


[316] 838-9071


DEC. 30, 2009

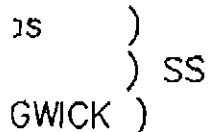

evitera, being a duly licensed land surveyor in said County hereby certify that I caused the land shown in the exhibit to be surveyed and that said survey and the exhibit are true and correct to the best of my knowledge

7 available

NOTE

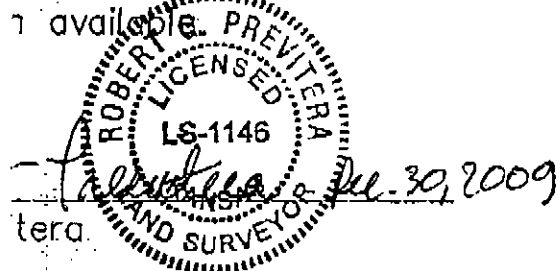

A = House to R.O.W.
B = House to Back of Curb



VAC2010-09

Air Capital Land Surveyors

1900 N. AMIDON, SUITE 209
WICHITA, KANSAS 67203

[316] 838-9071

LEGEND

1 DISTANCE

2 DISTANCE

3 DISTANCE

Rebar LS #77


INUMENT

BEGINNING

Section	A	B
1	1.0'	29.5'
2	10.7'	36.1'
3	25.2'	41.2'

PLAT OF SURVEY

DEC. 30, 2009

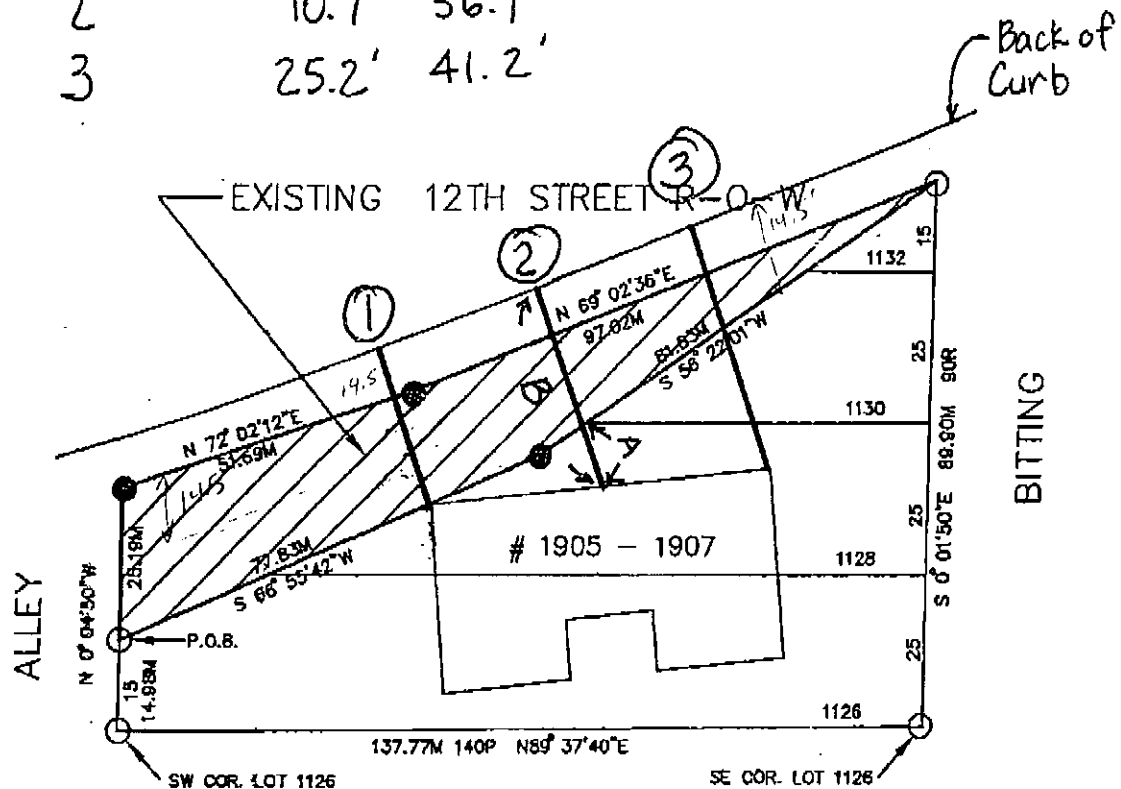


LEGAL

A tr.
north
desc.
Bitt.
City
the
as 91
more

Begin
point
1126,
an a:
12" 1
north
56° 2
of la
of th
corne
begin

15)
SS
GWICK)


evitera, being a duly licensed land surveyor in said County
hereby certify that I caused the land shown in the
exhibit to be surveyed and that said survey and the
exhibit are true and correct to the best of my knowledge

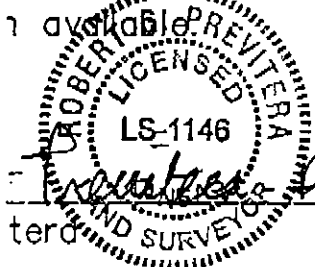

NOTE:

7, TWP. 27, R. 1 E.

W1
66

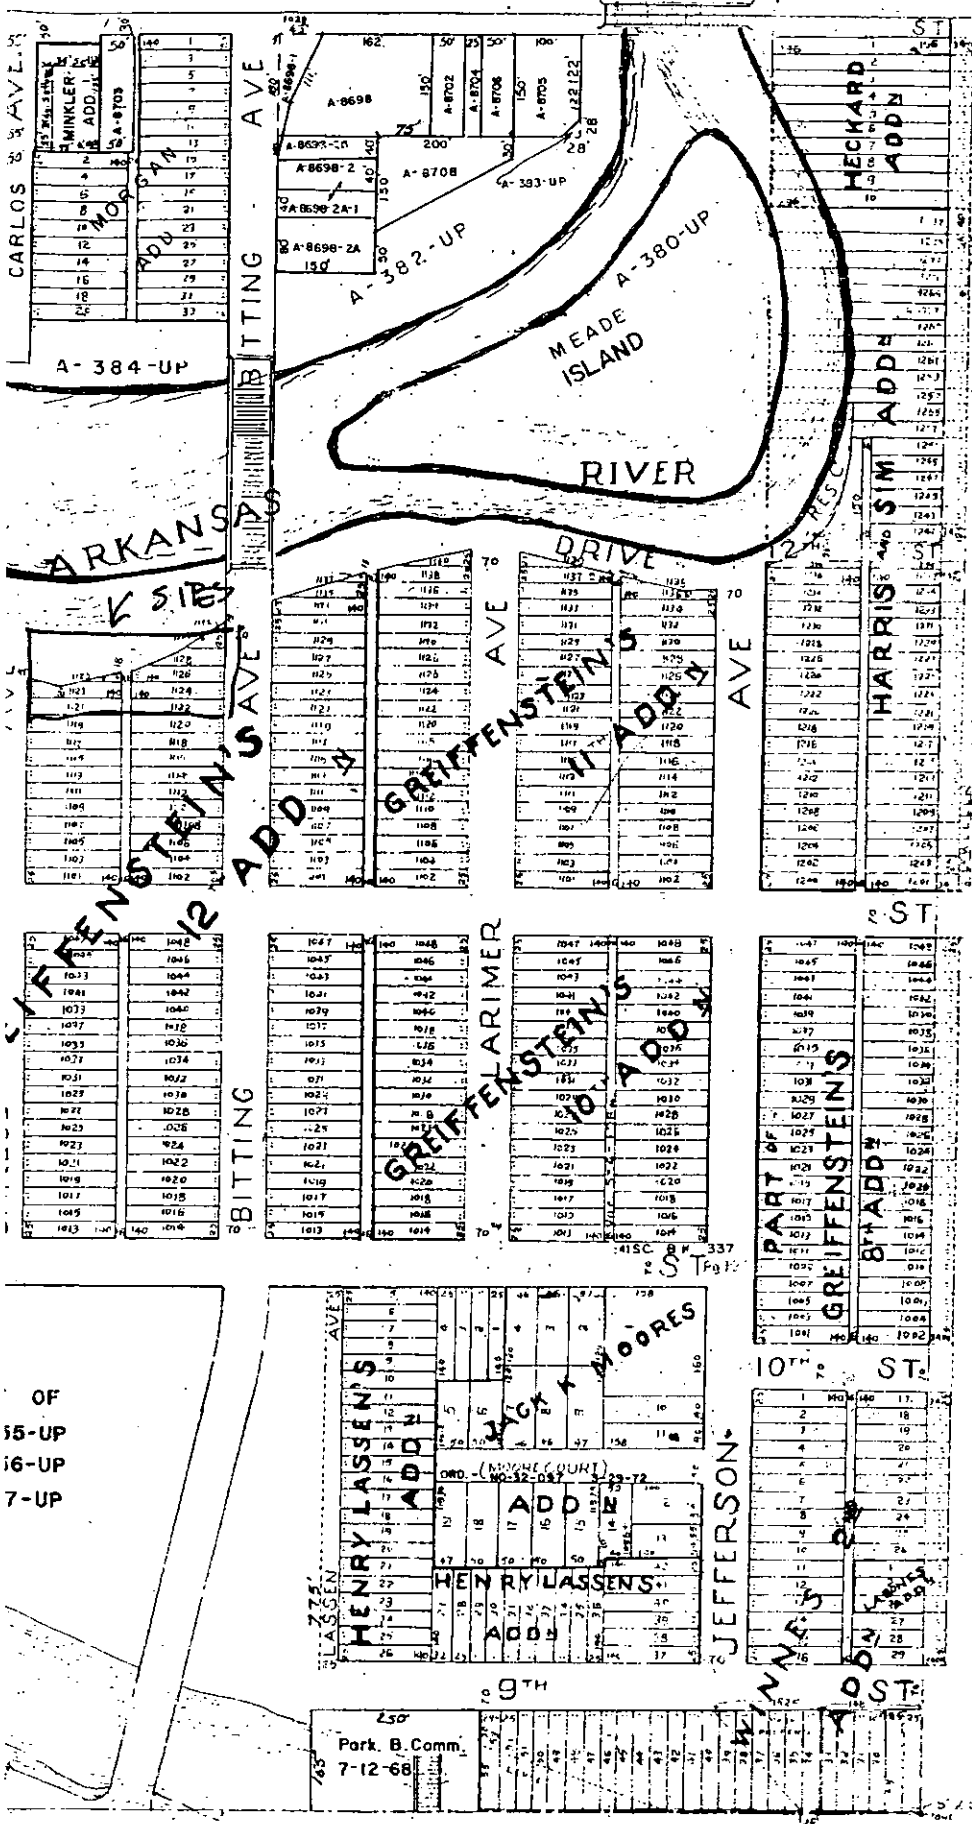

VAC 2010-09

V-1328
5-30-1985
lots 1128, 1130, 1132