

VAC 2013-06

S00°57'22"E
25.18'

S89°05'38"W 695.31'

S01°05'51"E
10.00'

S00°57'22"E
101.17'

**A portion of Lot 1, Blk. 1
Country Walk 2nd
Addition**

Subject Property


Vacated Portion
of Utility Easement

Proposed Reroute
Utility Easement

Webb Road



NORTH

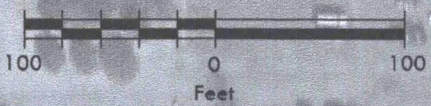

This exhibit is not to be considered a boundary survey.

MKEC
ENGINEERING
CONSULTANTS, INC.

411 N. WEBB ROAD
WICHITA, KS. 67206
316 - 684 - 9600
www.mkec.com

EXHIBIT "A"

TITLE

Utility Easement Vacation

SHEET NAME

Country Walk 2nd Addition

PROJECT-PROJECT NO. 05440