


6.	16°30'00" Lt.	06°59'41"	819.14'	118.77'	235.90'
7.	120°53'35" Lt.	44°04'11"	130.00'	229.27'	274.30'
8.	00°57'36" Lt.	00°28'11"	11,936.34'	100.0'	200.00'
9.	02°56'16" Rt.	00°44'05"	7,799.53'	200.0'	399.91'
10.	04°33'24" Lt.	03°15'23"	1,759.44'	70.0'	139.93'
11.	10°08'23" Rt.	04°37'16"	1,239.89'	110.0'	219.42'
12.	07°33'39" Lt.	05°24'30"	1,059.38'	70.0'	139.80'

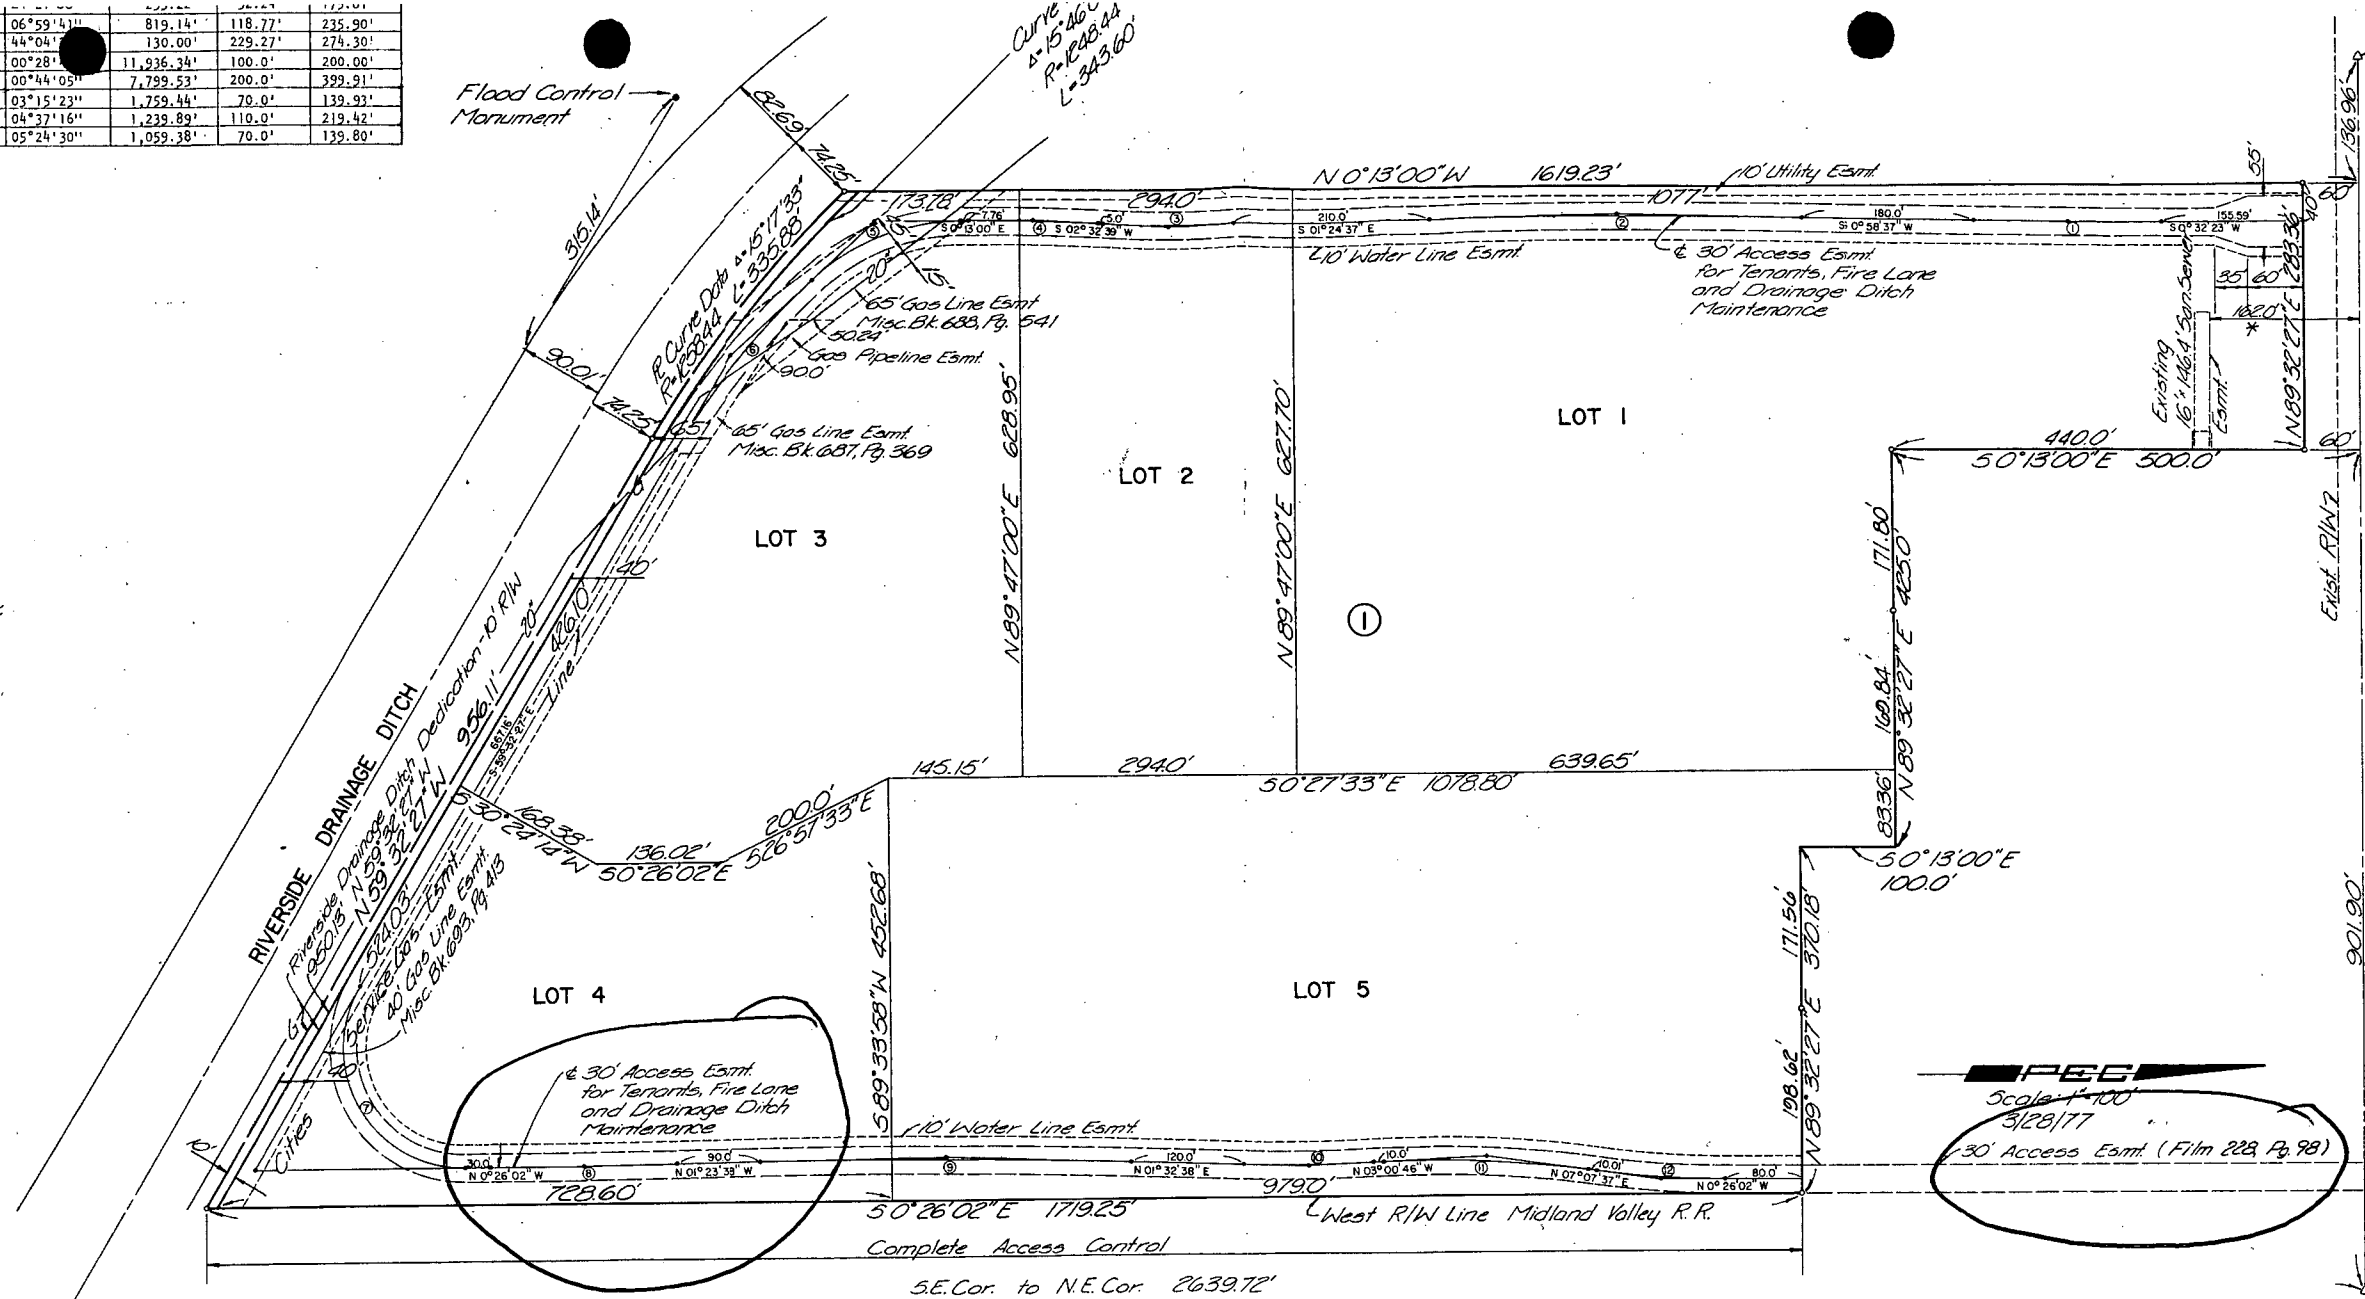

N.W. Cor. E 1/4, N.W. 1/4, Sec. 17, T28S, R1E of the 6th P.M.

Access Control Except One Opening

MACARTHUR RD.

N.E. Cor. N.W. 1/4, Sec. 17, T28S, R1E of the 6th P.M.

S.E. Cor. N.W. 1/4, Sec. 17, T28S, R1E of the 6th P.M.

VAC2013-37

REFILE 415398

* this plat has been refiled this 28 day of Nov. 1978 to show correction in Lot 1, of distance from the North line of San. Sewer Easmt. to the North line of Sec. 17, T28S, R1E, to be 162 feet, as shown.

Bette F. McCart Register of Deeds.
Bette F. McCart
Pat Kettler Deputy
Pat Kettler



SHEET 1 OF 2

B2 8 19 H-1-6-16 A