



**Wichita-Sedgwick County
Metropolitan Area
Planning Department**

April 10, 2026

Tier 1, LLC
2243 N. Ridge Rd., Ste. 105
Wichita, KS 67205

Baughman Company, P.A.
Attn: Phil Meyer
315 S. Ellis Ave.
Wichita, KS 67211

RE: CUP2026-00009– Administrative Adjustment in the City to the Stonebridge Community Unit Plan CUP DP-295 to adjust the parcel boundaries of Parcels 6 and 7 based on a boundary shift, on property zoned LC Limited Commercial District; generally located on the south side of West 37th Street North and within one-block east of North Maize Road.

Legal Description: Lots 5, 6, and 7, Block 1, Stonebridge Commercial Addition, Wichita, Sedgwick County, Kansas.

Dear Applicant,

We received and reviewed your request for an Administrative Adjustment to CUP DP-295 to modify the parcel boundaries of Parcels 6 and 7 based on a boundary shift. We understand that Parcel 6 is reducing in size and Parcel 7 is enlarging in size.

The following reflects the proposed modifications identified in red letters. Text that is in **bold** is Planning Department approved text that more accurately reflects the total area. The submitted text identified the new area for Parcel 7 as 1.24 acres, which did not accurately match the corresponding square footage of 53,876 s. f. and would have added 0.01 acres to the total area.

GENERAL PROVISIONS

Parcel 6

Gross Area = ~~1.29 Ac. or 56,243 s.f.~~ **1.03 Ac. or 44,867 s.t.**
Maximum Height = 35 feet
Max. Building Coverage = 30%
Maximum Building(s) = 1
Max. Gross Floor Area = 30% or ~~16,873 s.f.~~ **13,460 s.f.**
Floor Area Ratio = 0.30


Parcel 7

Gross Area = ~~0.97 Ac. or 42,500 s.f.~~ **1.23 Ac. or 53,876 s.t.**
Maximum Height = 35 feet
Max. Building Coverage = 30%
Maximum Building(s) = 1
Max. Gross Floor Area = 30% or ~~14,875 s.f.~~ **16,163 s.f.**
Floor Area Ratio = 0.30


On the basis of our review, we find that adjusting the CUP in the manner stated above is consistent with the approved CUP and will not have an adverse effect on the CUP or adjacent properties, nor will it be a substantial deviation of the original plan.

Our signatures below indicate that the CUP shall be adjusted as stated in this letter. This CUP adjustment shall not be deemed to alter any other provisions of the CUP except as expressly stated herein.

The "Development Application" sign should now be removed from the property. Please submit one (1) electronic copy and four (4) full-sized paper copies of the revised CUP drawing within 60 days in order for this adjustment to be considered final.

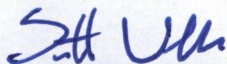

Scott Wadle, Director
Metropolitan Area Planning Department

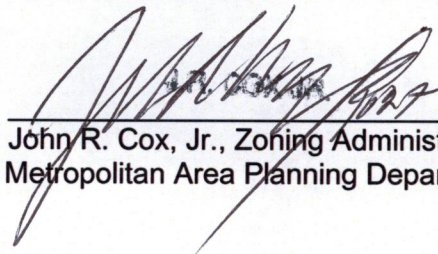

John R. Cox, Jr., Zoning Administrator
Metropolitan Area Planning Department

cc: MABCD
J.V. Johnston, CM District V
Teresa Veazey, CSR District V

DEVELOPMENT GUIDELINES

General Provisions

- Area: The total development contains 36.3 acres of land more or less with a net land area of 35.93 acres of land more or less.

Parcel Descriptions:

Summary:

Total allowable buildings = 18
(excluding necessary structures)
Total allowable floor ratio = .32
(may be adjusted from parcel to parcel)
Minimum Building Setbacks: (applies to all parcels as shown)
Arterial Street setback = 35'
Interior side setback = 15'
Exterior side setback = 35' **
Exterior boundary setback = 100' **
** (if building has a gross floor area greater than 100,000 s.f.)
Also see G.P.9 hereon.

Parcel 1a
Gross Area= 0.71 Ac. or 30,936 s.f.
Maximum Height=35 feet
Max. Building Coverage=35%
Maximum Building(s) = 1
Max. Gross Floor Area=35% or 10,828 s.f.
Floor Area Ratio=0.35

Parcel 1b
Gross Area= 0.71 Ac. or 30,822 s.f.
Maximum Height=35 feet
Max. Building Coverage=35%
Maximum Building(s) = 1
Max. Gross Floor Area=35% or 10,788 s.f.
Floor Area Ratio=0.35

Parcel 2a
Gross Area= 0.70 Ac. or 30,729 s.f.
Maximum Height=35 feet
Max. Building Coverage=35%
Maximum Building(s) = 1
Max. Gross Floor Area=35% or 10,755 s.f.
Floor Area Ratio=0.35

Parcel 2b
Gross Area= 0.71 Ac. or 30,899 s.f.
Maximum Height=35 feet
Max. Building Coverage=35%
Maximum Building(s) = 1
Max. Gross Floor Area=35% or 10,815 s.f.
Floor Area Ratio=0.35

Parcel 3
Gross Area= 0.70 Ac. or 30,331 s.f.
Maximum Height=35 feet
Max. Building Coverage=35%
Maximum Building(s) = 1
Max. Gross Floor Area=35% or 10,616 s.f.
Floor Area Ratio=0.35

Parcel 4a
Gross Area= 1.19 Ac. or 52,009 s.f.
Maximum Height=35 feet
Max. Building Coverage=35%
Maximum Building(s) = 1
Max. Gross Floor Area=35% or 18,203 s.f.
Floor Area Ratio=0.35

Parcel 4b
Gross Area= 0.89 Ac. or 38,755 s.f.
Maximum Height=35 feet
Max. Building Coverage=35%
Maximum Building(s) = 1
Max. Gross Floor Area=35% or 13,564 s.f.
Floor Area Ratio=0.35

Parcel 5
Gross Area= 1.92 Ac. or 83,775 s.f.
Maximum Height=35 feet
Max. Building Coverage=35%
Maximum Building(s) = 2
Max. Gross Floor Area=35% or 29,321 s.f.
Floor Area Ratio=0.30

Parcel 6
Gross Area= 1.29 Ac. or 56,243 s.f.
Maximum Height=35 feet
Max. Building Coverage=30%
Maximum Building(s) = 1
Max. Gross Floor Area=30% or 16,873 s.f.
Floor Area Ratio=0.30

Parcel 7
Gross Area= 0.97 Ac. or 42,500 s.f.
Maximum Height=35 feet
Max. Building Coverage=30%
Maximum Building(s) = 1
Max. Gross Floor Area=30% or 14,875 s.f.
Floor Area Ratio=0.30

Parcel 8
Gross Area= 0.97 Ac. or 42,500 s.f.
Maximum Height=35 feet
Max. Building Coverage=30%
Maximum Building(s) = 1
Max. Gross Floor Area=30% or 14,875 s.f.
Floor Area Ratio=0.30

Parcel 9
Gross Area= 0.97 Ac. or 42,500 s.f.
Maximum Height=35 feet
Max. Building Coverage=30%
Maximum Building(s) = 1
Max. Gross Floor Area=30% or 14,875 s.f.
Floor Area Ratio=0.30

Parcel 10
Gross Area= 0.90 Ac. or 42,500 s.f.
Maximum Height=35 feet
Max. Building Coverage=30%
Maximum Building(s) = 1
Max. Gross Floor Area=30% or 14,875 s.f.
Floor Area Ratio=0.30

Parcel 11a
Gross Area= 11.02 Ac. or 479,861 s.f.
Maximum Height=45 feet
Max. Building Coverage=11a+11b=30%
Max. Building(s) = 1
Max. Gross Floor Area=30% or 14,875 s.f.
Floor Area Ratio=11a+11b=0.30

Parcel 11b
Gross Area= 12.26 Ac. or 533,895 s.f.
Maximum Height=45 feet
Max. Building Coverage=11a+11b=30%
Max. Building(s) = 1
Max. Gross Floor Area=30% or 14,875 s.f.
Floor Area Ratio=11a+11b=0.30

- The following uses are permitted for all Parcels within the C.U.P.:
A. Parcels 1a, 1b, 2a, 2b, 3, 4a, 4b, 5, 6, 7, 8, 9, 10, and 11a allow for all uses permitted within the Limited Commercial Zoning District (LC), except the uses listed below:
Correctional placement residential limited and general, adult entertainment establishment, pawn shop, asphalt or concrete plant-limited, and storage-outdoor. Additionally, the following uses are prohibited within the east 150 feet of Parcels 10 and 11a and the south 200 feet of Parcels 1a and 11a, if the adjoining parcels are specifically zoned for residential: convenience stores, service stations, auto repair, car washes (further prohibited to 200 feet of residential uses as stated below), restaurants with drive-in or drive-through windows, and taverns and drinking establishment on out-parcels. Car Washes in the CUP shall be subject to the supplementary use regulations of Sec. III-D.6.f. of the Unified Zoning Code.

- Parcel 11b allows for the following General Commercial Zoning District (GC), uses listed below:
Construction sales and services and outdoor storage of materials and equipment ordinarily associated with construction sales and services activities, and also home improvement stores, and also all the uses permitted in Parcel 11a.

- The uses permitted by the C.U.P. are only those uses permitted by right and not by conditional use unless specifically identified.

- Architectural Controls:
With exception to Parcel 11b, all buildings within the C.U.P. shall share a uniform architectural character, color, and same predominate exterior building material, as determined by the Director of Planning. The building walls and roofs must have predominately earth-tone colors, with vivid colors limited to incidental accents, and must employ materials similar to surrounding residential areas. The building(s) walls shall not utilize metal as a predominant exterior facade material, unless approved by the Director of Planning.

- Title:
The transfer of the title on all or any portion of the land included in the Community Unit Plan does not constitute a termination of the plan or any portion thereof, but said plan shall run with the land for commercial development and be binding upon the present owners, their successors and assigns and amended. However, the Director of the MAPD, with the concurrence of the Zoning Administrator, may approve minor adjustments to the conditions in this overlay, consistent with the approved development plan, without filing a formal ordinance amendment.

- Landscaping for this site shall be required as follows:
A. Landscaped street yards, buffers, and parking lot landscaping and screening - Shall be in accordance with the City of Wichita Landscape Ordinance.
B. A landscape plan shall be prepared by a Kansas Landscape Architect for the above referenced landscaping, indicating the type, location, and specifications of all plant material. This plan shall be submitted to the Metropolitan Area Planning Department (MAPD) for its review and approval prior to issuance of any building permit(s).

- Lighting:
A. Lighting shall be in accordance with the Wichita-Sedgwick County Unified Zoning Code, Section IV.
B. All Parcels shall share similar or consistent parking lot lighting elements (i.e. fixtures, poles and lamps and etc.), as approved by the Director of the MAPD.
C. All lighting shall be shielded to direct light disbursement in a downward direction and directed away from residential areas.
D. Light poles including above ground base shall be limited to 27 feet tall, except 15 feet tall when within 100 feet of residential zoning with residential use. School is not a residential use.
E. Extensive use of back lit canopies and neon or fluorescent tube lighting on buildings is not permitted.

Screening for this site shall be required as follows:

- Rooftop mechanical equipment shall be screened from ground level view per Wichita-Sedgwick County Unified Zoning Code.
- Trash receptacles, loading docks, outdoor storage, and loading areas shall be appropriately screened to reasonably hide them from ground view.
- Unless otherwise noted Screening shall be in accordance with the Wichita-Sedgwick County Unified Zoning Code, Section IV and Section III-C.2.b.
- Outdoor display and storage shall be subject to all conditions of Section III-B.14.a for all Parcels, except, Parcel 11b. Parcel 11b is allowed outdoor storage in conformance with the GC zoning regulations.
- Masonry walls consisting of a solid or semisolid wall constructed of brick, stone, masonry, architectural tile, or other similar material (not including wood or woven wire) are required along the northeastern most boundary of Parcel 11a (40.00 feet), and along the east line of Parcel 10. The masonry walls shall not be less than six feet and not more than eight feet high. Construction of the masonry wall will require a building permit. Wall openings may be permitted allowing pedestrian access. The wall opening shall be determined and approved by the director of planning prior to the issuance of the building permit.
- A wood screening wall with brick column features every fifty feet shall be built on or near the southern line of Parcel 11b from 35' west of the east line of Parcel 11b to a point equal to a line extended south from the western facade of the main building built on Parcel 11b. A wood screening wall with brick column features every fifty feet shall be built on or near the 35' building setback line located along the eastern property line of Parcel 11b (an accessory building may replace a portion of the this wall provided its height is a minimum of 14'). The 35' setback area shall be landscaped to provide additional screening. The wood screening wall shall be a minimum of 14' tall.
- Landscape screening and berming will be provided within the 35 foot setback area of the southwest most 565 feet of Parcel 11a, as indicated.

- Setbacks:
Setbacks are as follows and or as specified in Wichita-Sedgwick County Unified Zoning Code. If contiguous Parcels are to be developed under the same ownership, setbacks between those Parcels are not required. Within Parcel 11b buildings greater than 200,000 square feet shall adhere to a 100 foot rear or east building setback. Within Parcel 11b, a 35 foot rear or east building setback is required for an accessory building. Also see Parcel Descriptions for building setbacks.

- Signs: As permitted under the current Sign Code of the City of Wichita. Additionally, the following conditions apply:

- Parcels 1a through 11a, are subject to the requirements of the Sign Code for the City of Wichita for Limited Commercial (LC) Zoning District, except as noted herewith (10. B. thought 10. J.).
- No flashing, moving, portable, billboard, banner, or pennant signs shall be permitted (except for signs showing time and temperature).
- All freestanding signs adjoining Maize Road and 37th Street roadways shall be monument type signs with a maximum height of 20 ft., with the exception of three 30 ft. development marker/monument type signs. The maximum sign area for the 30 ft. signs shall be 200 sq. ft. and shall be used for development identification as well as tenant signs for tenants within the C.U.P.
- The minimum distance between signs shall be 150 ft., except for those signs adjacent to the development marker/monument signs, the minimum distance between these signs is 100 ft.
- Along Maize Road, Parcels 1a through 5, and Parcel 11a and 11b shall be permitted a total of 7 monument signs including the development sign(s). The monument signs shall not exceed 20 feet in height with a maximum sign area of 150 sq. ft. each. These signs may be used for tenants within the C.U.P.
- Along 37th Street, Parcels 5 through 11a shall be permitted a total of 7 monument signs including the development sign(s). The maximum sign area is 150 sq. ft. These signs may be used for tenants within the C.U.P.
- Building signage shall be permitted within the C.U.P. and per the current Sign Code.
- Accent lighting of monument signs shall be permitted.
- Window signage shall be limited to 25% of window area.
- The total amount of sign face area of freestanding signage along each arterial street shall not exceed 0.8 times the linear frontage.
- Parcel 11b is subject to the requirements of the Sign Code for the City of Wichita for General Commercial (GC) Zoning District.

- Parking:
A. All Parcels, shall be in accordance with the Wichita-Sedgwick County Unified Zoning Code, Section IV-A.
B. unless otherwise specified.
Parcels 1a and 11b shall be reviewed as one parcel in consideration to parking requirements. On Parcels 11a and 11b, a minimum of 450 parking stalls is required.

- Reserves:
The location, uses, and size of reserves shall be determined at the time of final platting.

- No occupancy permits shall be issued for any development without services by municipal water and sewer services.

- The following transportation improvements and Parcel access shall be provided:

- Cross-lot circulation agreements shall be required at the time of platting to assure internal vehicular movement between Parcels within the C.U.P.
- Guarantees for specific street and or signalization improvements for Maize Road shall be further reviewed and determined at the time of final platting.
- Access controls shall be as shown on the Final Plat and revised upon the C.U.P.
- An overall site circulation plan shall be submitted for review and approval by the Director of Planning, in concurrence with the Zoning Administrator and Traffic Engineer. The circulation plan shall assure smooth internal vehicular and pedestrian movements, pedestrian connectivity to major arterial and within buildings on the CUP and may provide connections to adjoining properties, and ensure that the main drives are not blocked by parking spaces directly backing onto the main drive aisles.

- Grading Plan:
A lot grading plan will be prepared in conformance with the Drainage Concept Plan for review prior to the issuance of a Building Permit.

- All proposed new utilities shall be installed underground.

- Final determination of minimum pad elevations (at least 2 feet higher than the 100 year flood elevation), street right(s)-of-way, easements, and pavement widths on public private streets shall be resolved at the time of platting.

- The development of this property shall proceed in accordance with the development plan as recommended for approval by the Planning Commission and approved by the Governing Body, and any substantial deviation of the plan, as determined by the Zoning Administrator and the Director of Planning, shall constitute a violation of the building permit authorizing construction of the proposed development.

- Any major changes within this Community Development Plan shall be submitted to the Planning Commission and the Governing Body for their consideration. Amendments, adjustments, or interpretations to the C.U.P. shall be done in accordance with the Unified Zoning Code.

APPROVED CUP

MAFC 11-20-08 klu

WCC 1-27-09 klu

MAPD copy 10/4

Per Adjust 8-22-2016 klu

COMMUNITY UNIT PLAN DP-295


STONEBRIDGE

OWNER / DEVELOPER: Tier 1, LLC Attn: Marv Schellenberg
OWNER / DEVELOPER: Menard, Inc. Attn: Tyler Edwards

7926 W. 21st, Wichita, KS 67205 (316) 721-2153
5101 Menard Drive, Eau Claire, WI 54703 (715) 876-2143


Adjustment #4 CUP2016-00033
Amendment #2 CUP2016-00023
Adjustment #3 CUP2013-00038
Adjustment #2 CUP2013-00005
Adjustment #1 CUP2012-00014
Amendment #1 ZON2008-00061 / CUP2008-00044
Original Case: ZON2006-07 / CUP2006-06

August 22, 2016
July 21, 2016
November 4, 2013
March 11, 2013
May 21, 2012
November 20, 2008
June 6, 2006

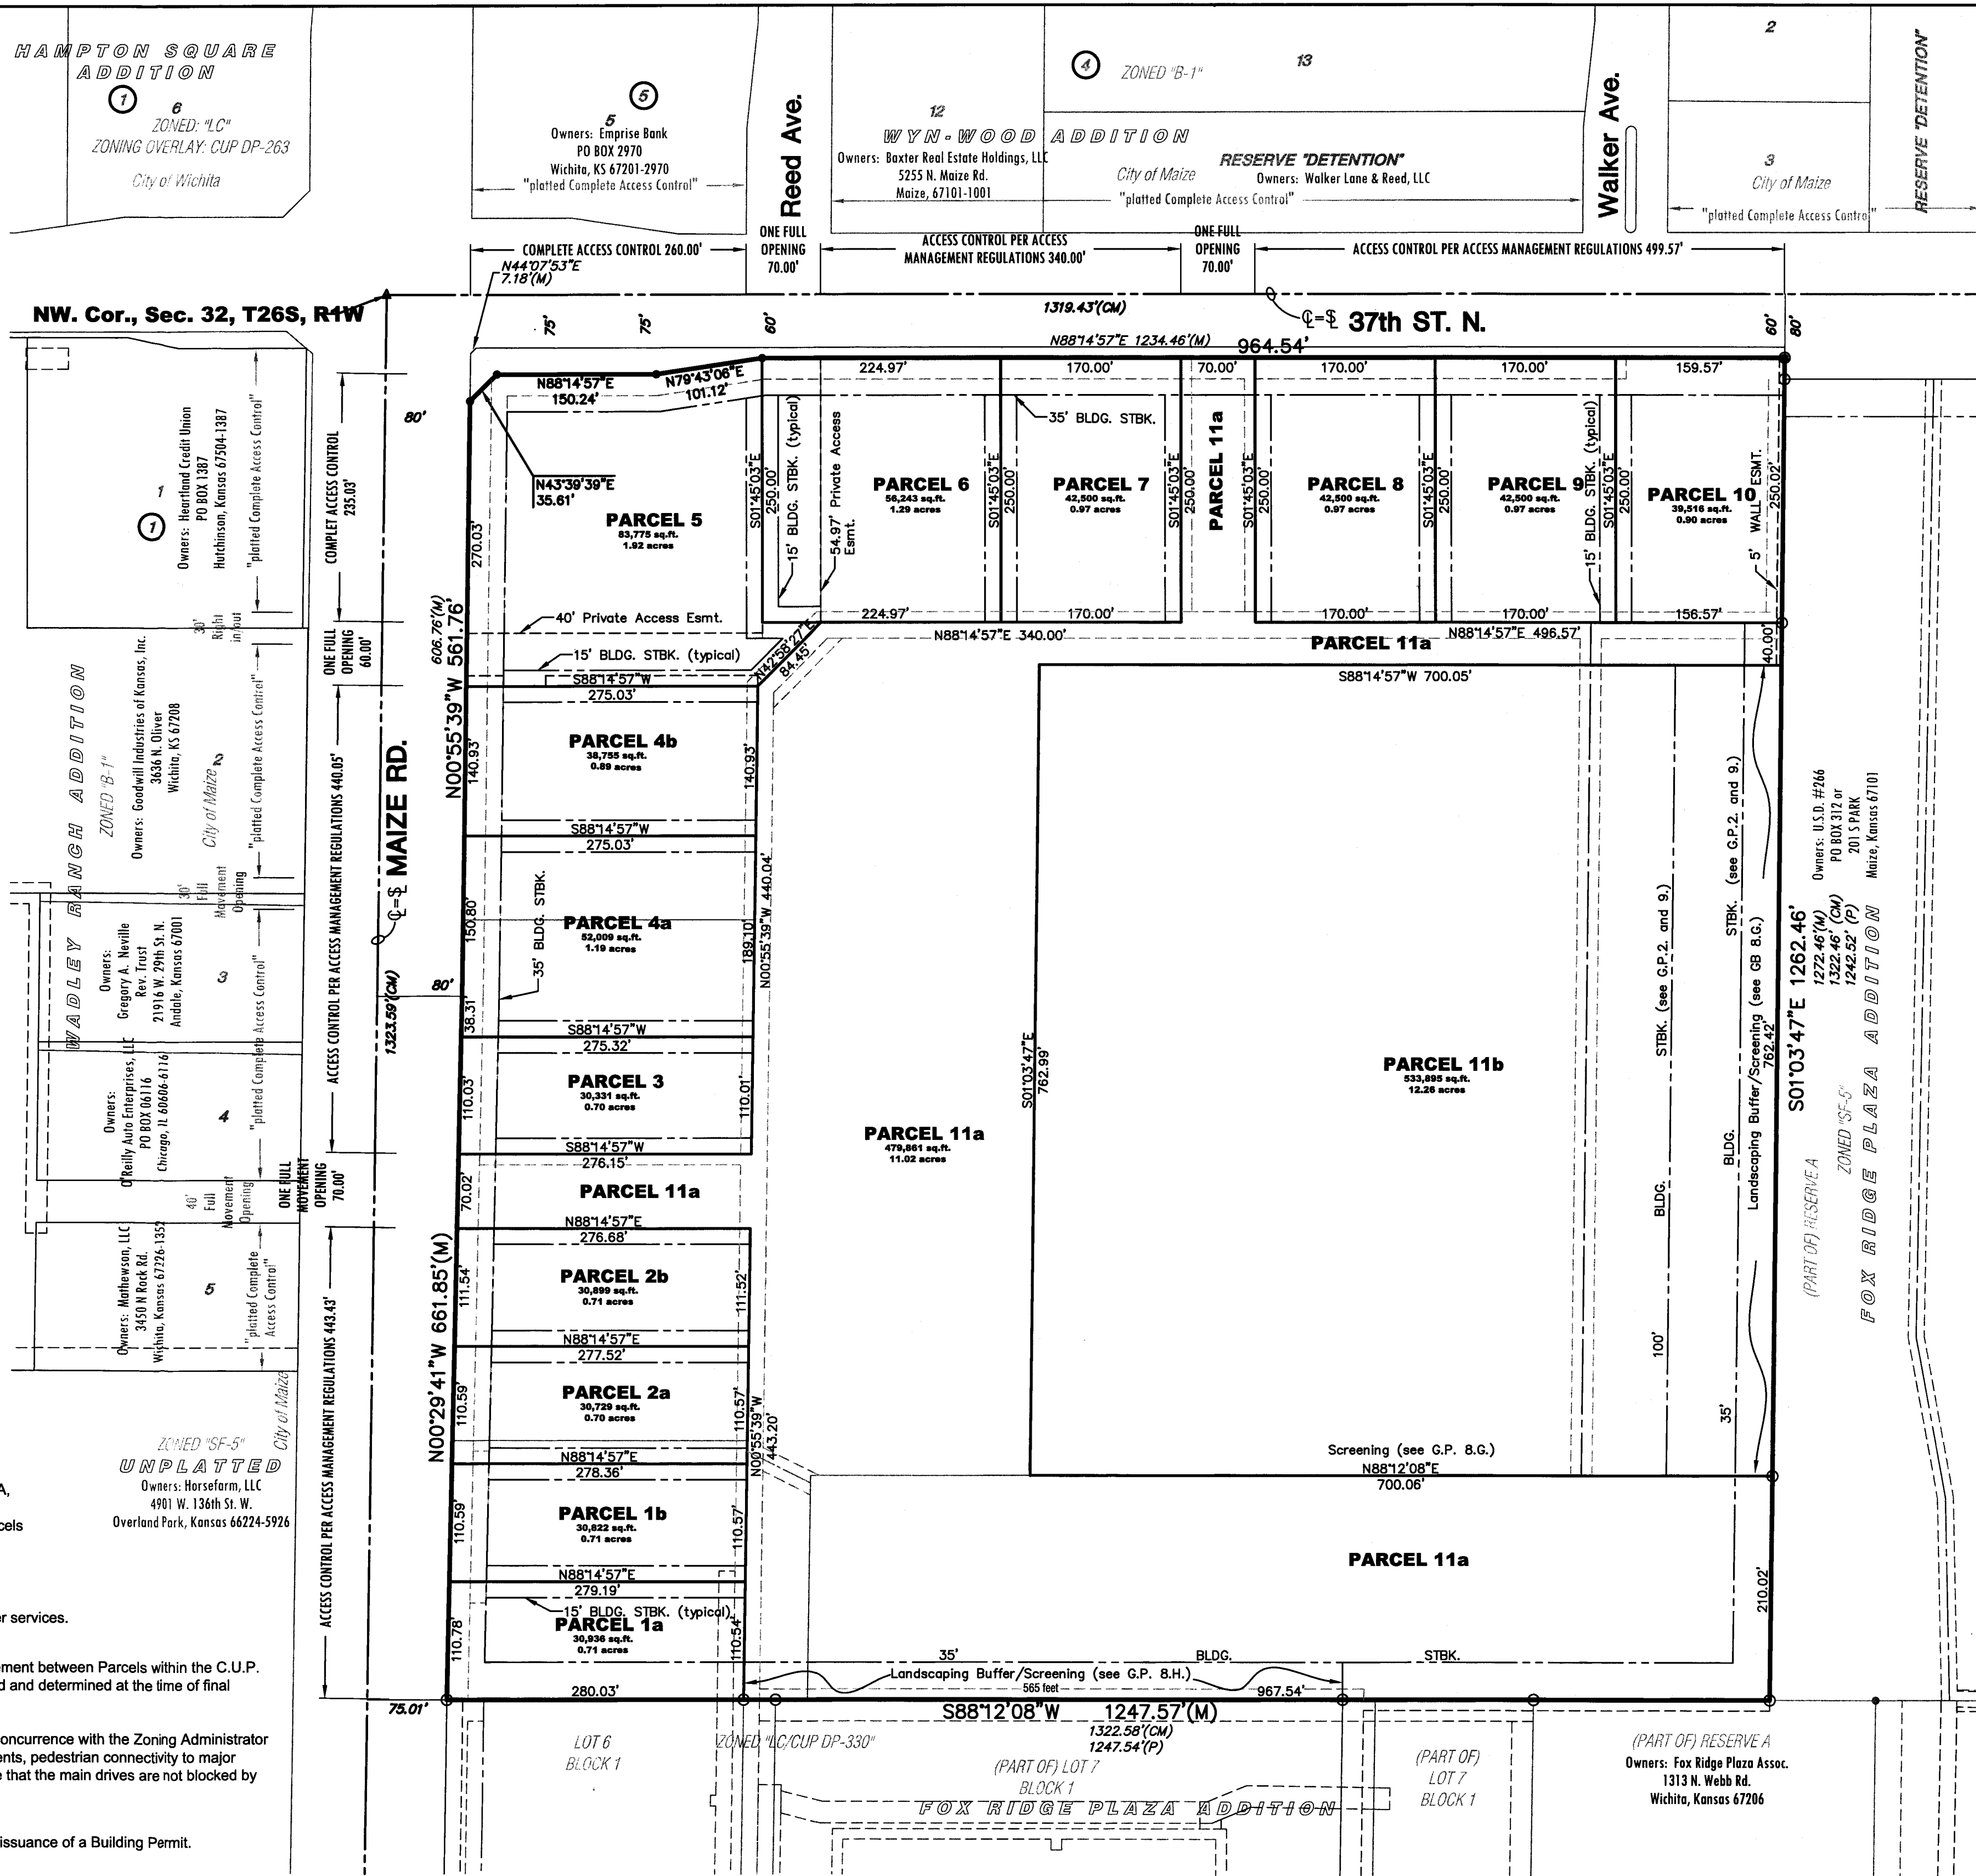

LEGAL DESCRIPTION

Stonebridge Commercial Addition, an addition to Wichita, Sedgwick County, Kansas.

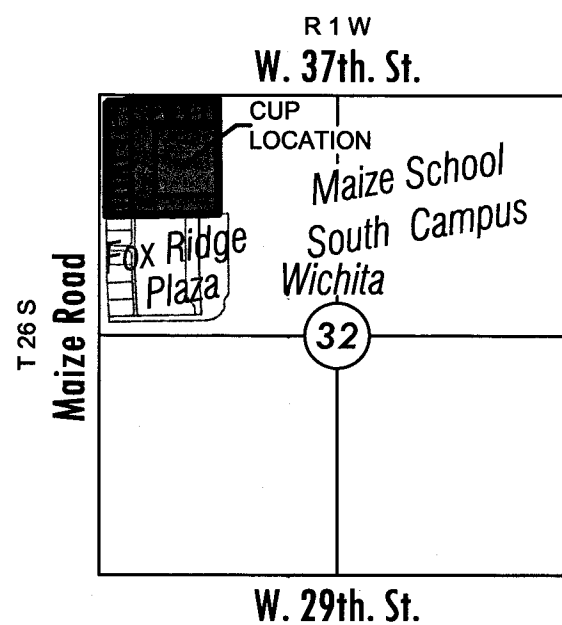


VICINITY MAP




MKEC
Wichita, KS • 316.684.9600

Plot: 17, 2010
Last Saved By: keth
Paper Size: arch D (36x24 in.)
Plot: 17, 2010

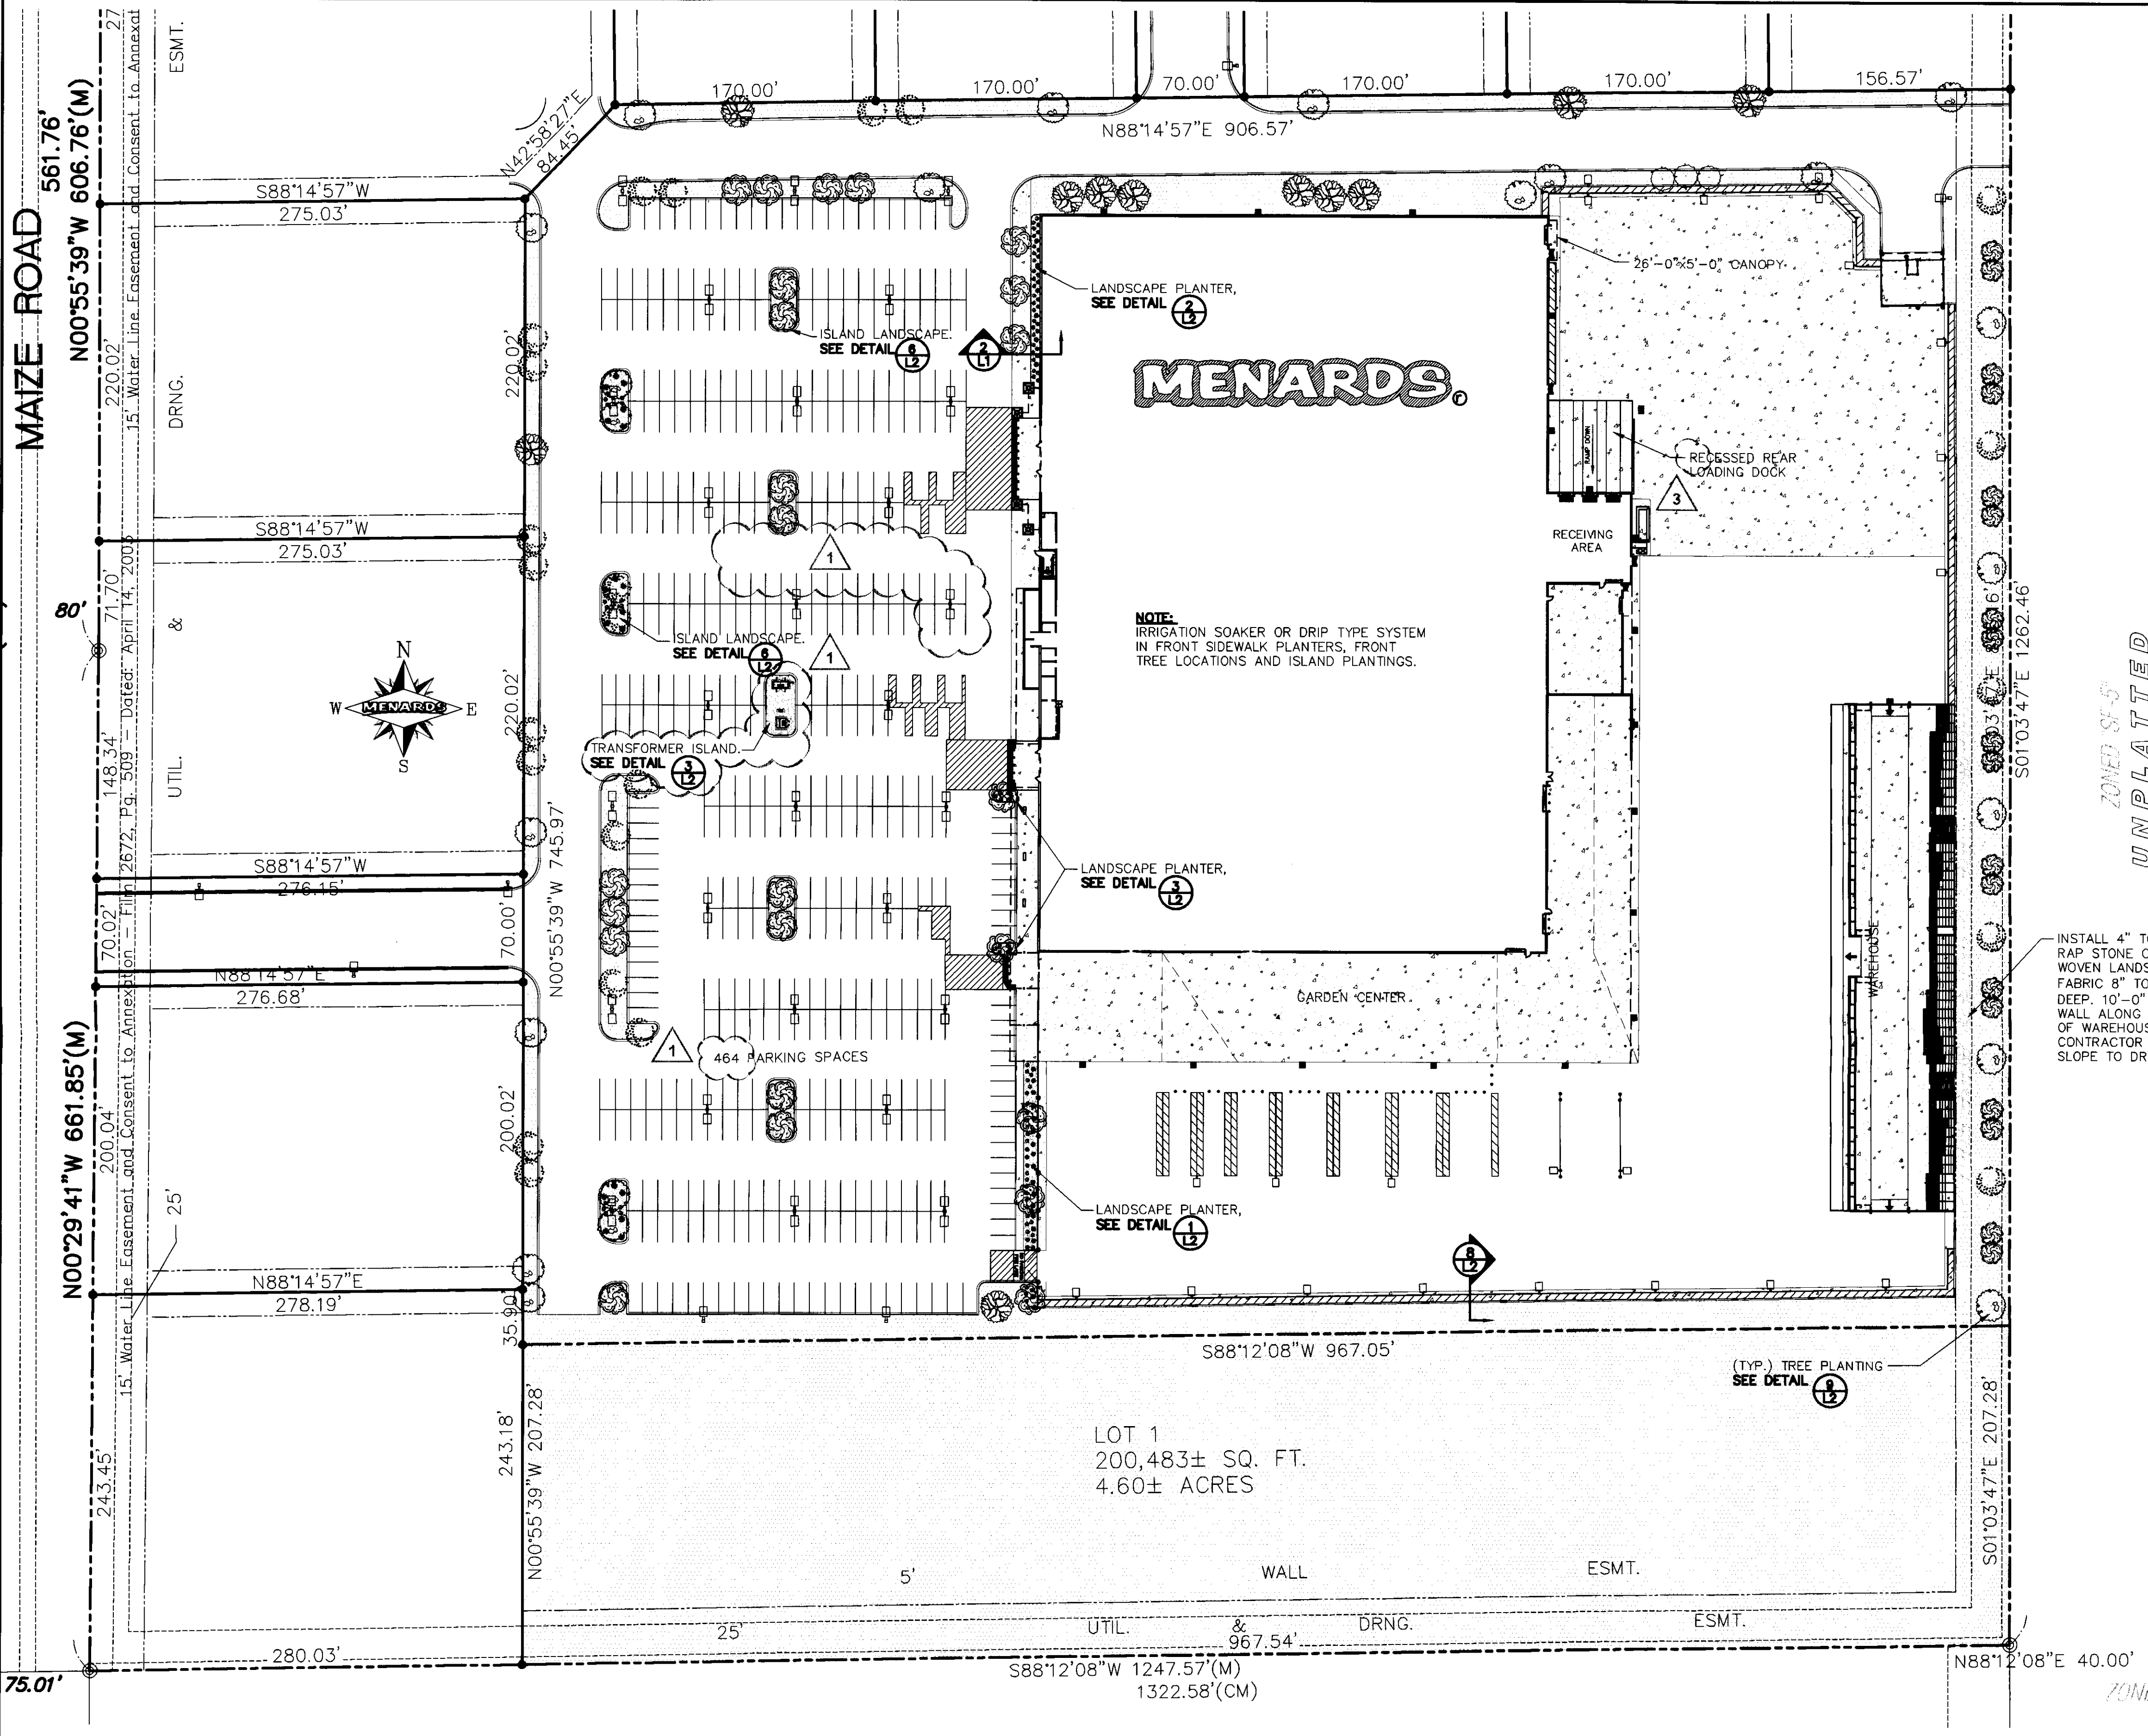

NOTE:
IRRIGATION SOAKER OR DRIP TYPE SYSTEM IN FRONT SIDEWALK PLANTERS AND FRONT TREE LOCATIONS.

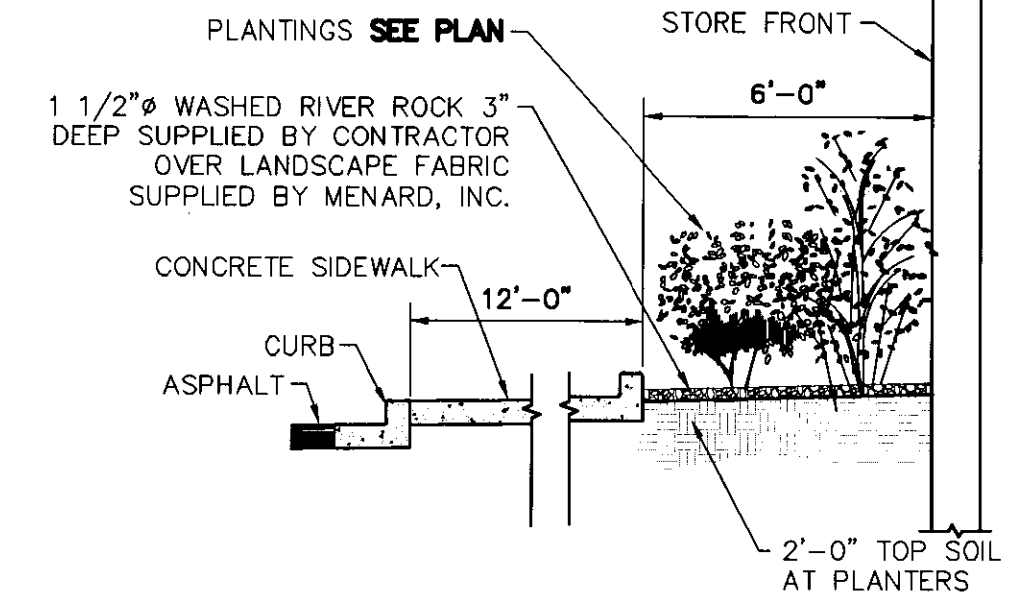

2 PLANTER SECTION
SCALE: 1/4" = 1'-0" (REF. 1/L1) (REF. 1/L2)

PARKING LOT LANDSCAPE LEGEND

SYMBOL	SCIENTIFIC, COMMON NAME	SIZE	QUANTITY	MATURE SIZE
	ACER SACCHARUM 'LEGACY', 'LEGACY' SUGAR MAPLE	2 1/2" DIA.	5	60'-0" TO 75'-0" TALL 40'-0" TO 50'-0" WIDE
	MALUS X HYBRID 'CENTURION', 'CENTURION' FLOWERING CRAB	2 1/2" DIA.	16	25'-0" TALL 15'-0" TO 20'-0" WIDE
	GLEDTISIA TRIACANTHOS var. INERMIS 'SKYLINE', 'SKYLINE' THORNLESS COMMON HONEYLOCUST	2 1/2" DIA.	8	30'-0" TO 70'-0" TALL 30'-0" TO 70'-0" WIDE
	BERBERIS THUNBERGII var. ATROPURPUREA 'CRIMSON PYGMY', 'CRIMSON PYGMY' JAPANESE BARBERRY	3 GALLON	23	1'-6" TO 2'-0" TALL 2'-6" TO 3'-0" WIDE
	JUNIPERUS HORIZONTALIS 'TURQUOISE SPREADER', 'TURQUOISE SPREADER' CREEPING JUNIPER	3 GALLON	32	1'-0" TO 2'-0" TALL 2'-0" TO 3'-0" WIDE
	HYDROSEED			
	1 1/2" WASHED RIVER ROCK (ISLANDS AND PLANTERS)			

PARKING LOT LANDSCAPING REQUIRED:
1 SHADE TREE OR TWO ORNAMENTAL TREES FOR EACH 20 PARKING SPACES
462 PARKING SPACES IN PARKING LOT = 24 SHADE TREES
PARKING LOT LANDSCAPING PROVIDED:
13 SHADE TREES, 18 ORNAMENTAL TREES AND 174 SHRUBS

OVERALL LOT LANDSCAPE LEGEND

SYMBOL	SCIENTIFIC, COMMON NAME	SIZE	QUANTITY	MATURE SIZE
	ACER SACCHARUM 'LEGACY', 'LEGACY' SUGAR MAPLE	2 1/2" DIA.	22	60'-0" TO 75'-0" TALL 40'-0" TO 50'-0" WIDE
	MALUS X HYBRID 'CENTURION', 'CENTURION' FLOWERING CRAB	2 1/2" DIA.	42	25'-0" TALL 15'-0" TO 20'-0" WIDE
	GLEDTISIA TRIACANTHOS var. INERMIS 'SKYLINE', 'SKYLINE' THORNLESS COMMON HONEYLOCUST	2 1/2" DIA.	23	30'-0" TO 70'-0" TALL 30'-0" TO 70'-0" WIDE
	CELTIS OCCIDENTALIS 'PRAIRIE PRIDE', 'PRAIRIE PRIDE' COMMON HACKBERRY	2 1/2" DIA.	11	40'-0" TO 60'-0" TALL 40'-0" TO 50'-0" WIDE
	PINUS STROBIFORMIS, SOUTHWESTERN WHITE PINE	6'-0" TALL	3	40'-0" TO 60'-0" TALL 25'-0" TO 40'-0" WIDE
	SPIRAEA x BUMALDA 'ANTHONY WATERER', 'ANTHONY WATERER' SPIRAEA	3 GALLON	31	3'-0" TO 4'-0" TALL 5'-0" TO 6'-0" WIDE
	BERBERIS THUNBERGII var. ATROPURPUREA 'CRIMSON PYGMY', 'CRIMSON PYGMY' JAPANESE BARBERRY	3 GALLON	56	1'-6" TO 2'-0" TALL 2'-6" TO 3'-0" WIDE
	POTENTILLA FRUTICOSA 'JACKMANII', 'JACKMANII' POTENTILLA	3 GALLON	14	3'-0" TO 4'-0" TALL 2'-0" TO 3'-0" WIDE
	RHUS AROMATICA, FRAGRANT SUMAC	3 GALLON	25	2'-0" TO 6'-0" TALL 6'-0" TO 10'-0" WIDE
	JUNIPERUS HORIZONTALIS 'TURQUOISE SPREADER', 'TURQUOISE SPREADER' CREEPING JUNIPER	3 GALLON	32	1'-0" TO 2'-0" TALL 2'-0" TO 3'-0" WIDE
	HYDROSEED			
	1 1/2" WASHED RIVER ROCK (ISLANDS AND PLANTERS) 4" TO 8" ROCK RIP-RAP (BEHIND WAREHOUSE)			

1 LANDSCAPE SITE PLAN
SCALE: 1" = 60'-0"










DP-295 PARCEL 11A & 11B
LANDSCAPE PLAN
APPROVED 08/04/10 BY [Signature]
SHEET 1 OF 2
MAPD Copy 1 OF 2

NOTES:
1. PLANTING ARRANGEMENT AND QUANTITIES APPROVED BY MENARD, INC. PRIOR TO INSTALLATION.
2. ALL TREES AND PLANTS TO BE APPROVED BY MENARD, INC. PRIOR TO INSTALLATION.
3. DECIDUOUS SHADE TREES TO BE OF A MIN. CALIPER MEASURED AT A POINT 6" ABOVE GROUND LEVEL. SEE ABOVE FOR CALIPER SIZES REQUIRED.
4. ALL PLANTS SHALL BE INSTALLED WITHIN MENARDS PROPERTY LINES.
5. CONTRACTOR IS RESPONSIBLE TO SUPPLY WATER NECESSARY TO PROMOTE AND MAINTAIN HEALTHY PLANTINGS.
6. THE SURFACE OF THE TOPSOIL SHALL NOT CONTAIN ANY CLODS, LUMPS, ROCKS, DEBRIS, ETC. LARGER THAN 1/2" DIAMETER.
7. WESTERN WHITE WOOD MULCH AND LANDSCAPE FABRIC SUPPLIED BY MENARD, INC.
8. CONTRACTOR IS RESPONSIBLE FOR ALL MOWING, FERTILIZING, AND MAINTENANCE OF LANDSCAPING FOR A PERIOD OF NOT LESS THAN ONE YEAR FROM THE PROJECT COMPLETION.

LATEST REVISION
DESTROY ALL PREVIOUS ISSUES AT ONCE
DO NOT KEEP DUPLICATE COPIES
DATE: _____
SIGNED: _____

MENARD INC. STORE DESIGN DEPARTMENT EAU CLAIRE, WISCONSIN		PROJECT TITLE WICHITA, KS (WEST)	
SCALE AS NOTED NO. DATE DESCRIPTION		SHEET TITLE LANDSCAPE SITE PLAN	
REVISIONS		CAD. DWG NAME WICHITA, KS WEST SITES	
1 06-08-10 RELOCATE TRANSFORMER ISLAND		BY KWK	
2 06-15-10 REVISE LANDSCAPING QUANTITIES		BY KWK	
3 06-17-10 REMOVE LOADING DOCK DIMENSION		BY KWK	
		SHEET NO. L1	

LATEST REVISION

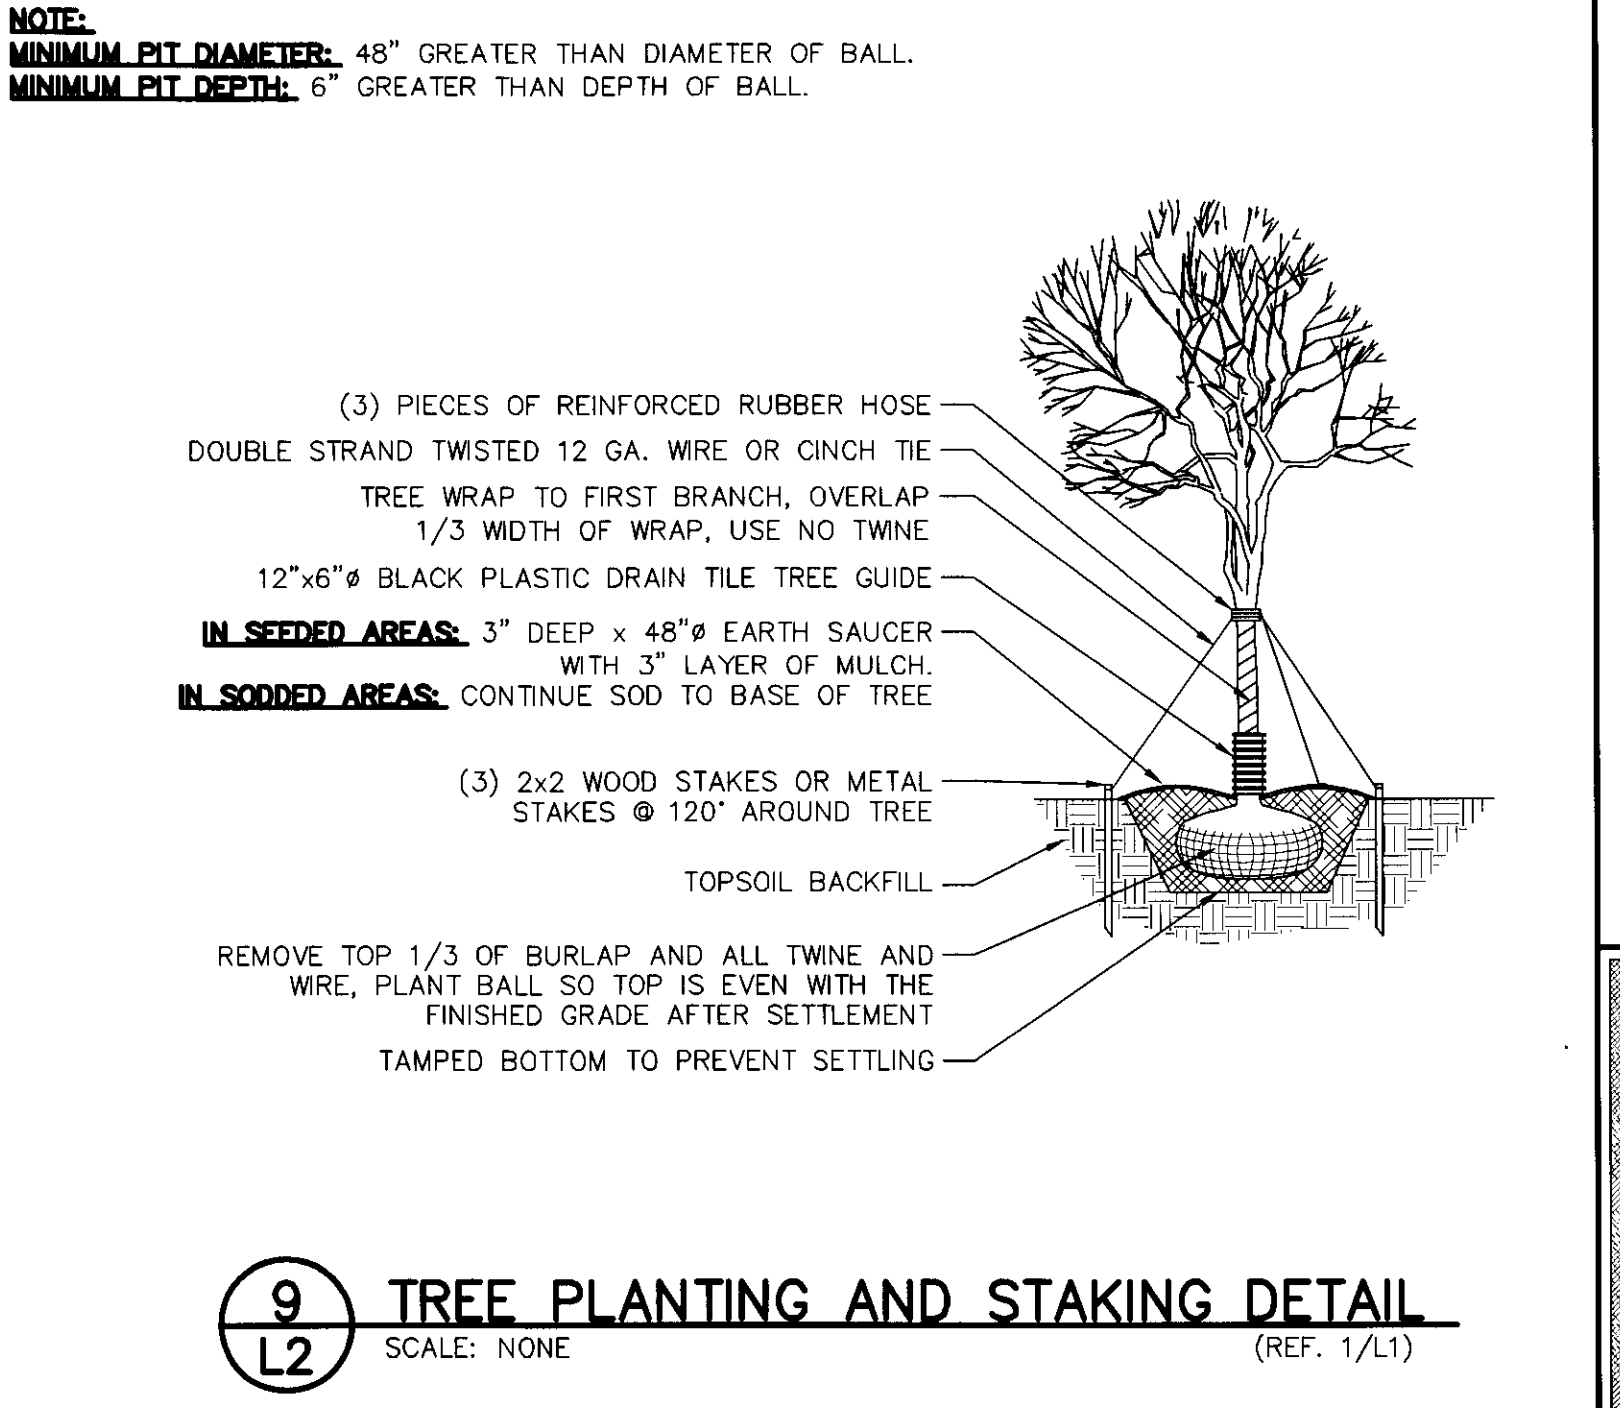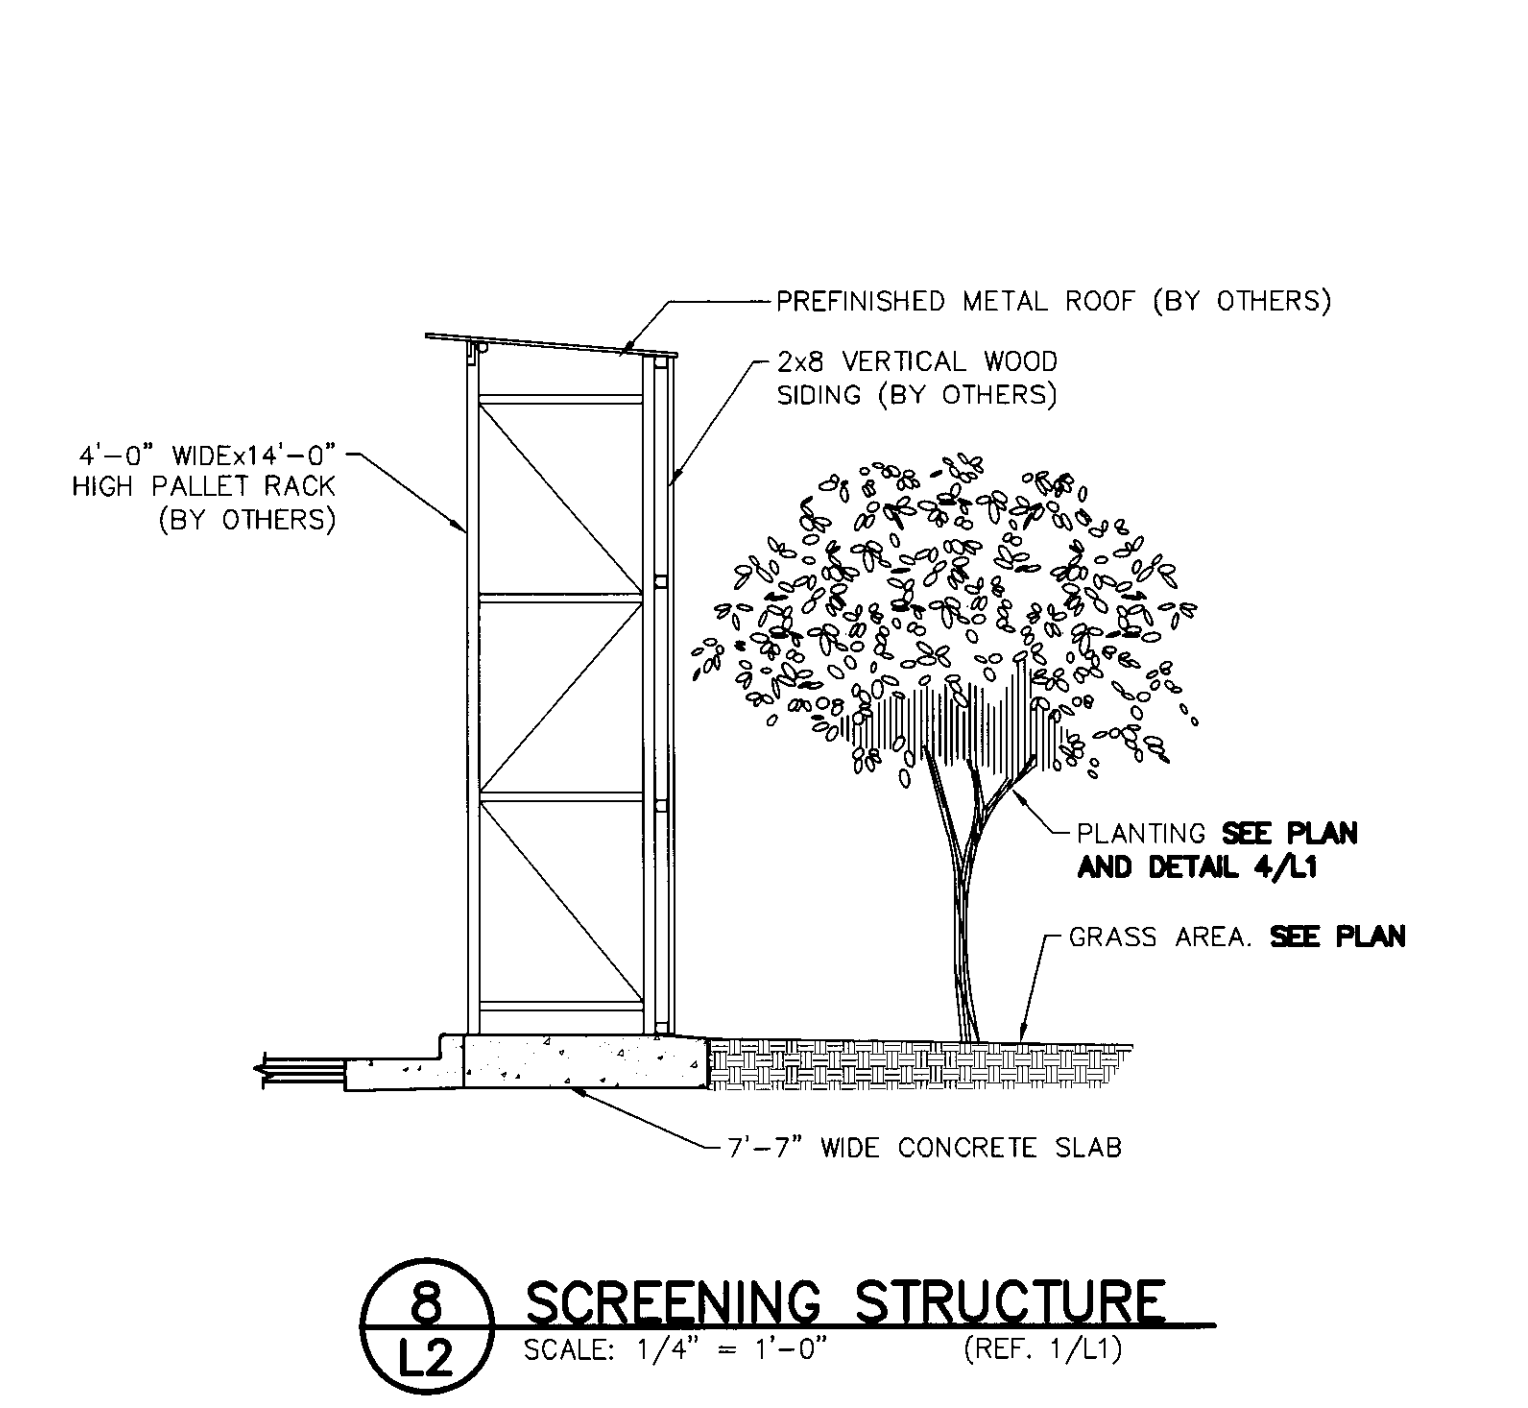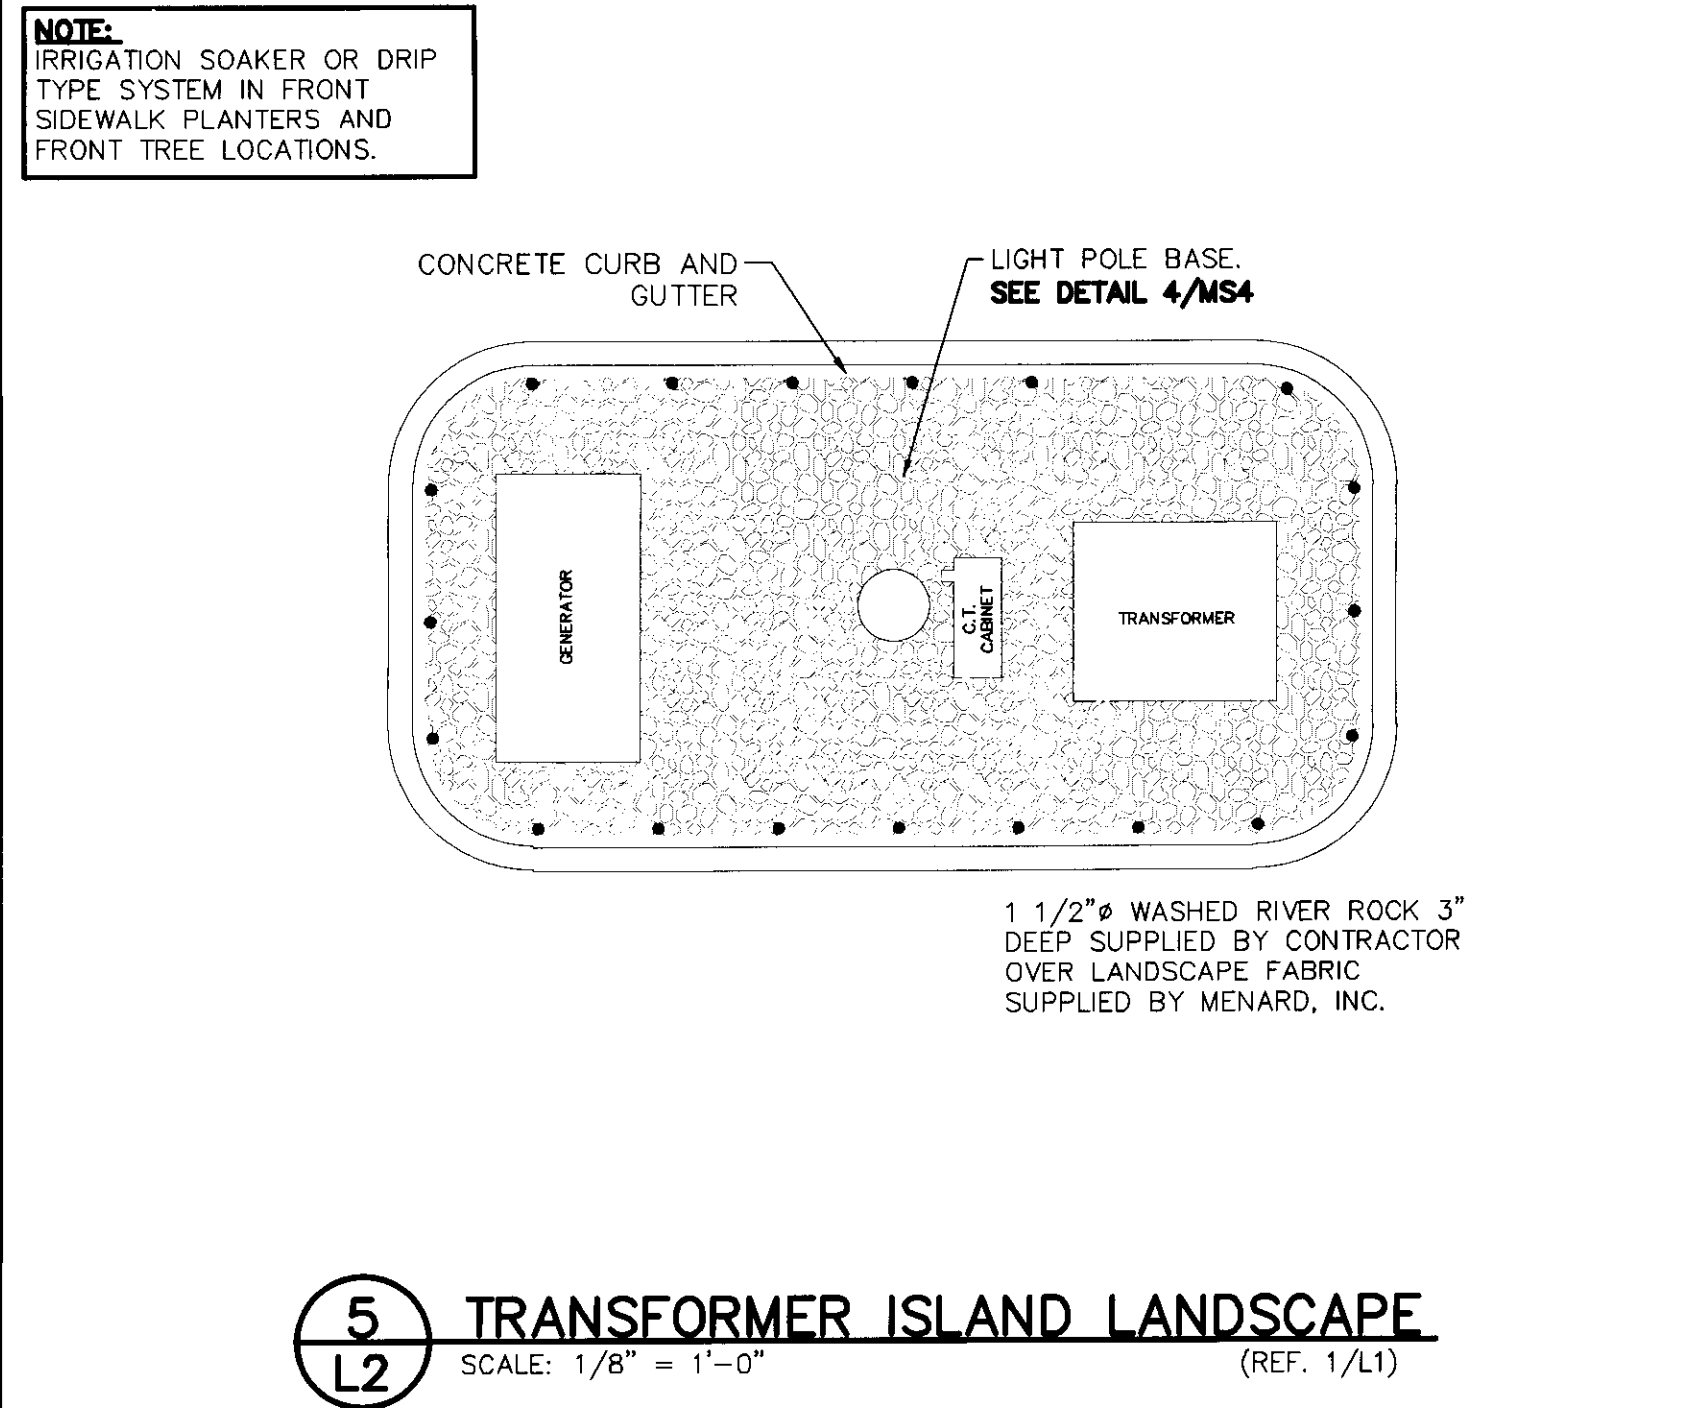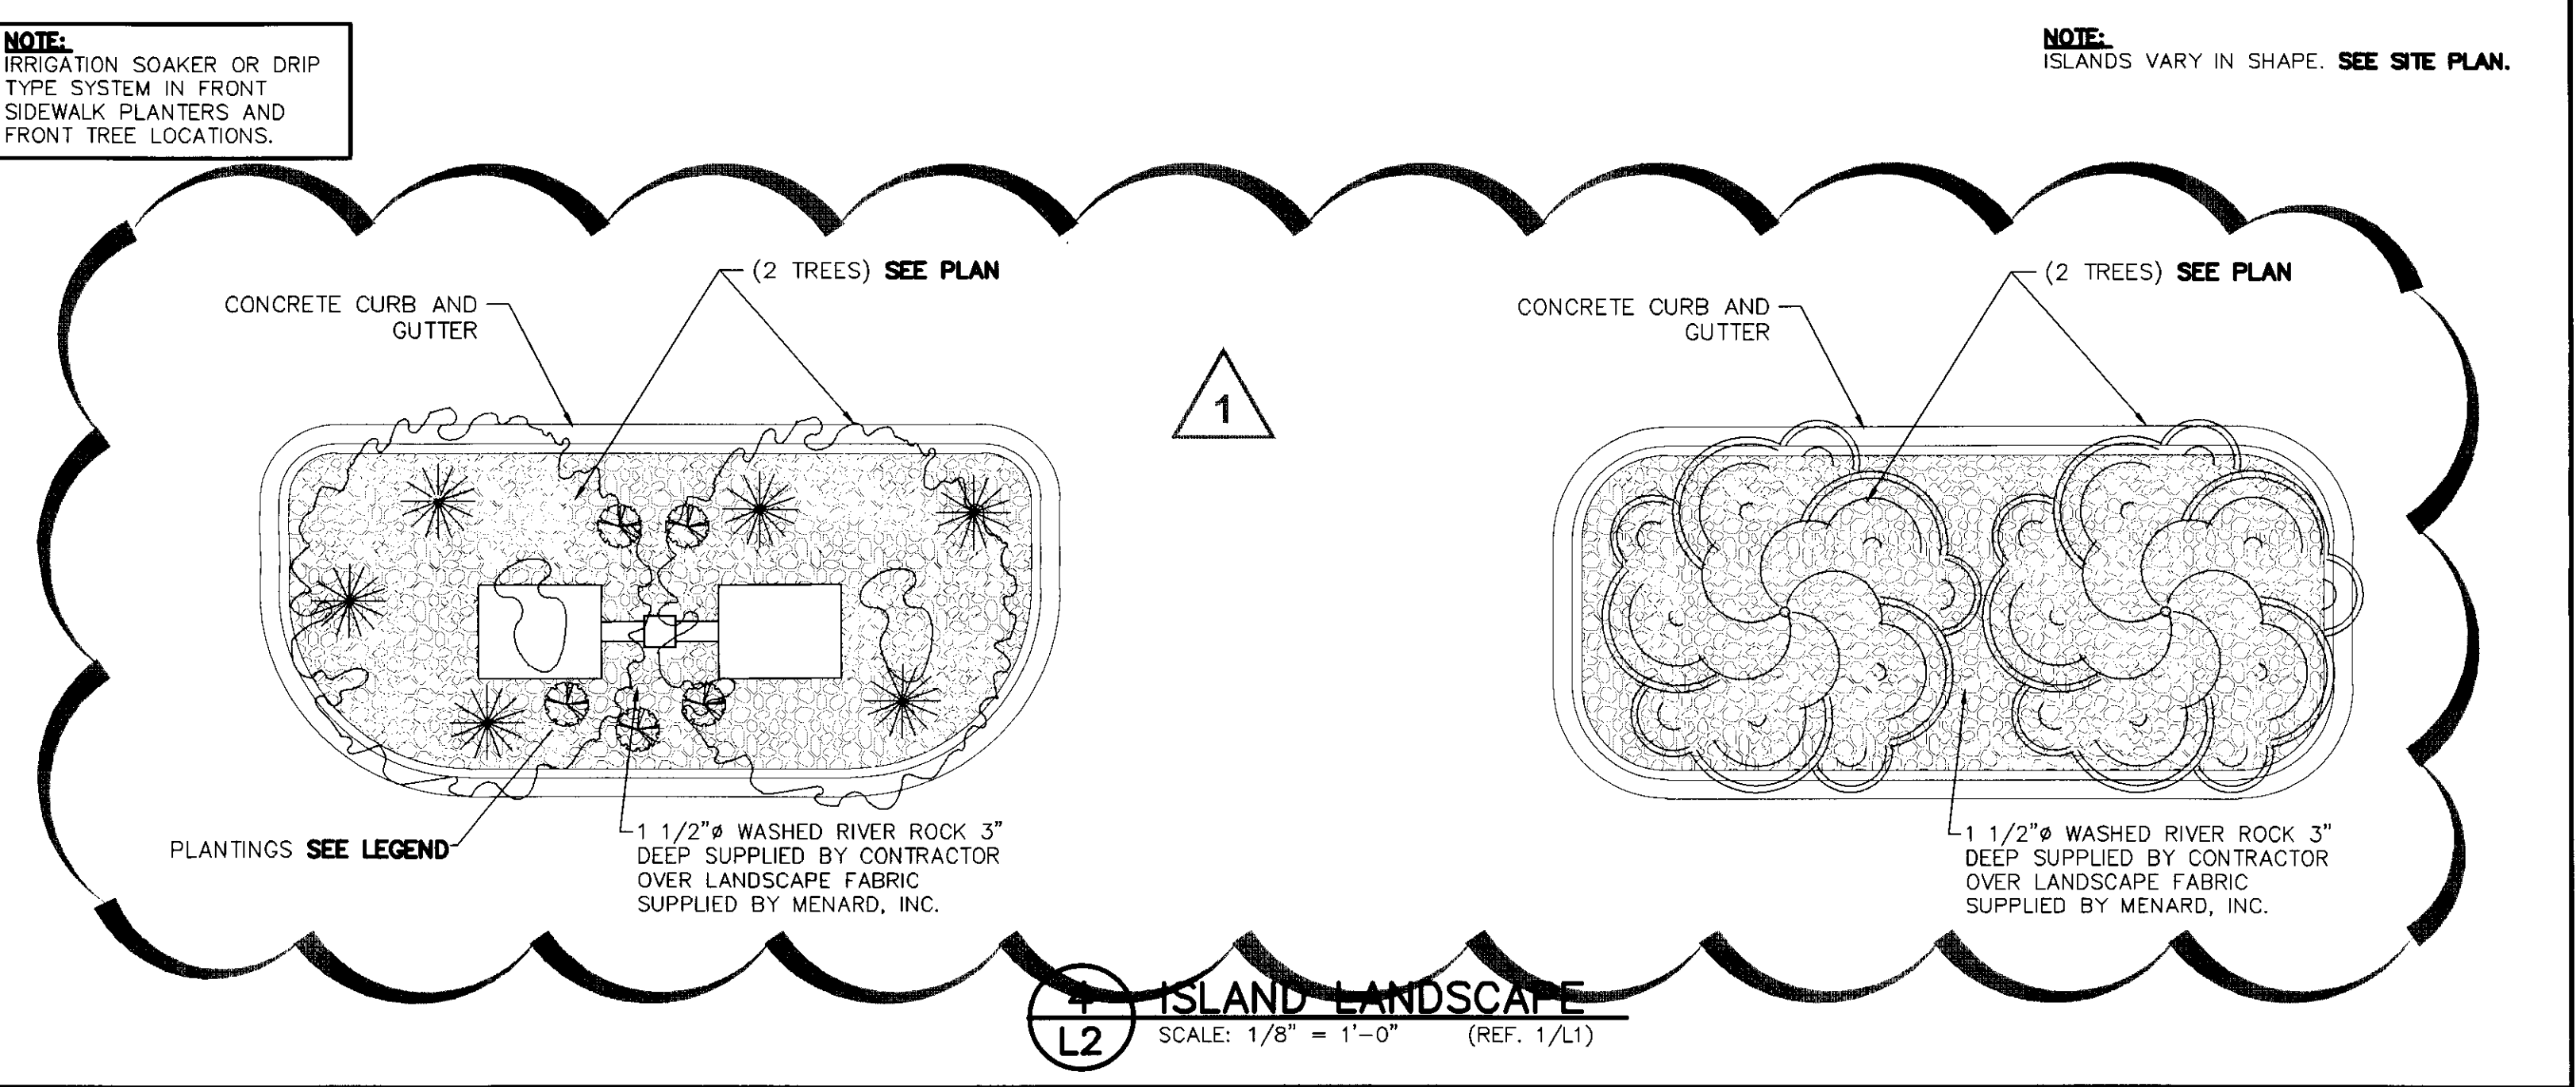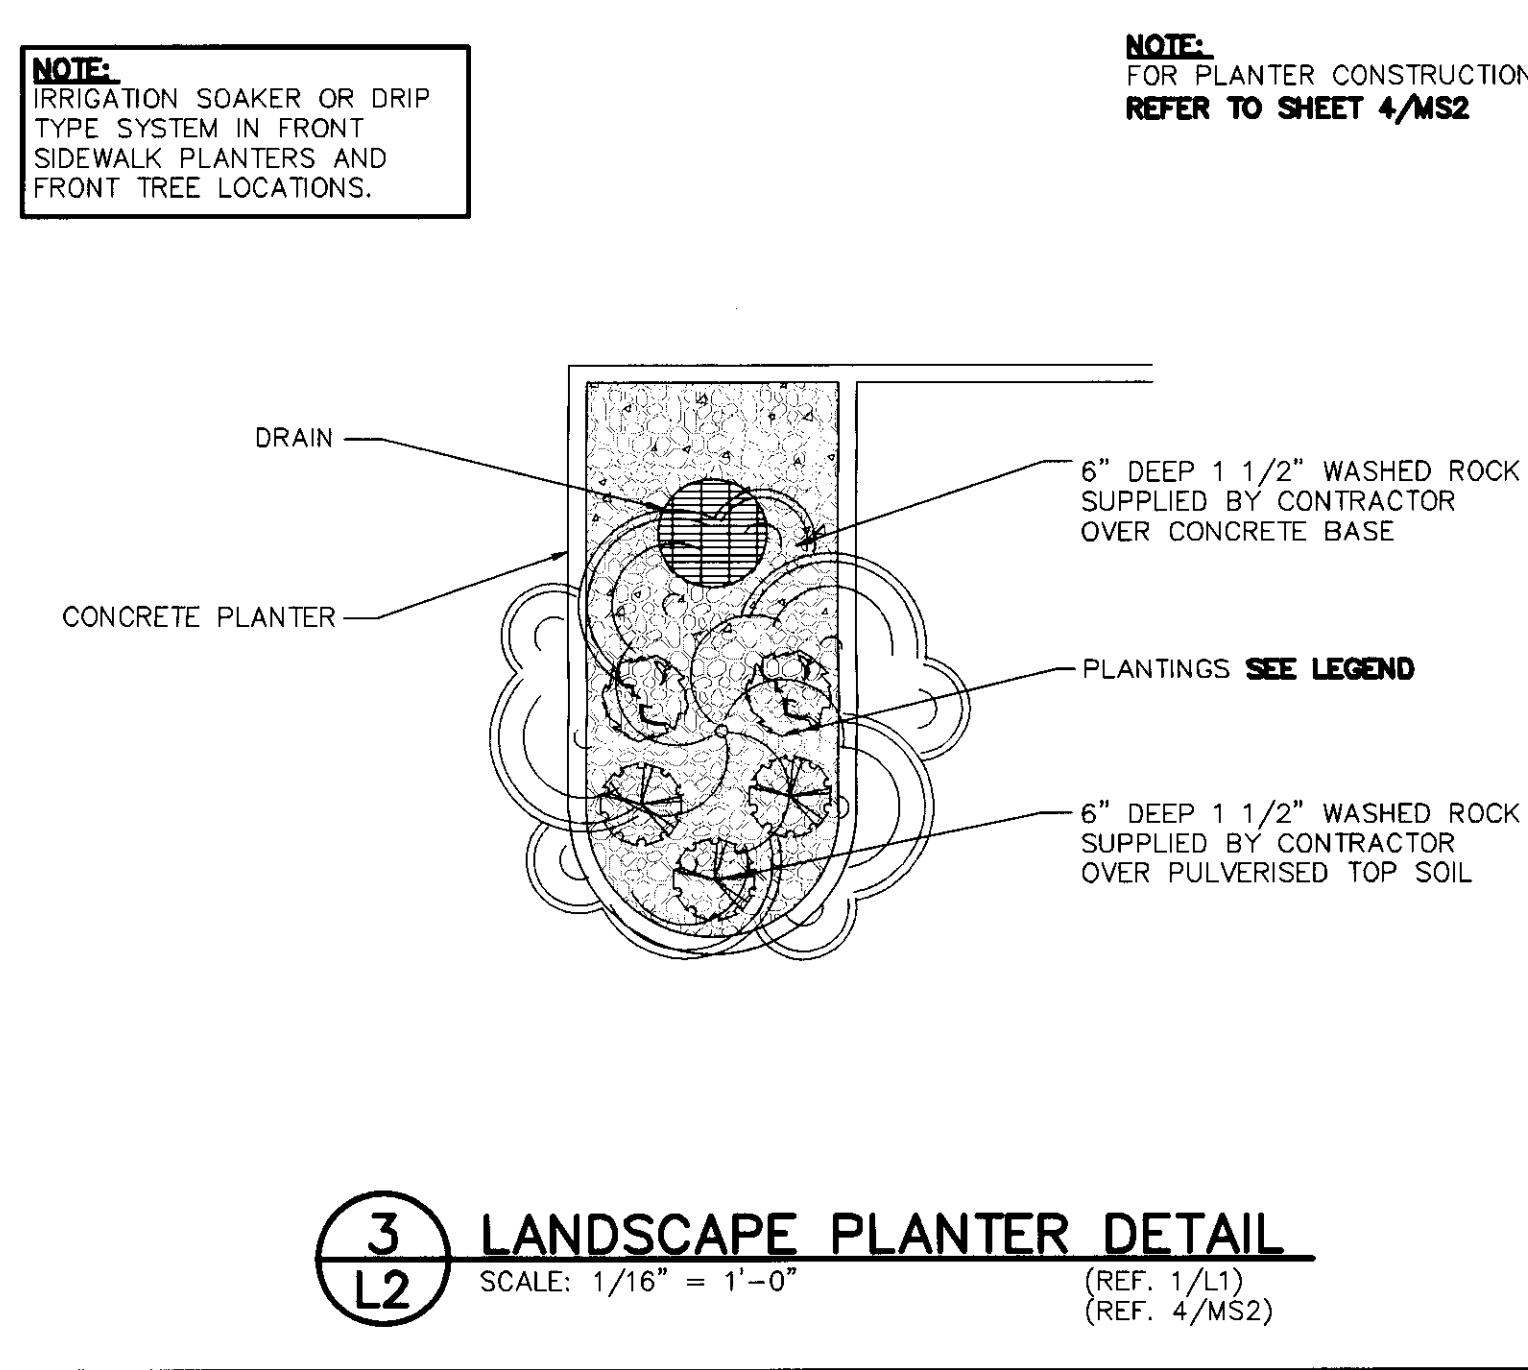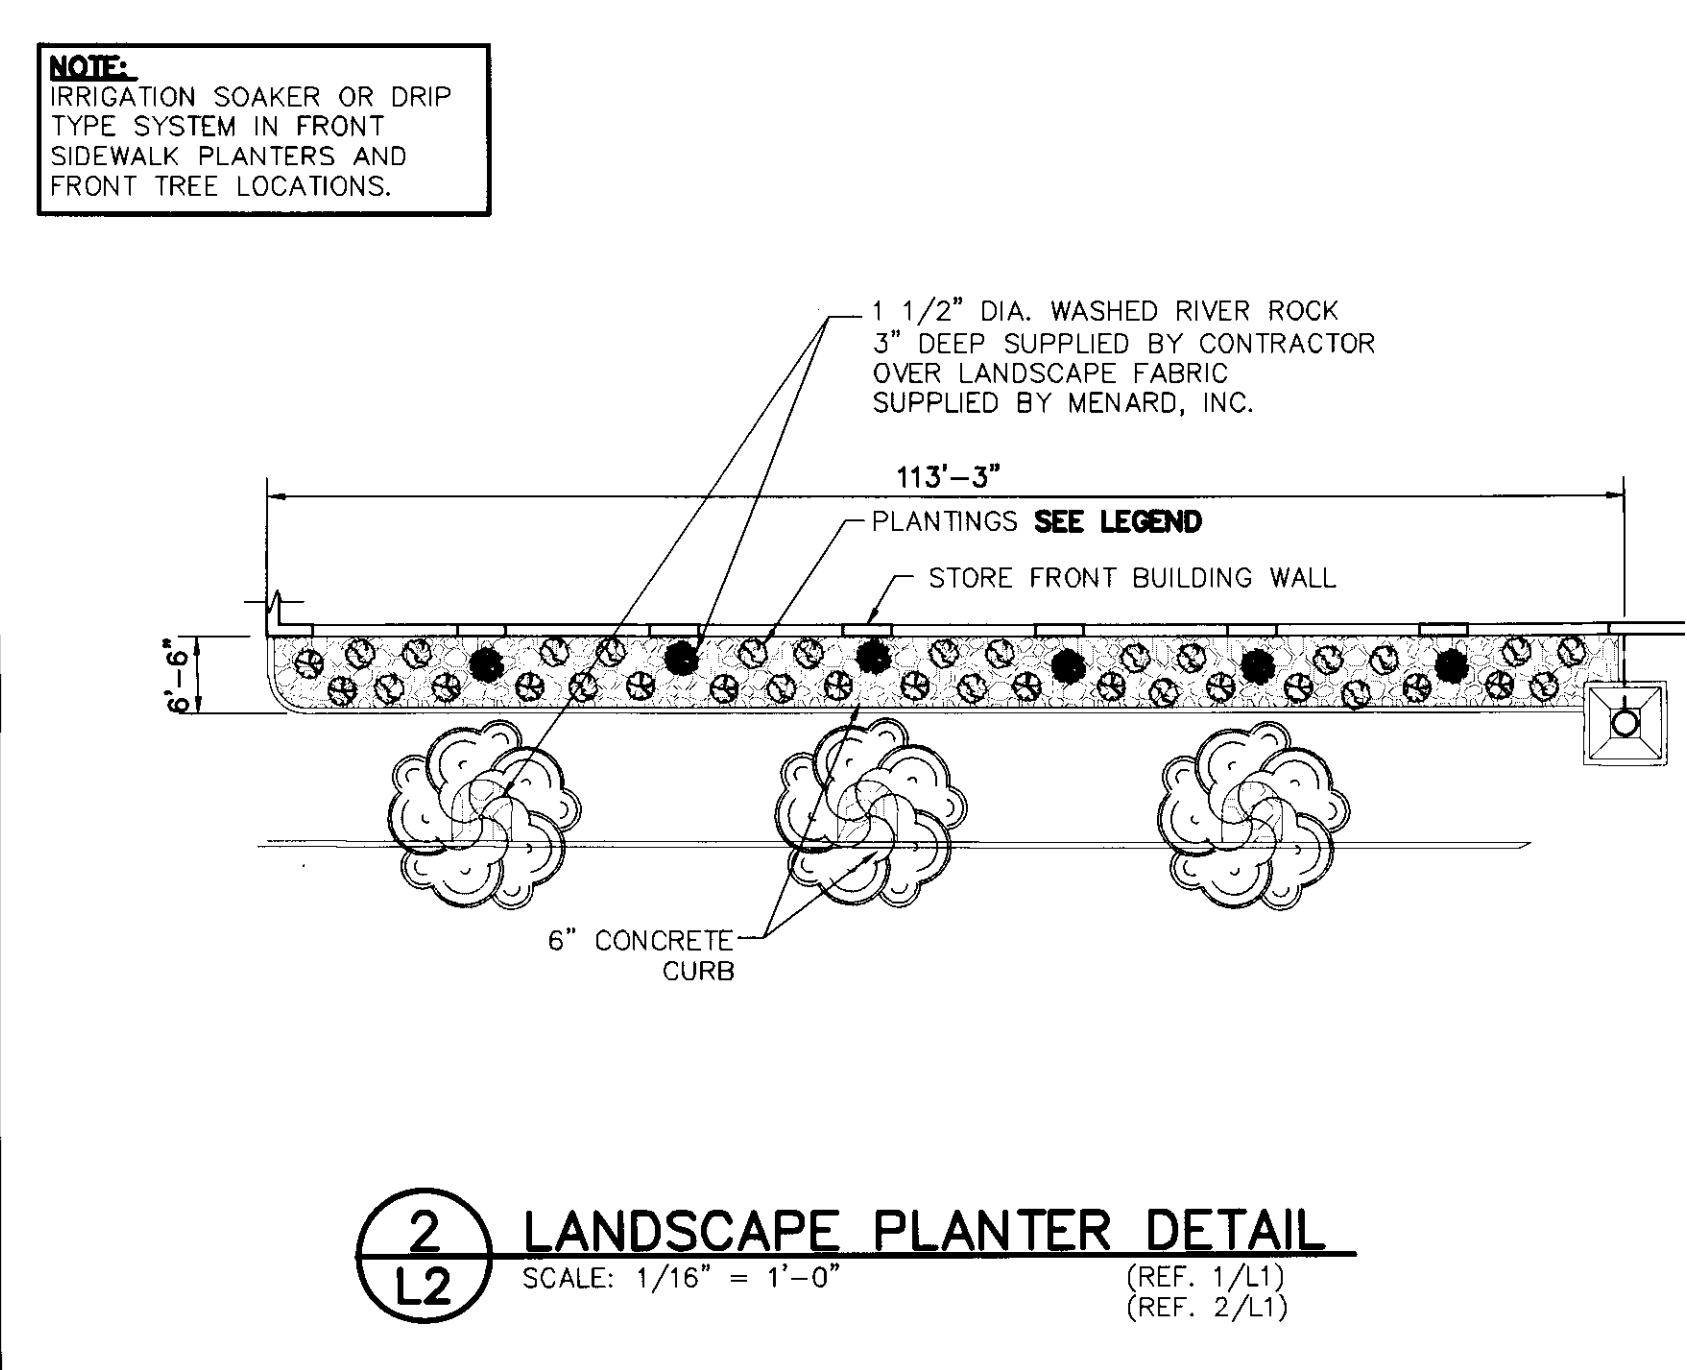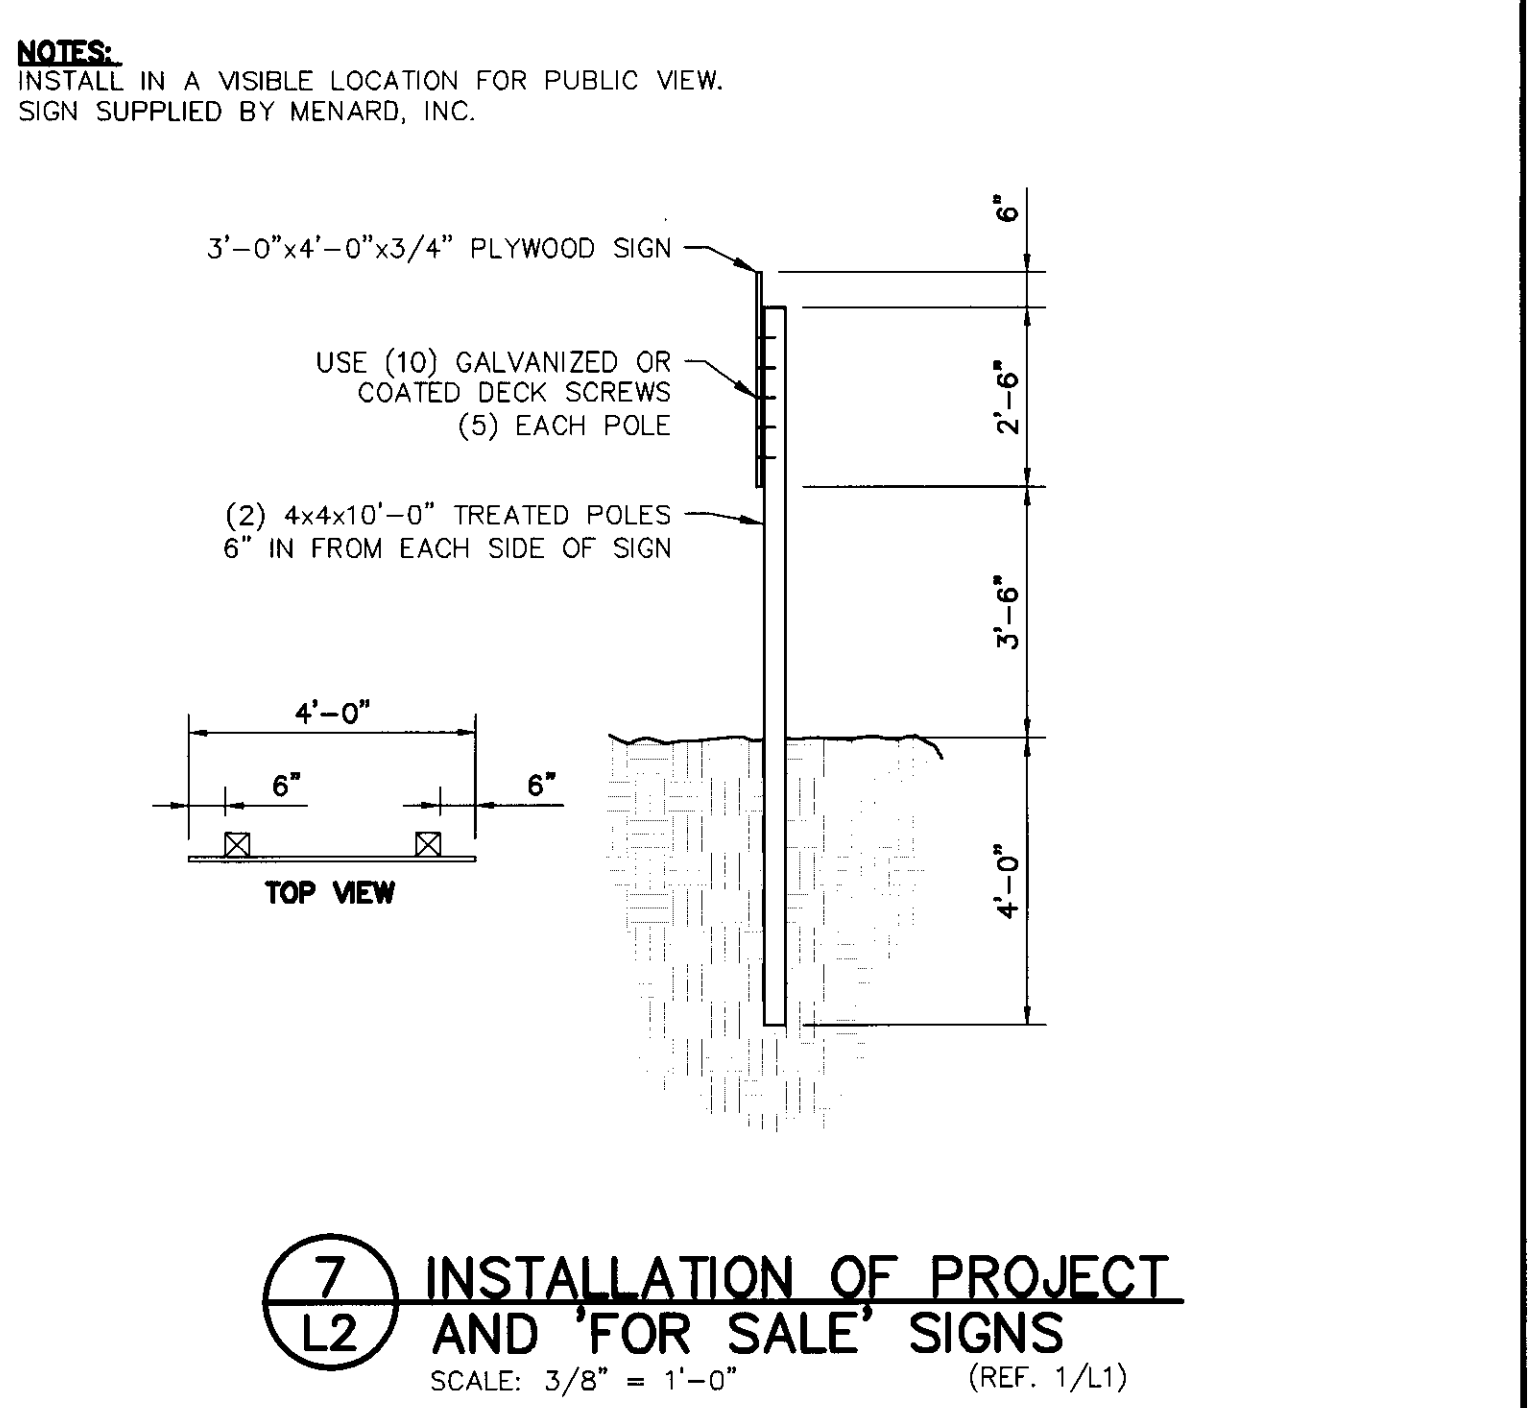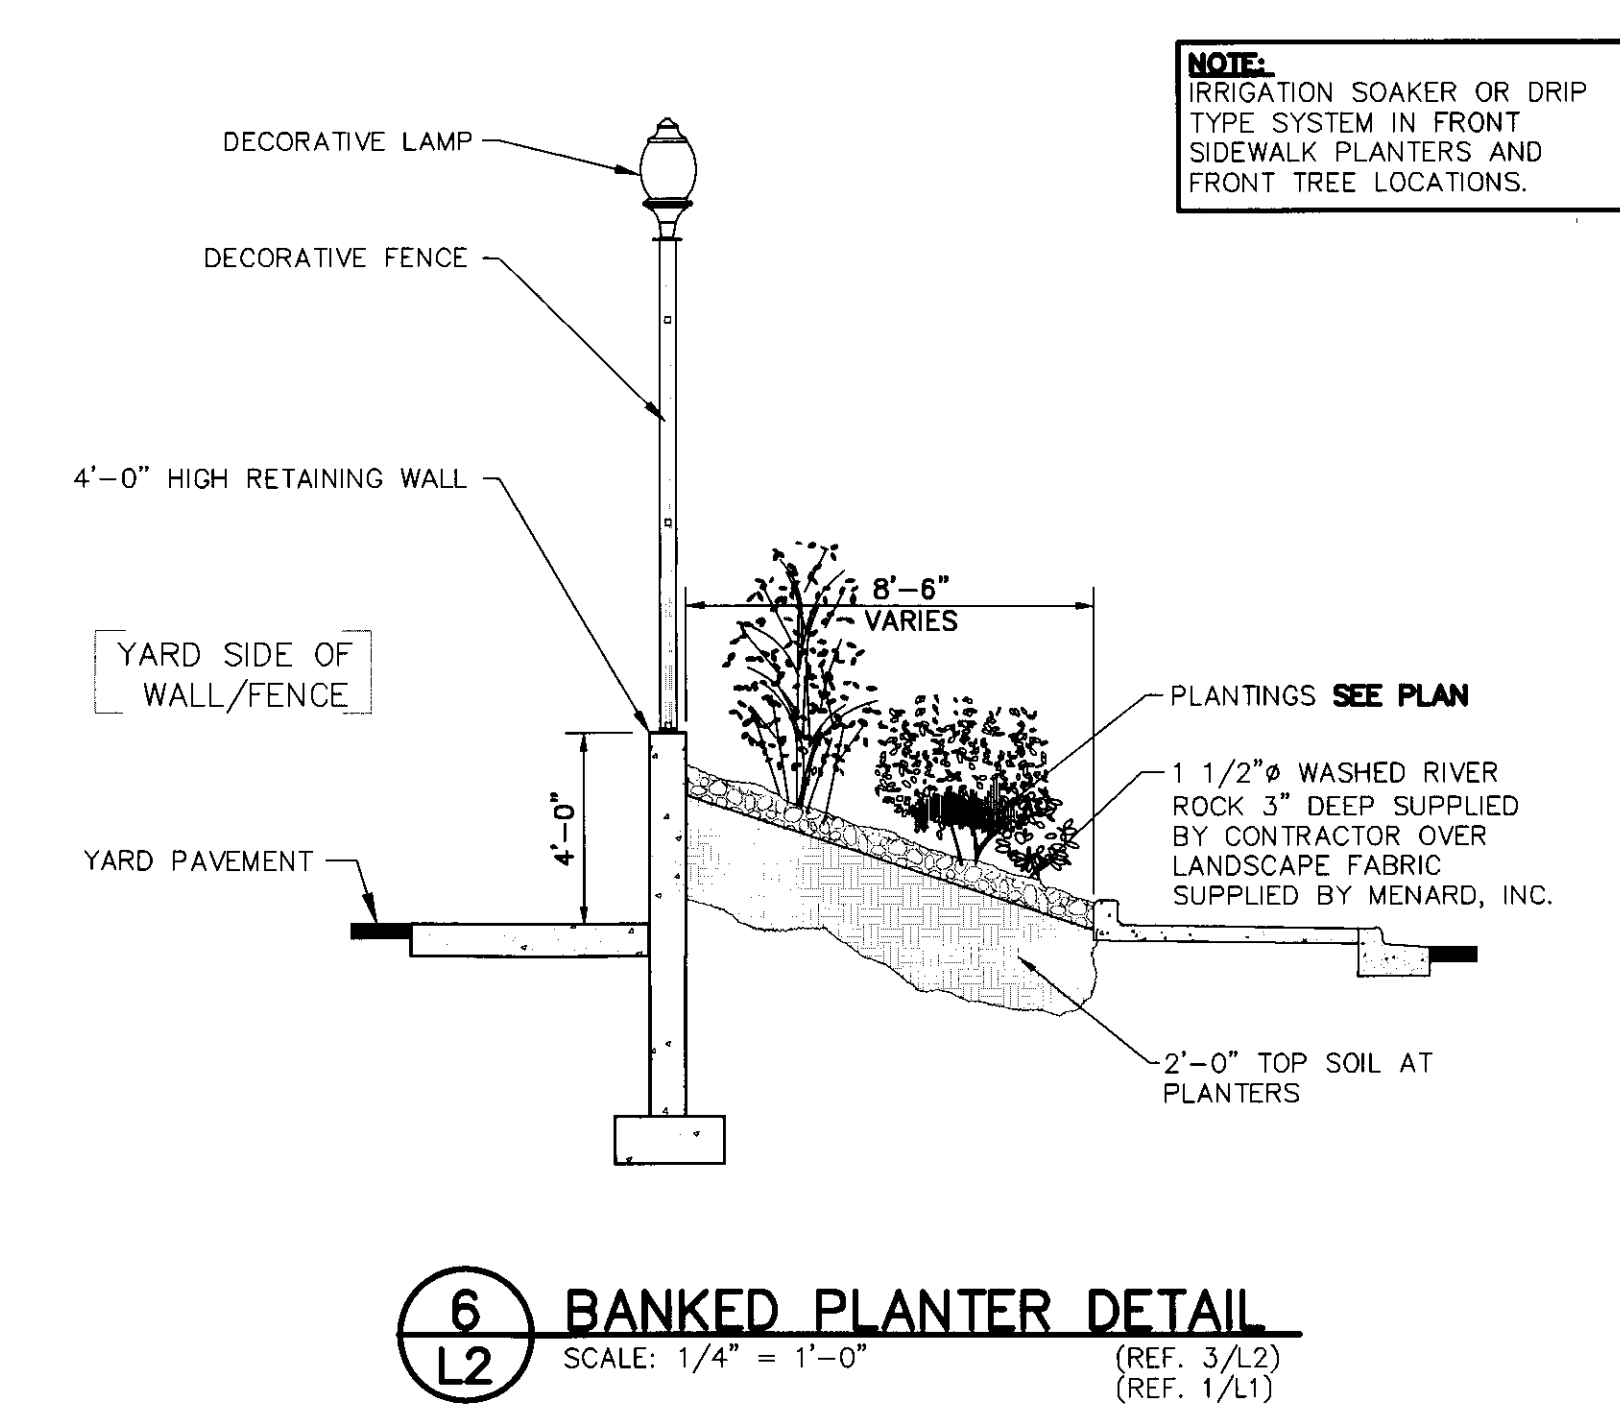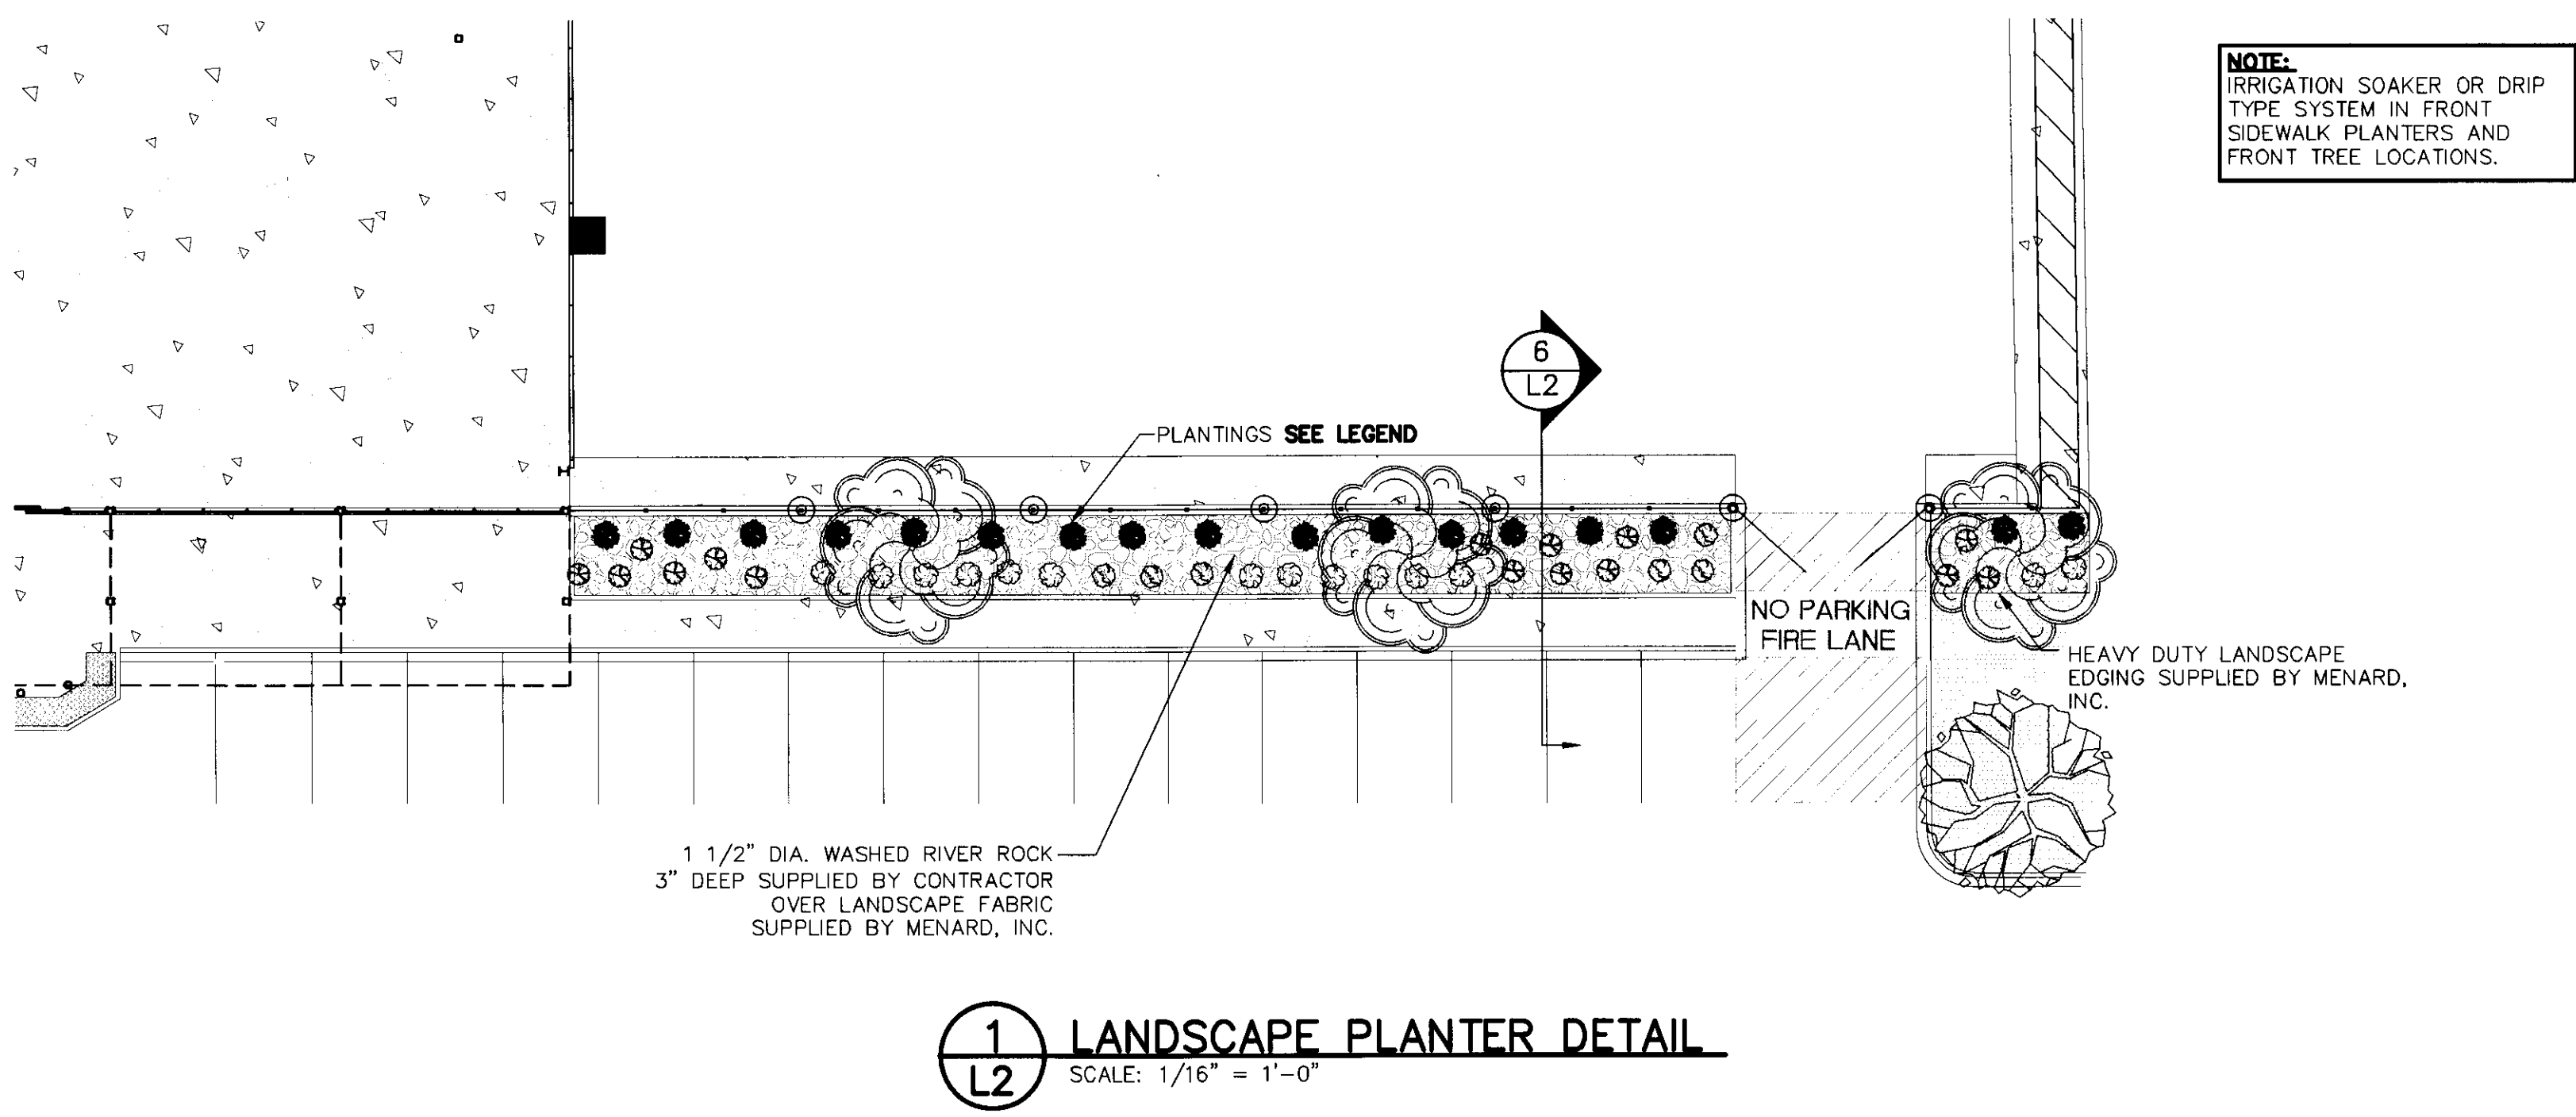

DP-295 PARCEL 11A & 11B

LANDSCAPE PLAN

APPROVED 08-04-10 BY DS


SHEET 2 of 2

MAPD COPY 1 of 2

LATEST REVISION		DESTROY ALL PREVIOUS ISSUES AT ONCE		DO NOT KEEP DUPLICATE COPIES	
DATE:		SIGNED:			

MENARD INC.		PROJECT TITLE	
STORE DESIGN DEPARTMENT		WICHITA, KS (WEST)	
EAU CLAIRE, WISCONSIN		SHEET TITLE	
LANDSCAPE DETAILS			

REVISIONS		BY		SHEET NO.	
NO.	DATE	DESCRIPTION	BY		
1	06-15-10	REVISE LANDSCAPING QUANTITIES	KWK		L2

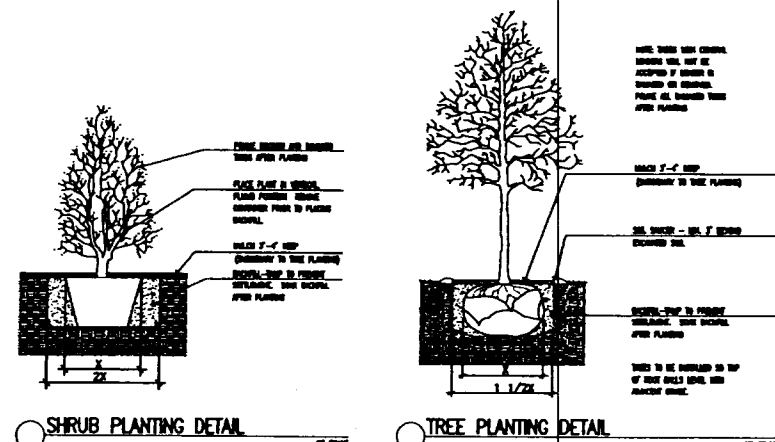

PLANT MATERIALS LIST					
KEY	QUANTITY	COMMON NAME	BOTANICAL NAME	SIZE	CONDITION
TREES					
HR	2	Hackberry	<i> Celtis occidentalis</i>	2' Cal.	B & B
LE	2	Lacoba's Elm	<i> Ulmus parvifolia</i>	2' Cal.	B & B
RM	1	Red Maple	<i> Acer rubrum 'Autumn Blaze'</i>	2' Cal.	B & B
SHO	6	Sheward Oak	<i> Quercus shewardii</i>	2' Cal.	B & B
SO	3	Southcoast Oak	<i> Quercus cascalensis</i>	2' Cal.	B & B
ZCA	2	Swart Crabapple	<i> Malus x zawi var. Calocarpa</i>	1.5' Cal.	B & B
SHRUBS / PERENNIALS					
BJ	9	Broadrunner Juniper	<i> Juniperus sabinne 'Broadrunner'</i>	5 Cal.	Cont. ; 4' O.C.
DHC	30	Dwarf Hameln Grass	<i> Pennstemon 'Aprocynanthus Hameln'</i>	2 Cal.	Cont. ; 2' O.C.
FRG	26	Fireweed 'Red' Grass	<i> Collinsia grandis x 'Scarlet' 'Red' 'Fireweed'</i>	2 Cal.	Cont. ; 2' O.C.
GLS	12	Grass-leaf Sumac	<i> Rhus glabra 'Grass-leaf'</i>	2 Cal.	Cont. ; 4' O.C.
KOR	7	Knock out Rose 'Redwood'	<i> Rosa x 'Redwood'</i>	5 Cal.	Cont. ; 4' O.C.
LB	26	Little Blueberry	<i> Scholachthymum scoparium</i>	2 Cal.	Cont. ; 2' O.C.
SJ	16	Sea Grass Juniper	<i> Juniperus chinensis 'Sea Grass'</i>	5 Cal.	Cont. ; 4' O.C.
LANDSCAPE MATERIALS					
500 AREA = 27,200 SF (KANGS PREMIUM BLEND FESQUE SOO) (TO BE IRRIGATED WITH SPINOS)					
SEED AREA = 3,700 SF (KANGS PREMIUM BLEND FESQUE SEED) (NO IRRIGATION)					
PLANTING BEDS ARE TO BE IRRIGATED WITH DRIP IRRIGATION, DRIP TUBING WITH 12" SPACING BY NUMBER OR EQUAL.					
MEDIAL EDGING = 125 LF. (BLACK OR GREEN MEDIAL EDGING - INSTALL PER MANUFACTURERS INSTRUCTIONS)					
GRADE A CEDAR MULCH = 23 CUBITS. (3-4" DEPTH FOR ALL TREE RINGS AND PLANTING BEDS)					

PVC PIPE SIZE (INCHES)	MAXIMUM FLOW (GPM)
1	18
1 1/4	28
1 1/2	36
2	56
2 1/2	80

IRRIGATION LEGEND	
■ ■ ■ ■	IRRIGATION SLEEVES (SCHEDULE 40 PVC REQUIRED UNDER VEHICULAR PAVING) CONTRACTOR TO VERIFY SIZE
C	CONTROLLER (MOUNT CONTROLLER ON BUILDING, REFERENCE ELECTRICAL PLANS. GET OWNER APPROVAL FOR LOCATION PRIOR TO INSTALLATION.) (WARRANT EX-LT MODULAR CONTROLLER OR EQUAL)
S	RAIN SENSOR (MOUNT ON BUILDING. GET OWNER APPROVAL FOR LOCATION PRIOR TO INSTALLATION.)
■	BACKFLOW PREVENTION WITH DARK GREEN FIREPROOF INSULATED ENCLOSURE. EZ BOX INSULATED DROP OVER ENCLOSURE BY HOT BOX WITH LOCK AND KEY. PLACE ON LEVEL GROUND WITH SURFACE DRAINAGE AWAY FROM ENCLOSURE.

LEGAL DESCRIPTION:
 LOT 5, EXCEPT THE EAST 54.87 FEET OF THE NORTH 250 FEET THEREOF, BLOCK 1,
 STONEBRIDGE COMMERCIAL ADDITION, AN ADDITION TO MIDWAY, SEDGWICK COUNTY, KANSAS.

LANDSCAPE CHAIRMAN'S RECOMMENDATIONS

LANDSCAPE STREET YARD
 REQUIRED: 5/17' (CROWN PROTRUSION) - 200' (GREATEST PERP. DISTANCE) = 370'
 370' / 2' = 185 5/8"
 PROVIDED: 5,550 SF

STREET YARD TREES REQUIRED = 12
 STREET YARD TREES PROVIDED = 13

PARKING LOT SCREENING
 PROVIDED BY 3' TALL GRASS BERM

SURVEY
 SURVEY

SURVEY PERFORMED BY SAVOY COMPANY, P.A.
SURVEY DATE: JUNE 27, 2012



PROFESSIONAL ENGINEERING CONSULTANTS, P.A.
303 SOUTH TOPEKA WICHITA, KS 67202
316-262-2691 www.pec1.com



▲	3-11-13	CITY COMMENTS
▲	3-13-13	ASR #1
Mark	Date:	Description

LANDSCAPE PLAN

Job No.	12329
Date	1/03/13
Drawn	CAE
Checked	IDK

C1.9

Dep. 9 of 24

CUP DP-295
Superceded 2/19/13 Plan

APPROVED
3/16/13
N69

NYPD
Copy 1 of 2

PLANTING SPECIFICATIONS


1. WHEN CLAY SOIL IS ENCOUNTERED IN THE ESTABLISHMENT OF THE LAWN OR THE INSTALLATION OF THE PLANT MATERIAL, IT SHALL BE IMPROVED IN ACCORDANCE WITH STANDARD TRADE PRACTICE, I.E. ADDITION OF LIME, GYPSUM, ETC.
2. REESTABLISH TURF IN ALL THE AREAS DISTURBED BY GRADING OR UTILITY TRENCHING IN THE R.O.W.
3. ALL PLANT MATERIAL SHALL BE WELL-FORMED AND DEVELOPED IN GOOD CONDITION, HEALTHY AND DISEASE-FREE, AND BE TYPICAL OF THE SPECIES. PLANTS SHALL COMPLY IN ALL APPLICABLE RESPECTS WITH ACCEPTABLE STANDARDS AS SET FORTH IN THE AMERICAN ASSOCIATION OF NURSERYMAN'S "AMERICAN STANDARD OF NURSERY STOCK". OWNER RESERVES THE RIGHT TO REJECT AT ANY TIME OR PLACE PRIOR TO FINAL ACCEPTANCE OF WORK, ANY AND ALL PLANTS WHICH IN THEIR OPINION FAIL TO MEET THESE SPECIFICATION REQUIREMENTS.
4. PLANTS DESIGNATED CONTAINER GROWN SHALL HAVE BEEN GROWN IN POTS, CANS OR BOXES FOR A MINIMUM OF SIX MONTHS AND A MAXIMUM OF TWO YEARS. THESE PLANTS SHALL BE REMOVED FROM CONTAINERS BEFORE PLANTING. PLANTS THAT APPEAR ROOT-BOUND SHALL BE ROOT-PRUNED THROUGH THE USE OF A VERTICAL SLICING METHOD PRIOR TO PLANTING.
5. WRAP ALL TREE TRUNKS SPIRALLY WITH APPROVED WRAPPING MATERIAL FROM GROUND TO THE FIRST BRANCH. SECURELY TIE WRAPPING AT THE TOP AND BOTTOM WITH MASKING TAPE. TREES SHALL BE SUPPORTED IMMEDIATELY AFTER PLANTING IN THE MANNER SHOWN ON TREE PLANTING DETAIL.
6. AFTER PLANTING IS COMPLETED, REPAIR INJURIES TO ALL PLANTS AS REQUIRED. LIMIT AMOUNT OF PRUNING TO A MINIMUM NECESSARY TO REMOVE DEAD OR INJURED TWIGS AND BRANCHES. PRUNE IN SUCH A MANNER AS NOT TO CHANGE NATURAL HABIT OR SHAPE OF PLANT. MAKE CUTS FLUSH, LEAVING NO STUBS.
7. PLANTING BEDS RECEIVING MULCH ARE TO BE FREE OF WEEDS AND GRASS. TREAT BEDS WITH A PRE-EMERGENT HERBICIDE PRIOR TO PLANTING AND MULCH PLACEMENT. APPLY IN ACCORDANCE WITH STANDARD TRADE PRACTICE.
8. GUARANTEE TREES AND SHRUBS FOR ONE CALENDAR YEAR FOLLOWING PROVISIONAL ACCEPTANCE OF THE OVERALL PROJECT. DURING THE GUARANTEE PERIOD, PLANTS THAT DIE DUE TO NATURAL CAUSES OR THAT ARE UNHEALTHY OR UNSIGHTLY IN CONDITION, SHALL BE REPLACED BY THE CONTRACTOR. PLANTS USED FOR THE REPLACEMENT SHALL BE OF THE SAME VARIETY AND SIZE AS ORIGINALLY SPECIFIED IN THE PLANT SCHEDULE. REPLACEMENTS SHALL BE MADE WITHIN TWO DAYS OF REQUEST PENDING FAVORABLE SEASONAL PLANTING TIMES.
9. GUARANTEE WILL NOT BE ENFORCED SHOULD THE PLANT MATERIAL DIE DUE TO VANDALISM, OVER OR UNDER WATERING BY THE OWNER, IMPROPER MAINTENANCE PROCEDURES CARRIED OUT BY THE OWNER INVOLVING LAWN MOWER DAMAGE, OVER FERTILIZATION, ACTS NOT RELATED TO CONTRACTUAL RESPONSIBILITIES OF CONTRACTOR OF SIMILAR CIRCUMSTANCES BEYOND THE CONTROL OF THE CONTRACTOR.
10. REMOVE ALL RUBBISH, EQUIPMENT AND MATERIAL AND LEAVE THE AREA IN A NEAT, CLEAN CONDITION EACH DAY. MAINTAIN PAVED AREAS UTILIZED FOR HAULING EQUIPMENT AND MATERIALS BY OTHER TRADES IN A CLEAN AND UNOBSTRUCTED CONDITION AT ALL TIMES. REMOVE SOIL OR DIRT THAT ACCUMULATED DURING OR AS A RESULT OF PLANTING OPERATIONS EACH DAY.
11. AT THE COMPLETION OF PLANTING OPERATIONS, ALL PLANTS SHALL BE INSPECTED BY THE OWNER. CONTRACTOR SHALL REPLACE IMMEDIATELY ANY PLANTS NOT IN HEALTHY AND VIGOROUS CONDITION AT THAT TIME AT NO EXPENSE TO THE OWNER. ANY PLANT NOT IN HEALTHY CONDITION AFTER ONE FULL YEAR FROM THE DATE OF FINAL ACCEPTANCE SHALL BE REPLACED AS PER THE ORIGINAL SPECIFICATIONS, FREE OF CHARGE TO THE OWNER.
12. LANDSCAPE CONTRACTOR TO REMOVE TREE STAKES, TREE WRAP, AND REMOVE ALL DEAD WOOD ON TREES AND SHRUBS ONE YEAR AFTER FINAL ACCEPTANCE.
13. NO SUBSTITUTIONS SHALL BE ALLOWED WITHOUT APPROVAL.
14. ANY PLANTING BED ADJACENT TO WALKS OR CURBING SHALL HAVE THE GRADE TO A SUFFICIENT DEPTH TO ALLOW TOP OF THE MULCH TO MATCH THE TOP OF WALK OR CURBING.
15. FERTILIZER WITH MILORGANITE, DISTRIBUTED UNIFORMLY AT THE RATE OF 1000 POUNDS PER ACRE.
16. SUBMIT TYPEWRITTEN INSTRUCTIONS RECOMMENDING PROCEDURES TO BE ESTABLISHED BY OWNER FOR MAINTENANCE OF LANDSCAPE WORK.
17. LABEL AT LEAST 1 TREE, 1 SHRUB, AND 1 GROUND COVER OF EACH VARIETY WITH A SECURELY ATTACHED WATERPROOF TAG BEARING LEGIBLE DESIGNATION OF BOTANICAL AND COMMON NAMES.
18. PLANT TREES, SHRUBS AND GROUND COVERS DURING NORMAL SEASON FOR SUCH WORK. DO NOT PLANT IN FROZEN GROUND.
19. MAINTAIN PLANT MATERIAL UNTIL FINAL ACCEPTANCE BY OWNER. MAINTENANCE CONSISTS OF SPRAYING PRUNING, WATERING AND WEEDING AS REQUIRED FOR HEALTHY GROWTH. REMOVE AND REPLACE PLANT MATERIAL FOUND TO BE DEAD OR IN AN UNHEALTHY CONDITION.

GENERAL PLANTING NOTES

1. PRIOR TO BEGINNING ANY WORK ON THE SITE, THE CONTRACTOR SHALL CONTACT THE OFFICE OF THE OWNER AND THE ARCH./LANDSCAPE ARCH. FOR SPECIFIC INSTRUCTIONS RELEVANT TO THE SEQUENCING OF THE WORK.
2. LANDSCAPE CONTRACTOR SHALL PROVIDE ALL LABOR, MATERIALS AND SERVICE NECESSARY TO FURNISH AND INSTALL PLANTINGS AS SPECIFIED HEREIN AND AS SHOWN ON THESE PLANS.
3. NO MATERIAL SUBSTITUTIONS SHALL BE MADE WITHOUT LANDSCAPE ARCH. OR OWNER'S REPRESENTATIVE'S APPROVAL. ALTERNATE MATERIALS OF SIMILAR SIZE AND CHARACTER MAY BE CONSIDERED IF SPECIFIED PLANT MATERIALS CANNOT BE OBTAINED. LANDSCAPE ARCH. RESERVES THE RIGHT TO REVISE PLANT LIST AS DEEMED NECESSARY.
4. ALL PLANT LOCATIONS ARE APPROXIMATE. ADJUST AS NECESSARY TO AVOID CONFLICTS.
5. UTILITIES HAVE BEEN SHOWN ON THE PLAN FOR ROUGH LOCATION OF SERVICES. CONTRACTOR SHALL LOCATE ALL UTILITIES BEFORE WORK. LOCATE EXACT UTILITY LOCATIONS BY CONTACTING KANSAS ONE-CALL CENTER. CONTRACTOR WILL BE RESPONSIBLE FOR THE REPAIR OF ANY DAMAGE HE MAY CAUSE TO UTILITIES.
6. SOD TYPE SHALL BE LOCALLY AVAILABLE HARDY BLEND OF TALL FESCUE.
7. RE-ESTABLISH TURF IN AREAS DISTURBED BY GRADING OR UTILITY TRENCHING IN THE R.O.W.
8. RE-ESTABLISH TURF IN ALL AREAS DISTURBED BY THE CONSTRUCTION PROCESS AND WITHIN THE LIMITS OF DISTURBANCE BY SEED, SOD OR PLANNED PLANTING AREAS, AS NOTED ON PLAN.
9. BACKFILL FOR PLANT EXCAVATIONS TO BE CLEAN NATURAL SOIL, EXCAVATED FROM PLANTING PITS MIXED WITH COMPOST AND WELL-ROTTED MANURE AT A RATIO OF THREE (3) PARTS SOIL TO ONE (1) PART COMPOST AND WELL-ROTTED MANURE.
10. FERTILIZE ALL PLANTS WITH 6-10-4 COMMERCIAL FERTILIZER AS DIRECTED BY INSTRUCTIONS ON FERTILIZER.
11. ALL PLANT MATERIALS SHALL HAVE BACKFILL CAREFULLY PLACED AROUND BASE AND SIDES OF BALL TO TWO-THIRDS (2/3) DEPTH OF BALL, THEN THOROUGHLY SOAKED WITH WATER TO ALLOW SETTLEMENT. ALL WIRE, BURLAP FASTENERS AND LOOSE BURLAP AROUND BASE OF TRUNK SHALL BE REMOVED AT THIS TIME. REMAINDER OF PIT SHALL THEN BE BACKFILLED, ALLOWING FOR DEPTH OF MULCH, SAUCER AND SETTLEMENT OF BACKFILL. BACKFILL SHALL THEN BE THOROUGHLY WATERED ONCE AGAIN.
12. ALL PLANT MATERIALS SHALL BE PROTECTED FROM THE DRYING ACTION OF THE SUN AND WIND AFTER BEING DUG, WHILE BEING TRANSPORTED, AND WHILE AWAITING PLANTING. BALLS OF PLANTS WHICH CANNOT BE PLANTED IMMEDIATELY SHALL BE PROTECTED FROM DRYING ACTION BY COVERING THEM WITH MOIST MULCH. PERIODICALLY, APPLY WATER TO MULCH-COVERED BALLS TO KEEP MOIST. IF PLANTING SHOULD OCCUR DURING GROWING SEASON, APPLY ANTI-DESSICANT TO LEAVES BEFORE TRANSPORT TO REDUCE LIKELIHOOD OF WINDBURN. REAPPLY ANTI-DESSICANT AFTER PLANTING TO REDUCE TRANSPIRATION.
13. STEEL EDGER BY "PROSTEEL, INC.". EDGER TO BE 10 GAUGE (1/8" X 4" HIGH) AND PAINTED GREEN. INSTALL AS PER MANUFACTURER'S RECOMMENDATIONS. TOP OF EDGER TO ALIGN WITH SIDEWALK/CURB WHERE OCCURS. GRADE TO BE 1: BELOW TOP OF EDGER ON LAWN SIDE. REFER TO EDGER DETAIL.
14. USE SHREDDED CEDAR WOOD MULCH IN ALL PLANTING BEDS. LANDSCAPE CONTRACTOR TO PROVIDE SAMPLE TO LANDSCAPE ARCHITECT OR OWNER'S REPRESENTATIVE FOR APPROVAL.
15. PLACE 4" OF MULCH IN ALL TREE SAUCERS. PLANTING BEDS RECEIVING MULCH ARE TO BE FREE OF WEEDS AND GRASS.
16. THE CONTRACTOR SHALL PROVIDE ALL WATER, WATERING DEVICES AND LABOR NEEDED TO IRRIGATE PLANT MATERIALS UNTIL ACCEPTANCE OF THE PROJECT'S PLANT MATERIALS. THE CONTRACTOR SHALL SUPPLY ENOUGH WATER TO MAINTAIN THE PLANT'S HEALTHY CONDITION.
17. LANDSCAPE CONTRACTOR TO REMOVE TREE STAKES AND ALL DEAD WOOD ON TREES ONE YEAR AFTER PROVISIONAL/FINAL ACCEPTANCE.
18. REPORT ANY DISCREPANCIES IN THE PLANTING PLAN TO THE LANDSCAPE ARCHITECT PRIOR TO STARTING CONSTRUCTION.

GENERAL IRRIGATION NOTES

1. THE IRRIGATION SYSTEM TO BE PROVIDED BY THE GENERAL CONTRACTOR. THE SYSTEM IS TO COVER THE ENTIRE PLANTED AREA AS SHOWN ON PLAN.
2. PLANS SHALL BE SUBMITTED TO THE ARCHITECT FOR REVIEW. SUBMITTALS SHALL INCLUDE IRRIGATION DESIGN DRAWINGS AND MANUFACTURER'S TECHNICAL DATA SUFFICIENT TO EXHIBIT THE CONTRACTOR'S INTENDED SYSTEM DESIGN. PLANS SHALL BE TO SCALE AND WELL DRAWN. QUANTITIES AND TYPES OF HEADS, VALVES AND CONTROLLER SHALL BE LISTED. SUBMIT PROJECT RECORD (AS BUILT) DRAWINGS PROVIDING A PERMANENT RECORD OF THIS WORK AT COMPLETION OF THE PROJECT.
3. THE IRRIGATION CONTRACTOR SHALL COORDINATE WORK WITH THE ELECTRICAL CONTRACTOR.
4. VERIFY EXISTING STATIC PRESSURE PRIOR TO DESIGNING THE SYSTEM. THE CITY WATER SUPPLY WILL BE THE SOURCE OF WATER FOR THE SYSTEM.
5. COORDINATE IRRIGATION SYSTEM INSTALLATION WITH LANDSCAPE WORK.
6. THE IRRIGATION SYSTEM IS TO BE DESIGNED WITH RAIN BIRD SPRINKLER MANUFACTURING CO. OR EQUAL PRODUCTS AND MATERIALS. OTHER MANUFACTURERS AS APPROVED BY ARCHITECT
7. COORDINATE LOCATION OF THE CONTROLLER WITH THE OWNER.
8. INSTALL BACKFLOW PREVENTER, SHUT OFF VALVE AND MANUAL DRAIN VALVE PER LOCAL PLUMBING CODES. PROVIDE PLASTIC TRUNCATED ENCLOSURE FOR THE BACKFLOW PREVENTER AS PROVIDED BY THE MANUFACTURER.
9. PROVISIONS SHALL BE MADE TO WINTERIZE THE PIPING SYSTEM.

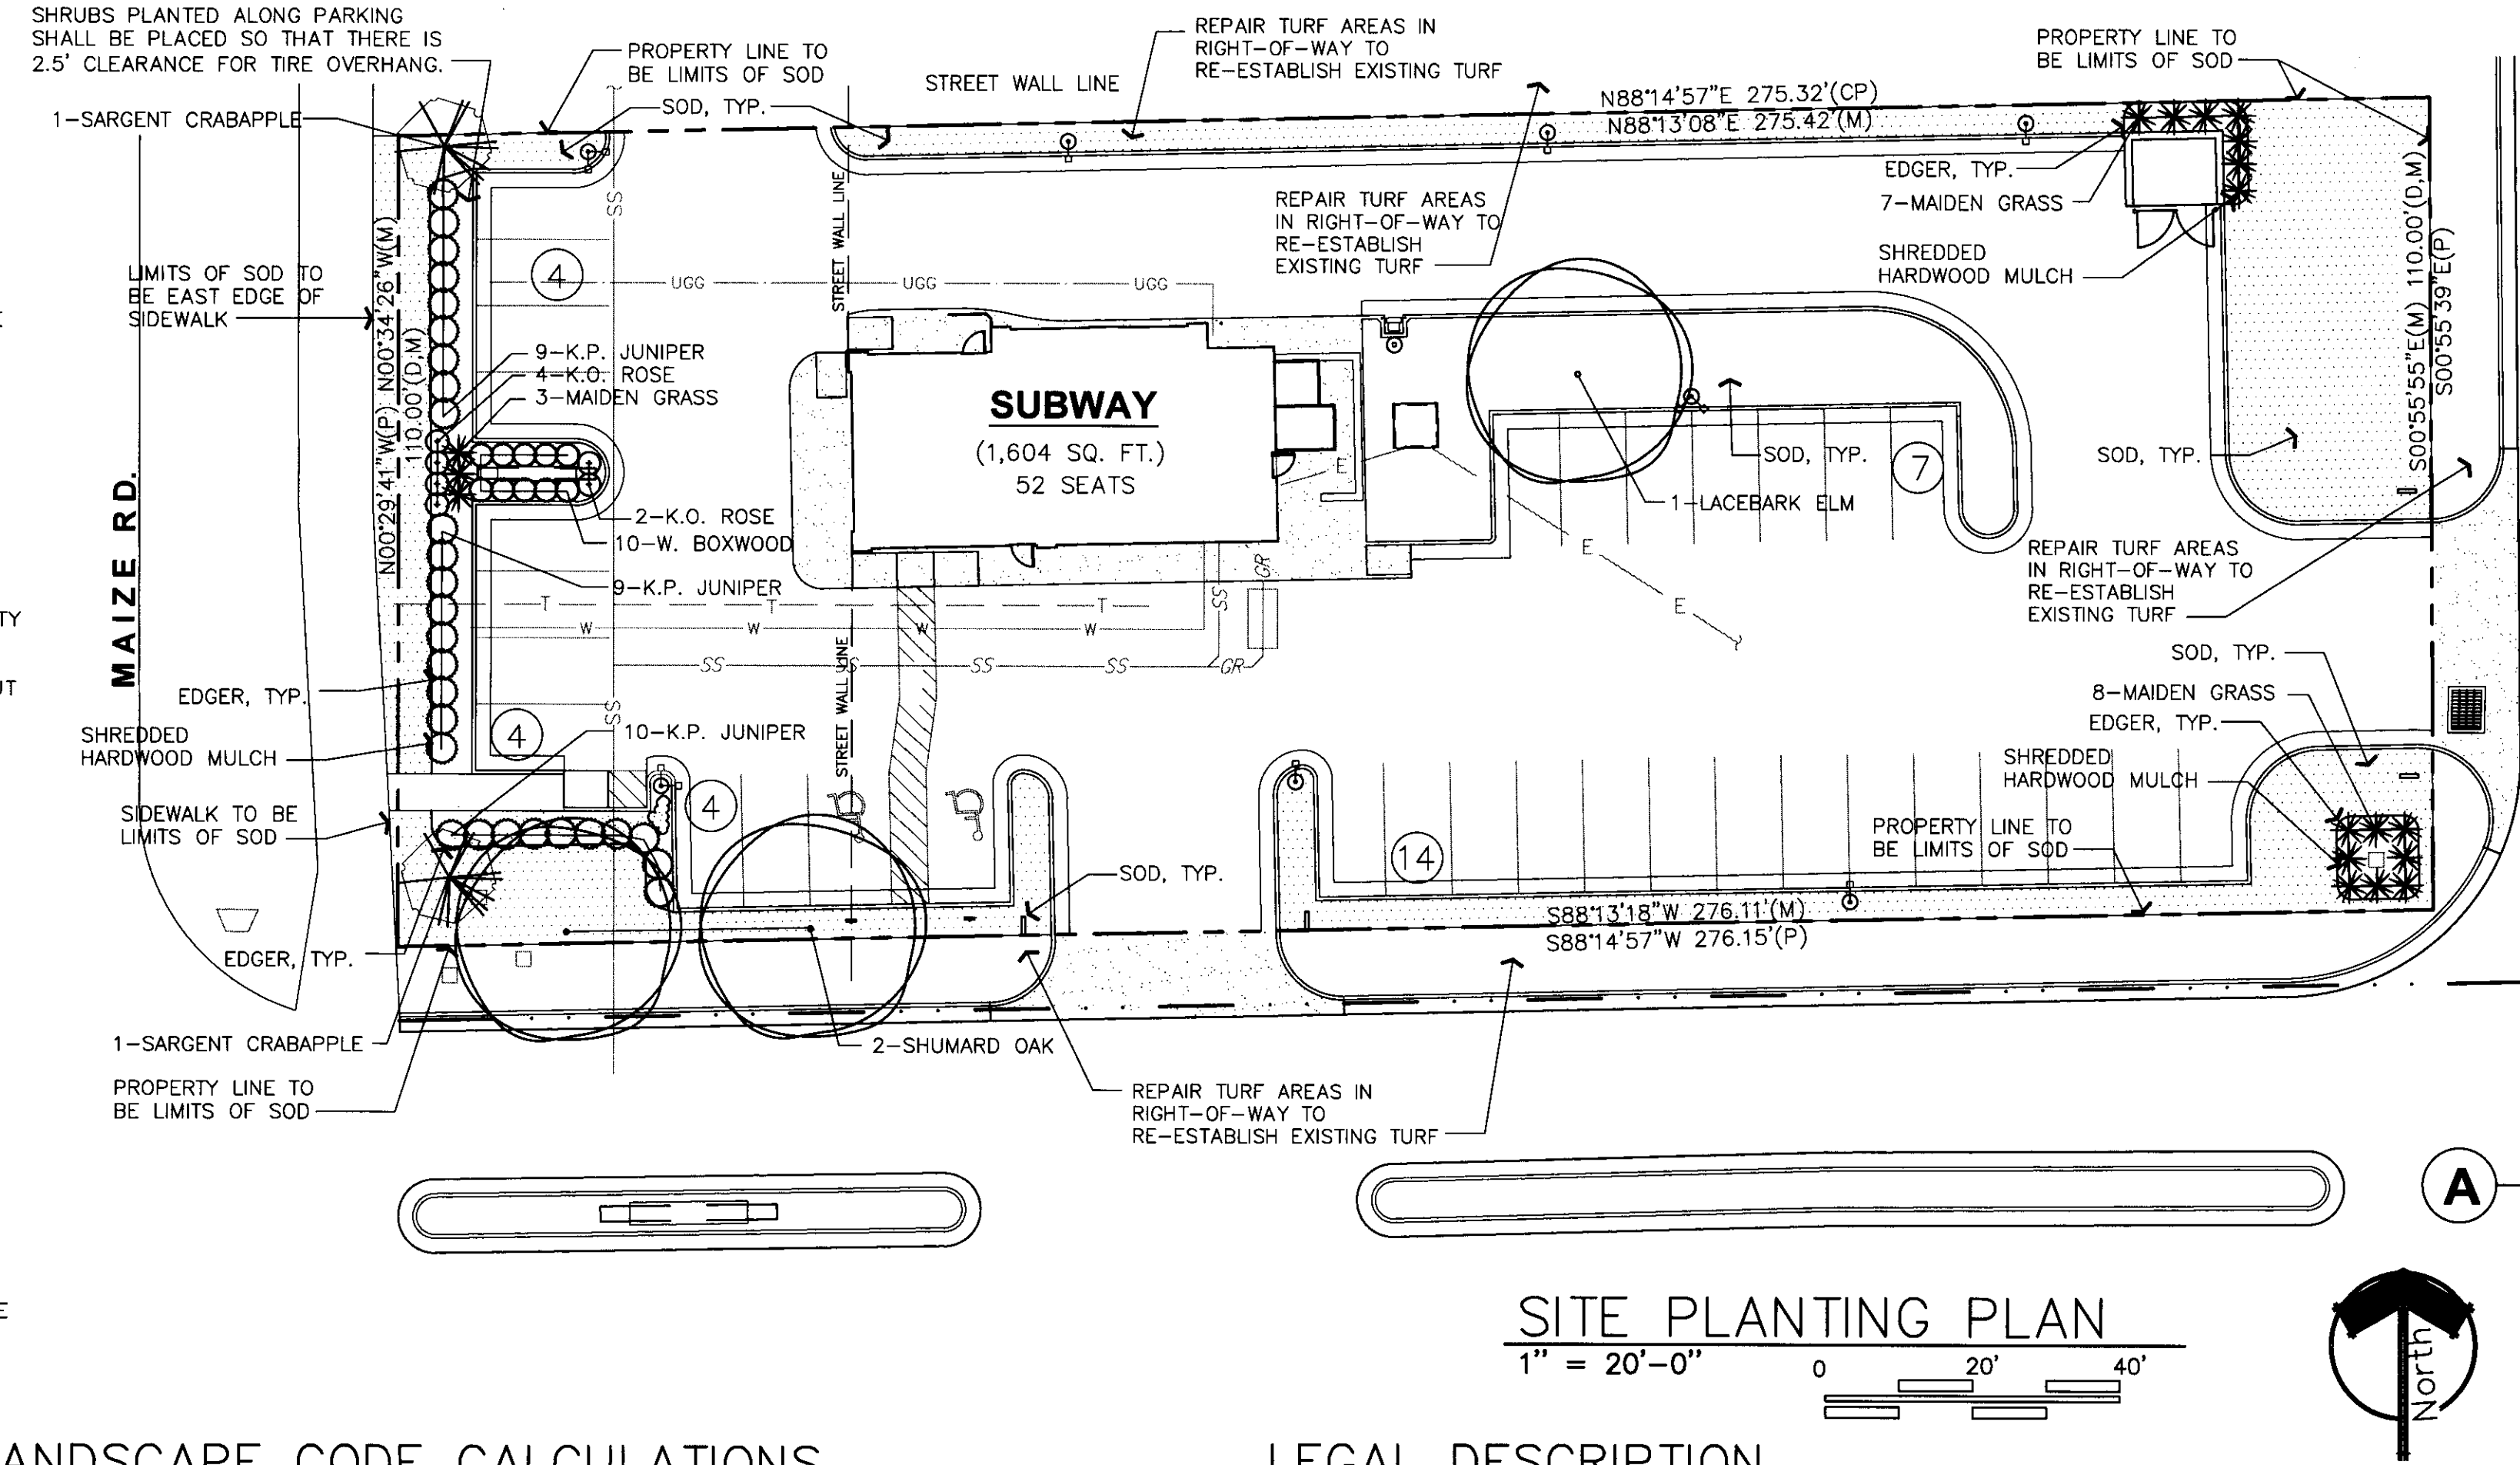

LANDSCAPE CODE CALCULATIONS

LANDSCAPED STREET YARD REQUIREMENT:
REQUIRED: 110 LF X 15 (SQ. FT. FACTOR) = 1,650 SF STREET YARD.
PROVIDED: 1,900 SF

REQUIRED: 1 SHADE, 2 ORNAMENTAL OR 10 SHRUBS PER 500 SF
1,650/500 = 3.3 TREES OR SAY 4 TREES REQ'D
PROVIDED: 2 SHADE TREES, 2 ORNAMENTAL TREES AND 10 SHRUBS = 4 TREES

PARKING LOT LANDSCAPE REQUIREMENT:
REQUIRED: 34 PKG STALLS / 20 = 1.7 OR SAY 2 TREES REQ'D (UP TO ONE-THIRD OF REQ'D STREET YARD TREES CAN BE USED)
PROVIDED: 1 SHADE TREE PLUS 1 STREET YARD TREE = 2 TREES


NO BUFFER REQUIRED
PARKING LOT SCREENED WITH SHRUBS

LEGAL DESCRIPTION

THE SOUTH 110.00 FEET OF LOT 3, BLOCK 1, STONEBRIDGE COMMERCIAL ADDITION, AN ADDITION TO WICHITA, SEDGWICK COUNTY, KANSAS.


UTILITIES SHOWN REPRESENT THE BEST INFORMATION AVAILABLE FOR DESIGN. ADDITIONAL UTILITIES MAY BE PRESENT ON THIS PROJECT. THE CONTRACTOR SHALL BE RESPONSIBLE FOR DETERMINING THE EXACT LOCATION, DEPTH AND SIZE OF ALL UNDERGROUND UTILITIES PRIOR TO CONSTRUCTION. THE CONTRACTOR SHALL BE LIABLE FOR ANY DAMAGE CAUSED BY THE FAILURE TO DO SO.

PLANTING LEGEND

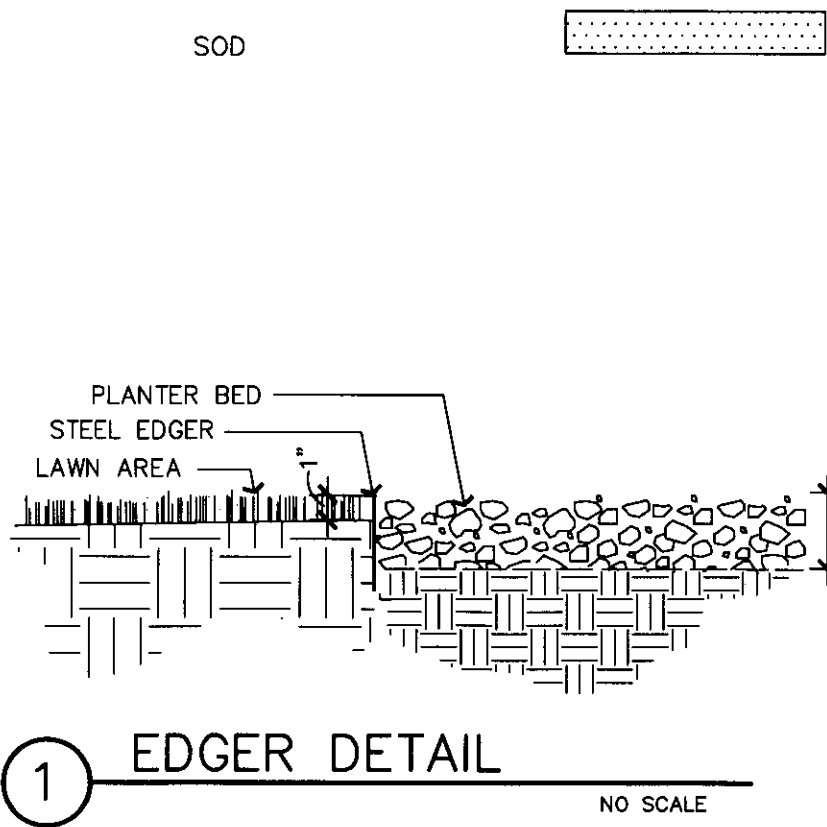

PLANT MATERIAL SCHEDULE


QTY.	COMMON NAME	BOTANICAL NAME	SIZE/REMARKS
	SHADE TREES		
2	SHUMARD OAK	QUERCUS SHUMARDII	2" CAL.
1	LACEBARK ELM	ULMUS PARVIFOLIA	2" CAL.
	ORNAMENTAL TREES		
2	SARGENT CRABAPPLE	MALUS SARGENTII	1-1/2" CAL.
	DECIDUOUS SHRUBS		
6	KNOCK-OUT ROSE	ROSA 'KNOCK-OUT'	3 GAL - COLOR RED
	ORNAMENTAL GRASSES		
18	MAIDEN GRASS	MISCANTHUS SINENSIS 'YAKU JIMA'	3 GAL
	EVERGREEN SHRUBS		
28	KALLAY PFITZER JUNIPER	JUNIPERUS CHINENSIS PFITZERIANA	3 GAL.
10	WINTERGREEN BOXWOOD	BUXUS MICROPHYLLA VAR. KOREANA	3 GAL.

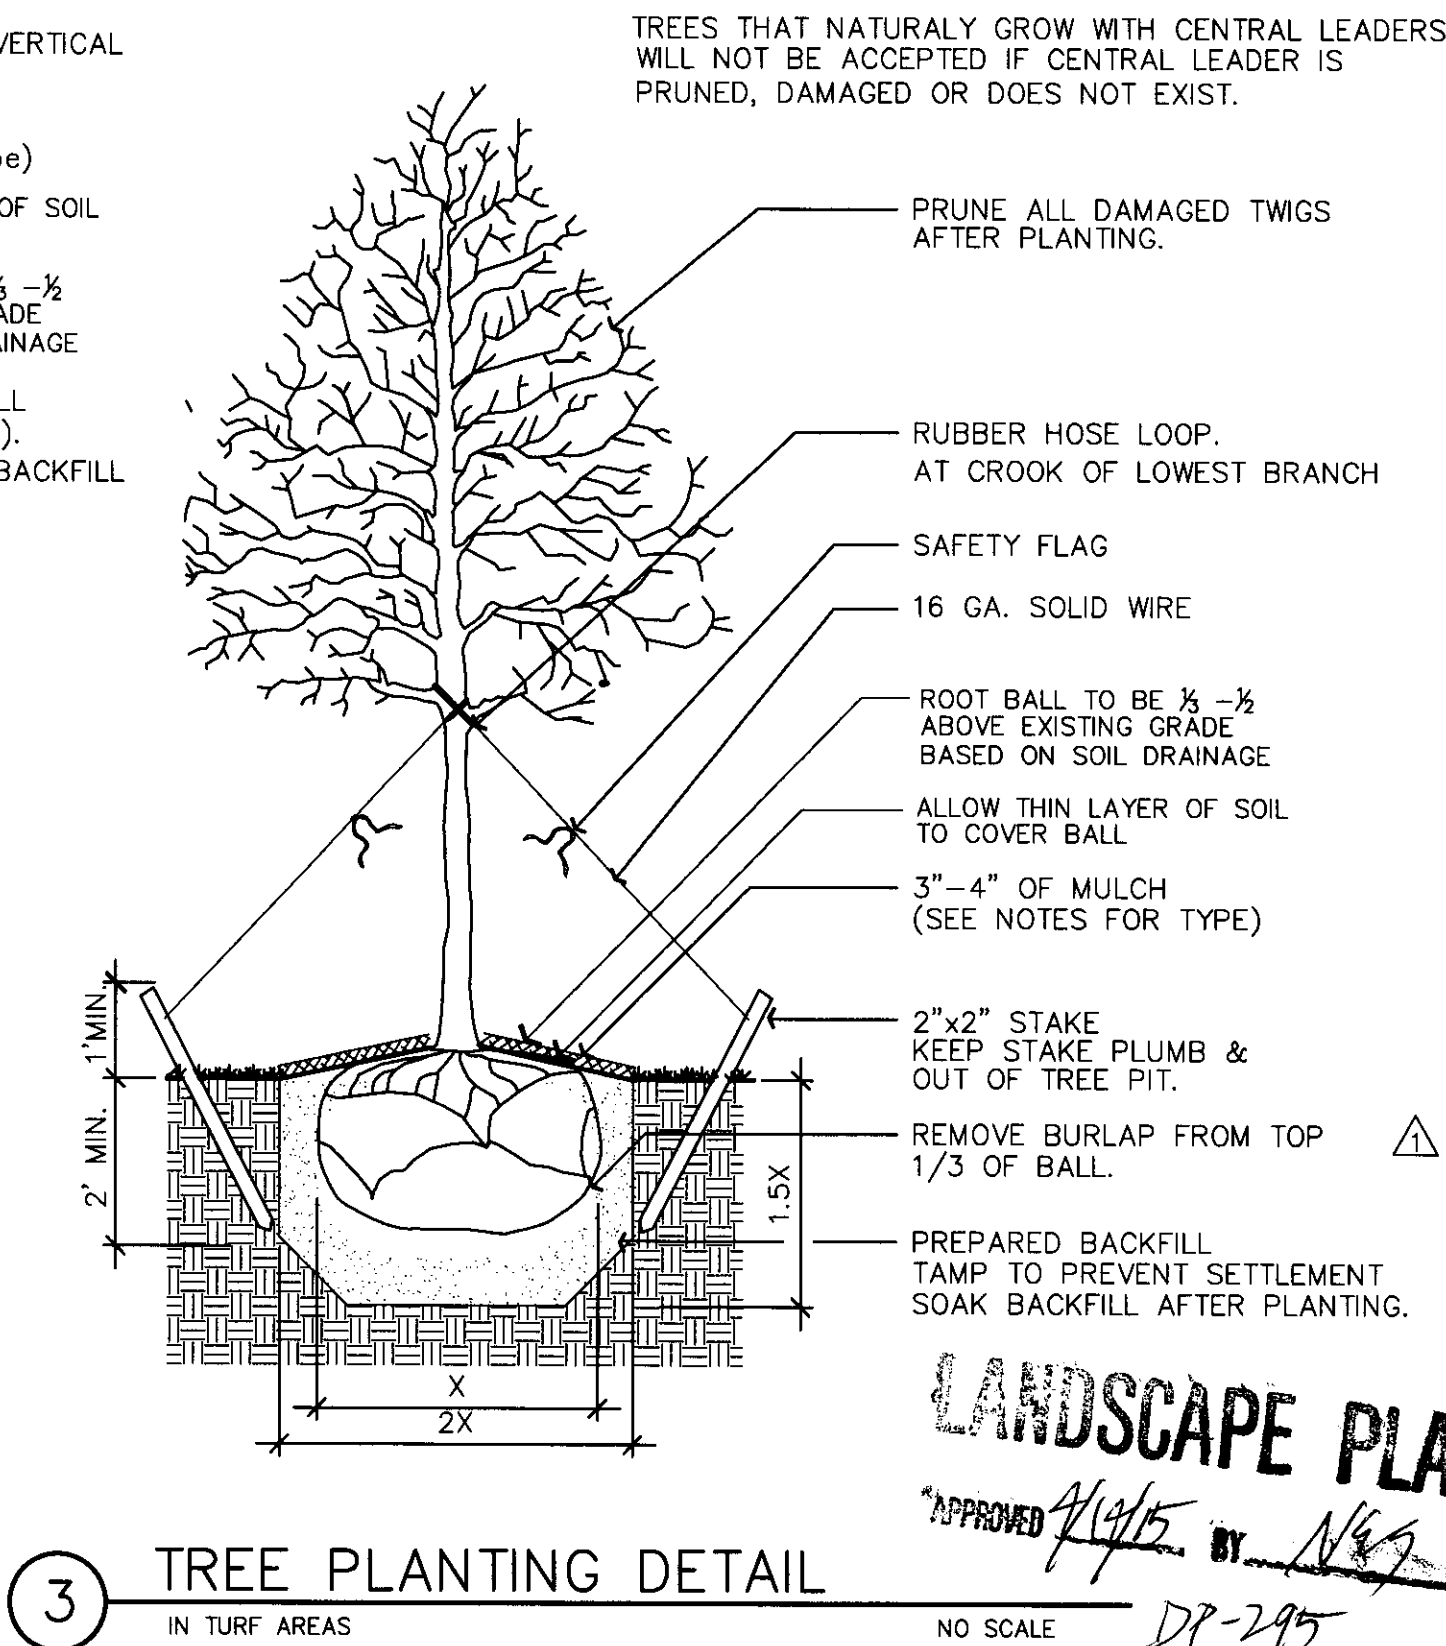

THE DESIGN AND DETAILS DISCLOSED HEREIN ARE THE EXCLUSIVE PROPERTY OF DAN WINTER ARCHITECT AND SHALL NOT BE COPIED OR REPRODUCED IN WHOLE OR IN PART WITHOUT ITS PRIOR WRITTEN CONSENT.

DAN WINTER, ARCHITECT

SUBWAY SANDWICH SHOP
Stonebridge Commercial Center
37th & Maize Rd. Wichita, Ks. 67205

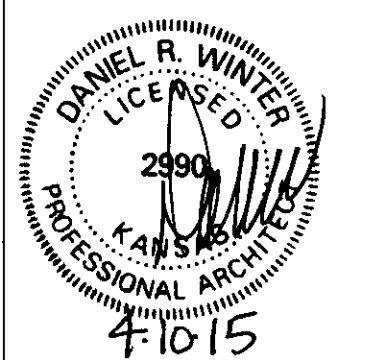

DAN WINTER ARCHITECT

1024 EAST FIRST STREET
WICHITA, KS. 67214
PH. 316-267-7142

PLANTING PLAN

DATE
JUL 30, 2014
SEP 4, 2014

DRAWN BY:
TAF
CHECKED BY:

SHEET NO.
LS1

FLOOD NOTE:
THIS PROPERTY IS LOCATED IN ZONE
WHICH ARE AREAS OF 0.2% CHANCE
AND NOT LOCATED WITHIN ANY PRE-
ESTABLISHED 100-YEAR FLOODPLAIN
DETERMINED BY THE NATIONAL FLOOD
INSURANCE PROGRAM, FLOOD INSURA-
RATE MAP FOR SEDGWICK COUNTY, N.
MAP NUMBER: 20173C0330F
MAP REVISED: MAY 2, 2012 AND
MAP NUMBER: 20173C0190E
MAP REVISED: FEBRUARY 2, 2007

THESE NOTES APPLY TO ALL ACTIVITIES ON THIS PROJECT.

1. ALL DIMENSIONS SHOWN ARE TO EDGE OF PAVEMENT, FACE OF CURB, FACE OF SIDEWALK, OUTSIDE FACE OF BUILDING, PROPERTY LINE, CENTER OF MANHOLE/CATCH BASIN OR CENTERLINE OF PIPE UNLESS OTHERWISE NOTED.
2. ALL DISTURBANCES INCURRED TO ANY ADJOINING PROPERTY DUE TO CONSTRUCTION OR DEMOLITION SHALL BE RESTORED TO THE PREVIOUS CONDITION OR BETTER TO THE SATISFACTION OF THE OWNER, MUNICIPALITY, OR STATE AUTHORITY.
3. BUILDING DIMENSIONS SHOWN ON THESE CIVIL ENGINEERING PLANS ARE FOR REFERENCE ONLY. REFER TO THE ARCHITECTURAL AND STRUCTURAL DRAWINGS FOR EXACT BUILDING DIMENSIONS.
4. PROPERTY LINE AND RIGHT-OF-WAY MONUMENTS SHALL NOT BE DISTURBED BY CONSTRUCTION. IF DISTURBED, THEY SHALL BE RESET TO THEIR ORIGINAL LOCATION AT THE CONTRACTOR'S EXPENSE BY A REGISTERED LAND SURVEYOR.
5. BEFORE ROLL BUILDING AND ALL PAVING AREAS, NOTIFY AUTOZONE INC. OF ANY UNACCEPTABLE AREAS.
6. REFER TO SHEETS C1A - C1B FOR ON-SITE PAVING DETAILS, AND OTHER CONSTRUCTION DETAILS.
7. THE CONTRACTOR SHALL PROVIDE AS-BUILT RECORDS OF ALL CONSTRUCTION TO AUTOZONE INC., CITY OF MONTGA (AS REQUIRED) AND BEDFORD COUNTY (AS REQUIRED) AT THE END OF CONSTRUCTION.
8. IF REQUIRED BY THE FIRE OFFICIAL, TWO PARKING-FIRE LANE SIGNS SHALL BE POSTED ALONG ALL FIRE LANES AT 100 FOOT INTERVALS OR AS DIRECTED.
9. ALL CONSTRUCTION SHALL BE IN ACCORDANCE WITH THE CITY OF MONTGA, BEDFORD COUNTY AND KUDOT CURRENT STANDARDS AND REGULATIONS.
10. THE CONTRACTOR SHALL NOTIFY THE CITY OF MONTGA AND/OR THE AUTHORITY HAVING JURISDICTION 3 BUSINESS DAYS PRIOR TO THE BEGINNING OF CONSTRUCTION.
11. IT SHALL BE THE RESPONSIBILITY OF THE CONTRACTOR TO ADJUST THE TOP OF ALL EXISTING AND PROPOSED STRUCTURES (MANHOLES, CATCH BASINS, INLETS, GATE WELLS ETC.) WITHIN GRADED AND/OR PAVED AREAS TO FINAL GRADE/LOW WATER ELEVATION. SUCH ADJUSTMENTS SHALL BE INCIDENTAL TO THE JOB AND WILL NOT BE PAID FOR SEPARATELY.
12. CHAPTER 14 OF THE FFC (TIME SAVING DURING CONSTRUCTION) SHALL BE ADHERED TO DURING ALL CONSTRUCTION ACTIVITIES FOR THIS PROJECT.

PARKING INFORMATION		
ITEM	REQUIREMENTS	PROVIDED
PARKING REQUIRED	MINIMUM PARKING COUNT: 1 SPACE PER 133 SF BUILDING FLOOR AREA 7,581/133 = 22.16 SPACES 22 SPACES REQUIRED	50 SPACES
MIN. PARKING DIM.	9 FT x 18 FT	8.00 FT x 18.00 FT
MIN. DRIVE AISLE WIDTH	34 FT	24.00 FT. WEST; 30.00 FT. NORTH & EAST
HANDICAP SPACES	2 SPACES	2 SPACES
LOADING SPACE	1 PER 25,000 SF G.F.A.	1 SPACE (15' x 50')

REFERENCE IS MADE TO THE WIGHTA-SEDERBERG COUNTY UNIFIED ZONING CODE

BULK AREA REQUIREMENTS		
LOCATION LOT 1, BLOCK 1, STONEBRIDGE COMMERCIAL ADDITION, AN ADDITION TO WICHTA SEDGWICK COUNTY, KANSAS PER DDC #0714-POL 29040448 ZONING DISTRICTS: UNIFIED COMMERCIAL (STONEBRIDGE COMMUNITY PLAN PD-295)		
USE: AUTO PARTS RETAIL		
BUILDING DIMENSIONS:		
GROSS FLOOR AREA = 7,381 SF (EXTERIOR WALL)		
BUILDING HEIGHT = 21 FT (TOP OF PARAPET WALL)		
NUMBER OF FLOORS = ONE		
ITEM	REQUIRED (PER C.U.P.)	PROVIDED
MINIMUM FRONT SETBACK	35 FT	84.25 FT (SW BUILDING CORNER)
MINIMUM SIDE SETBACK	18 FT	80.00 FT (SOUTH BUILDING WALL) 100.08 FT (NORTH BUILDING WALL)
MINIMUM REAR SETBACK	10 FT	75.52 FT (SE BUILDING CORNER)
MAXIMUM BUILDING COVERAGE	35%	7,381 / 52,023 = 14.2%
MAXIMUM BUILDING HEIGHT	35 FT	1 STORY/21 FT (TOP OF PARAPET)
REFERENCE IS MADE TO THE WICHTA-SEDCWICK COUNTY UNIFIED ZONING CODE		

LEADS		
	Property Line	② Transverse member
	Architect's History / Use	③ Three wide members
	Support Line	④ After work in
	Building Line	⑤ Rafter
	Roofline Details / Use	⑥ Ridge
	Interior / Exterior Details / Use	⑦ Ceiling member
①	Interior / Exterior Details / Use	⑧ Floor Joist
②	Interior / Exterior Details / Use	⑨ Ceiling member
③	Interior / Exterior Details / Use	⑩ Ceiling member
④	Interior / Exterior Details / Use	⑪ Ceiling member
⑤	Interior / Exterior Details / Use	⑫ Ceiling member
⑥	Interior / Exterior Details / Use	⑬ Ceiling member
⑦	Interior / Exterior Details / Use	⑭ Ceiling member
⑧	Interior / Exterior Details / Use	⑮ Ceiling member
⑨	Interior / Exterior Details / Use	⑯ Ceiling member
⑩	Interior / Exterior Details / Use	⑰ Ceiling member
⑪	Interior / Exterior Details / Use	⑱ Ceiling member
⑫	Interior / Exterior Details / Use	⑲ Ceiling member
⑬	Interior / Exterior Details / Use	⑳ Ceiling member
⑭	Interior / Exterior Details / Use	㉑ Ceiling member
⑮	Interior / Exterior Details / Use	㉒ Ceiling member
⑯	Interior / Exterior Details / Use	㉓ Ceiling member
⑰	Interior / Exterior Details / Use	㉔ Ceiling member
⑱	Interior / Exterior Details / Use	㉕ Ceiling member
㉑	Interior / Exterior Details / Use	㉖ Ceiling member
㊳	Interior / Exterior Details / Use	㊸ Ceiling member
㊴	Interior / Exterior Details / Use	㊹ Ceiling member
㊵	Interior / Exterior Details / Use	㊺ Ceiling member
㊶	Interior / Exterior Details / Use	㊻ Ceiling member
㊷	Interior / Exterior Details / Use	㊼ Ceiling member
㊸	Interior / Exterior Details / Use	㊽ Ceiling member
㊹	Interior / Exterior Details / Use	㊾ Ceiling member
㊺	Interior / Exterior Details / Use	㊿ Ceiling member
㊻	Interior / Exterior Details / Use	㊿ Ceiling member
㊼	Interior / Exterior Details / Use	㊿ Ceiling member
㊽	Interior / Exterior Details / Use	㊿ Ceiling member
㊾	Interior / Exterior Details / Use	㊿ Ceiling member
㊿	Interior / Exterior Details / Use	㊿ Ceiling member

SIDEWALK RAMP TYPE A' ②
SIDEWALK RAMP TYPE D' ②
REFER TO CITY OF MOHITA STANDARD RAMP AND
DETECTABLE WARNING DETAILS ON DETAIL SHEETS

PROPOSED


SHOULDER WIDTH,
ELBOWS & KNEES

SHOULDER WIDTH,
ELBOWS & KNEES

CHECK GREEN

STOP

NOTE:
PROTECT EXISTING ADJACENT ASPHALT PAVEMENT AT PROPOSED NORTH, SOUTH, AND EAST APPROACHES. CONTRACTOR TO REPAIR ASPHALT PAVEMENT DAMAGED FROM HIS CONSTRUCTION PROJECTS TO THE SATISFACTION OF THE PROPERTY OWNER. MATCH EXISTING PAVEMENT CROSS SECTIONS, MATERIALS AND CONSTRUCTION PRACTICES TO BE IN ACCORDANCE WITH KDOT SPECIFICATIONS AND CONTRACT DOCUMENTS. WORK PERTAINING TO REPAIR OF PAVEMENT DAMAGED BY CONTRACTOR'S OPERATIONS IS TO BE PAID FOR BY THE CONTRACTOR.

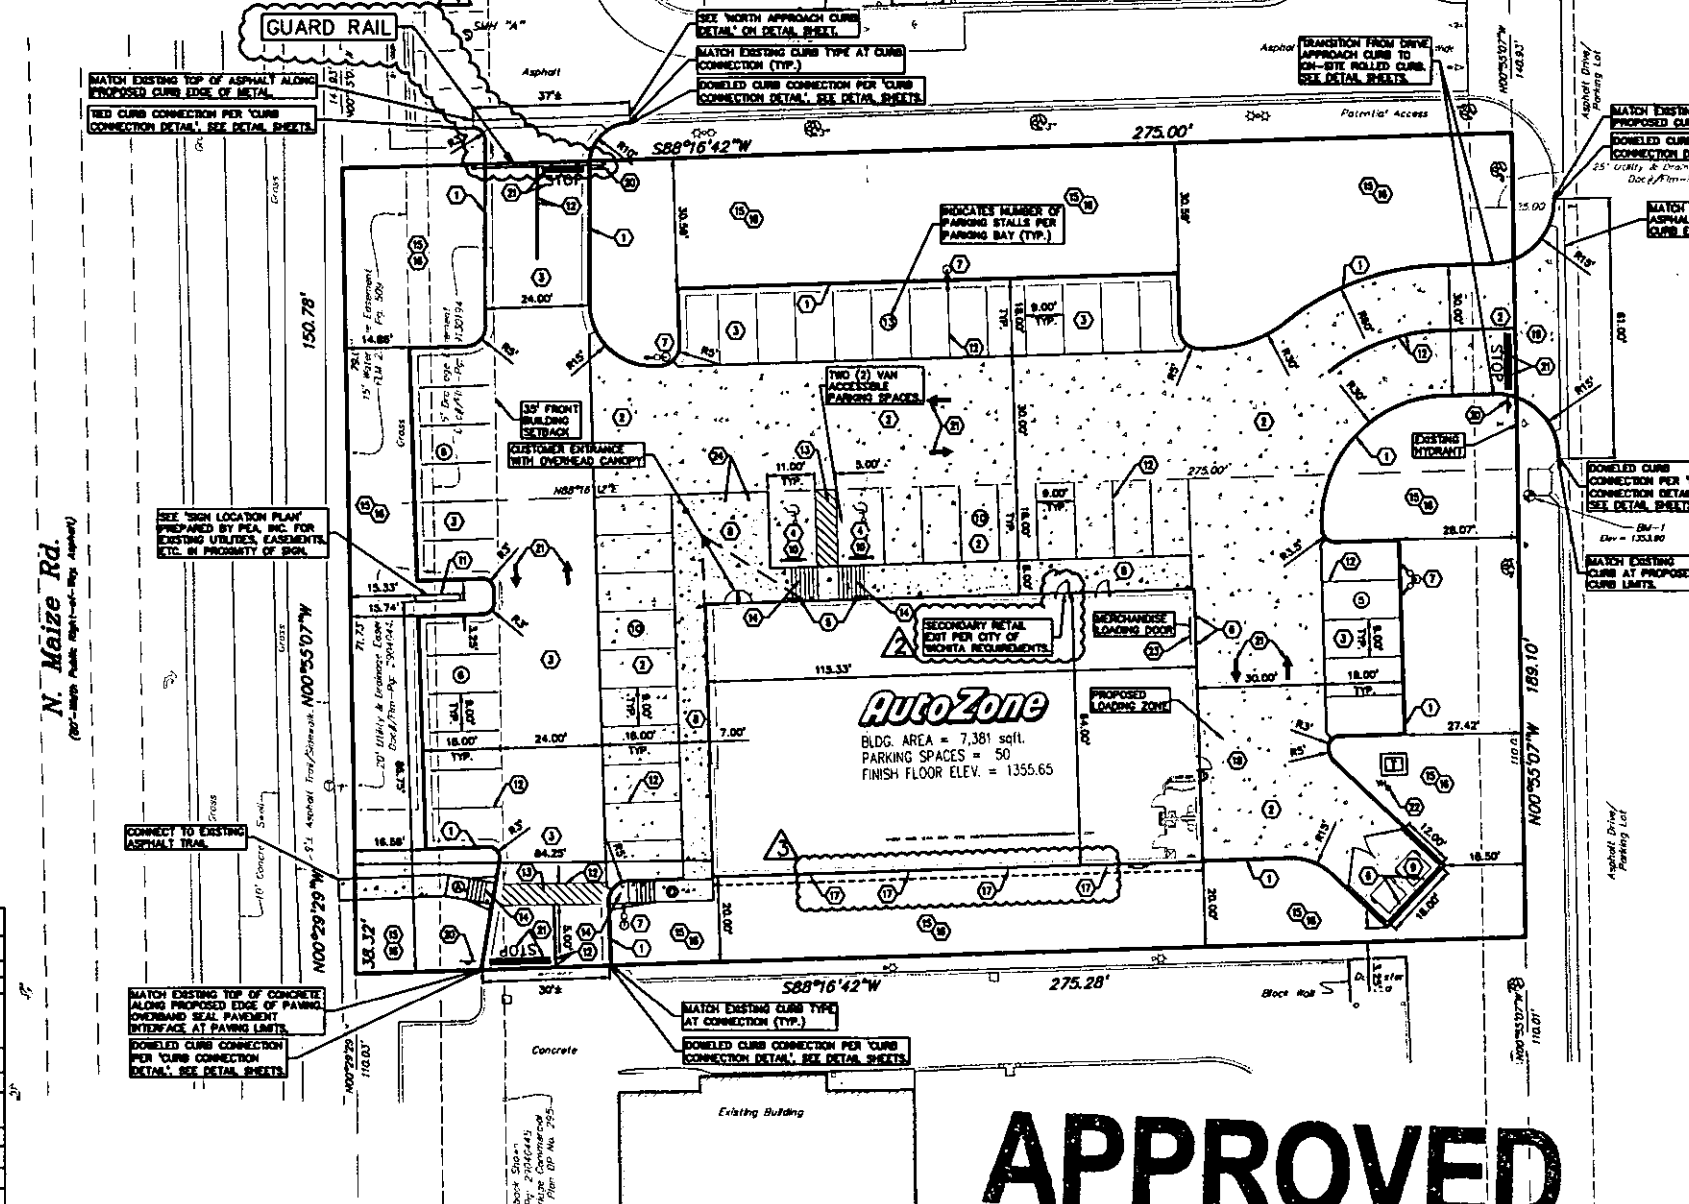


APPROVED

DP-295- Revised Traffic and Circulation
Plan per GP #14- replaces plans from
10-3-16 and 2-27-17

Date: 9-21-17

GRAPHIC SCALE

(IN FEET)
1 inch = 20 ft.

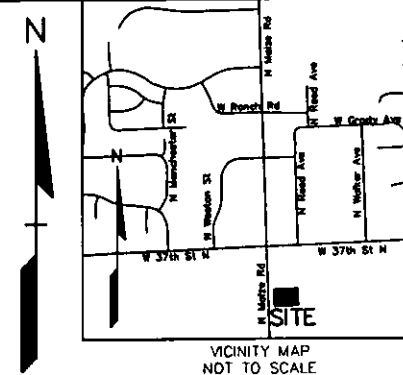

THE CONSTRUCTION INDICATED IN THESE PLANS SHALL BE PERFORMED IN COMPLETE COMPLIANCE WITH THE SPECIFICATIONS OF THE STATE OF KANSAS, KANSAS DEPARTMENT OF TRANSPORTATION, CITY OF WICHITA, SEDGWICK COUNTY, INDEPENDENT UTILITY OWNERS, AND AUTODIAGNE PRODUCT SPECIFICATIONS.

PAVING LEGEND	
	CONCRETE PAVING. SEE DETAILS ON C1.A.
OTHER AREAS ON SITE	ASPHALT PAVING (BASE BID); CONCRETE PAVING (ALTERNATE BID). SEE DETAILS ON C1.A.
NOTE: REFER TO CURB DETAIL 1/C1.A FOR CONCRETE PAVING; REFER TO CURB DETAIL 2/C1.A FOR ASPHALT PAVING.	

KEYNOTES

- (1) CONCRETE CURB - SEE DETAILS 1 & 2/ C.I.A.
- (2) CONCRETE PAVING - SEE DETAIL 4/C.I.A. EXPANSION AND CONTRACTION JOINTS - SEE DETAILS 21 & 22/C.I.A. MAXIMUM SPACING FOR CONTRACTION JOINTS IS 15'-0" O.C. EACH WAY.
- (3) ASPHALT PAVING (BASE 30) - SEE DETAIL 5/C.I.A. O.C. TO PROVIDE ALTERNATE BID FOR CONCRETE PAVING - SEE DETAIL 4/C.I.A.
- (4) HANDICAP PARKING AREA, 2% MAX. SLOPE ANY DIRECTION (TYP.) - SEE DETAILS 6 & 7/C.I.A.
- (5) HANDICAP PARKING SIGN - SEE DETAIL 12/C.I.A.
- (6) PIPE CULVERT-SEE DETAILS 8, 14, 15, & 16/C.I.A.
- (7) LIGHT POLE WITH CONCRETE BASE, ARM FUTURE IN DIRECTIONS INDICATED. SEE DETAIL 13/C.I.A. AND PH.10
- (8) 6" MT. INTERIOR CONCRETE CURB AND WALK. SEE DETAIL 19 & 20/C.I.A. FOR SIDEWALK AROUND BUILDING
- (9) DUMPSITE LAYOUT - 6" TREATED PIPE ENCLOSURE OVER TREATED PIPE FRAMING. SEE DETAILS 8,9,10, & 11/C.I.A.
- (10) 8'-0" LONG CONCRETE WHEEL STOP, FINISHED TO ELEVATION - SEE DETAIL 23/C.I.A. LOCATE 2'-0" FROM FACE OF CURB, EDGE OF PAVEMENT OR SIDEWALK.
- (11) 8.5/15/15" MAX. WIDE SITE SIGN, 30" OVERALL HEIGHT. SEE SIGN DRAWING (SEPARATE PERMIT).
- (12) 6" WIDE PARKING STRIPE PAINTED WHITE (TYP.)
- (13) 6" WIDE DIAGONAL STRIPES PAINTED AT 2 FT. O.C.
- (14) CONCRETE HANDICAP RAMP - MAXIMUM SLOPE 1:12 (8.3%) AND PER ADA REQUIREMENTS. MAXIMUM GRASS SLOPE 1:50 (2.00%). METAL PER-FABRICATED DETECTABLE WARNING SURFACES SHALL BE INSTALLED, CONTRASTING IN COLOR, PER ADA REQUIREMENTS AT ALL RAMPS.
- (15) NEW LANDSCAPE AREA - PROVIDE 30" AND 3" TOPSOIL. SEE SHEET 11.5 FOR ADDITIONAL INFORMATION.
- (16) SLOPE GRADE IN LANDSCAPE AREA FOR GRADING PLANT PROVIDE POSITIVE SURFACE DRAINAGE FOR ALL AREAS.
- (17) BUILDING DOWNSPOUT LOCATION, ROOMS DRAINAGE CONNECTED TO UNDERGROUND STORM SEWER SYSTEM PER SHEET C.I.3. SEE DETAIL 3/C.I.A.
- (18) LOADING AREA, SLOPE AWAY FROM BUILDING. SEE GRADING PLAN, DETAIL C.I.1.
- (19) CONCRETE DRIVE APPROACH WITH INTERIOR CURB. SEE "LAST CONCRETE DRIVE APPROACH DETAIL" ON C.I.8.
- (20) STOP SIGN - SEE DETAIL 26/C.I.A.
- (21) PAVEMENT MARKINGS - SEE DETAIL 24 & 25/C.I.A.
- (22) FREEDZEZEY YARD HYDRANT. PROVIDE APPROPRIATE BACKFLOW PREVENTION AS REQUIRED BY MUNICIPALITY. SEE DETAIL 4/MSHEET N2.
- (23) SERVICE DOOR PLAN - SEE DETAIL 15/C.I.A.
- (24) BOLLARD PLAN FOR STOREFRONT - SEE DETAIL 14/MSHEET C.I.A.

NO.	DATE BY	DESCRIPTION
1	7-24-84	REMOVED ON-SITE PUMP
2	8-14-84	REVISE PER WACSD
3	8-14-84	REVISE PER WACSD
4	8-28-84	ADDED SUBSURFILL
5	9-24-84	REVISE PER WACSD
6	9-24-84	REVISE PER WACSD
21877
A-20-17
KAMRAB

CAUTION!!

THE LOCATION AND BOUNDS OF THE PROPERTY OF THE ABLER BROS. COMPANY ARE SHOWN ON THE ATTACHED MAP. THE BOUNDARIES ARE ONLY APPROXIMATE. NO GUARANTEE IS MADE THAT THE LOCATION AND BOUNDS OF THE PROPERTY ARE COMPLETELY OR ACCURATELY THEREOF. THE COMPANY SHALL BE RESPONSIBLE FOR DETERMINING THE EXACT UTILITY LOCATIONS AND BOUNDS PRIOR TO THE START OF CONSTRUCTION. THE DRAWING AND DESIGN ARE THE PROPERTY OF THE ABLER BROS. COMPANY. NO PART THEREOF SHALL BE REPRODUCED, COPIED, OR OTHERWISE USED FOR ANY PURPOSE WITHOUT THE WRITTEN CONSENT OF ABLER BROS. AND ALL CLAIMS FOR INFRINGEMENT OF ANY PATENT RIGHTS WILL BE PROSECUTED. © 2014 ABLER BROS. COMPANY. ALL RIGHTS RESERVED.

CONSTRUCTION CONTRACTOR AGREES THAT IN ACCORDANCE WITH ORIGINALLY ACCEPTED CONTRACT DOCUMENTS, THE CONSTRUCTION CONTRACTOR WILL BE RESPONSIBLE TO ASSUME BOND OF THE BOUNDARIES OF THE PROPERTY CONDITIONS DURING THE COURSE OF CONSTRUCTION OF THE PROJECT, INCLUDING LIABILITY OF ALL PERSONS AND THINGS ON THE PROPERTY. THE CONTRACTOR SHALL BE RESPONSIBLE TO BE MADE TO ACCEPT CONTINGUOUS AND NOT BE Liable FOR ANY DAMAGE TO THE PROPERTY OF THE CONSTRUCTION FIRM ARISING TO ARISING FROM ANY AND ALL LIABILITY, LOSS OR DAMAGE, IN CONNECTION WITH THE PERFORMANCE OF THE PROJECT. THE CONTRACTOR SHALL BE RESPONSIBLE FOR THE BOUNDARIES OF THE PROPERTY FROM THE SOLE NEGLIGENCE OF THE DESIGNER.

Kansas 811
Know what's below.
Call 811 before you dig.

PEA

PEA, Inc.
7927 Nemco Way, Ste. 115
Brighton, MI 48116
t 517.546.8583
f 517.546.8973
www.beainc.com

AUTOZONE PARTS, INC.
123 S FRONT ST
MEMPHIS, TN 38103

SITE PLAN

CITY OF WICHITA, KANSAS #4471
N WATZ ROAD, NEAR W 7TH ST, N
CITY OF WICHITA, SEDGWICK COUNTY, KS

WVB	DN	SAP/MBR	SUR	CEI	P.M.	WFO
-----	----	---------	-----	-----	------	-----

ORIGINAL ISSUE DATE: JULY 20, 2016
PEA JOB NO. 2016-060
SCALE: 1" = 20'
DRAWING NUMBER: C1.0



Wichita-Sedgwick County Metropolitan Area Planning Department

August 8, 2016

Menard, Inc.
Attn: Tyler Edwards
5101 Menard Drive
Eau Claire, WI 54703

MKEC Engineering
Attn: Brian Lindebak
Wichita KS 67206

RE: CUP2016-23 – City request to amend the Stonebridge Community Unit Plan (CUP) DP-295 to allow for the expansion of an accessory building on Parcel 11b

Dear Applicants:

At its regular meeting on **July 21, 2016**, the Wichita - Sedgwick County Metropolitan Area Planning Commission (MAPC) considered the above captioned request. The action of the MAPC was to **APPROVE** the request subject to the following conditions:

- (1) The applicant shall submit four revised copies of the CUP to the Metropolitan Area Planning Department within 60 days of approval or the request shall be considered denied and closed.
- (2) If the Zoning Administrator finds that there is a violation of any of the conditions of the CUP amendment, the Zoning Administrator, in addition to enforcing the other remedies set forth in the Unified Zoning Code, may, with the concurrence of the Planning Director, declare the CUP amendment null and void.

This case received no protests during the two-week period, therefore the MAPC decision is final. If you have any questions concerning this application, please contact out office at 268-4421.

Sincerely,


Kathy L. Morgan
Senior Planner
Current Plans Division

Copies to: Bryan Frye, WCC, District V
Laura Rainwater, CSR, District V
JR Cox, MABCD
Tom Stolz, MABCD
Paul Hays, MABCD

City Hall • 10th Floor • 455 North Main • Wichita, Kansas 67202-1688

T 316.268.4421 F 316.268.4390

www.wichita.gov



Wichita-Sedgwick County Metropolitan Area Planning Department

Tier 1, LLC
Attn: Marv Schellenberg
1313 N. Webb Rd, Ste. 230
Wichita, KS 67206

August 22, 2016

MKEC Engineering
Attn: Brian Lindebak
411 N. Webb Rd.
Wichita, KS 67206

RE: CUP2016-33 – City CUP Administrative Adjustment to CUP DP-295 Stonebridge, to adjust the wall easement on Parcel 1a containing 0.71 acres. The property is generally located on the east side of Maize Road south of 37th Street North

Dear Applicants:

We received and reviewed your request for an Administrative Adjustment to DP-295, to reflect VAC2016-26 on Parcel 1a. Proposed modifications are as follows:

1. Remove wall easement depiction on Parcel 1a as per VAC2016-26
2. Remove Development Guideline General Provision 8F and re-letter accordingly
3. Update easements to reflect current plan and separate instrument documents

On the basis of our review, we find that adjusting the CUP in the manner stated in the above paragraph is consistent with the approved CUP and will not have an adverse effect on the CUP or adjacent properties, nor will it be a substantial deviation of the original plan.

Our signatures below indicate that the CUP shall be adjusted as stated in this letter. This CUP adjustment shall not be deemed to alter any other provisions of the CUP except as expressly stated herein.

The “Development Application” sign should now be removed from the property. Please submit four (4) copies of the revised CUP drawing within 60 days in order for this adjustment to be considered final.

Dale Miller, Director
Metropolitan Area Planning Department

Kyle J. McLaren, Interim Director
Metropolitan Area Building and Construction
Department

cc: J.R. Cox, MABCD
Paul Hays, MABCD
Bryan Frye, CM District V
Laura Rainwater, Community Liaison District V



Wichita-Sedgwick County Metropolitan Area Planning Department

November 4, 2013

MKEC attn. Brian Lindebak
411 N. Webb
Wichita, KS 67208

RE: CUP2013-38 - City Administrative Adjustment to DP-295 to adjust parcel boundaries, generally located at the southeast corner of W. 37th Street North and Maize.

Dear Applicants:


We received and reviewed your request for an administrative adjustment to the above-referenced community unit plan, DP-295 Stonebridge Community Unit Plan ("CUP"). We understand you wish to reconfigure parcel boundaries; building coverage and floor area will be distributed proportionately on the revised CUP. Uses permitted on the existing parcels do not change.

On the basis of our review, we find that adjusting the CUP in the manner stated in the above paragraph is consistent with the approved CUP and will not have an adverse effect on the CUP or on adjacent properties, nor will it be a substantial deviation of the original plan.

Our signatures below indicate that the CUP shall be adjusted as stated in this letter. This CUP adjustment shall not be deemed to alter any other provisions of the CUP except as expressly stated herein.

The "Development Application" signs may now be removed from the property. Please submit four (4) copies of the revised CUP drawing within 60 days in order for this adjustment to be considered final.


John L. Schlegel
Director of Planning

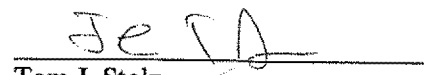
Tom J. Stolz
MABCD Director

cc: JR Cox, MABCD
Paul Hays, MABCD
Jeff Longwell, CM District V
Megan Buckmaster, NA District V

City Hall • 10th Floor • 455 North Main • Wichita, Kansas 67202-1688

T 316.268.4421 F 316.268.4390

www.wichita.gov



Wichita-Sedgwick County Metropolitan Area Planning Department

May 21, 2012

North 37th LLC attn. Paul Jackson
1625 N. Waterfront Pkwy. #220
Wichita, KS 67206

MKEC attn. Brian Lindebak
411 N. Webb Rd.
Wichita, KS 67206

RE: CUP2012-14 - City CUP Adjustment #1 to DP-295, Stonebridge Community Unit Plan, to adjust parcel lines creating two new parcels, and extension of screening wall deferral along the south property line; generally located south of 37th Street North and east of Maize.


Dear Applicants:

We received and reviewed your request for an administrative adjustment to the above-referenced community unit plan, DP-295 Stonebridge Community Unit Plan ("CUP"). We understand you wish to create Parcels 1a, 1b, 2a, and 2b from the existing parcels 1 and 2. And, you wish to extend the Parcel 1a south screening wall deferral from a total of four years to a total of ten years. Maximum building coverage and floor area will be the distributed proportionately between the four new parcels as indicated on the revised CUP. Uses and signage permitted on the newly created parcels does not change.

On the basis of our review we feel that adjusting the CUP in the manner you have requested would be consistent with the approved CUP and will not have an adverse effect on the CUP or on adjacent properties, nor will it be a substantial deviation of the original plan.

Our signatures below indicate that the CUP shall be adjusted as requested. This CUP adjustment shall not be deemed to alter any other provisions of the CUP except expressly stated herein.

The "Development Application" signs may now be removed from the property. Please submit four (4) copies of the revised CUP drawing within 60 days in order for this adjustment to be considered final.

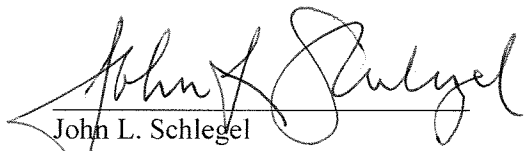

John L. Schlegel
Director of Planning

cc: Paul Hays, Office of Central Inspection
Jeff Longwell, CM District II
Megan Buckmaster, NA District II



Rick Stubbs
Co-Interim Superintendent of Central Inspection



Wichita-Sedgwick County Metropolitan Area Planning Department

May 21, 2012

North 37th LLC attn. Paul Jackson
1625 N. Waterfront Pkwy. #220
Wichita, KS 67206

MKEC attn. Brian Lindebak
411 N. Webb Rd.
Wichita, KS 67206

RE: CUP2012-14 - City CUP Adjustment #1 to DP-295, Stonebridge Community Unit Plan, to adjust parcel lines creating two new parcels, and extension of screening wall deferral along the south property line; generally located south of 37th Street North and east of Maize.


Dear Applicants:

We received and reviewed your request for an administrative adjustment to the above-referenced community unit plan, DP-295 Stonebridge Community Unit Plan ("CUP"). We understand you wish to create Parcels 1a, 1b, 2a, and 2b from the existing parcels 1 and 2. And, you wish to extend the Parcel 1a south screening wall deferral from a total of four years to a total of ten years. Maximum building coverage and floor area will be the distributed proportionately between the four new parcels as indicated on the revised CUP. Uses and signage permitted on the newly created parcels does not change.

On the basis of our review we feel that adjusting the CUP in the manner you have requested would be consistent with the approved CUP and will not have an adverse effect on the CUP or on adjacent properties, nor will it be a substantial deviation of the original plan.

Our signatures below indicate that the CUP shall be adjusted as requested. This CUP adjustment shall not be deemed to alter any other provisions of the CUP except expressly stated herein.

The "Development Application" signs may now be removed from the property. Please submit four (4) copies of the revised CUP drawing within 60 days in order for this adjustment to be considered final.

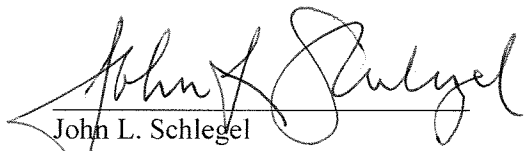

John L. Schlegel
Director of Planning

cc: Paul Hays, Office of Central Inspection
Jeff Longwell, CM District II
Megan Buckmaster, NA District II



Rick Stubbs
Co-Interim Superintendent of Central Inspection

- a. THE CONTRACTOR SHALL FOLLOW ALL LOCAL CODES THAT PERTAIN TO LANDSCAPE INSTALLATION, AND SHALL NOTIFY THE DESIGNER REGARDING ANY DISCREPANCIES BETWEEN LOCAL CODES, PLANS AND SPECIFICATIONS PRIOR TO ANY CONSTRUCTION.
- b. THE CONTRACTOR SHALL NOTIFY THE DESIGNER OF ANY LAYOUT DISCREPANCIES PRIOR TO ANY PLANTING.
- c. THE CONTRACTOR SHALL VERIFY DEPTHS AND LOCATIONS OF ALL EXISTING UTILITIES, STRUCTURES, UNDERGROUND UTILITY PROJECT SITE BEFORE LANDSCAPE CONSTRUCTION BEGINS.
- d. THE CONTRACTOR SHALL KEEP THE PREMISES FREE FROM RUBBISH AND ALL DEBRIS ASSOCIATED WITH THE WORK AT ALL TIMES. ALL UNUSED MATERIALS AND DEBRIS SHALL BE REMOVED IMMEDIATELY TO PERFORM THE OTHER PERMEABILITY TEST TO DETERMINE SOIL WATER RETENTION CAPACITY.
- e. A PERMEABILITY TEST TO DETERMINE SOIL WATER RETENTION CAPACITY SHALL BE COMPLETED AFTER 18 HOURS TO VISUALLY CHECK FOR RETAINING WATER. THIS TEST IS DETERMINED TO BE POOR FOR PLANTING CONDITIONS, TO REMEDY POOR SOIL CONDITIONS, THE CONTRACTOR SHALL BE REQUIRED TO OVER EXCAVATE THE SOIL TO THE DEPTH OF THE ROOT BALL AND REPLACE THE SOIL WITH QUALITY TOPSOIL OR FERTILE SOIL. THE CONTRACTOR SHALL RE-PLANT TREES OR SHRUBS ON THE PLANS PRIOR TO ANY LANDSCAPE MATERIALS TO BE WATERED BY CONTRACTOR UNTIL ESTABLISHED.

16. ACCEPTABLE. FOR STAKED TREES. TREE TIE SYSTEMS SHALL BE 20" DEWITT (BLACK) TREE TAPES (TSL-BX (60 PER CASE) OR APPROVED EQUAL-NO PLASTIC TIES ALLOWED. WIRE: 14 GAUGE. ELECT. FENCE WIRE.

17. ALL PLANTING BEDS AS DESIGNATED ON THESE PLANS SHALL BE BORDERED BY 1/2" X 1/2" X 10' PAVED CONCRETE OR 1/2" X 1/2" X 10' PAVED ASPHALT WITH INTEGRATED STAKES, THROUGH SLOTS IN EDGING. (REFER TO DETAIL SHEETS FOR ACCEPTED EDGING MATERIAL)

18. ALL PLANTING BEDS AS DESIGNATED ON THESE PLANS SHALL BE 4" OF EITHER SHREDDED HARDWOOD BARK MULCH OR EITHER CYPRESS OR PINE BARK FLOWER BEDS USE EITHER CYPRESS OR PINE BARK MULCH. DO NOT USE HARDWOOD MULCH IN SEASONAL LOW SPOTS.

19. ALL PLANTING AREAS SHALL RECEIVE A THREE INCH (3") TOP DRESSING OF MULCH OVER A 10 MIL WEED MAT EQUAL TO "WEEBLOC" FABRIC BY "EASY GARDENER" OR DEWITT WEED BARRIER. SINGLE TREES OR SHRUBS SHALL BE MULCHED TO THE OUTSIDE EDGE OF THE SAUCER OR LANDSCAPE ISLAND (REFER TO PLANTING DETAILS).

20. ALL SLOPES AND AREAS EXCEPT THOSE OCCUPIED BY BUILDINGS, STRUCTURES, OR PAVING SHALL BE GRADED SMOOTH AND 4" (INCHES) OF TOPSOIL APPLIED. (REFER TO THE EROSION CONTROL DETAIL SHEET(S) FOR TOPSOIL AND SEEDING SPECIFICATIONS).

21. CONTRACTOR SHALL FERTILIZE ALL PLANTS AT THE TIME OF PLANTING WITH 10-10-10 TIME RELEASE FERTILIZER.

4 INCHES MULCH (SEE LANDSCAPE NOTES FOR TYPE OF MULCH)
 IF SHRUB IS B & B, THEN REMOVE BURLAP & ROPE FROM TOP 1/3 OF BALL
 BACKFILL MIX
 UNDISTURBED SUBSOIL
 2" (MIN.)

Diagram illustrating the structure of a planting hole. The hole is filled with mulch (4 INCHES MULCH) and contains a shrub (SHRUB IS B & B). The hole is lined with a flat surface (EXISTING GRADE OR PROPOSED GRADE) and a layer of backfill mix (BACKFILL MIX). The hole is 2' MIN. deep and 1' MIN. wide. The hole is filled with mulch (4 INCHES MULCH) and contains a shrub (SHRUB IS B & B). The hole is lined with a flat surface (EXISTING GRADE OR PROPOSED GRADE) and a layer of backfill mix (BACKFILL MIX). The hole is 2' MIN. deep and 1' MIN. wide.

LANDSCAPED STREET YARD:
AVERAGE LOT DEPTH = 27'
SQUARE FOOT FACTOR = 15 SQ. FT. PER LF
N. MAIZE RD STREET FRONTAGE = 120'

TOTAL LANDSCAPED STREET YARD REQUIRED = $120' \times 15' = 1,800$ SF

1 SHADE TREE OR 2 ORNAMENTAL TREES REQUIRED PER 500 SF OF LANDSCAPED STREET YARD = 4 SHADE TREES, 8 ORNAMENTAL TREES, OR A COMBINATION REQUIRED.

SHRUBBERY MAY BE SUBSTITUTED FOR UP TO ONE THIRD OF THE REQUIRED TREES AT A RATE OF 10 SHRUBS PER ONE SHADE TREE OR 5 SHRUBS PER ORNAMENTAL TREE.

PARKING LOT SCREENING:
SHRUBS AND TREES MAY BE USED FOR SCREENING IF THE PLANTING WIDTH IS AT LEAST 6 FEET WIDE AND ADJACENT TO THE PARKING LOT PAVING. SHRUBS MAY BE EVERGREEN OR DECIDUOUS AS LONG AS THE SCREENING IS SOLID FOR 8 MONTHS OF THE YEAR. THE REQUIRED SCREENING MUST BE 18 INCHES IN HEIGHT AT THE TIME OF PLANTING AND REACH A MINIMUM OF 3 FEET IN HEIGHT ABOVE THE PARKING SURFACE AFTER 3 YEARS OF GROWTH.

INTERIOR LANDSCAPING:
10 SPACES PROVIDED IS LESS THAN 20 SPACE REQUIREMENT FOR INTERIOR LANDSCAPING THEREFORE INTERIOR LANDSCAPING IS NOT REQUIRED.

CONTRACTOR TO COORDINATE FINAL LOCATION AND TYPE OF LANDSCAPING WITH
OWNER.

[illegible]

C5 SCALE: 1" = 20'

HORIZONTAL SCALE

(IN FEET)

1 inch = 20 ft.



VANTEDGE AUTO T5
TAKES OIL CHANGE

3642 N. MAIZE RD
WICHITA, KS

[illegible]


JARED M. DAVIS
 LICENSED
 27214
 PROVIDENCE

ISSUED BY:	JARED M DAVIS
LICENSE NO:	PE No. 27214

LANDSCAPE
PLAN

SHEET NUMBER

C5

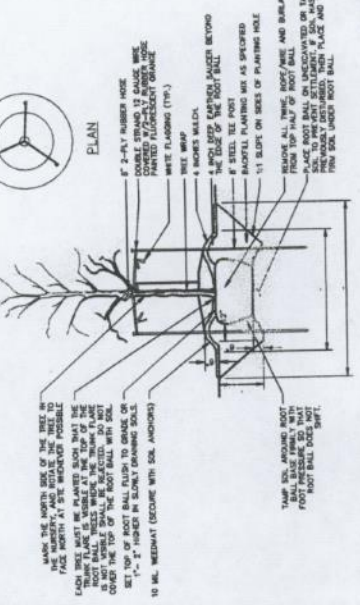

NOTES:

1. DO NOT HEAVILY PRUNE TREE AT PLANTING. PRUNE ONLY THE BRANCHES LEADING TO THE LEADERS AND BRANCHES OF THE FIRST TWO OR THREE LATERAL BRANCHES.
2. LEADERS AND BRANCHES OF THE FIRST TWO OR THREE LATERAL BRANCHES WILL BE PROTECTED BY THE CROWN.
3. STAKE TREES ONLY UPON THE APPROVAL OF THE OWNER.
4. STAKE TREES ONLY UPON THE APPROVAL OF THE OWNER.
5. WATER TREES THIRDS ONLY UPON THE APPROVAL OF THE OWNER.
6. BACKFILL WITH EXISTING SOIL IN SHELTER GARDEN BEDS.
7. ORGANIC MATTER (IN THE FORM OF MULCH) AND 20% MANURE BY VOLUME COMPOSTED FOR 12 MONTHS FOR TYPES OF MULCH TO BE USED.

REQUIRED LANDSCAPING:

LANDSCAPED STREET YARD:
AVERAGE LOT DEPTH = 278'
SQUARE FOOTAGE FACTOR = 15 SQ. FT. PER LF
N. MAIZE RD STREET FRONTAGE = 120'

TOTAL LANDSCAPED STREET YARD REQUIRED = $120' \times 15' = 1,800 \text{ SF}$


1 SHADE TREE OR 2 ORNAMENTAL TREES REQUIRED PER 500 SF OF LANDSCAPED STREET YARD - 4 SHADE TREES, 8 ORNAMENTAL TREES, OR A COMBINATION REQUIRED.

SHRUBBERY MAY BE SUBSTITUTED FOR UP TO ONE THIRD OF THE REQUIRED TREE AT A RATE OF 10 SHRUBS PER ONE SHADE TREE OR 5 SHRUBS PER ORNAMENTAL TREE.

PARKING LOT SCREENING: SHRUBS AND TREES MAY BE USED FOR SCREENING IF THE PLANTING WIDTH IS AT LEAST 3 FEET WIDE AND ADJACENT TO THE PARKING LOT PAVING. SHRUBS MAY BE EVERGREEN OR DECIDUOUS AS LONG AS THE SCREENING IS SOLID FOR 8 MONTHS OF THE YEAR. THE REQUIRED SCREENING MUST BE 18 INCHES IN HEIGHT AT THE TIME OF PLANTING AND REACH A MINIMUM OF 3 FEET IN HEIGHT ABOVE THE PARKING SURFACE AFTER 3 YEARS OF GROWTH.

INTERIOR LANDSCAPING:
10 SPACES PROVIDED IS LESS THAN 20 SPACE REQUIREMENT FOR INTERIOR LANDSCAPING THEREFORE INTERIOR LANDSCAPING IS NOT REQUIRED.

CONTRACTOR TO COORDINATE FINAL LOCATION AND TYPE OF LANDSCAPING WITH
OWNER.

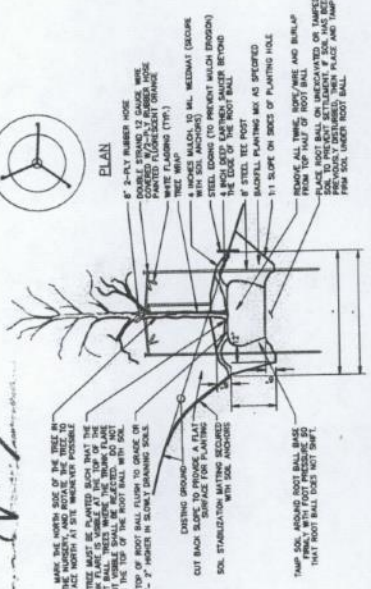

NOTES:

1. DO NOT HEAVILY PRUNE TREES AT PLANTING. PRUNE ONLY CROSSOVER LIMBS, OR DOMINANT LEADERS, AND BRANCHES OF DEAD BRANCHES. SOME INTERIOR BRANCHES OF DEAD BRANCHES MAY BE PRUNED IN ORDER TO IMPROVE THE APPEARANCE OF THE BRANCHES THAT EXTEND FROM THE MAIN TRUNK.
2. WEAP TREES ONLY UPON THE APPROVAL OF THE OWNER.
3. STUMP TREES TRUNKS ONLY UPON THE APPROVAL OF THE OWNER.
4. BACKFILL WITH EXISTING SOIL IN SHADY LOAM SOILS AND ZIN MALL BY VOLUME COMPOSED OF 25% ORGANIC MATTER AND 75% INERT FILL FOR SOILS TO BE USED.

AE-U-1
TREE PLANTING ON SLOPE

LANDSCAPE LEGEND

[illegible]

16. ACCEPTANCE FOR STAKED TREES. TREE TREE SYSTEMS SHALL BE 30" DENSELY STAKED AND STAKES SHALL BE 1/2" DIA. OR APPROVED EQUIVALENT. STAKES SHALL BE ALLOWED. WIRE: 14 GAUGE. ELECT. FENCING WIRE.
17. ALL PLANTING BEDS AS DESIGNATED ON THESE PLANS SHALL BE BORDERED BY 1/2" x 4" PAINTED BROWN STEEL EDGING AND RYKSON OR APPROVED EQUAL WITH INTEGRATED STAKES THROUGH SLOTS IN THE EDGING. (REFER TO DETAIL SHEETS FOR SLOPE IN THE EDGING.)
18. ALL TREE PLANTINGS AND PLANTING BEDS WITH 4" OF EITHER SHREDDED HARDWOOD BARK MULCH OR CYPRESS MULCH. IN THE SEASONAL FLOWER BEDS USE EITHER CYPRESS OR PINE BARK MULCH. DO NOT USE HARDWOOD MULCH IN SEASONAL FLOWER BEDS.
19. ALL TREE PLANTINGS SHALL RECEIVE A THREE INCH MULCH TOP DRESSING OF MULCH. OVER A 10 ML. NEED MAY EQUAL TO "WEDGELIK" FABRIC BY "EASY GARDENER" OR DOWMIT WEED BARRIER. SINGLE TREES OR SHRUBS SHALL BE MULCHED TO THE OUTSIDE EDGE OF THE SAUCER OR LANDSCAPE ISLAND (REFER TO PLANTING DETAILS).
20. ALL SLOPES AND EXCEPT THOSE OCCUPIED BY BUILDINGS, STRUCTURES, OR PAVING SHALL BE GRADED SMOOTH AND 4" (INCHES) OF TOPSOIL APPLIED. (REFER TO THE EROSION CONTROL DETAIL SHEETS) FOR TOPSOIL AND SEEDING SPECIFICATIONS).
21. CONTRACTOR SHALL FERTILIZE ALL PLANTS AT THE TIME OF PLANTING WITH 10-10-10 TIME RELEASE FERTILIZER.




SHRUB PLANTING ON SLOPE

N.T.S.




SHRUB PLANTING

N.T.S.

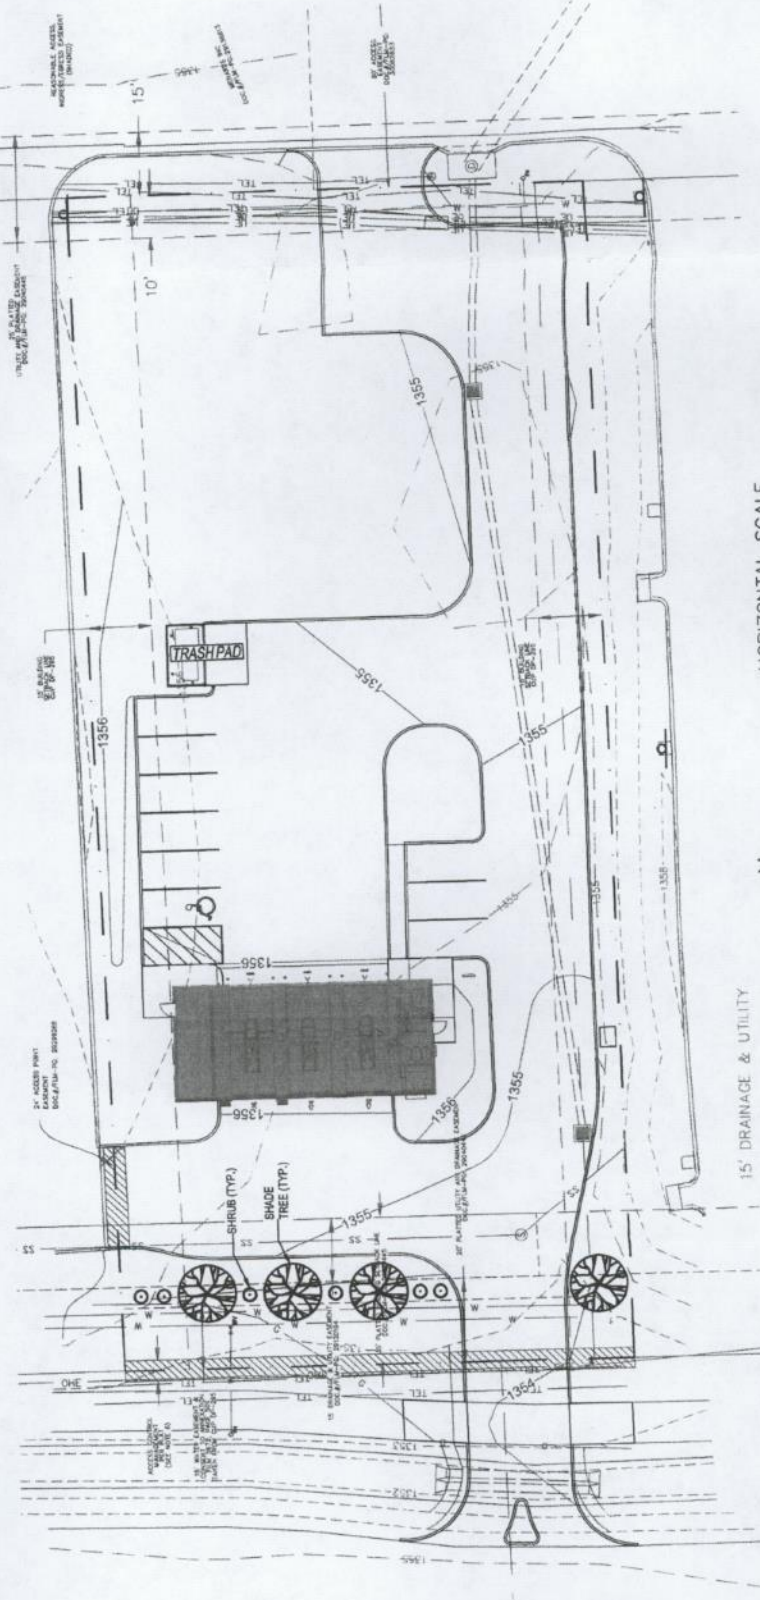

HORIZONTAL SCALE

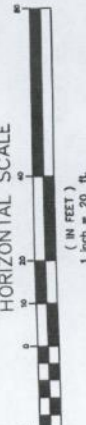

(IN FEET)

1 LANDSCAPE PLAN

C5 SCALE: 1" = 20'