


KOCH COMMUNITY PARK

COMMUNITY UNIT PLAN

DP-304

Northeast Expressway
per Dedication
Film 1236, Pages 958-962

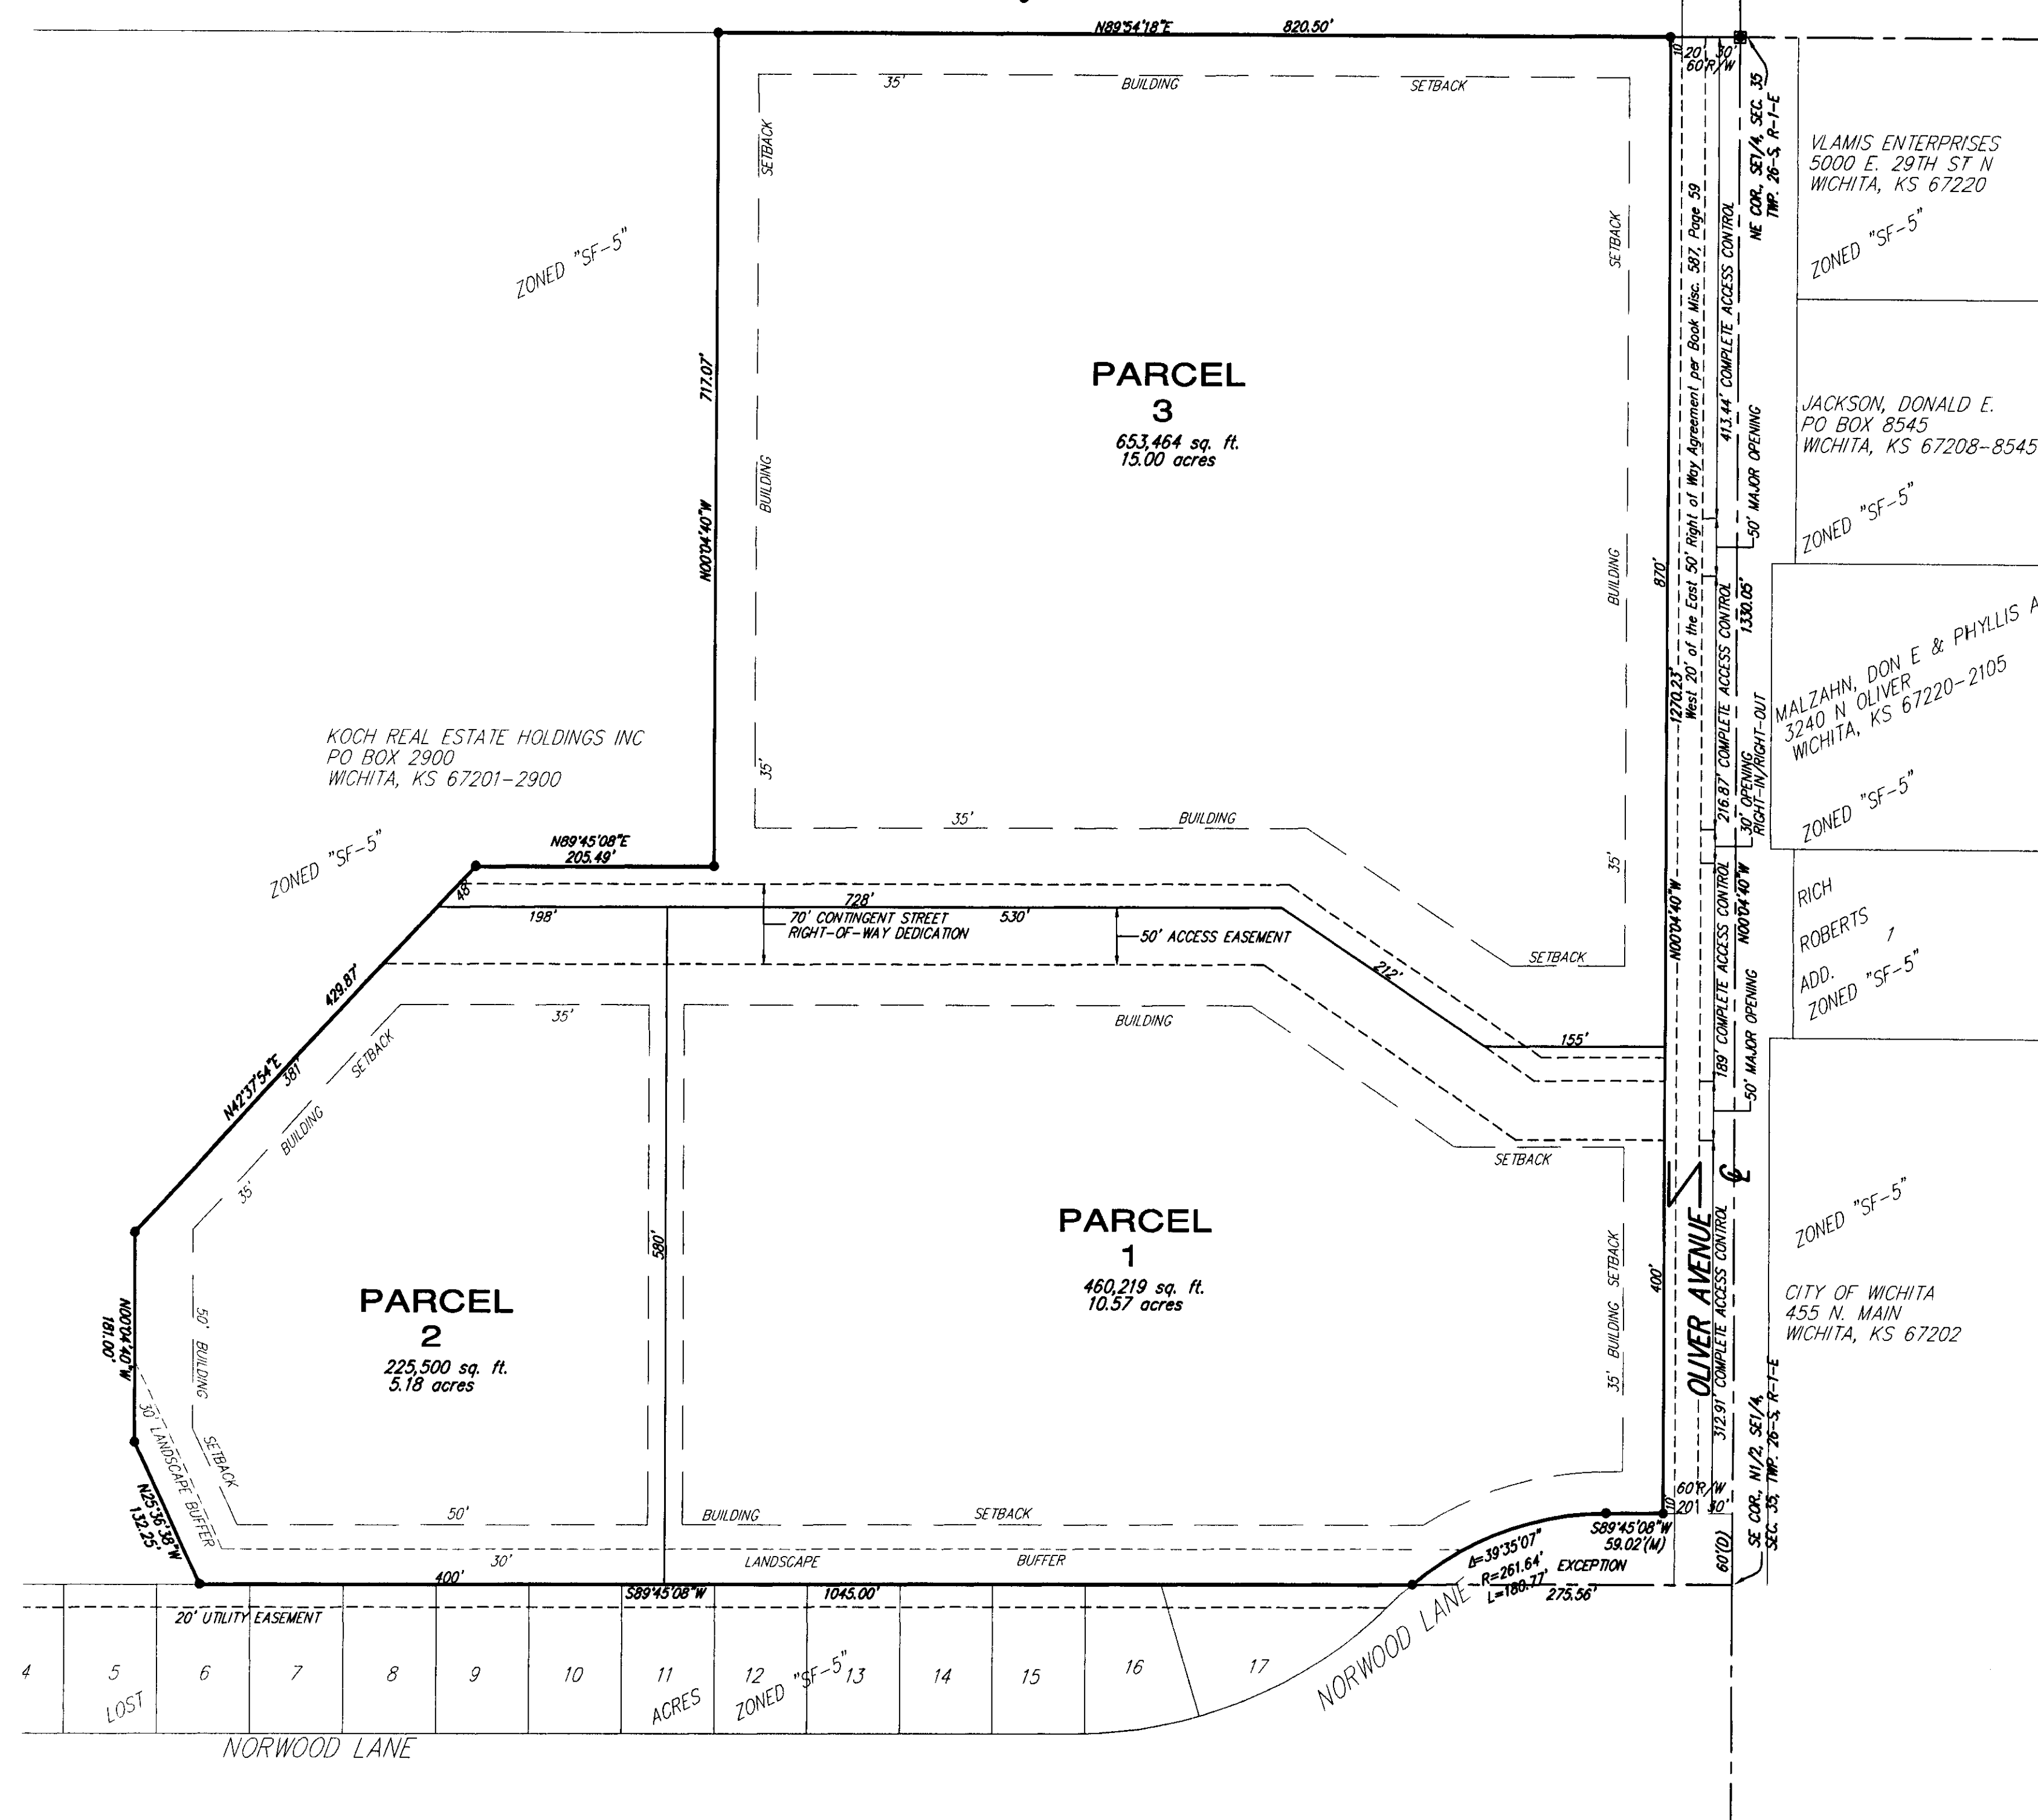

REVISIONS

Created: November 16, 2006
Revised: December 3, 2006
Submitted: December 11, 2006
Revised: January 11, 2007
Revised: January 26, 2007 (per MAPC - January 18, 2007)

PARCEL 1

- Net Area: 460,219 sq. ft. or 10.57 acres
- Maximum Building Coverage: 92,000 sq. ft. or 20 percent
- Maximum Gross Floor Area: 161,077 sq. ft.
- Floor Area Ratio: 35 percent
- Maximum Number of Buildings: One (1)
- Maximum building height to conform to Chapter 28.08 Code of the City of Wichita, but shall be not greater than 35 feet.
- Setbacks: See Drawing
- Access Points: See Drawing

PARCEL 2

- Net Area: 225,500 sq. ft. or 5.18 acres
- Maximum Building Coverage: 45,100 sq. ft. or 20 percent
- Maximum Gross Floor Area: 78,925 sq. ft.
- Floor Area Ratio: 35 percent
- Maximum Number of Buildings: One (1)
- Maximum building height to conform to Chapter 28.08 Code of the City of Wichita, but shall be not greater than 35 feet.
- Setbacks: See Drawing
- Access Points: See Drawing

PARCEL 3

- Net Area: 653,464 sq. ft. or 15.00 acres
- Maximum Building Coverage: 196,039 sq. ft. or 30 percent
- Maximum Gross Floor Area: 228,712 sq. ft.
- Floor Area Ratio: 35 percent
- Maximum Number of Buildings: Five (5)
- Maximum building height to conform to Chapter 28.08 Code of the City of Wichita, but shall be not greater than 45 feet.
- Setbacks: See Drawing
- Access Points: See Drawing

GENERAL PROVISIONS:

- Total Land Area: 1,351,953 ± sq. ft. or 31.04 ± acres
Net Land Area: 1,339,253 ± sq. ft. or 30.75 ± acres
- Total Gross Floor Area: 473,184 sq. ft.
Total Floor Area Ratio: 35 percent
- Parking shall be provided in accordance with Section IV of the Unified Zoning Code, unless otherwise specified in the parcel description.
- Setbacks are as indicated on the C.U.P. drawing, or as specified in the parcel descriptions. If contiguous parcels are to be developed under the same ownership, setbacks between those parcels will not be required.
- A Drainage Plan shall be submitted to City Engineering for approval. Required guarantees for drainage shall be provided at the time of platting improvements.
- Guarantees for specific street improvements for Oliver St. shall be further reviewed and determined at the time of platting.
- Signs shall be in accordance with the Sign Code of the City of Wichita with the following conditions:
 - Each parcel is permitted the following signage along the arterial frontage:

Parcel 1: One monument style sign to be located a minimum of 150 feet north of Norwood Lane along Oliver. The sign shall have a maximum area of 96 square feet and a maximum height of 14 feet. As an option, Parcels 1 and 2 may share one monument style sign with a maximum combined area of 150 square feet and a maximum height of 20 feet.

Parcel 2: One monument style sign to be located in a platted reserve near the major opening on Oliver. The sign shall have a maximum area of 96 square feet and a maximum height of 14 feet. As an option, Parcels 1 and 2 may share one monument style sign with a maximum combined area of 150 square feet and a maximum height of 20 feet.

Parcel 3: Four monument style signs to be located along Oliver. Each sign shall have a maximum area of 96 square feet and a maximum height of 14 feet.

B. Each parcel is permitted the following signage along the access drive frontage:

Parcel 1: One monument style sign with a maximum area of 36 square feet and a maximum height of 8 feet.

Parcel 2: One monument style sign with a maximum area of 36 square feet and a maximum height of 8 feet.

Parcel 3: Three monument style signs with a maximum area of 36 square feet and a maximum height of 8 feet per sign.

C. As the frontage develops along the arterial roadway, monument type signs shall be spaced a minimum of 150' apart within Parcel 3, and a minimum of 75' apart between Parcels 1 and 2, irrespective of how land is leased or sold.

D. Flashing signs (except for signs showing only time, temperature and other public service messages), rotating or moving signs, signs with moving lights or signs which create illusions of movement are not permitted.

E. Portable, off-site and billboard signs are not permitted.

F. Window display signs are limited to 25% of the window area.

G. Building wall signage is prohibited on the south facades on Parcels 1 and 2, and the west facades of Parcel 2.

B. Access Controls shall be as shown on the final plat.

9. All exterior lighting shall be shielded to direct light disbursement in a downward direction and away from residential areas.

10. All parcels shall share similar or consistent parking lot lighting elements (i.e., fixtures, poles, and lamps, and etc.).

A. Limited height of light poles to 24 feet.

B. Extensive use of back lit canopies and neon or fluorescent tube lighting on buildings is not permitted.

11. Utilities shall be installed underground on all parcels.

12. Landscaping for this site shall be required as follows:

A. Development of all parcels within the C.U.P. shall comply with the Landscape Ordinance of the City of Wichita.

B. A landscape plan shall be prepared by a Kansas Landscape Architect for the above referenced landscaping, indicating the type, location, and specifications of all plant material. This plan shall be submitted to the Planning Department for their review and approval prior to issuance of a building permit.

C. A financial guarantee for the plant material approved on the landscape plan for that portion of the C.U.P. being developed shall be required prior to issuance of any occupancy permit, if the required landscape has not been planted.

13. Screening shall be provided along the south and southwest property lines, as indicated on the plan, by a combination of a 30-foot landscape buffer in conjunction with either a solid screening wall or decorative fencing. This buffer shall provide the equivalent of, at minimum, one tree per 20 feet. The existing tree rows may be used to meet the condition of one tree per 20 feet if the existing trees are located on the subject property. Where there are gaps, a mixture of evergreen and deciduous trees shall be installed with one tree per 20 feet with the planting size of the trees meeting the requirements of the landscape ordinance. Screening shall be waived along the west property lines. Solid screening shall be provided for all outdoor work and storage areas, parking lots and loading docks, playgrounds, etc. in order to screen these areas from residential zoning districts.

14. Rooftop mechanical equipment shall be screened from ground level view per Unified Zoning Code.

15. Trash receptacles, loading docks, outdoor storage, and loading areas shall be appropriately screened to reasonably hide them from ground view per Unified Zoning Code.

16. All buildings within each parcel of the C.U.P. shall share uniform architectural character, color, texture, and the same predominate exterior building material, as determined by the Director of Planning. Building walls and roofs must have predominately earth-tone colors, with vivid colors limited to incidental accent, and must employ materials similar to surrounding residential areas. Metal as an exterior material shall be limited to incidental accent.

17. Fire lanes shall be in accordance with the Fire Code of the City of Wichita. No parking shall be allowed in said fire lanes, although they may be used for passenger loading and unloading. The Fire Chief or his designated representative shall review and approve the location and design of all fire lanes. Fire hydrant installation and paved access to all building sites shall be provided for each phase of construction prior to the issuance of building permits.

18. All parcels shall be zoned Limited Commercial with the following use restrictions: Parcels 1 and 2 shall be limited to those uses permitted by right in the "GO" General Office District. Parcel 3 shall be limited to those uses permitted by right in the "LC" Limited Commercial District, except the following uses: manufactured home, accessory apartment, convalescent care facility, golf course, government service, hospital, recycling collection station, reverse vending machine, school (elementary, middle and high), utility (minor), animal care (limited), bed and breakfast inn, broadcasting/recording studio, car wash, construction sales and service, convenience store, hotel or motel, marine facility (recreational), medical service, night club, post office substation, recreation and entertainment (indoor), secondhand store, service station, tavern and drinking establishment, vehicle repair (limited), storage (outdoor), and communication towers.

No parcel within this C.U.P. shall allow the use of adult entertainment establishments, sexually oriented business, correctional placement residences, asphalt/concrete safety service, pawn shop, agricultural sales and service, commercial wireless communication facilities or theater. Restaurants that serve liquor can be developed and may serve liquor, as long as food is the primary service of the establishment. There shall be a prohibition of all overhead doors facing residential zoning, except on west property line, and for all drive-in windows within 200 feet of residential zoning. Any single retail use shall be limited to a maximum size of 40,000 square feet, except for a grocery store or drug store.

19. Cross-lot circulation agreements shall be required at the time of platting to assure internal vehicular movement between parcels within the C.U.P.

20. Amendments, adjustments or interpretations to this C.U.P. shall be done in accordance with the Unified Zoning Code.

21. The Transfer of title of all or any portion of land included within the Community Unit Plan (or any amendments thereto) does not constitute a termination of the plan or any portion thereof, but said plan shall run with the land and be binding upon present owners, their successors and assigns.

22. The development of this property shall proceed in accordance with the development plan as recommended for approval by the Planning Commission and approved by the Governing Body, and any substantial deviation of the plan, as determined by the Zoning Administrator and the Director of Planning, shall constitute a violation of the building permit authorizing construction of the proposed development.

23. Any major changes in this development plan shall be submitted to the Planning Commission and to the Governing Body for their consideration.

24. A plan for a pedestrian walk system shall be submitted and approved by the Director of Planning prior to the issuance of building permits. Said walk system shall link sidewalks along Oliver St. with the proposed buildings within the subject property, as well as link buildings within each parcel.

25. Site access for Parcels 1 and 2 shall be provided by a 24-foot (minimum) drive located within the 50-foot access easement, as shown on the plan. Upon development within Parcel 3, the contingent right-of-way dedication shall be activated and the existing access drive shall be rebuilt to a City standard street.

26. Approval of a site circulation plan by the Planning Director is required for each phase of construction prior to the issuance of a building permit to insure vehicular connections between uses in each parcel.

27. Transportation improvements:

- Slight modifications on the CUP drawing may be needed during platting to align the drives in this manner.
- Provide petition(s) to guarantee construction of left turn center lanes to both major entrances.
- Access to Norwood Lane is prohibited.


DP-304

APPROVED CUP

MAPC 01-18-07 DM

WCC 03-06-07 DM

MAPD Copy 1 of 2

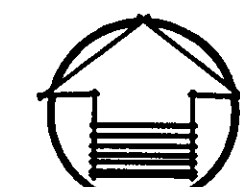


SCALE: 1" = 100'

DP-304

KOCH COMMUNITY PARK
COMMUNITY UNIT PLAN

Baughman Company, P.A.
315 Ellis St. Wichita, KS 67211 P 316-262-7271 F 316-262-0149
Baughman ENGINEERING | SURVEYING | PLANNING | LANDSCAPE ARCHITECTURE

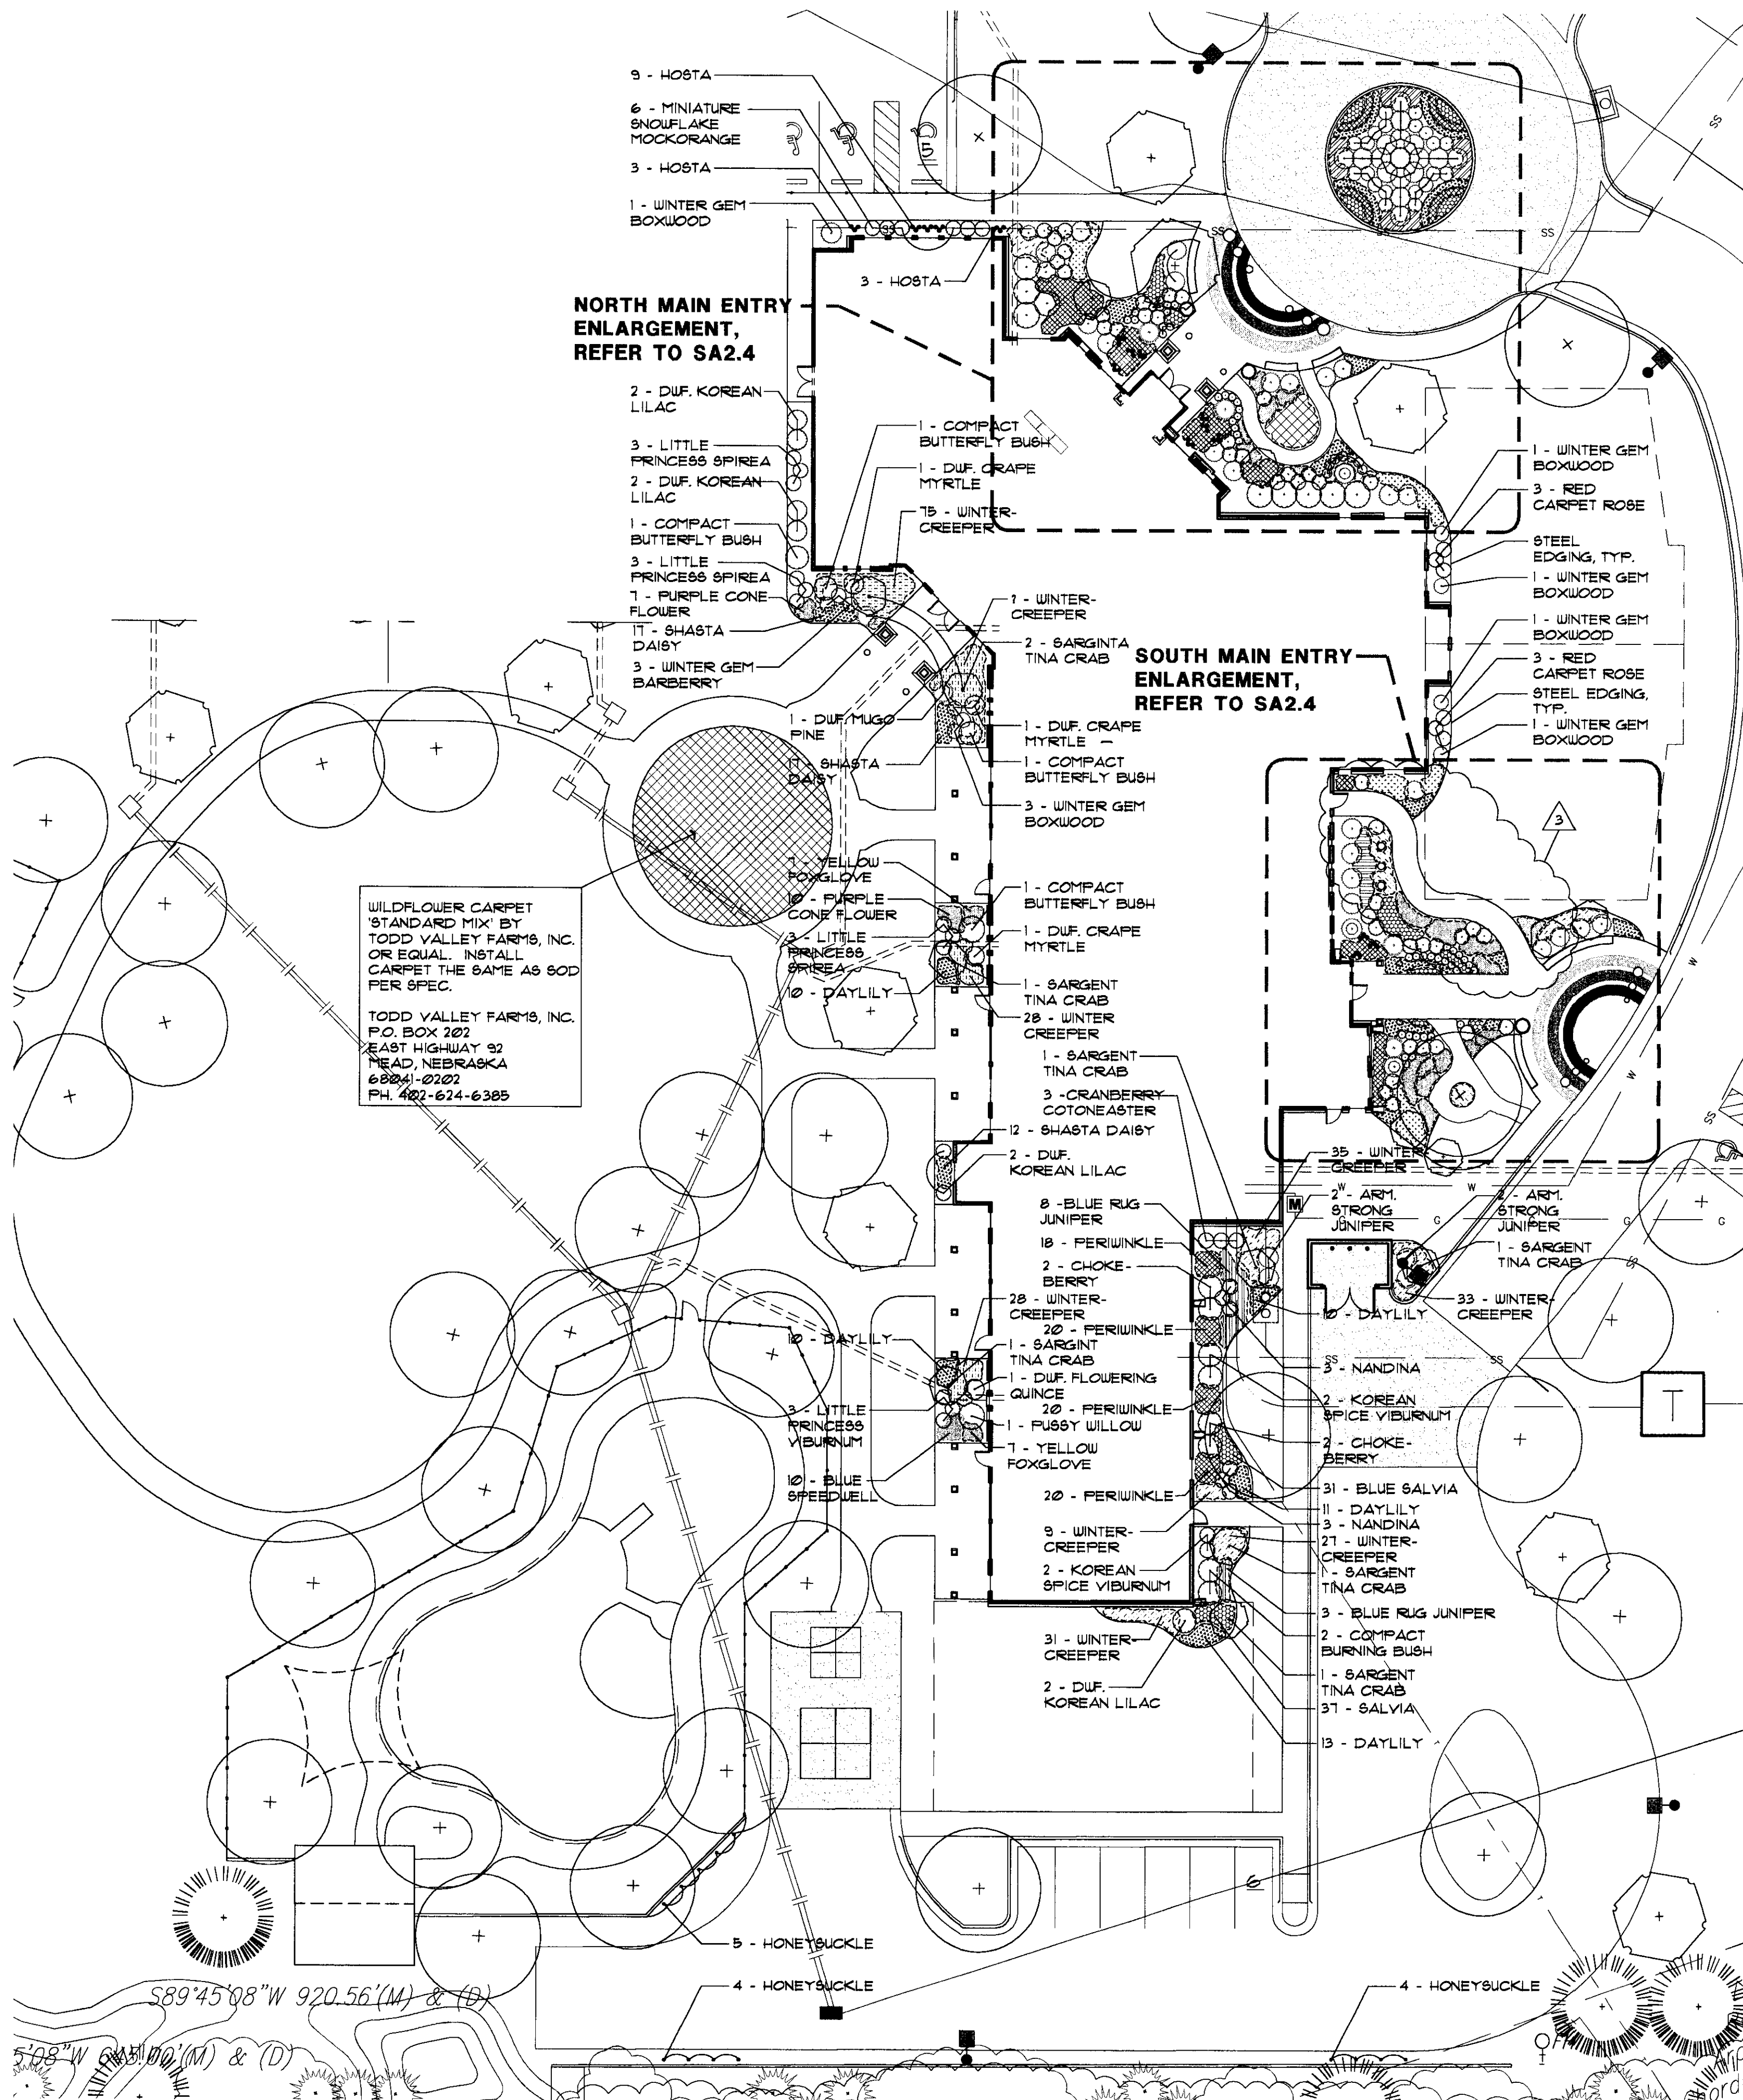


PLANT SCHEDULE

COMMON NAME	BOTANICAL NAME	SIZE	COND.	REMARKS
TREES				
SKYLINE HONEYLOCUST	Gleditsia triacanthos inermis 'Skyline'	2'-2 1/2'	B 4 B	
GREEN ASH	Fraxinus pennsylvanica	2'-2 1/2'	B 4 B	
SUGAR MAPLE	Acer saccharum	2'-2 1/2'	B 4 B	
SAWTOOTH OAK	Quercus acutissima	2'-2 1/2'	B 4 B	
BUR OAK	Quercus macrocarpa	2'-2 1/2'	B 4 B	
BALD CYPRESS	Taxodium distichum	2'-2 1/2'	B 4 B	
LACEBARK ELM	Ulmus parvifolia	2'-2 1/2'	B 4 B	
CHINESE PISTACHE	Pistacia chinensis	2'-2 1/2'	B 4 B	
GINKGO	Ginkgo biloba	2'-2 1/2'	B 4 B	
JAPANESE PAGODA TREE	Sophora japonica	2'-2 1/2'	B 4 B	
KENTUCKY COFFEE TREE	Gymnocladus dioica	2'-2 1/2'	B 4 B	
AMERICAN LINDEN	Gymnocladus dioica	2'-2 1/2'	B 4 B	
MULBERRY	Morus spp. Moraceae	2'-2 1/2'	B 4 B	
PERSIMMON	Diospyros virginiana	2'-2 1/2'	B 4 B	
SWEETGUM	Liquidambar styraciflua	2'-2 1/2'	B 4 B	
SYCAMORE	Platanus occidentalis	2'-2 1/2'	B 4 B	
WEeping WILLOW	Salix babylonica	2'-2 1/2'	B 4 B	
CORKSCREW WILLOW	Salix matsudana 'Tortosa'	2'-2 1/2'	B 4 B	
WESTERN SOAPBERRY	Sapindus drummondii	2'-2 1/2'	B 4 B	
CATALPA	Catalpa speciosa	2'-2 1/2'	B 4 B	
COTTONWOOD	Populus deltoides	2'-2 1/2'	B 4 B	
EVERGREEN TREES				
AUSTRIAN PINE	Pinus nigra	6-8' HT.	B 4 B	
ARBORVITAE, GREEN GIANT	Thuja standishii x plicata	6-8' HT.	B 4 B	
ORNAMENTAL TREES				
THORNLESS COCKSPUR HAWTHORN	Crataegus crugallii var. inermis	1 1/2'-2'	B 4 B	
SARGENT TINA CRABAPPLE	Malus Sargentii 'Tina'	1 1/2'-2'	B 4 B	
REDBUD	Cercis canadensis	1 1/2'-2'	B 4 B	
PRAIRIFIRE CRAB	Malus 'Prairifire'	1 1/2'-2'	B 4 B	
SNOWDRIFT CRAB	Malus 'Snowdrift'	1 1/2'-2'	B 4 B	
GOLDEN RAIN TREE	Koeleruteria paniculata	1 1/2'-2'	B 4 B	
FLAME AMUR MAPLE	Acer glabrum 'Flame'	1 1/2'-2'	B 4 B	
CORKSCREW HAZEL	Corylus avellana 'Contorta'	1 1/2'-2'	B 4 B	
DECIDUOUS SHRUBS				
SNOWFLAKE MOCK ORANGE, DUF.	Philadelphus x virginialis 'Dwarf Snowflake'	3 GAL.	CONT.	
RED CARPET ROSE	Rosa x noae	3 GAL.	CONT.	COLOR RED
BARBERRY, DUF. BAGATILLE	Berberis thunbergii 'Bagatille'	3 GAL.	CONT.	
LITTLE PRINCESS SPIREA	Spiraea japonica 'Little Princess'	3 GAL.	CONT.	
JUDD VIBURNUM	Viburnum x juddii	5 GAL.	CONT.	
CRANBERRY COTONEASTER	Cotoneaster spiculata	3 GAL.	CONT.	
COMPACT BURNING BUSH	Euonymus alatus compacta	5 GAL.	CONT.	
GRAPE MYRTLE, DUF.	Lagerstroemia indica 'Low Flame'	5 GAL.	CONT.	
FUSSY WILLOW	Salix discolor	3 GAL.	CONT.	
CHOKEBERRY	Aronia arbutifolia	5 GAL.	CONT.	
NANDINA	Nandina domestica 'Harbour Dwarf'	3 GAL.	CONT.	
FLOWERING QUINCE	Chamaeas speciosa 'Texas Scarlet'	3 GAL.	CONT.	
ANTHONY WATERER SPIREA	Spiraea x bumalda 'Anthony Waterer'	3 GAL.	CONT.	
KOREAN SPICE VIBURNUM	Viburnum carlesii	3 GAL.	CONT.	
KOREAN LILAC, DUF.	Syringa meyeri Palatin Duf. Korean Lilac	3 GAL.	CONT.	
BUTTERFLY BUSH, COMPACT	Buddleia davidii 'Peckee'	3 GAL.	CONT.	
EVERGREEN SHRUBS				
DWARF MUGHO PINE	Pinus mugho mugho	5 GAL.	CONT.	
ARMSTRONG JUNIPER	Juniperus chinensis 'Armstrongii'	5 GAL.	CONT.	
WINTER GEM BOXWOOD	Buxus microphylla var. koreana 'Winter Gem'	3 GAL.	CONT.	
SPARTAN JUNIPER	Juniperus chinensis 'Spartan'	6' HT.	B 4 B	SPIRAL TOPIARY COLUMN
BEEHIVE DWARF JAPANESE HOLLY	Ilex crenata 'Beehive'	5 GAL.	CONT.	
BLUE STAR JUNIPER	Juniperus squamata 'Blue Star'	5 GAL.	CONT.	
ORNAMENTAL GRASS				
LITTLE BUNNY FOUNTAIN GRASS	Pennisetum alopecuroides 'Little Bunny'	2 GAL.	CONT.	
FOUNTAIN GRASS, DUF.	Pennisetum alopecuroides 'Hamel'	2 GAL.	CONT.	
GROUNDCOVERS & PERENNIALS				
DAYLILY	Hemerocallis sp. 'Black eyed Stella'	1 GAL.	CONT.	SPACE 18" O.C.
BLUE RUG JUNIPER	Juniperus horizontalis 'Wiltonii'	2 GAL.	CONT.	SPACE 36" O.C.
WINTERCREEPER	Euonymus fortunei 'Coloratus'	4" POT	CONT.	SPACE 18" O.C.
SALVIA (EAST FRIESLAND)	Salvia x superba	4" POT	CONT.	SPACE 12" O.C.
HOSTA	Hosta plantaginea	1 GAL.	CONT.	SPACE AS SHOWN
FERN, AUTUMN	Dryopteris erythrosora Brilliance	1 GAL.	CONT.	SPACE 18" O.C.
PERIWINKLE	Vinca minor	4" POT	CONT.	SPACE 15" O.C.
SPRING SNOWFLAKE	Leucojum vernum	4" POT	CONT.	SPACE 12" O.C.
PINK COTTAGE	Dianthus plumarius	4" POT	CONT.	SPACE 12" O.C.
EDGING CANDYTUFT	Iberis sempervirens	4" POT	CONT.	SPACE 15" O.C.
ROSY GLOW SEDUM	Sedum 'Rosy Glow'	4" POT	CONT.	SPACE 12" O.C.
BLUE FESCUE	Festuca ovina glauca 'Elijah Blue'	1 GAL.	CONT.	SPACE AS SHOWN
LILY TURF	Liriope spicata	1 GAL.	CONT.	SPACE 18" O.C.
LAMB'S EAR, STACHYS	Stachys lanata	4" POT	CONT.	SPACE 15" O.C.
PURPLE CONE FLOWER	Echinacea purpurea 'Grimson Star'	1 GAL.	CONT.	SPACE 18" O.C.
YELLOW FOXGLOVE	Digitalis grandiflora	1 GAL.	CONT.	SPACE 18" O.C.
BLUE SPEEDWELL	Veronica 'Sunny Border Blue'	1 GAL.	CONT.	SPACE 18" O.C.
CHYSANTHEMUM	Chrysanthemum zawadskii var. Latilobum 'Clara Curtis'	1 GAL.	CONT.	SPACE 24" O.C.
SHASTA DAISY	Chrysanthemum maximum	4" POT	CONT.	SPACE 15" O.C.
SWEET WOODRIF	Galium odoratum	4" POT	CONT.	SPACE 12" O.C.
GARDEN PHLOX	Phlox paniculata 'David'	4" POT	CONT.	SPACE 15" O.C.
CREEPING PHLOX	Phlox subulata	4" POT	CONT.	SPACE 12" O.C.
VINE				
GOLDFLAME HONEYSUCKLE	Lonicera x heckrottii 'Goldflame'	2 GAL.	CONT.	TRAIN ON FENCE
LAWN				
FESCUE	-----	-----	SOD	
FESCUE	-----	-----	SEED	
NATIVE GRASS				
SHORT NATIVE GRASS (MIX)	-----	-----	SEED	REFER TO SPECIFICATION

NOTE:
1. TREES ARE SHOWN FOR REFERENCE.
SEE SA2.1 FOR DESIGNATION AND QUANTITY.
2. SEE GENERAL NOTES ON SA2.4.



DR-304 PARCEL 1
LANDSCAPE PLAN
10-04-07
SHEET 2 of 4
MAP & Copy 2 of 2

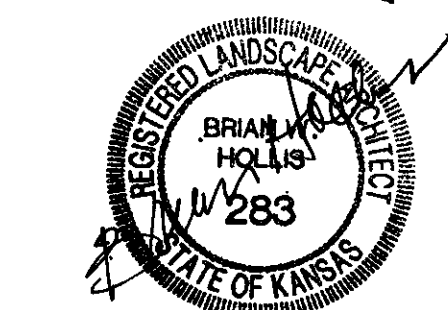

9.27.07



Wilson Darnell Mann P.A.
105 N. Washington Wichita, Kansas 67202
ph 316.262.4700 fx 316.262.0002
www.wdmdesign.com


RAINBOWS
UNITED, INC.
NEW NORTHEAST FACILITY
Oliver Avenue & Highway 96
Wichita Kansas

PRINTS ISSUED
July 10, 2007 - CONSTRUCTION DOCUMENTS
SEPTEMBER 21, 2007 - REV. #3


WDM No. 05240
drawn: bh
checked: le

PLANTING PLAN AT BUILDING - BASE BID

SA2.2
copyright 2007 Wilson Darnell Mann P.J.

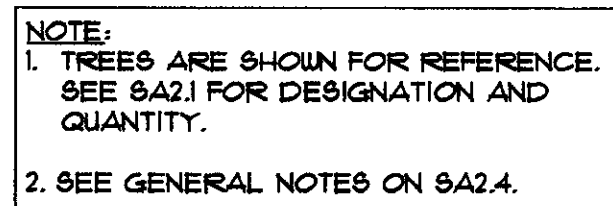

DP-304 PARCEL 1
LANDSCAPE PLAN
10-4-07 P.E.
SHEET 9 of 4
MARD 08/11/07

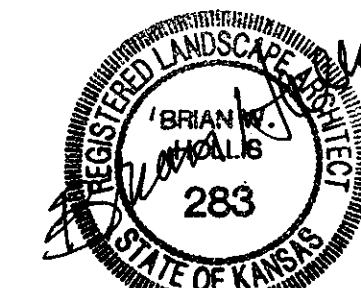

9.27.05

w d n
a r c h i t e c t s

Wilson Darnell Mann P.A.
105 N. Washington Wichita, Kansas 67202
ph 316.262.4700 fx 316.262.0002
www.wdmdesign.com


RAINBOWS
UNITED, INC.
NEW NORTHEAST FACILITY
Oliver Avenue & Highway 96
Wichita, Kansas

PRINTS ISSUED
July 10, 2007 - CONSTRUCTION DOCUMENT
SEPTEMBER 21, 2007 - REV. #3


WDH No. **05240**

PLANTING PLAN AT BLDG. - ADD ALT. #1

PLANTING PLAN
AT BLDG. - ADD ALT. #1

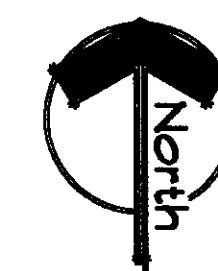

SA2.3

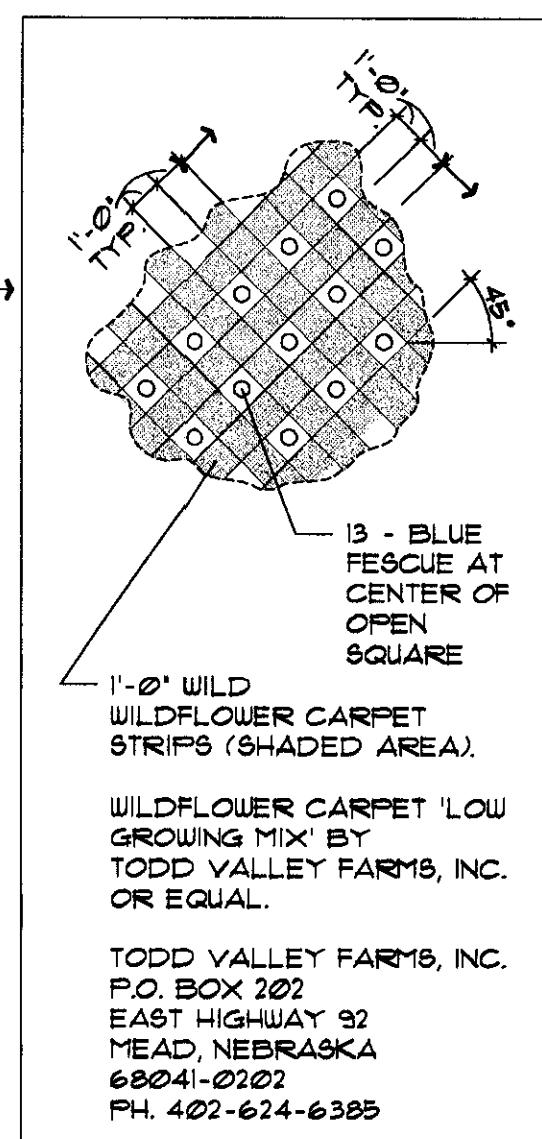

© copyright 2007 Wilson Darnell Mann

LANDSCAPE ORDINANCE CALCULATIONS

LANDSCAPE PLAN AS REQUIRED BY KOCH COMMUNITY PARK COMMUNITY UNIT PLAN DP-304

THE FOLLOWING INFORMATION IS THE TYPICAL LANDSCAPE ORDINANCE CALCULATIONS FOR THE CITY OF WICHITA:

LANDSCAPE STREET YARD

400.00 (TOTAL LINEAL FT. OF ST. YARD FRONTAGE)
X 2.22 S.F. FACTOR
8,800.00 TOTAL S.F. OF LANDSCAPE ST. YARD REQ'D.
+ 500 (1 TREE PER 500 S.F.)
16 TREES REQ'D.

22 TREES PROVIDED (25 SHADE + 14 ORNAMENTAL)

108,231.50 S.F. OF LANDSCAPE STREET YARD PROVIDED

SIDE AND REAR YARD BUFFERS

SOUTH PROPERTY LINE BUFFER REQUIRED BY CLUP

PARKING LOT SCREENING & LANDSCAPING

PARKING LOT 18 SCREENING - N/A

PARKING LOT TREES

102 PARKING STALLS
X 20 (ONE TREE PER 20 STALLS)
2,040 (1 TREE PER 20 STALLS)
51 OR 84Y & TREES REQ'D. (1/2 MUST BE INTERIOR)
16 TREES PROVIDED (2 PROVIDED FROM STREET YARD)
(ONE-HALF OF THE STREET YARD TREES MAY BE USED TO FULFILL PARKING LOT TREE REQUIREMENT)

IMPERVIOUS AREA

342,883.30 S.F.

TOTAL SITE AREA

460,219.00 S.F.


NOTE:
SEE GENERAL NOTES ON SHEET SA2.4

- △ = 3/4" Iron Pipe Found
- X = Stone with Cross Found
- = #6 Rebar in Concrete Found
- = #5 RB Rebar Found
- = P.K. Nail Found
- △ = #5 Municipal Rebar Found
- X = #4 Baughman Rebar Found
- = #5 Mid Kansas Rebar Found
- ⊗ = Chiseled Cross Set

- (C) = Calculated
- (D) = Described
- (M) = Measured
- (P) = Platted

MAIN ENTRY - ISLAND ENLARGEMENT, REFER TO SA2.4

DP-304 PARCEL 1
LANDSCAPE PLAN
10-04-07
SHEET 1 OF 4
MAPP COPY 1 OF 2

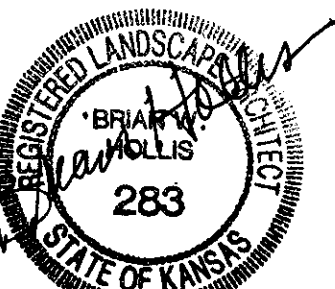

wdm
architects

Wilson Darnell Mann P.A.
105 N. Washington, Wichita, Kansas 67202
ph 316.262.4700 fx 316.262.0002
www.wdmarchitects.com

RAINBOWS
UNITED, INC.
NEW NORTHEAST FACILITY
Oliver Avenue & Highway 96
Wichita, Kansas

PRINTS ISSUED
July 10, 2007 - CONSTRUCTION DOCUMENTS
SEPTEMBER 21, 2007 - REV. #3


WDM No.
05240

drawn: bh
checked: le

OVERALL PLANTING PLAN - TREES AND TURF

CA2.1

© copyright 2007 Wilson Darnell Mann P.A.

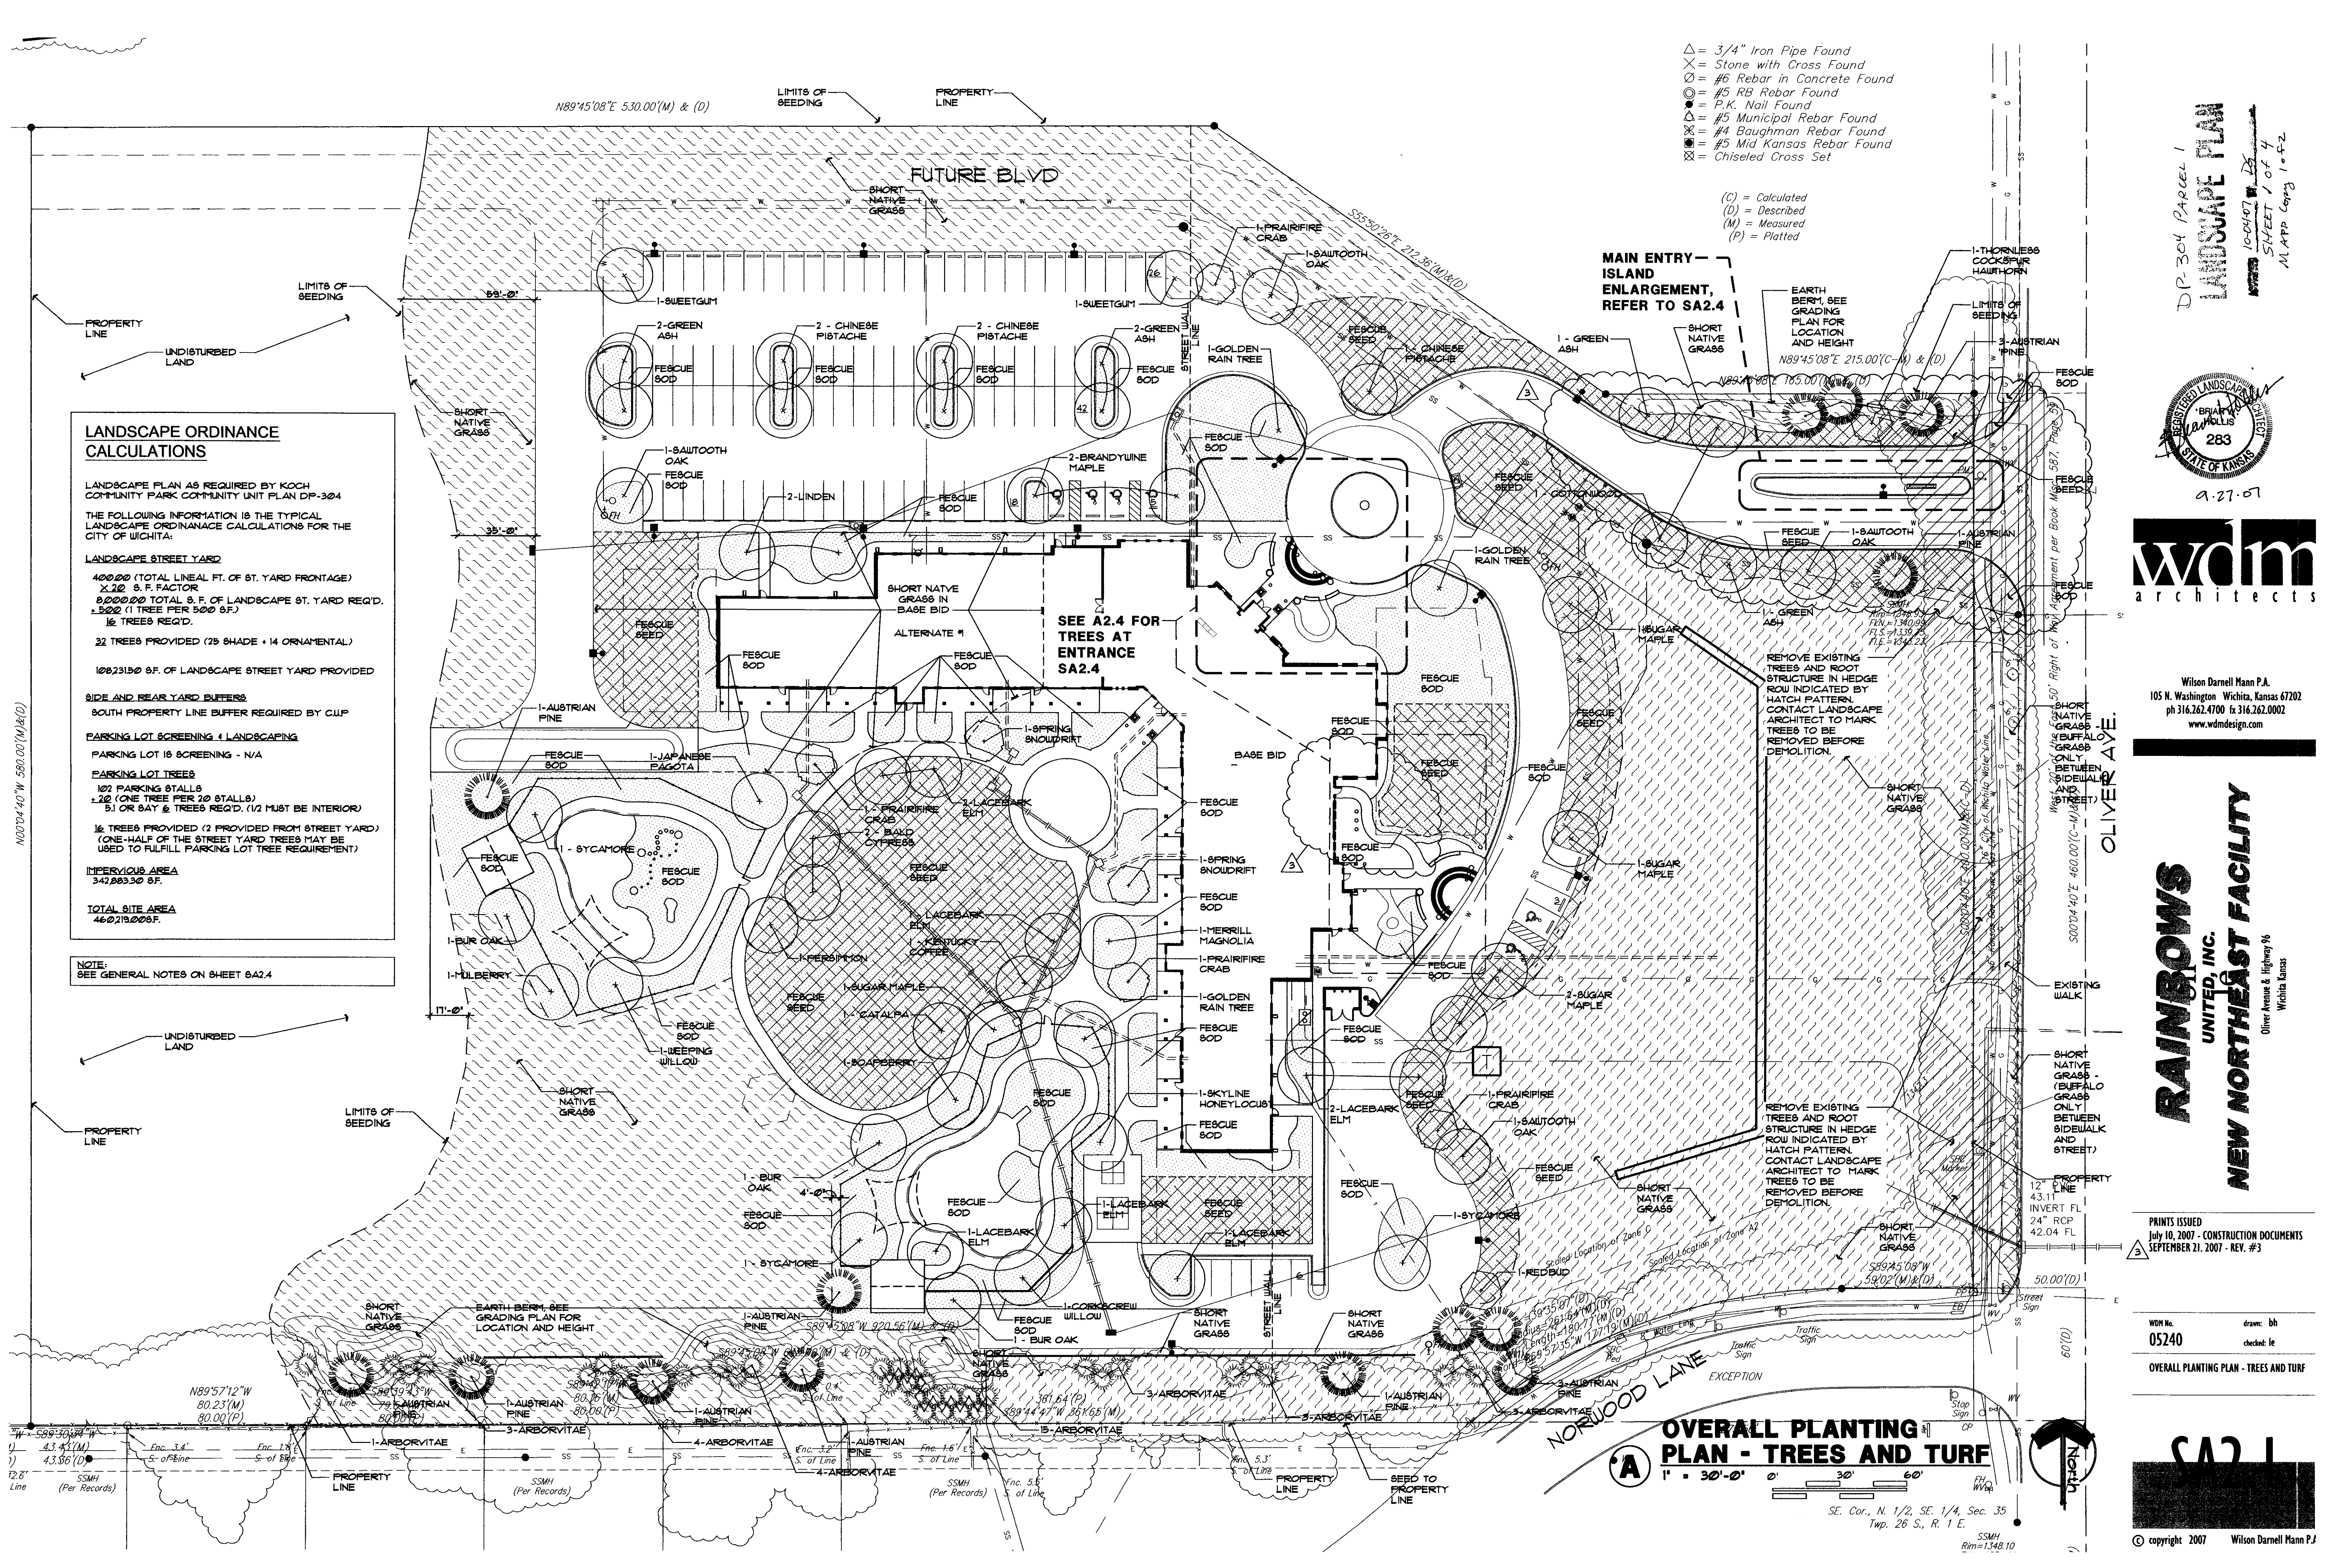

N89°45'08"E 530.00'(M) & (D)

LIMITS OF SEEDING

PROPERTY LINE

FUTURE BLVD

Post-It® Fax Note 7671

Date 9-4-08

of pages 1

To Jim Garrett
Co. Dept. Rainbows
Phone #
Fax # 267-5444

From Brian Hallin
Co.
Phone #
Fax #

LANDSCAPE ORDINANCE CALCULATIONS

LANDSCAPE PLAN AS REQUIRED BY KOCH
COMMUNITY PARK COMMUNITY UNIT PLAN DP-384
THE FOLLOWING INFORMATION IS THE TYPICAL
LANDSCAPE ORDINANCE CALCULATIONS FOR THE
CITY OF WICHITA.

LANDSCAPE STREET YARD

4888.88 (TOTAL LINEAL FT. OF ST. YARD FRONTAGE)
X 2.28 S.F. FACTOR
= 11144.44 TOTAL S.F. OF LANDSCAPE ST. YARD REQ'D.
= 1582 (1 TREE PER 500 S.F.)
= 15 TREES REQ'D.

22 TREES PROVIDED (15 SHADE + 7 ORNAMENTAL)

18835.96 S.F. OF LANDSCAPE STREET YARD PROVIDED

SIDE AND REAR YARD BUFFERS

SOUTH PROPERTY LINE BUFFER REQUIRED BY CLIP

PARKING LOT SCREENING & LANDSCAPING

PARKING LOT IS SCREENING - N/A

PARKING LOT TREES

16 PARKING STALLS
= 16 (ONE TREE PER 20 STALLS)
= 16 OR 24 TREES REQ'D (1/2 MUST BE INTERIOR)
= 16 TREES PROVIDED (2 PROVIDED FROM STREET YARD)
(ONE-HALF OF THE STREET YARD TREES MAY BE
USED TO FULFILL PARKING LOT TREE REQUIREMENT)

EXTERIOR AREA

347,885.30 S.F.

TOTAL SITE AREA

448,778.00 S.F.

NOTE: SEE GENERAL NOTES ON SHEET SA2.4

SUPPLEMENTAL
PLANTINGS
BY OWNER
NOT REQUIRED
BY LANDSCAPE
ORDINANCE

ISLAND
ENLARGEMENT,
REFER TO SA2.4

SEE A2.4 FOR
TREES AT
ENTRANCE
SA2.4

OVERALL PLANTING PLAN - TREES AND TURF

1" = 30'-0"

SE 1/4, N 1/2, SE 1/4, Sec. 35
Twp. 26 S., R. 1 E.
SSM (Per Records)



Wilson Daniel Hall P.A.
105 S. Washington Wichita, Kansas 67202
P 314.262.4700 & 314.262.8001
www.wilsondaniel.com

RAINBOWS
UNITED, INC.
NEW NORTHEAST FACILITY

PRINTS ISSUED
1st M. 2007 - CONSTRUCTION DOCUMENTS
SEPTEMBER 21, 2007 - REV. #3
OCTOBER 14, 2007 - REV. #4

05240

OVERALL PLANTING PLAN - TREES AND TURF

SA2.1

© copyright 2007 Wilson Daniel Hall P.A.

DP-304 PARCEL SUPPLEMENT
LANDSCAPE PLAN

APPROVED 06-30-09 BY Dg
ADDENDUM TO SHEET 1044
AND SUPPORTING DOCUMENTATION
MAP Copy 1 of 2

LANDSCAPE PLAN

APPROVED 7/1/13 BY NAD

PP-304 MAY 24 2013

ARCHITECTURE
Empire Center
257 N. Broadway
Wichita, Kansas
67202-2517
Tel: 316.261.1111
Fax: 316.261.1111
www.aicf.com
architecture@aicf.com

SCHAEFER JOHNSON COX FREY



PROFESSIONAL ENGINEERING CONSULTANTS, P.A.
STRUCTURAL ENGINEERS
PROFESSIONAL ENGINEERING CONSULTANTS, P.A.
MECHANICAL ENGINEERS
PROFESSIONAL ENGINEERING CONSULTANTS, P.A.
ELECTRICAL ENGINEERS
PROFESSIONAL ENGINEERING CONSULTANTS, P.A.
CIVIL ENGINEERS

QUIVIRA COUNCIL - BSA
KOCH SCOUTING CENTER

3247 N. OLIVER
WICHITA, KS 67220

©2013
Schaefer Johnson Cox Frey Architecture, Inc.
All Rights Reserved.
These drawings and their contents, including, but not limited to, all concepts, designs, sketches and the exclusive property of Schaefer Johnson Cox Frey Architecture, Inc. may not be used or reproduced in any way without the express consent of SJCF.

Revisions

Project Number
5013.00

Date

7 FEB 2013
LANDSCAPING /
SCREENING PLAN

SA22.1

KEYED NOTES

- 32.15 SHUMARD OAK - 2" CAL, B&B
32.16 EXISTING TREE ROW TO REMAIN
32.17 EXISTING WOOD PRIVACY FENCE
32.18 EXISTING CHAIN LINK FENCE

FFE = 1353.00 (NAVD 88)
REFERENCED AS 100'-0"
ARCHITECTURAL

A LANDSCAPING / SCREENING PLAN

1" = 20'-0"





Wichita-Sedgwick County Metropolitan Area Planning Department

February 15, 2013

Quivira Council, Boy Scouts of America
1555 East 2nd Street North
Wichita, KS 67214

RE: DP-304 – Administrative Adjustment to DP-304 Koch Community Park Community Unit Plan (“CUP”), Parcel 2 to allow retail sales to members only, generally located west of North Oliver Avenue and south of K-96 Northeast Expressway. (CUP2013-00001)

We have received and reviewed your request for an Administrative Adjustment to Parcel 2 to retail sales to members only on Parcel 2. Currently, per General Provision 18, which states, in part: All parcels shall be zoned Limited Commercial with the following use restrictions: Parcels 1 and 2 shall be limited to those uses permitted by right in the “GO” General Office District.”

It is our understanding that Parcel 2 is being developed for administrative offices for the Quivira Council of the Boy Scouts of America. A part of the administrative office activity there is to be provided an area of approximately 1,000 square feet that may be used for the sale of materials related to Scouting (merit badges, awards, camping or other activities involved with Scout activities). The GO district does not permit retail sales; therefore, to permit the proposed merchandising of Scouting related materials, the CUP needs to be adjusted.

On the basis of our review, an adjustment to the CUP in the manner you have requested and granted herein would be consistent with the approved CUP and will not have an adverse effect on the CUP or on adjacent properties, nor will it be a substantial deviation from the original plan.

Our signatures below indicate that an administrative adjustment has been granted to adjust General Provision 18 of the CUP as follows. This adjustment shall not be deemed to alter any other provisions of the CUP, except as expressly stated herein.

All parcels shall be zoned Limited Commercial with the following use restrictions: Parcels 1 and 2 shall be limited to those uses permitted by right in the “GO” General Office District.” except that Parcel 2 shall be allowed the retail sales of merchandise used in Boy Scouts of America activities or programs to members or prospective members of the Boy Scouts of America. Parcel 3 shall...and communication towers.

Within 30 days, please submit four revised CUP drawings to reflect the approved adjustments.

City Hall • 10th Floor • 455 North Main • Wichita, Kansas 67202-1688

T 316.268.4421 **F** 316.268.4390


www.wichita.gov

The zoning notification signs may now be removed from the property.



for

John L. Schlegel
Director of Planning

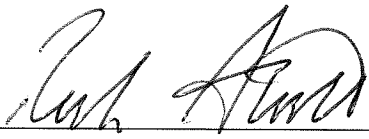

Rick Stubbs
Assistant Building Plan Review Administrator

cc: Paul Hays, Office of Central Inspection
J. R. Cox, Office of Central Inspection



FILE COPY

Wichita-Sedgwick County Metropolitan Area Planning Department

August 21, 2013

Koch Real Estate Holdings, Inc.
Attn: Sher French
4111 East 37th Street North (P.O. Box 2256)
Wichita, KS 67220

Baughman Company, P. A.
Attn: Russ Ewy
315 Ellis
Wichita, KS 67211

RE: Administrative Adjustment (CUP2013-00026) to General Provisions 24 and 25 of the Koch Community Park Community Unit Plan ("CUP") DP-304 to clarify which parcels are responsible for sidewalk, turn lane and street and drive improvements on property generally located south of K-96 Highway and west of North Oliver Avenue and platted as Lots 1-3, Block A, Koch Community Park Addition.

Per General Provision 24 of CUP DP-304 "A plan for a pedestrian walk system shall be submitted and approved by the Director of Planning prior to the issuance of building permits. Said walk system shall link sidewalks along Oliver Street with the proposed buildings within the subject property as well as link buildings within each parcel."

You have requested to add the following language to General Provision 24: *The sidewalk extension required by the City located on the north side of Parcel 1, extending from the end of the sidewalk connecting with Oliver Street, shall be shared between the owners of each parcel in the following manner: Parcel 1 – 35%, Parcel 2 – 15% and Parcel 3 – 50%. Construction of said sidewalk may be deferred until Lot 3 is developed.*

Per General Provision 25 of CUP DP-304 "Site access for Parcels 1 and 2 shall be provided by a 24-foot (minimum) drive located within the 50-foot access easement, as shown on the plan. Upon development within Parcel 3, the contingent right-of-way dedication shall be activated and the existing access drive shall be rebuilt to a City standard street."

You have requested to add the following language to General Provision 25: *Per Resolution No. 07-502 filed 9/27/2007, the cost of the turn lane shall be shared equally by the owners of Parcels 1, 2 and 3. In addition to the turn lane, the 24-foot access drive will need to be built to the current City street standards for a public street. The cost of the public street shall be allocated between the owners of each parcel in the following manner: Parcel 1 – 35%, Parcel 2 – 15% and Parcel 3 – 50%.*

City Hall • 10th Floor • 455 North Main • Wichita, Kansas 67202-1688

T 316.268.4421 F 316.268.4390

www.wichita.gov

We have reviewed your request and have approved the requested additions to General Provisions 24 and 25 as described above.

All other applicable development standards shall apply unless specifically adjustment or amended.


Except as expressly stated above, this adjustment shall not be deemed to alter any other provisions of the CUP.

The zoning notification signs may now be removed from the property.

This adjustment shall not be effective until four revised copies of the CUP have been submitted to the Metropolitan Area Planning Department.



John L. Schlegel
Director of Planning

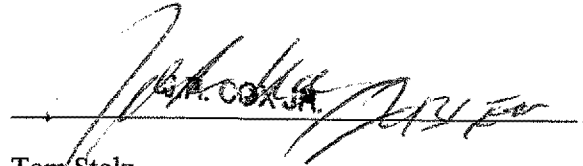

Tom Stolz
Director of the Metropolitan Area Building and
Construction Department

cc: Rainbows United, Inc., 3223 N. Oliver, Wichita, KS 67220
Quivera Council Boy Scouts of America, 1555 E. 2nd Street, Wichita, KS 67214