

PARCEL NO. 1
 PROPOSED GENERAL USE SERVICE OFFICE, RESTAURANT, RETAIL GENERAL (SEE ADMIN. ADJUST. 08/23/01)
 TOTAL NET AREA 117,206.9 SQ. FT. ± OR 2.7 ACRES ±
 MAXIMUM GROSS FLOOR AREA 46,904.4 SQ. FT. ±
 FLOOR AREA RATIO 0.40
 MAX. BUILDING HEIGHT 6 STORIES
 MAX. LAND COVERAGE 30% OR 35,178.3 SQ. FT. ±

PARCEL NO. 2A
 PROPOSED GENERAL USE SHOPPING CENTER, SERVICE STATION
 TOTAL NET AREA 934,494 SQ. FT. ± OR 21.45 ACRES ±
 MAXIMUM GROSS FLOOR AREA 373,798 SQ. FT. ±
 FLOOR AREA RATIO 0.40
 MAX. BUILDING HEIGHT 8 STORIES
 MAX. LAND COVERAGE 30% OR 280,348 SQ. FT. ±

PARCEL NO. 2B
 PROPOSED GENERAL USE SEE GENERAL PROVISION NO. 13
 TOTAL NET AREA 34,221 SQ. FT. ± OR 0.79 ACRES ±
 MAXIMUM GROSS FLOOR AREA 13,688 SQ. FT. ±
 FLOOR AREA RATIO 0.40
 MAX. BUILDING HEIGHT 35 FEET
 MAX. LAND COVERAGE 30% OR 10,266 SQ. FT. ±

PARCEL NO. 2C
 PROPOSED GENERAL USE SEE GENERAL PROVISION NO. 13
 TOTAL NET AREA 35,708 SQ. FT. ± OR 0.82 ACRES ±
 MAXIMUM GROSS FLOOR AREA 14,283 SQ. FT. ±
 FLOOR AREA RATIO 0.40
 MAX. BUILDING HEIGHT 35 FEET
 MAX. LAND COVERAGE 30% OR 10,712 SQ. FT. ±

PARCEL NO. 2D
 PROPOSED GENERAL USE SERVICE STATION
 TOTAL NET AREA 26,922 SQ. FT. ± OR 0.62 ACRES ±
 MAXIMUM GROSS FLOOR AREA 10,789 SQ. FT. ±
 FLOOR AREA RATIO 0.40
 MAX. BUILDING HEIGHT 35 FEET
 MAX. LAND COVERAGE 30% OR 8,077 SQ. FT. ±

PARCEL NO. 2E
 PROPOSED GENERAL USE SEE GENERAL PROVISION NO. 13
 TOTAL NET AREA 64,950 SQ. FT. ± OR 1.49 ACRES ±
 MAXIMUM GROSS FLOOR AREA 25,980 SQ. FT. ±
 FLOOR AREA RATIO 0.40
 MAX. BUILDING HEIGHT 35 FEET
 MAX. LAND COVERAGE 30% OR 19,485 SQ. FT. ±

PARCEL NO. 2F
 PROPOSED GENERAL USE SEE GENERAL PROVISION NO. 13
 TOTAL NET AREA 83,996 SQ. FT. ± OR 1.93 ACRES ±
 MAXIMUM GROSS FLOOR AREA 33,598 SQ. FT. ±
 FLOOR AREA RATIO 0.40
 MAX. BUILDING HEIGHT 35 FEET
 MAX. LAND COVERAGE 30% OR 25,198 SQ. FT. ±

PARCEL NO. 3
 PROPOSED GENERAL USE AUTOMOTIVE, SERVICE & OFFICE, RESTAURANT
 TOTAL NET AREA 32,300 SQ. FT. ± OR 0.7 ACRES ±
 MAXIMUM GROSS FLOOR AREA 12,940 SQ. FT. ±
 FLOOR AREA RATIO 0.40
 MAX. BUILDING HEIGHT 35 FEET
 MAX. LAND COVERAGE 30% OR 9,705 SQ. FT. ±

PARCEL NO. 4
 TOTAL NET AREA 30.6 ACRES ±
 PROPOSED USE
 KINKAID PARK THIRD ADDITION TWO, THREE AND FOUR FAMILY DWELLING UNITS
 PROPOSED USE GARDEN APARTMENTS, HIGH RISE APARTMENTS OR TOWNHOUSES AND COMMUNITY ACTIVITY CENTERS OR CLUBS ASSOCIATED THEREWITH.
 KINKAID PARK FIFTH ADDITION 25 U.U.'s / NET ACRE
 MAX. BUILDING HEIGHT 35 FEET OR THREE STORIES, 180 FEET OR 15 STORIES FOR HIGH RISE APARTMENTS
 MAX. DENSITY 25 U.U.'s / NET ACRE
 PARKING RATIO 1.5 / D.U.
 MINIMUM SETBACK AS SHOWN ON PLAN (SEE ADJUSTMENT DATED 07/24/04)
 THE DENSITY FOR THE AREA SHOWN AS KINKAID PARK 5TH ADDITION SHALL NOT EXCEED 25 UNITS PER ACRE. THE TOTAL NUMBER OF DWELLING UNITS FOR PARCEL 4 SHALL NOT EXCEED 652 DWELLING UNITS, WITH 44 UNITS ALLOCATED FOR KINKAID PARK 3RD ADDITION AND 608 UNITS FOR KINKAID PARK 5TH ADDITION.
 PRIOR TO ISSUANCE OF A BUILDING PERMIT FOR A HIGH RISE APARTMENT BUILDING, A SITE PLAN SHALL BE SUBMITTED TO THE DIRECTOR OF PLANNING FOR REVIEW AND APPROVAL.

D.P. 43
KINKAID C.U.P.

DP-43 AMENDMENT #3
APPROVED CUP

MAPC 05/28/03 DM

MAPD Copy # of 2


20. GUARANTEES SHALL BE PROVIDED FOR EXTENDING THE LEFT-TURN CENTER LANE ON BROADWAY TO THE SOUTHERN ENTRANCE ON PARCEL 2A, AND EXTENDING THE RIGHT-TURN DECEL LANE ON BROADWAY FROM MARION ROAD TO FORM A DECEL LANE WITH AT LEAST 100 FEET OF TAPER AND 150 FEET OF STORAGE, AS DETERMINED BY THE TRAFFIC ENGINEER.
21. THE SOUTHERNMOST THIRD ENTRANCE TO PARCEL 2A SHALL BE CLOSED, AND THE MIDDLE ENTRANCE ON ST. FRANCIS SHALL BE CLOSED.
- 13A. CAR WASHES SHALL BE ALLOWED IN COMPLIANCE WITH THE SUPPLEMENTARY USE REQUIREMENTS OF ARTICLE III, SECTION III.D.8.F OF THE UNIFIED ZONING CODE.

ADDITIONAL CONDITIONS PER AMENDMENT

GENERAL PROVISIONS

1. THIS COMMUNITY UNIT PLAN CONTAINS A TOTAL NET AREA OF 61.1 ACRES ±.
2. CURB CUTS - THE MAXIMUM NUMBER OF CURB CUTS ALONG PAWNEE AVE. SHALL NOT EXCEED 5. THE MAXIMUM NUMBER OF CURB CUTS ALONG BROADWAY AVE. SHALL NOT EXCEED 5. THE MAXIMUM NUMBER OF CURB CUTS ALONG ST. FRANCIS SHALL NOT EXCEED 6.
3. DRAINAGE PROBLEMS HAVE BEEN RESOLVED AT THE TIME OF PLATTING.
4. MAXIMUM LAND COVERAGE BY BUILDING SHALL NOT EXCEED 30 PERCENT OF THE TOTAL SITE (793,268.4 SQ. FT. ±).
5. ALL UTILITIES SHALL BE INSTALLED UNDERGROUND.
6. ADVERTISING SIGNS ALONG PAWNEE AVE. AND BROADWAY AVE. SHALL NOT EXCEED 30 FEET IN HEIGHT AND SHALL BE PLACED SO AS NOT TO PROJECT OVER PUBLIC RIGHT-OF-WAY. NO BILL BOARD ADVERTISEMENT OR ROOF SIGNS SHALL BE ALLOWED.
7. MAXIMUM BUILDING HEIGHT (SEE INDIVIDUAL PARCELS).
8. PARKING RATIO - OFFICE AND COMMERCIAL BUILDINGS, INCLUDING GOVERNMENTAL, PUBLIC UTILITY AND OTHER SIMILAR BUILDINGS, SHALL PROVIDE ONE (1) SPACE FOR EACH TWO HUNDRED FIFTY (250) SQUARE FEET OF FLOOR AREA OR (1) SPACE FOR EVERY THREE EMPLOYEES IN THE LARGEST WORKING SHIFT IN A TWENTY-FOUR (24) HOUR PERIOD, WHICHEVER IS THE GREATER.
9. A FIRE LANE, 20 FEET IN WIDTH (WITH SUFFICIENT TURNING RADIUS AT CORNERS FOR STANDARD FIRE APPARATUS) SHALL BE PROVIDED AROUND ALL MAIN STRUCTURES CONSTRUCTED WITHIN PARCEL NO. 2. SAID FIRE LANE SHALL HAVE A 3 1/2 INCH ASPHALT BASE WITH 1 1/2 INCH ASPHALT SURFACE. NO PARKING SHALL BE ALLOWED IN SUCH FIRE LANE ALTHOUGH IT MAY BE USED FOR PASSENGER LOADING AND UNLOADING. PRIOR TO FINAL APPROVAL OF THE PARKING PLAN, THE FIRE CHIEF OR HIS DESIGNATED REPRESENTATIVE, SHALL APPROVE THE PLAN TO THE LOCATION AND DESIGN OF THE FIRE LANE.
10. A HOMES ASSOCIATION AGREEMENT PROVIDING FOR MAINTENANCE OF NON-PUBLIC COMMON AREAS, PARKING AREAS, PRIVATE DRIVES, COMMUNITY FACILITIES, ETC., SHALL BE SUBMITTED WITH THE PLAT FOR PARCEL #4. IF IT IS PROPOSED THAT EACH DWELLING UNIT WILL BE INDIVIDUALLY OWNED, SPECIFICALLY DEFINED PRIOR TO ISSUANCE OF BUILDING PERMITS FOR PARCEL NO. 4.

11. SIGNS OR MONUMENTS DESIGNATING THE NAME OF THE DEVELOPMENT SHALL BE PERMITTED AT THE ENTRANCES TO THE PROPOSED DEVELOPMENT OF PARCEL 4. THESE SHALL BE PERMITTED IF THEY FOLLOW IN ACCORDANCE WITH THE PROVISIONS OF SECTION 28.04.139 OF THE CODE OF THE CITY OF WICHITA.
12. APPROPRIATE FIRE LANE EASEMENTS AND TRAFFIC CIRCULATION WILL BE CONSIDERED AND MORE SPECIFICALLY DEFINED PRIOR TO ISSUANCE OF BUILDING PERMITS FOR PARCEL NO. 4.
13. THE PROPOSED GENERAL USE FOR PARCELS 2B, 2C, 2E, AND 2F SHALL BE ANY COMMERCIAL USE PERMITTED BY-RIGHT IN THE LC ZONING DISTRICT EXCLUDING NIGHT CLUB IN CITY, SEXUALLY ORIENTED BUSINESS, TAVERN AND DRINKING ESTABLISHMENT.
14. LANDSCAPING: DEVELOPMENT OF PARCELS 2A, 2B, 2C, 2D, 2E AND 2F SHALL COMPLY WITH THE LANDSCAPE ORDINANCE OF THE CITY OF WICHITA. A LANDSCAPE PLAN SHALL BE PREPARED BY A KANSAS LANDSCAPE ARCHITECT FOR THE ABOVE REFERENCED LANDSCAPING, INDICATING THE TYPE, LOCATION AND SPECIFICATIONS OF ALL PLANT MATERIAL. THIS PLAN SHALL BE SUBMITTED TO THE PLANNING DEPARTMENT FOR REVIEW AND APPROVAL PRIOR TO ISSUANCE OF A BUILDING PERMIT. A FINANCIAL GUARANTEE FOR THE PLANT MATERIAL APPROVED ON THE LANDSCAPE PLAN FOR THAT PORTION OF THE C.U.P. BEING DEVELOPED SHALL BE REQUIRED PRIOR TO ISSUANCE OF ANY OCCUPANCY PERMIT, IF THE REQUIRED LANDSCAPING HAS NOT BEEN PLANTED.
15. ARCHITECTURAL: ALL BUILDINGS CONSTRUCTED ON PARCELS 2A, 2B, 2C, 2D, 2E, AND 2F SHALL SHARE UNIFORM ARCHITECTURAL CHARACTER, COLOR, TEXTURE, AND THE SAME PREDOMINATE EXTERIOR BUILDING MATERIAL, AS DETERMINED BY THE DIRECTOR OF PLANNING. BUILDING WALLS AND ROOFS MUST HAVE PREDOMINANTLY EARTH-TONE COLORS, WITH VIVID COLORS LIMITED TO INCIDENTAL ACCENT.
16. LIGHTING: ALL EXTERIOR LIGHTING FOR PARCELS 2A, 2B, 2C, 2D, 2E, AND 2F SHALL BE SHIELDED TO DIRECT LIGHT DISBURSEMENT IN A DOWNWARD DIRECTION. THE ABOVE PARCELS SHALL SHARE SIMILAR OR CONSISTENT PARKING LOT LIGHTING ELEMENTS (I.E. FIXTURES, POLE TYPE, LAMPS, ETC.). EXTENSIVE USE OF BACK UP CANDRELS AND NEON OR FLUORESCENT TUBE LIGHTING ON BUILDINGS IS NOT PERMITTED.
17. FOR PARCELS 2A, 2B, 2C, 2E AND 2F, ROOFTOP MECHANICAL EQUIPMENT SHALL BE SCREENED FROM GROUND LEVEL VIEW PER THE UNIFIED ZONING CODE.
18. FOR PARCELS 2A, 2B, 2C, 2E AND 2F, TRASH RECEPTACLES, LOADING DOCKS, OUTDOOR STORAGE, AND LOADING AREAS SHALL BE APPROPRIATELY SCREENED TO REASONABLY HIDE THEM FROM GROUND VIEW.
19. FOR PARCELS 2A, 2B, 2C, 2E AND 2F, CROSS-LOT CIRCULATION IS TO BE PROVIDED FOR ALL LOTS PLATTED FOR RETAIL, COMMERCIAL OR OFFICE USES.

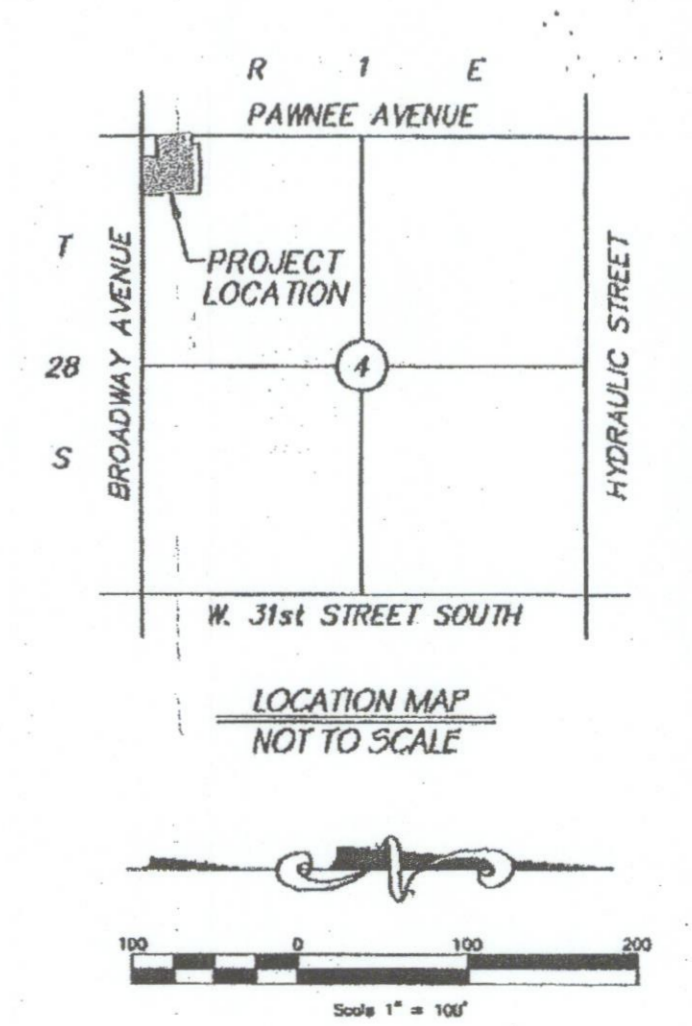

Dated 1/21/25
APPROVED CUP
 MAPC Per Admin Adjustment
 MAPC 05-28-03
 CUP25-01 1 of 4

As per AA CUP 2019-00082
 8-19-2019

Amendment #3
APPROVED CUP

MAPC 05-28-03

MAPD Copy 1 of 4

AMENDED
 ORIGINAL 09/07/11
 AMENDED 07/25/13
 REVISIONS 08/09/13
 AMENDED 02/25/15
 REVISED 08/29/15

Date: 04/30/2003
 SPEAR & McCLEB CO., P.C.
 815 W. Main Street
 Oklahoma City, OK 73108
 KINKAID (DP-43)
 SHEET 1 OF 1

KINKAID C.U.P.



**Wichita-Sedgwick County
Metropolitan Area
Planning Department**

January 21, 2025

Walmart Real Estate Business Trust
2608 SE J Street
Bentonville, AR 72716

BFA, Inc.
Attn: Rick Rohifing
103 Elm Street
Washington, MO 63090

RE: CUP2025-00001 – Administrative Adjustment in the City to the Kinkaid CUP DP-43, to permit Service Station on Parcel 2A, on property zoned GC General Commercial District; generally located on the south side of East Pawnee Avenue and within one-quarter mile east of South Broadway Avenue (501 E. Pawnee Avenue).

Legal Description: Lot1 1, Block A, Replat of a Part of Kinkaid Park Addition, Wichita, Sedgwick County, Kansas.

Dear Applicant,

We received and reviewed your request for an Administrative Adjustment to CUP DP-43 to permit a Service Station on the east side of Parcel 2A. The subject site is zoned GC General Commercial District for which Service Station would typically be a use permitted by-right. The CUP does not specifically prohibit the proposed use. Furthermore, the proposed use is not deemed to be more intensive than existing, permitted uses within the CUP. General Provision 13 permits commercial uses permitted by-right in the LC Limited Commercial District (excluding Night Club in the City, Sexually Oriented Business, and Tavern and Drinking Establishment) for Parcels 2B, 2C, 2E, and 2F. This would include a Service Station as a permitted use.

General Provision 8 requires a parking ratio of 1 parking space for each 250 square feet of floor area for commercial buildings. This requires a minimum of 822 parking spaces for the primary retail store on Parcel 2A. A review of the parking provided on Parcel 2A shows that 845 spaces are provided outside of the area for which the proposed Service Station would be constructed. Therefore, removal of those parking spaces does not violate this provision of the CUP. Furthermore, the site plan provided illustrates a sufficient number of parking spaces to meet the 1 parking space per 333 square feet of sales area for the Service Station use.

The development standards for Parcel 2A limit the maximum land coverage area to 280,348 square feet. The current retail store has a land coverage of 205,318 square feet. Therefore, the proposed Service Station cannot exceed 75,030 square feet. The site plan indicates it does not exceed the remaining allotted land coverage area.

The following reflects staff's approved text modifications identified in red letters.

GENERAL PROVISIONS


Parcel No. 2A:

- A. Proposed General Use: Shopping Center, **Service Station.**
- B. Total Net Area: 934,494 sq. ft. or 21.45 Acres
- C. Maximum gross floor area: 373, 798 sq. ft.
- D. Floor Area Ratio: 0.40
- E. Max. Building Height: 8 Stories
- F. Max. land Coverage 30% or 280,348 sq ft.


On the basis of our review, we find that adjusting the CUP in the manner stated above is consistent with the approved CUP and will not have an adverse effect on the CUP or adjacent properties, nor will it be a substantial deviation of the original plan. Section V-E.14.c. of the Unified Zoning Code permits adjusting a CUP to permit uses that are not more intensive than the other uses approved as part of the CUP. As discussed in this letter, the CUP permits Service Station as a use on other parcels within the CUP. Permitting the use on Parcel 2A does not violate Section V-E.14.c.of the Unified Zoning Code.

Our signatures below indicate that the CUP shall be adjusted as stated in this letter. This CUP adjustment shall not be deemed to alter any other provisions of the CUP except as expressly stated herein.

The "Development Application" sign should now be removed from the property. Please submit one (1) electronic copy and four (4) full-sized paper copies of the revised CUP drawing within 60 days in order for this adjustment to be considered final.

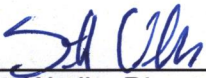

Scott Wadle, Director
Metropolitan Area Planning Department

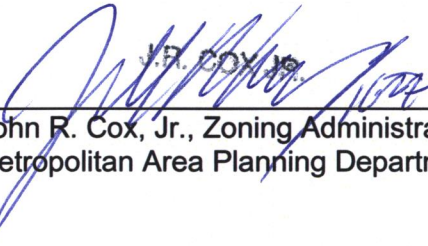

John R. Cox, Jr., Zoning Administrator
Metropolitan Area Planning Department

cc: MABCD
Mike Hoheisel, CM District III
Rebecca Johnson, CSR District III

PARCEL NO. 1
 PROPOSED GENERAL USE SERVICE, OFFICE, RESTAURANT, RETAIL GENERAL (SEE ADMIN. ADJUST. 06/23/01)
 TOTAL NET AREA 117,208.9 SQ. FT. ± OR 2.7 ACRES ±
 MAXIMUM GROSS FLOOR AREA 48,904.4 SQ. FT. ±
 FLOOR AREA RATIO 0.40
 MAX. BUILDING HEIGHT 6 STORIES
 MAX. LAND COVERAGE 30% OR 35,178.3 SQ. FT. ±

PARCEL NO. 2A
 PROPOSED GENERAL USE SHOPPING CENTER
 TOTAL NET AREA 934,494 SQ. FT. ± OR 21.45 ACRES ±
 MAXIMUM GROSS FLOOR AREA 373,798 SQ. FT. ±
 FLOOR AREA RATIO 0.40
 MAX. BUILDING HEIGHT 8 STORIES
 MAX. LAND COVERAGE 30% OR 280,348 SQ. FT. ±

PARCEL NO. 2B
 PROPOSED GENERAL USE SEE GENERAL PROVISION NO. 13
 TOTAL NET AREA 34,221 SQ. FT. ± OR 0.79 ACRES ±
 MAXIMUM GROSS FLOOR AREA 13,688 SQ. FT. ±
 FLOOR AREA RATIO 0.40
 MAX. BUILDING HEIGHT 35 FEET
 MAX. LAND COVERAGE 30% OR 10,266 SQ. FT. ±

PARCEL NO. 2C
 PROPOSED GENERAL USE SEE GENERAL PROVISION NO. 13
 TOTAL NET AREA 35,708 SQ. FT. ± OR 0.82 ACRES ±
 MAXIMUM GROSS FLOOR AREA 14,283 SQ. FT. ±
 FLOOR AREA RATIO 0.40
 MAX. BUILDING HEIGHT 35 FEET
 MAX. LAND COVERAGE 30% OR 10,712 SQ. FT. ±

PARCEL NO. 2D
 PROPOSED GENERAL USE SERVICE STATION
 TOTAL NET AREA 28,922 SQ. FT. ± OR 0.62 ACRES ±
 MAXIMUM GROSS FLOOR AREA 10,769 SQ. FT. ±
 FLOOR AREA RATIO 0.40
 MAX. BUILDING HEIGHT 35 FEET
 MAX. LAND COVERAGE 30% OR 8,077 SQ. FT. ±

PARCEL NO. 2E
 PROPOSED GENERAL USE SEE GENERAL PROVISION NO. 13
 TOTAL NET AREA 64,950 SQ. FT. ± OR 1.49 ACRES ±
 MAXIMUM GROSS FLOOR AREA 29,380 SQ. FT. ±
 FLOOR AREA RATIO 0.40
 MAX. BUILDING HEIGHT 35 FEET
 MAX. LAND COVERAGE 30% OR 19,485 SQ. FT. ±

PARCEL NO. 2F
 PROPOSED GENERAL USE SEE GENERAL PROVISION NO. 13
 TOTAL NET AREA 83,996 SQ. FT. ± OR 1.93 ACRES ±
 MAXIMUM GROSS FLOOR AREA 33,598 SQ. FT. ±
 FLOOR AREA RATIO 0.40
 MAX. BUILDING HEIGHT 35 FEET
 MAX. LAND COVERAGE 30% OR 25,198 SQ. FT. ±

PARCEL NO. 3
 PROPOSED GENERAL USE AUTOMOTIVE, SERVICE & OFFICE, RESTAURANT
 TOTAL NET AREA 32,350 SQ. FT. ± OR 0.7 ACRES ±
 MAXIMUM GROSS FLOOR AREA 12,940 SQ. FT. ±
 FLOOR AREA RATIO 0.40
 MAX. BUILDING HEIGHT 35 FEET
 MAX. LAND COVERAGE 30% OR 9,705 SQ. FT. ±

PARCEL NO. 4
 TOTAL NET AREA 30.6 ACRES ±
 PROPOSED USE KINKAID PARK THIRD ADDITION TWO, THREE AND FOUR FAMILY DWELLING UNITS
 KINKAID PARK FIFTH ADDITION GARDEN APARTMENTS, HIGH RISE APARTMENTS OR TOWNHOUSES AND COMMUNITY ACTIVITY CENTERS OR CLUBS ASSOCIATED THEREWITH.
 MAX. BUILDING HEIGHT 35 FEET OR THREE STORIES; 180 FEET OR 15 STORIES FOR HIGH RISE APARTMENTS
 MAX. DENSITY 25 D.U.'s / NET ACRE
 PARKING RATIO 1.5 / D.U.
 MINIMUM SETBACK AS SHOWN ON PLAN (SEE ADJUSTMENT DATED 07/24/84)
 THE DENSITY FOR THE AREA SHOWN AS KINKAID PARK 5TH ADDITION SHALL NOT EXCEED 25 UNITS PER ACRE. THE TOTAL NUMBER OF DWELLING UNITS FOR PARCEL 4 SHALL NOT EXCEED 659 DWELLING UNITS, WITH 14 UNITS ALLOCATED FOR KINKAID PARK 3RD ADDITION AND 625 UNITS FOR KINKAID PARK 5TH ADDITION.
 PRIOR TO ISSUANCE OF A BUILDING PERMIT FOR A HIGH RISE APARTMENT BUILDING, A SITE PLAN SHALL BE SUBMITTED TO THE DIRECTOR OF PLANNING FOR REVIEW AND APPROVAL.

KINKAID C.U.P.

D.P. 43
 DP-43 AMENDMENT #3
 APPROVED CUP
 MAPC 05/08/03 D/M


MAPC Copy # of 2

20. GUARANTEES SHALL BE PROVIDED FOR EXTENDING THE LEFT-TURN CENTER LANE ON BROADWAY TO THE SOUTHERN ENTRANCE ON PARCEL 2A, AND EXTENDING THE RIGHT-TURN DECEL LANE ON BROADWAY FROM MARION ROAD TO FORM A DECEL LANE WITH AT LEAST 100 FEET OF TAPER AND 150 FEET OF STORAGE, AS DETERMINED BY THE TRAFFIC ENGINEER.
21. THE SOUTHERNMOST THIRD ENTRANCE TO PARCEL 2A SHALL BE CLOSED, AND THE MIDDLE ENTRANCE ON ST. FRANCIS SHALL BE CLOSED.
- 13A. CAR WASHES SHALL BE ALLOWED IN COMPLIANCE WITH THE SUPPLEMENTARY USE REQUIREMENTS OF ARTICLE III, SECTION III D.6.F OF THE UNIFIED ZONING CODE.
- ADDITIONAL CONDITIONS PER AMEND #3

GENERAL PROVISIONS

- THIS COMMUNITY UNIT PLAN CONTAINS A TOTAL NET AREA OF 61.1 ACRES ±.
- CURB CUTS - THE MAXIMUM NUMBER OF CURB CUTS ALONG PAWNEE AVE. SHALL NOT EXCEED 5. THE MAXIMUM NUMBER OF CURB CUTS ALONG BROADWAY AVE. SHALL NOT EXCEED 5. THE MAXIMUM NUMBER OF CURB CUTS ALONG ST. FRANCIS SHALL NOT EXCEED 6.
- DRAINAGE PROBLEMS HAVE BEEN RESOLVED AT THE TIME OF PLATING.
- MAXIMUM LAND COVERAGE BY BUILDING SHALL NOT EXCEED 30 PERCENT OF THE TOTAL SITE (793,268.4 SQ. FT. ±).
- ALL UTILITIES SHALL BE INSTALLED UNDERGROUND.
- ADVERTISING SIGNS ALONG PAWNEE AVE. AND BROADWAY AVE. SHALL NOT EXCEED 30 FEET IN HEIGHT AND SHALL BE PLACED SO AS NOT TO PROJECT OVER PUBLIC RIGHT-OF-WAY. NO BILL BOARD ADVERTISEMENT OR ROOF SIGNS SHALL BE ALLOWED.
- MAXIMUM BUILDING HEIGHT (SEE INDIVIDUAL PARCELS).
- PARKING RATIO - OFFICE AND COMMERCIAL BUILDINGS, INCLUDING GOVERNMENTAL, PUBLIC UTILITY AND OTHER SIMILAR BUILDINGS, SHALL PROVIDE ONE (1) SPACE FOR EACH TWO HUNDRED FIFTY (250) SQUARE FEET OF FLOOR AREA OR (1) SPACE FOR EVERY THREE EMPLOYEES IN THE LARGEST WORKING SHIFT IN A TWENTY-FOUR (24) HOUR PERIOD, WHICHEVER IS THE GREATER.
- A FIRE LANE, 20 FEET IN WIDTH (WITH SUFFICIENT TURNING RADI AT CORNERS FOR STANDARD FIRE APPARATUS) SHALL BE PROVIDED AROUND ALL MAIN STRUCTURES CONSTRUCTED WITHIN PARCEL NO. 2. SAID FIRE LANE SHALL HAVE A 3 1/2 INCH ASPHALT BASE WITH 1 1/2 INCH ASPHALT SURFACE. NO PARKING SHALL BE ALLOWED IN SUCH FIRE LANE ALTHOUGH IT MAY BE USED FOR PASSENGER LOADING AND UNLOADING. PRIOR TO FINAL APPROVAL OF THE PARKING PLAN, THE FIRE CHIEF OR HIS DESIGNATED REPRESENTATIVE, SHALL APPROVE THE PLAN TO THE LOCATION AND DESIGN OF THE FIRE LANE.
- A HOME'S ASSOCIATION AGREEMENT PROVIDING FOR MAINTENANCE OF NON-PUBLIC COMMON AREAS, PARKING AREAS, PRIVATE DRIVES, COMMUNITY FACILITIES, ETC., SHALL BE SUBMITTED WITH THE PLAT FOR PARCEL #4. IF IT IS PROPOSED THAT EACH DWELLING UNIT WILL BE INDIVIDUALLY OWNED, SPECIFICALLY DEFINED PRIOR TO ISSUANCE OF BUILDING PERMITS FOR PARCEL NO. 4.

- SIGNS OR MONUMENTS DESIGNATING THE NAME OF THE DEVELOPMENT SHALL BE PERMITTED AT THE ENTRANCES TO THE PROPOSED DEVELOPMENT OF PARCEL 4. THESE SHALL BE PERMITTED IF THEY FOLLOW IN ACCORDANCE WITH THE PROVISIONS OF SECTION 20.04.139 OF THE CODE OF THE CITY OF WICHITA.
- APPROPRIATE FIRE LANE EASEMENTS AND TRAFFIC CIRCULATION WILL BE CONSIDERED AND MORE SPECIFICALLY DEFINED PRIOR TO ISSUANCE OF BUILDING PERMITS FOR PARCEL NO. 4.
- THE PROPOSED GENERAL USE FOR PARCELS 2B, 2C, 2E, AND 2F SHALL BE ANY COMMERCIAL USE PERMITTED BY-NIGHT IN THE LC ZONING DISTRICT EXCLUDING ~~BAR-WASH~~ NIGHT CLUB IN CITY, SEXUALLY ORIENTED BUSINESS, TAVERN AND DRINKING ESTABLISHMENT.
- LANDSCAPING: DEVELOPMENT OF PARCELS 2A, 2B, 2C, 2D, 2E AND 2F SHALL COMPLY WITH THE LANDSCAPE ORDINANCE OF THE CITY OF WICHITA. A LANDSCAPE PLAN SHALL BE PREPARED BY A KANSAS LANDSCAPE ARCHITECT FOR THE ABOVE REFERENCED LANDSCAPING, INDICATING THE TYPE, LOCATION, AND SPECIFICATIONS OF ALL PLANT MATERIAL. THIS PLAN SHALL BE SUBMITTED TO THE PLANNING DEPARTMENT FOR REVIEW AND APPROVAL PRIOR TO ISSUANCE OF A BUILDING PERMIT. A FINANCIAL GUARANTEE FOR THE PLANT MATERIAL APPROVED ON THE LANDSCAPE PLAN FOR THAT PORTION OF THE C.U.P. BEING DEVELOPED SHALL BE REQUIRED PRIOR TO ISSUANCE OF ANY OCCUPANCY PERMIT, IF THE REQUIRED LANDSCAPING HAS NOT BEEN PLANTED.
- ARCHITECTURAL: ALL BUILDINGS CONSTRUCTED ON PARCELS 2A, 2B, 2C, 2D, 2E, AND 2F SHALL SHARE UNIFORM ARCHITECTURAL CHARACTER, COLOR, TEXTURE, AND THE SAME PREDOMINATE EXTERIOR BUILDING MATERIAL, AS DETERMINED BY THE DIRECTOR OF PLANNING. BUILDING WALLS AND ROOFS MUST HAVE PREDOMINANTLY EARTH-TONE COLORS, WITH VIVID COLORS LIMITED TO INCIDENTAL ACCENT.
- LIGHTING: ALL EXTERIOR LIGHTING FOR PARCELS 2A, 2B, 2C, 2D, 2E, AND 2F SHALL BE SHIELDED TO DIRECT LIGHT DISBURSEMENT IN A DOWNWARD DIRECTION. THE ABOVE PARCELS SHALL SHARE SIMILAR OR CONSISTENT PARKING LOT LIGHTING ELEMENTS (I.E. FIXTURES, POLE TYPE, LAMPS, ETC.). EXTENSIVE USE OF BACK LIT CANOPIES AND NEON OR FLUORESCENT TUBE LIGHTING ON BUILDINGS IS NOT PERMITTED.
- FOR PARCELS 2A, 2B, 2C, 2E AND 2F, ROOFTOP MECHANICAL EQUIPMENT SHALL BE SCREENED FROM GROUND LEVEL VIEW PER THE UNIFIED ZONING CODE.
- FOR PARCELS 2A, 2B, 2C, 2E AND 2F, TRASH RECEPTACLES, LOADING DOCKS, OUTDOOR STORAGE, AND LOADING AREAS SHALL BE APPROPRIATELY SCREENED TO REASONABLY HIDE THEM FROM GROUND VIEW.
- FOR PARCELS 2A, 2B, 2C, 2E AND 2F, CROSS-LOT CIRCULATION IS TO BE PROVIDED FOR ALL LOTS PLATTED FOR RETAIL, COMMERCIAL OR OFFICE USES.

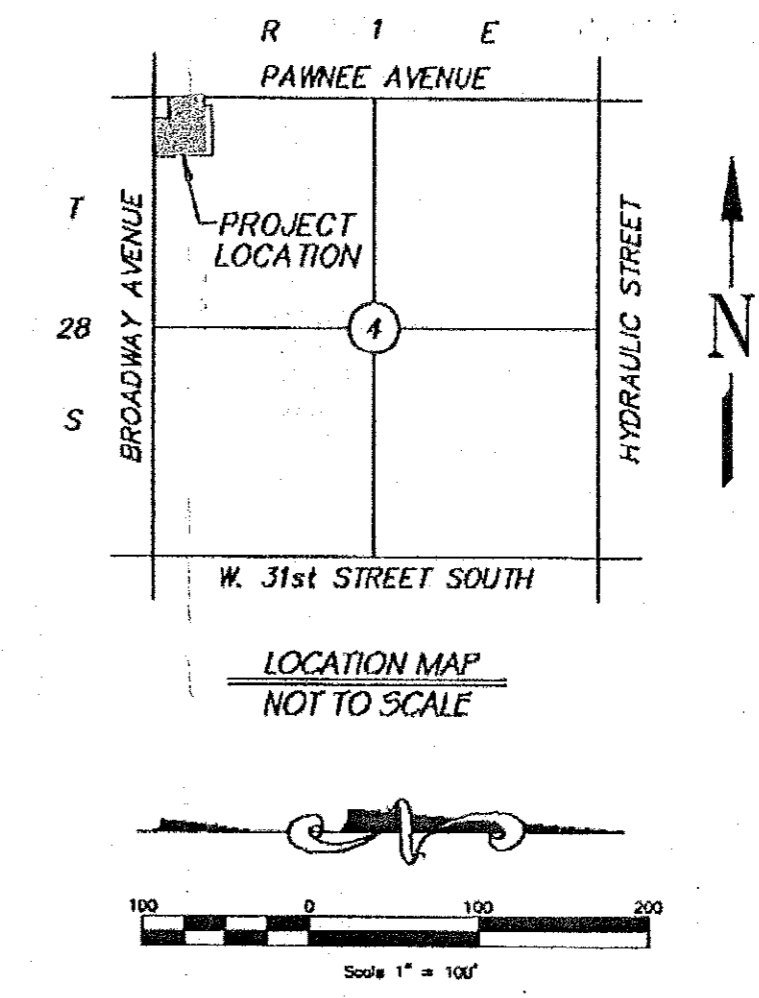

As per AA CUP 2019-00032
 8-19-2019

Amendment #3
APPROVED CUP
 MAPC 05-08-03 D/M

MAPC Copy 1054

AMENDED	
ORIGINAL	09/01/11
AMENDED	07/25/13
REVISIONS	08/09/13
AMENDED	02/25/18
REVISED	06/29/15

Date: 04/30/2003
 SPEAR & McCALEB CO., P.C.
 815 W. Main Street
 Oklahoma City, OK 73108

KINKAID (DP-43)
 SHEET 1 OF 1
KINKAID C.U.P.

PARCEL NO. 1
 PROPOSED GENERAL USE SERVICE, OFFICE, RESTAURANT, RETAIL GENERAL (SEE ADMIN. ADJUST. 06/23/01)
 TOTAL NET AREA 117,206.9 SQ. FT. ± OR 2.7 ACRES ±
 MAXIMUM GROSS FLOOR AREA 46,904.4 SQ. FT. ±
 FLOOR AREA RATIO 0.40
 MAX. BUILDING HEIGHT 6 STORIES
 MAX. LAND COVERAGE 30% OR 35,178.3 SQ. FT. ±

PARCEL NO. 2A
 PROPOSED GENERAL USE SHOPPING CENTER
 TOTAL NET AREA 934,494 SQ. FT. ± OR 21.45 ACRES ±
 MAXIMUM GROSS FLOOR AREA 373,798 SQ. FT. ±
 FLOOR AREA RATIO 0.40
 MAX. BUILDING HEIGHT 8 STORIES
 MAX. LAND COVERAGE 30% OR 280,348 SQ. FT. ±

PARCEL NO. 2B
 PROPOSED GENERAL USE SEE GENERAL PROVISION NO. 13
 TOTAL NET AREA 34,221 SQ. FT. ± OR 0.79 ACRES ±
 MAXIMUM GROSS FLOOR AREA 13,688 SQ. FT. ±
 FLOOR AREA RATIO 0.40
 MAX. BUILDING HEIGHT 35 FEET
 MAX. LAND COVERAGE 30% OR 10,266 SQ. FT. ±

PARCEL NO. 2C
 PROPOSED GENERAL USE SEE GENERAL PROVISION NO. 13
 TOTAL NET AREA 35,708 SQ. FT. ± OR 0.82 ACRES ±
 MAXIMUM GROSS FLOOR AREA 14,283 SQ. FT. ±
 FLOOR AREA RATIO 0.40
 MAX. BUILDING HEIGHT 35 FEET
 MAX. LAND COVERAGE 30% OR 10,712 SQ. FT. ±

PARCEL NO. 2D
 PROPOSED GENERAL USE SERVICE STATION
 TOTAL NET AREA 28,922 SQ. FT. ± OR 0.62 ACRES ±
 MAXIMUM GROSS FLOOR AREA 10,769 SQ. FT. ±
 FLOOR AREA RATIO 0.40
 MAX. BUILDING HEIGHT 35 FEET
 MAX. LAND COVERAGE 30% OR 8,077 SQ. FT. ±

PARCEL NO. 2E
 PROPOSED GENERAL USE SEE GENERAL PROVISION NO. 13
 TOTAL NET AREA 64,950 SQ. FT. ± OR 1.49 ACRES ±
 MAXIMUM GROSS FLOOR AREA 25,980 SQ. FT. ±
 FLOOR AREA RATIO 0.40
 MAX. BUILDING HEIGHT 35 FEET
 MAX. LAND COVERAGE 30% OR 19,485 SQ. FT. ±

PARCEL NO. 2F
 PROPOSED GENERAL USE SEE GENERAL PROVISION NO. 13
 TOTAL NET AREA 83,996 SQ. FT. ± OR 1.93 ACRES ±
 MAXIMUM GROSS FLOOR AREA 33,598 SQ. FT. ±
 FLOOR AREA RATIO 0.40
 MAX. BUILDING HEIGHT 33 FEET
 MAX. LAND COVERAGE 30% OR 25,198 SQ. FT. ±


PARCEL NO. 3
 PROPOSED GENERAL USE AUTOMOTIVE, SERVICE & OFFICE
 TOTAL NET AREA 32,350 SQ. FT. ± OR 0.7 ACRES ±
 MAXIMUM GROSS FLOOR AREA 12,940 SQ. FT. ±
 FLOOR AREA RATIO 0.40
 MAX. BUILDING HEIGHT 35 FEET
 MAX. LAND COVERAGE 30% OR 9,705 SQ. FT. ±

PARCEL NO. 4
 TOTAL NET AREA 30.6 ACRES ±
 PROPOSED USE KINKAID PARK THIRD ADDITION
 PROPOSED USE TWO, THREE AND FOUR FAMILY DWELLING UNITS
 PROPOSED USE GARDEN APARTMENTS, HIGH RISE APARTMENTS OR TOWNHOUSES AND COMMUNITY ACTIVITY CENTERS OR CLUBS ASSOCIATED THEREWITH.
 MAX. BUILDING HEIGHT 35 FEET OR THREE STORIES; 180 FEET OR 15 STORIES FOR HIGH RISE APARTMENTS
 MAX. DENSITY 25 D.U.'s / NET ACRE
 PARKING RATIO 1.5 / D.U.
 MINIMUM SETBACK AS SHOWN ON PLAN (SEE ADJUSTMENT DATED 07/24/84)
 THE DENSITY FOR THE AREA SHOWN AS KINKAID PARK 5TH ADDITION SHALL NOT EXCEED 25 UNITS PER ACRE. THE TOTAL NUMBER OF DWELLING UNITS FOR PARCEL 4 SHALL NOT EXCEED 659 DWELLING UNITS, WITH 44 UNITS ALLOCATED FOR KINKAID PARK 3RD ADDITION AND 625 UNITS FOR KINKAID PARK 5TH ADDITION.
 PRIOR TO ISSUANCE OF A BUILDING PERMIT FOR A HIGH RISE APARTMENT BUILDING, A SITE PLAN SHALL BE SUBMITTED TO THE DIRECTOR OF PLANNING FOR REVIEW AND APPROVAL.

KINKAID C.U.P.

DP-43 AMENDMENT #3
APPROVED CUP
 MAPC 05/08/03 DM

MAPD Copy 2 of 2


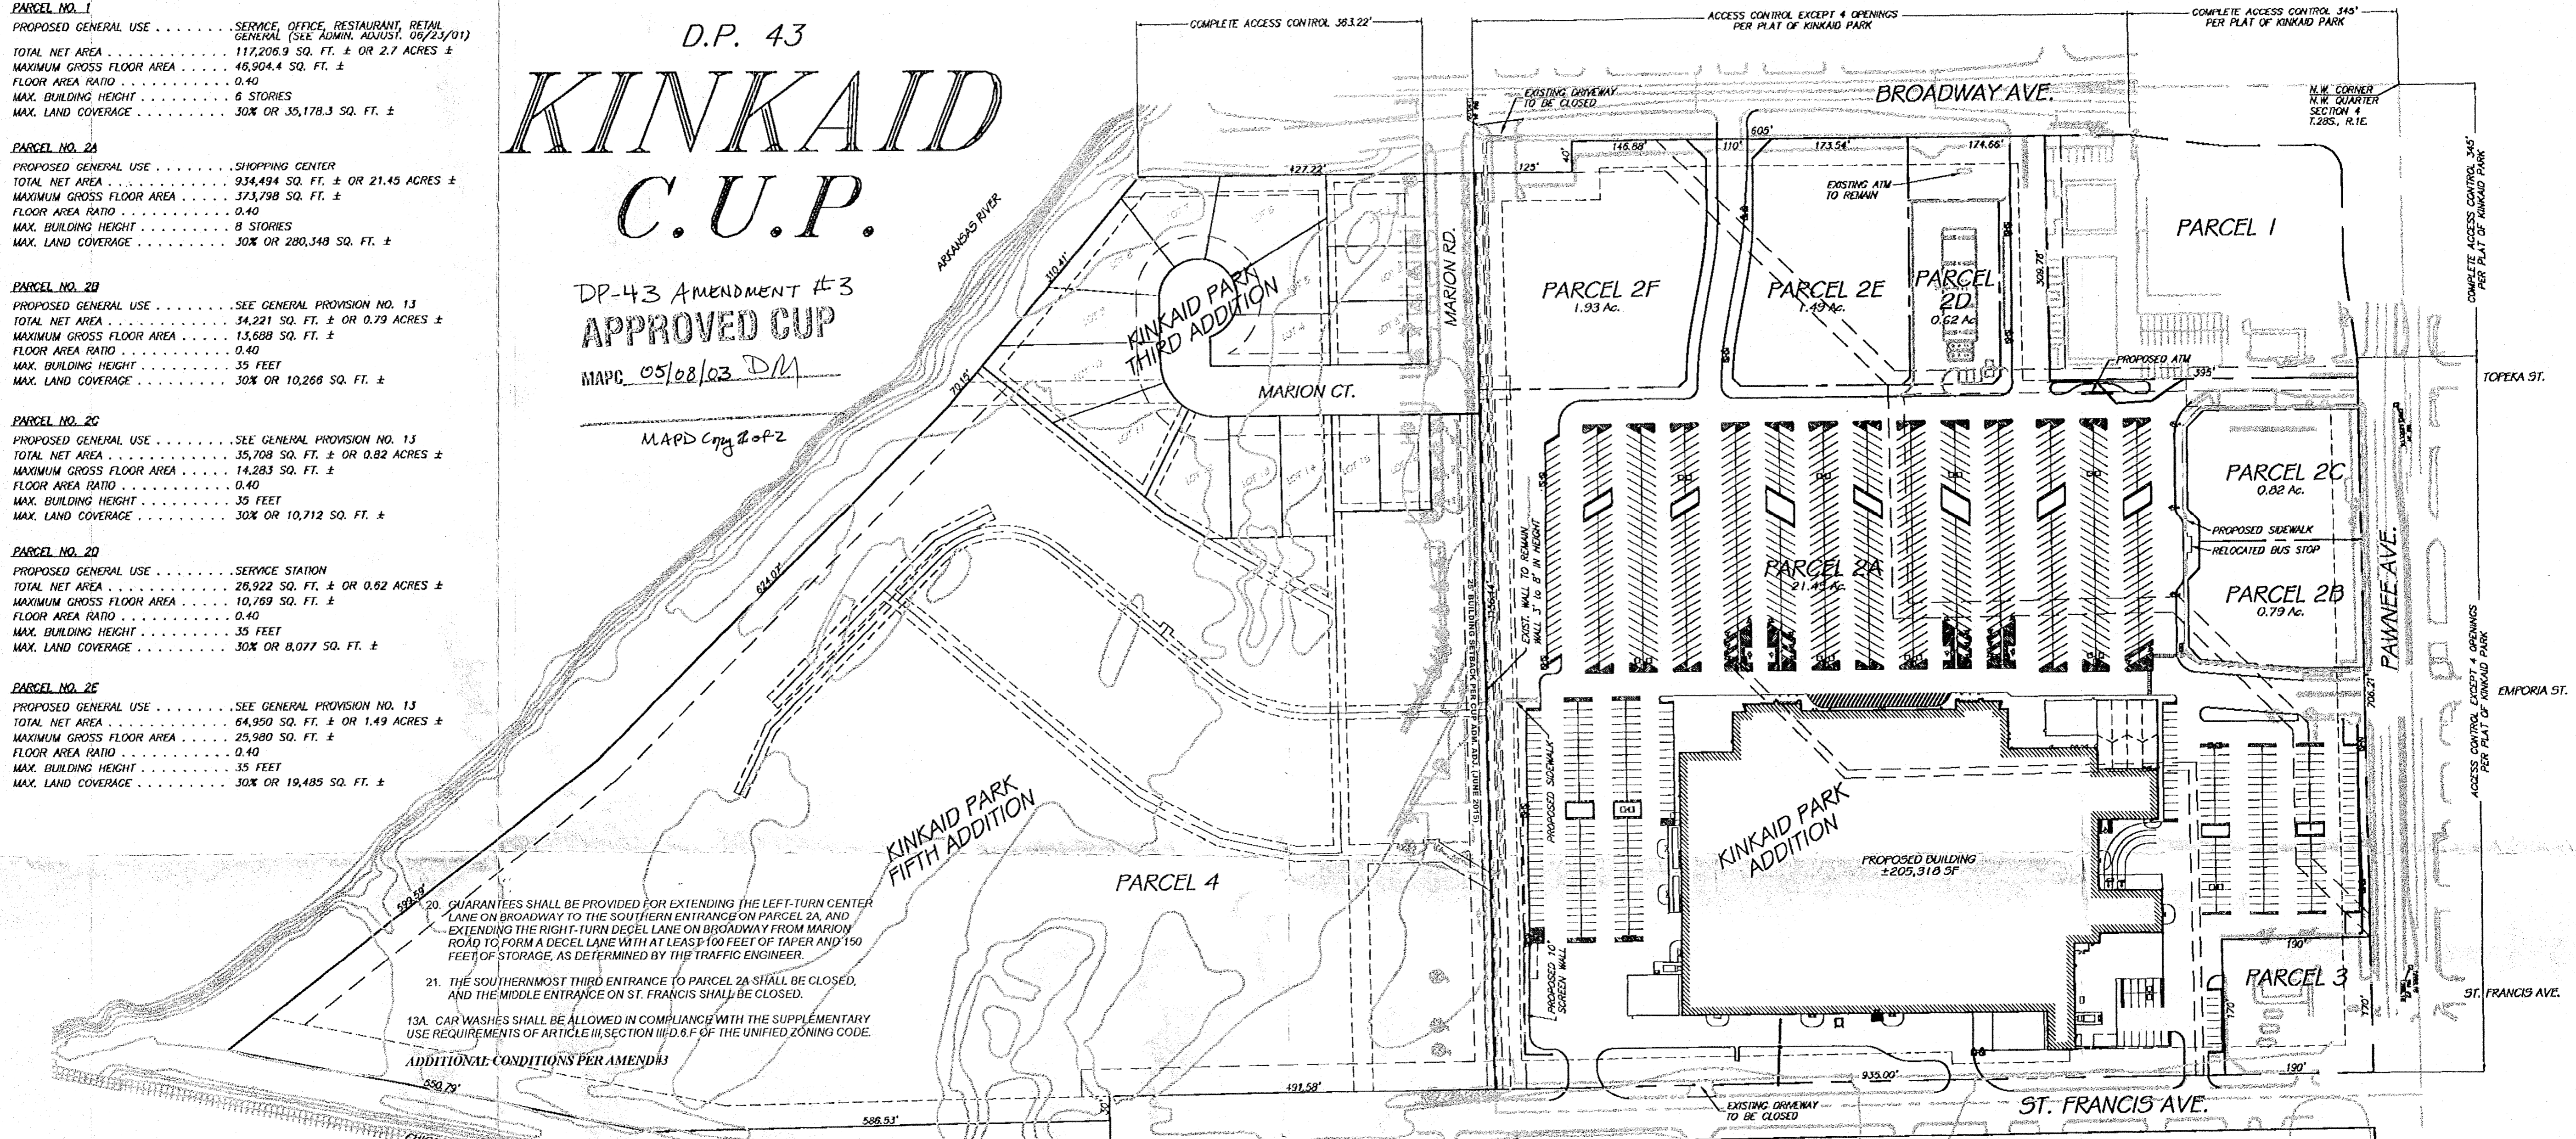


20. GUARANTEES SHALL BE PROVIDED FOR EXTENDING THE LEFT-TURN CENTER LANE ON BROADWAY TO THE SOUTHERN ENTRANCE ON PARCEL 2A, AND EXTENDING THE RIGHT-TURN DECEL LANE ON BROADWAY FROM MARION ROAD TO FORM A DECEL LANE WITH AT LEAST 100 FEET OF TAPER AND 150 FEET OF STORAGE, AS DETERMINED BY THE TRAFFIC ENGINEER.
21. THE SOUTHERNMOST THIRD ENTRANCE TO PARCEL 2A SHALL BE CLOSED, AND THE MIDDLE ENTRANCE ON ST. FRANCIS SHALL BE CLOSED.
- 13A. CAR WASHES SHALL BE ALLOWED IN COMPLIANCE WITH THE SUPPLEMENTARY USE REQUIREMENTS OF ARTICLE III, SECTION III.D.6.F OF THE UNIFIED ZONING CODE.
- ADDITIONAL CONDITIONS PER AMENDMENT 3**

GENERAL PROVISIONS

1. THIS COMMUNITY UNIT PLAN CONTAINS A TOTAL NET AREA OF 61.1 ACRES ±.
2. CURB CUTS - THE MAXIMUM NUMBER OF CURB CUTS ALONG PAWNEE AVE. SHALL NOT EXCEED 5. THE MAXIMUM NUMBER OF CURB CUTS ALONG BROADWAY AVE. SHALL NOT EXCEED 5. THE MAXIMUM NUMBER OF CURB CUTS ALONG ST. FRANCIS SHALL NOT EXCEED 6.
3. DRAINAGE PROBLEMS HAVE BEEN RESOLVED AT THE TIME OF PLATTING.
4. MAXIMUM LAND COVERAGE BY BUILDING SHALL NOT EXCEED 30 PERCENT OF THE TOTAL SITE (793,268.4 Sq. Ft. ±).
5. ALL UTILITIES SHALL BE INSTALLED UNDERGROUND.
6. ADVERTISING SIGNS ALONG PAWNEE AVE. AND BROADWAY AVE. SHALL NOT EXCEED 30 FEET IN HEIGHT AND SHALL BE PLACED SO AS NOT TO PROJECT OVER PUBLIC RIGHT-OF-WAY. NO BILL BOARD ADVERTISEMENT OR ROOF SIGNS SHALL BE ALLOWED.
7. MAXIMUM BUILDING HEIGHT (SEE INDIVIDUAL PARCELS).
8. PARKING RATIO - OFFICE AND COMMERCIAL BUILDINGS, INCLUDING GOVERNMENTAL, PUBLIC UTILITY AND OTHER SIMILAR BUILDINGS, SHALL PROVIDE ONE (1) SPACE FOR EACH TWO HUNDRED FIFTY (250) SQUARE FEET OF FLOOR AREA OR (1) SPACE FOR EVERY THREE EMPLOYEES IN THE LARGEST WORKING SHIFT IN A TWENTY-FOUR (24) HOUR PERIOD, WHICHEVER IS THE GREATER.
9. A FIRE LANE, 20 FEET IN WIDTH (WITH SUFFICIENT TURNING RADIUS AT CORNERS FOR STANDARD FIRE APPARATUS) SHALL BE PROVIDED AROUND ALL MAIN STRUCTURES CONSTRUCTED WITHIN PARCEL NO. 2. SAID FIRE LANE SHALL HAVE A 3 1/2 INCH ASPHALT BASE WITH 1 1/2 INCH ASPHALT SURFACE. NO PARKING SHALL BE ALLOWED IN SUCH FIRE LANE ALTHOUGH IT MAY BE USED FOR PASSENGER LOADING AND UNLOADING. PRIOR TO FINAL APPROVAL OF THE PARKING PLAN, THE FIRE CHIEF OR HIS DESIGNATED REPRESENTATIVE, SHALL APPROVE THE PLAN TO THE LOCATION AND DESIGN OF THE FIRE LANE.
10. A HOMES ASSOCIATION AGREEMENT PROVIDING FOR MAINTENANCE OF NON-PUBLIC COMMON AREAS, PARKING AREAS, PRIVATE DRIVES, COMMUNITY FACILITIES, ETC., SHALL BE SUBMITTED WITH THE PLAT FOR PARCEL #4, IF IT IS PROPOSED THAT EACH DWELLING UNIT WILL BE INDIVIDUALLY OWNED. SPECIFICALLY DEFINED PRIOR TO ISSUANCE OF BUILDING PERMITS FOR PARCEL NO. 4.

11. SIGNS OR MONUMENTS DESIGNATING THE NAME OF THE DEVELOPMENT SHALL BE PERMITTED AT THE ENTRANCES TO THE PROPOSED DEVELOPMENT OF PARCEL 4. THESE SHALL BE PERMITTED IF THEY FOLLOW IN ACCORDANCE WITH THE PROVISIONS OF SECTION 28.04.139 OF THE CODE OF THE CITY OF WICHITA.
12. APPROPRIATE FIRE LANE EASEMENTS AND TRAFFIC CIRCULATION WILL BE CONSIDERED AND MORE SPECIFICALLY DEFINED PRIOR TO ISSUANCE OF BUILDING PERMITS FOR PARCEL NO. 4.
13. THE PROPOSED GENERAL USE FOR PARCELS 2B, 2C, 2E, AND 2F SHALL BE ANY COMMERCIAL USE PERMITTED BY-RIGHT IN THE LC ZONING DISTRICT EXCLUDING ~~BAR~~ NIGHT CLUB IN CITY, SEXUALLY ORIENTED BUSINESS, TAVERN AND DRINKING ESTABLISHMENT.
14. LANDSCAPING: DEVELOPMENT OF PARCELS 2A, 2B, 2C, 2D, 2E AND 2F SHALL COMPLY WITH THE LANDSCAPE ORDINANCE OF THE CITY OF WICHITA. A LANDSCAPE PLAN SHALL BE PREPARED BY A KANSAS LANDSCAPE ARCHITECT FOR THE ABOVE REFERENCED LANDSCAPING, INDICATING THE TYPE, LOCATION AND SPECIFICATIONS OF ALL PLANT MATERIAL. THIS PLAN SHALL BE SUBMITTED TO THE PLANNING DEPARTMENT FOR REVIEW AND APPROVAL PRIOR TO ISSUANCE OF A BUILDING PERMIT. A FINANCIAL GUARANTEE FOR THE PLANT MATERIAL APPROVED ON THE LANDSCAPE PLAN FOR THAT PORTION OF THE C.U.P. BEING DEVELOPED SHALL BE REQUIRED PRIOR TO ISSUANCE OF ANY OCCUPANCY PERMIT, IF THE REQUIRED LANDSCAPING HAS NOT BEEN PLANTED.
15. ARCHITECTURAL: ALL BUILDINGS CONSTRUCTED ON PARCELS 2A, 2B, 2C, 2D, 2E, AND 2F SHALL SHARE UNIFORM ARCHITECTURAL CHARACTER, COLOR, TEXTURE, AND THE SAME PREDOMINANT EXTERIOR BUILDING MATERIAL, AS DETERMINED BY THE DIRECTOR OF PLANNING. BUILDING WALLS AND ROOFS MUST HAVE PREDOMINANTLY EARLY-1900 COLORS, WITH VIVID COLORS LIMITED TO INCIDENTAL ACCENT.
16. LIGHTING: ALL EXTERIOR LIGHTING FOR PARCELS 2A, 2B, 2C, 2D, 2E, AND 2F SHALL BE SHIELDED TO DIRECT LIGHT DISBURSEMENT IN A DOWNWARD DIRECTION. THE ABOVE PARCELS SHALL SHARE SIMILAR OR CONSISTENT PARKING LOT LIGHTING ELEMENTS (I.E. FIXTURES, POLE TYPE, LAMPS, ETC.). EXTENSIVE USE OF BACK LIT CANOPIES AND NEON OR FLUORESCENT TUBE LIGHTING ON BUILDINGS IS NOT PERMITTED.
17. FOR PARCELS 2A, 2B, 2C, 2E AND 2F, ROOFTOP MECHANICAL EQUIPMENT SHALL BE SCREENED FROM GROUND LEVEL VIEW PER THE UNIFIED ZONING CODE.
18. FOR PARCELS 2A, 2B, 2C, 2E AND 2F, TRASH RECEPTACLES, LOADING DOCKS, OUTDOOR STORAGE, AND LOADING AREAS SHALL BE APPROPRIATELY SCREENED TO REASONABLY HIDE THEM FROM GROUND VIEW.
19. FOR PARCELS 2A, 2B, 2C, 2E AND 2F, CROSS-LOT CIRCULATION IS TO BE PROVIDED FOR ALL LOTS PLATTED FOR RETAIL, COMMERCIAL OR OFFICE USES.

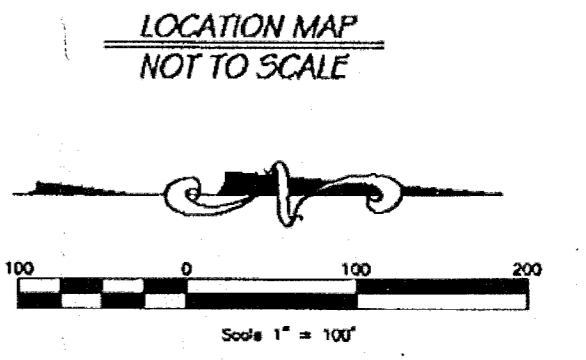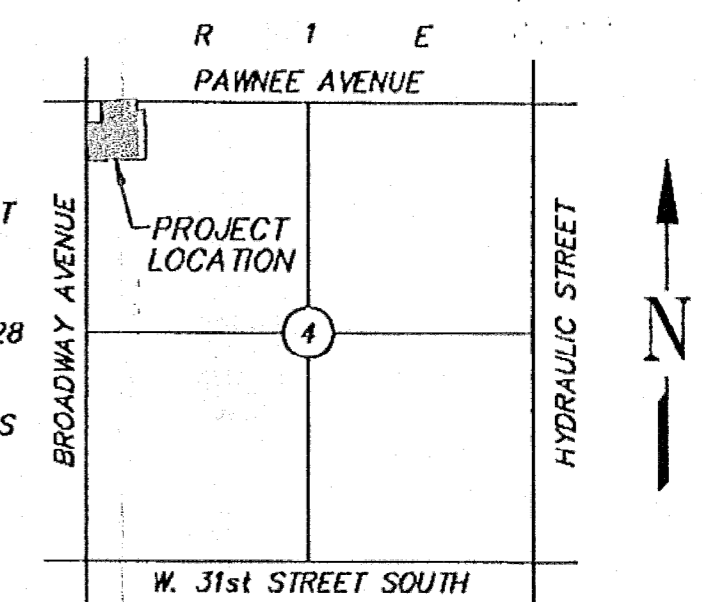

AMENDED
 ORIGINAL 09/07/71
 AMENDED 07/25/73
 REVISIONS 08/09/73
 AMENDED 02/25/81
 REVISED 06/29/15

Date: **04/30/2003**
 SPEAR & McCALEB CO., P.C.
 815 W. Main Street
 Oklahoma City, OK 73108

KINKAID (DP-43)
 SHEET 1 OF 1
KINKAID C.U.P.


LANDSCAPE CALC'S
 LOT DEPTH OF 308' = 15' x (110' - 24' ACCESS EASEMENT FOR NORTH PROPERTY = 1260 SQ. FT. LANDSCAPED STREET YARD
 1260/300 = 3 TREES
 ACTUAL LANDSCAPE YARD = 1270 SQ. FT.

NOTE:
 EXIST. LANDSCAPE BUFFER IS 10' WIDE.
 REMOVE SICKLY LANDSCAPING AND
 RE-PLANT W/ FIRE THORN (PYRACANTHA GNOHE)
 45'-6" O.C. (2 GAL SIZE) (15 THUS)
 AND 3 NEW 2" CALIPER SIZED
 THORNLESS HONEY LOCUST TREES. IRRIGATION TO
 BE BY HOSE BIBB ON BLDG.

EXIST. LANDSCAPED BUFFER TO BE
 WIDENED FROM 10' TO 15'
 RE-SEED W/ FESCUE. WATERING BY BLDG. HOSE BIBB

2- PEAR TREES 'DANCER' 2" CALIPER


24- 2 GAL SIZE COMMON QUINCE
 SPACED 3'-6" O.C.

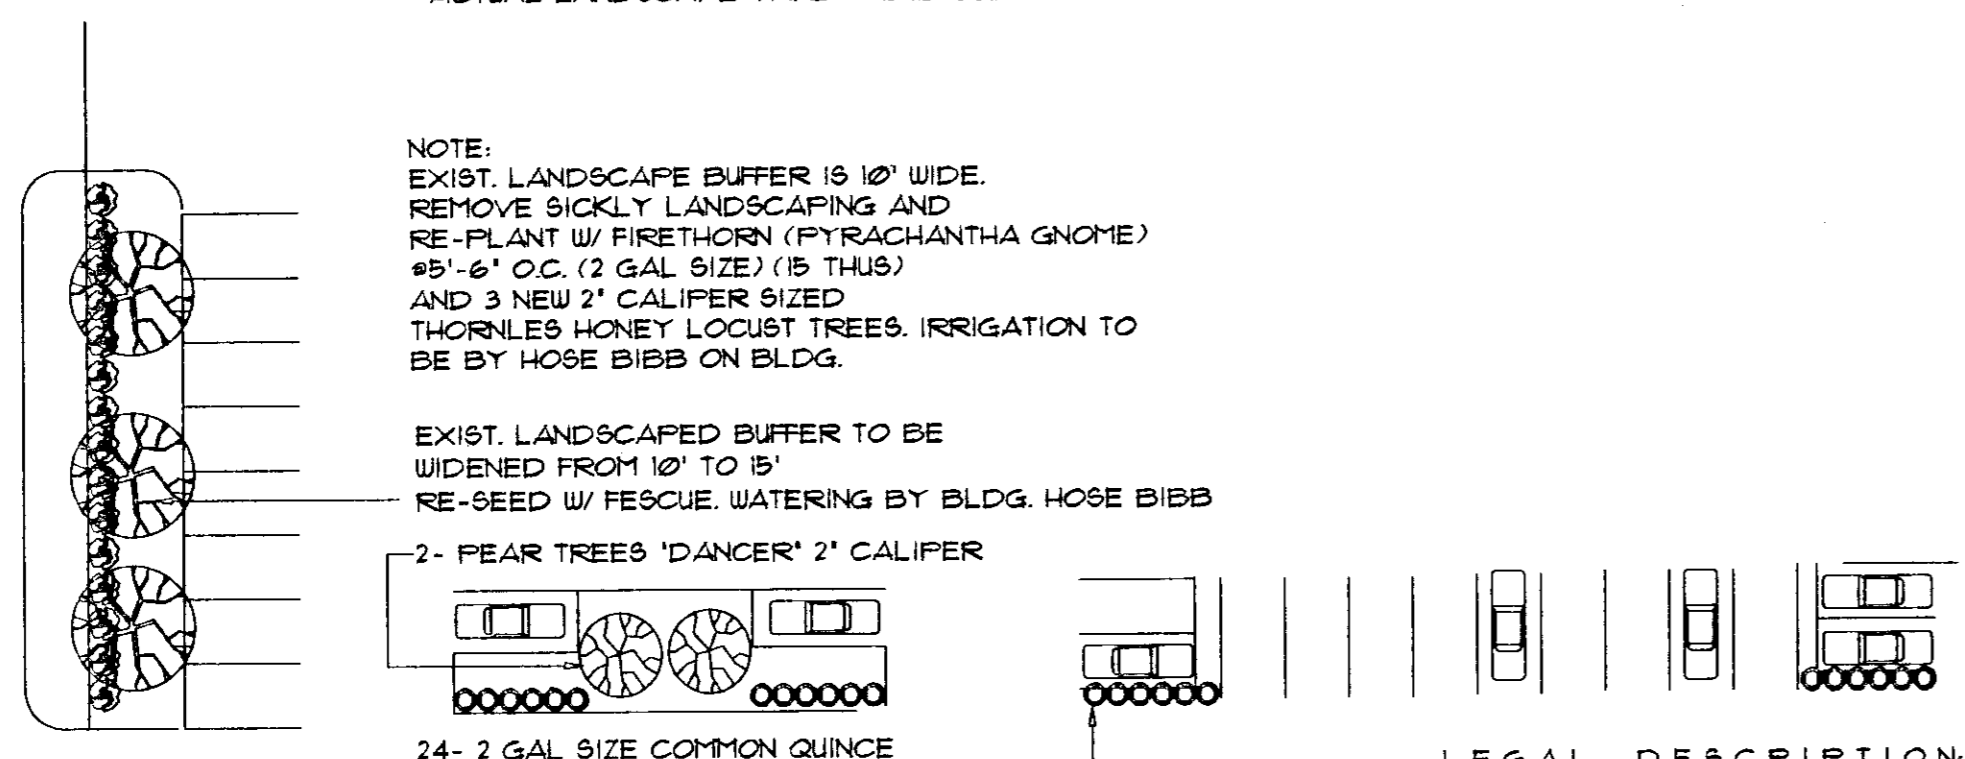


LANDSCAPE PLAN

SCALE: 1"=30'-0"


LEGAL DESCRIPTION:
 LOT 1, BLOCK A, KINCADE PARK ADDITION
 TO WICHITA, SEDG. CITY, KANSAS

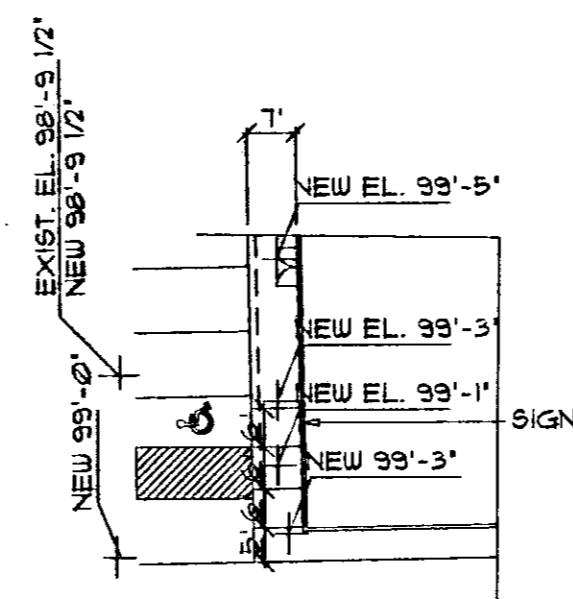


SOUTHWEST RAMP
 BLDG. "A"

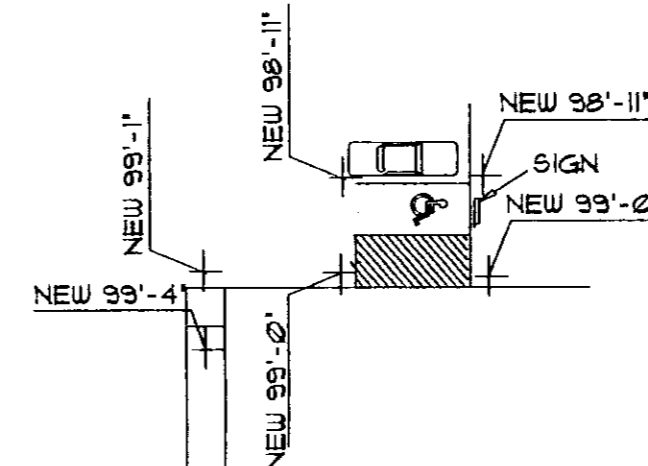

NORTHWEST RAMP
 BLDG. "A"

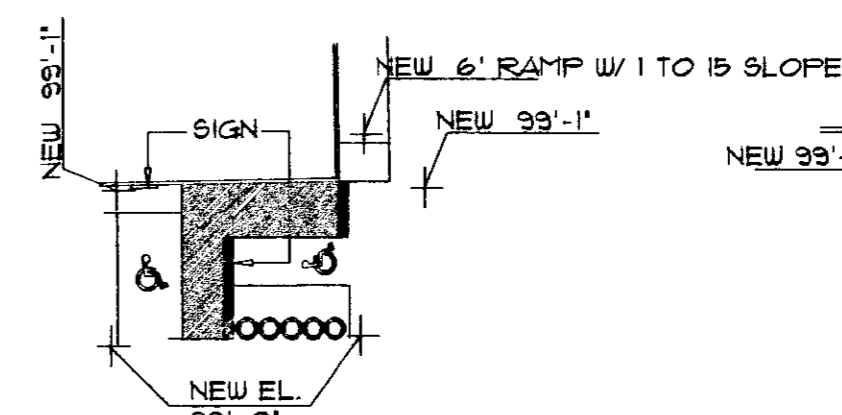

SOUTHEAST RAMP
 BLDG. "B"

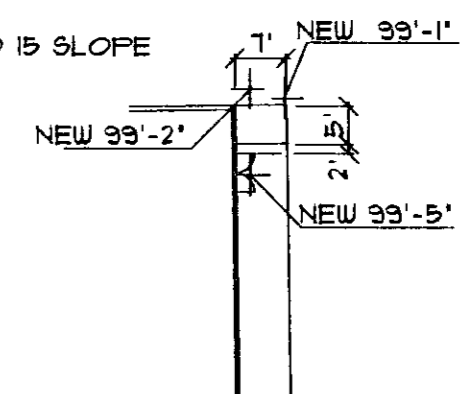


NORTHEAST RAMP
 BLDG. "B"

RAMP DETAILS

SCALE: 1"=30'-0"



NOTE: ELEVATIONS ON BOTH SIDES OF ALL
 DOOR THRESHOLDS SHALL BE SAME ELEVATION.
 SLOPE EXTERIOR WALK 1" IN 5'-0" AT ALL
 DOOR LOCATIONS MAXIMUM PER ADA. WHEN RAMP
 IS IN PROXIMITY OF AN EXTERIOR DOOR, SLOPE
 SHALL BEGIN NOT CLOSER THAN 2'-0" FROM DOOR
 JAMB, PER ADA

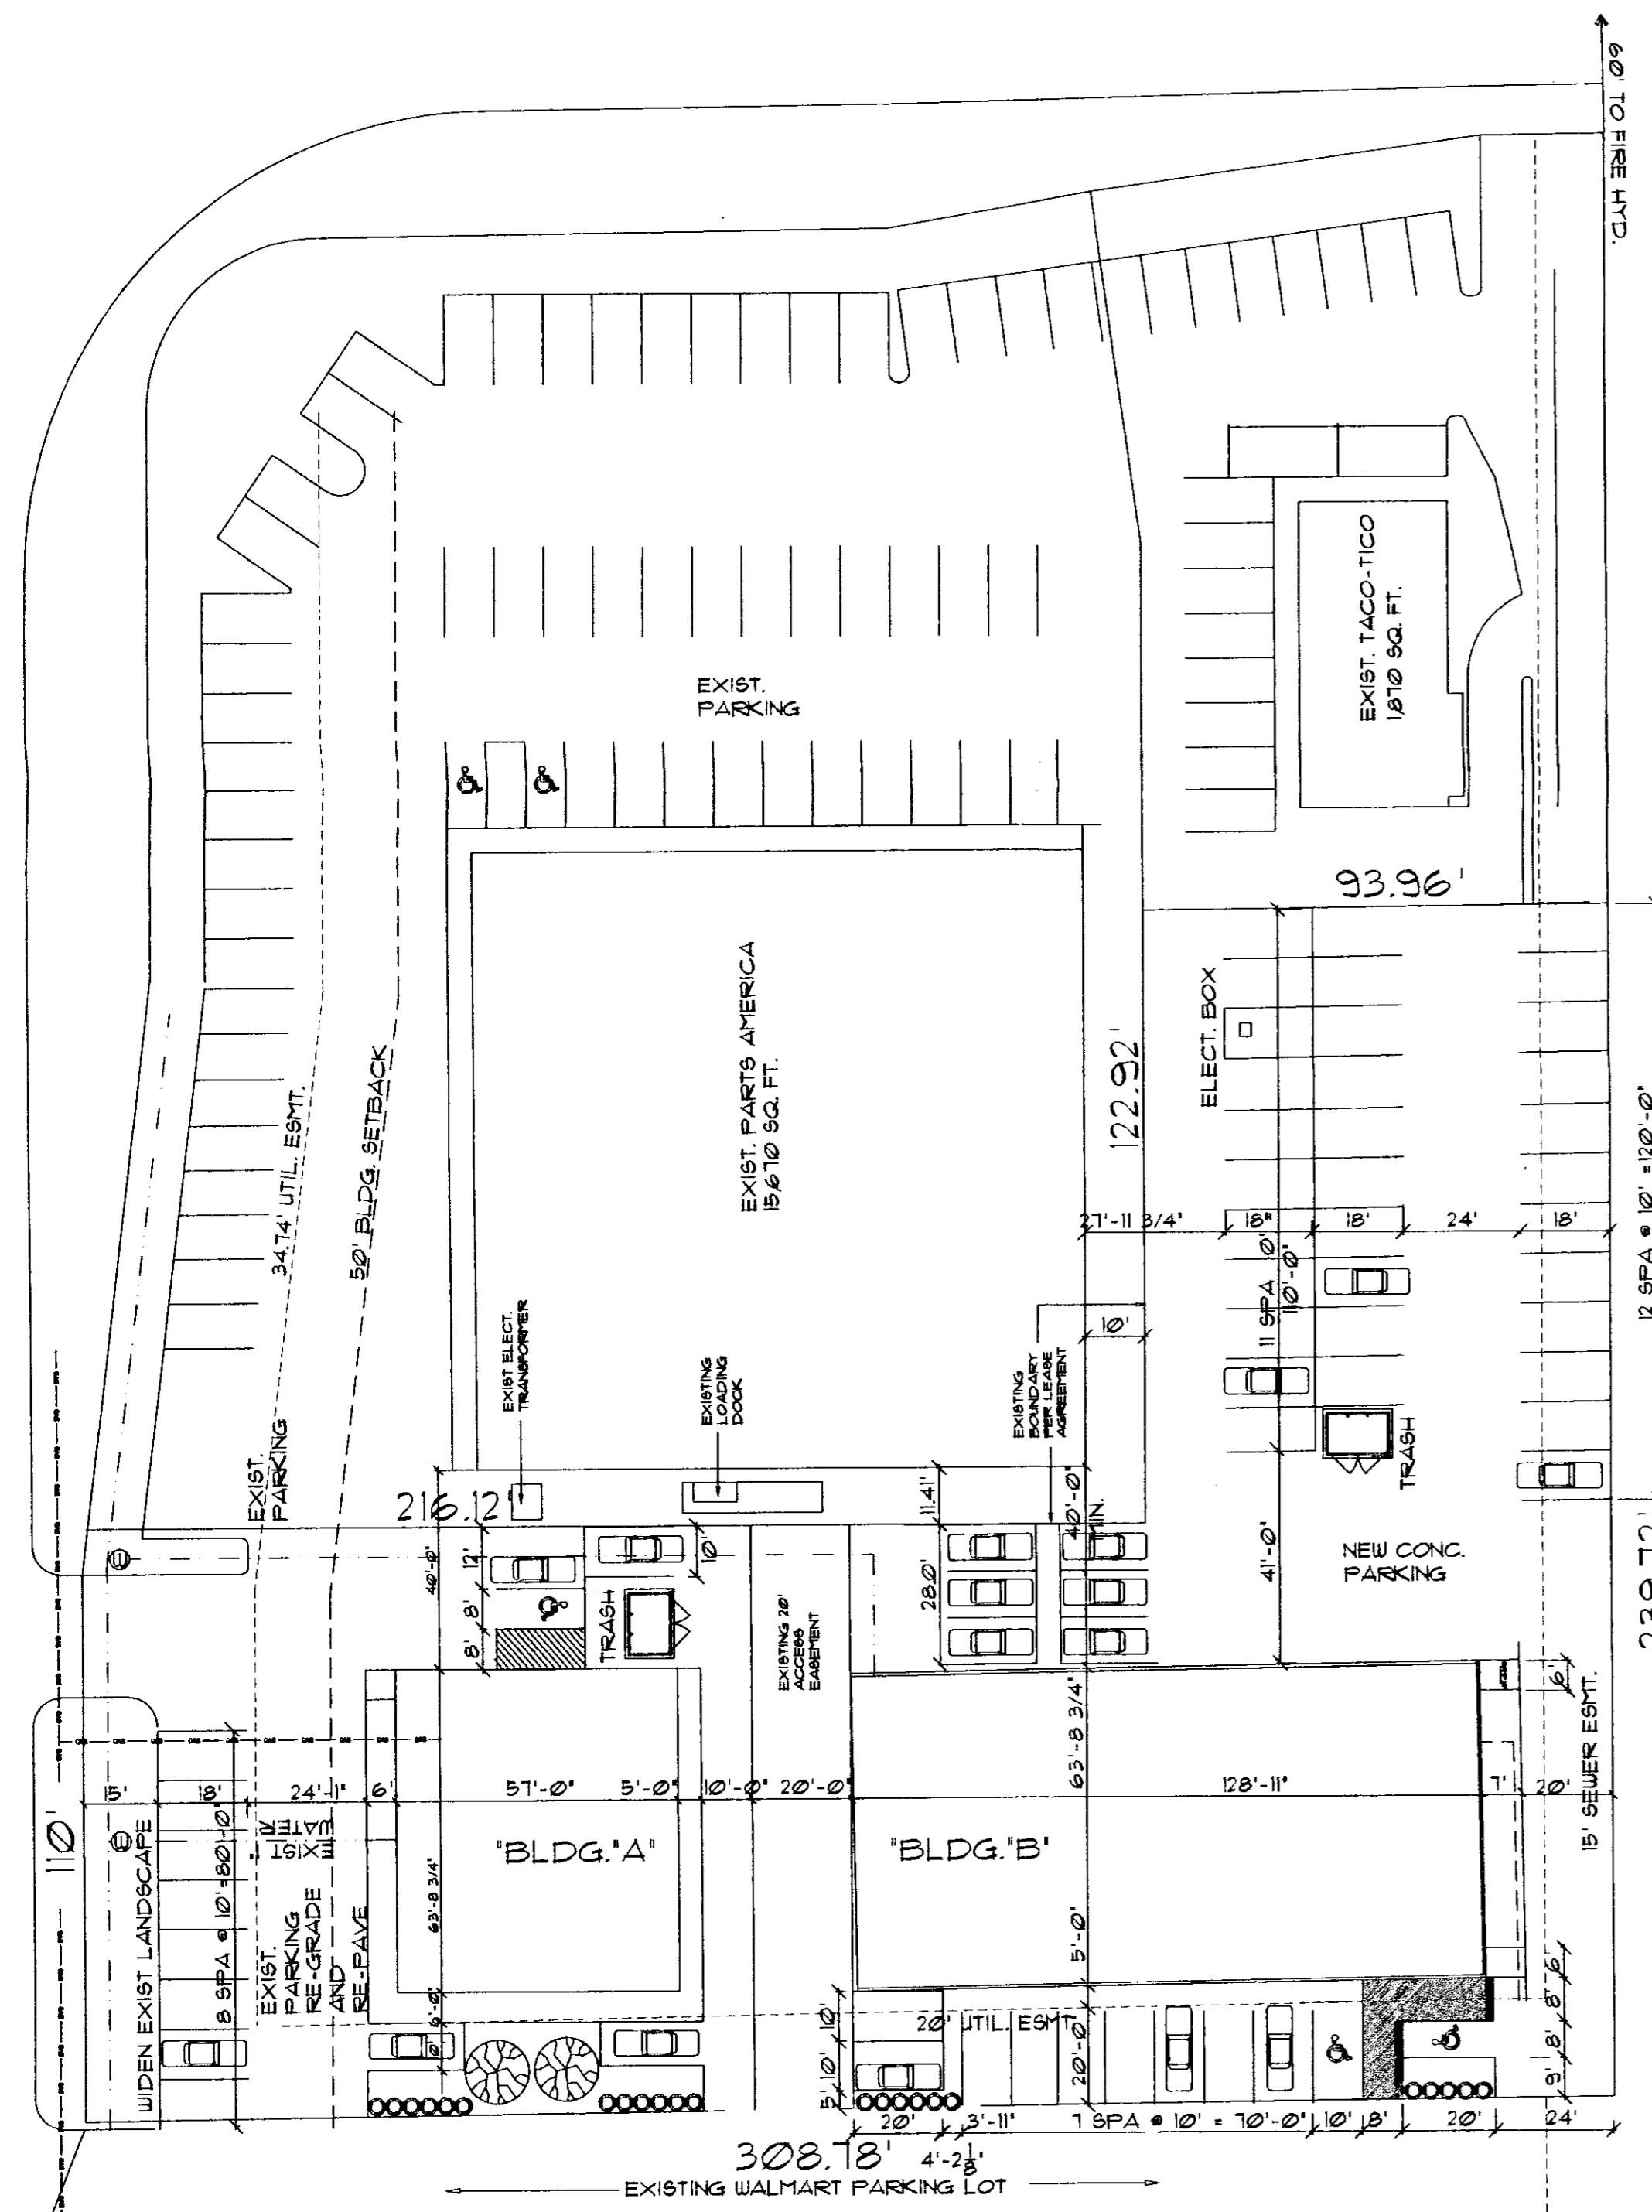

SITE PLAN

SCALE: 1"=30'-0"

GENERAL NOTES:
 TOTAL SITE = 45,539 SQ. FT.
 IMPERVIOUS AREA = 44,439 SQ. FT.
 BLDG. SIZE = 12,000 SQ. FT.
 BLDG. CONST TYPE = 2N
 PARKING REQUIRED = 40 CARS
 ACTUAL PARKING = 62 CARS

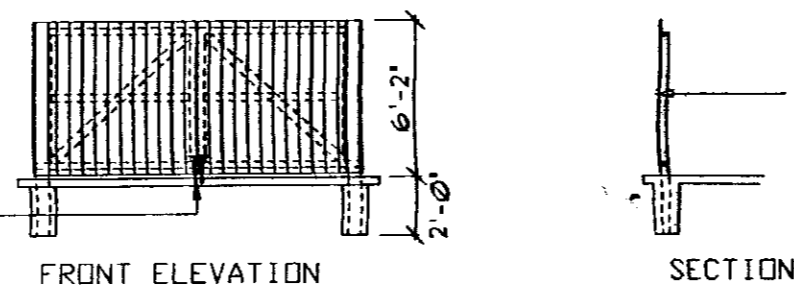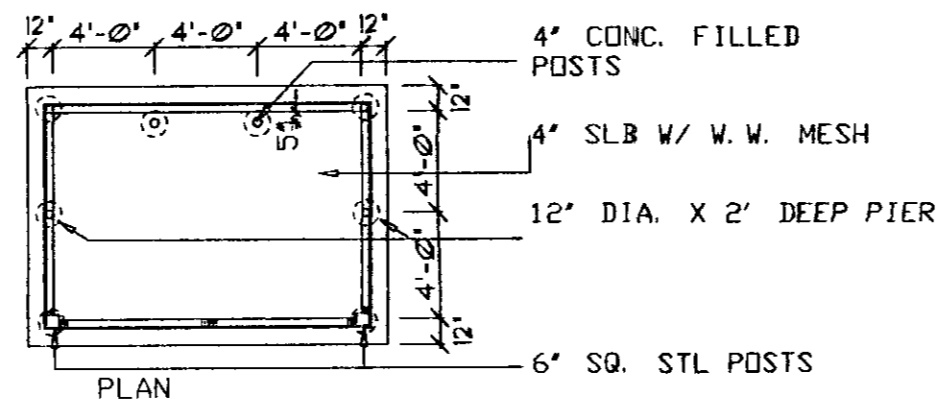


TRASH ENCLOSURE DTLS.

SCALE: 1/4"=1'-0"


* BLUE PAINT SYMBOL
 REFLECTIVE HANDICAP
 SIGN TO BE INSTALLED
 PER CITY STANDARDS

** SIGN TO READ:
 "VAN ACCESSIBLE"

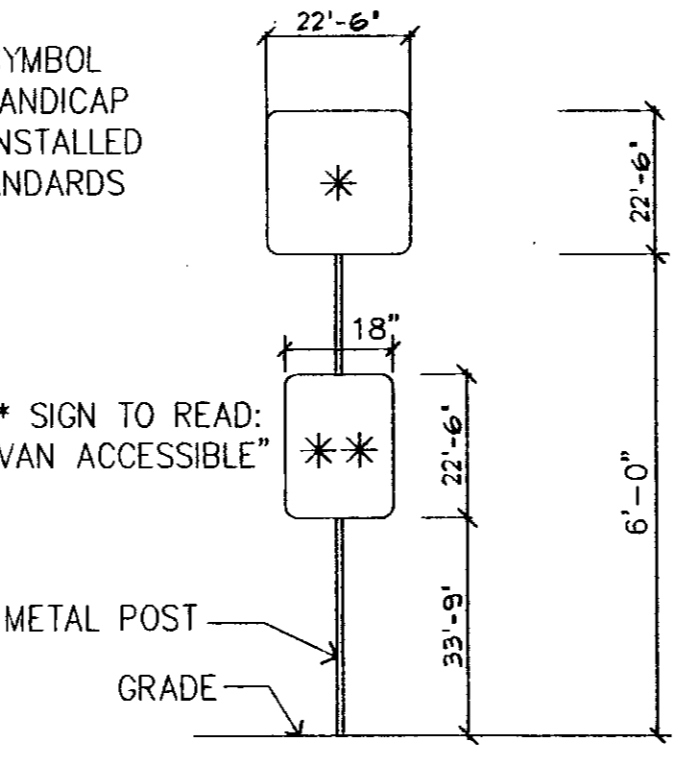

HANDICAP SIGN DETAIL

3/8" = 1'-0"

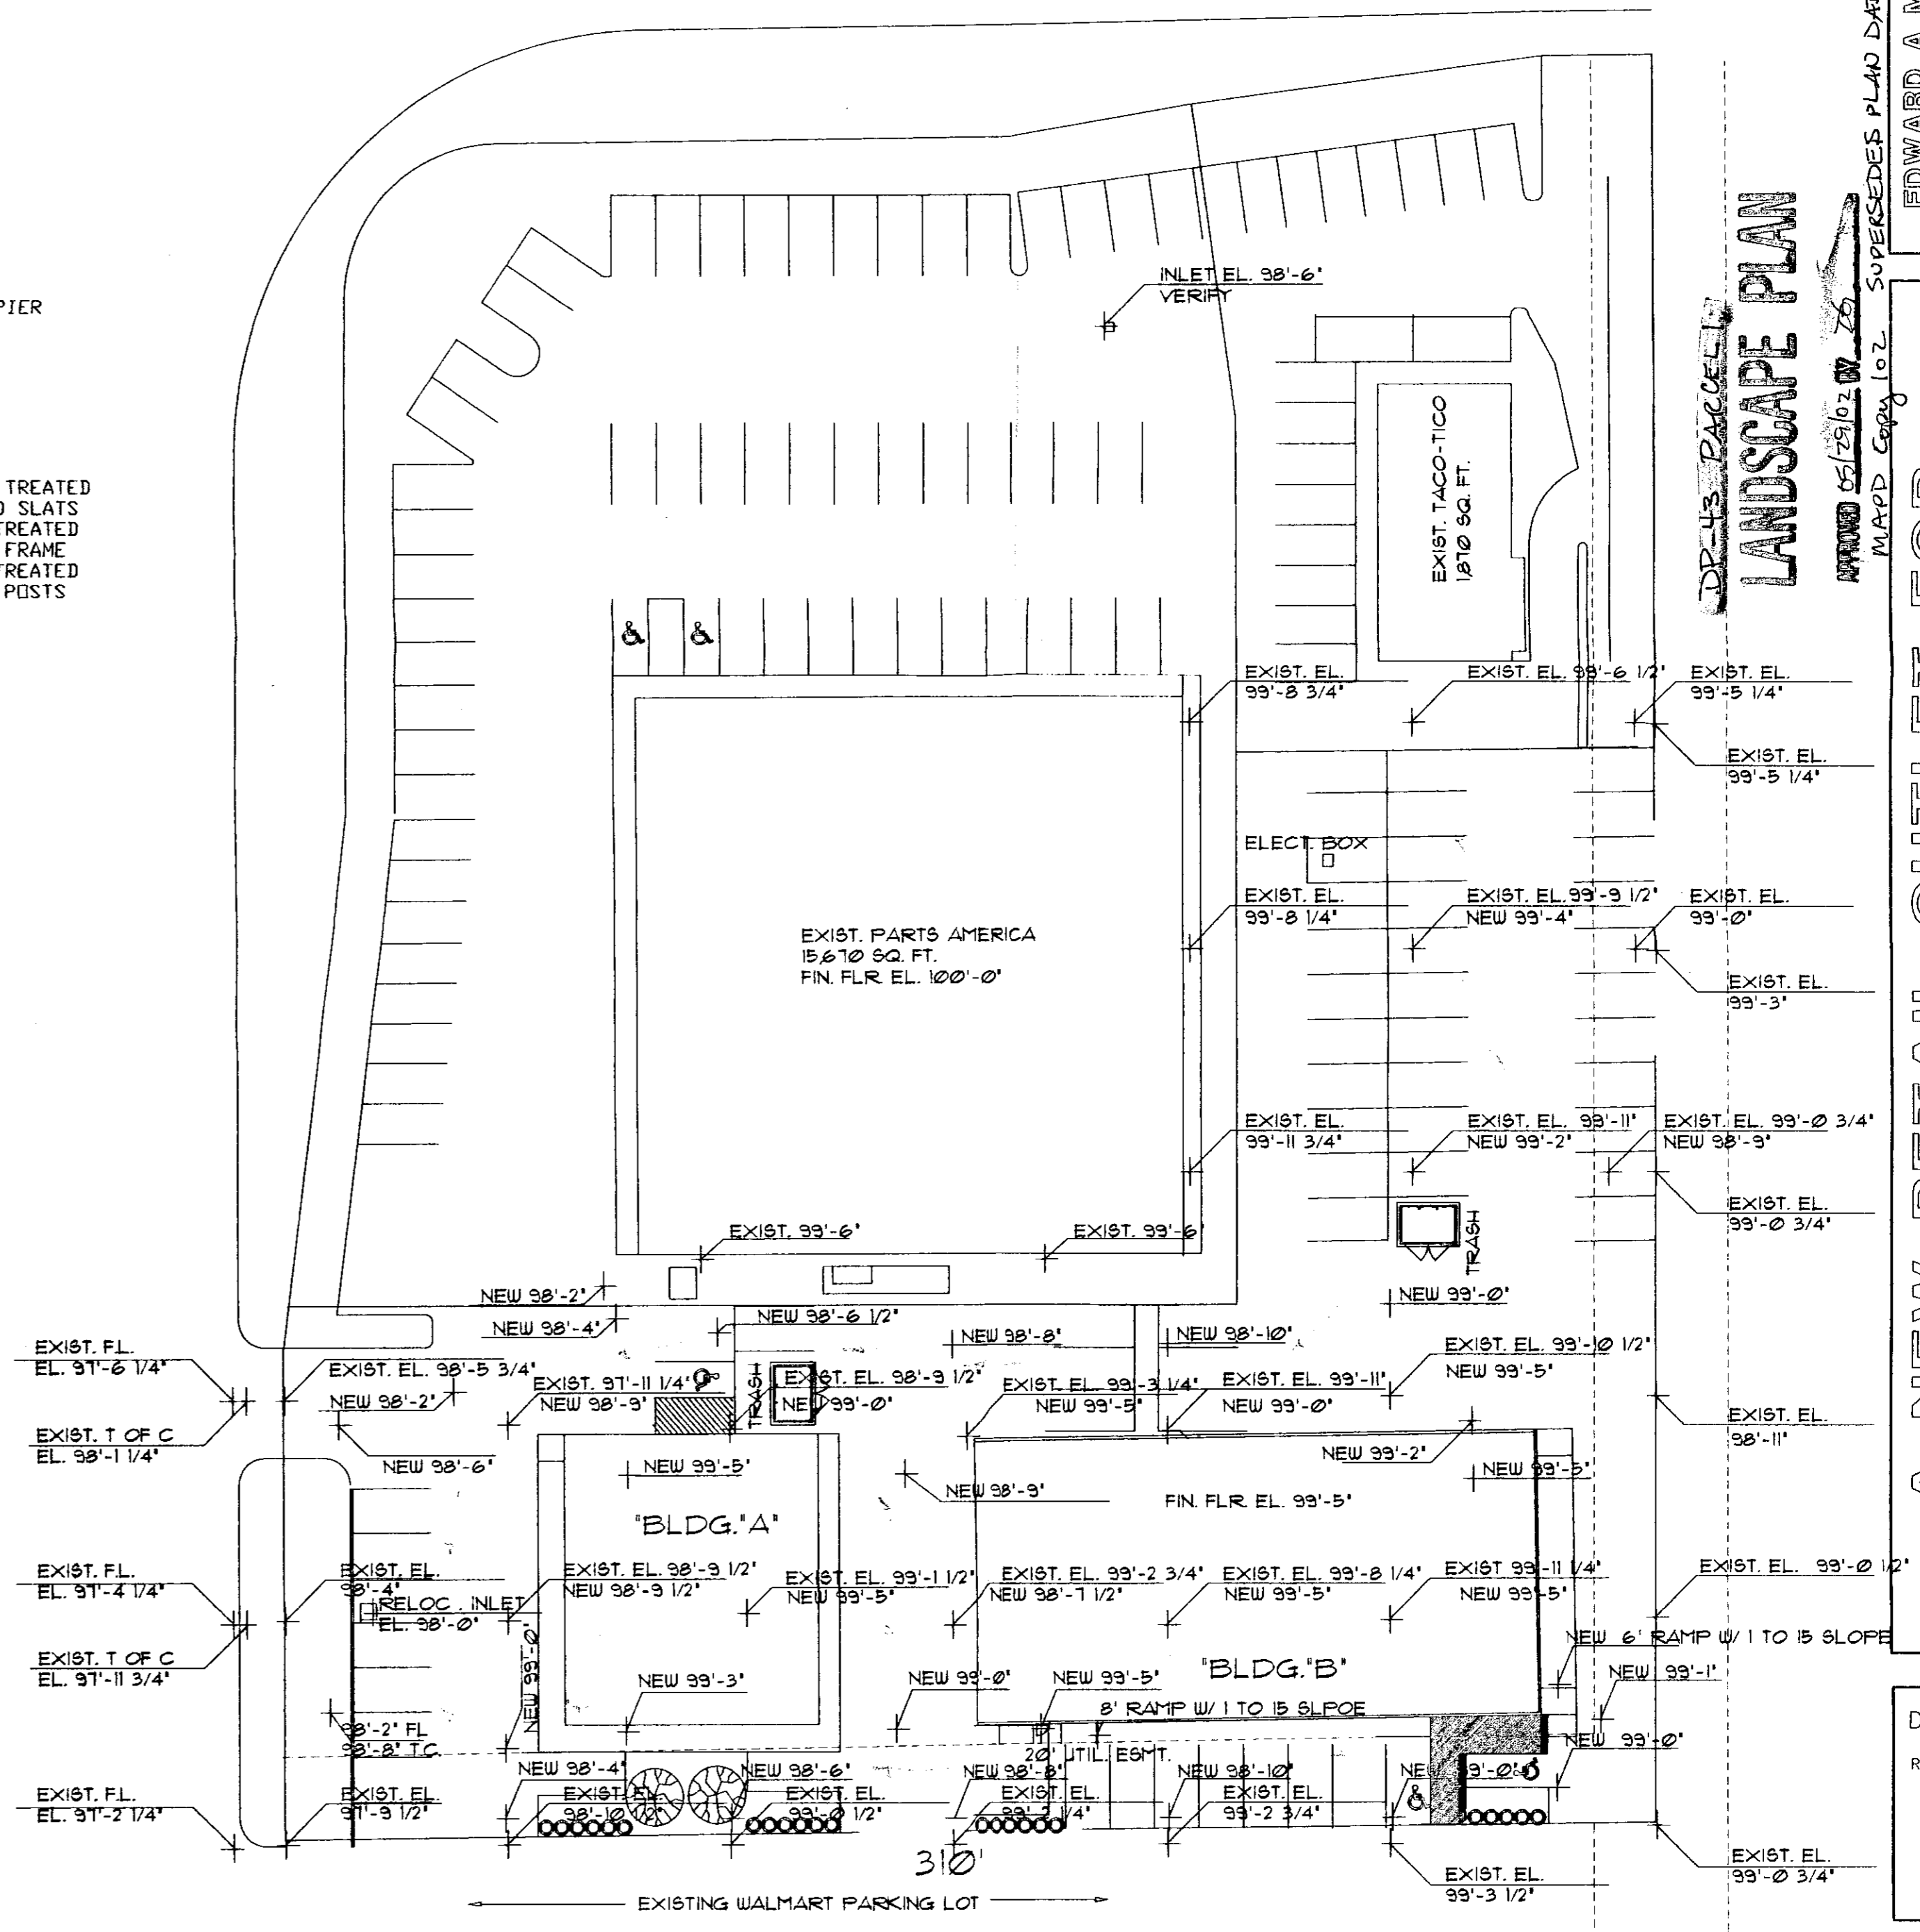

SITE GRADING PLAN

SCALE: 1"=30'-0"

EDWARD A MURABITO
 ARCHITECT
 PLANNER
 WICHITA KANSAS


A NEW RETAIL OUTLET FOR:
 DOLLAR GENERAL & ACTION RENT TO OWN
 PAWNEE AND BWY. WICHITA, KS.

DATE: 7 APRIL 01
 REVISED: 20 MAY 02

Copyright ©

SP.1
 OF

PHONE: 316 686-9516

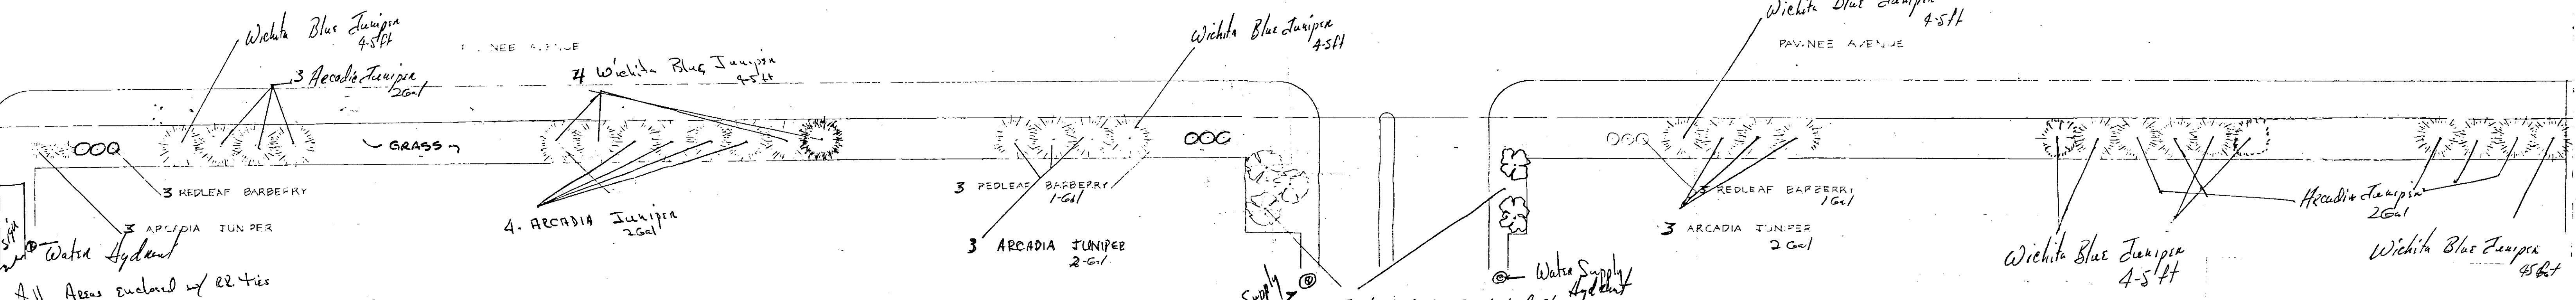

All Areas enclosed w/ RL ties

LANDSCAPE PLAN APPROVED
 FOR PARCEL No. 2 OF THE
 KINKAID C.U.P. (DP-43)
 J. M. [Signature] 5-18-79
 date

↑
 N
 1" = 20' 0"

Parcel No 2
 Kinkaid C.U.P.
 Pawnee Plaza Mall
 501 East Pawnee
 Wichita, Kansas
 67211

FIRE HYDRANT

LEGAL DESCRIPTION:
LOT 3 BLOCK A REPLAT
OF KINDAID PARK ADD.

LANDSCAPE ORDINANCE CALC.'S

LANDSCAPE STREETYARD REQUIRED
Average Lot Depth 198.20 l.f. = 10 Square Footage Factor per Linear Foot
Pawnee Avenue 164.94' l.f x 10 s.f. = 1,649 s.f. Street Yard Landscape
LANDSCAPE STREETYARD PROVIDED 1,734 Sq. Ft.

STREETYARD TREES REQUIRED 1,649 Sq. Ft. / 500 = 4 Shade Trees

PARKING LOT TREES REQUIRED 56 Parking Spaces / 20 = 3 Shade Trees

TOTAL TREES REQUIRED 7 Shade Trees

TOTAL TREES PROVIDED
3 Shade Trees
4 Ornamental Tree (Equals 2 Shade Trees)
5 Streetyard Shade Trees
2-1/2 Shade Tree Credit for Parking Lot
7-1/2 Shade Trees Total

PARKING LOT SCREENING REQUIRED
Screening along Arterial Street Provided

BUFFER SCREENING - NOT REQUIRED

EXTRA SHRUBS PROVIDED - NOT REQUIRED - 24 Shrubs

PLANT LIST

QTY.	COMMON NAME	BOTANICAL NAME	SIZE	CONDITION
2	URBANITE ASH	Fraxinus pennsylvanica 'Urbanite'	2" cal. min.	B#B
1	AUTUMN BLAZE MAPLE	Acer rubrum 'Autumn Blaze'	2" cal. min.	B#B
4	PRAIRIFIRE CRABAPPLE	Malus spp. 'Prairifire'	1" cal. min.	B#B
24	ANTHONY WATERER SPIREA - Not Required	Spirea x bumalda 'Anthony Waterer'	2 gal. min.	Container
12	COMPACT BURNING BUSH	Evonymus alatus 'Compacta'	2 gal. min.	Container
31	SEA GREEN JUNIPER	Juniper chinensis 'Sea Green'	2 gal. min.	Container

NOTES

- Prior to any excavation for landscaping purposes, the location of underground utilities shall be determined by calling Kansas One-Call Systems @ 687-2470. Installer shall be responsible for any damage done to existing utilities.
- Commercial grade Black Plastic or Steel Edging shall be used to separate turf areas from planting beds. Verify with Owner.
- All planting beds shall be prepared by eradicating existing vegetation with Round-UP (or-equal) according to label directions. A pre-emergent herbicide shall be applied per label directions.
- Planting soil shall be improved with new friable topsoil, organic soil amendments such as Back-to-Earth, Gypsum, etc. in accordance with standard trade practise and as approved by owner.
- Granular type slow-release fertilizer formulated for new plantings i.e. MYKE, Ferti-lome Start N Grow or Hi-Yield Grower's Special shall be applied to root ball and soil prior to planting. Follow label instructions.
- Mulch in shrub beds shall be 3" depth grade 'A' shredded cedar mulch or 2" depth decorative rock mulch as indicated on landscape plan. Weed barrier fabric shall be installed under rock. Verify with Owner.
- Trees shall be staked. Apply 4" depth organic mulch in tree rings.
- Water for establishment and maintenance of plant materials on this project will be provided by automatic sprinkler system or hand watering. Verify with Owner.
- Disturbed lawn areas shall be reseeded or sodded as approved by owner.

DP-43 PARCEL 2C
LANDSCAPE PLAN
APPROVED 07-22-09 BY DS
MAPD Copy 1 of 2

LANDSCAPE ARCHITECTURE
Leslie Elving
Landscape Architect
(316) 685-9492
Wichita, Kansas

LANDSCAPE ARCHITECT
LESLIE MARIE ELVING
STATE OF KANSAS
1/24/2009


WA
WOLF & ASSOCIATES
ARCHITECTURE
12225 DOVE HILL CT.
DERBY, KANSAS 67037
TEL 1-316-776-1110
CELL 1-316-305-8811

DATE : 7-19-09
DR. BY : LME
PROJECT NO.
09-039
REVISIONS:
7-24-09

WILLIAM E. WOLF
REGISTERED ARCHITECT
KANSAS LICENSE NO. 2991


SHEET
LA1

ICS
INNOVATIVE CONSTRUCTION
SERVICES, INC.
316-260-1644
415 S. Central Expressway, Suite 2
Wichita, KS 67211
Lic. 6481

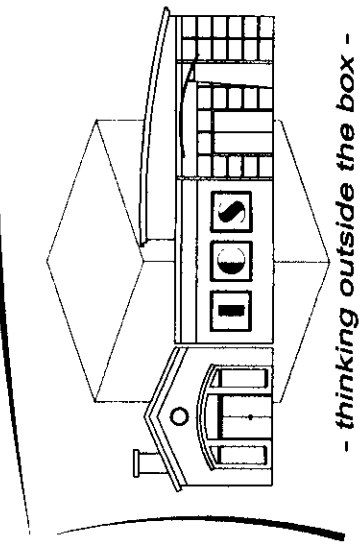

RETAIL CENTER
PAWNEE & BROADWAY
Wichita, KS

PROPERTY
OF
INNOVATIVE CONSTRUCTION SERVICES, INC.
UNLAWFUL TO REPRODUCE

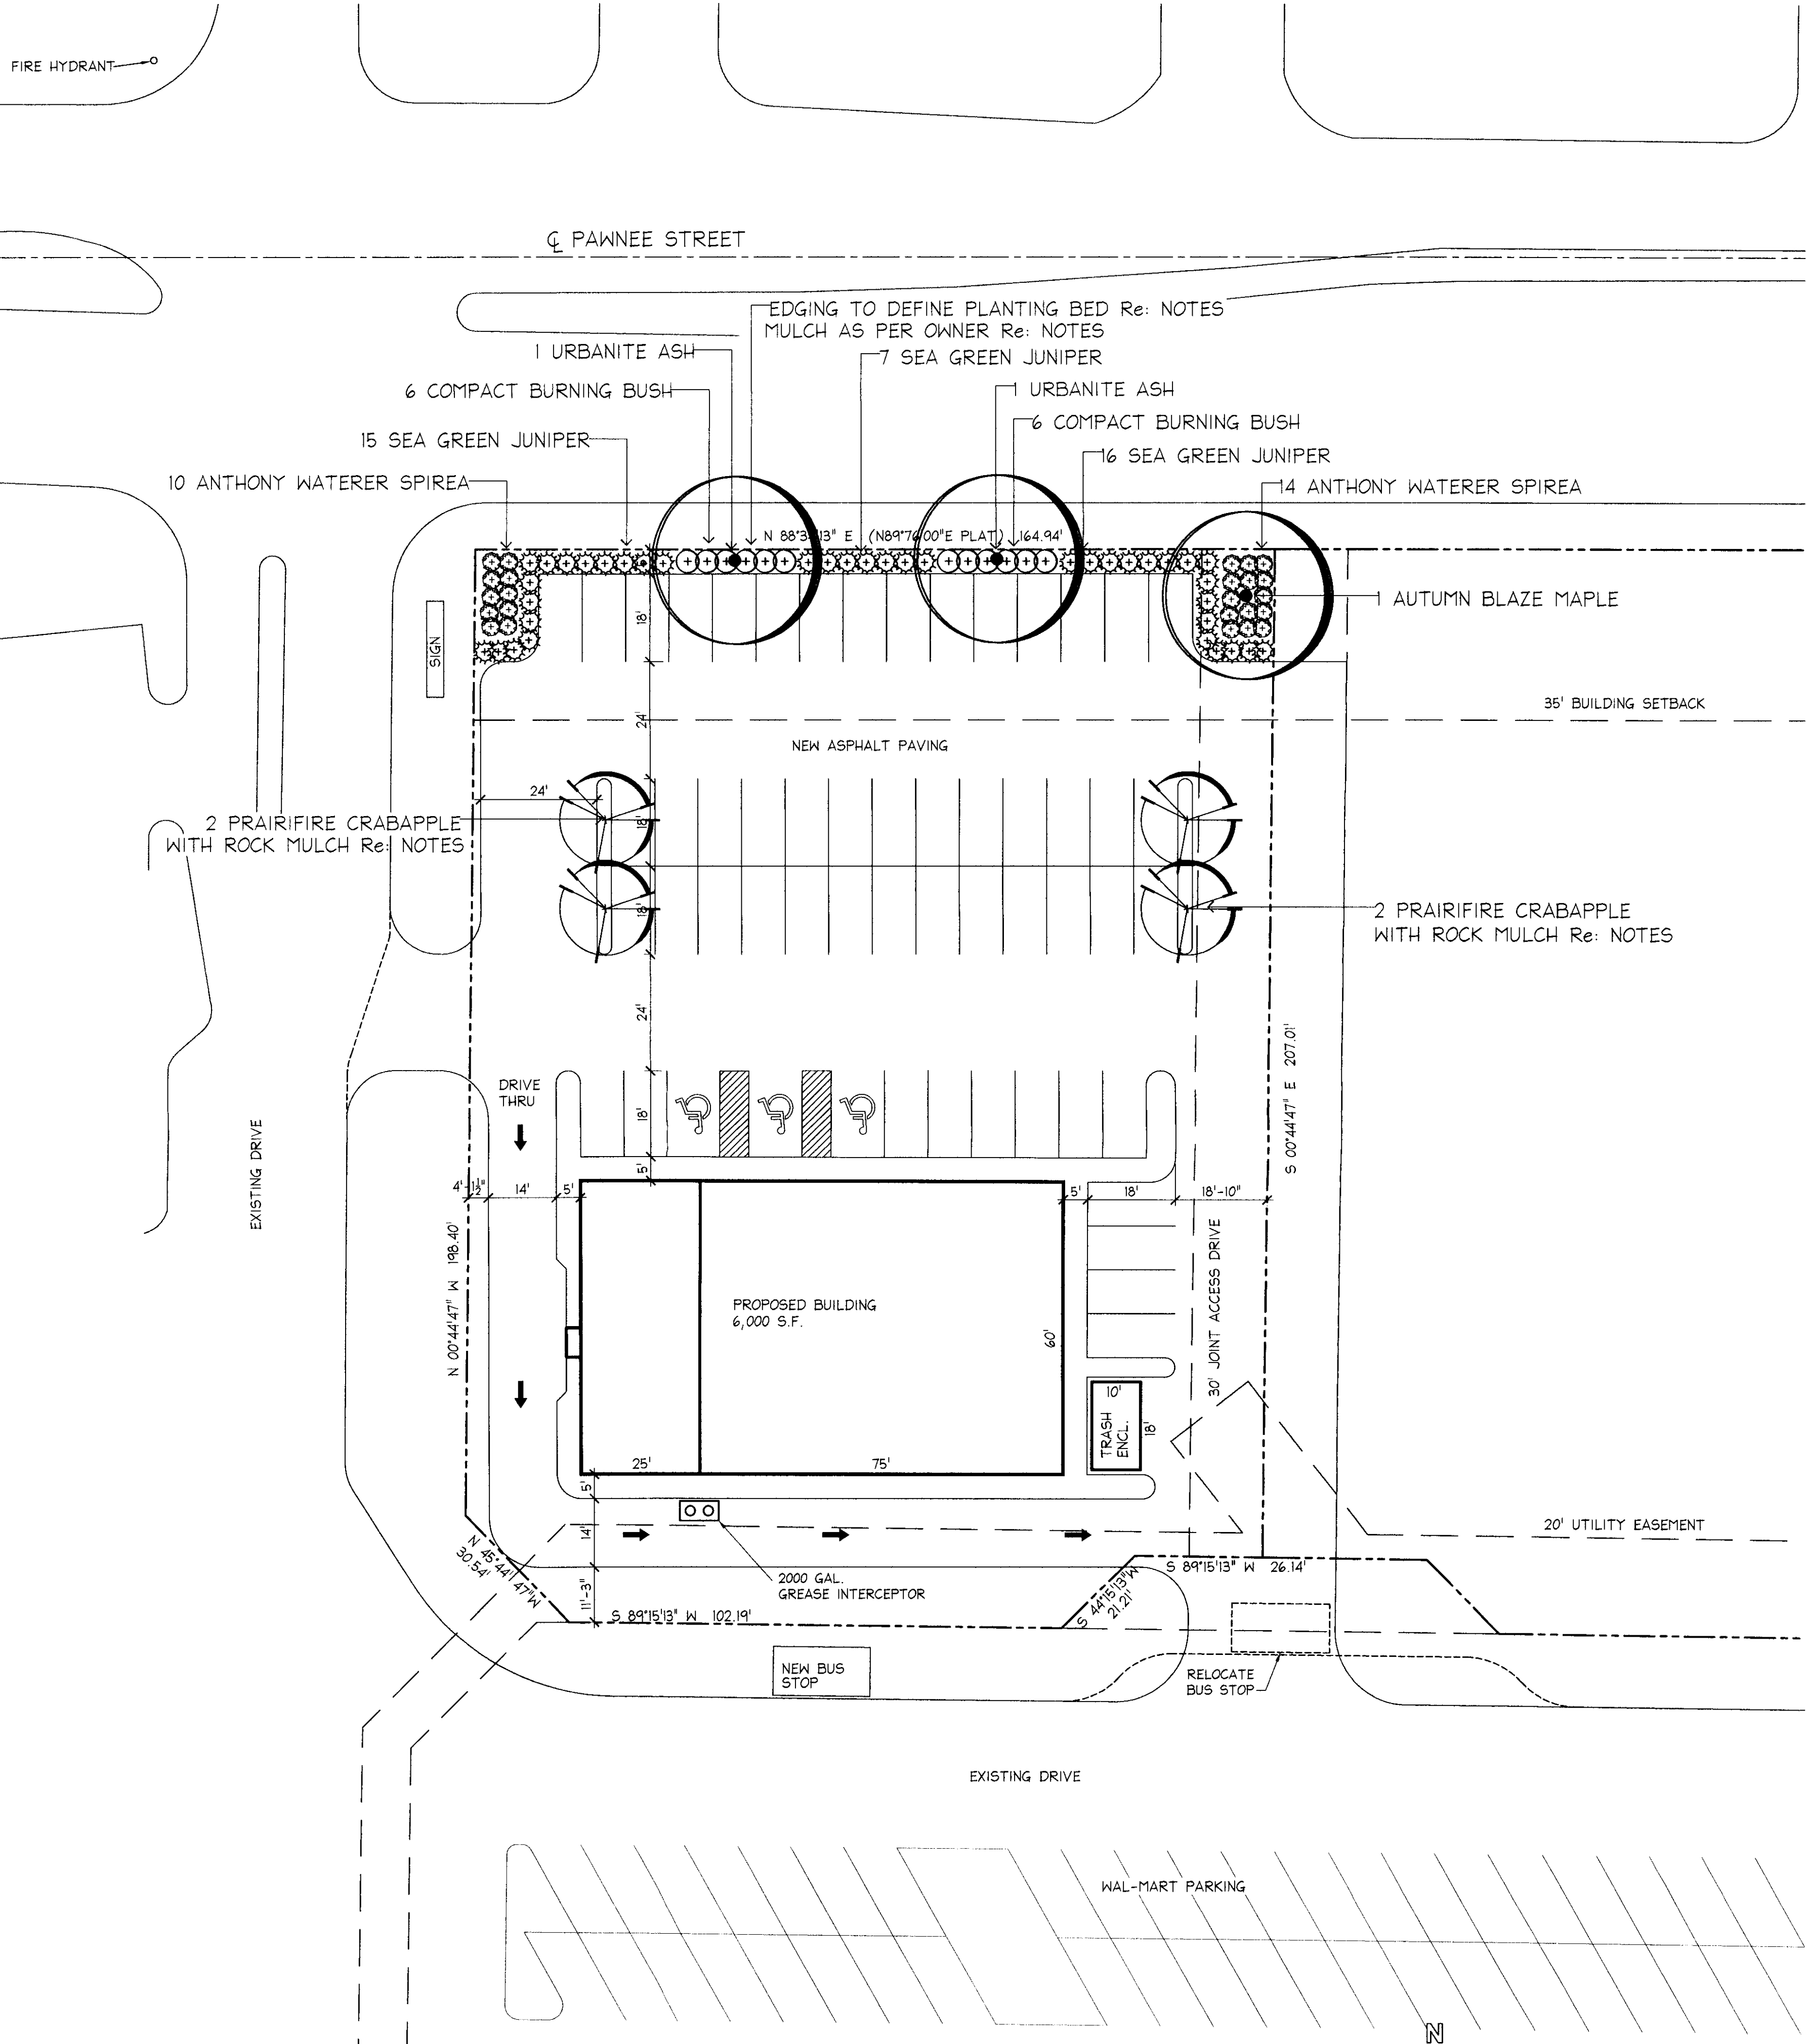

A LANDSCAPE PLAN
SCALE: 1" = 20'



Wichita-Sedgwick County Metropolitan Area Planning Department

October 28, 2015

Green Cabin LLC
156 N. Central Ave.
Wichita, KS 67202

Luminous Neon Inc. attn. Andrea Edwards
1429 W. 4th Ave.
Hutchinson, KS 67501

RE: CUP2015-40 - City Administrative Adjustment to DP-43 to reduce sign spacing on Parcel 2E from 150' to 115' in LC Limited Commercial zoning, generally located south of Pawnee and east of Broadway (2484 S. Broadway).

Dear Applicants:

We received and reviewed your request for an administrative adjustment to the above-referenced community unit plan, DP-43, the Kinkaid Community Unit Plan (CUP). We understand that you wish to reduce sign spacing for a pole sign on Parcel 2E from 150' to 115' from the existing pole sign to the south. Therefore General Provision 6 shall be adjusted to add: "Per administrative adjustment dated October 28, 2015, a pole sign on Parcel 2E may be within 115' from the next pole sign to the south."

On the basis of our review, we find that adjusting the CUP in the manner stated in the above paragraph is consistent with the approved CUP and will not have an adverse effect on the CUP or on adjacent properties, nor will it be a substantial deviation of the original plan.

Our signatures below indicate that the CUP shall be adjusted as stated in this letter. This CUP adjustment shall not be deemed to alter any other provisions of the CUP except as expressly stated herein.


The "Development Application" signs may now be removed from the property. Please submit four (4) copies of the revised CUP drawing within 60 days in order for this adjustment to be considered final.

City Hall • 10th Floor • 455 North Main • Wichita, Kansas 67202-1688

T 316.268.4421 F 316.268.4390

www.wichita.gov


Dale Miller
Director of Planning

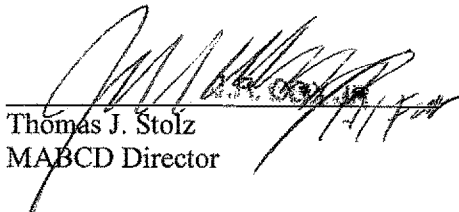
Thomas J. Stolz
MABCD Director

cc: JR Cox, MABCD
James Clendenin, CM District III
Teia Wair, Community Service Representative District III



Wichita-Sedgwick County Metropolitan Area Planning Department

August 19, 2019

M&M Property LLC
Attn: Marwan Jabara
13814 Pepper Tree Street
Wichita, KS 67228

Kaw Valley Engineering
Attn: Levi Bond
200 N. Emporia, Suite 100
Wichita, KS 67202

RE: CUP2019-32 – City Administrative Adjustment to Kincaid CUP DP-43 to Parcel 3 to allow restaurant uses.

Description: LOT 3, Block A, Kinkaid Park Addition, Wichita, Sedgwick County, KS

Dear Applicants:


We received and reviewed your request for an Administrative Adjustment to DP-43 to reflect changes to Parcel 3 to allow restaurants.

On the basis of our review, we find that adjusting the CUP in the manner stated above is consistent with the approved CUP and will not have an adverse effect on the CUP or adjacent properties, nor will it be a substantial deviation of the original plan.

Our signatures below indicate that the CUP shall be adjusted as stated in this letter and on the approved CUP document. This CUP adjustment shall not be deemed to alter any other provisions of the CUP except as expressly stated herein.

The "Development Application" sign should now be removed from the property. Please submit four (4) copies of the revised CUP drawing within 60 days in order for this adjustment to be considered final.


Dale Miller, Director
Metropolitan Area Planning Department

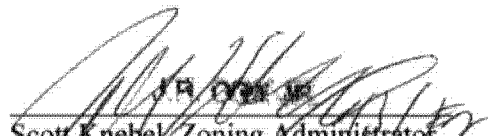
Scott Knebel, Zoning Administrator
Metropolitan Area Planning Department


cc: MABCD;
James Clendenin, CM District III
Maddy Campbell, CSR, District III

GENERAL PLANTING NOTES


- PRIOR TO BEGINNING ANY WORK ON THE SITE, THE CONTRACTOR SHALL CONTACT THE OFFICE OF THE OWNER AND THE ARCHITECT/LANDSCAPE ARCHITECT FOR SPECIFIC INSTRUCTIONS RELEVANT TO THE SEQUENCING OF WORK.
- LANDSCAPE CONTRACTOR SHALL PROVIDE ALL LABOR, MATERIALS AND SERVICE NECESSARY TO FURNISH AND INSTALL PLANTINGS AS SPECIFIED HEREIN AND AS SHOWN ON THESE PLANS.
- NO MATERIAL SUBSTITUTIONS SHALL BE MADE WITHOUT THE OWNER'S APPROVAL. ALTERNATE MATERIALS OF SIMILAR SIZE AND CHARACTER MAY BE CONSIDERED IF SPECIFIED PLANT MATERIALS CANNOT BE OBTAINED. LANDSCAPE ARCHITECT RESERVES THE RIGHT TO REVISE PLANT LIST AS DEEMED NECESSARY.
- ALL PLANT LOCATIONS ARE APPROXIMATE, ADJUST AS NECESSARY TO AVOID CONFLICTS.
- QUANTITIES OF MATERIALS SHOWN ON THE PLANTING PLAN TAKE PRECEDENCE OVER QUANTITIES SHOWN ON THE PLANT MATERIAL SCHEDULE. LANDSCAPE CONTRACTOR SHALL BE RESPONSIBLE FOR VERIFYING ALL QUANTITIES ON THE PLANTING PLAN.
- CONTRACTOR SHALL LOCATE ALL UTILITIES BEFORE WORK. LOCATE EXACT UTILITY LOCATIONS BY CONTACTING THE LOCAL UTILITY LOCATOR SERVICE. THE CONTRACTOR SHALL BE RESPONSIBLE FOR THE REPAIR OF ANY DAMAGE HE MAY CAUSE TO UTILITIES.
- GENERAL CONTRACTOR SHALL PROVIDE 4" OF TOPSOIL AT ALL SOG AND PLANTING AREAS. GRADE SHALL BE ADJUSTED FOR SOG THICKNESS. ALL FINISH GRADING SHALL BE PERFORMED BY THE LANDSCAPE CONTRACTOR.
- SOG/SEED TYPE SHALL BE LOCALLY AVAILABLE TALL FESCUE BLEND OR OTHER TURF GRASS RECOMMENDED FOR THE SPECIFIC AREA.
- BACKFILL FOR PLANT EXCAVATIONS TO BE CLEAN NATURAL SOIL, EXCAVATED FROM PLANTING PITS MIXED WITH COMPOST AND WELL-ROTTED MANURE AT A RATIO OF THREE (3) PARTS SOIL TO ONE (1) PART COMPOST AND WELL-ROTTED MANURE.
- FERTILIZE ALL PLANTS WITH 6-10-4 COMMERCIAL FERTILIZER AS DIRECTED BY INSTRUCTIONS ON FERTILIZER.
- AFTER PLANTING IS COMPLETED, REPAIR INJURIES TO ALL PLANTS AS REQUIRED. LIMIT AMOUNT OF PRUNING TO A MINIMUM NECESSARY TO REMOVE DEAD OR INJURED TWIGS AND BRANCHES. PRUNE IN SUCH A MANNER AS NOT TO CHANGE NATURAL HABIT OR SHAPE OF PLANT. MAKE CUTS FLUSH, LEAVING NO STUBS.
- INSTALL SHREDDED HARDWOOD MULCH IN ALL PLANT BEDS AND TREE SAUCERS. PLACE 3"-4" OF MULCH IN ALL PLANT BEDS AND TREE SAUCERS.
- PLANTING BEDS RECEIVING MULCH ARE TO BE FREE OF WEEDS AND GRASS. TREAT BEDS WITH A PRE-EMERGENT HERBICIDE PRIOR TO MULCH PLACEMENT. APPLY IN ACCORDANCE WITH STANDARD TRADE PRACTICE.
- THE CONTRACTOR SHALL PROVIDE ALL WATER, WATERING DEVICES AND LABOR NEEDED TO IRRIGATE PLANT MATERIALS UNTIL ACCEPTANCE OF THE PROJECT'S PLANT MATERIALS. THE CONTRACTOR SHALL SUPPLY ENOUGH WATER TO MAINTAIN THE PLANT'S HEALTHY CONDITION.
- RE-ESTABLISH TURF IN AREAS DISTURBED BY GRADING OR UTILITY TRENCHING IN THE R.O.W.
- REESTABLISH TURF IN ALL AREAS DISTURBED BY THE CONSTRUCTION PROCESS AND WITHIN THE LIMITS OF DISTURBANCE BY SEED, SOG OR PLANNED PLANTING AREAS, AS NOTED ON PLAN.
- REPORT ANY DISCREPANCIES IN THE PLANTING PLAN TO THE OWNER'S REPRESENTATIVE PRIOR TO STARTING CONSTRUCTION.

LANDSCAPE PLAN


APPROVED 6/11/20 BY NES
 DP-43

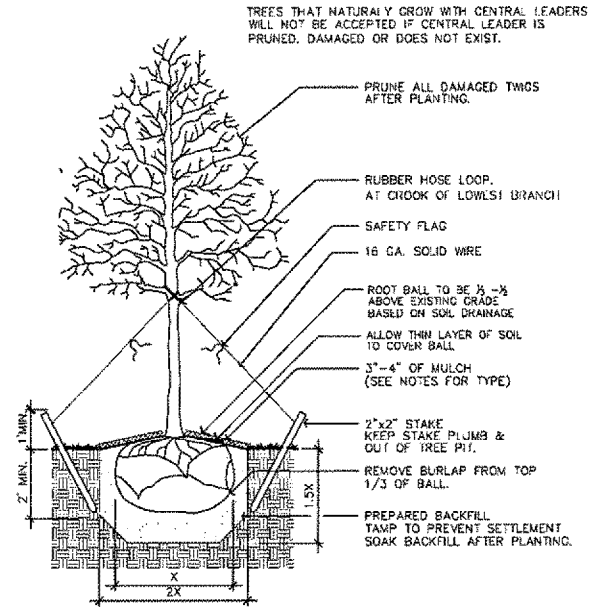

1 TREE PLANTING DETAIL
 IN TURF AREAS NO SCALE

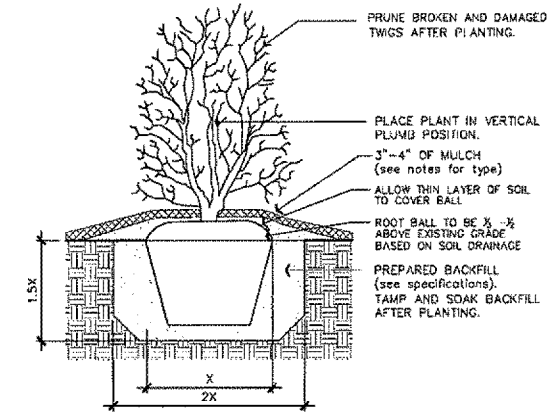

2 SHRUB PLANTING DETAIL
 NO SCALE

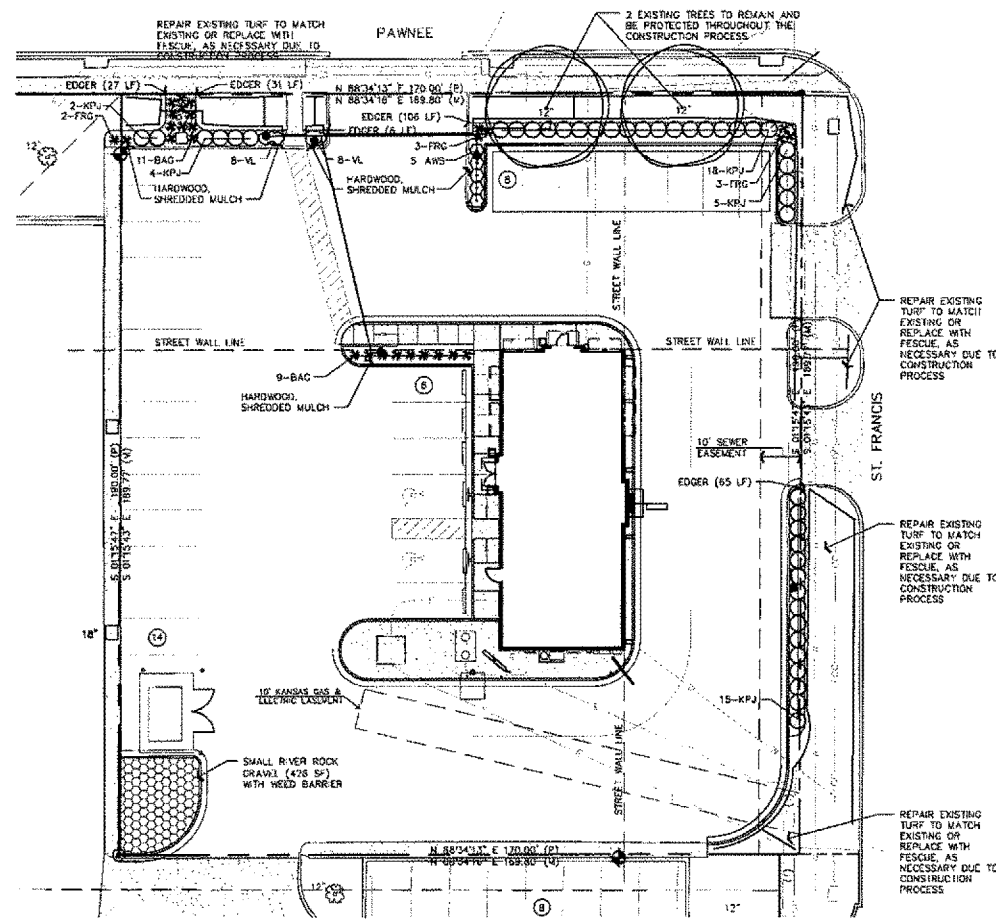

LANDSCAPE CODE CALCULATIONS


LANDSCAPED STREET YARD	PARKING LOT SCREENING AND LANDSCAPING
Landscaped Street Yard Required: 170 LF Pawnee + 190 LF St. Francis = 360 total street frontage = 63 greatest perpendicular distance 297 x 10 = 2,970 req'd landscaped area	Parking lot screening provided Parking lot trees required (One-half of the req'd. street yard trees may be used to fulfill parking lot tree requirement) One-half of 6 street yard trees = 3 28 parking stalls x 20 = 1.4 or say 2 trees required
Landscaped Street Yard Provided: 2,727 total sq. ft. provided	
Street Yard Trees Required: 2,970 ÷ 500 = 5.9 or say 6 trees required (up to 1/2 can be provided by shrubs)	Parking lot trees provided: 2 parking lot trees provided (up to 1/2 can be provided by shrubs)
Shade Trees Provided: 2 existing shade trees + 20 shrubs = 6 Shade trees provided	

PLANTING LEGEND


SOG/SEED	[Symbol]
SIDEWALK	[Symbol]

PLANT SCHEDULE

KEY	QTY.	COMMON NAME	BOTANICAL NAME	SIZE	COND.	REMARKS
		SHADE TREES				
		ORNAMENTAL TREES				
		EVERGREEN SHRUBS				
KPJ	44	KALLAY PFITZER JUNIPER	JUNIPERUS CHINENSIS PFITZERIANA	3 GAL.	CONT.	OR SIMILAR GROWTH HABIT
		DECIDUOUS SHRUBS				
AWS	5	ANTHONY WATERER SPIREA	SPIRAEA JAPONICA 'ANTHONY WATERER'	3 GAL.	CONT.	
		ORNAMENTAL/NATIVE GRASSES				
RAG	20	BLONDE AMBITION GRAMA GRASS	ROUPELOVA GRACILIS 'BLONDE AMBITION'	1-3 GAL.	CONT.	
FRG	8	FEATHER REED GRASS	CALAMAGROSITS X ACUTIFOLIA 'KARL FOERSTER'	1-3 GAL.	CONT.	
		PERENNIALS & GROUNDCOVERS				
VL	16	VARIEGATED LIRIOPE	LIRIOPE MUSCARI 'VARIEGATA'	5" - 1 GAL.	CONT.	

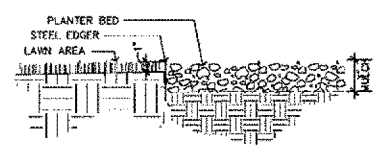

3 EDGER DETAIL
 NO SCALE

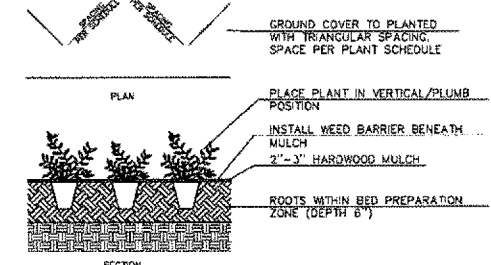

4 GROUND COVER DETAIL
 NO SCALE

FOR CONSTRUCTION

REVISIONS		
ITEM	DATE	NO.

PRINTS ISSUED		
DATE	PURPOSE	NO.
8-27-18	FOR REVIEW	
5/20/20	CITY REVIEW	

Church's Chicken
 Corporate Development
 900 Hammond Drive, #1100
 Atlanta, Georgia 30328
 (478) 388-3871

KARAM DESIGN
 8 RAMBLER RD.
 HUTCHINSON, KS 67502
 (781) 442-1111
 karam@karamdesign.com

CHURCH'S CHICKEN
 588 E. PAWNEE ST.
 WICHITA, KS 67201

DRAWN	CHECKED
TAF	

PROJECT NUMBER: 01955

PLANTING PLAN

SHEET TITLE
 SHEET NUMBER

L1

OF _____ SHEETS