


SANITARY SEWER MAIN PLANS
MONARCH LANDING
WICHITA, KS

LINE 1
SHEET TITLE
468-84206
PROJECT NUMBER


DESIGN BY *DFL*
DRAWN BY *DFL*
CHECKED BY *BW*

ISSUED
March 2007
REVISED

SHEET NO.
6 of 13

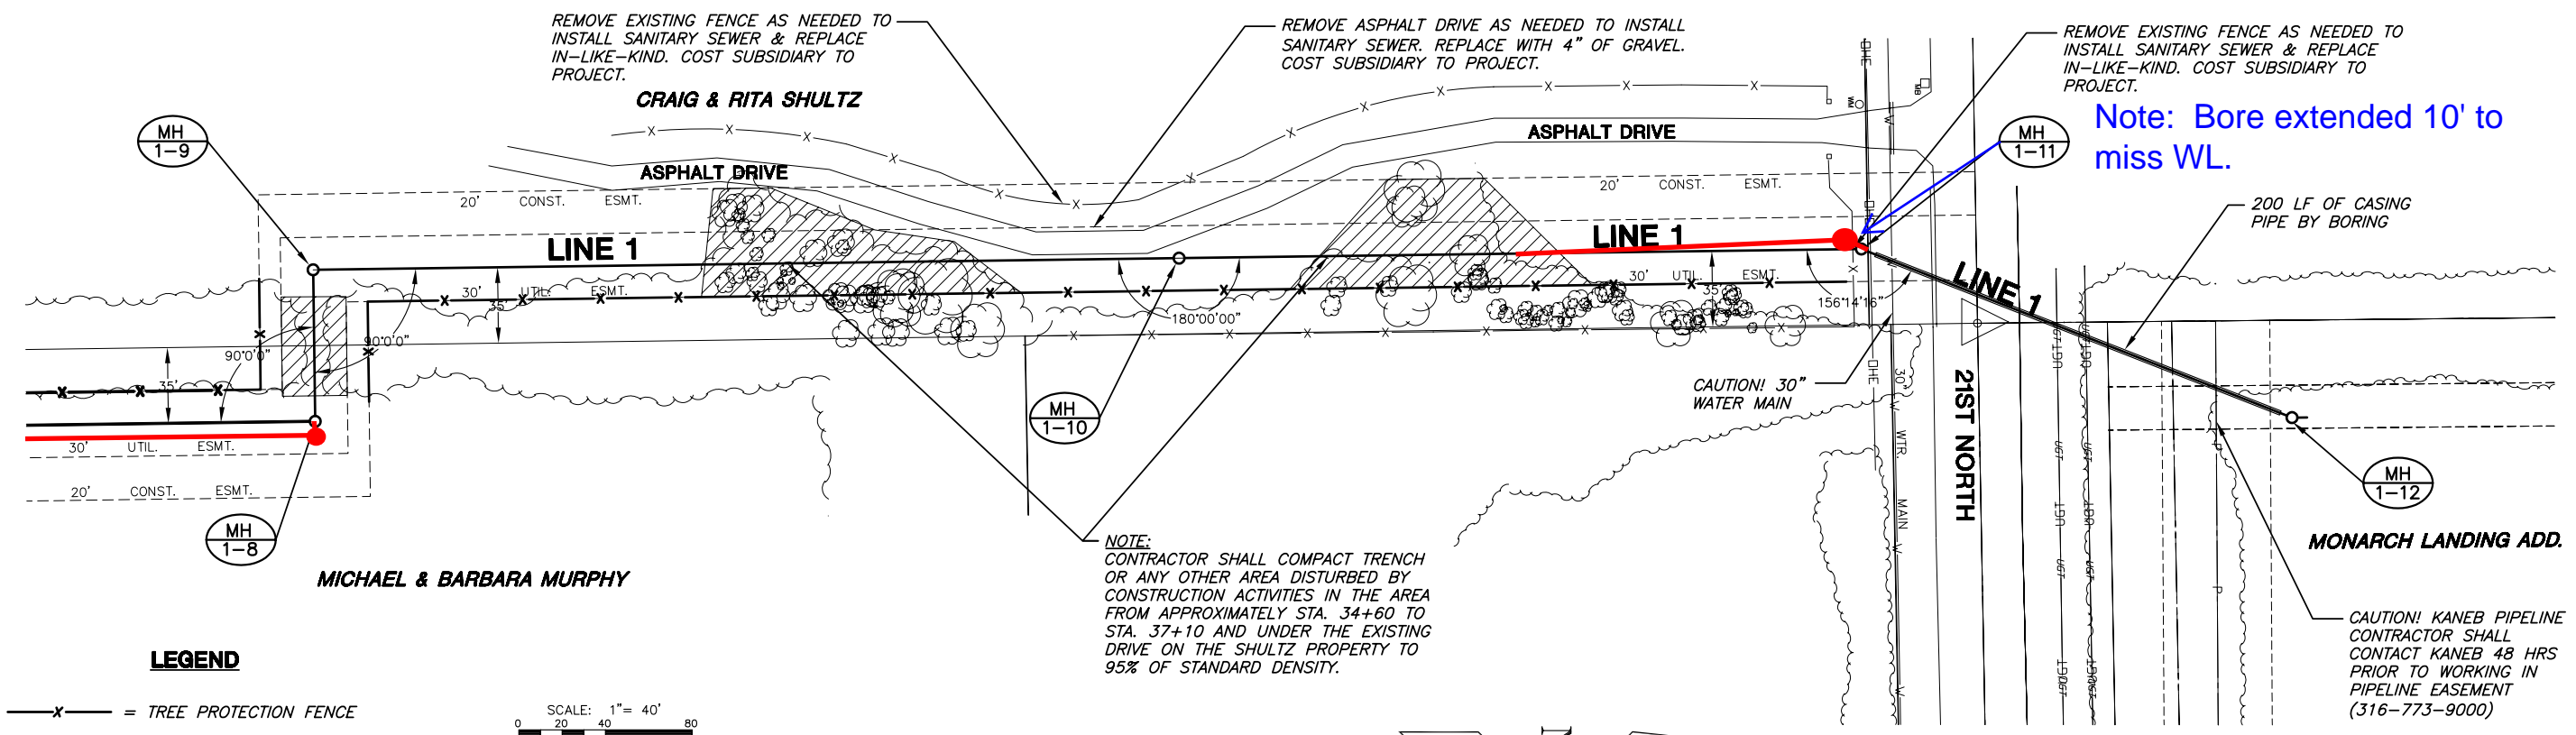

PLAN LINE 1

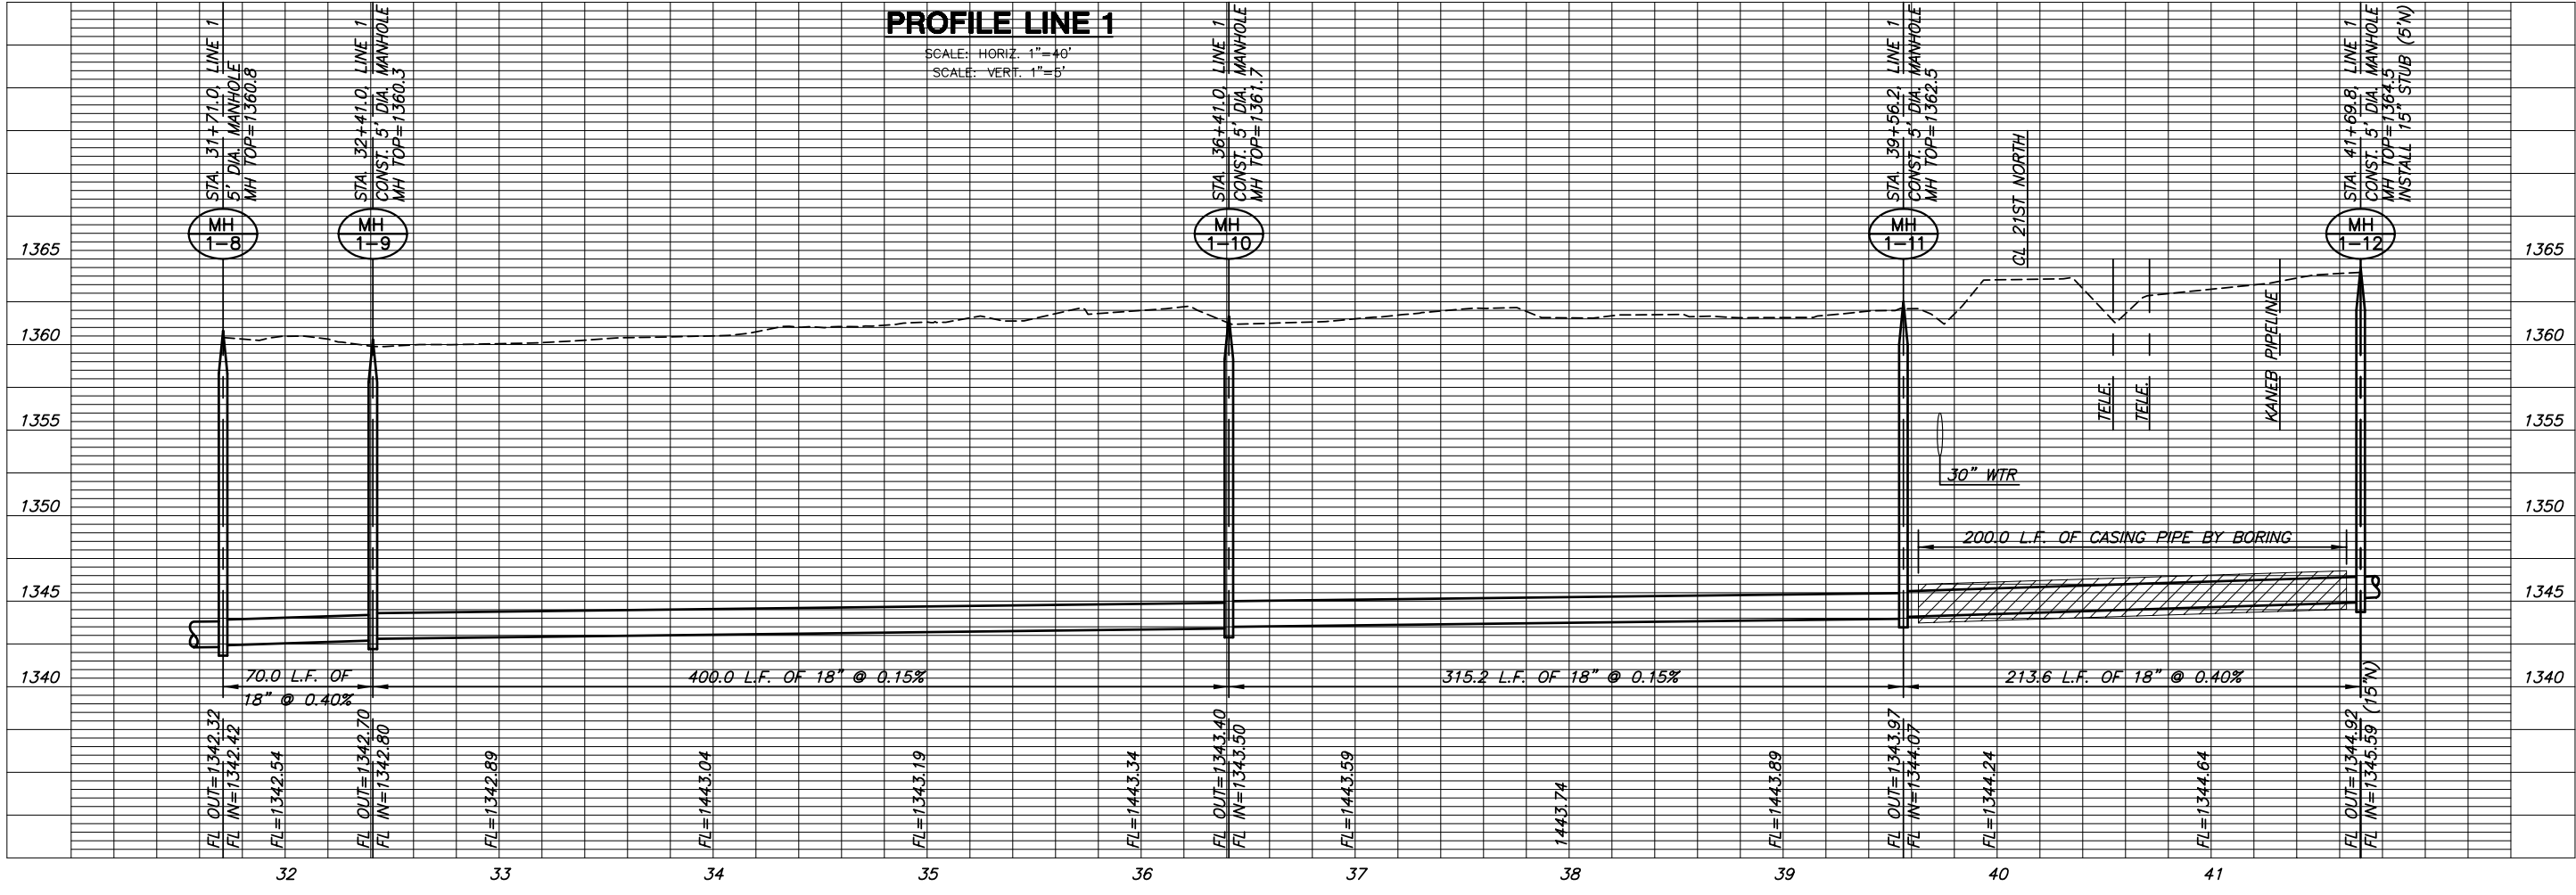

PLOTTED: Friday, March 02, 2007 9:05:28AM

J:\CIVIL\06201\SS MAIN.DWG\SAN\6201_B3.DWG