

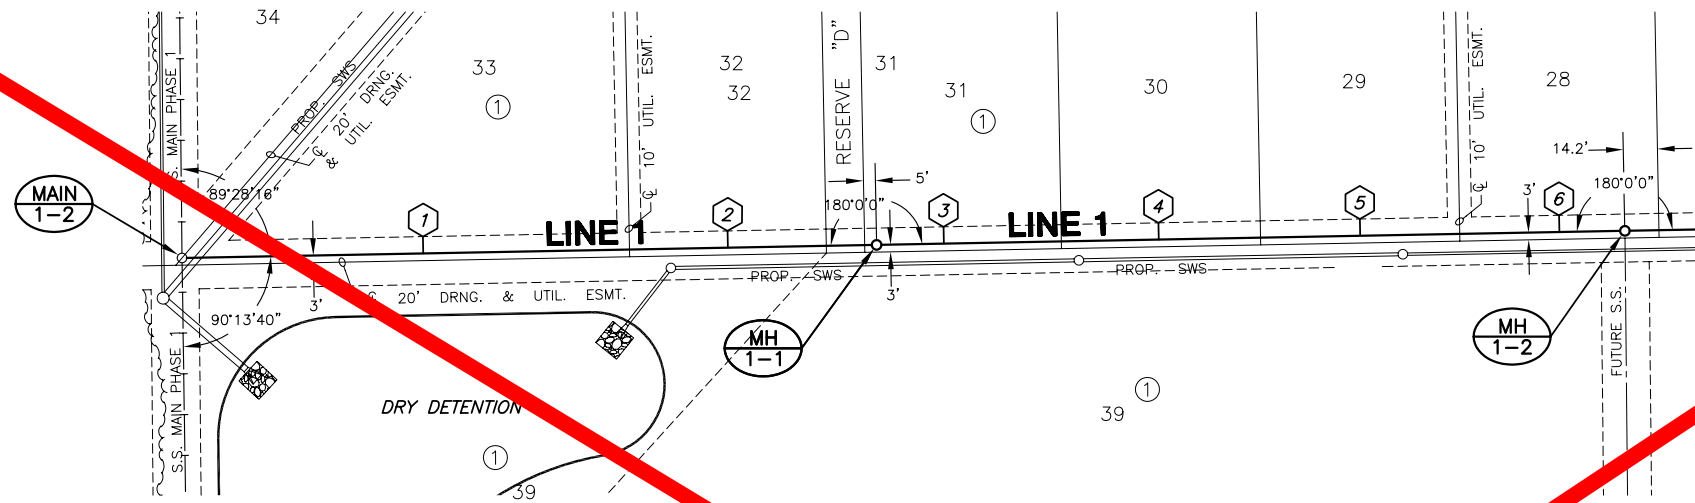


# SEE REVISED SHEET

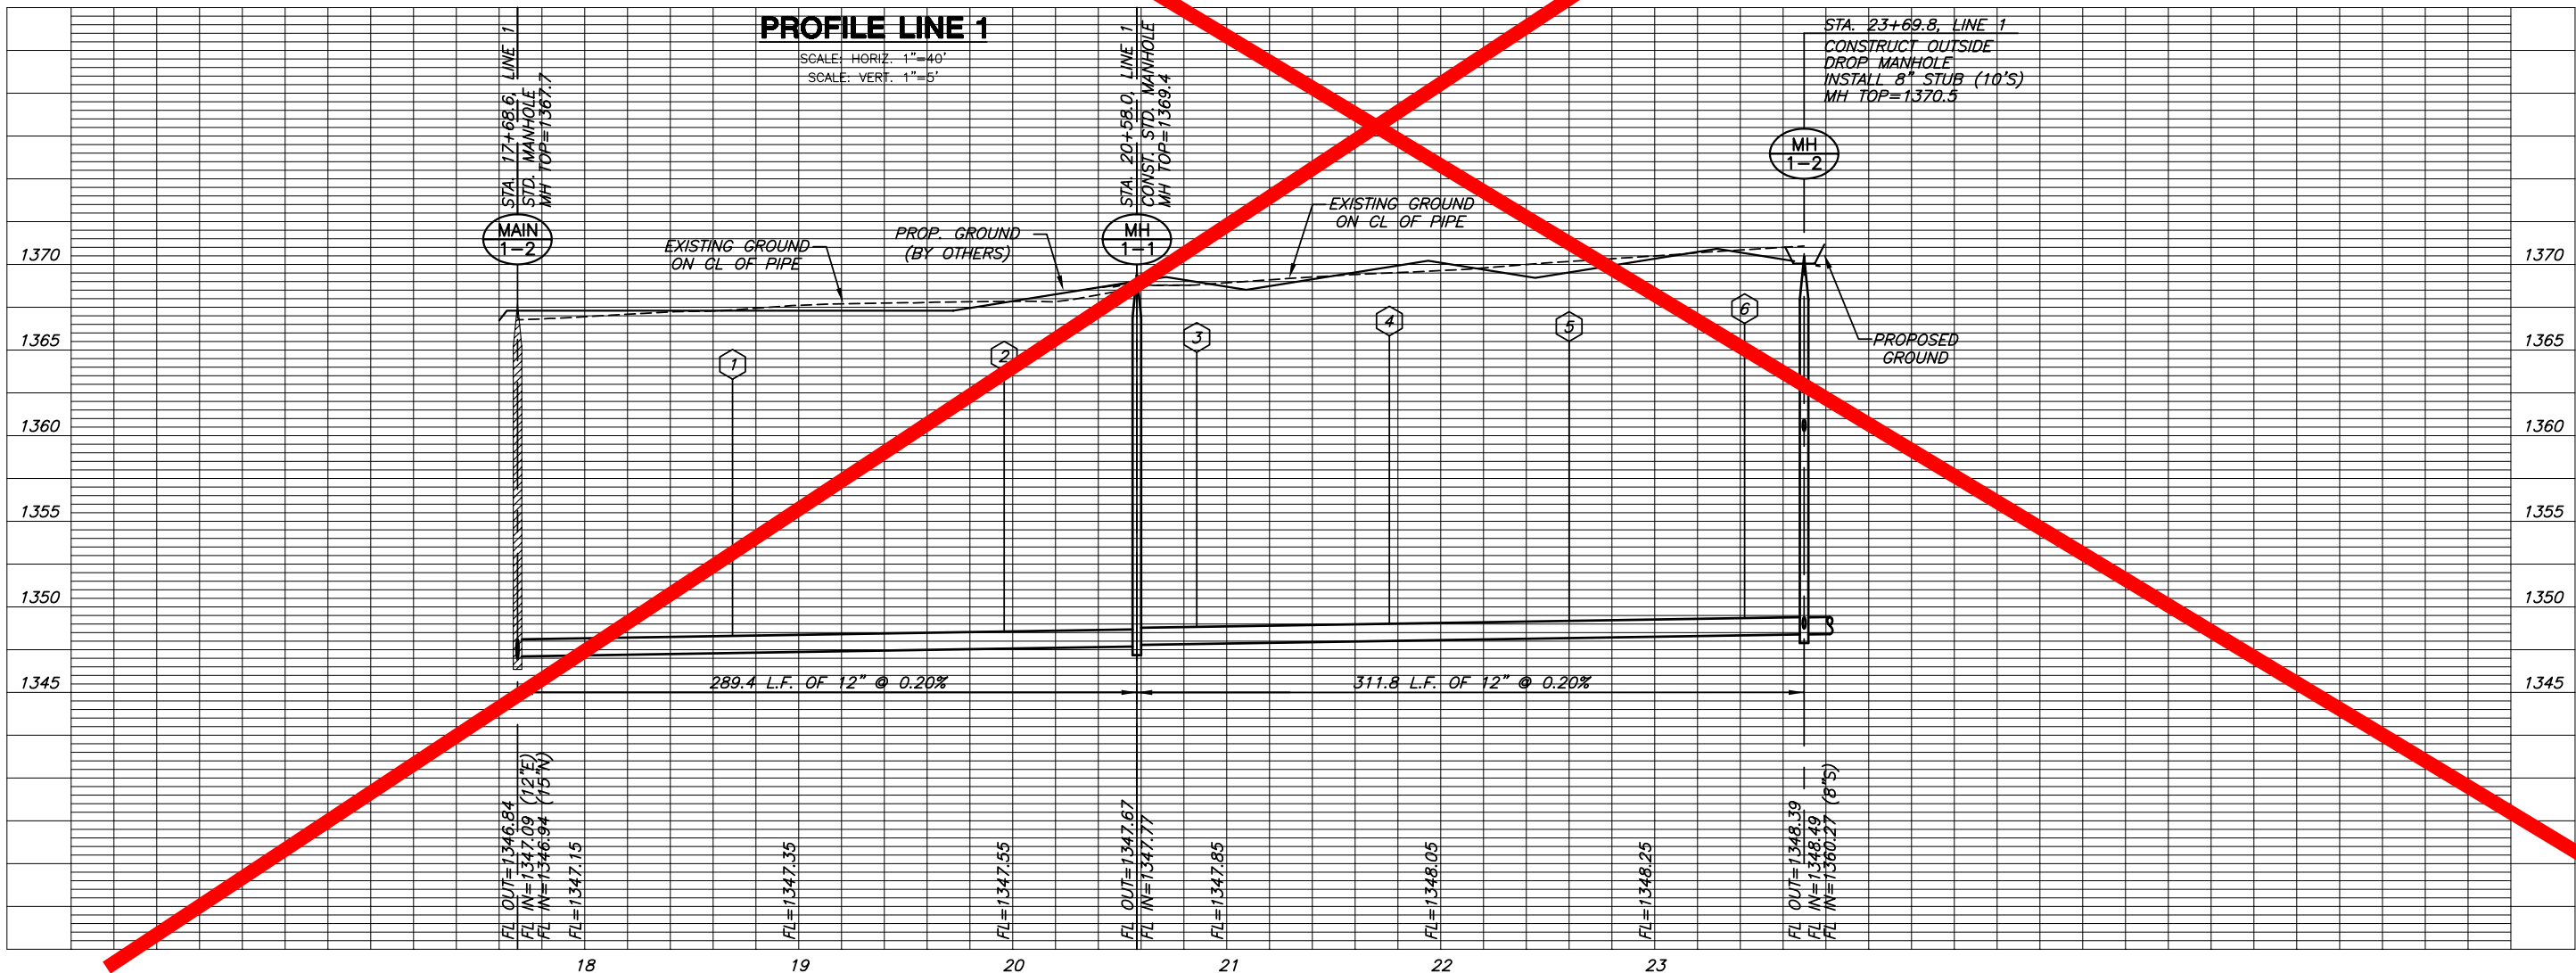

**PLAN LINE 1**

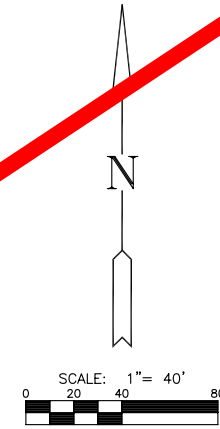

**PROFILE LINE 1**

SCALE: HORIZ. 1"=40'  
SCALE: VERT. 1"=5'

**SANITARY SEWER PLANS FOR  
MONARCH LANDING ADDITION  
PHASE 1**

**LINE 1**  
SHEET TITLE  
PROJECT NUMBER  
**468-84317**

DESIGN BY: **DFL**  
DRAWN BY: **DMU**  
CHECKED BY: **GJA**

ISSUED: **January 2007**

REVISED:

SHEET NO.  
**4 of 20**