

SEE REVISED SHEET


**SANITARY SEWER PLANS FOR
MONARCH LANDING ADDITION
PHASE 1**

LINES 4 - 6
SHEET TITLE
468-84317
PROJECT NUMBER


DESIGN BY: DFL
DRAWN BY: DMU
CHECKED BY: GJA

ISSUED: January 2007
REVISED:


SHEET NO.
10 of 20

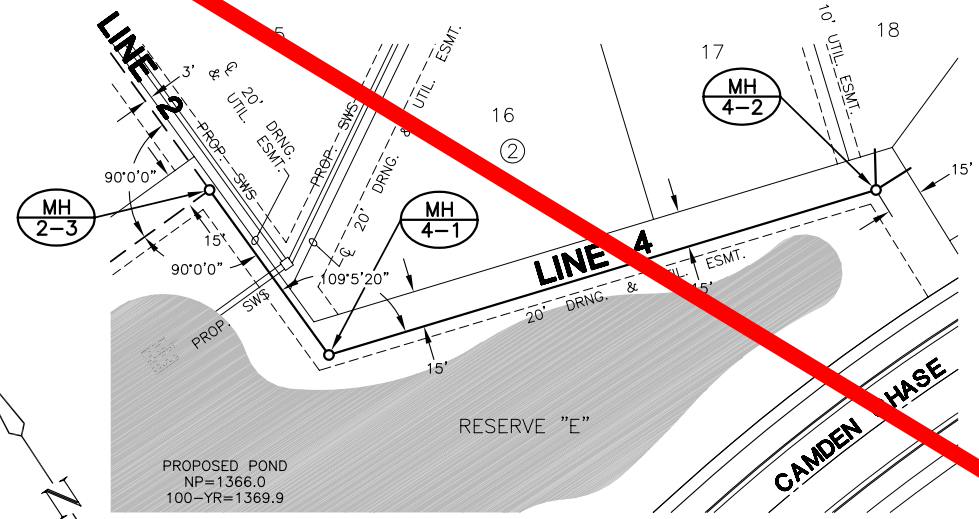

PLAN LINE 4

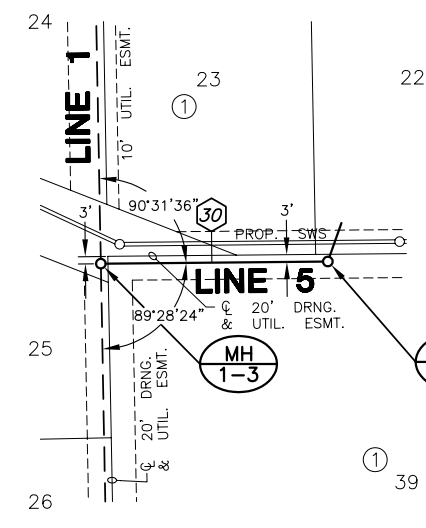


PLAN LINE 5

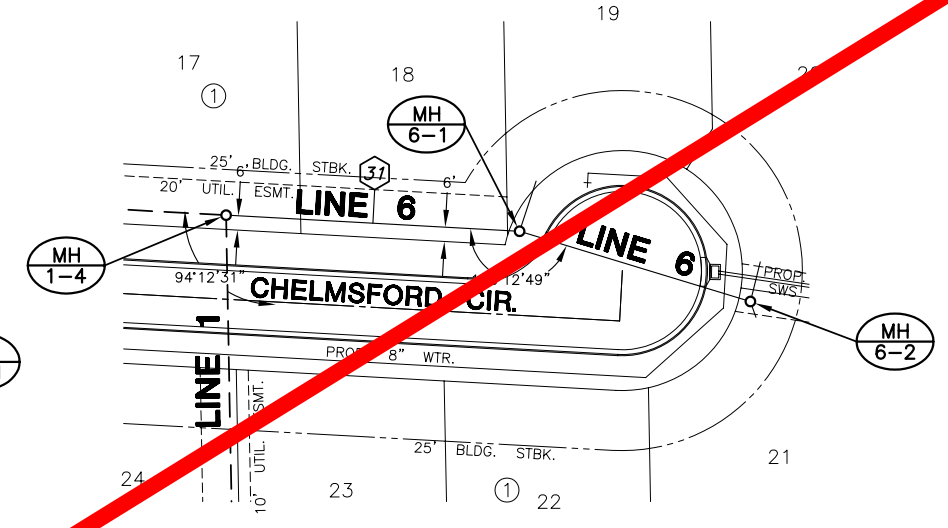


PLAN LINE 6


NOTE:
TRENCHES TO BE BACKFILLED WITH SAND AND FLUSHED WHEN SEWER RUNS ALONG FRONT OF LOTS.
(LINE 6, STA. 10+00.0 TO 11+22.4)

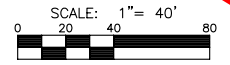

PROFILE LINE 4

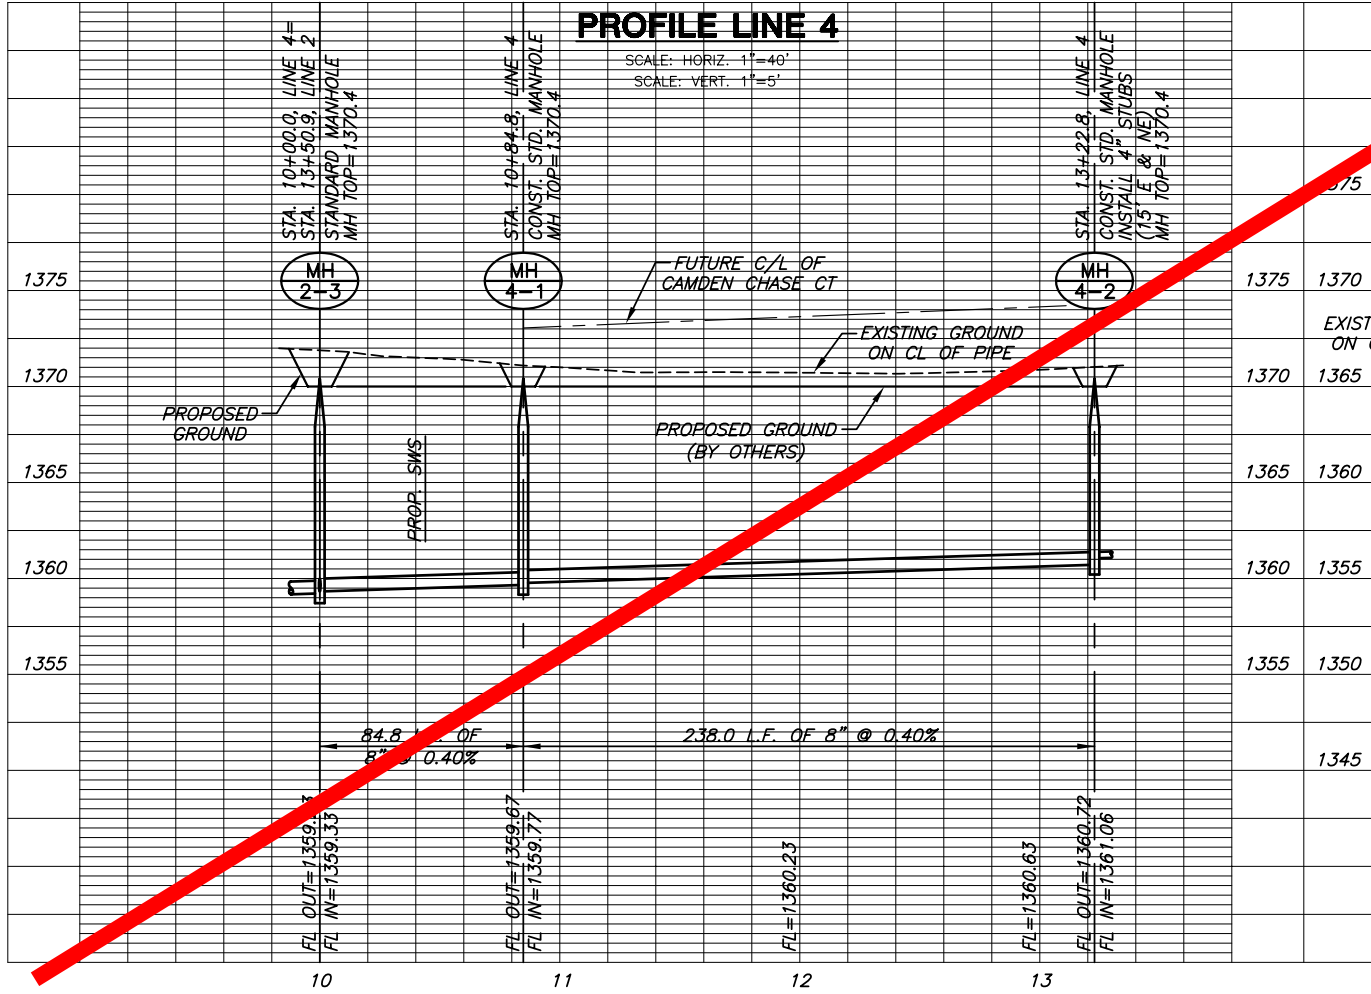

PROFILE LINE 5

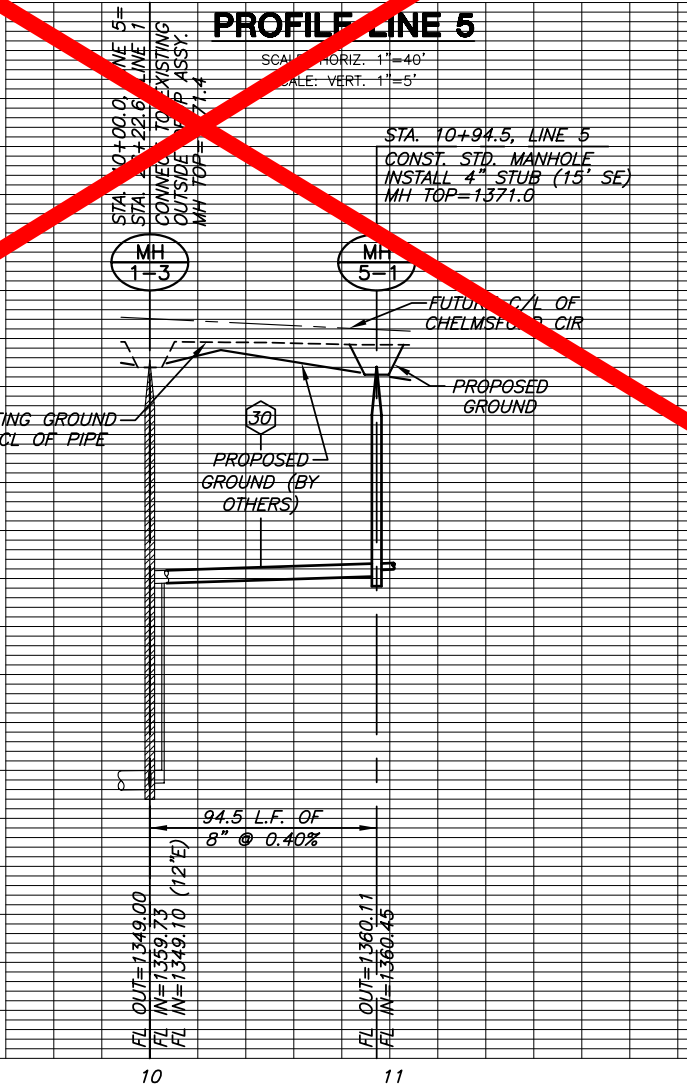

PROFILE LINE 6

