

# PRIVATE SANITARY SEWER EXTENSION

TO SERVE


## ETHANOL PRODUCT CORP HEADQUARTERS

PRIVATE PROJECT NO. 1749 PPS (607861)

## CITY OF WICHITA, KANSAS

JAMES L. ARMOUR, P.E. - CITY ENGINEER

McCullough Excavation, Inc. - Contractor  
 Jones, KE Miller - Inspector  
 Released 9/27/07  
 As-Built  
 .pdf by JDL 9/27/07

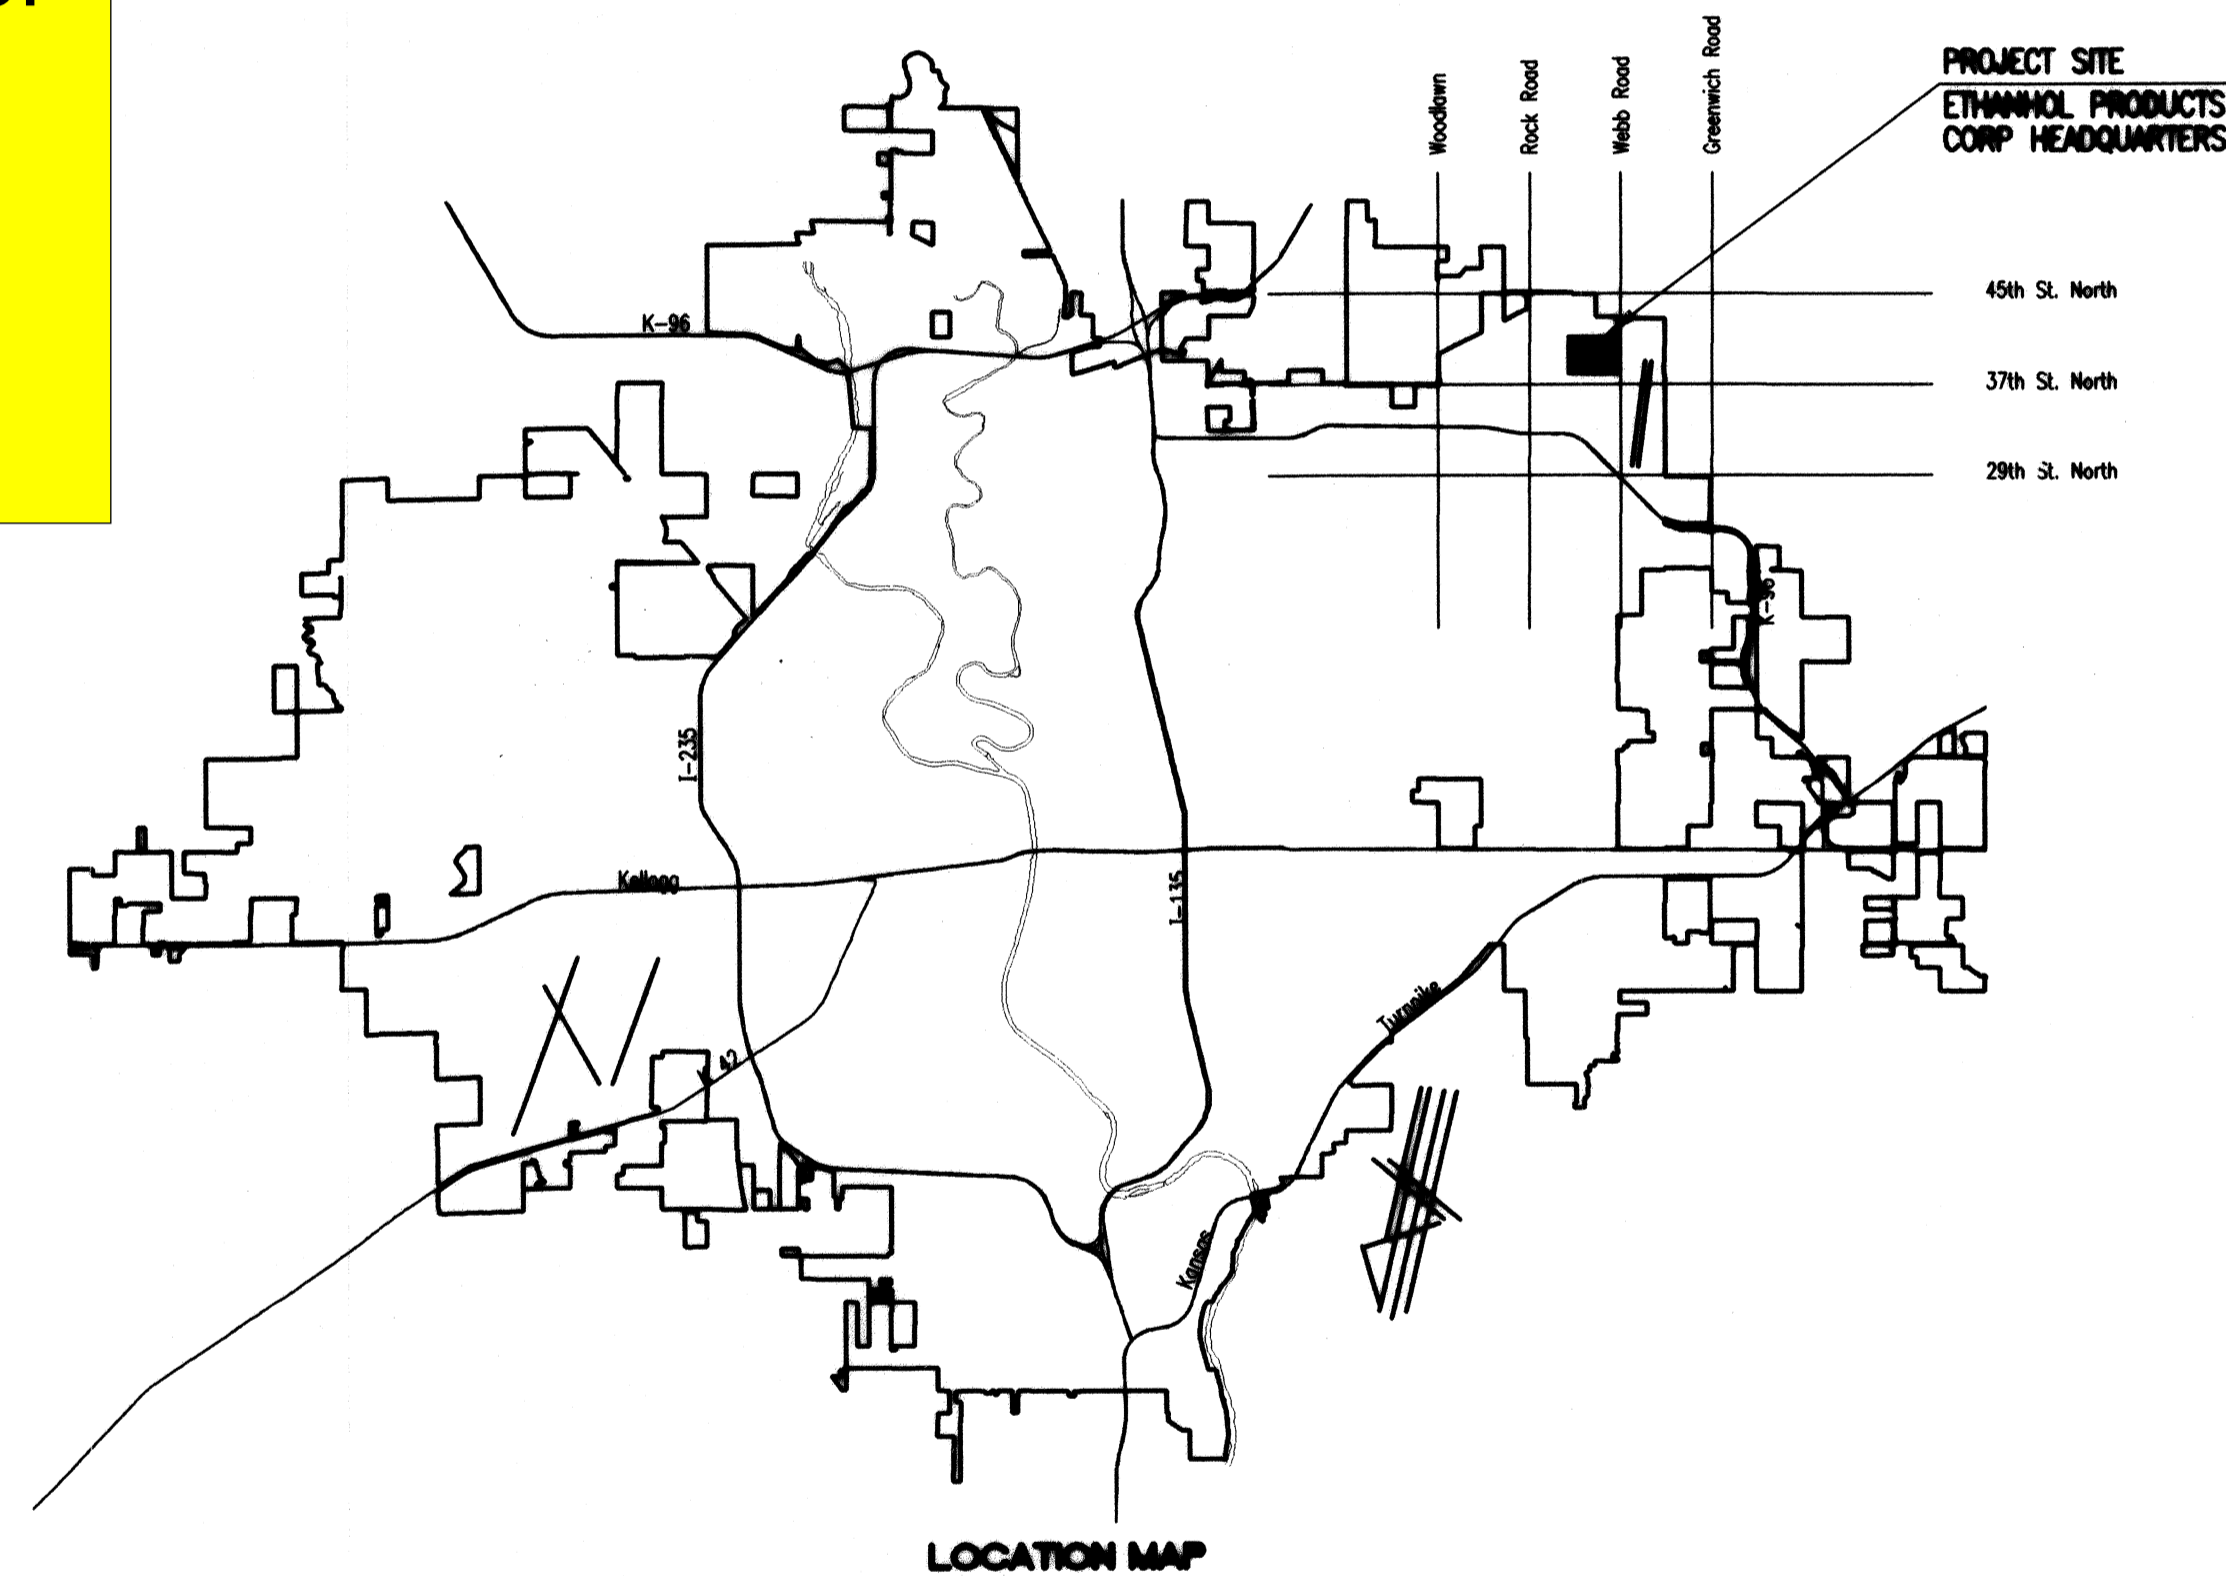

**INDEX OF SHEETS**

SHEET NO. C3.1	TITLE SHEET
SHEET NO. C3.2	KEY MAP AND GENERAL NOTES
SHEET NO. C3.3	PLAN/PROFILE
SHEET NO. C5.2-5.4	SOIL EROSION BMP DETAILS
SHEET NO. C6.1	PLAT
SHEET NO. C6.2	TYPE "F" MANHOLE DETAILS
SHEET NO. C6.3	FRAME & COVER DETAILS

APPROVED AS NOTED  
 By CITY ENGINEER OF WICHITA

Sanitary Sewers VRH 3/8/07

Storm Sewers \_\_\_\_\_

Driveway Approaches \_\_\_\_\_

Paving \_\_\_\_\_



**NOTE TO CONTRACTOR**

INSPECTION AND TESTING FOR THIS PROJECT IS TO BE PROVIDED BY A LICENSED CONSULTING ENGINEERING FIRM CONTRACTED BY THE OWNER/DEVELOPER. SAID INSPECTION TO BE IN ACCORDANCE WITH THE CITY OF WICHITA STANDARD CONSTRUCTION ENGINEERING PRACTICES AND CERTIFIED BY A LICENSED PROFESSIONAL ENGINEER. NO WORK SHALL BE PERFORMED IN DEDICATED EASEMENTS OR PUBLIC RIGHT-OF-WAY BY THE CONTRACTOR UNTIL SUCH INSPECTION IS ARRANGED FOR AND REQUIRED BONDS HAVE BEEN SUBMITTED TO AND APPROVED BY THE CITY. NOR SHALL ANY WORK BE COMMENCED IN DEDICATED EASEMENTS OR PUBLIC RIGHT-OF-WAY WITHOUT WRITTEN AUTHORIZATION BY THE CITY ENGINEER. IMPROVEMENTS PERFORMED UNDER THIS PROJECT SHALL NOT BE ACCEPTED BY THE CITY UNTIL ALL APPLICABLE DOCUMENTATION HAS BEEN SUBMITTED TO THE CITY ENGINEER. THIS MAY INCLUDE: RECORD DRAWINGS, INSPECTION LOGS, TEST DOCUMENTATION, TV TAPES, AND A CERTIFICATE OF COMPLETION. THE ABOVE SHALL BE PERFORMED BY THE CONSULTING FIRM CONTRACTED TO INSPECT THIS PROJECT.

**AS-BUILT**  
 9/7/07  
 Date  
*[Signature]*  
 Signer

**MARCH 2007**

PLANS PREPARED BY  
**PROFESSIONAL ENGINEERING CONSULTANTS, P.A.**  
 ENGINEERS  
 WICHITA, KANSAS

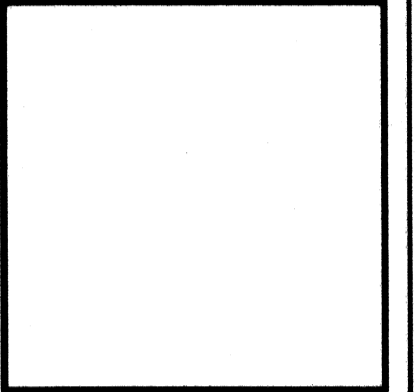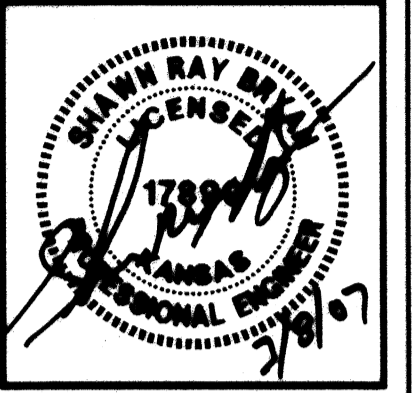

**Ethanol Products  
 Corporate Headquarters**  
 38th and Webb Road  
 Wichita, Kansas

prints issued  
 3-9-07  
 For Construction

project no.  
 26122

drawn by: AU check by: [Signature]

PRIVATE  
 SANITARY SEWER  
 TITLE SHEET  
**C3.1**  
 of