


**SANITARY SEWER PLANS FOR
WATERFRONT FOURTH ADDITION**

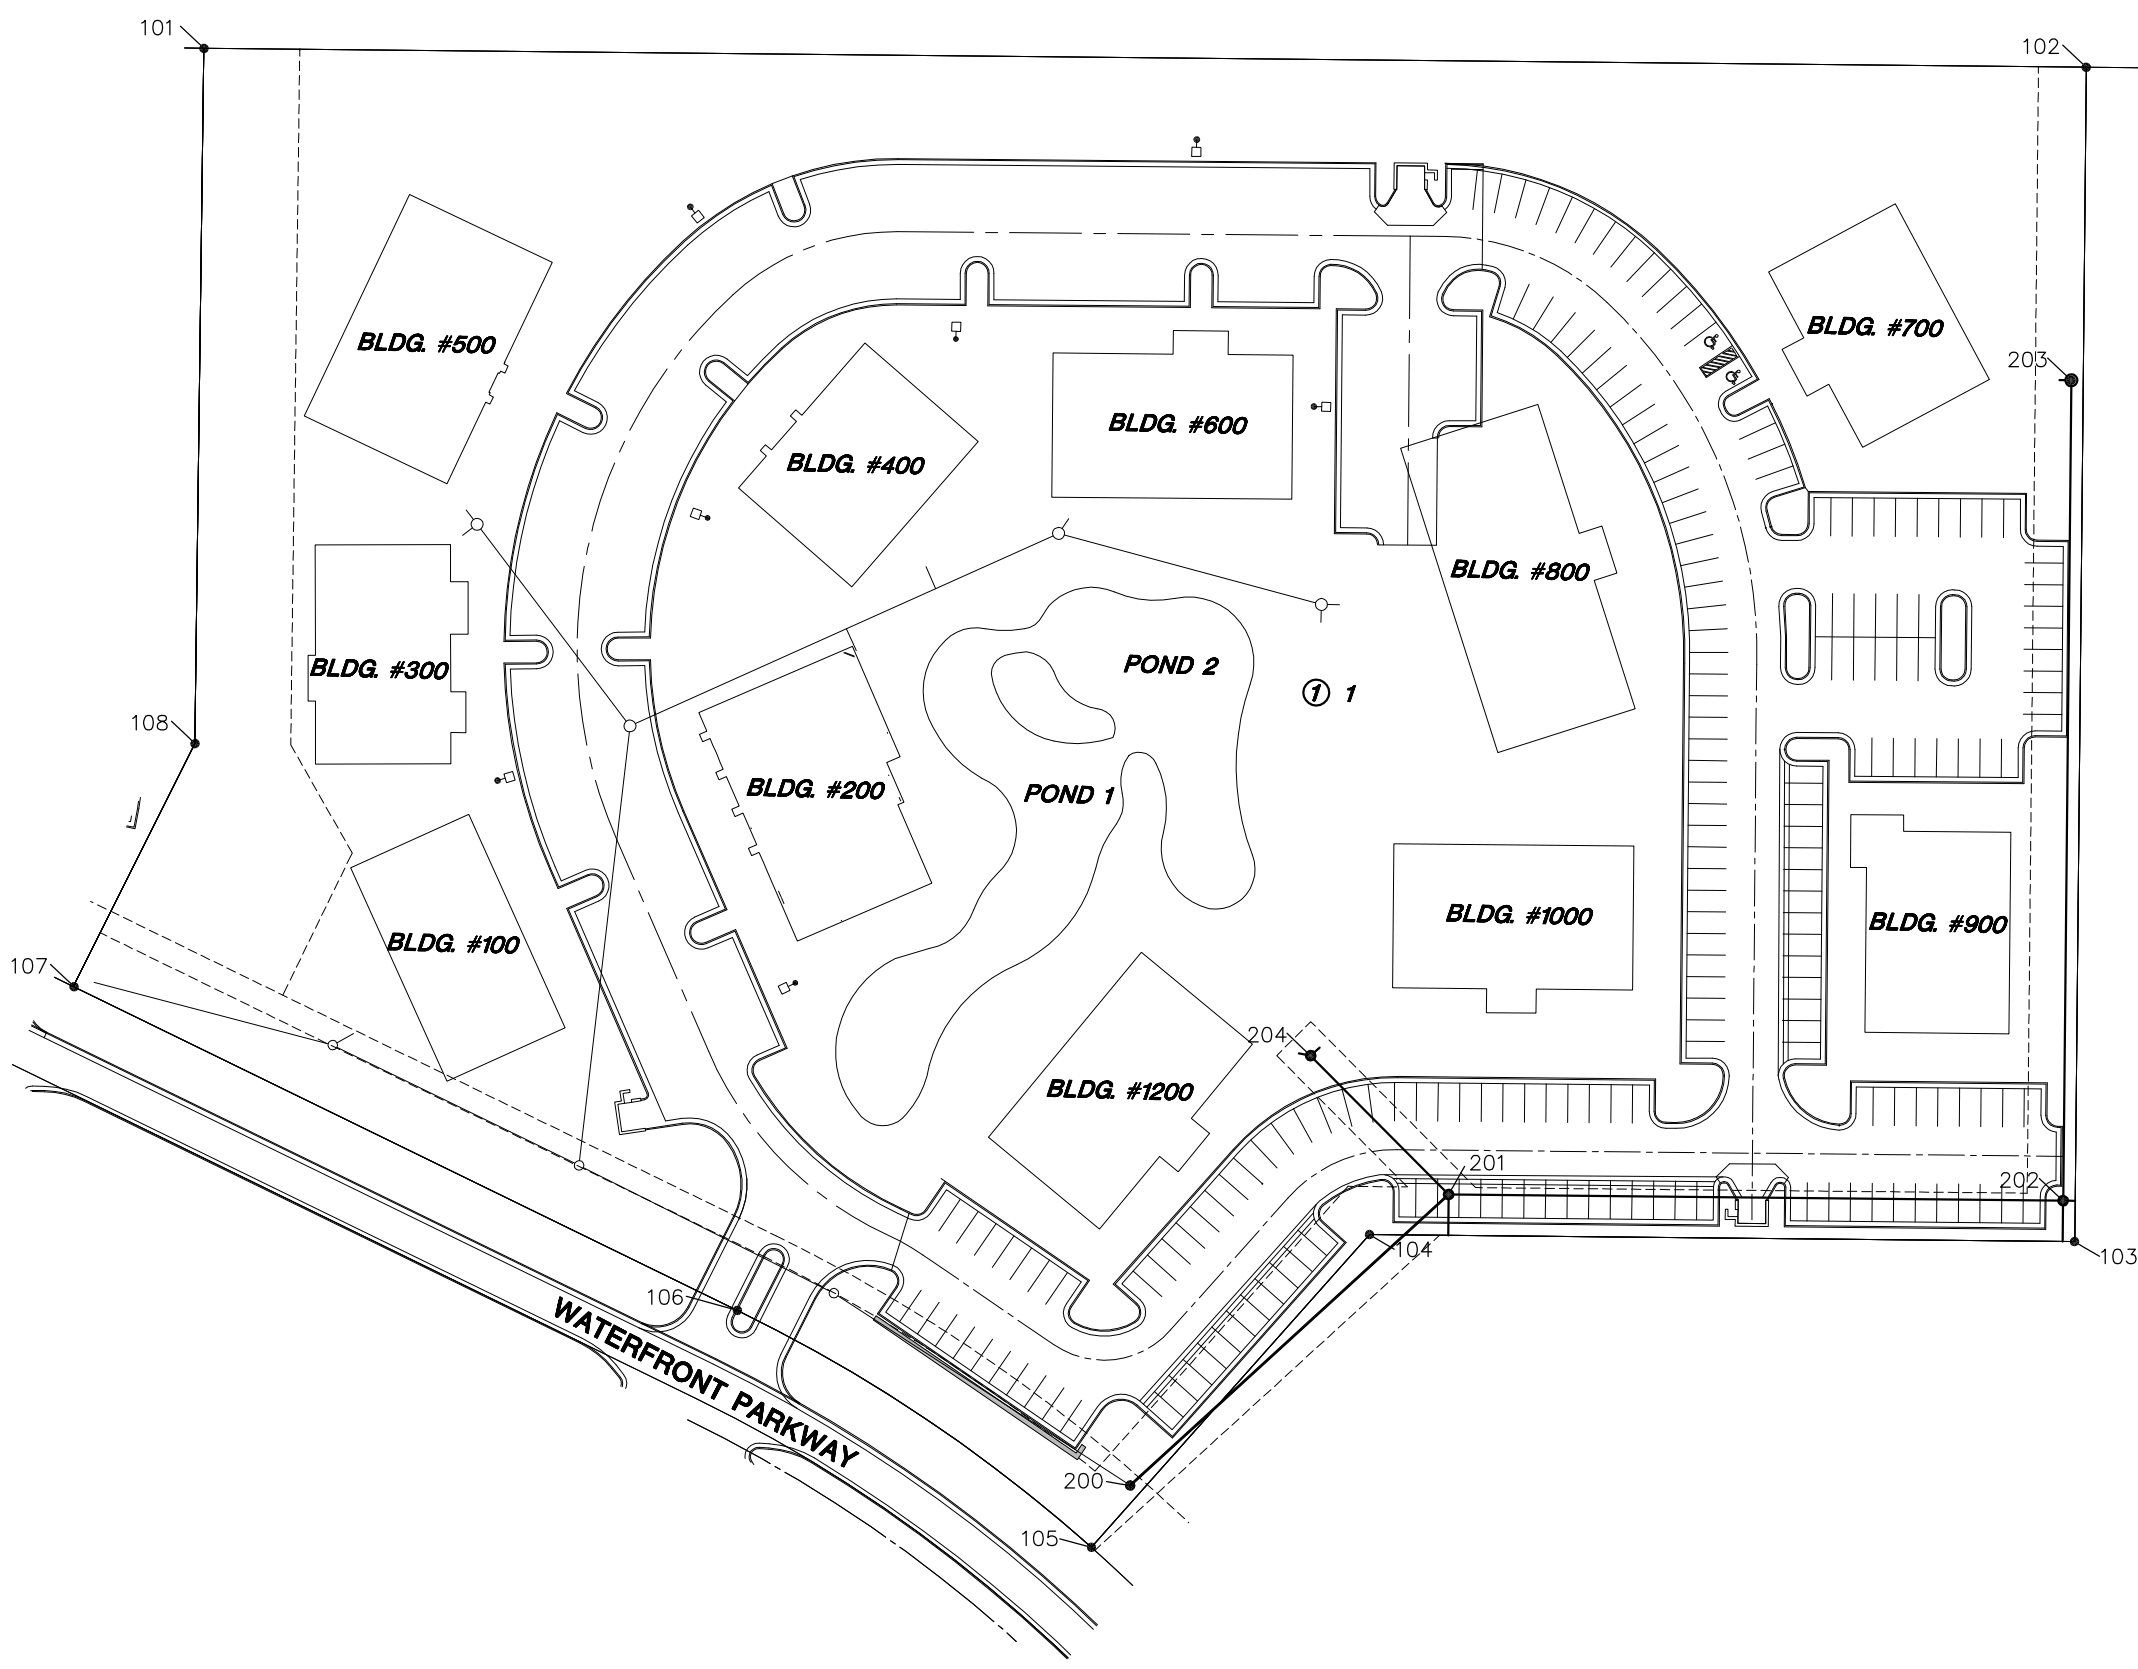

SANITARY SEWER LINE POINTS AS-BUILT LOCATIONS			
POINT NO.	NORTHING	EASTING	DESCRIPTION
200	1696370.19	1682294.07	MANHOLE

SANITARY SEWER LINE POINTS			
POINT NO.	NORTHING	EASTING	DESCRIPTION
201	1696495.42	1682423.45	MANHOLE
202	1696500.18	1682679.37	MANHOLE
203	1696841.96	1682673.02	MANHOLE
204	1696551.62	1682364.33	MANHOLE

PLAT IRONS			
POINT NO.	NORTHING	EASTING	DESCRIPTION
101	1696957.96	1681891.46	PI
102	1696972.54	1682675.59	PI
103	1696483.28	1682684.69	PI
104	1696477.81	1682390.96	PI
105	1696344.27	1682278.92	PI
106	1696438.39	1682129.37	PI
107	1696565.70	1681848.34	PI
108	1696668.31	1681895.97	PI

BUBBLE MAP

SHEET TITLE
04026
PROJECT NUMBER

DESIGN BY: SRS
DRAWN BY: SKF
CHECKED BY: DFL

ISSUED: AUGUST 2007
REVISED:

SHEET NO.
5 of 11