


Gilbert E.L. Spruce W.L. Grove
 30' Corner E Curb
 B.M. Elev. 106.17 W' in Walker SE. Cor. Madison + Gilbert

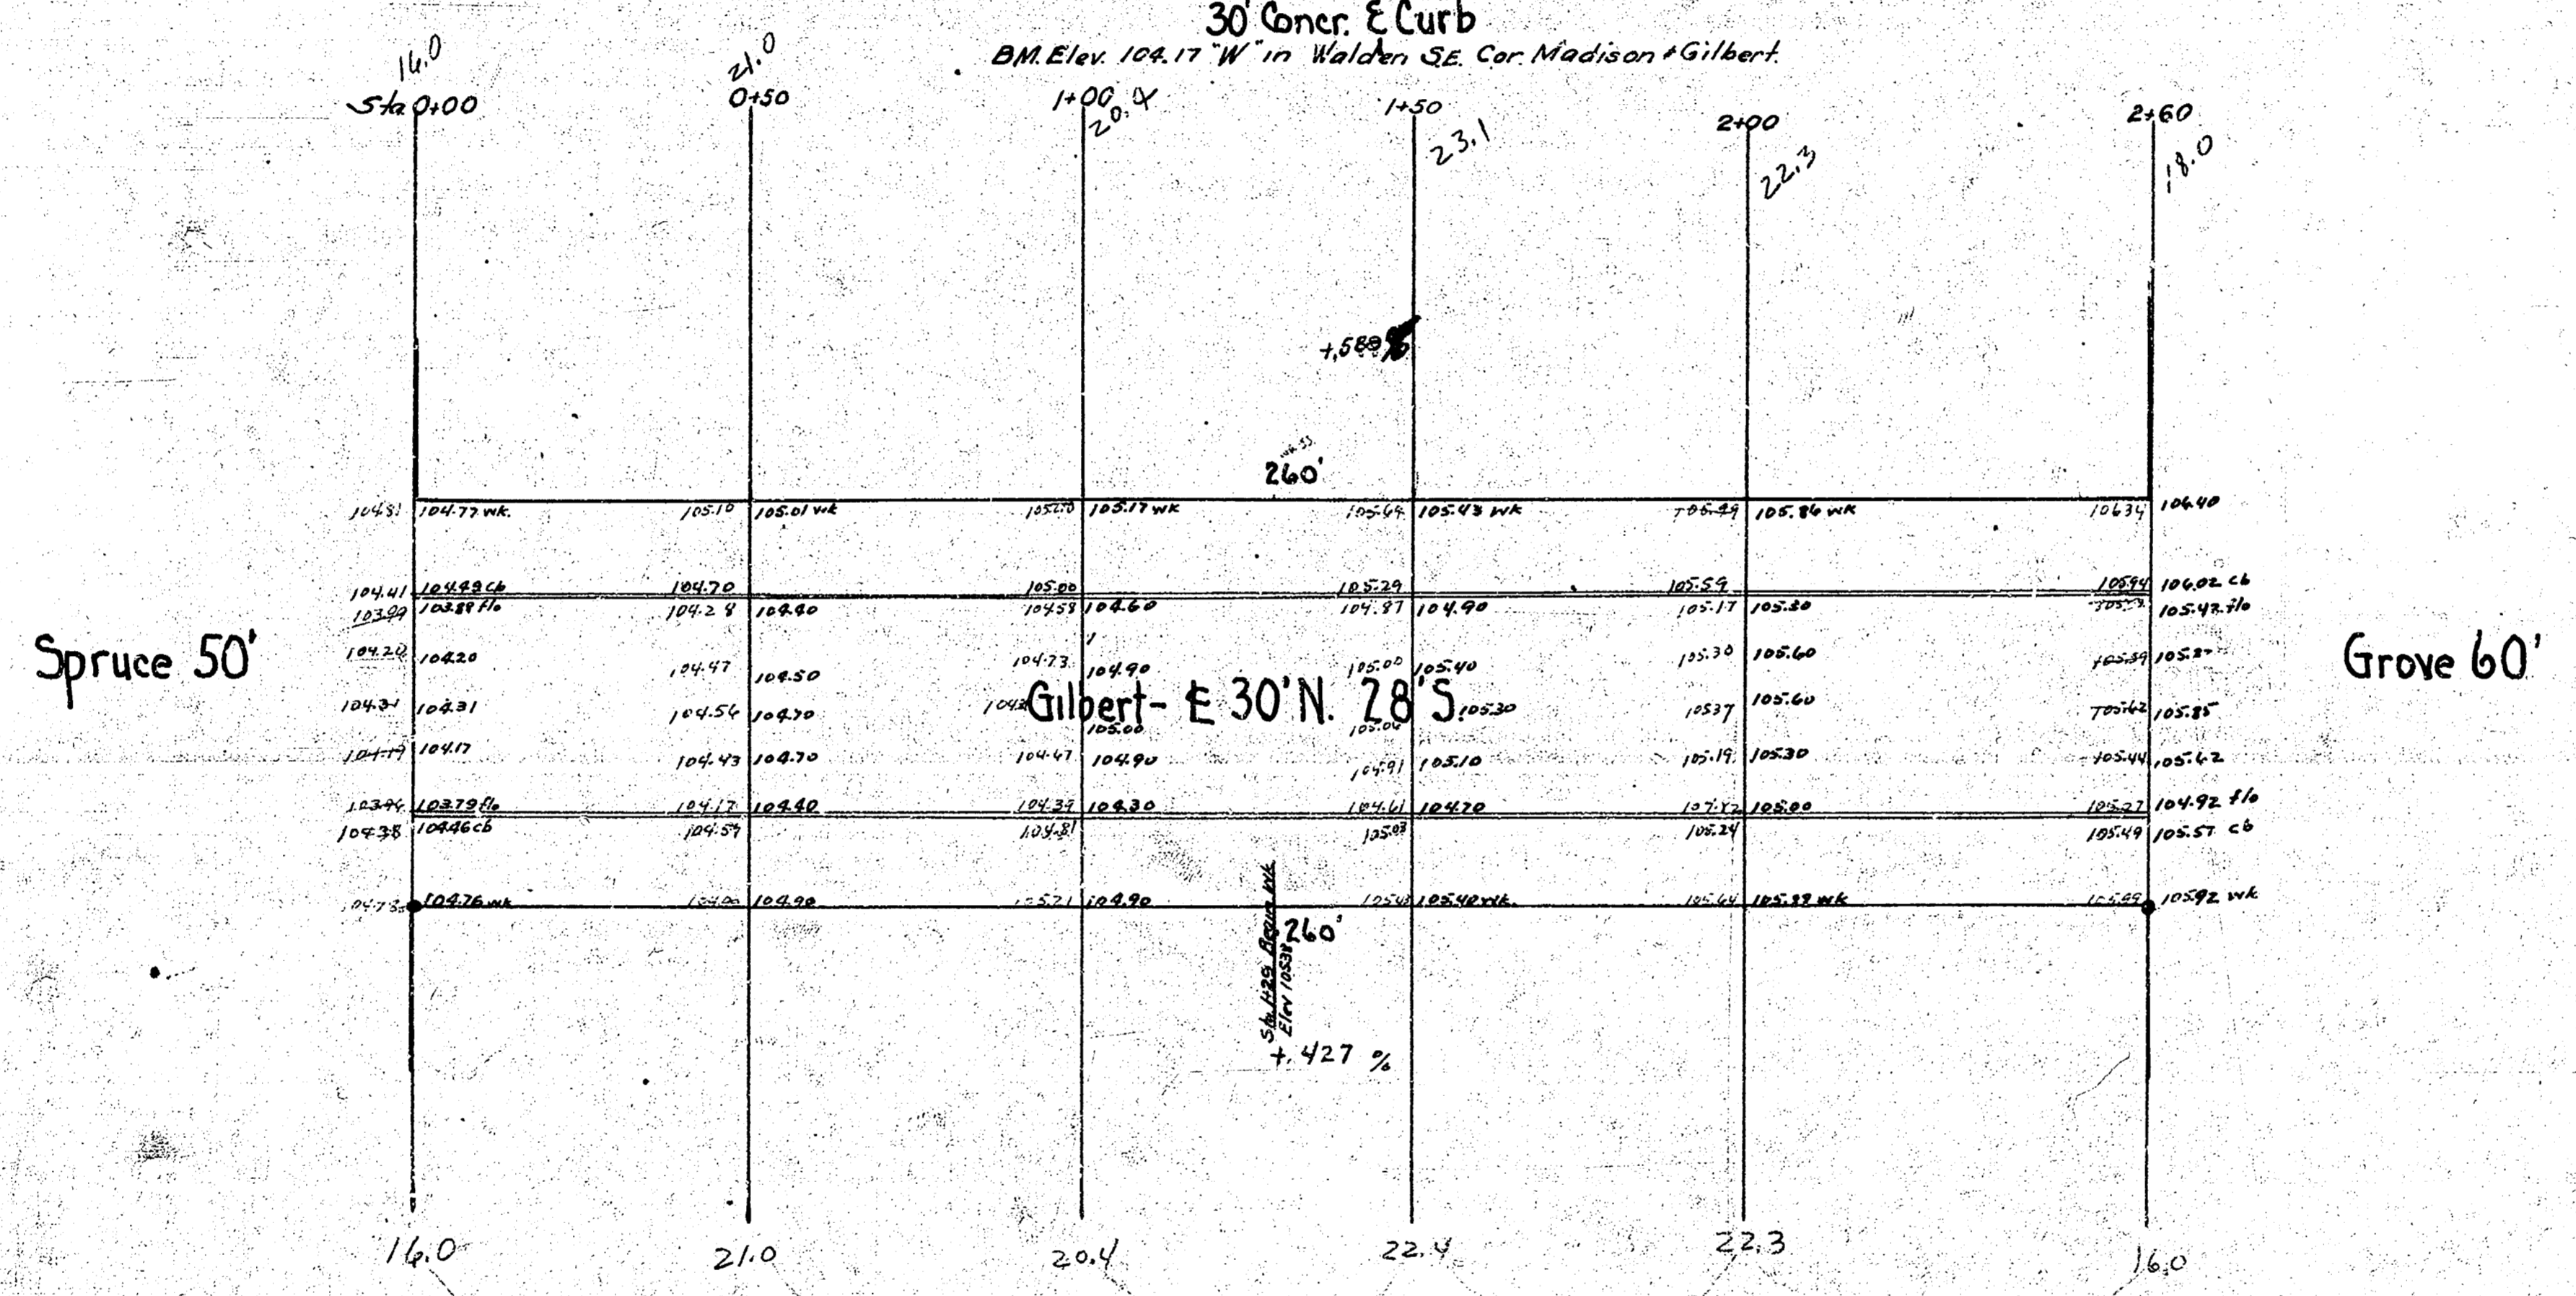

Property	34.2	38.2	39.6	41.3	43.8	$= 197.1 + 19.7 = 216.8 \text{ cu yds}$
----------	------	------	------	------	------	---

Paving Plan
 1940
 Gilbert -
 W.L. Grove
 E.L. Spruce