


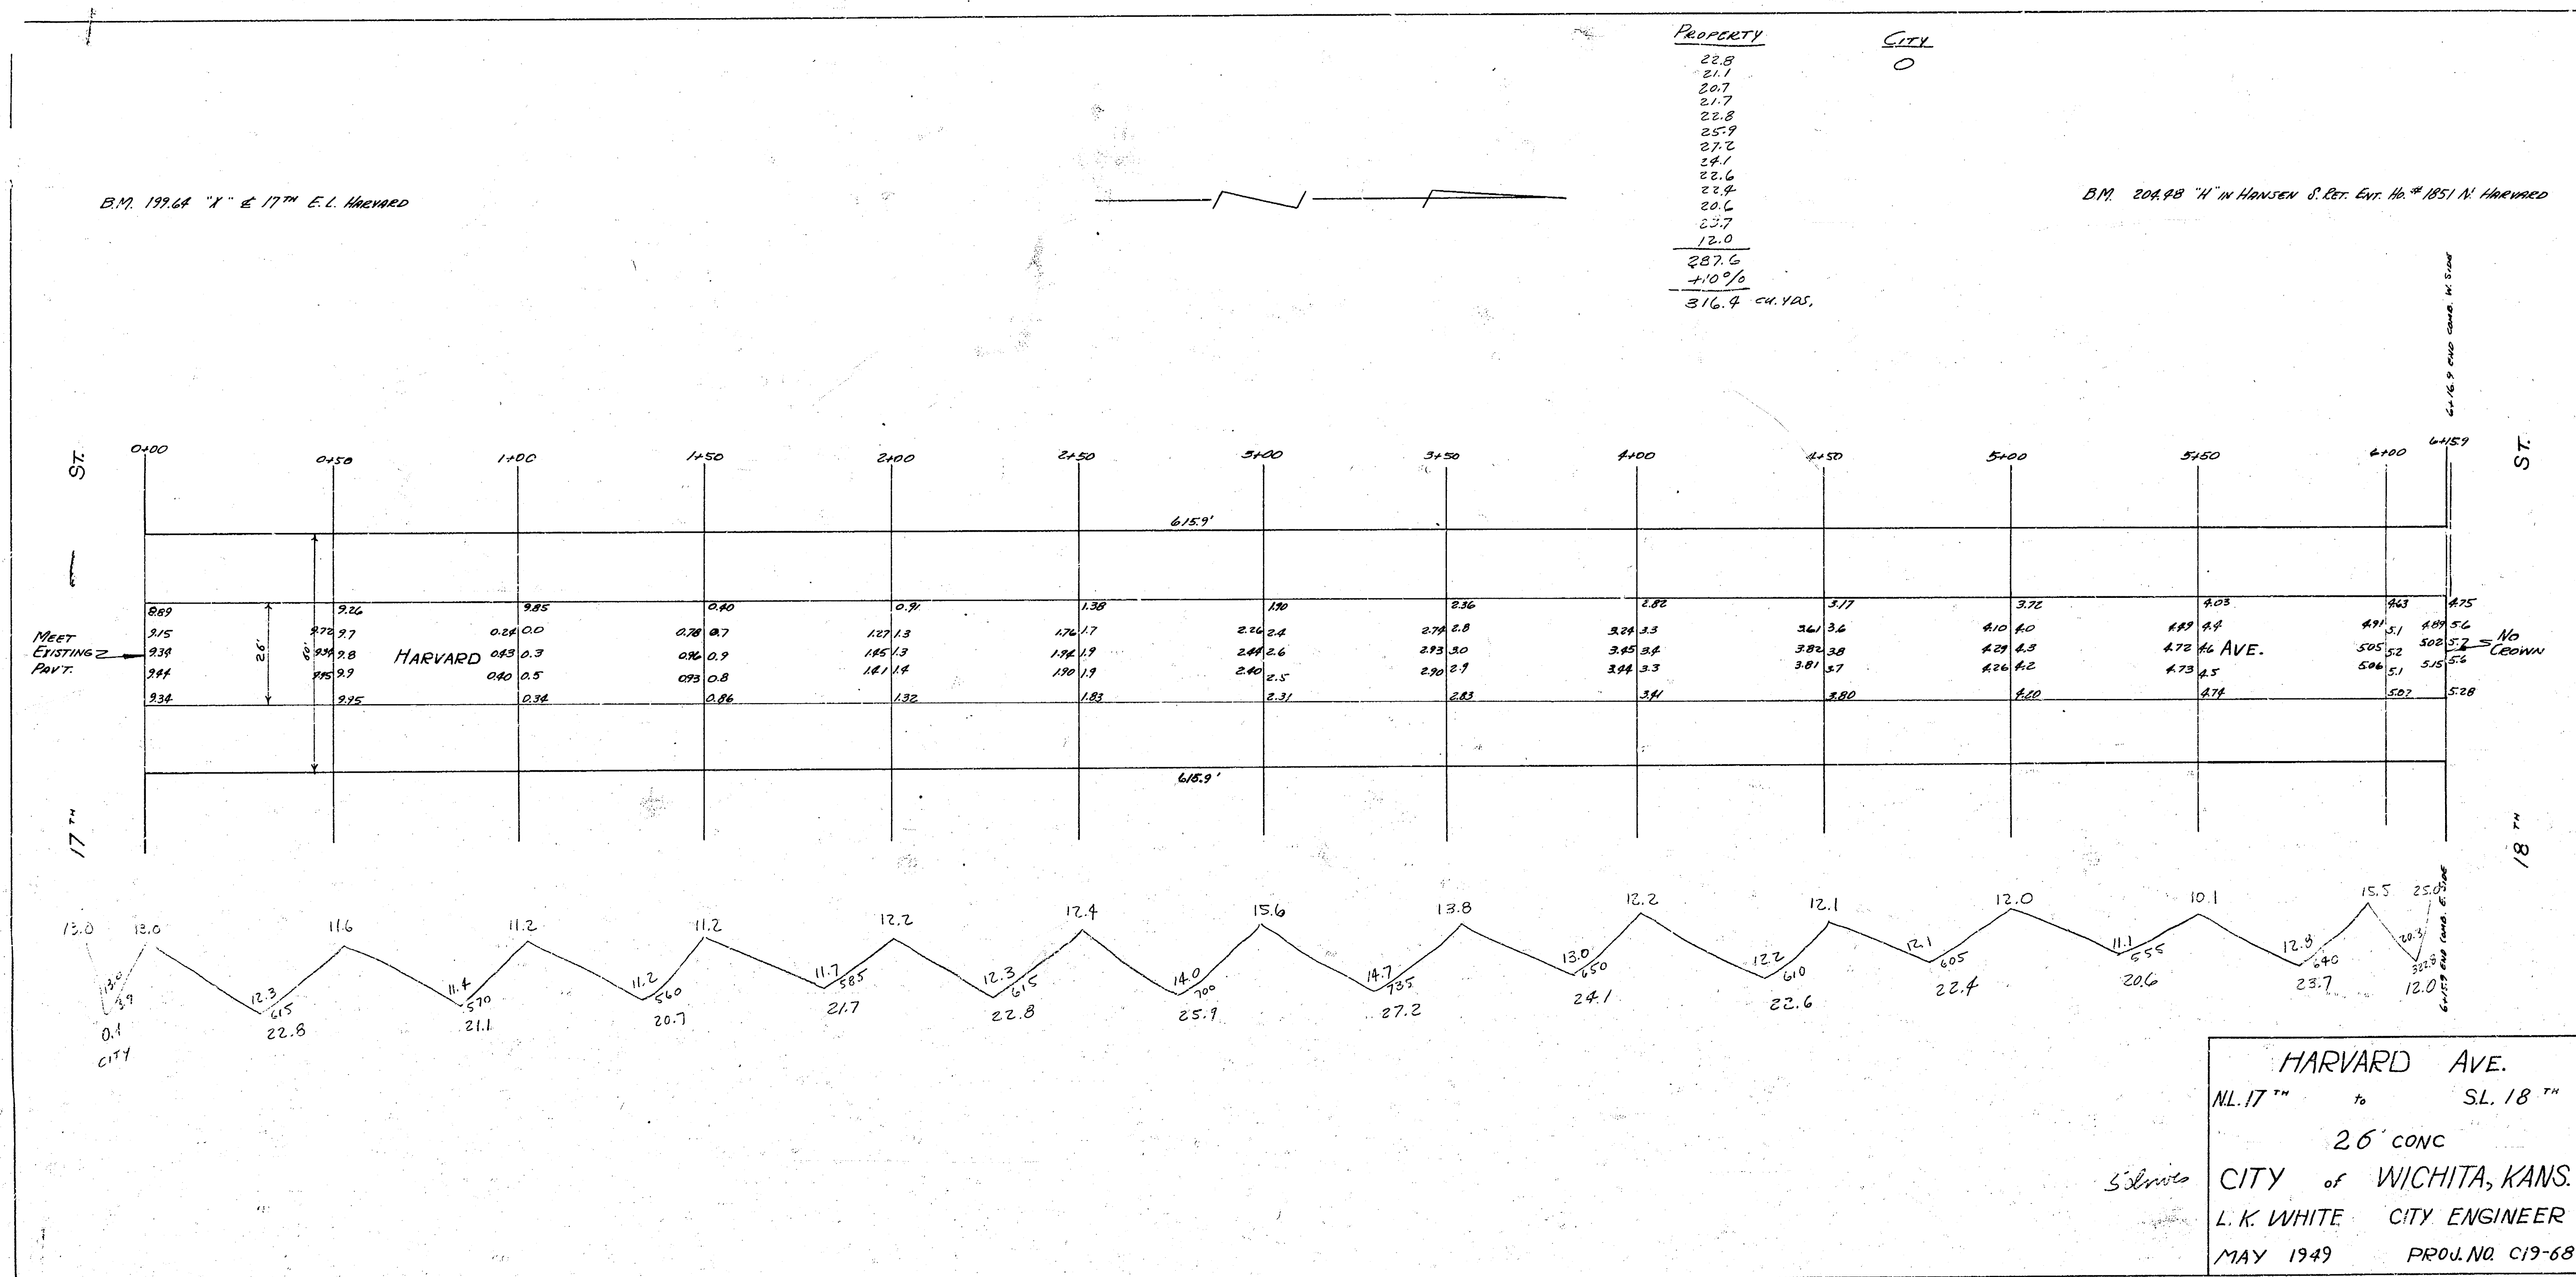

$$\begin{array}{r} 135 \\ 11.2 \\ \hline 2.1 \end{array}$$

$$\begin{array}{r} 15 \overline{) 120} \\ \underline{90} \\ 300 \end{array}$$

$$\begin{array}{r} 18 \\ 9 \\ \hline 3.2 \end{array}$$

Comp. Corp & Gutter

{ B.M. T in Troy - Hydrony Sept. 17th @ Rosecrans.
Elev. 207.63
X - @ 17th & E. Side Hayward.
Elev. 199.64

Green figures are 1st Cross sections
Blue figures are Final Cross sections

