


1942
PORTER AVE - N.L. PERRY TO S.L. 16TH
CB & GTR.

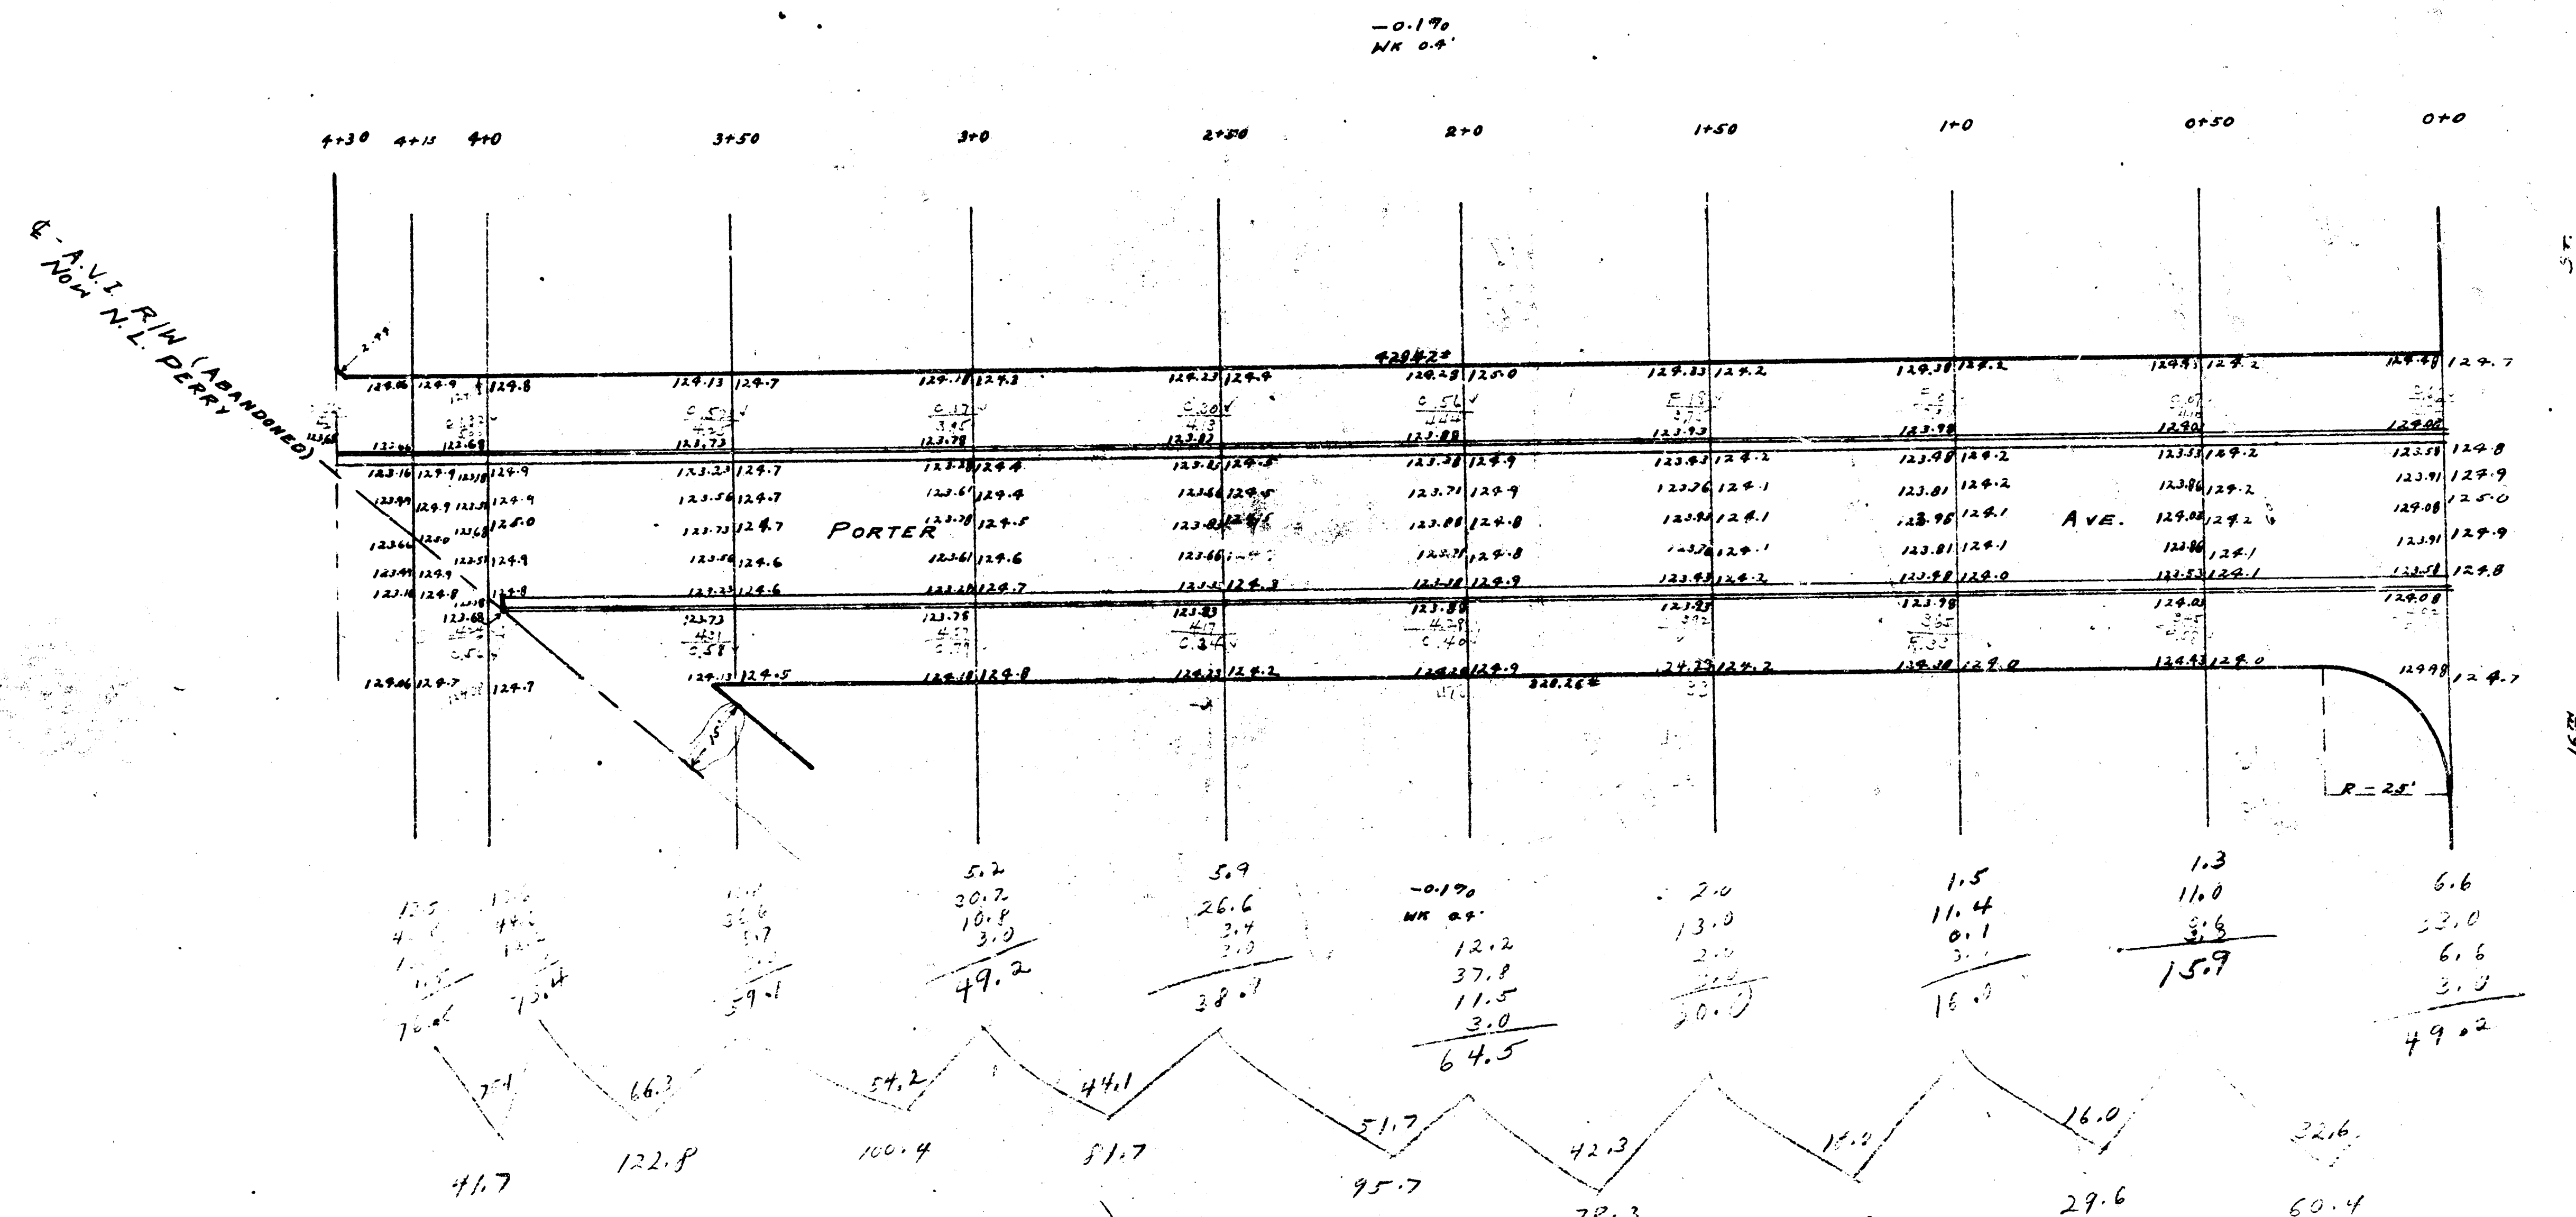

Brn 113.77 x 20.00 S. of Perry (Porter & 14th)
Inn 120.26 x 20.00 S. of Perry (Porter & S.L. 16th)

Prop

41.7
122.8
100.4
51.7
100.4
32.3
27.6
60.4

543.9
61.4

77.6 → 77.3