





B.M. 118.37 NW Cor. Conc. Porch Ho. W. 2459 Newell
B.M. 117.00 Spike in 36" Elm W.L. Meridian 20' So. of St. Louis
B.M. 117.45 SE Cor. Lower Step Ho. W. 2400 St. Louis

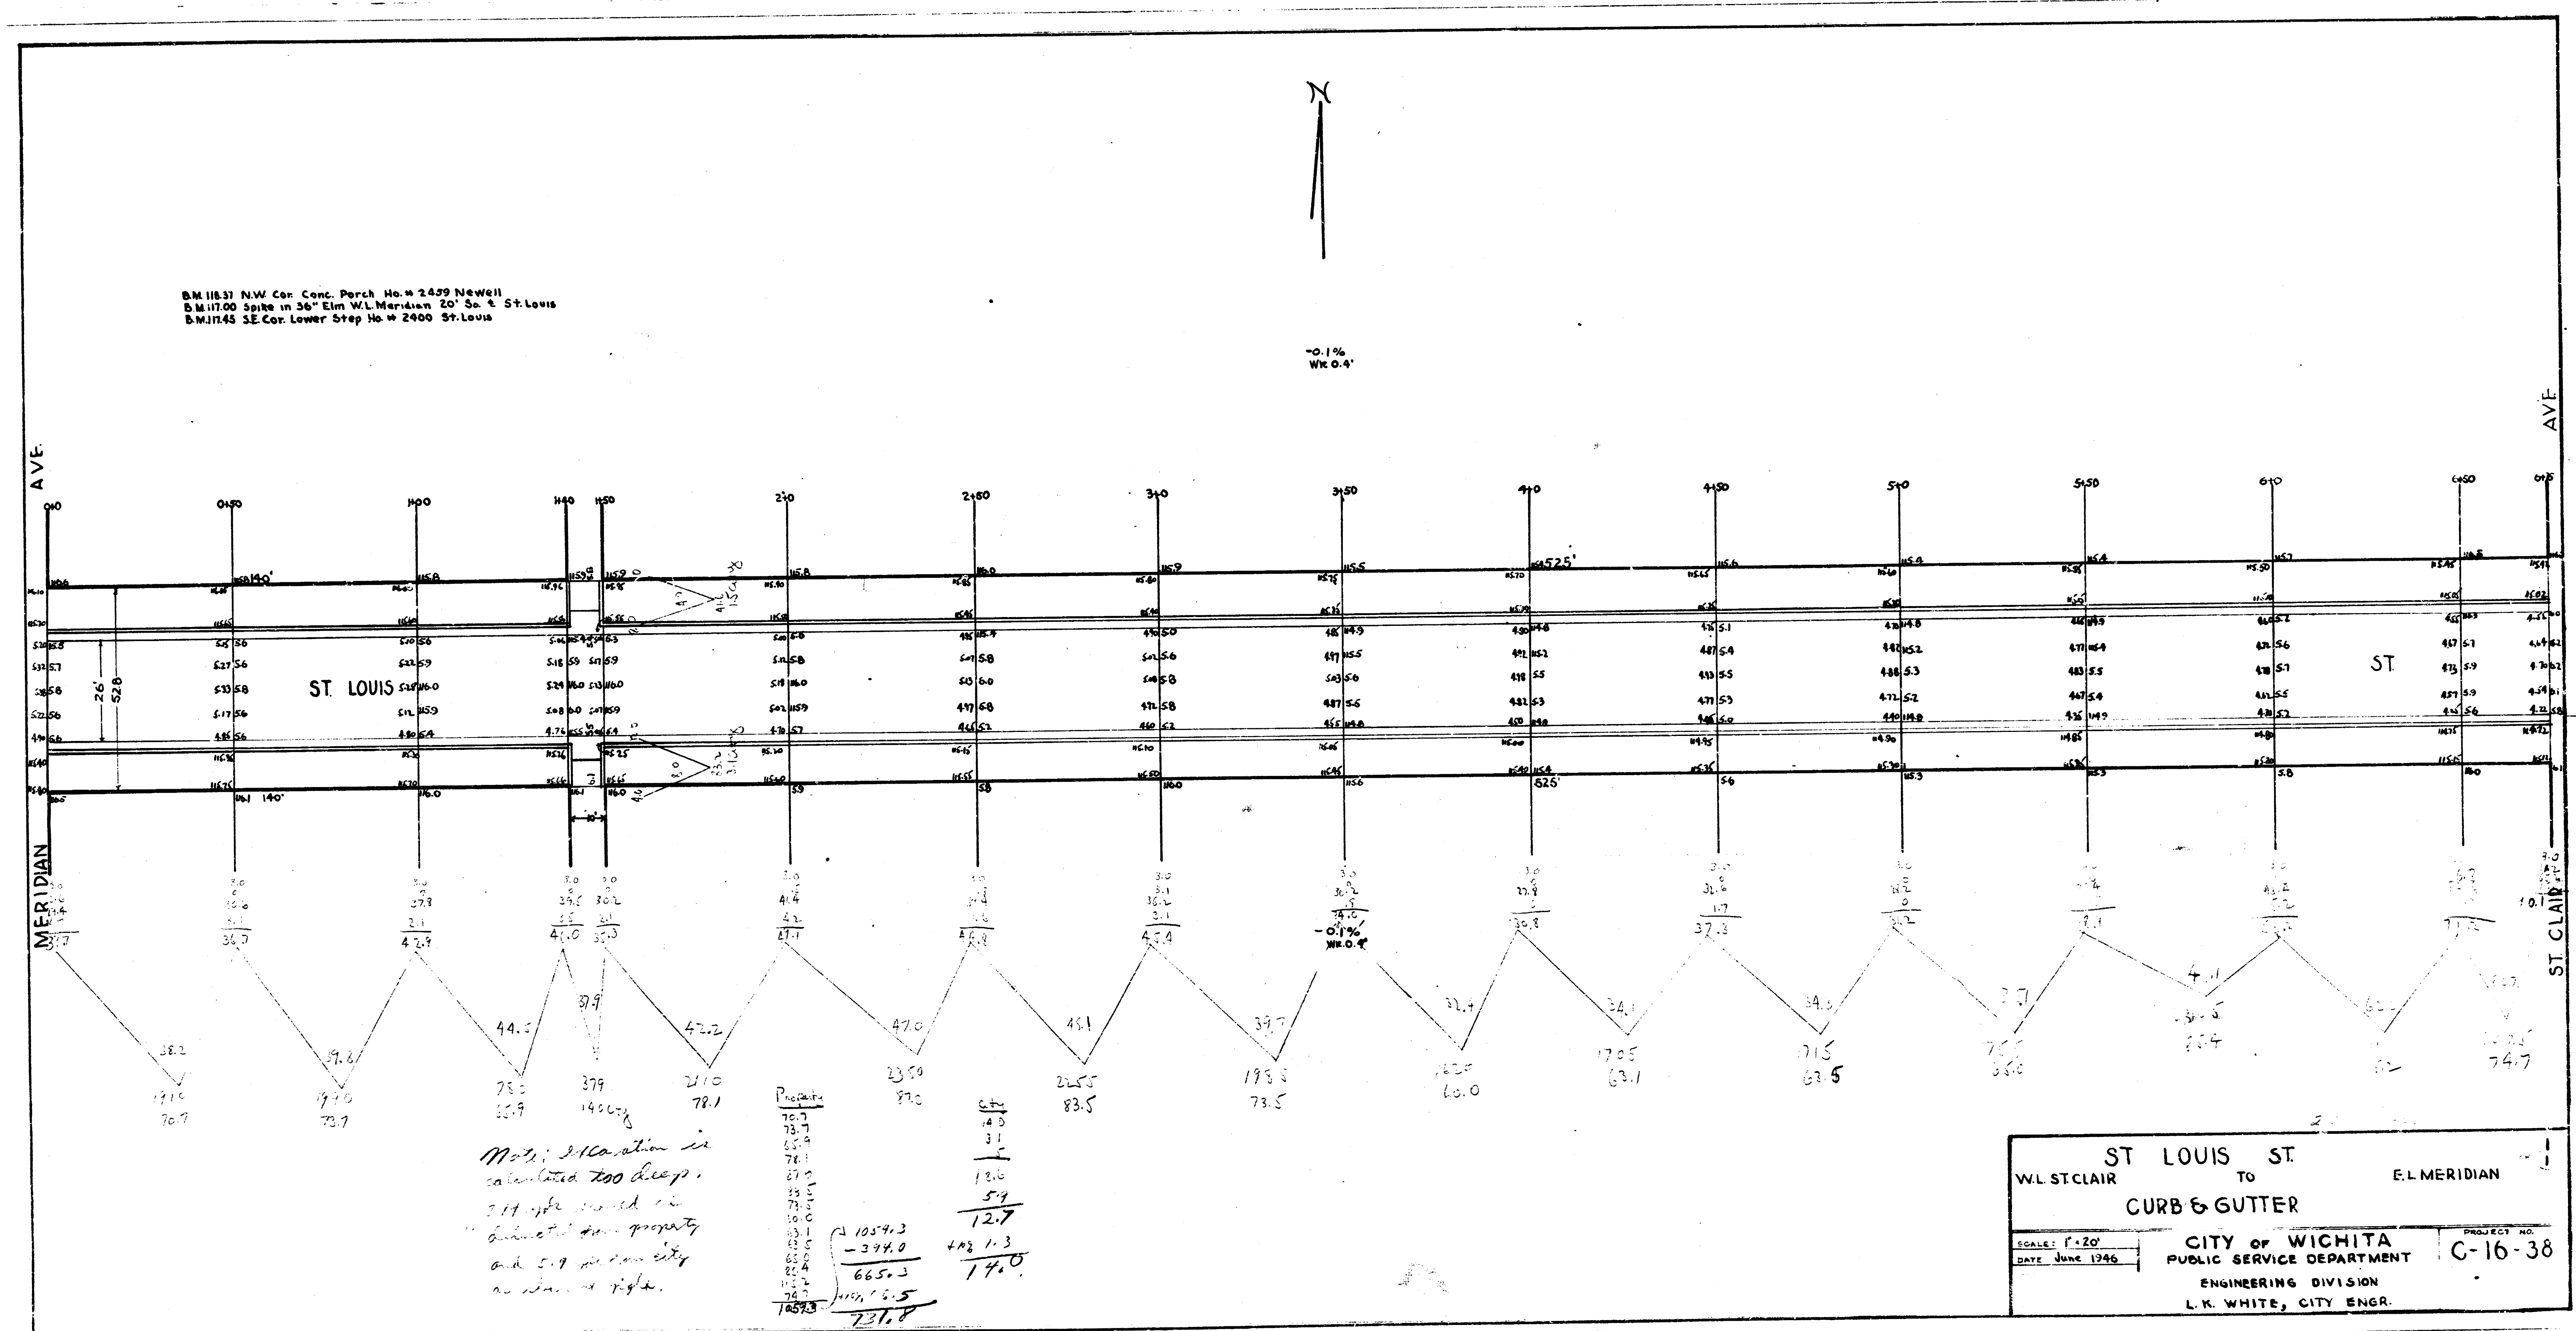

0.1%
W.R.O.4

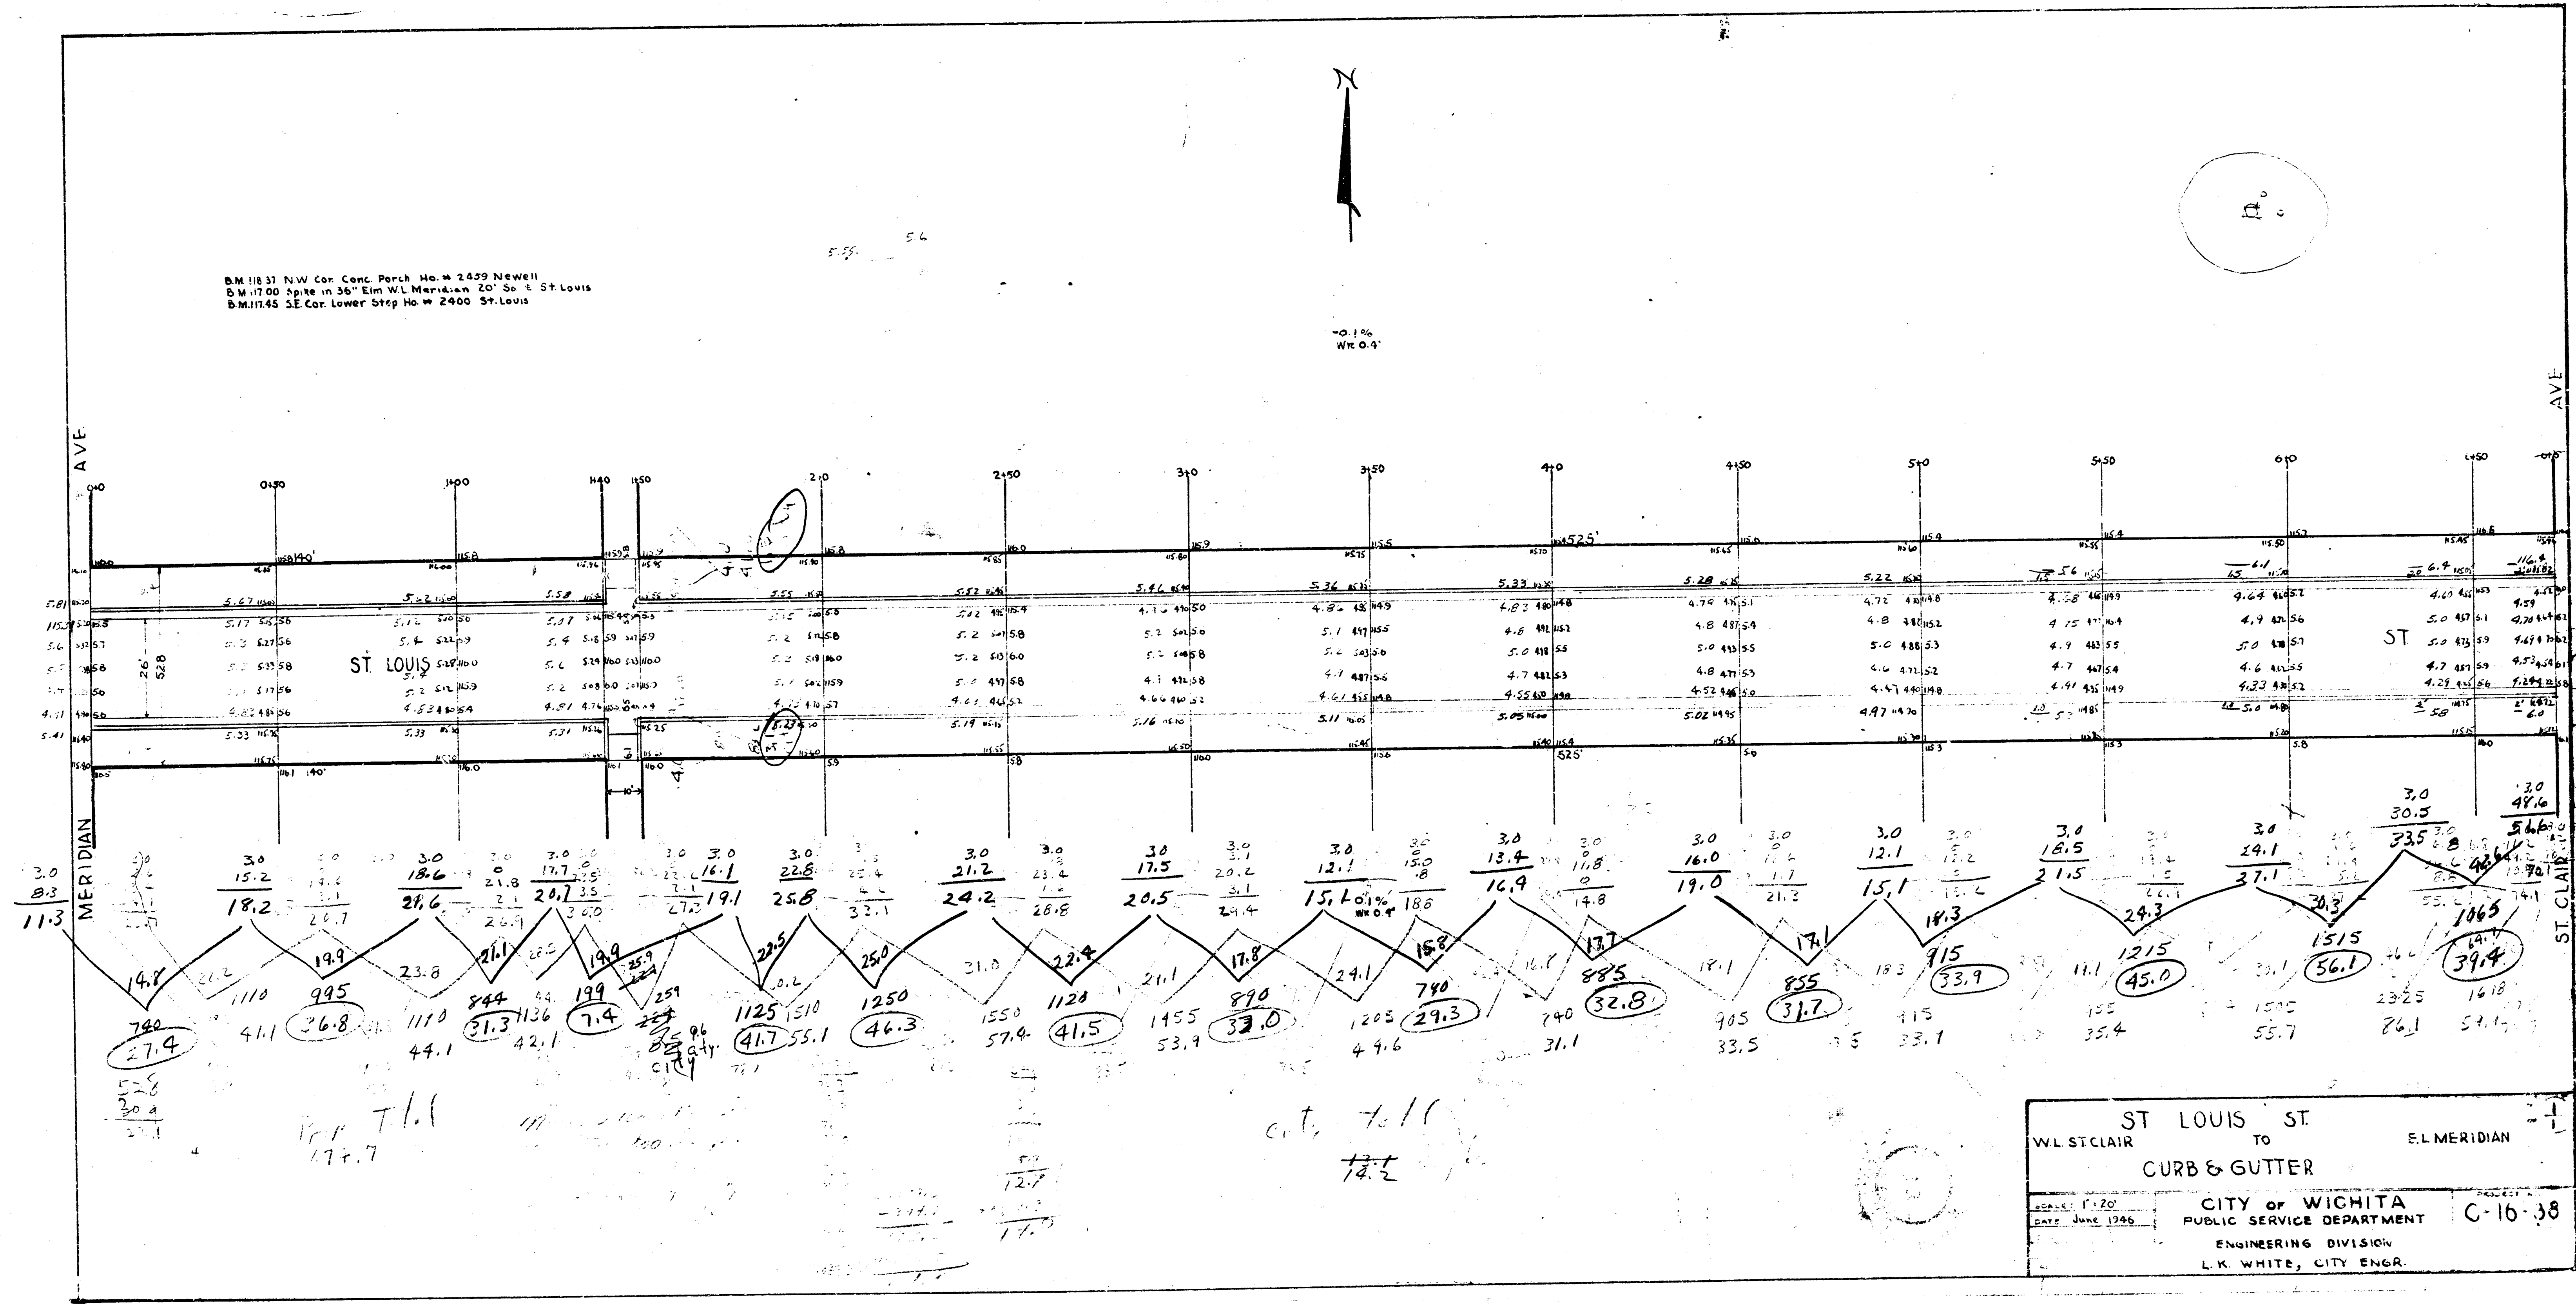

ST. LOUIS ST.	
WL ST. CLAIR	TO E.L. MERIDIAN
CURB & GUTTER	
DATE: JUNE 1958	PROJECT: C-10-38
CITY OF WICHITA	
PUBLIC SERVICE DEPARTMENT	
ENGINEERING DIVISION	
L.K. WHITE, CITY ENGR.	