

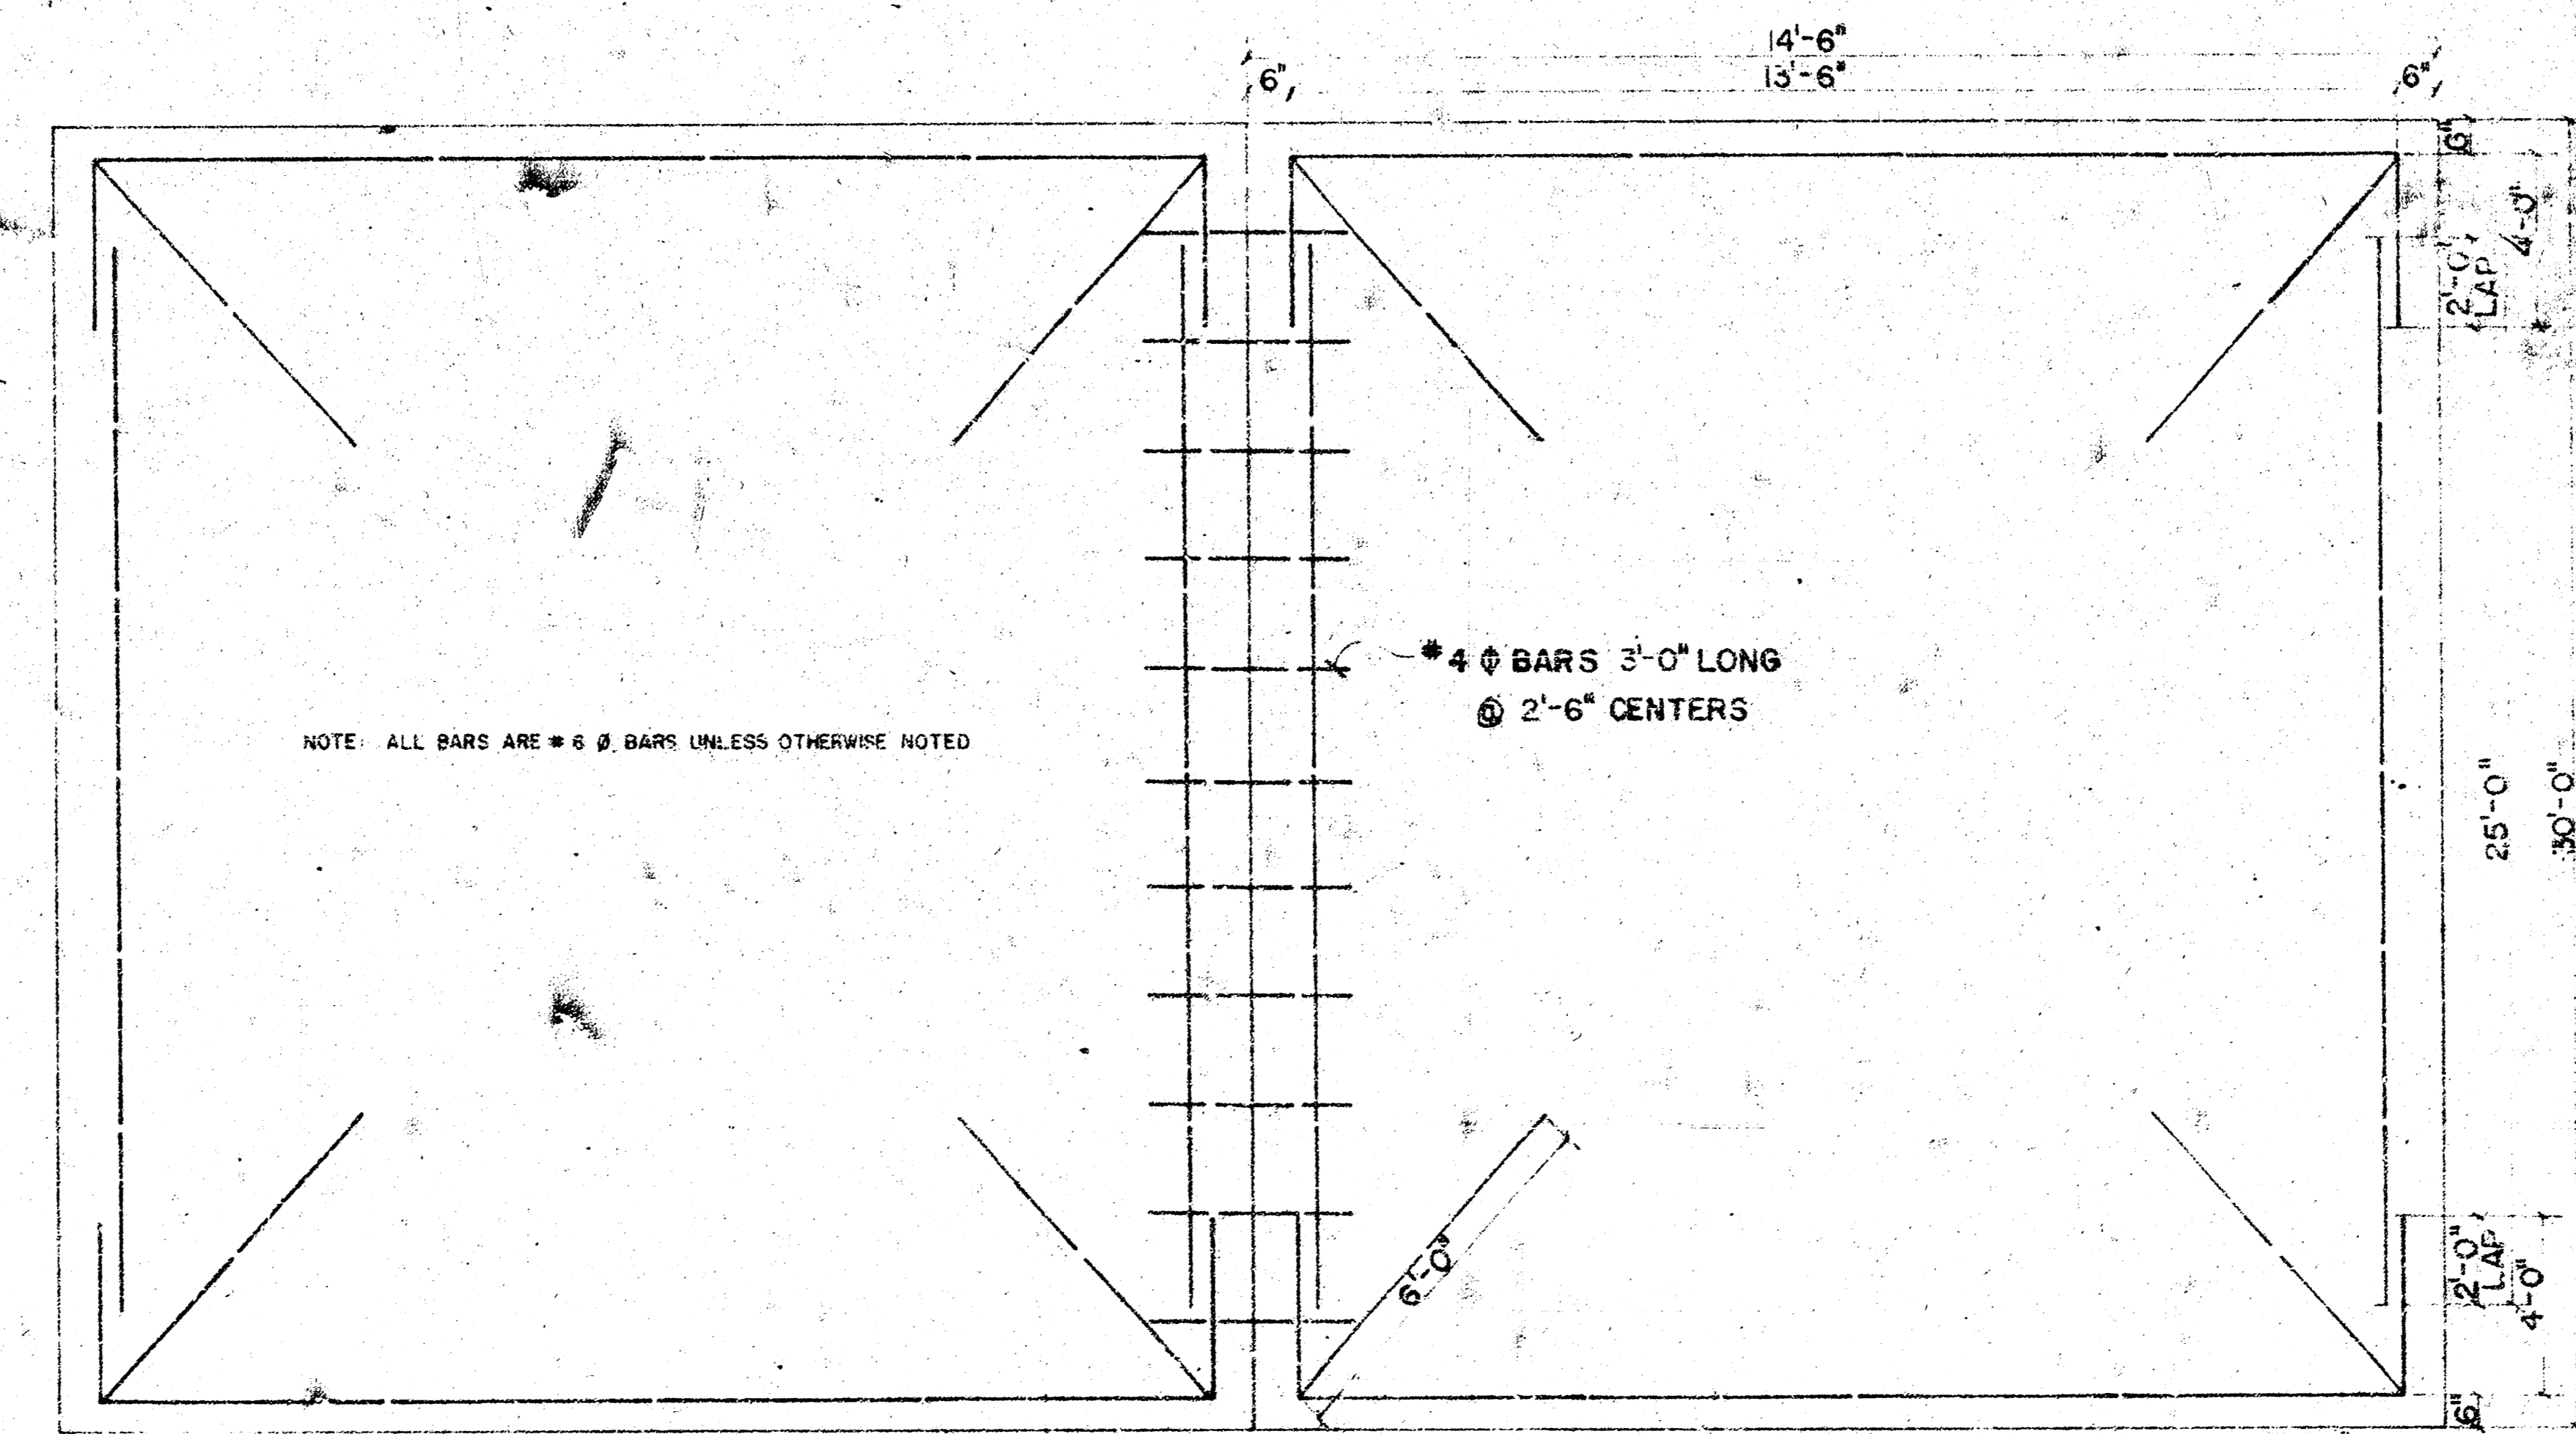



SHERIDAN AVENUE
N. L. 31ST STREET SO. TO N. L. SUNNYBROOK LANE
TYPICAL SECTION 29'-0" CONCRETE PAVEMENT

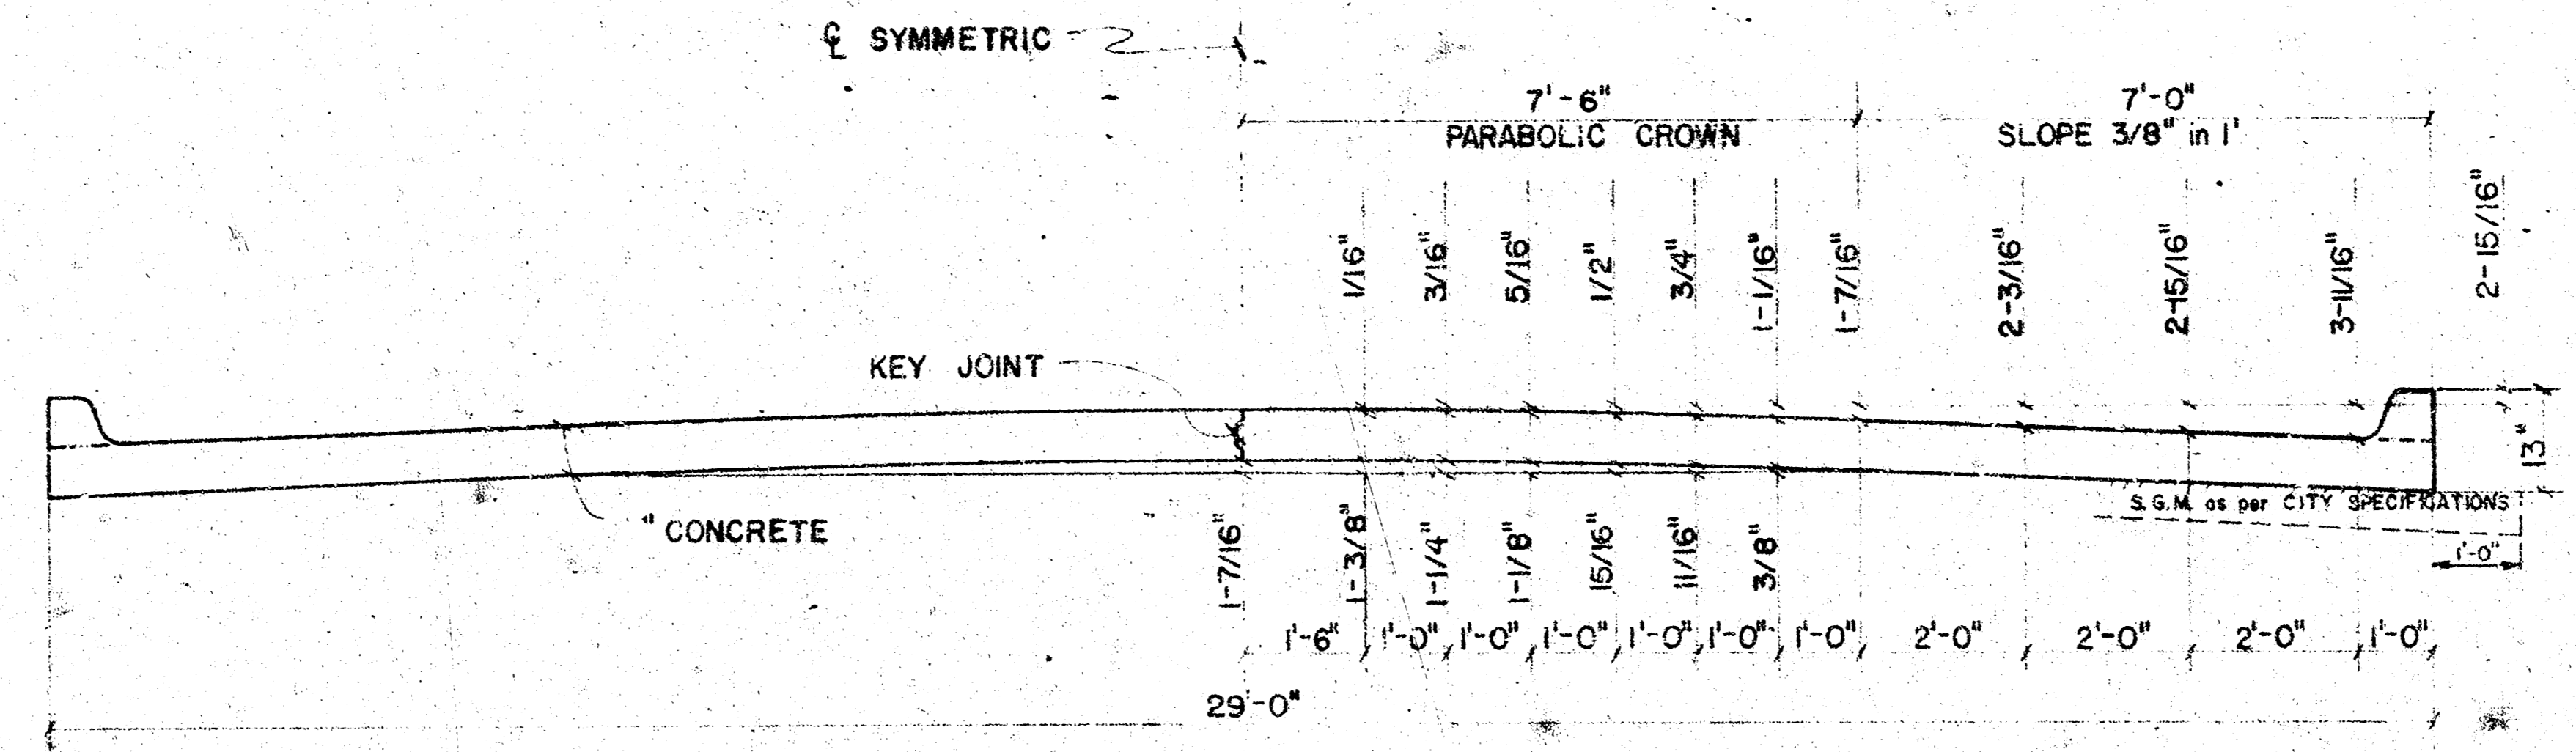


STEEL PATTERN
 NO SCALE

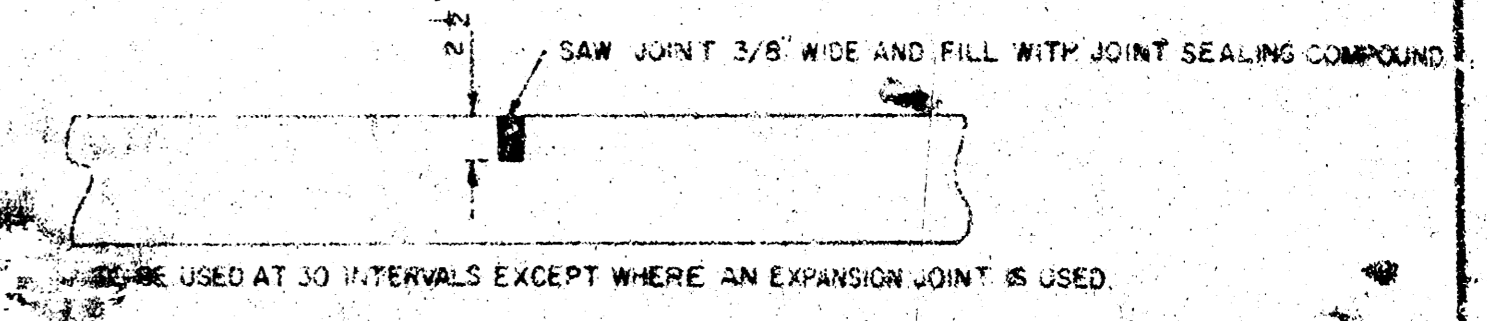


CONTRACTION JOINT DETAIL

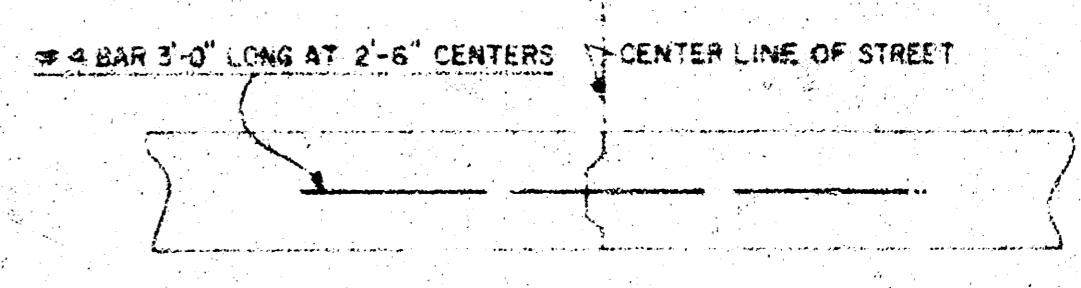

KEY JOINT DETAIL

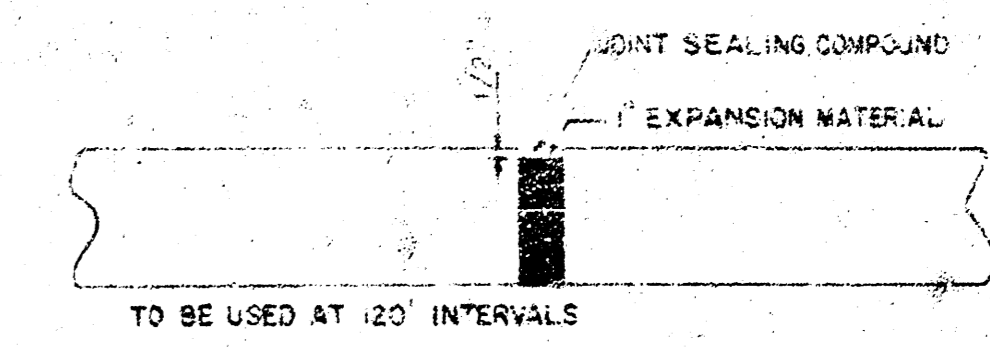


EXPANSION JOINT DETAIL

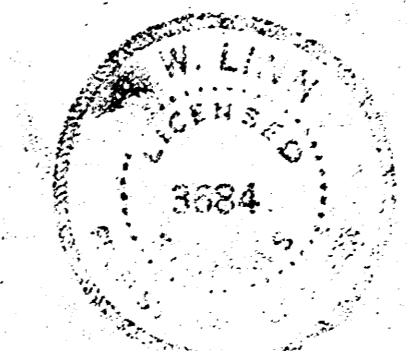


CITY OF WICHITA, KANSAS
 DEPARTMENT OF PUBLIC WORKS-ENGINEERING DIVISION
 B. E. SMITH CITY ENGINEER
 DATE: PROJ. NO. DAKS575049

FILMED FROM THE BEST AVAILABLE COPY

B.M. 103 23 City Std. Top East End South Handrail To R.C.B. @ Sheridan & 31st Street
 Baseline on East R. of Sheridan

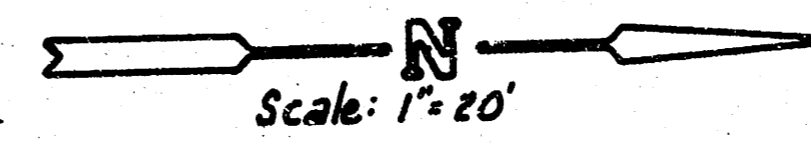

Note: Drainage Ditch Grading By "Others."

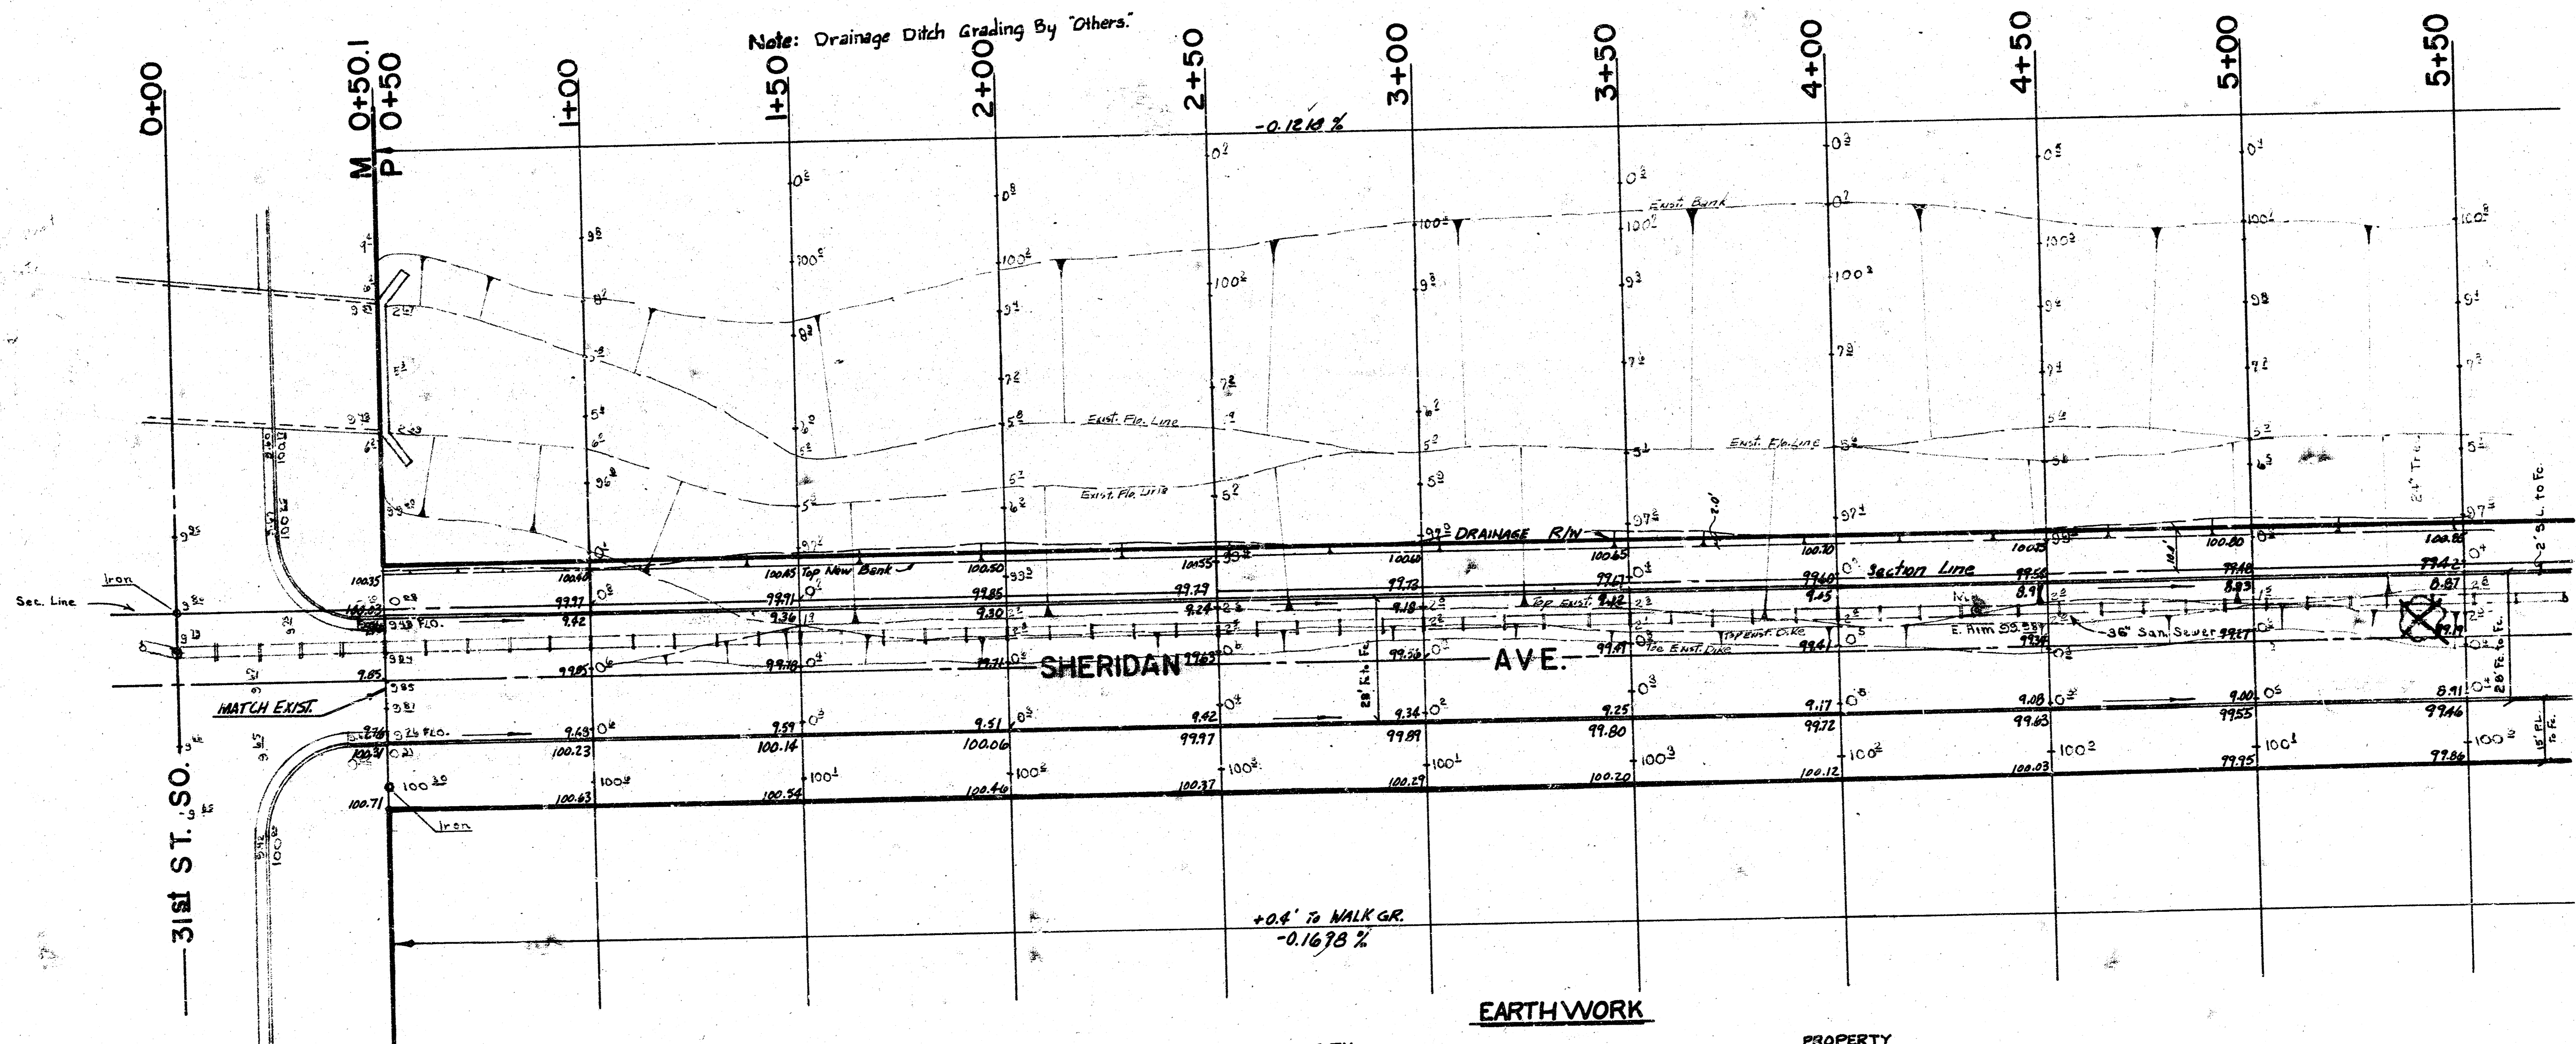

SUPV. CHECKED: [Signature]
 PLAN MANIPULATED BY: [Signature]
 EXC. 1/18/57
 CHECKED: [Signature]

NOTE TO FIELD ENGINEER & CONTRACTOR
 Grade parking and clear right-of-way for proposed sidewalk. Compact fill in sidewalk area. TO BE CONSTRUCTED BY "OTHERS".


SUB-GRADE
 TYPE OF SUB-GRADE TREATMENT SHALL BE DETERMINED BY THE FIELD ENGINEER. SUB-GRADE TREATMENT MAY CONSIST OF LIME TREATMENT, CEMENT TREATMENT, SUB-GRADE MODIFICATION, OR ANY COMBINATION OF THESE.

CITY EXCAVATION	
X-SECTION 10%	188.2 C.Y.
	188.6 C.Y.
TOTAL	2,074.8 C.Y.

EARTHWORK

PROPERTY EXCAVATION		COMP. FILL	
X-SECTION 10%	1,510.5 C.Y.		3.9 C.Y.
	151.1 C.Y.		0.4 C.Y.
TOTAL	1,661.6 C.Y.		4.3 C.Y.

MANIPULATION - 4,359 S.Y.

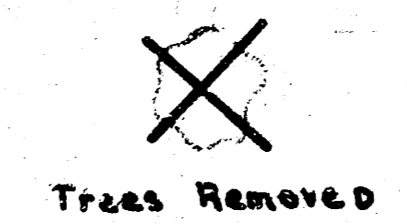


24" Inlet By Others

SHERIDAN AVE.
 PROJ. NO. DAKS575049

2/6

FILMED FROM THE BEST AVAILABLE COPY.....

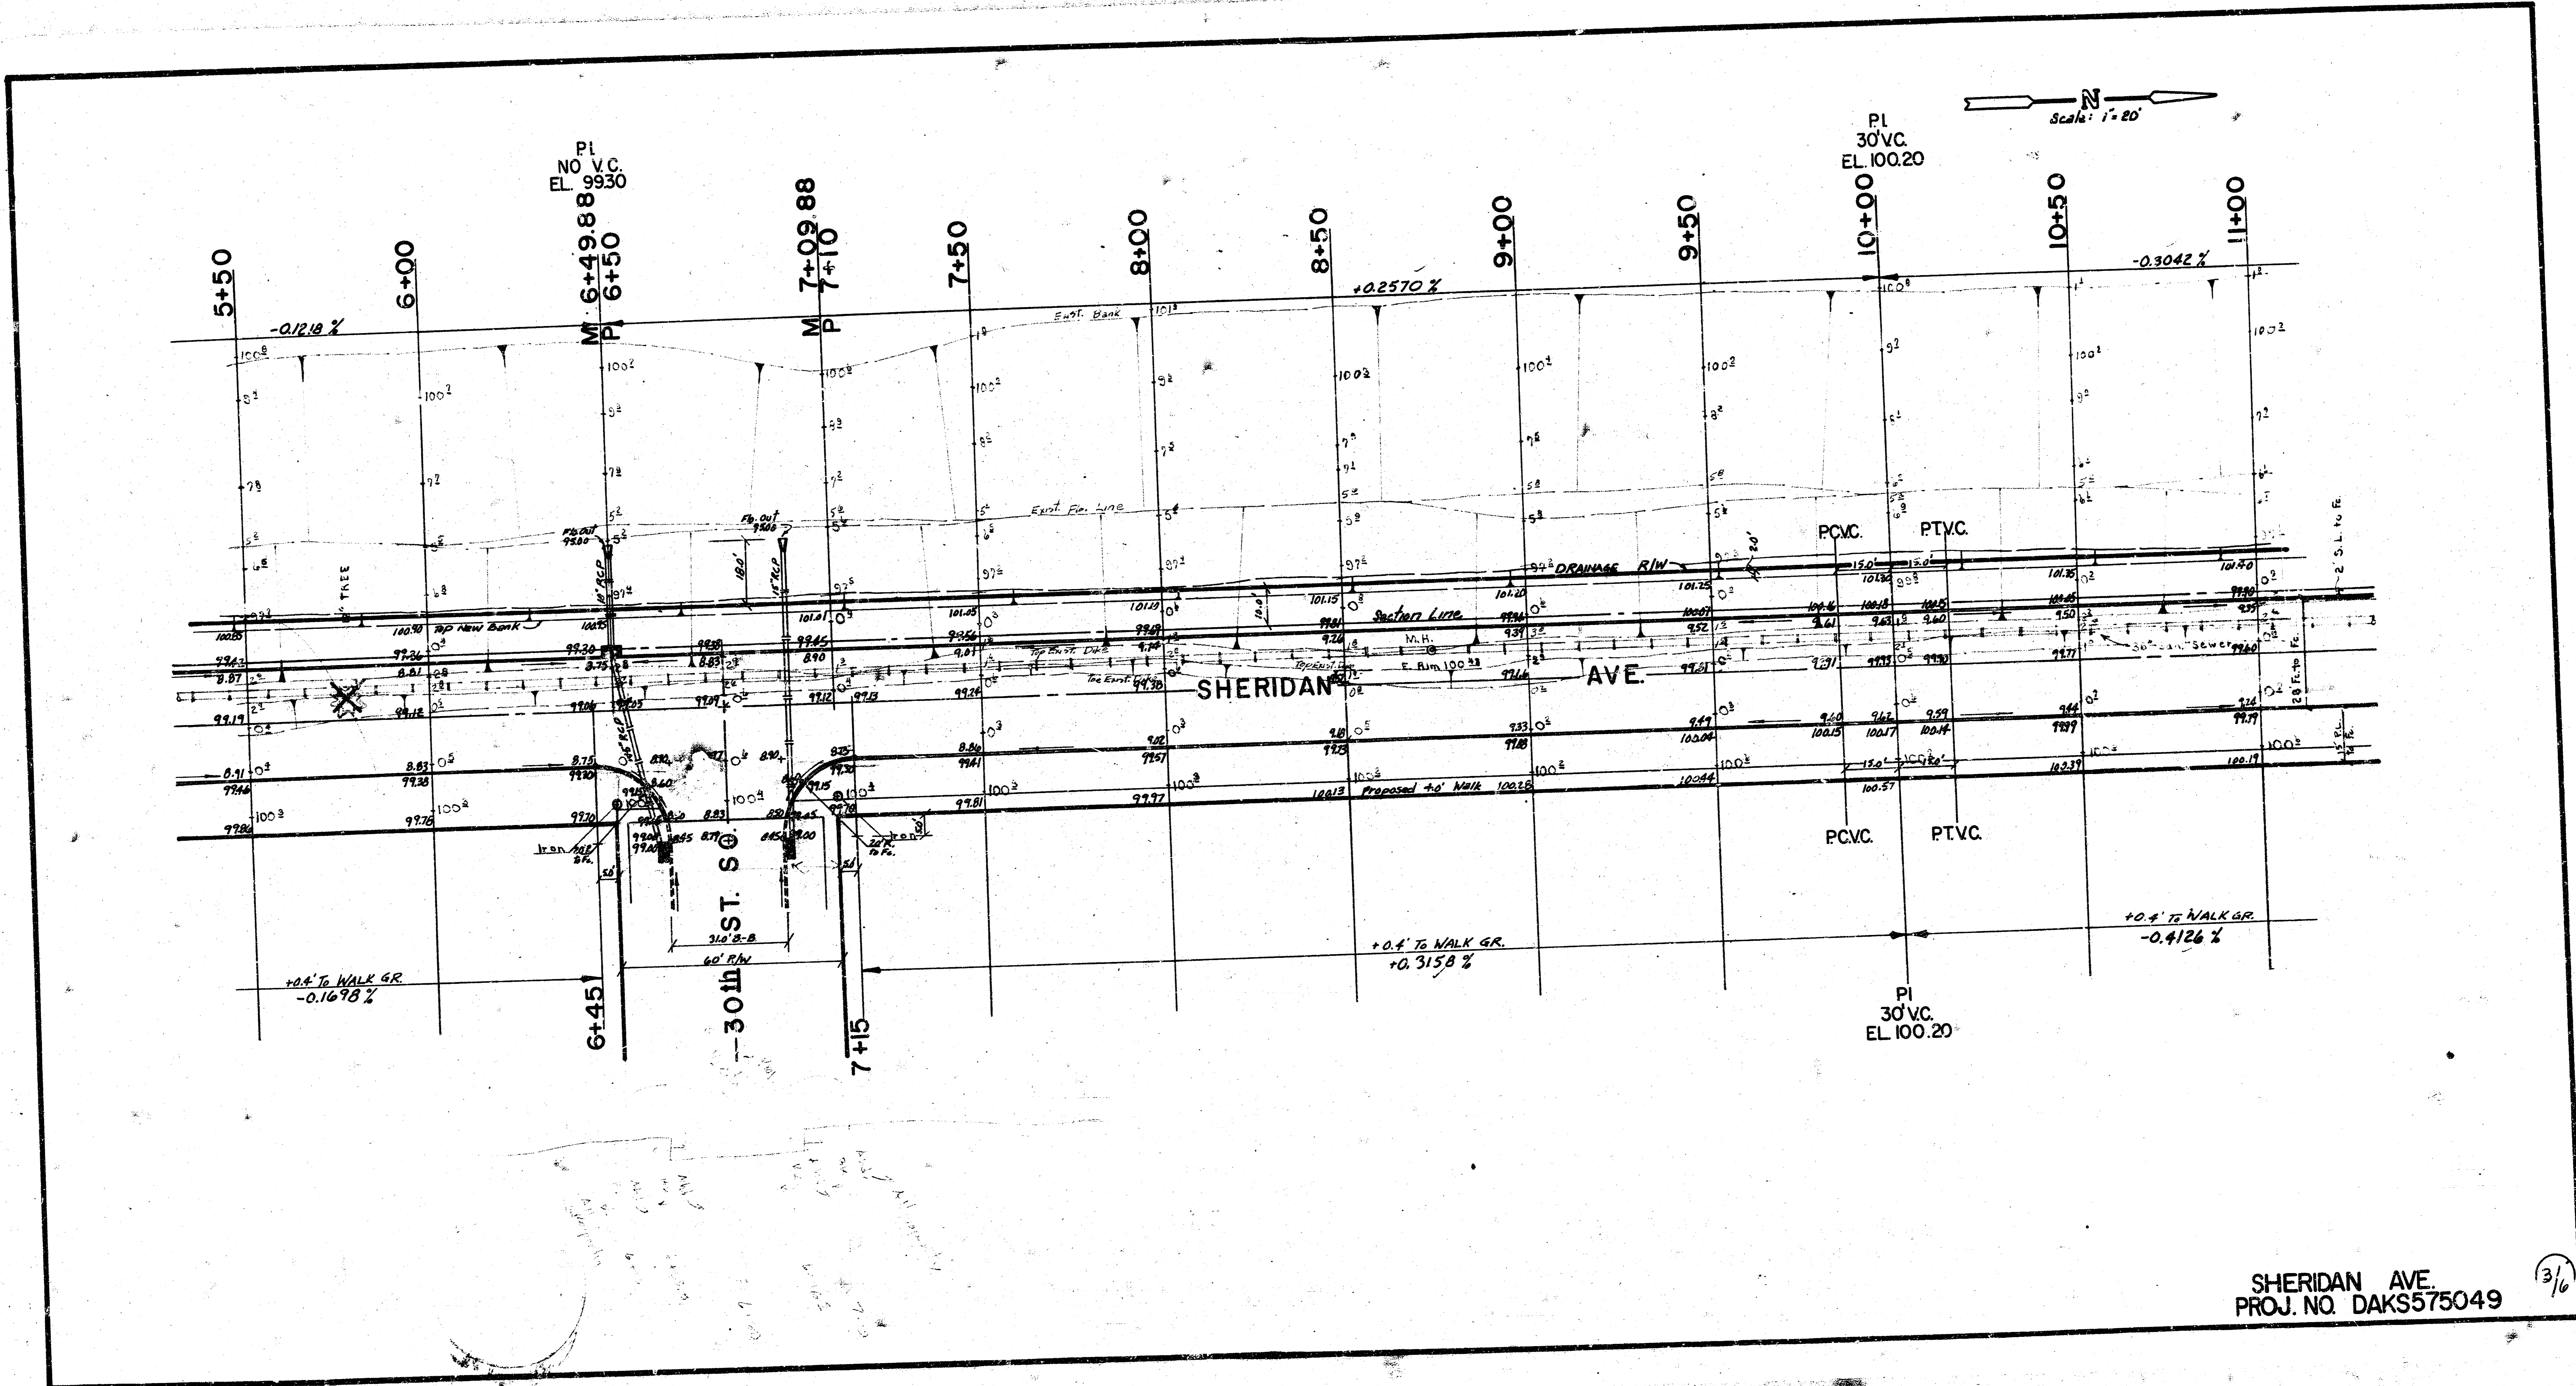


SHERIDAN AVE.
 PROJ. NO. DAKS575049


3/16

FILMED FROM THE BEST

Scale: 1" = 20'

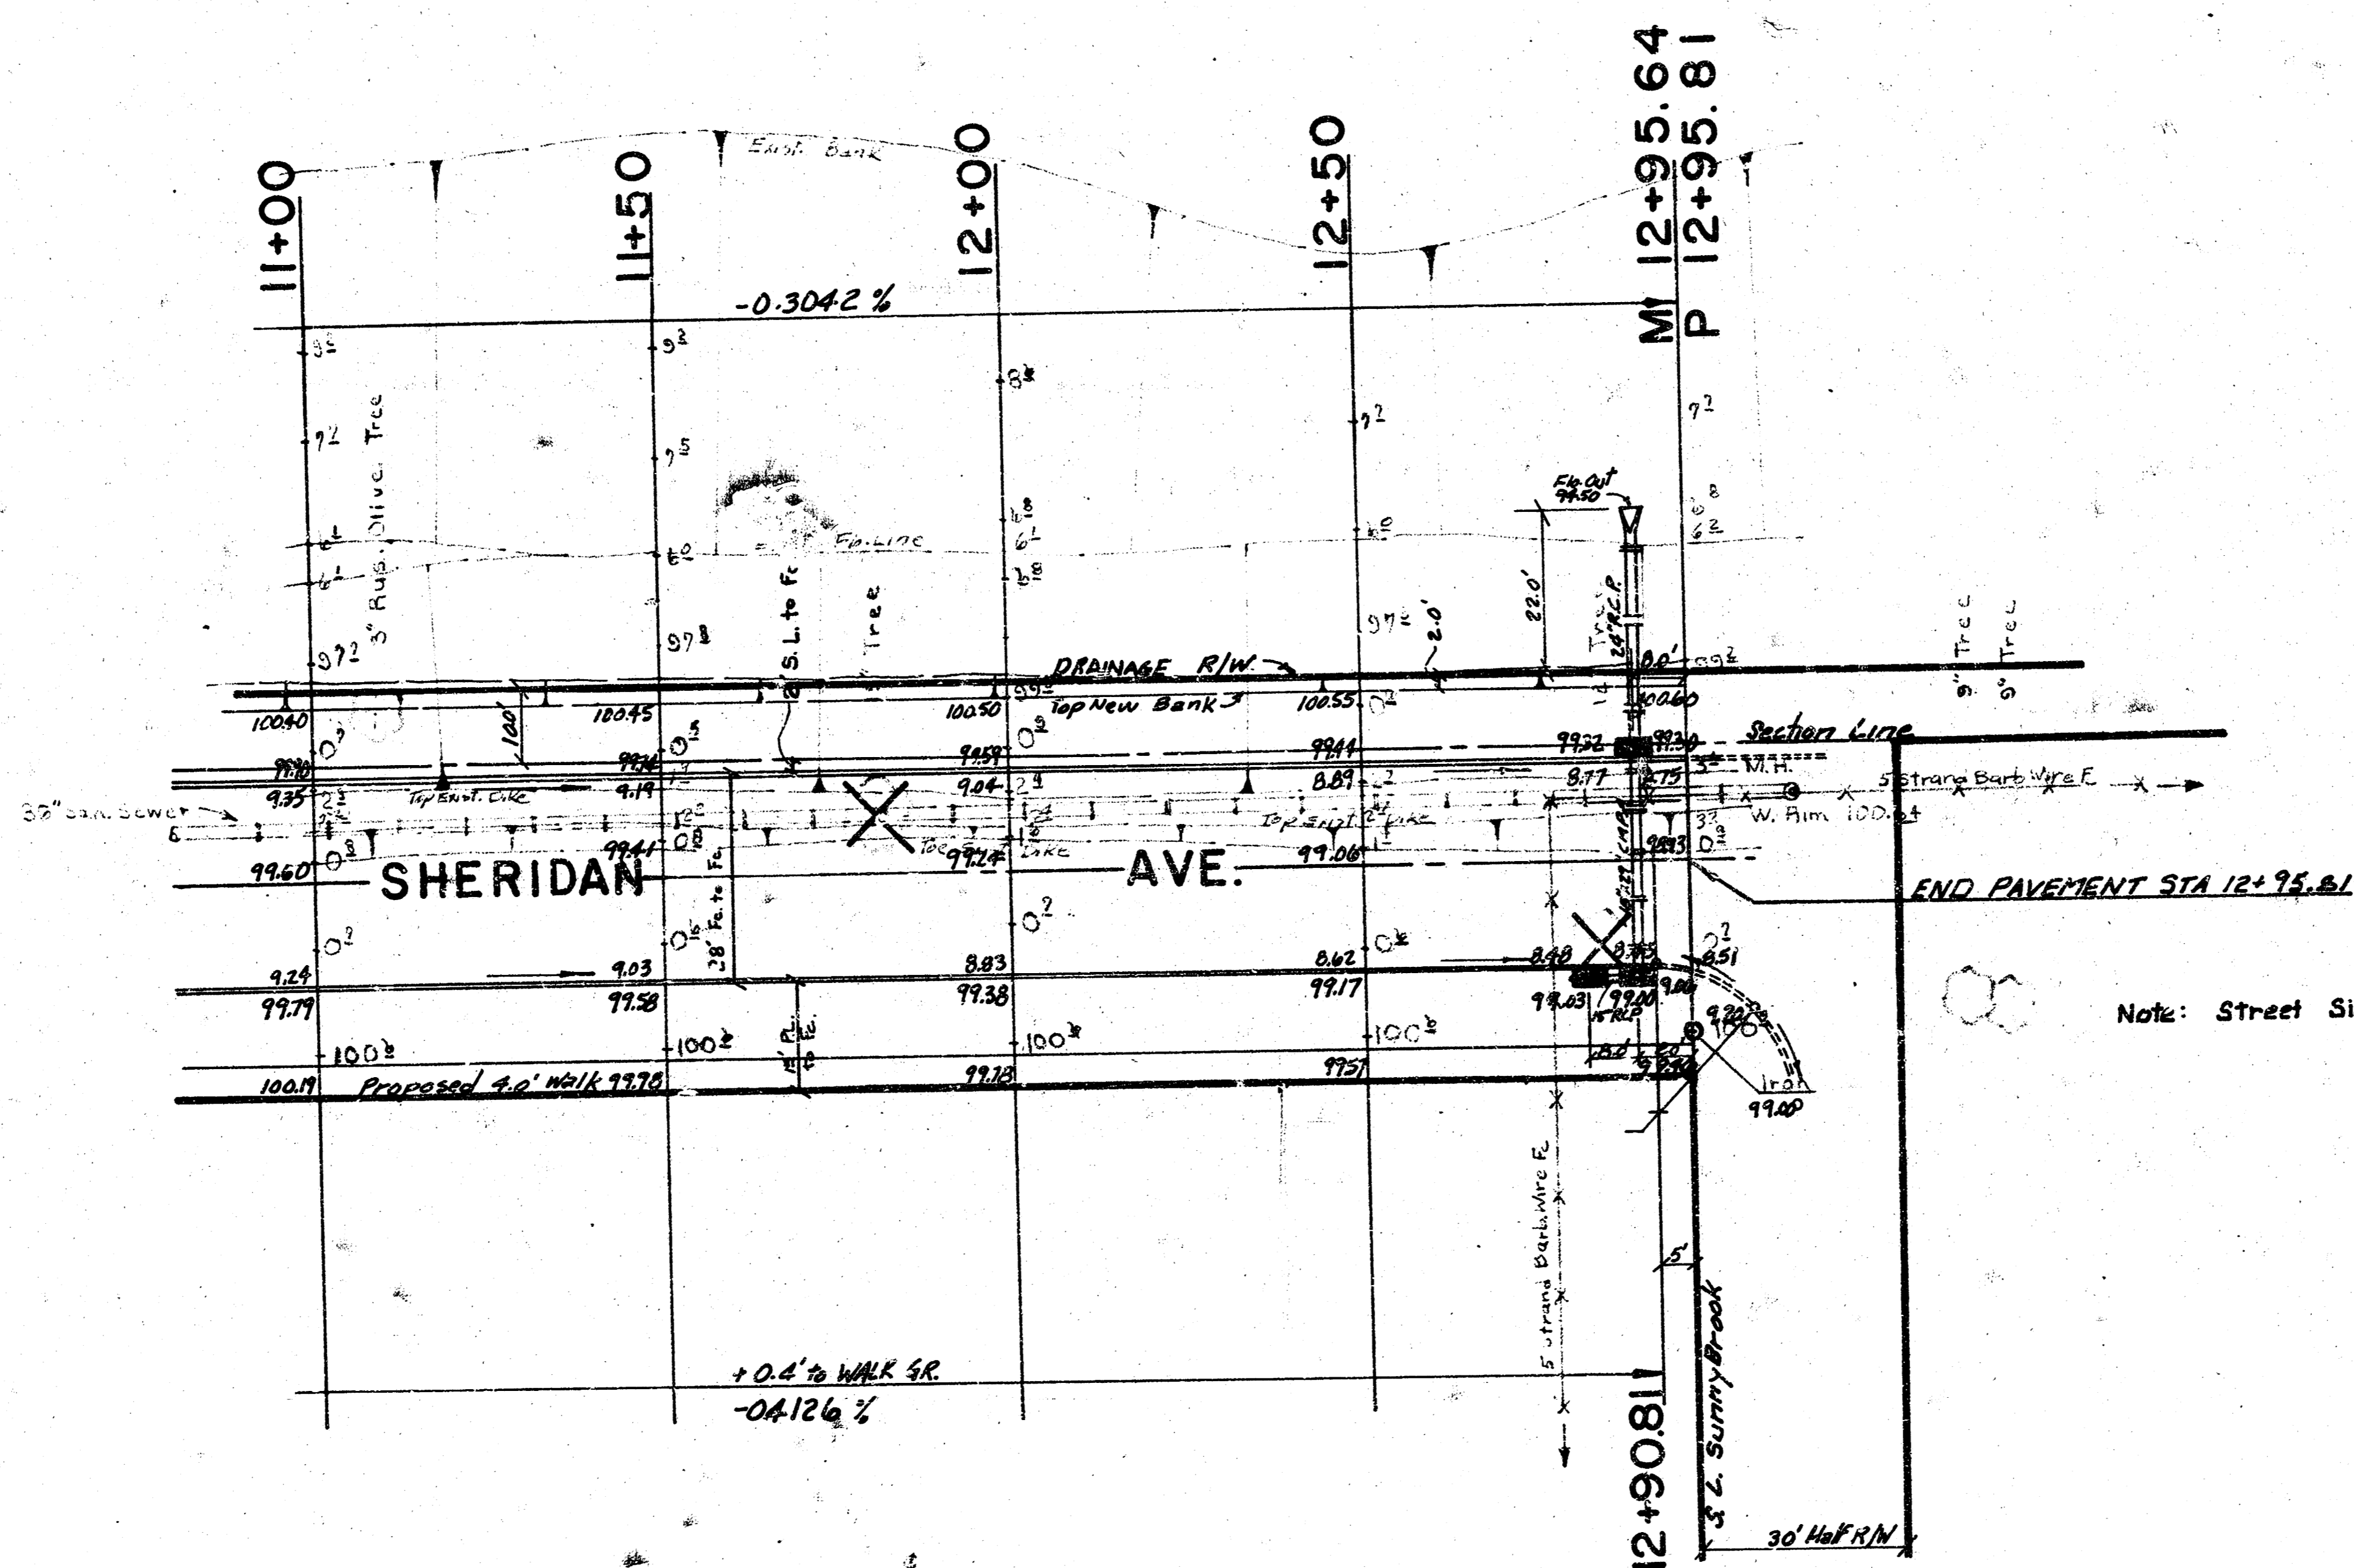

Note: Street Signing By "Others."

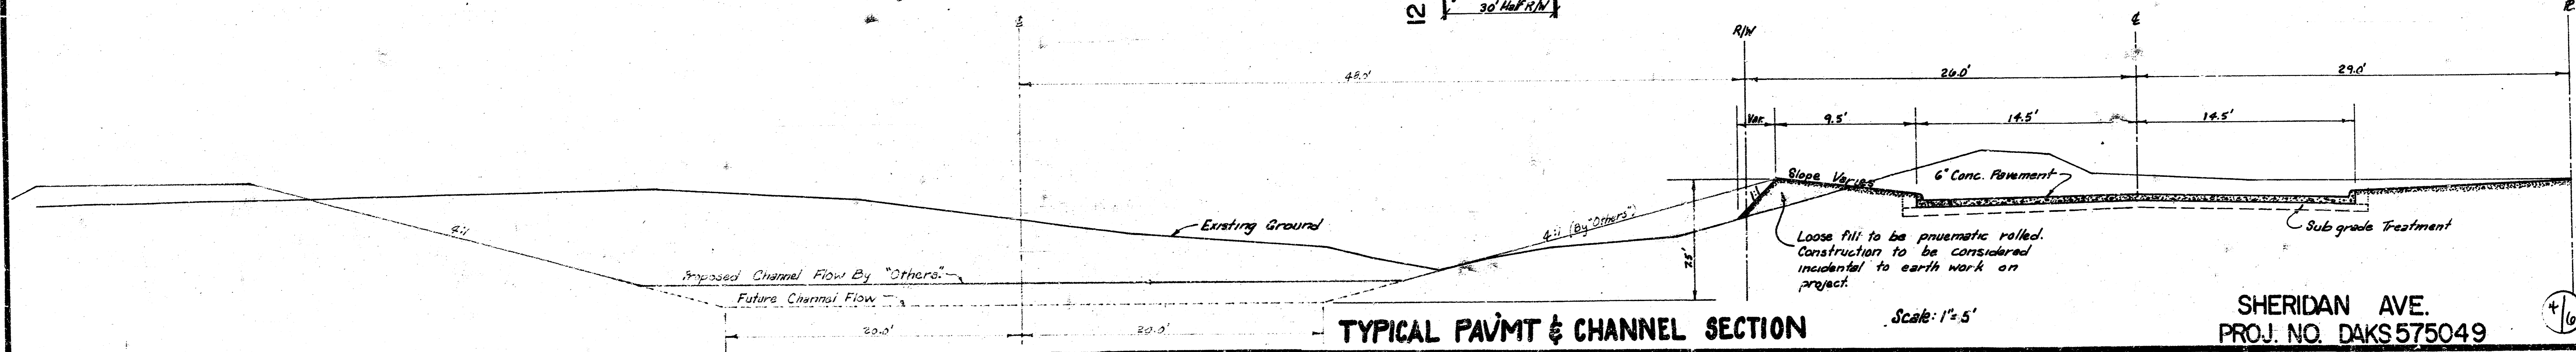

TYPICAL PAVMT & CHANNEL SECTION

Scale: 1" = 5'


SHERIDAN AVE.
PROJ. NO. DAKS575049

4/6

City of Wichita
344216

LINE "A"

LINE "B"

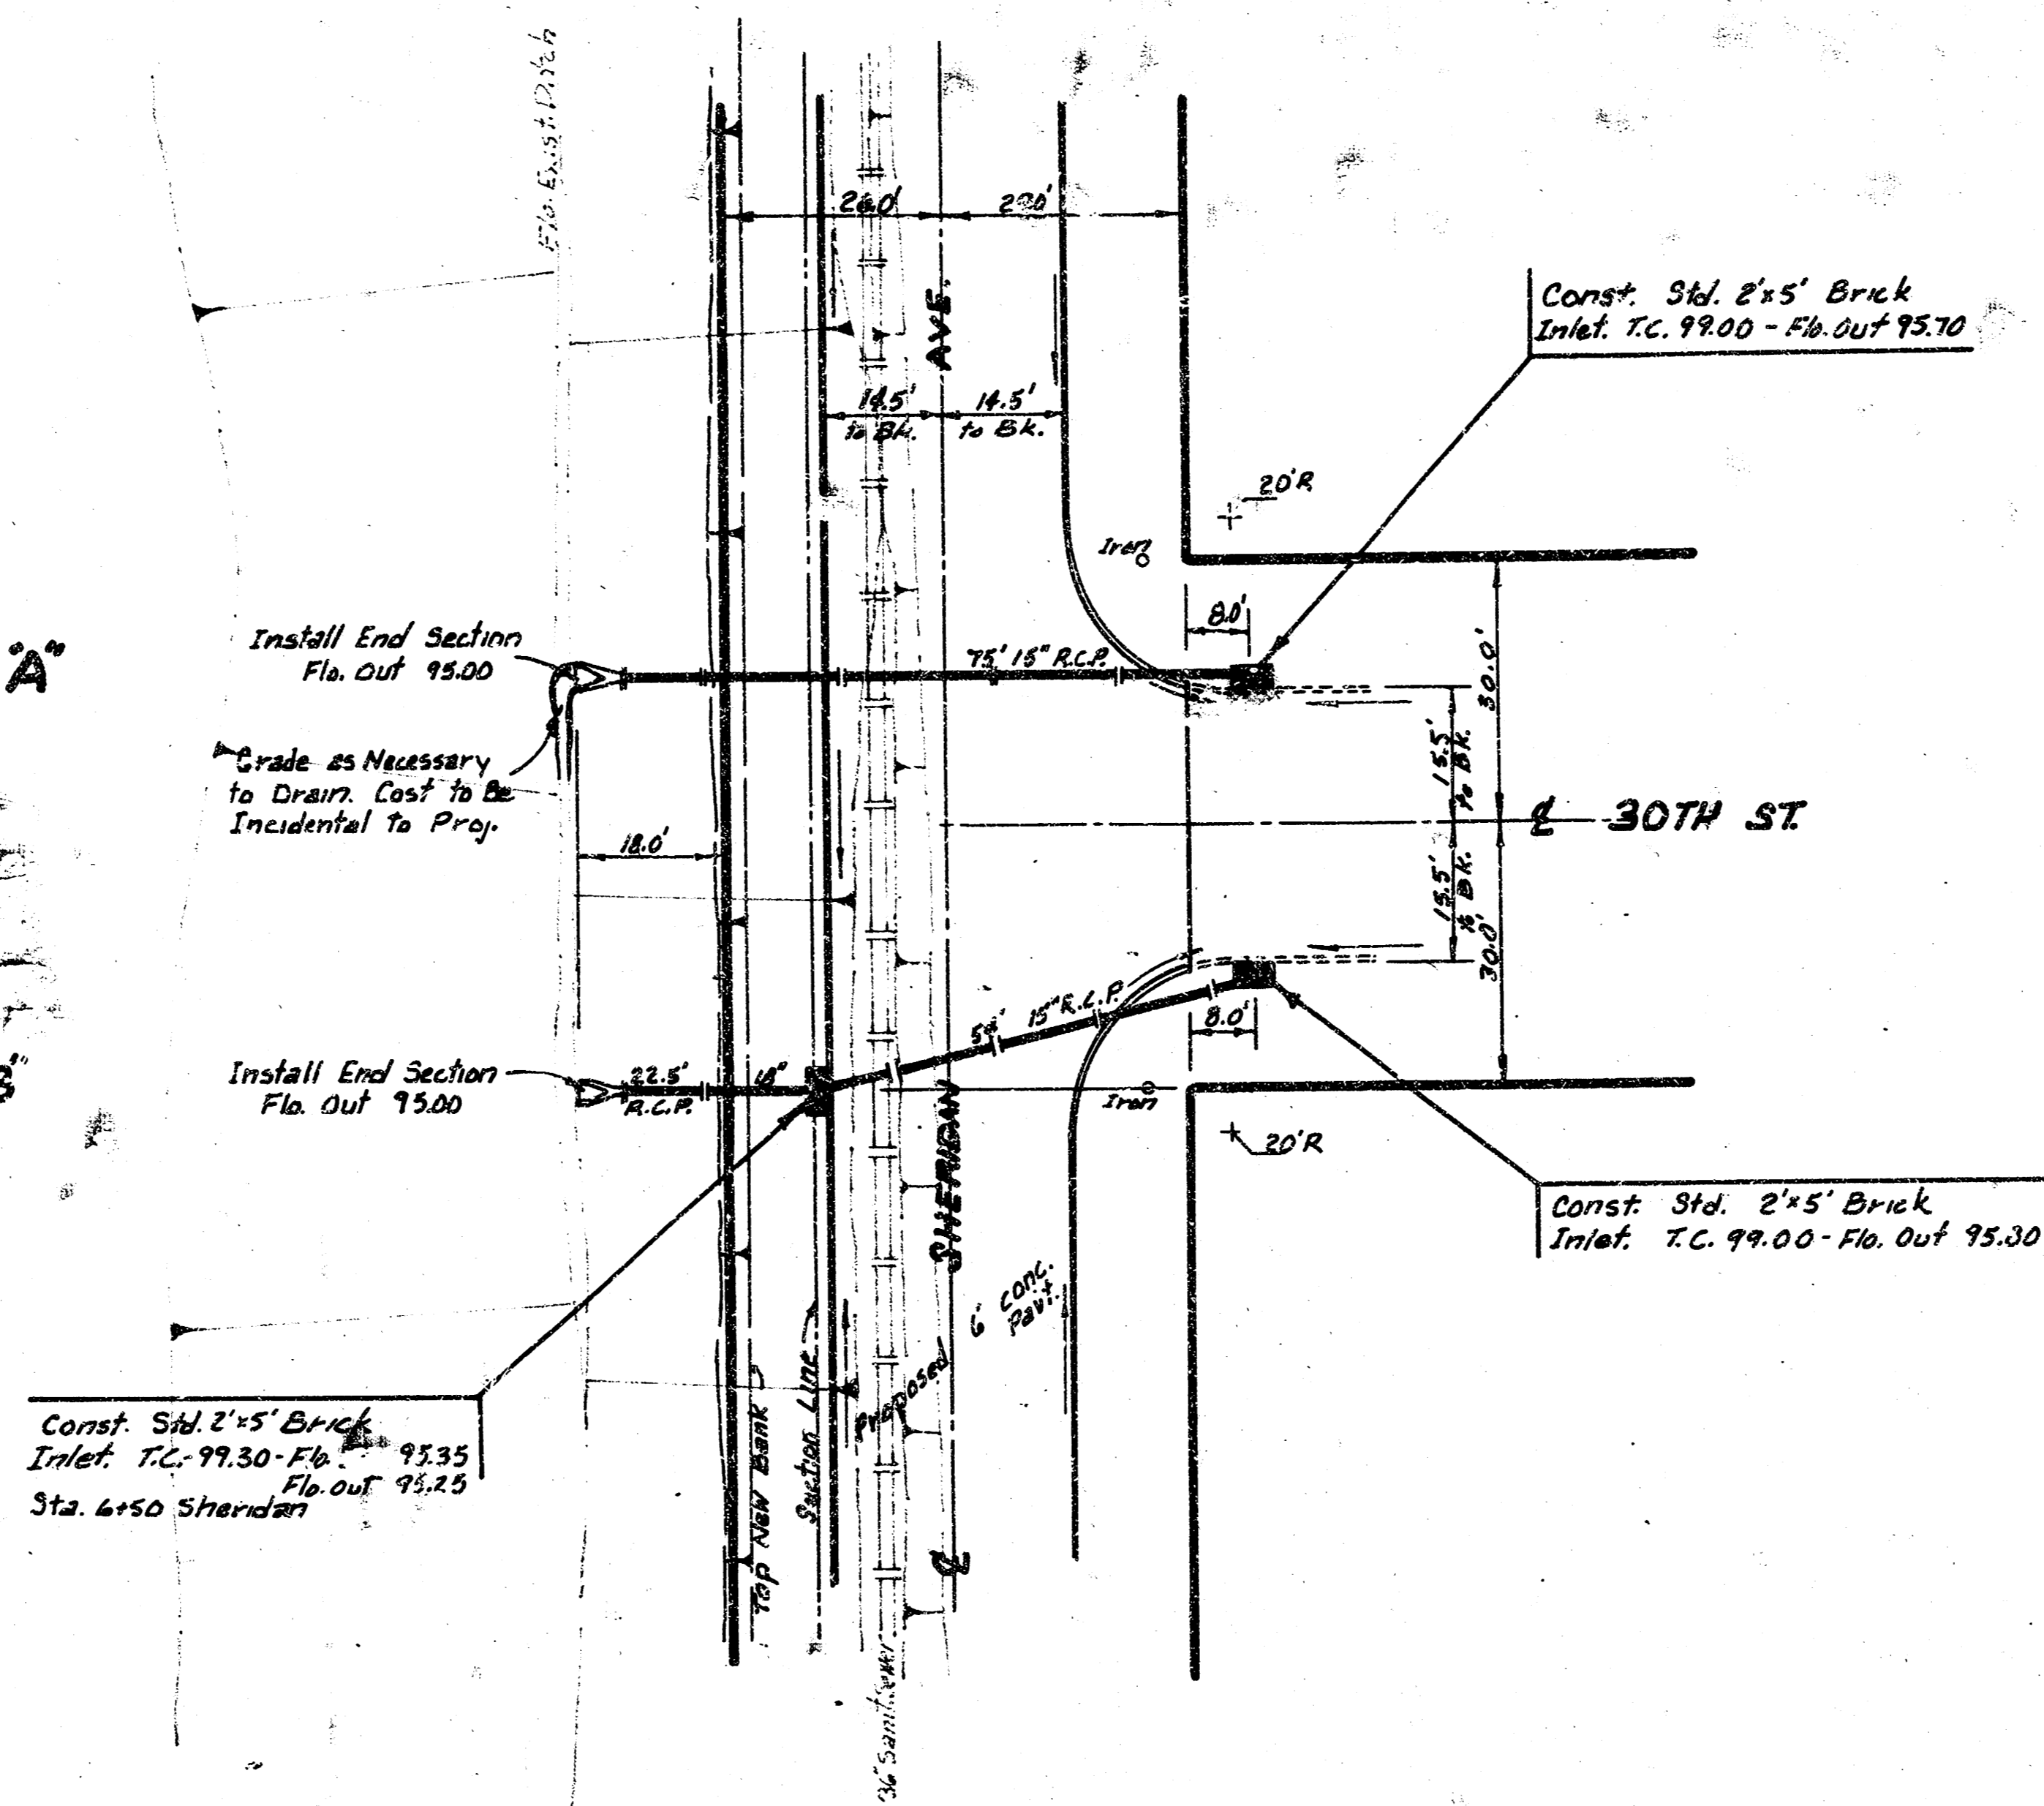

Install End Section
Flo. Out 95.00

Grade as Necessary
to Drain. Cost to Be
Incidental to Prop.

Install End Section
Flo. Out 95.00

Const. Std. 2'x5' Brick
Inlet T.C. 99.30 - Flo. Out 95.35
Sta. 4+50 Sheridan

Const. Std. 2'x5' Brick
Inlet T.C. 99.00 - Flo. Out 95.70


Const. Std. 2'x5' Brick
Inlet T.C. 99.00 - Flo. Out 95.30

Note: Cost for end sections to
be included in the price bid for pipe.
Cost for mechanically tamped backfill
to be incidental to project.

PLAN SCALE: 1" = 20'
PROFILE SCALE: 1" = 10' HORIZ.
1" = 5' VERT.

LINE "A"


LINE "B"

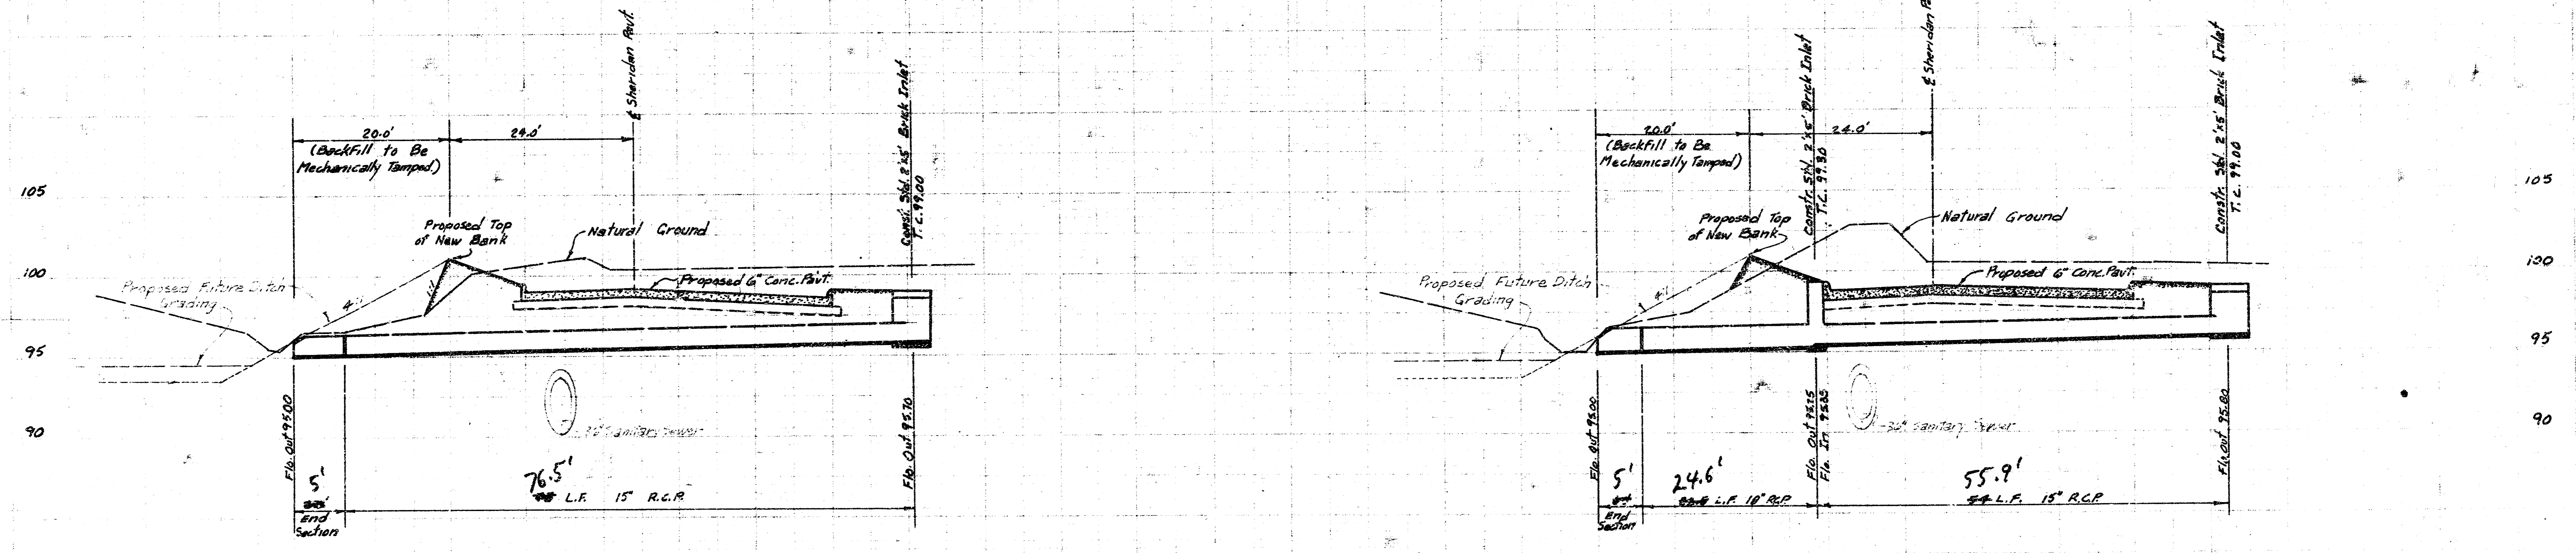

As Built 4-8-76


INCIDENTAL DRAINAGE
IN CONNECTION WITH THE PAVING
OF
SHERIDAN AVENUE
N.L. 31ST ST. SO. to N.L. SUNNYBROOK LN.
CITY OF WICHITA, KANSAS
R. W. LINN - CITY ENGINEER
DATE: APRIL 8, 1976

FILMED FROM THE BEST
AVAILABLE COPY

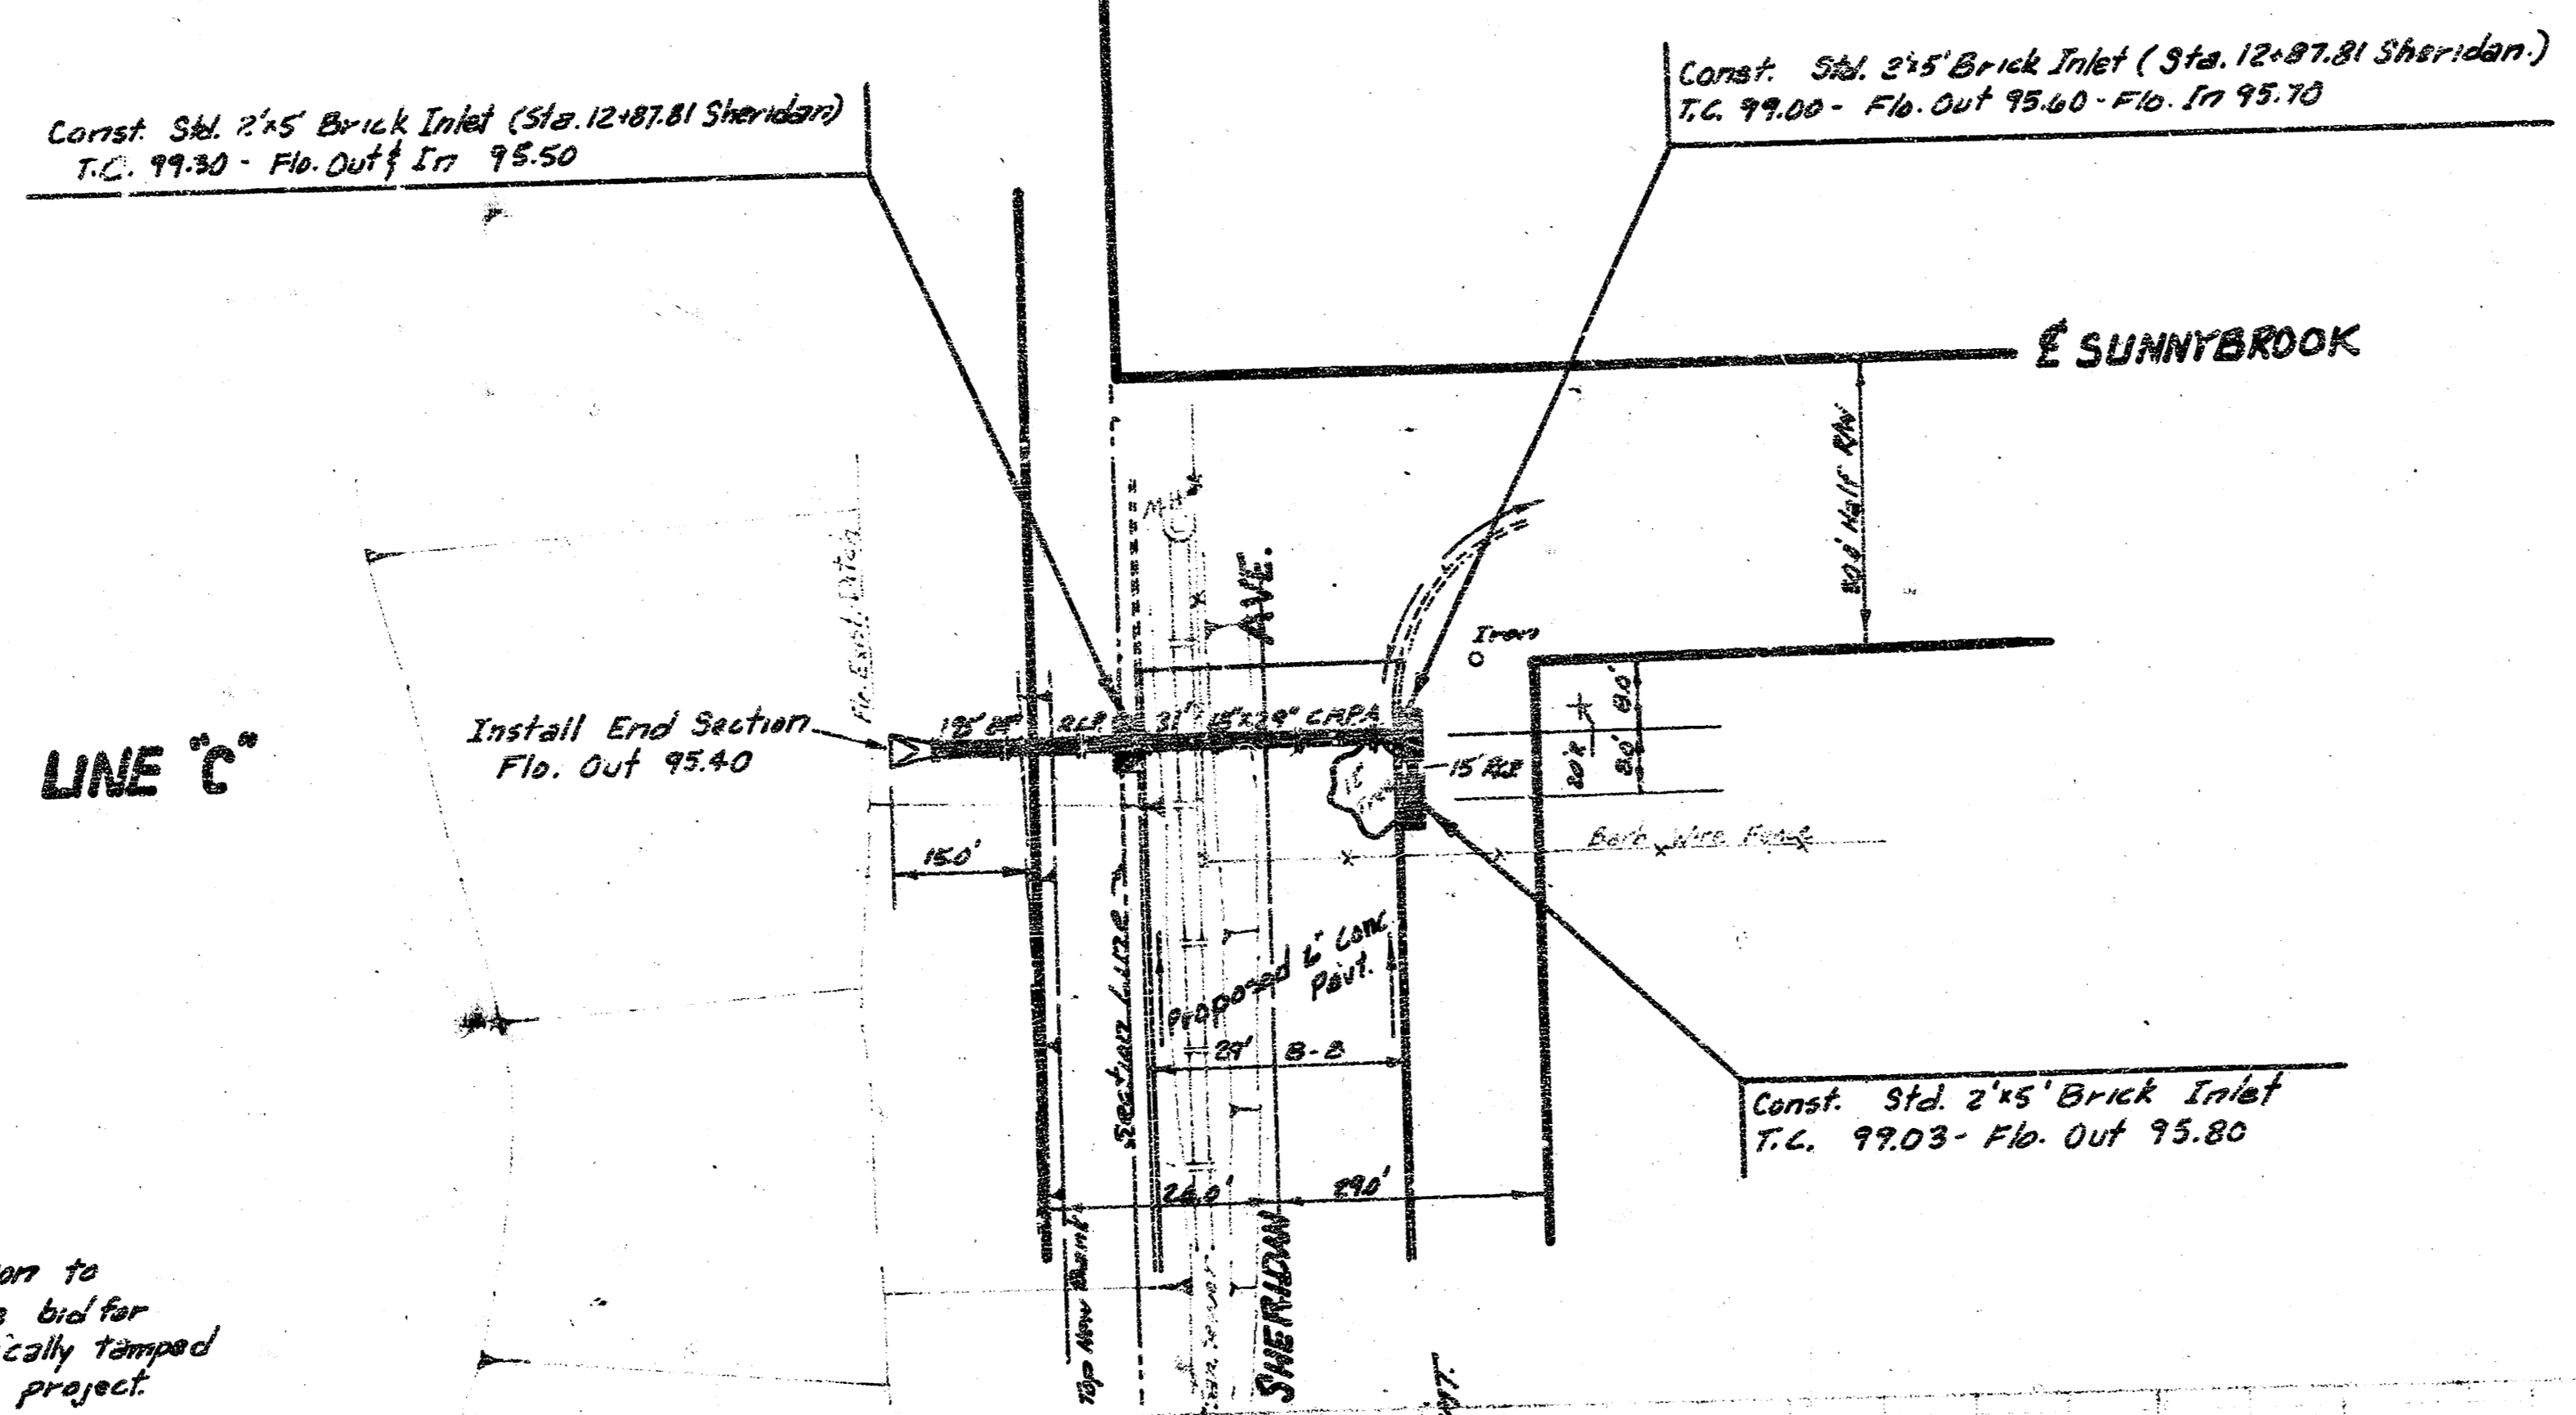

PLAN SCALE: 1" = 20'
 PROFILE SCALE: 1" = 10' HORIZ.
 1" = 5' VERT.

Note: Cost for end section to be included in the price bid for pipe. Cost for mechanically tamped backfill to be incidental to project.

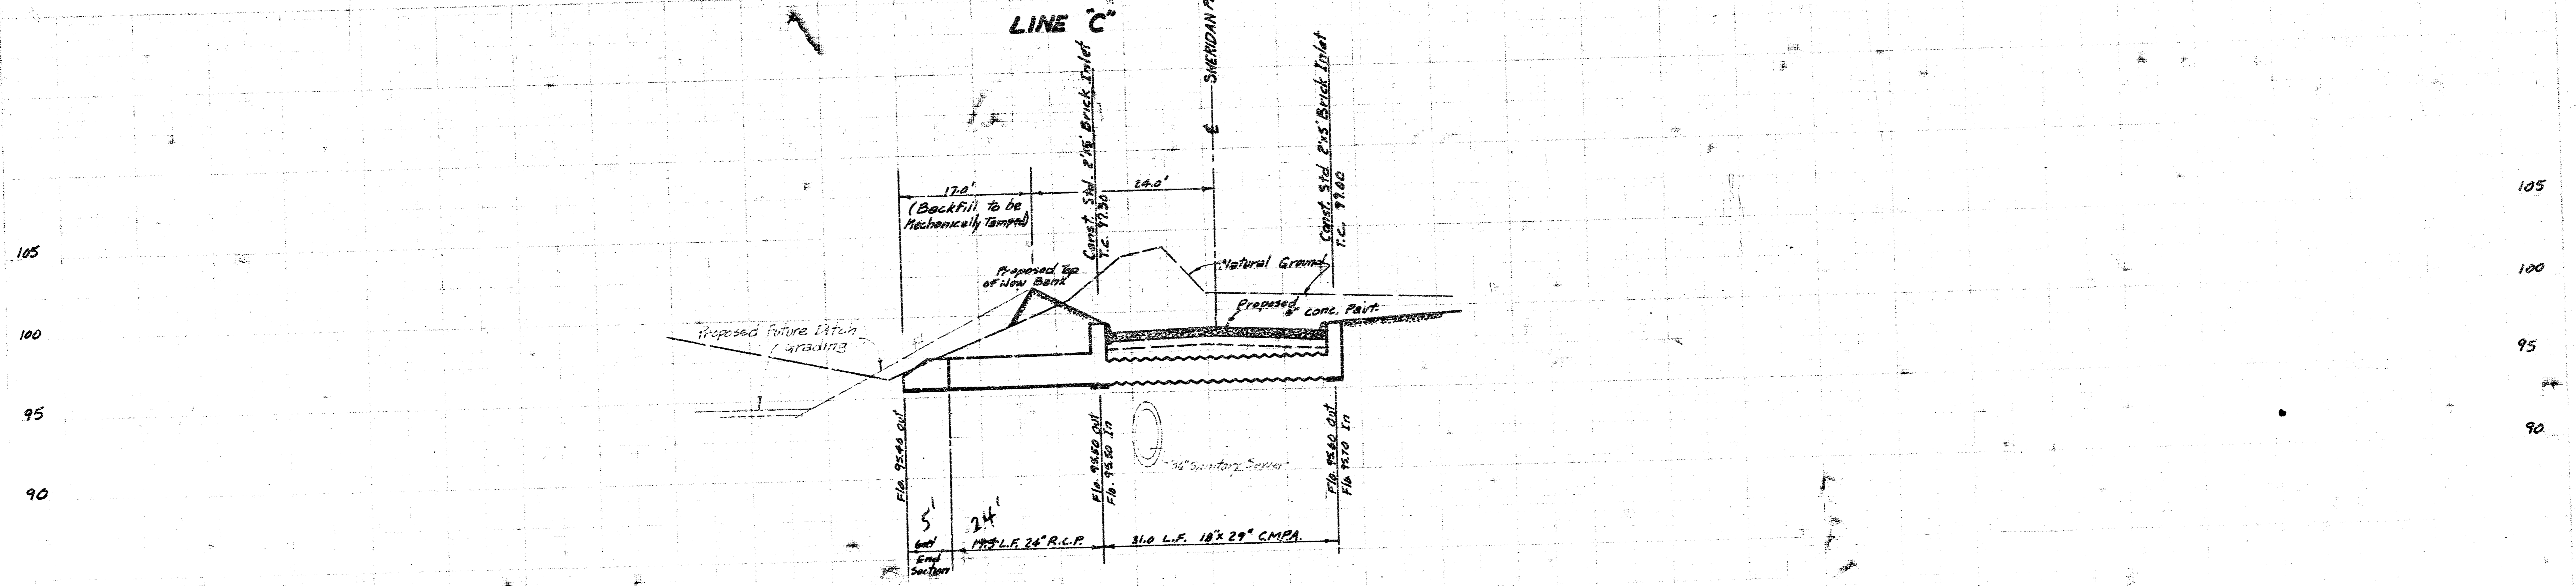

INCIDENTAL DRAINAGE
 IN CONNECTION WITH THE PAVING
 OF
 SHERIDAN AVENUE
 CARD 575019
 N.L. 31ST ST. SQ. 14 N.L. SUNNYBROOK LN. 6/163

FILMED FROM THE BEST AVAILABLE COPY