


B.M. 115.53 N.E. corner conc. porch
S.W. corner Taft & St. Paul.

Ties to IRON Sta. 0+30 & Taft & St. Paul
 1. 24.70' E. to nail in washer in S. face p. pole.
 2. 71.66' S.S.W. to nail in washer E. face p. pole.
 3. 48.31' N.N.W. to nail in washer W. face p. pole.
 4. 80.38' N.E. to nail in washer W. face p. pole.

NOTE:
 Contractor to clear right-of-way & grade
 parkings for proposed sidewalk. Sidewalk
 to be constructed by others.

Scale: 1"=20'

NOTE: Notify the Sewer Maintenance Division before removing trees.
 The Sewer Maintenance Division has requested the
 removal of the trees located near the sewer
 pipe. Use caution in removing these trees.

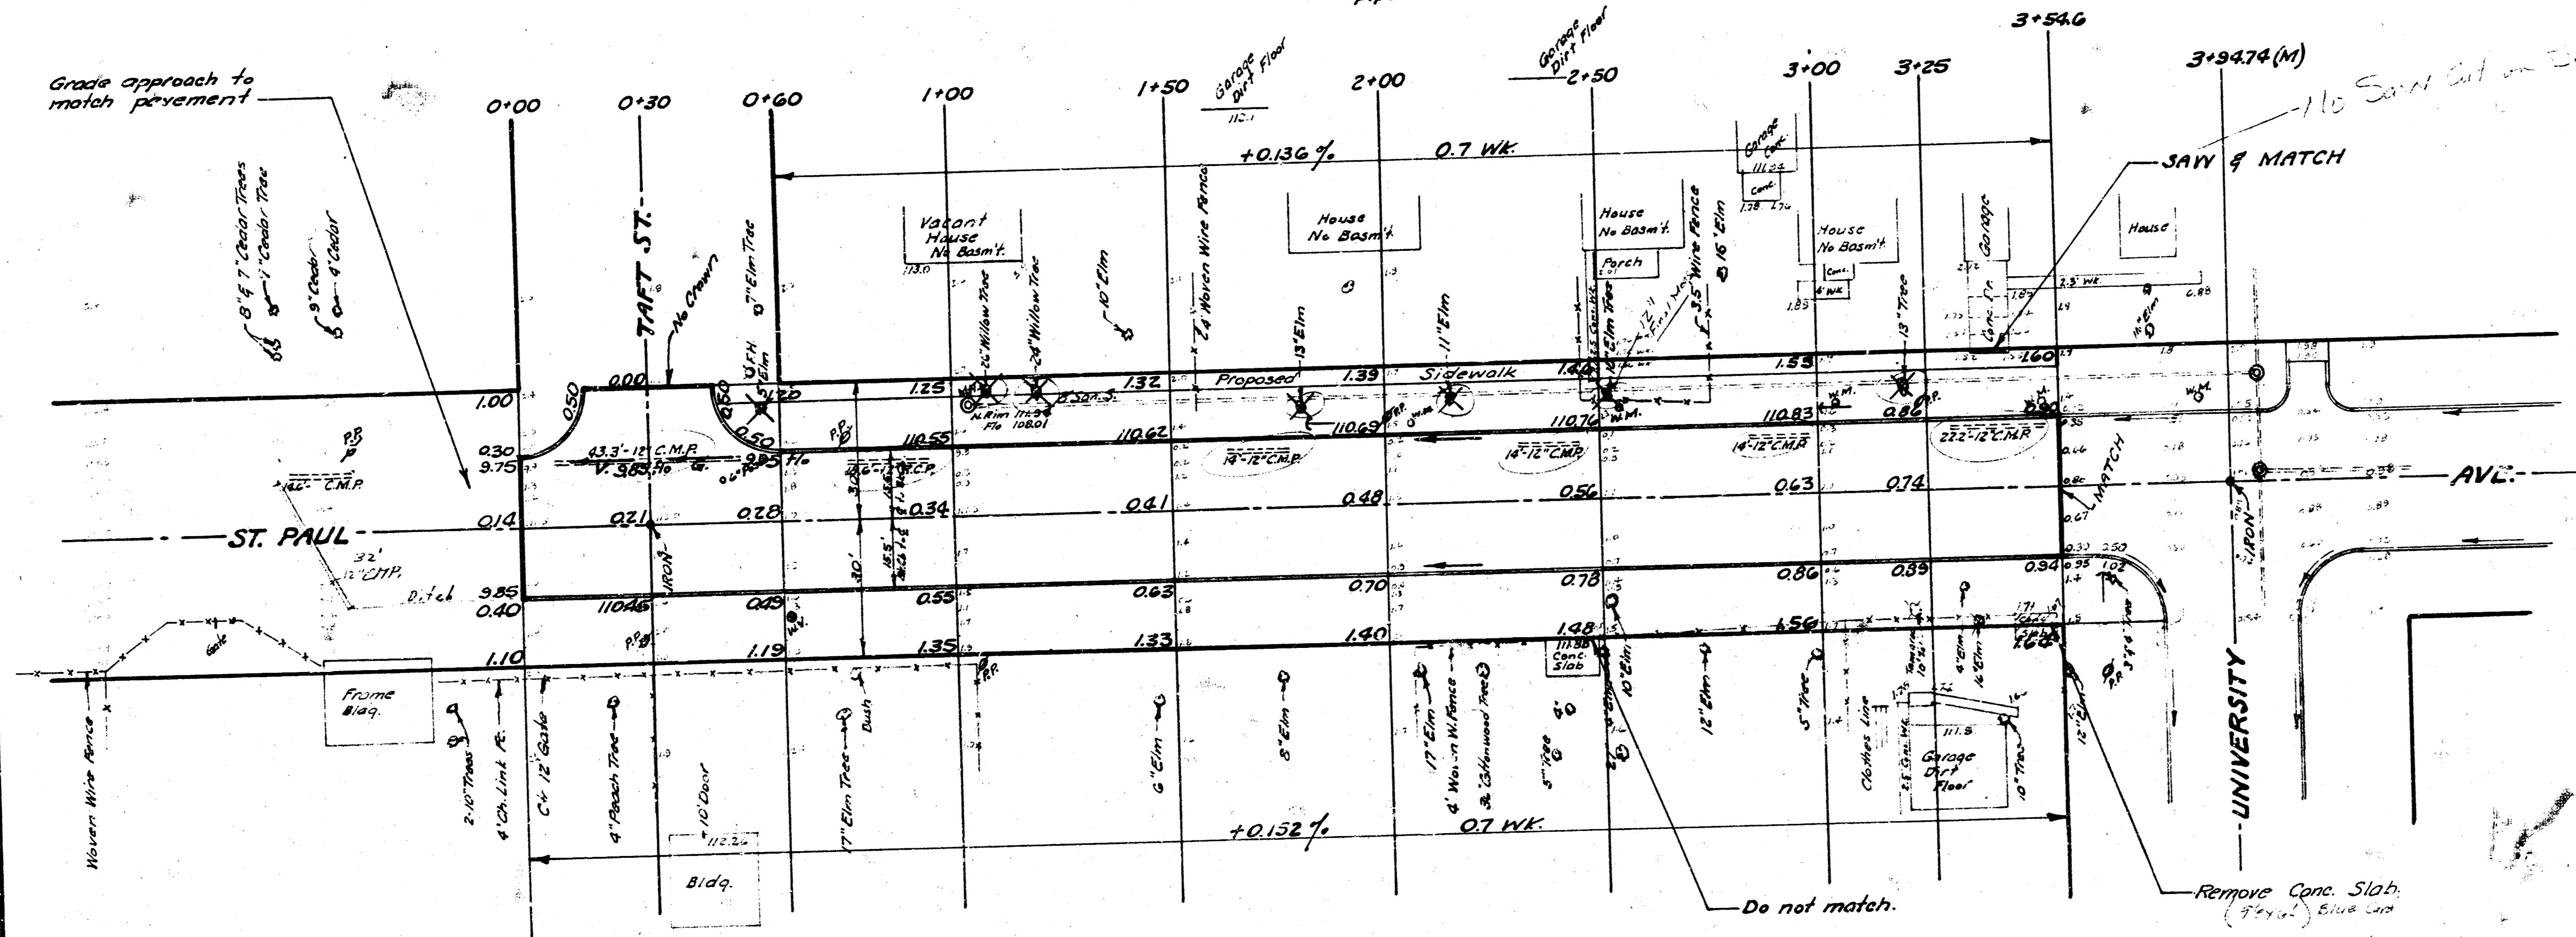

EXCAVATION	
PROPERTY	CITY
686 Cu. Yds.	126 Cu. Yds.
+ 10% 69	13
Totals 755 Cu. Yds.	139 Cu. Yds.

COMPACTED FILL (Subgrade Modification)
 200 Cu. Yds. 30 Cu. Yds.

Field Engineer to contact office prior to using any
 cement for subgrade treatment.

ST. PAUL AVE.
 S.L. TAFT STREET to
 S.L. UNIVERSITY AVE.
 6" Conc. 31' & Curb.
 R.W. LINN CITY ENGINEER
 CITY OF WICHITA KANSAS
 Date: MAY 1978
 Project No. DAKS 571048



1/2