
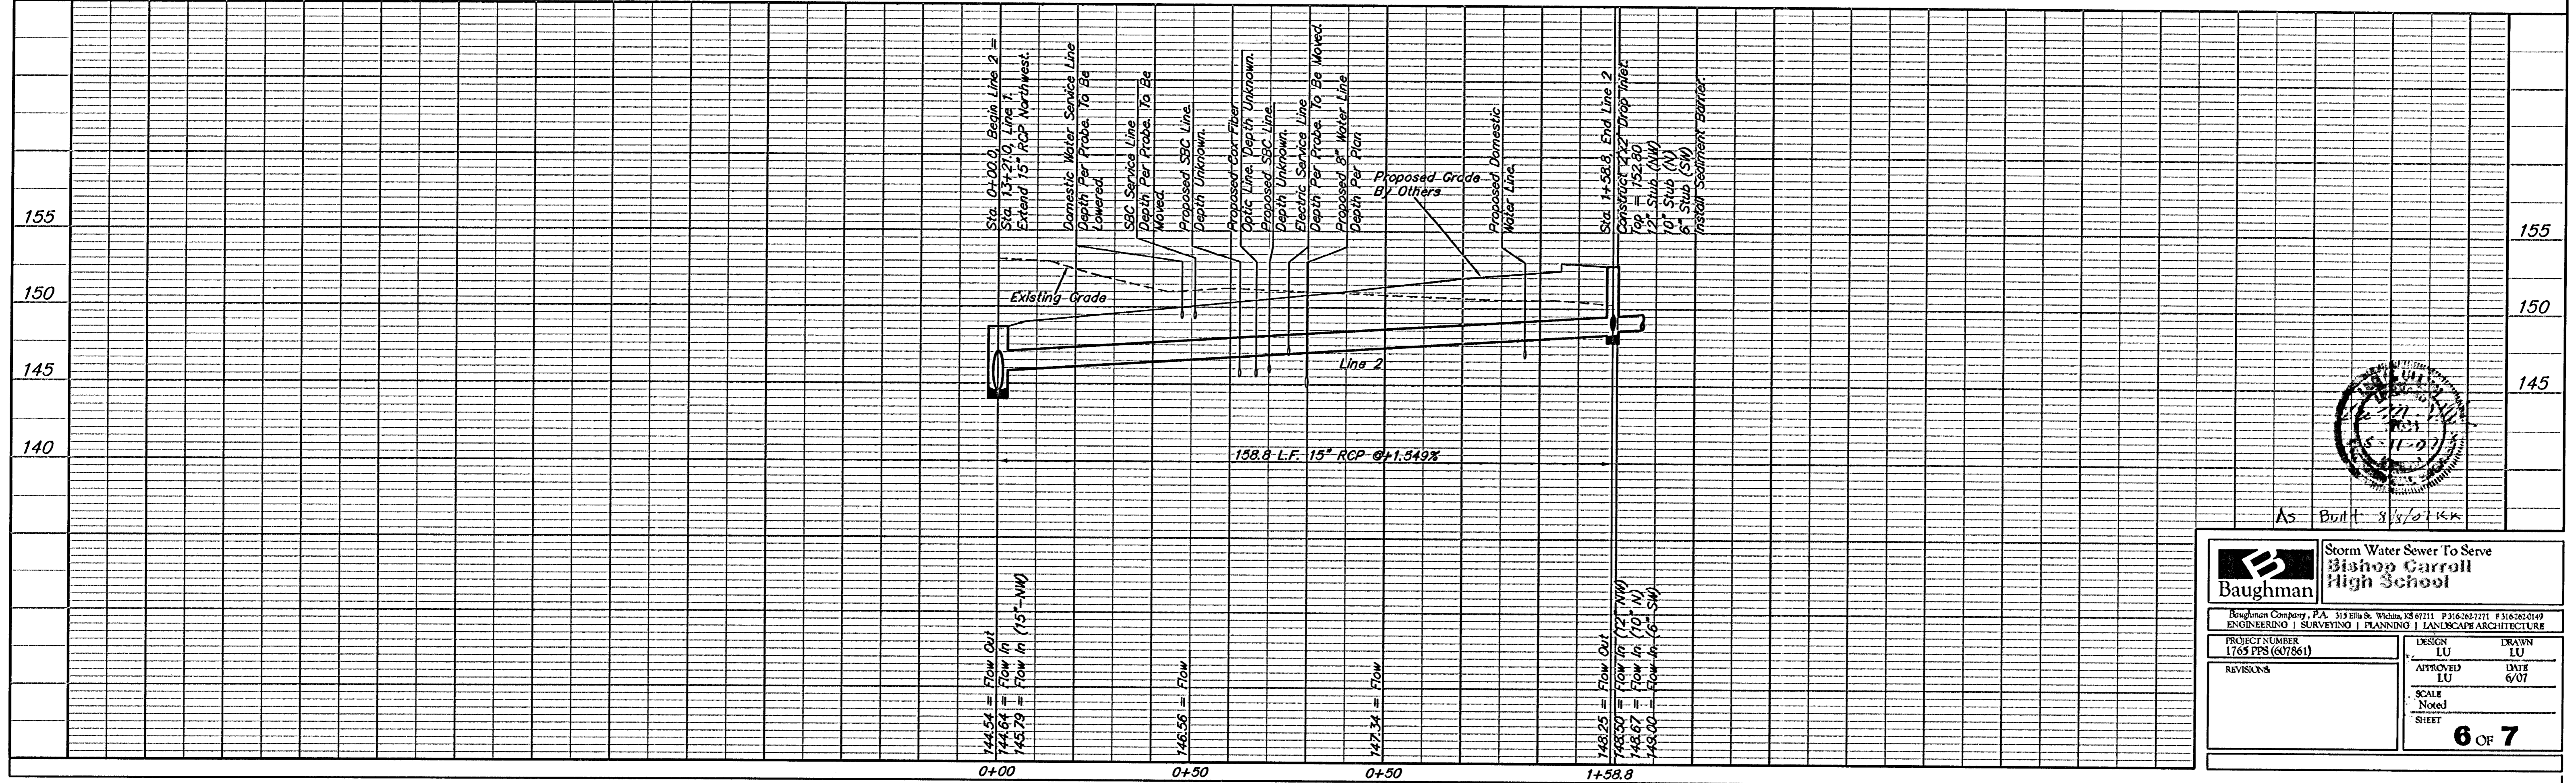


Bench Marks:

Woodchuck & Central
City of Wichita Bench Mark.
52.00 ft. North of center line.
24.00 ft. West of center line.
Elevation = 154.05 (City Datum)

SCALE:
1" = 20' HORIZONTAL
1" = 5' VERTICAL

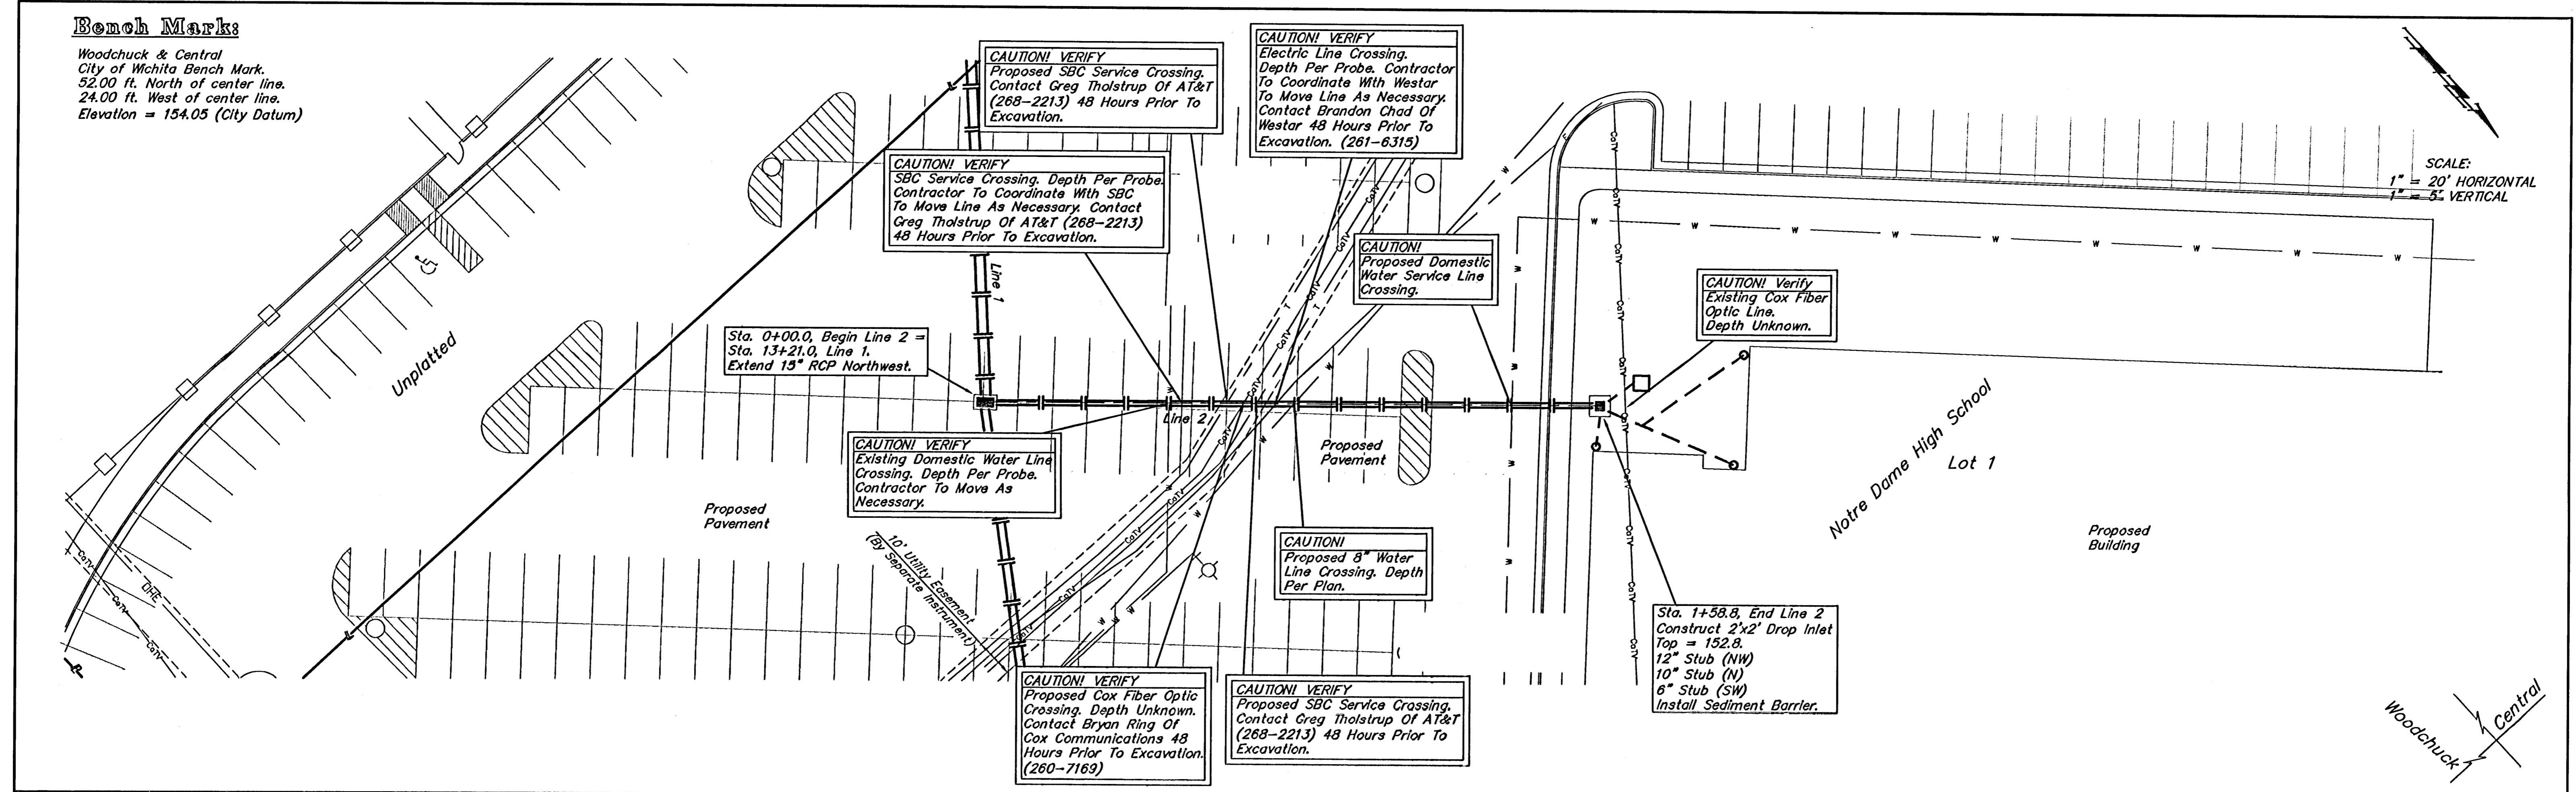

As Built 8/5/14

Baughman		Storm Water Sewer To Serve Bishop Carroll High School	
Baughman Company, P.A. 315 Ellis St. Wichita, KS 67211 P316-627271 F316-265049 ENGINEERING SURVEYING PLANNING LANDSCAPE ARCHITECTURE			
PROJECT NUMBER 1765 PPS (607861)	DESIGN LU	DRAWN LU	
REVISIONS	APPROVED LU	DATE 6/07	
	SCALE None	SHEET 6	7