

PHASE 1 PRIVATE STREET IMPROVEMENTS FOR TOWNE PARC 2ND ADDITION

LINDEN: FROM THE S.L. LOT 9, BLOCK 1, TOWNE PARC 2ND ADDITION TO THE S.L. CARSON

Project No.


472-76-245-80001-000-000-044

City of Wichita, Kansas - Michael E. Lindebak, City Engineer


ONLY THE PAVEMENT INDICATED BELOW WILL BE CONSTRUCTED WITH THIS PROJECT

Index to the Plans

Title Sheet	1
Typical 35' (7" A.C.) Pavement Section	2
Typical 29' (7" A.C.) Pavement Section	3
Plan Sheet; Linden Sta. 0+00 - 5+53.58	4
Plan Sheet; Linden & Scott Sta. 5+53.58 - 10+74.39	5
Plan Sheet; Scott Sta. 10+74.39 - 13+79.39	6
Plan Sheet; Linden Court Sta. 0+00 - 1+84.58	7
Plan Sheet; Linden Sta. 0+00 - 2+67	8
Plan Sheet; Scott Court Sta. 0+00 - 4+20.33	9
Incidental Drainage	10
Std. Type 1A Inlet Detail 6" x 5'-0" Opening	11
Std. Type 1A Inlet Detail 6" x 10'-0" Opening	12

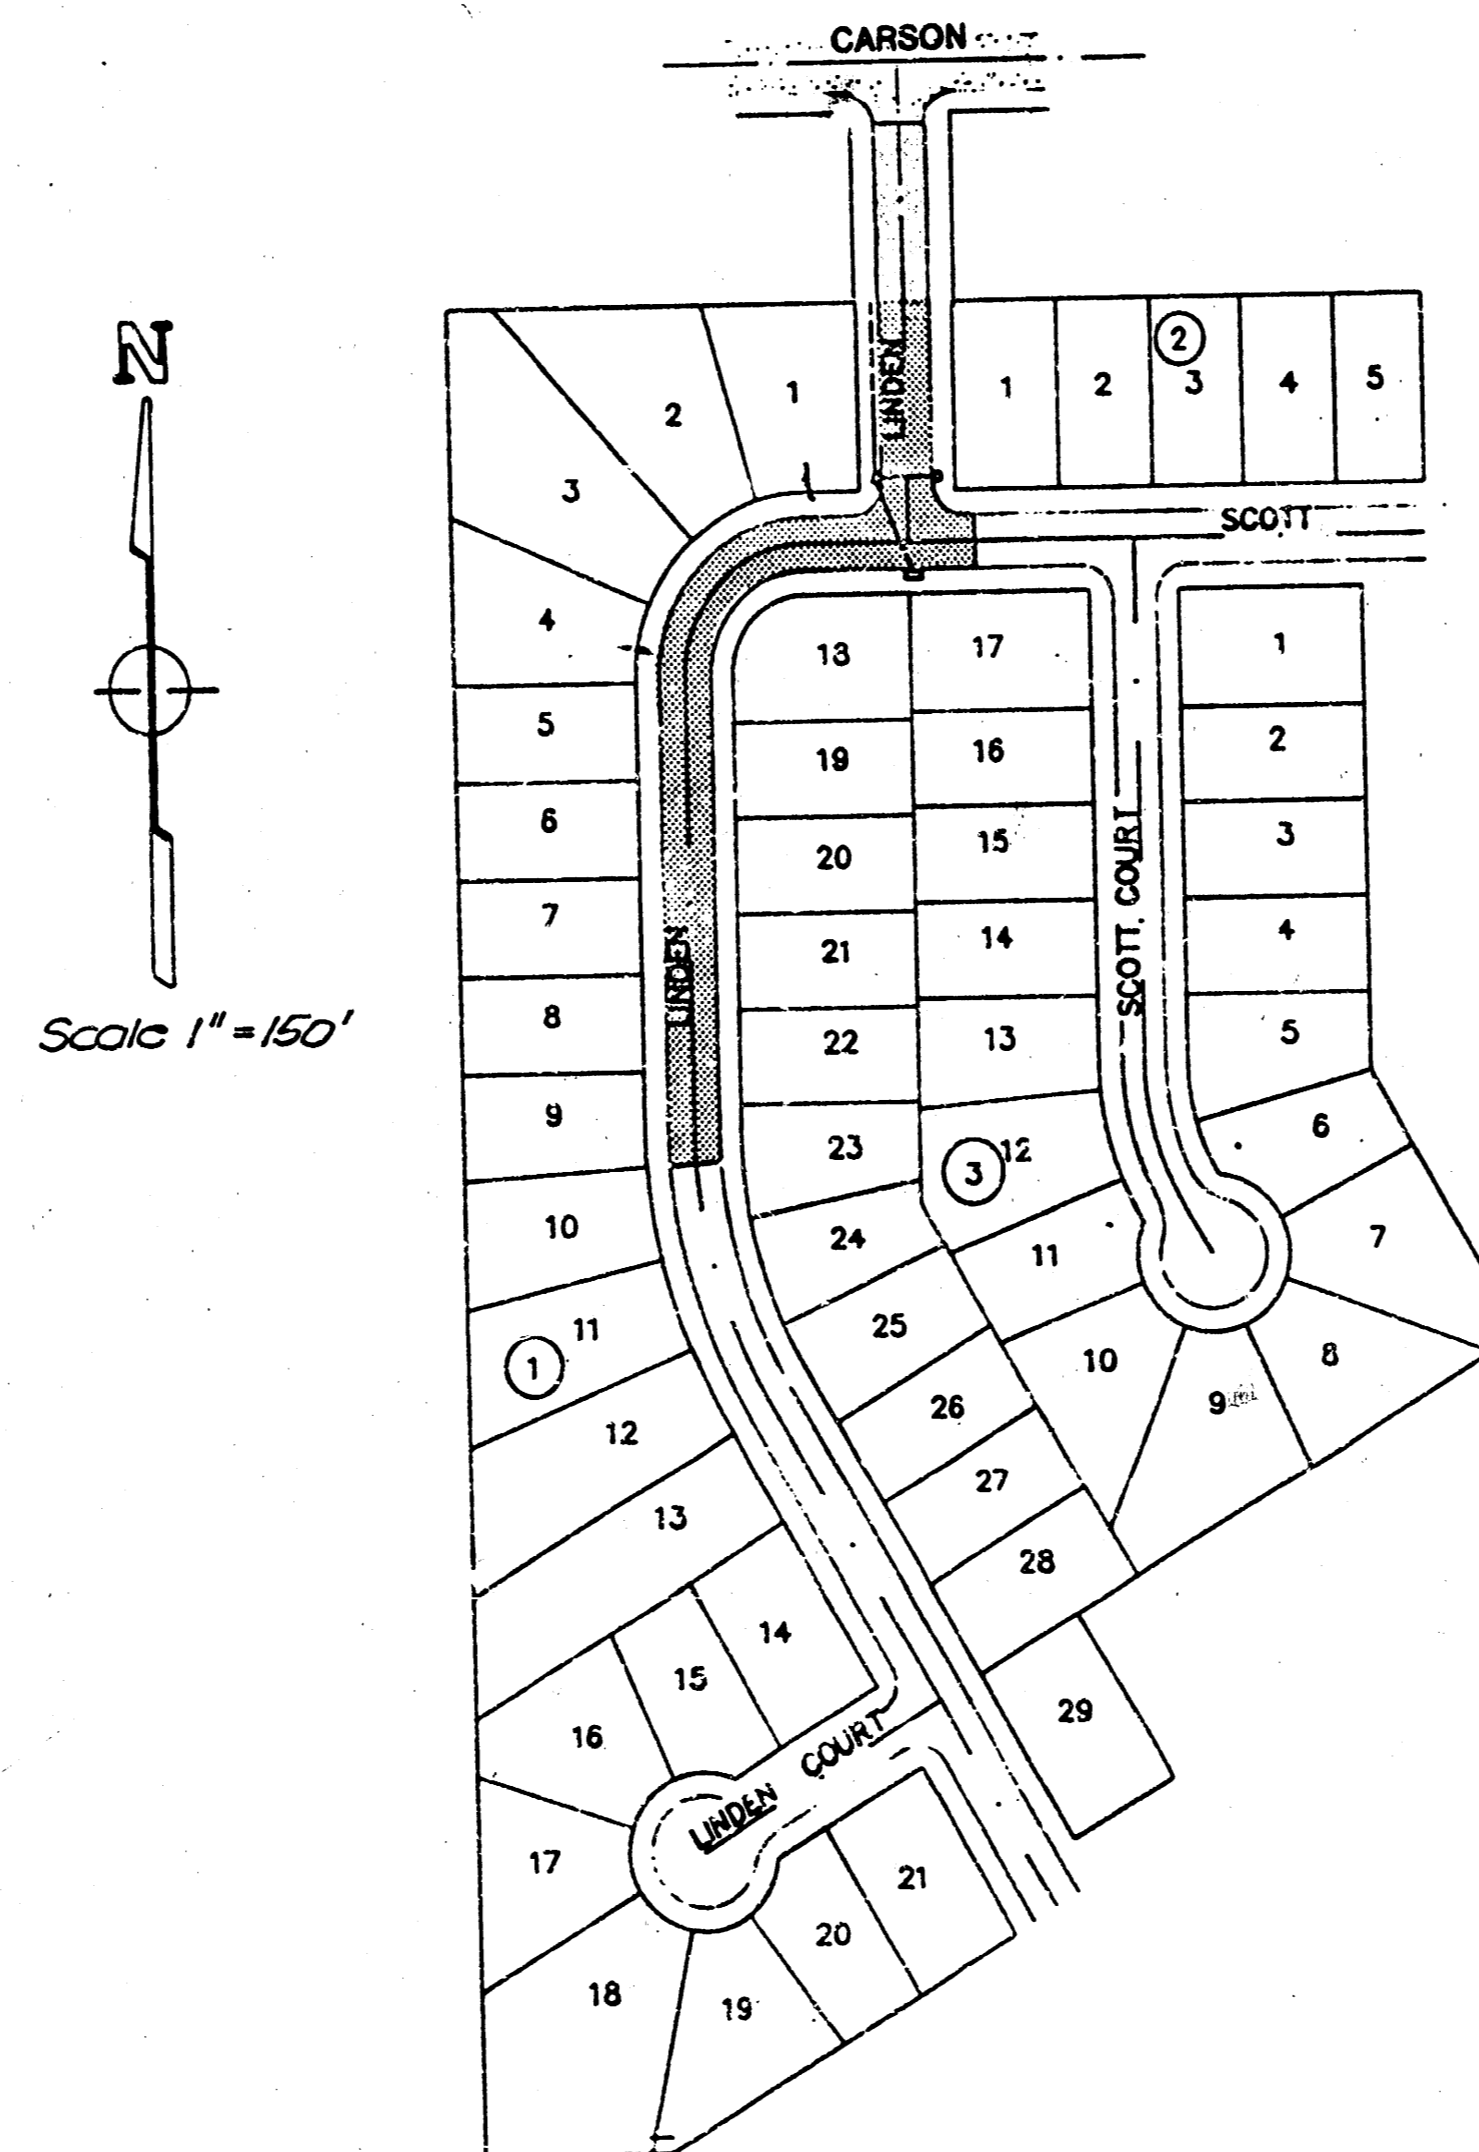

Location Map

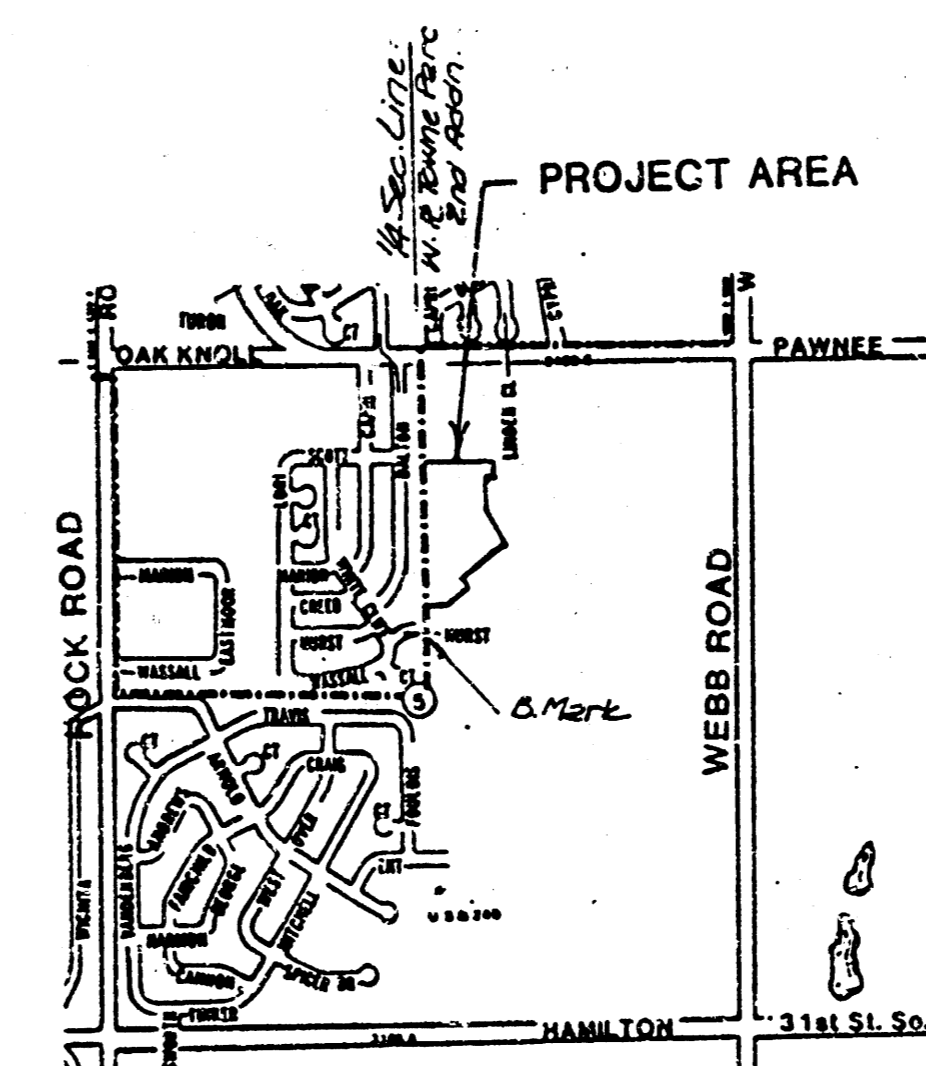

VICINITY MAP

General Notes

- Utility service lines, poles, valve boxes, meters, and etcetera are to be adjusted as necessary by others prior to construction unless the plans specifically call for their adjustment by the Contractor or unless the plans specifically identify a utility to be adjusted by its owner during construction. Existing utilities and their location, as shown on the plans, represent the best information obtainable for design. The contractor will be required to work around existing utilities within the right-of-way which do not conflict with proposed construction.
- The Contractor shall be responsible for preserving property irons. The Contractor will be required to re-establish any property irons which are damaged or destroyed by his construction operations. Such irons shall be re-established by a licensed land surveyor in accordance with state laws.

CONSTRUCTION AND MAINTENANCE FOR THIS PROJECT TO BE PROVIDED BY A LICENSED CONSULTING ENGINEER UNDER CONTRACT WITH THE KANSAS DEPARTMENT OF TRANSPORTATION AND HIGHWAYS WITH THE CITY OF WICHITA STAFFING CONSTRUCTION ENGINEERING PRACICES AND COSTS SHALL BE PERFORMED BY DESIGNATED ENGINEERS OF THE PUBLIC RIGHT-OF-WAY BY THE CONTRACTOR WITHIN THE PUBLIC RIGHT-OF-WAY SHALL ANY WORK BE CONSIDERED A PUBLIC RIGHT-OF-WAY OR PUBLIC RIGHT-OF-WAY WITHOUT WRITTEN AUTHORIZATION BY THE CITY ENGINEER

AS NOTED
CITY ENGINEER OF WICHITA


Water Mains _____
Sewer _____
Irrigation _____
Filing VRH 8/10/88



1/2


Rev. As-built 12-20-88 (Sheets 4, 5, 6, 8, 10)
BAUGHMAN COMPANY P. A.
SURVEYING & ENGINEERING
316/282-7271 • 315 ELLIS • WICHITA, KANSAS 67211

TYPICAL 35' PAVEMENT DETAILS

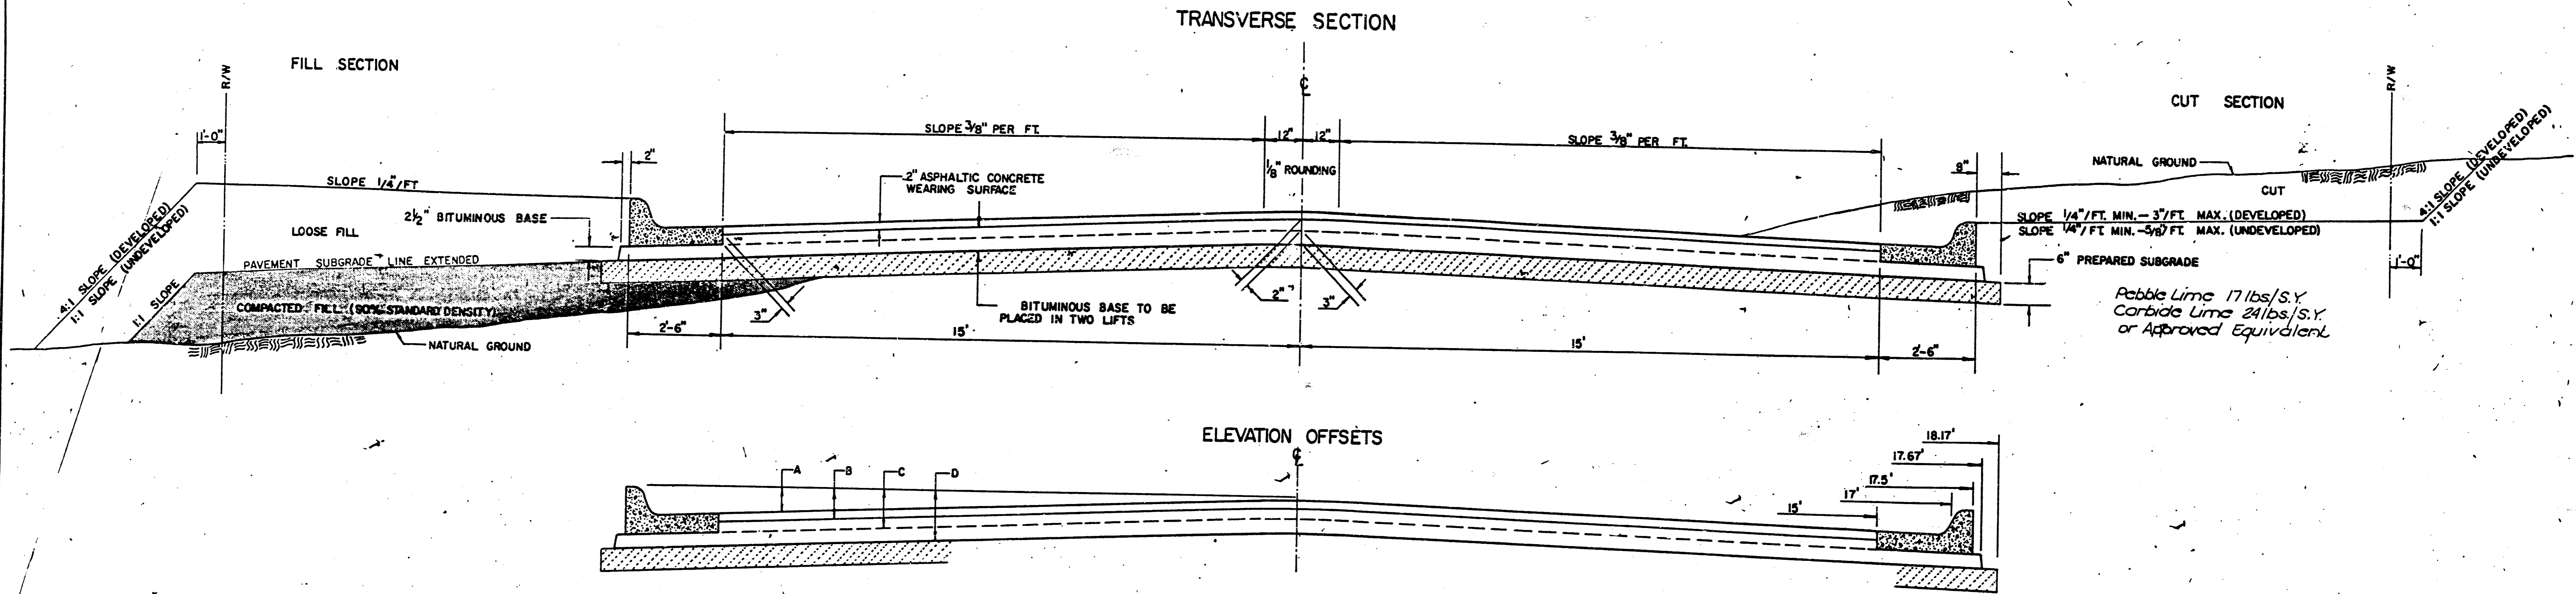


	DISTANCE FROM CENTERLINE (LT. & RT.)												
	0'	2'	4'	6'	8.5'	10'	12'	14'	15'	17'	17.5'	17.67'	18.17'
A: TOP OF CURBS TO TOP OF SURFACE LIFT	0.04	0.08	0.14	0.21	0.29	0.33	0.35	0.46	0.49	—	—	—	—
B: TOP OF CURBS TO TOP OF UPPER BASE LIFT	0.21	0.25	0.31	0.37	0.45	0.50	0.56	0.62	0.65	—	—	—	—
C: TOP OF CURBS TO TOP OF LOWER BASE LIFT	0.37	0.43	0.50	0.57	0.67	0.72	0.79	0.87	0.90	0.98	1.00	1.00	—
D: TOP OF CURBS TO TOP OF SUBGRADE	0.62	0.67	0.74	0.81	0.90	0.95	1.02	1.08	1.12	1.19	1.21	1.21	1.23

COMBINED CURB & GUTTER

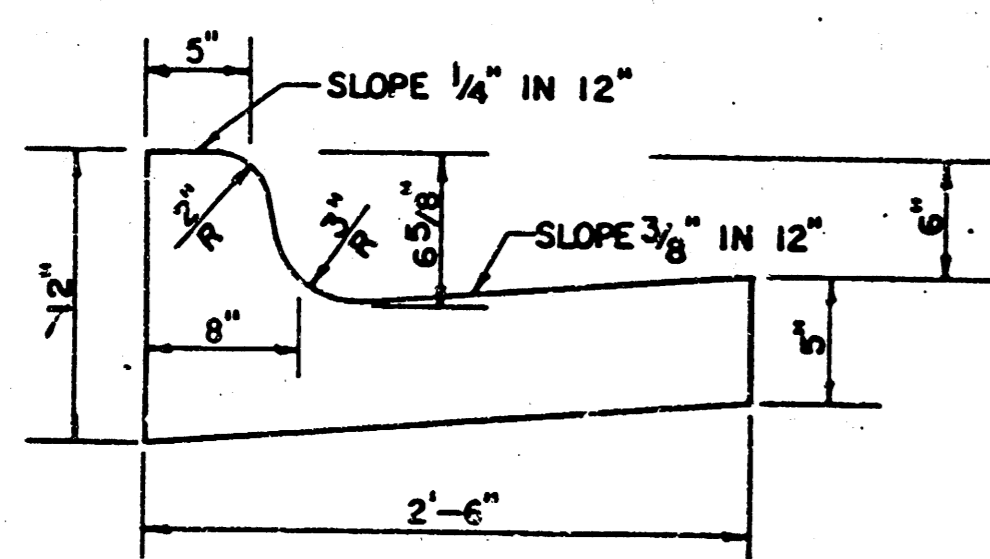


ROLL TYPE COMBINED CURB & GUTTER

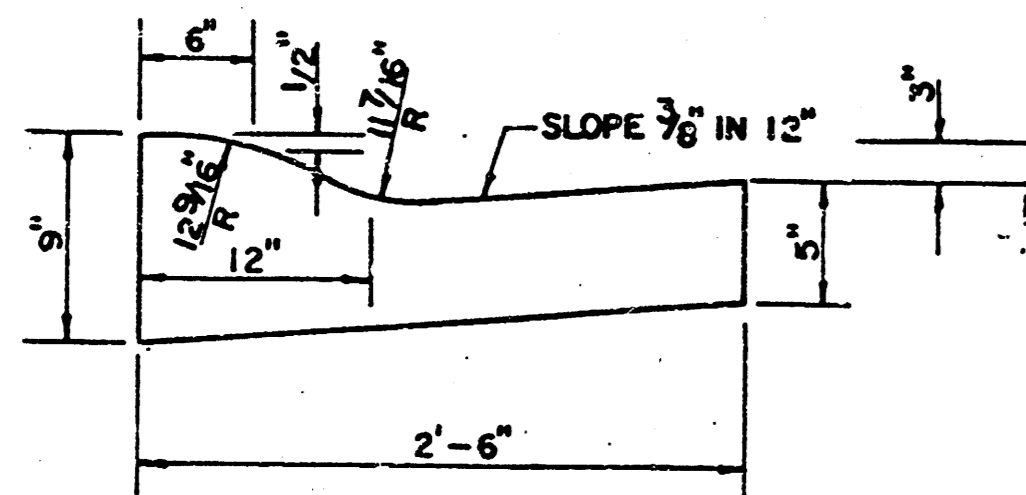

GENERAL NOTES

- 1) THE ASPHALTIC CONCRETE PAVEMENT BETWEEN THE COMBINED CURB AND GUTTER SHALL BE PAID AS SQUARE YARDS OF 7" ASPHALTIC CONCRETE (5" BITUMINOUS BASE).
- 2) THE BITUMINOUS BASE UNDER AND BEHIND THE COMBINED CURB AND GUTTER SHALL BE PAID AS SQUARE YARDS OF 2 1/2" BITUMINOUS BASE.
- 3) A TACK COAT OF EMULSIFIED ASPHALT (SC-1H OR CSS-1H) SHALL BE APPLIED AT AN APPROXIMATE RATE OF 0.05 GALLONS PER SQUARE YARD BETWEEN EACH LIFT OF ASPHALTIC MATERIAL.
- 4) BITUMINOUS BASE AND ASPHALTIC CONCRETE WEARING SURFACE SHALL BE PLACED WITH A LAYDOWN MACHINE HAVING AUTOMATIC CONTROLS FOR LINE AND GRADE.
- 5) CONSTRUCTION JOINTS IN EACH LIFT SHALL BE STAGGERED A MINIMUM DISTANCE OF ONE (1) FOOT FROM JOINTS IN PRECEDING LIFTS AND PLACED SO THAT A JOINT WILL BE CONSTRUCTED ON THE CENTERLINE OF THE TOP LIFT.
- 6) CONTRACTOR TO BID ONLY ONE SUBGRADE TREATMENT ALTERNATE WHEN ALTERNATES ARE PROVIDED IN THE PROPOSAL AND CONTRACT. THE ALTERNATE CHOSEN BY THE SUCCESSFUL BIDDER SHALL BE USED IN CONSTRUCTING THIS PROJECT.

TRANSVERSE CONSTRUCTION JOINTS

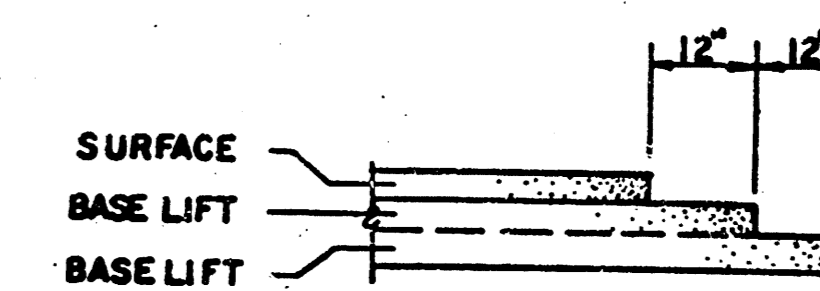


TRANSVERSE CONSTRUCTION JOINTS SHALL BE CONSTRUCTED IN FLEXIBLE BASE PAVEMENTS AT LOCATIONS WHERE PAVEMENT JOINTS EXISTING FLEXIBLE BASE PAVEMENT AS SHOWN BY THE DETAIL. ALL COSTS ASSOCIATED WITH THE CONSTRUCTION OF THE TRANSVERSE JOINT SHALL BE INCLUDED IN THE BID PRICE FOR SQUARE YARDS 7" ASPHALTIC CONCRETE (5" BITUMINOUS BASE).



7 INCH RESIDENTIAL ASPHALTIC CONCRETE
PAVEMENT WITH 5 INCH BITUMINOUS BASE
CITY OF WICHITA, KANSAS
PROJECT NUMBER
472-76-245-80001-000-000-12

TYPICAL 29' PAVEMENT DETAILS

TRANSVERSE SECTION




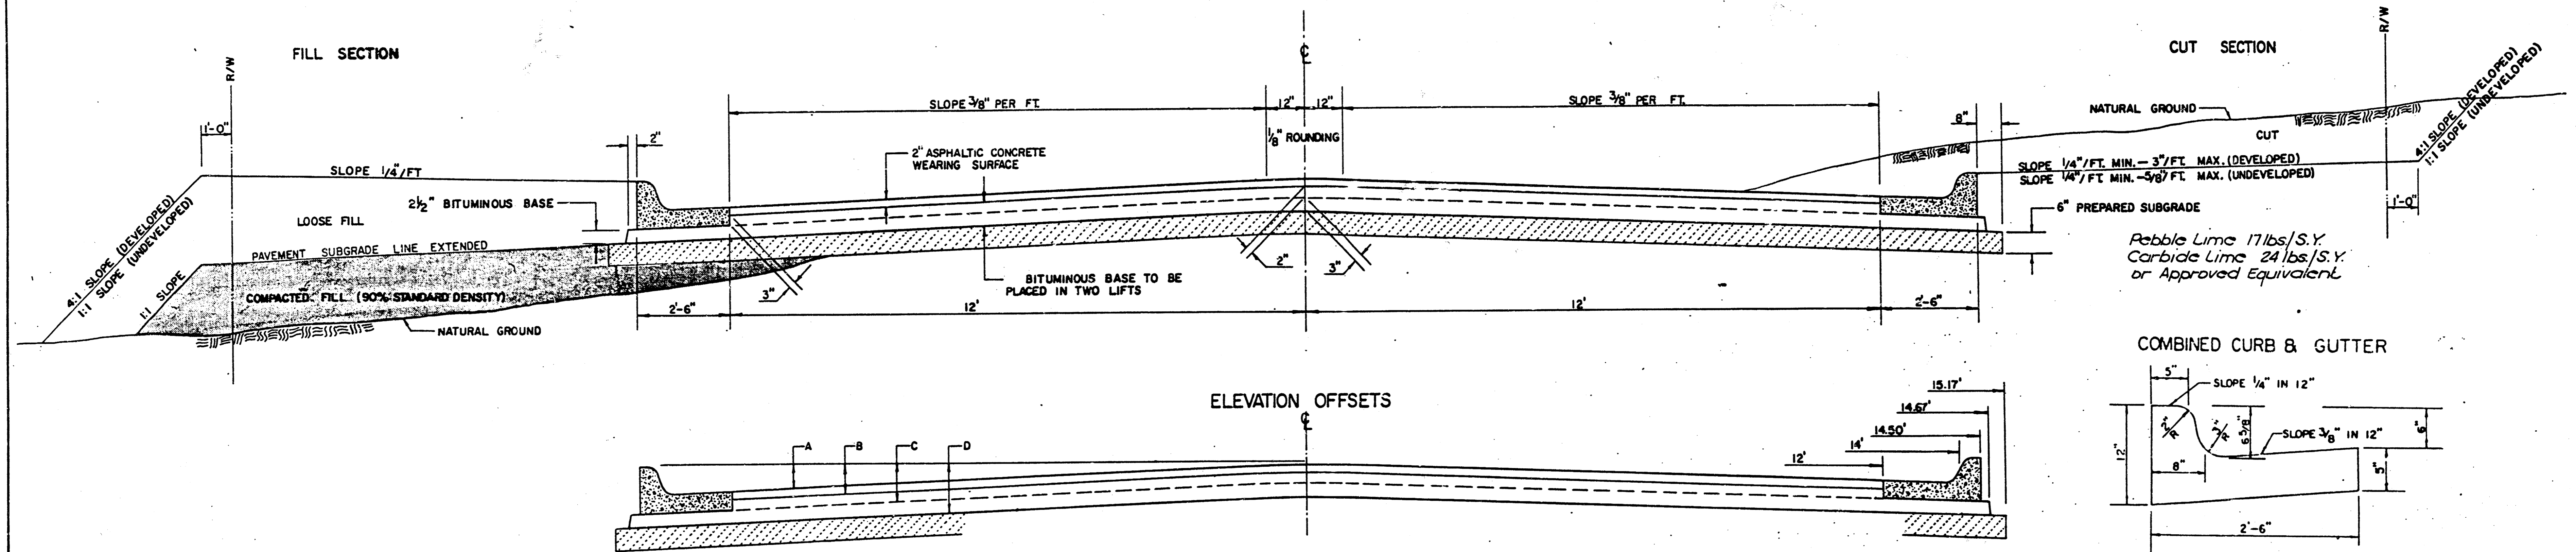


Pebble Lime 17 lbs/S.Y.
Carbide Lime 24 lbs/S.Y.
or Approved Equivalent

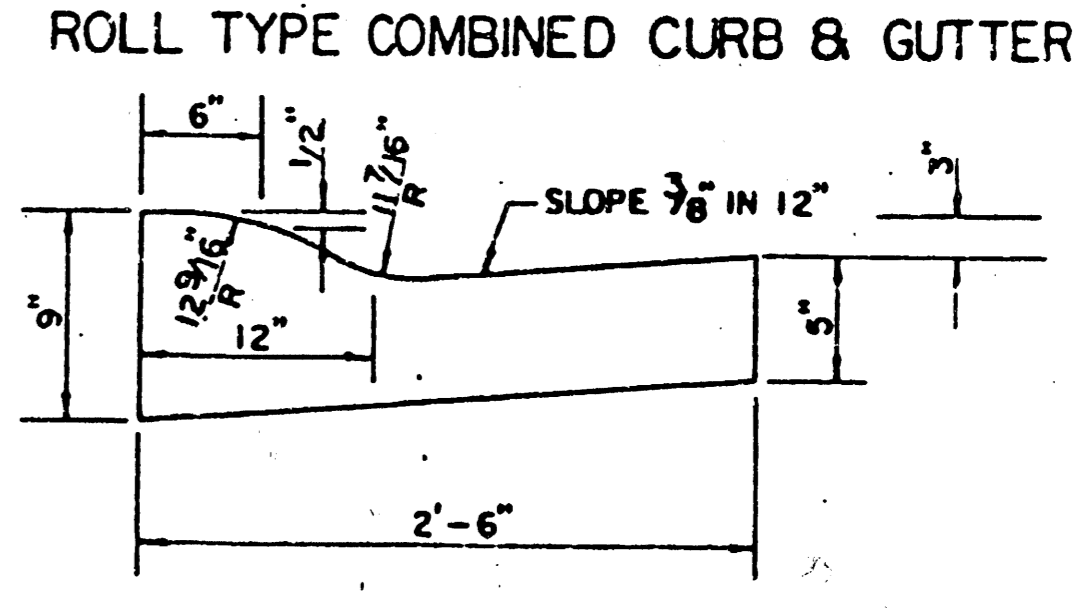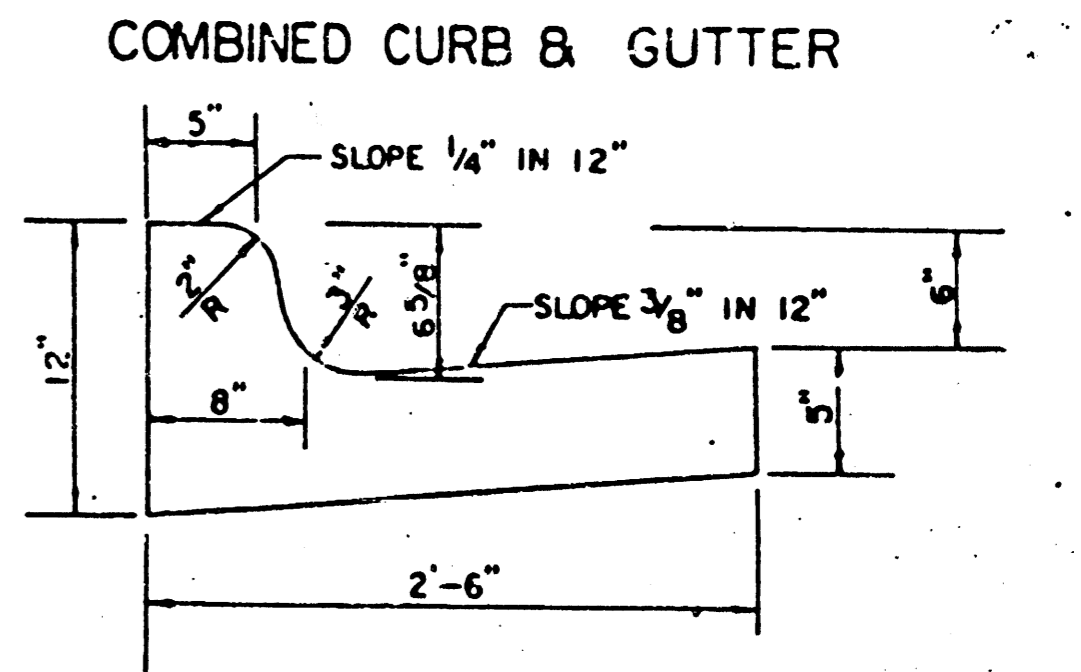

	DISTANCE FROM CENTERLINE (LT. & RT.)												
	0'	2'	4'	6'	7'	8'	10'	12'	14'	14.5'	14.67'	15.17'	
A: TOP OF CURBS TO TOP OF SURFACE LIFT	0.13	0.18	0.24	0.30	0.33	0.36	0.43	0.49	—	—	—	—	
B: TOP OF CURBS TO TOP OF UPPER BASE LIFT	0.30	0.35	0.41	0.47	0.50	0.53	0.60	0.66	—	—	—	—	
C: TOP OF CURBS TO TOP OF LOWER BASE LIFT	0.47	0.52	0.60	0.68	0.71	0.75	0.83	0.90	0.98	1.00	1.01	—	
D: TOP OF CURBS TO TOP OF SUBGRADE	0.72	0.77	0.84	0.91	0.94	0.98	1.05	1.12	1.19	1.21	1.21	1.23	

VALLEY GUTTER DETAIL

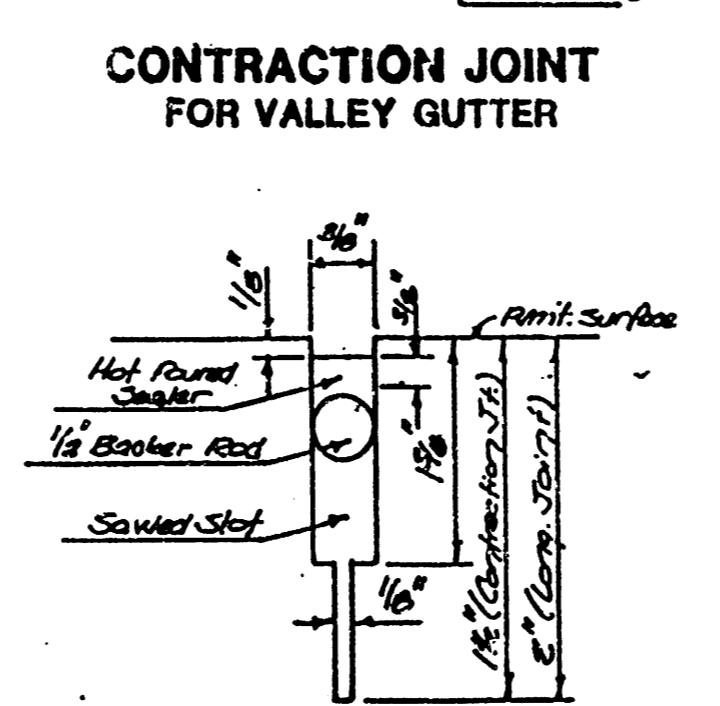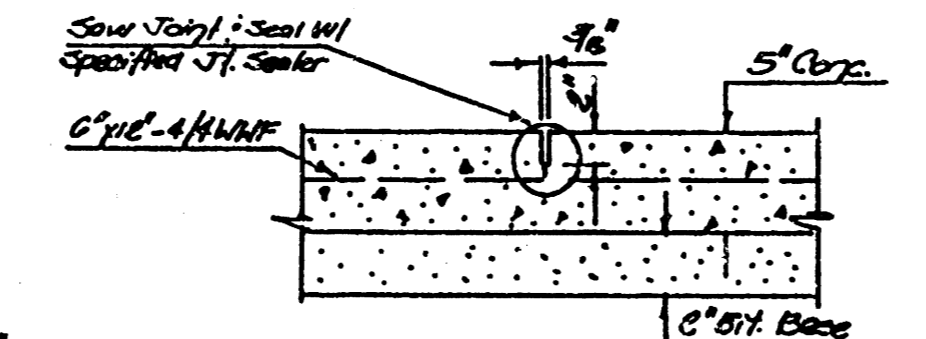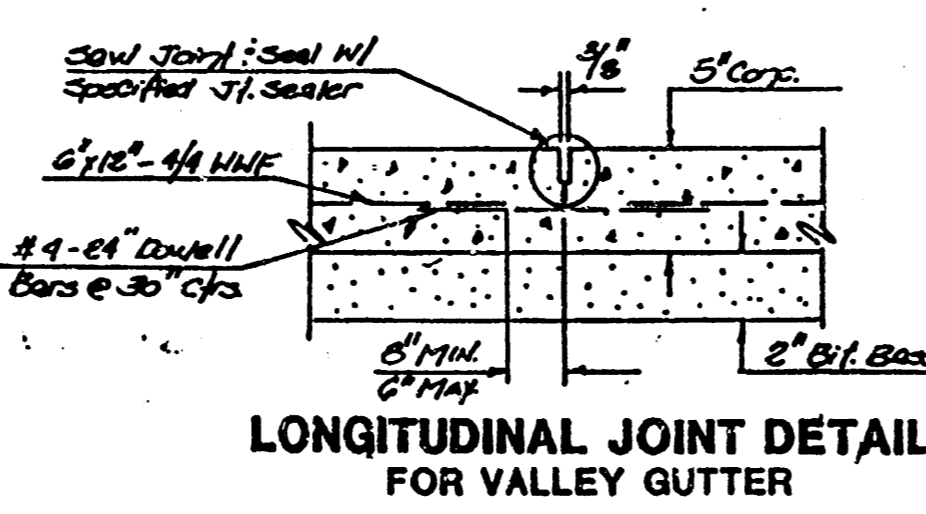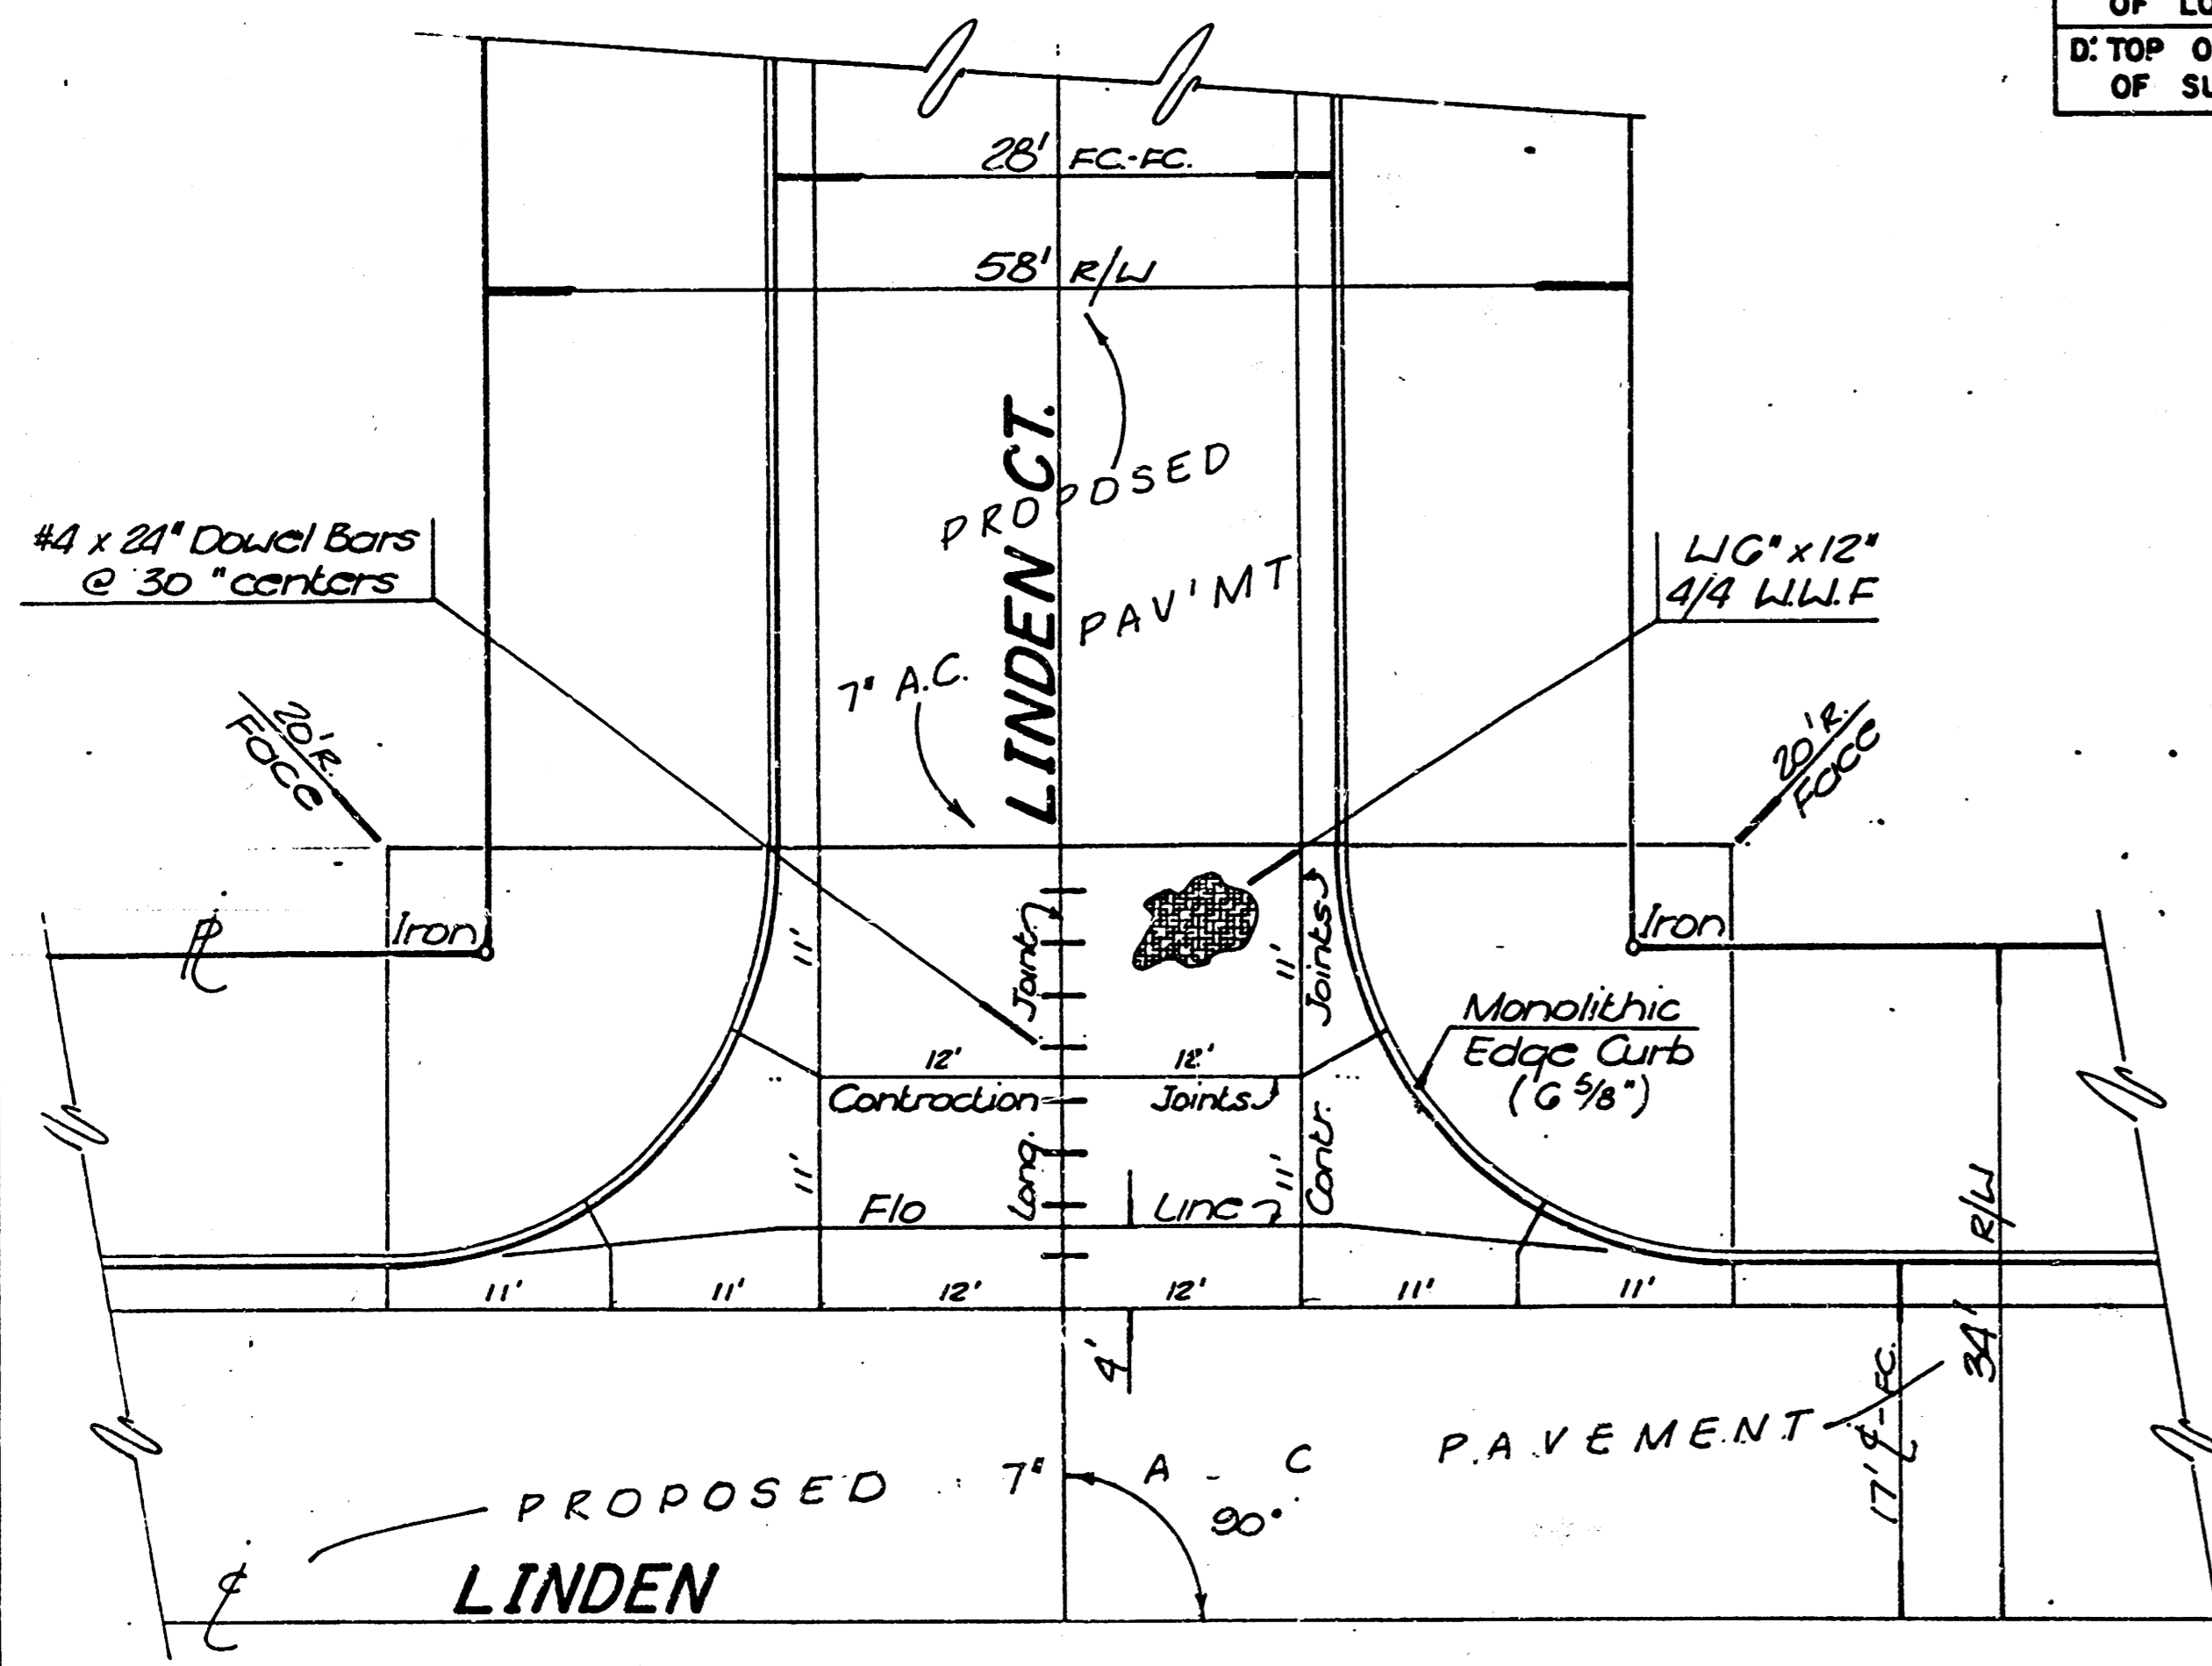


Note: Sawing Material shall conform to ASTM D-1180

GENERAL NOTES

- 1) THE ASPHALTIC CONCRETE PAVEMENT BETWEEN THE COMBINED CURB AND GUTTER SHALL BE PAID AS SQUARE YARDS OF 7" ASPHALTIC CONCRETE (5" BITUMINOUS BASE).
- 2) THE BITUMINOUS BASE UNDER AND BEHIND THE COMBINED CURB AND GUTTER SHALL BE PAID AS SQUARE YARDS OF 2 1/2" BITUMINOUS BASE.
- 3) A TACK COAT OF EMULSIFIED ASPHALT (SC-1H OR CSS-1H) SHALL BE APPLIED AT AN APPROXIMATE RATE OF 0.05 GALLONS PER SQUARE YARD BETWEEN EACH LIFT OF ASPHALTIC MATERIAL.
- 4) BITUMINOUS BASE AND ASPHALTIC CONCRETE WEARING SURFACE SHALL BE PLACED WITH A LAYDOWN MACHINE HAVING AUTOMATIC CONTROLS FOR LINE AND GRADE.
- 5) CONSTRUCTION JOINTS IN EACH LIFT SHALL BE STAGGERED A MINIMUM DISTANCE OF ONE (1) FOOT FROM JOINTS IN PRECEDING LIFTS AND PLACED SO THAT A JOINT WILL BE CONSTRUCTED ON THE CENTERLINE OF THE TOP LIFT.
- 6) CONTRACTOR TO BID ONLY ONE SUBGRADE TREATMENT ALTERNATE WHEN ALTERNATES ARE PROVIDED IN THE PROPOSAL AND CONTRACT. THE ALTERNATE CHOSEN BY THE SUCCESSFUL BIDDER SHALL BE USED IN CONSTRUCTING THIS PROJECT.



TRANSVERSE CONSTRUCTION JOINTS

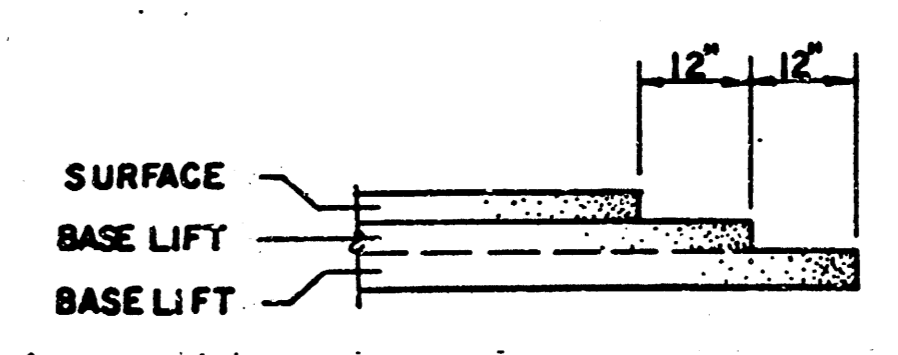

TRANSVERSE CONSTRUCTION JOINTS SHALL BE CONSTRUCTED IN FLEXIBLE BASE PAVEMENTS AT LOCATIONS WHERE PAVEMENT JOINS EXISTING FLEXIBLE BASE PAVEMENT AS SHOWN BY THE DETAIL. ALL COSTS ASSOCIATED WITH THE CONSTRUCTION OF THE TRANSVERSE JOINT SHALL BE INCLUDED IN THE BID PRICE FOR SQUARE YARDS 7" ASPHALTIC CONCRETE (5" BITUMINOUS BASE).

7 INCH RESIDENTIAL ASPHALTIC CONCRETE PAVEMENT WITH 5 INCH BITUMINOUS BASE
CITY OF WICHITA, KANSAS 3
PROJECT NUMBER
472-76-245-80001-000-000- 12

BENCHMARKS
 Bench Mark 1: 10' Cut Top of Curb 08' ± W. of 1/4 Section Line S. side of Hurst. Elevation 211.22 City Datum
 Bench Mark 2: 10' Cut Top of Curb on the S. side of Carson and W. R./W. of Linden Elevation 201.71 City Datum

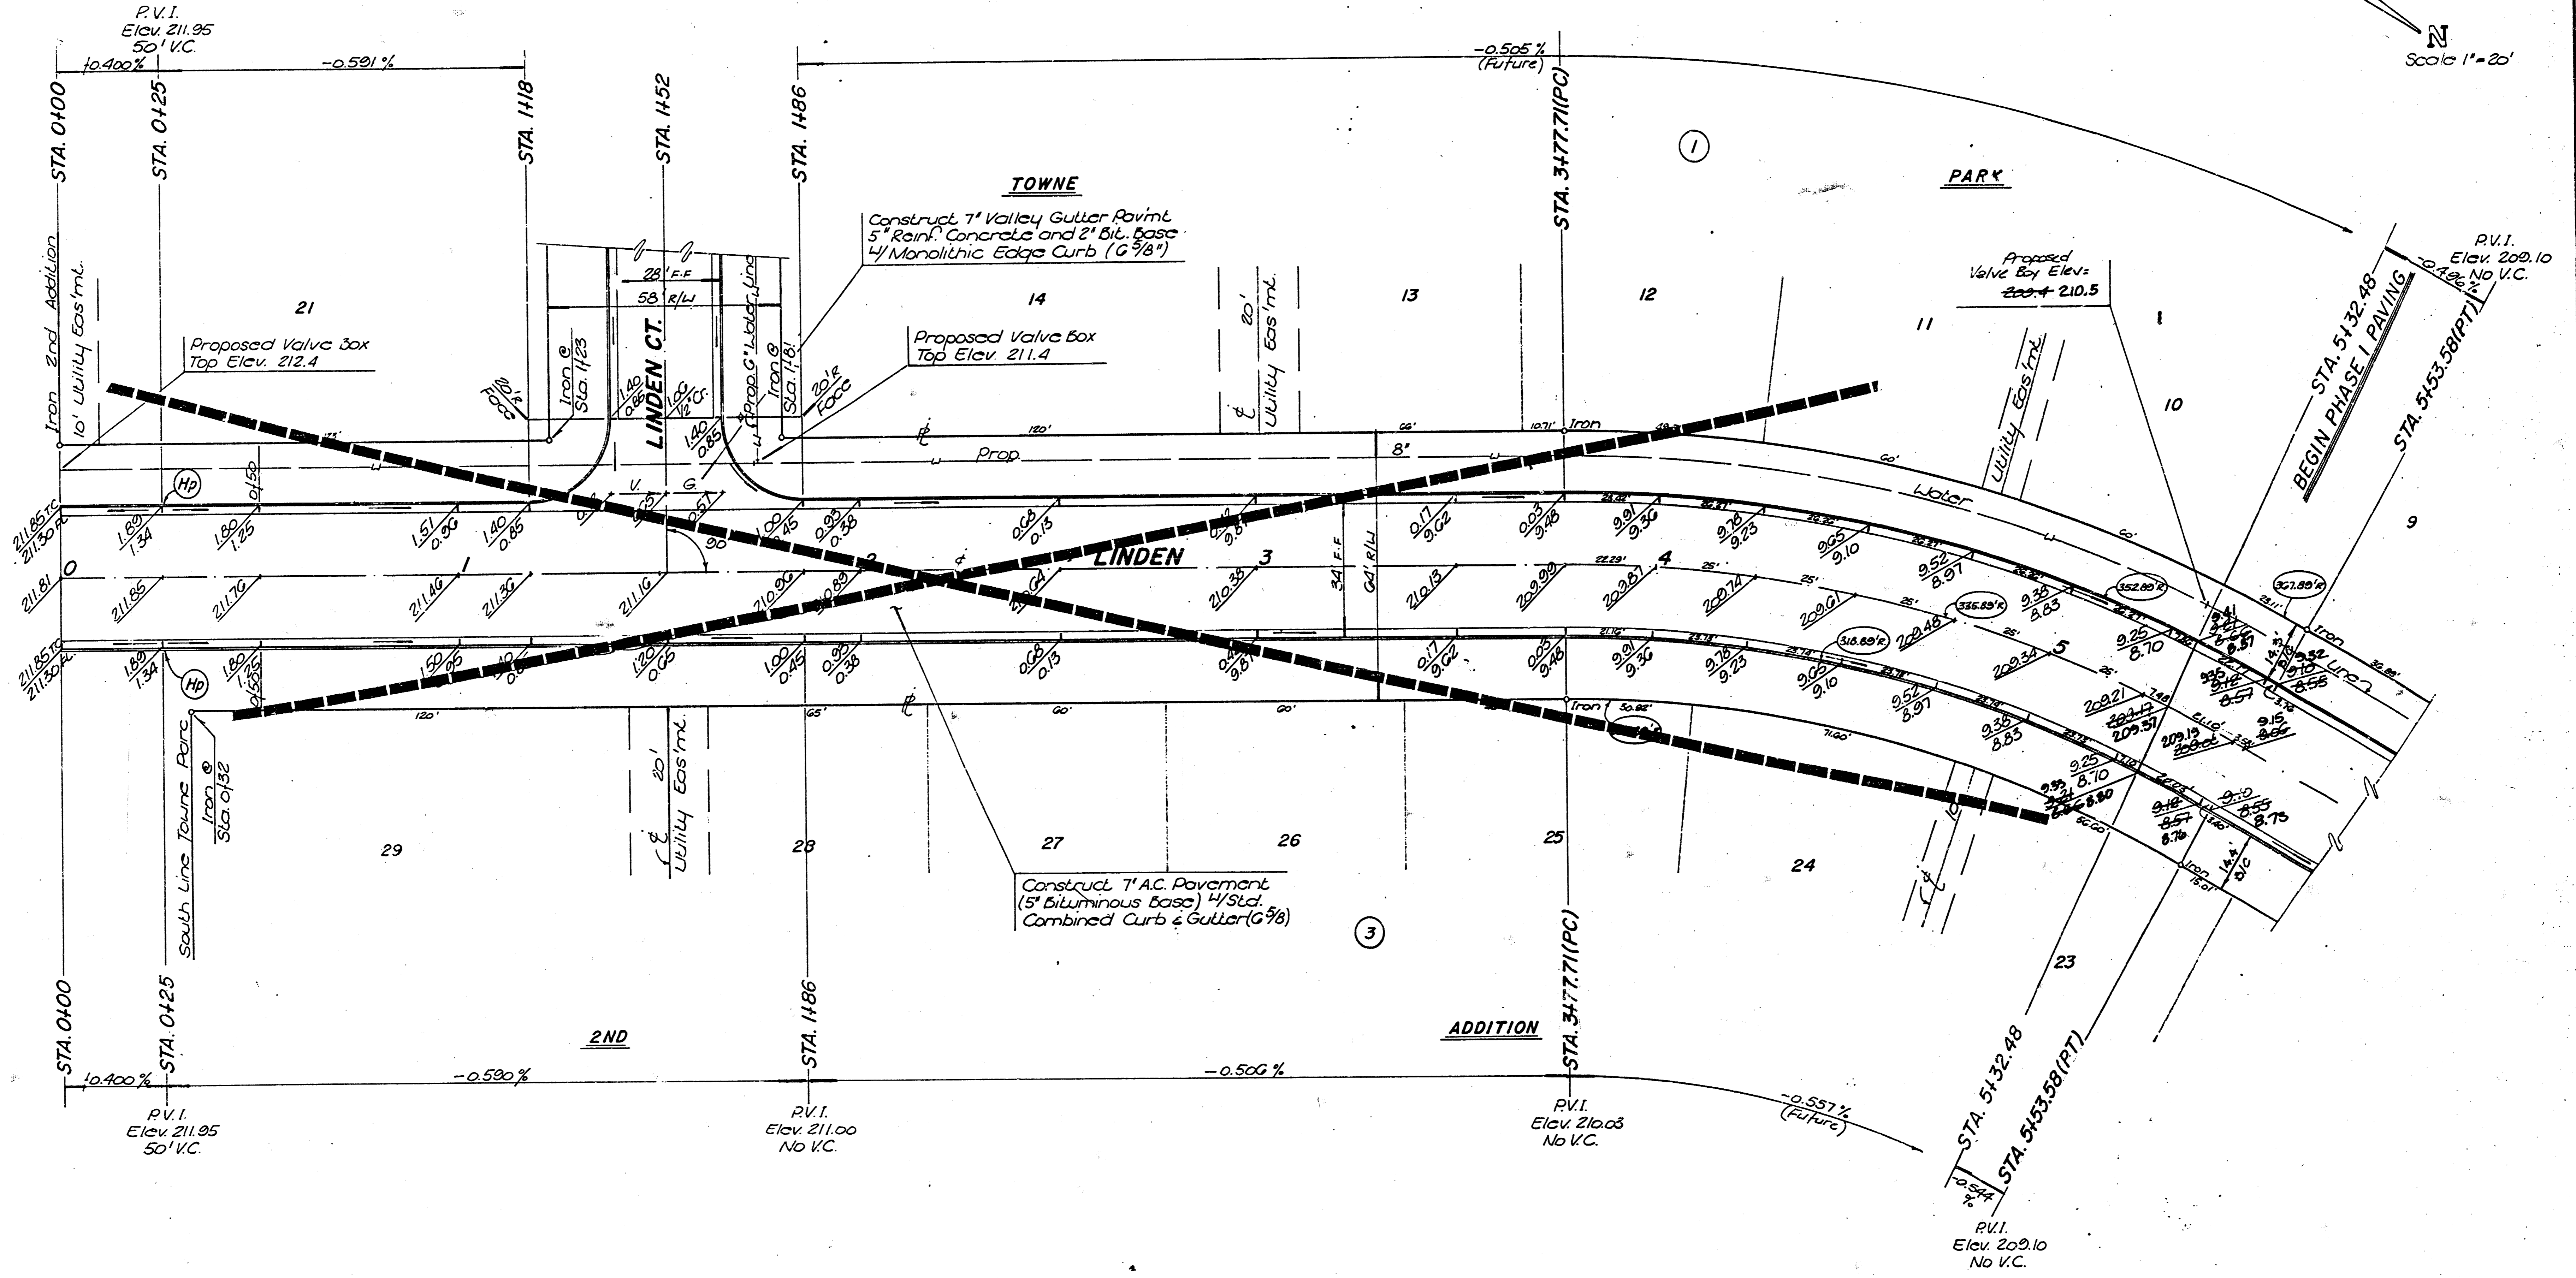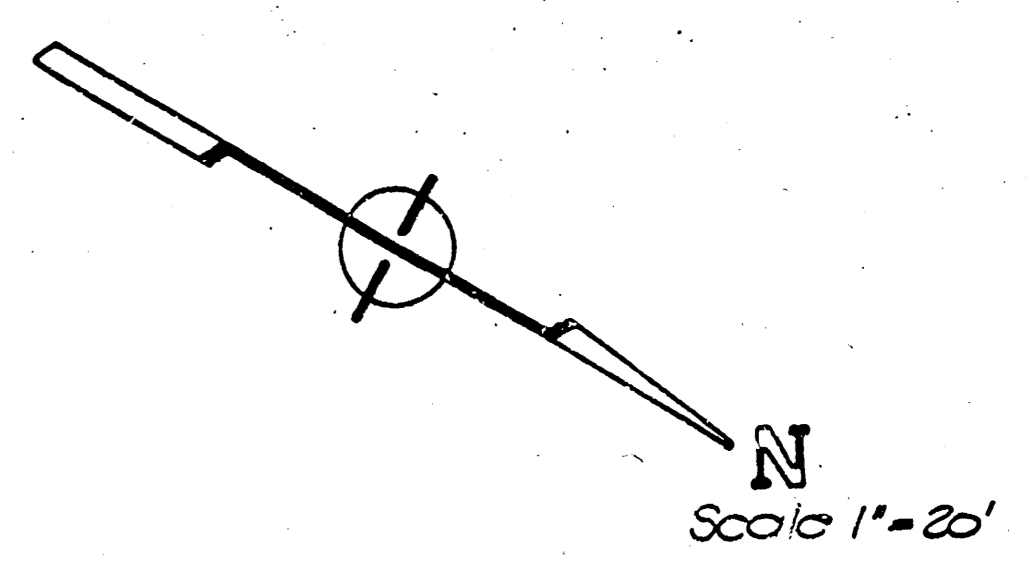

CURVE DATA BASED ON CENTERLINE DATA

R = 336.80 Δ = 30°00' L = 175.87 Chd. = 173.57 Tan. = 90' Def/ft. = 5.1174 min.

I Station	Arc Length	CHORD LENGTHS		Deflection Angle	Total Deflection
		B' Left/face	B' Right/face		
3+77.71(PC)				0°00'	0°00'
4+00	22.29	23.95'	20.63'	1°54'04"	1°54'04"
4+25	25	20.85'	23.13'	2°07'50"	4°02'00"
4+50	25	20.85'	23.13'	2°07'50"	6°09'50"
4+75	25	20.85'	23.13'	2°07'50"	8°17'40"
5+00	25	20.85'	23.13'	2°07'50"	10°25'30"
5+25	25	20.85'	23.13'	2°07'50"	12°33'20"
5+53.58(P.T.)	21.10	8.03'	13.53'	0°38'10"	13°12'01"

NOTE: PHASE I PAVING BEGINS @ STATION 5+32.48. PAVEMENT FROM STA. 0+00 TO STA. 5+32.48 WILL BE CONSTRUCTED UNDER A FUTURE PROJECT.



Rev. As-Built 12-20-88

LINDEN
 STA. 0+00 TO STA. 5+53.58

BAUGHMAN COMPANY P. A.
 SURVEYING & ENGINEERING
 316/262-7271 • 315 ELLIS • WICHITA, KANSAS 67211

PROJECT NUMBER
472-76-245-80001-000-000-

DESIGN: C. Bohm DRAWN: R.J. Plush APPROVED: DATE: SCALE: 1" = 20' SHEET: 4 OF 12

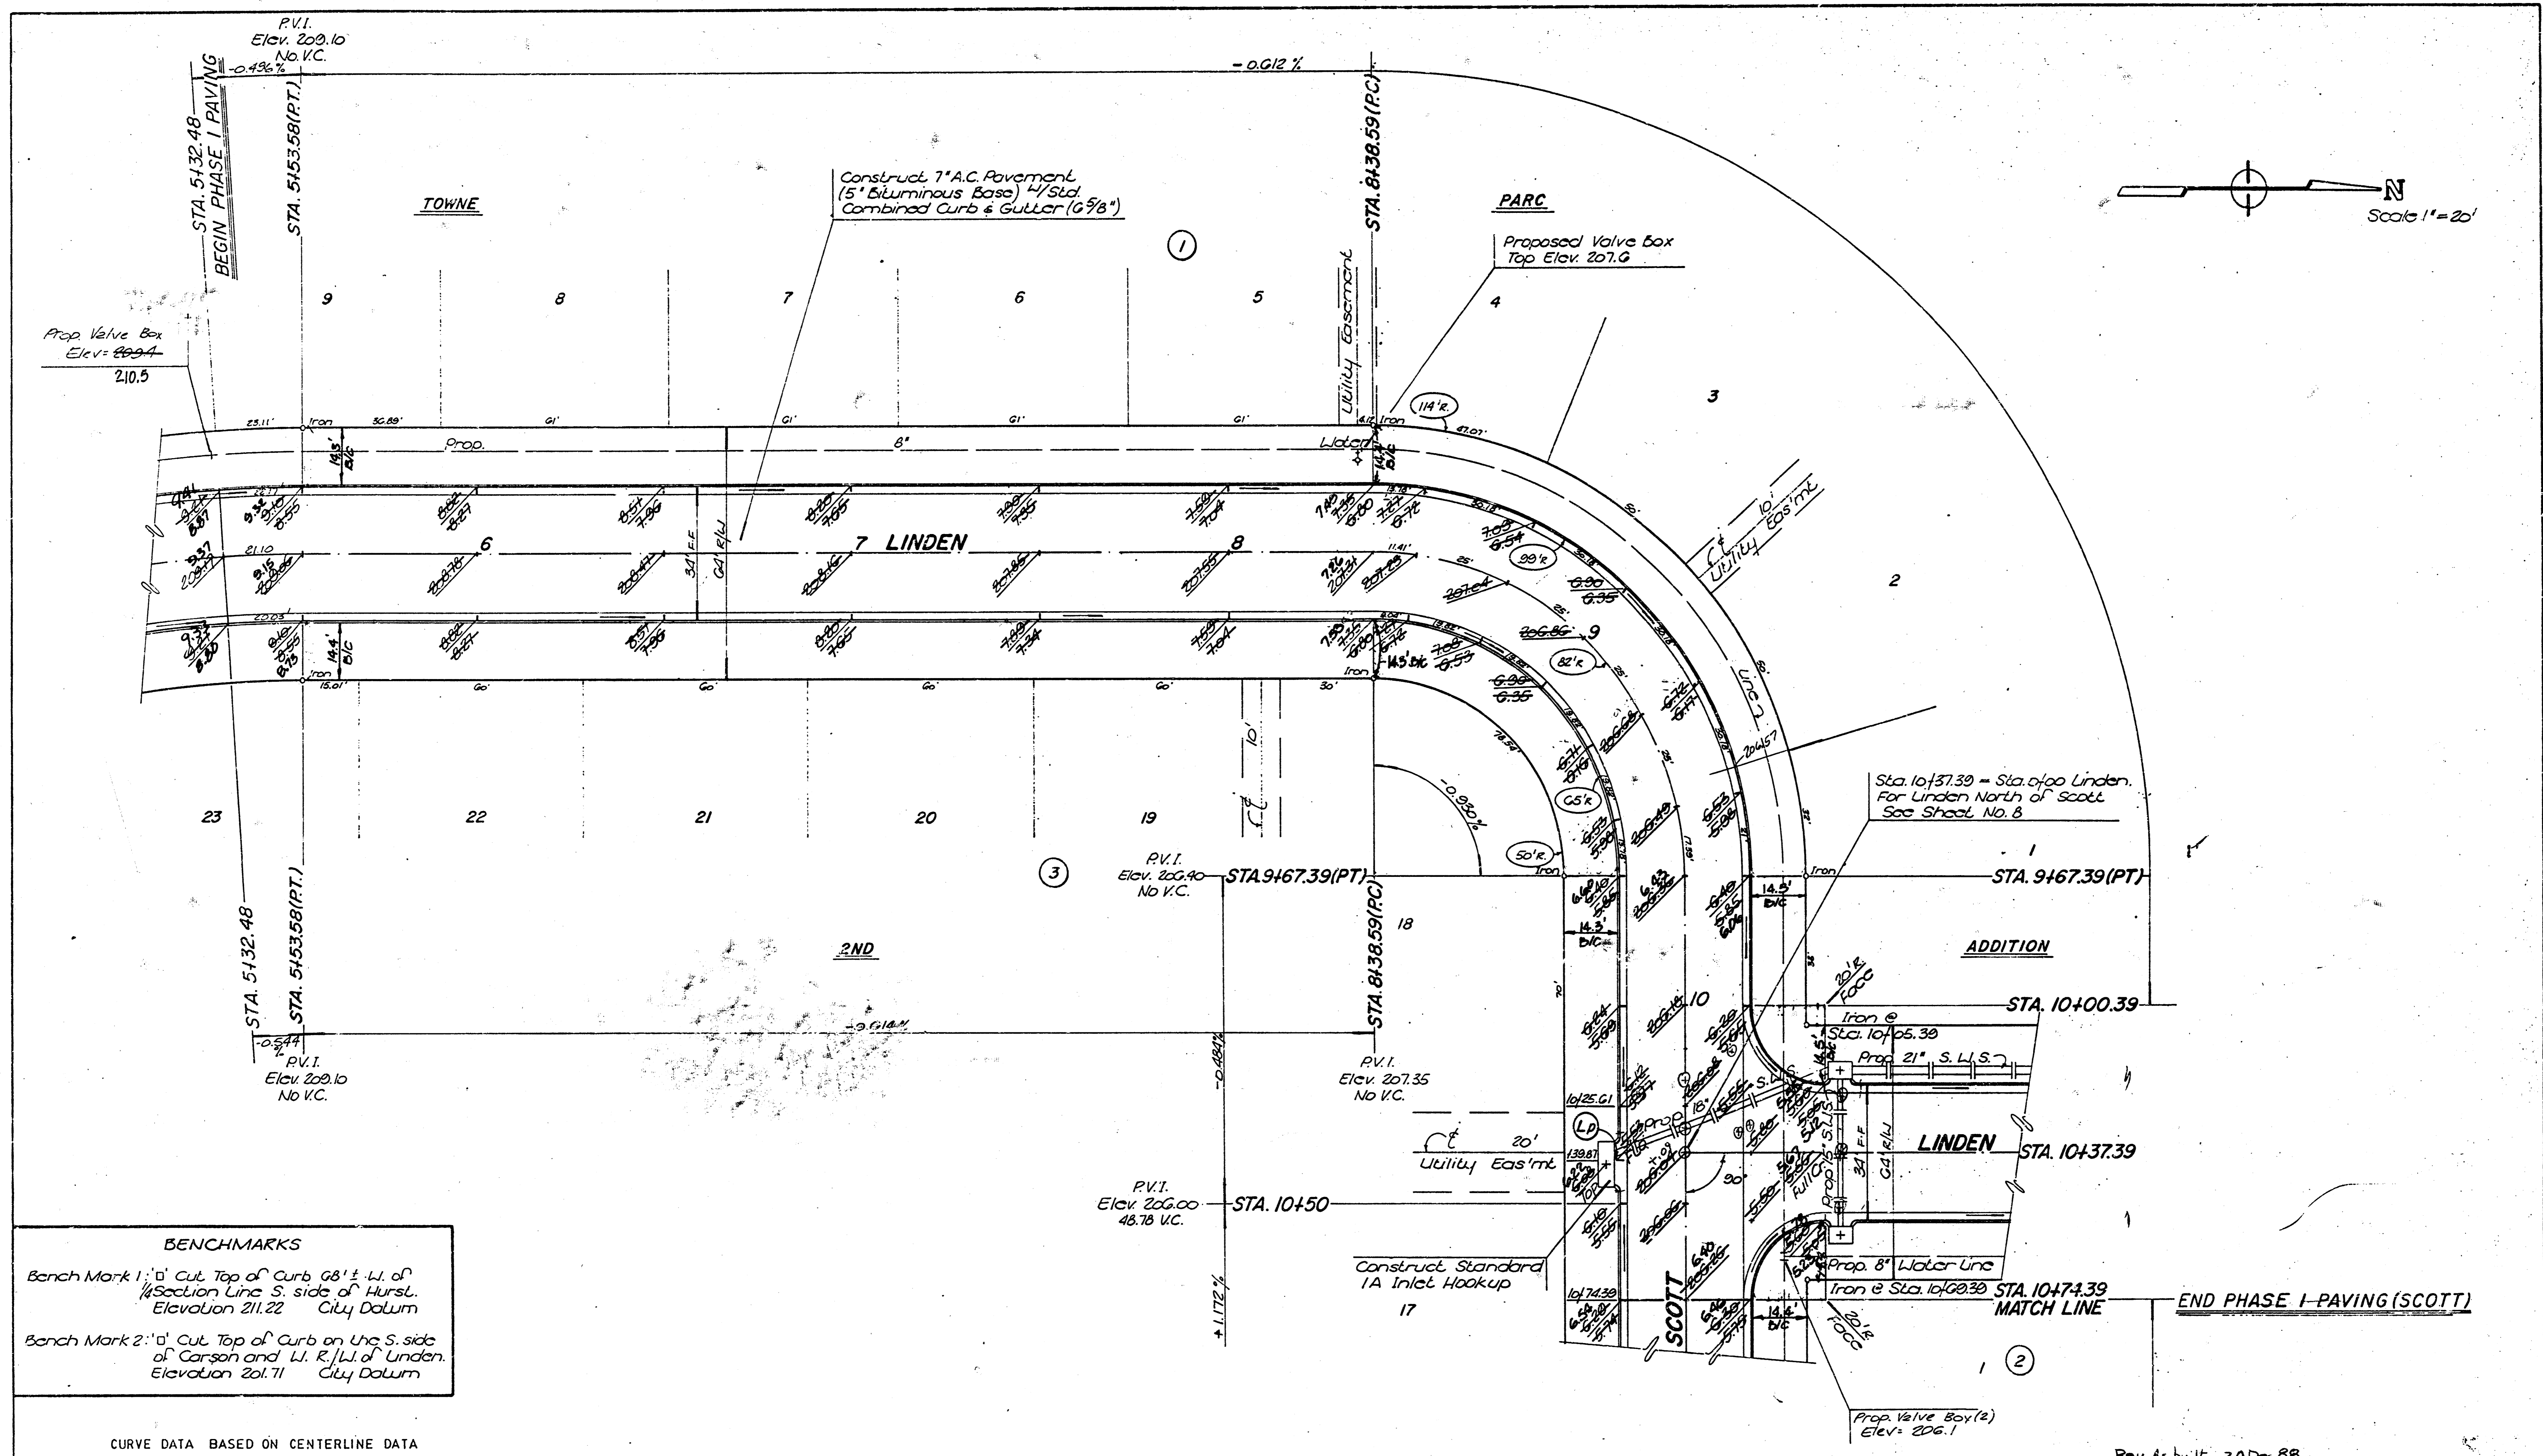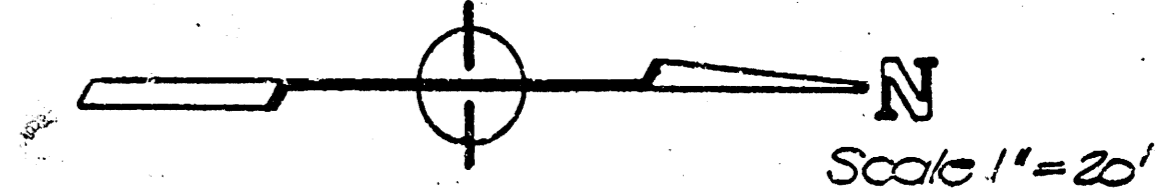

BENCHMARKS

Bench Mark 1: 0' Cut Top of Curb 68' ± L.I. of Section Line S. side of Hurst. Elevation 211.22 City Datum

Bench Mark 2: 0' Cut Top of Curb on the S. side of Carson and L.I. R. / L.I. of Linden. Elevation 201.71 City Datum

CURVE DATA BASED ON CENTERLINE DATA

R = 62' Δ = 90°00' L = 128.82 Chd. = 115.91 Tan. = 82' Def/H. = 20.9621 min.

Station	Arc Length	CHORD LENGTHS		Deflection Angle	Total Deflection Angle
		0' Left/face	0' Right/face		
8138.59 PC	—	—	—	0°00'	0°00'
8150	11.41'	14.88'	7.93'	3°59'11"	3°59'11"
8176	25'	32.50'	17.31'	8°44'04"	12°43'15"
8100	25'	32.50'	17.31'	8°44'04"	21°27'19"
8125	25'	32.50'	17.31'	8°44'04"	30°11'23"
8150	25'	32.50'	17.31'	8°44'04"	38°55'27"
8173.39 PT	17.39'	22.65'	12.07'	0°04'33"	45°00'00"

Rev As built 20D-88

LINDEN & SCOTT.
STA. 5153.58 TO STA. 10474.39



BAUGHMAN COMPANY P. A.
SURVEYING & ENGINEERING
318/282-7271 • 315 ELLIS • WICHITA, KANSAS 67211

PROJECT NUMBER
472-76-245-80001-000-000-

DESIGN: C. Bohm DRAWN: R.J. Alush APPROVED: DATE: SCALE: 1" = 20'

SHEET 5 OF 12

BENCHMARKS
 Bench Mark 1: 1'0" Cut Top of Curb 08'± W. of Section Line S. side of Hurst. Elevation 211.22 City Datum
 Bench Mark 2: 1'0" Cut Top of Curb on the S. side of Carson and W. R/W of Under. Elevation 201.71 City Datum

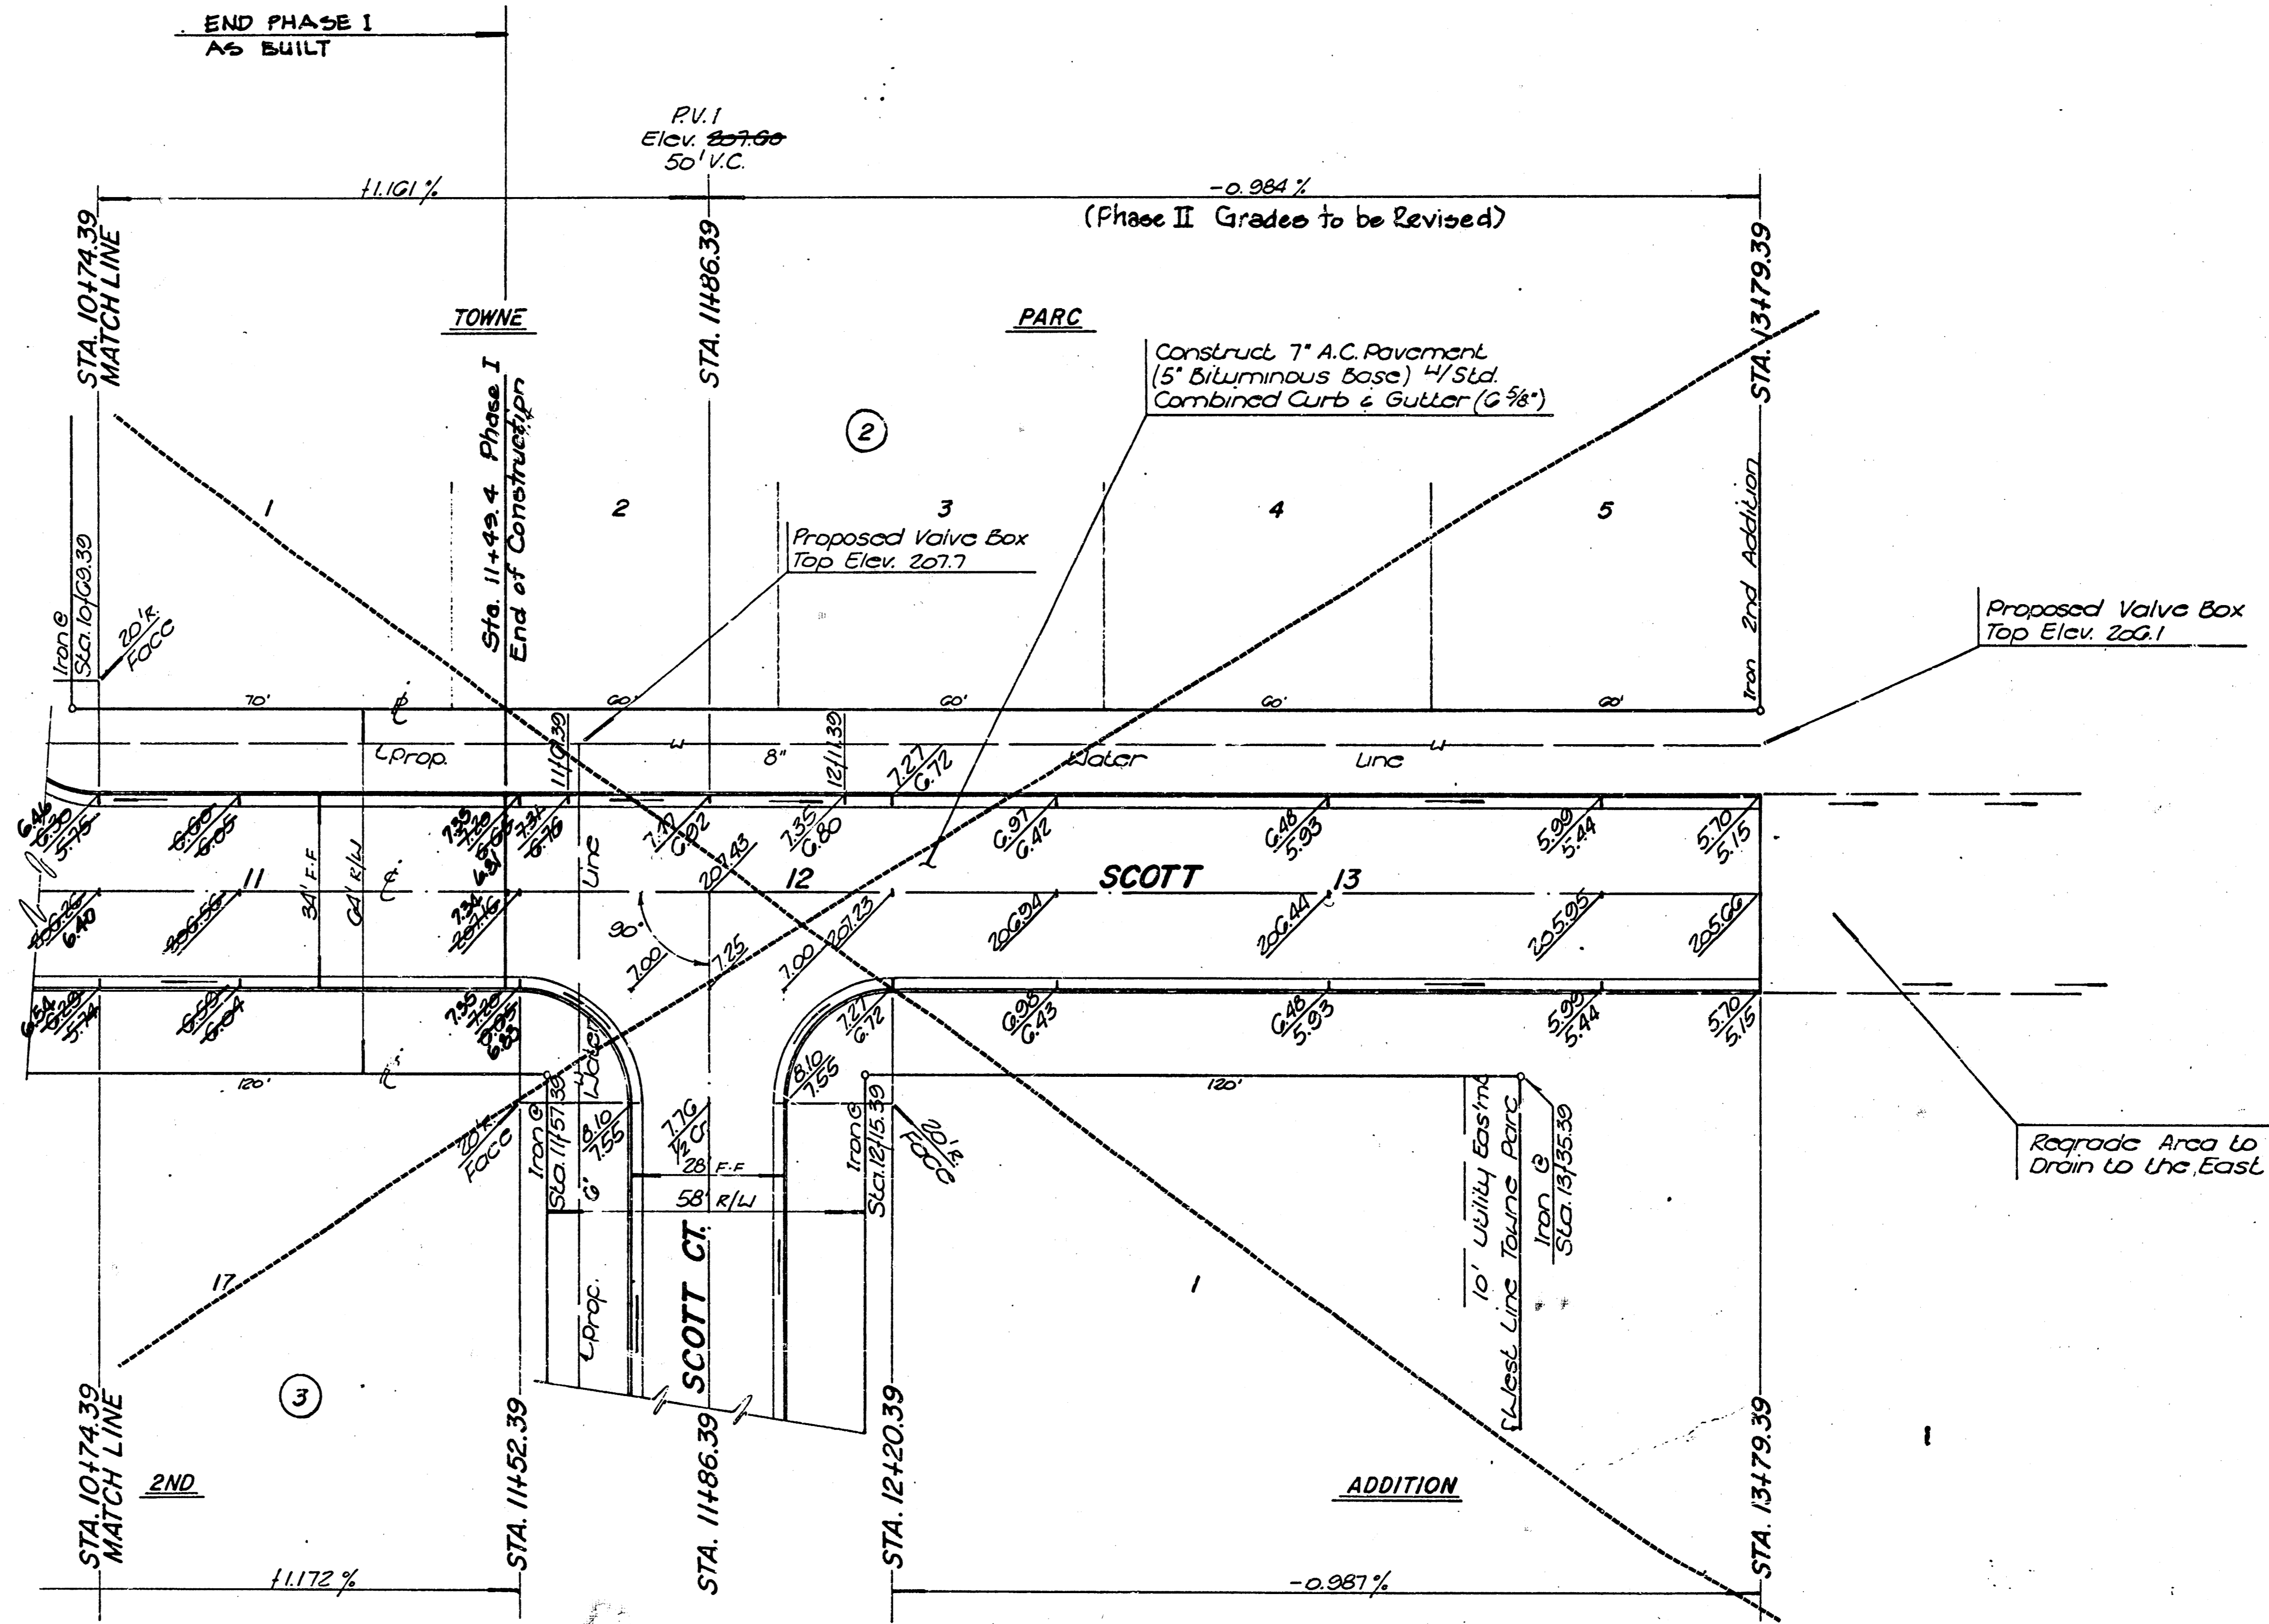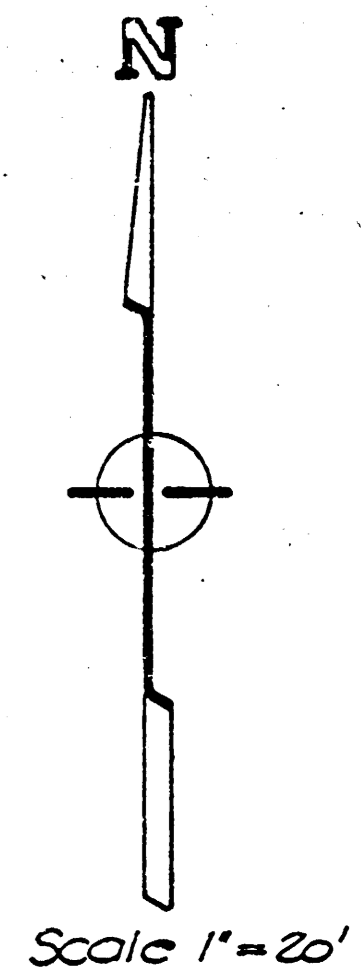

11+49.4 AS BUILT
 NOTE: NO PAVING PAST STATION 10+74.39 WILL BE CONSTRUCTED ON SCOTT WITH THIS PROJECT. THE REMAINDER OF THE PAVING WILL BE CONSTRUCTED UNDER A FUTURE PROJECT.

AS-BUILTS
 private paving
 #472-80001-044



Rev. As-Built 12-20-88

SCOTT		REV.
STA. 10+74.39 TO STA. 13+79.39		
BAUGHMAN COMPANY P. A. SURVEYING & ENGINEERING 316/282-7271 • 315 ELLIS • WICHITA, KANSAS 67211		6/12
PROJECT NUMBER 472-76-245-80001-000-000-		SHEET 6
DESIGN C.Bohm	DRAWN R.J.Plus	OF 12
APPROVED	DATE	SCALE 1" = 20'

BENCHMARKS

Bench Mark 1: 1'0" Cut Top of Curb 68' ± W. of
1/4 Section Line S. side of Hurst.
Elevation 211.22 City Datum

Bench Mark 2: 1'0" Cut Top of Curb on the S. side
of Carson and W. R. W. of Linden.
Elevation 201.71 City Datum

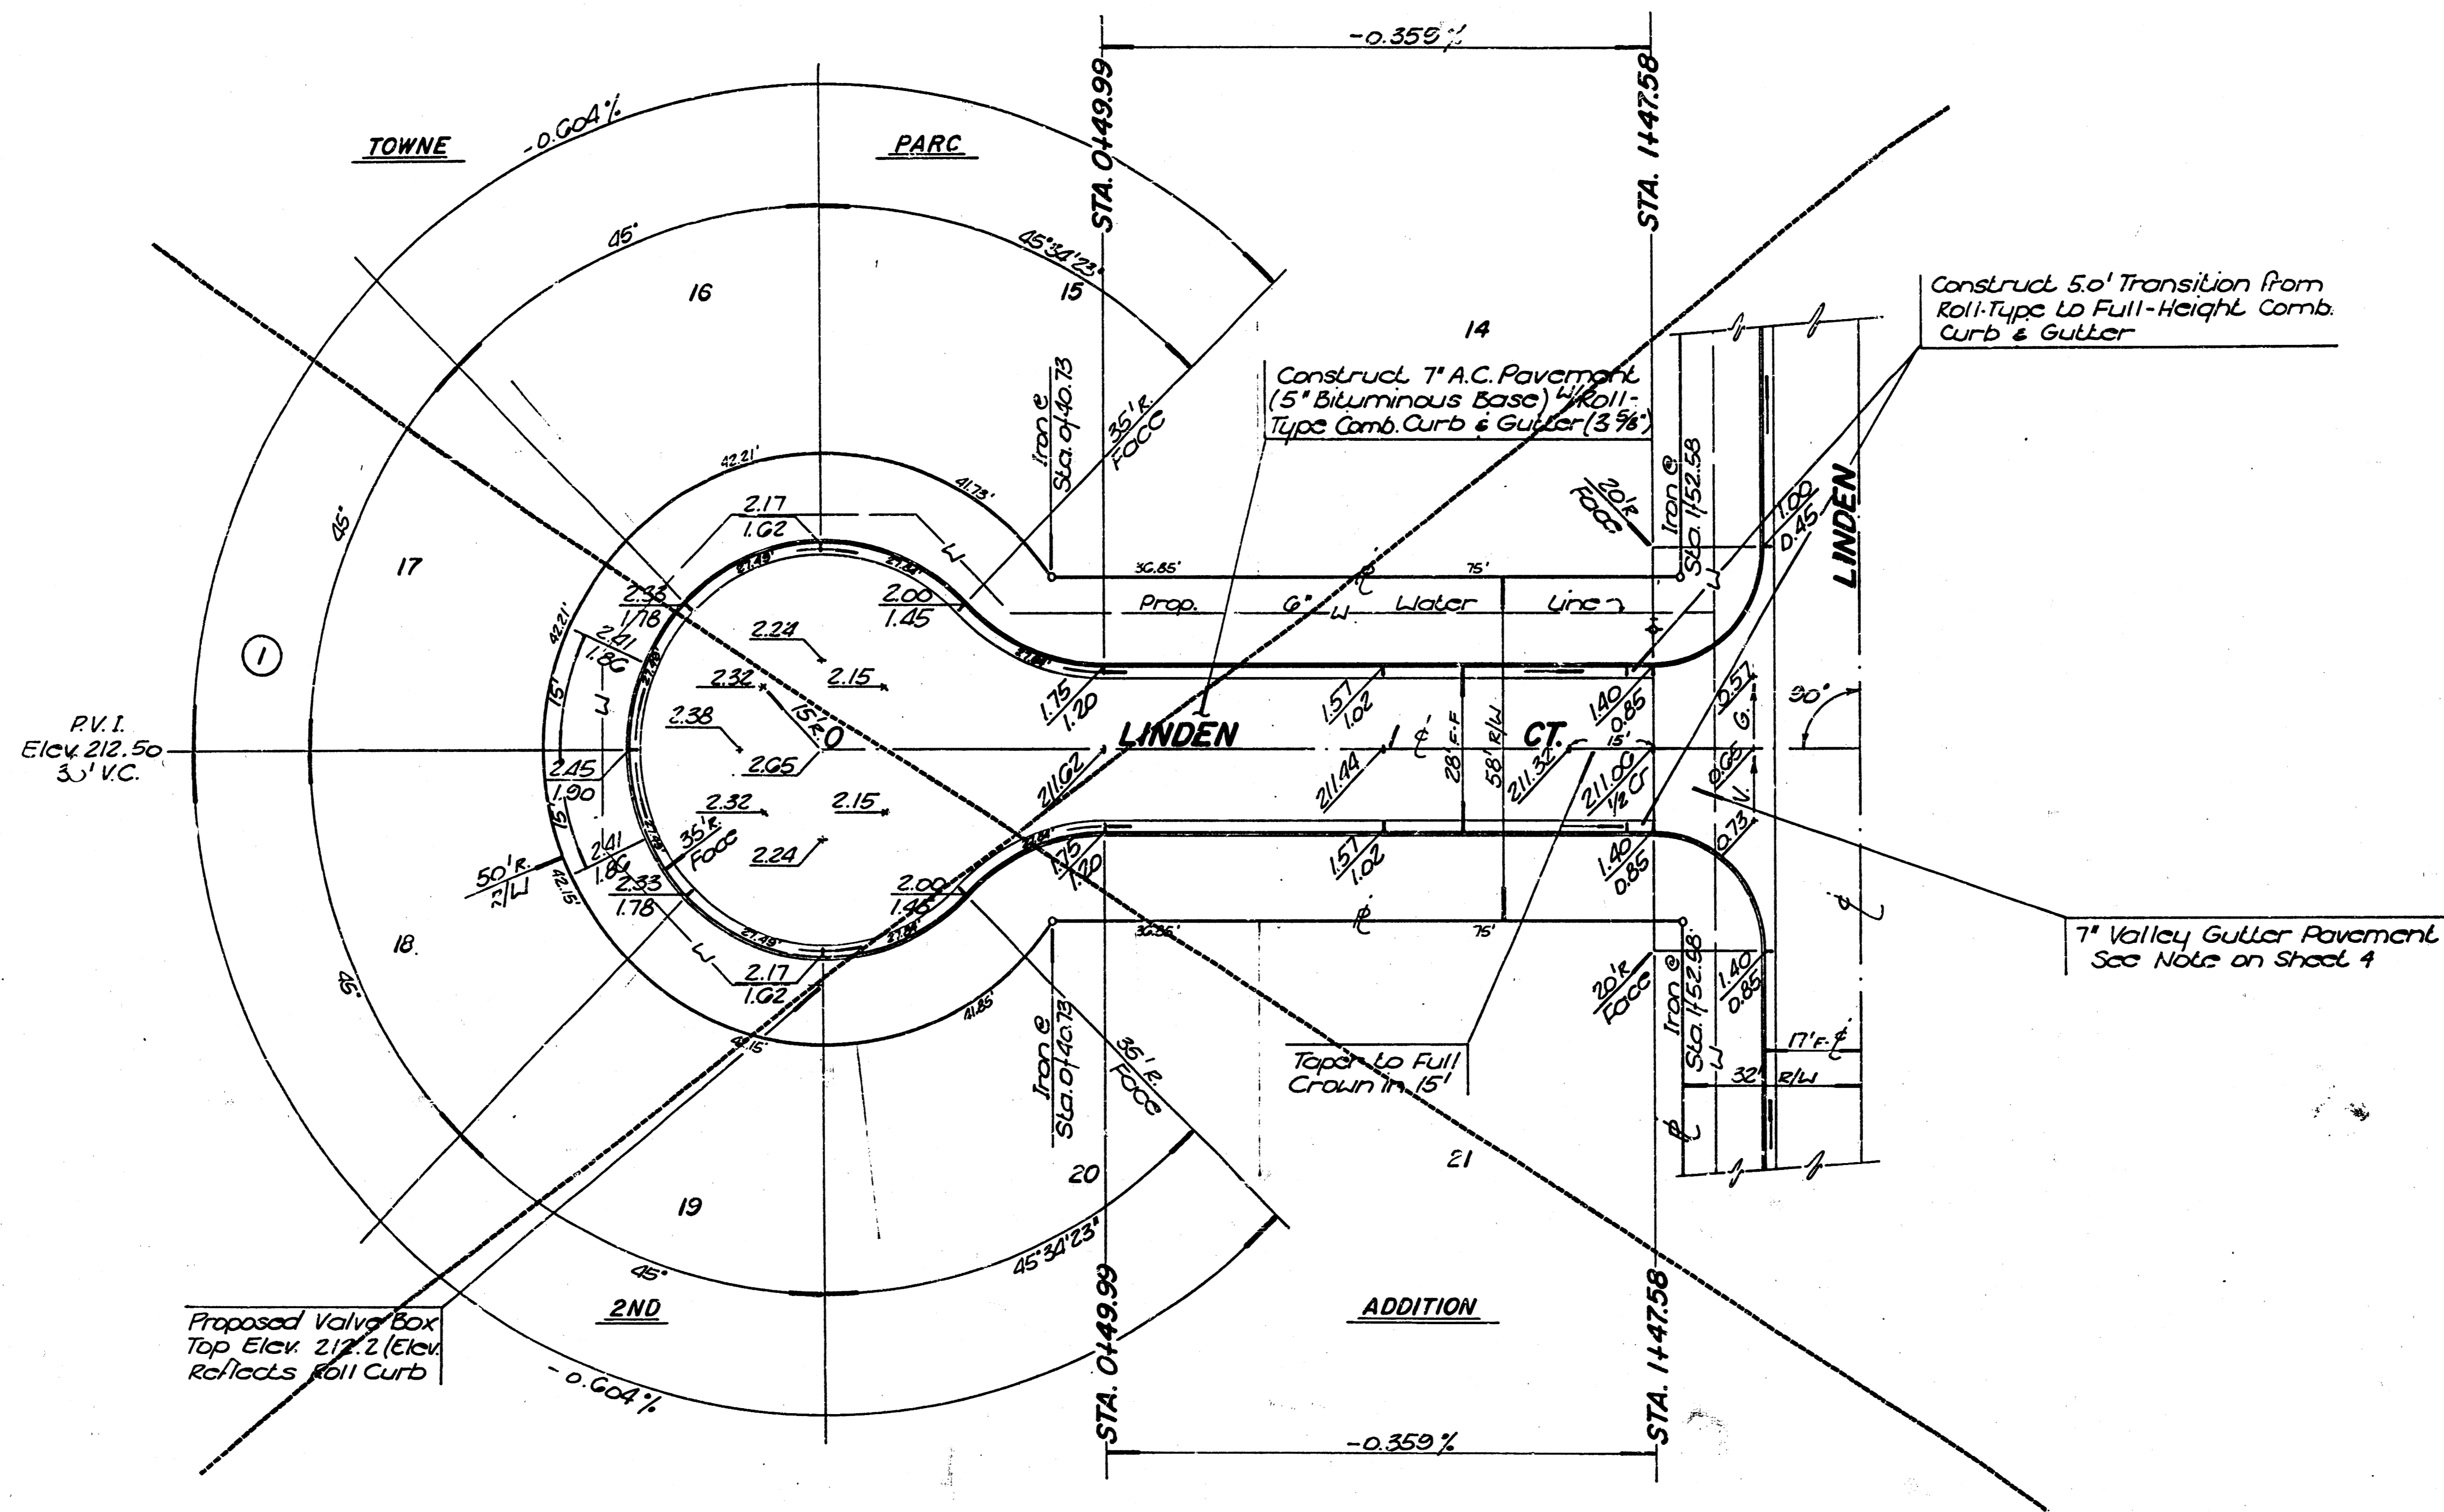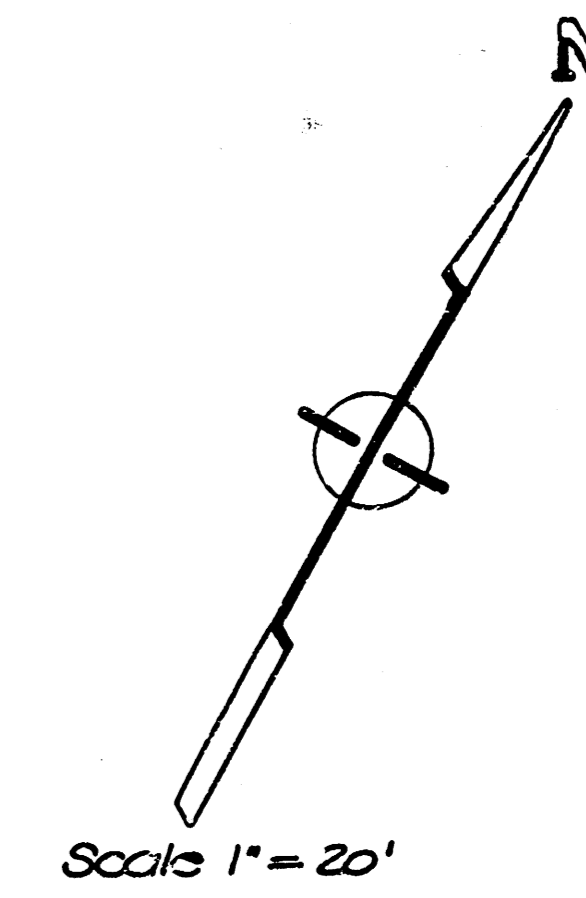

Proposed Valve Box
Top Elev. 212.2 (Elev.
Reflects Roll Curb)

Construct 5.0' Transition from
Roll-Type to Full-Height Comb.
Curb & Gutter



7" Valley Gutter Pavement
See Note on Sheet 4

NOTE
Roll-Type Combined Curb & Gutter (3 3/8") is to
be constructed in Linden Court. Transitions
from Roll-Type to Full-Height Curb to be paid
for as LF of Full-Height Comb. Curb & Gutter (6 9/8")

NOTE
PAVEMENT ON LINDEN COURT WILL NOT BE
CONSTRUCTED ON THIS PROJECT. PROVIDED
FOR INFORMATION ONLY.

LINDEN CT.			
STA. 0+00 TO STA. 1+84.58			
BAUGHMAN COMPANY P. A.		REV.	
SURVEYING & ENGINEERING		316/282-7271 • 315 ELLIS • WICHITA, KANSAS 67211	
PROJECT NUMBER			
472-76-245-80001-000-000-			
DESIGN	DRAWN	APPROVED	DATE
C. Bachm	R.J. Plush		
SCALE			SHEET
1" = 20'			7
			OF 12



BENCHMARKS
 Bench Mark 1: 1'0" Cut Top of Curb 08'± W. of 1/4 Section Line S. side of Hurst. Elevation 211.22 City Datum
 Bench Mark 2: 1'0" Cut Top of Curb on the S. side of Carson and W. R. W. of Linden. Elevation 201.71 City Datum

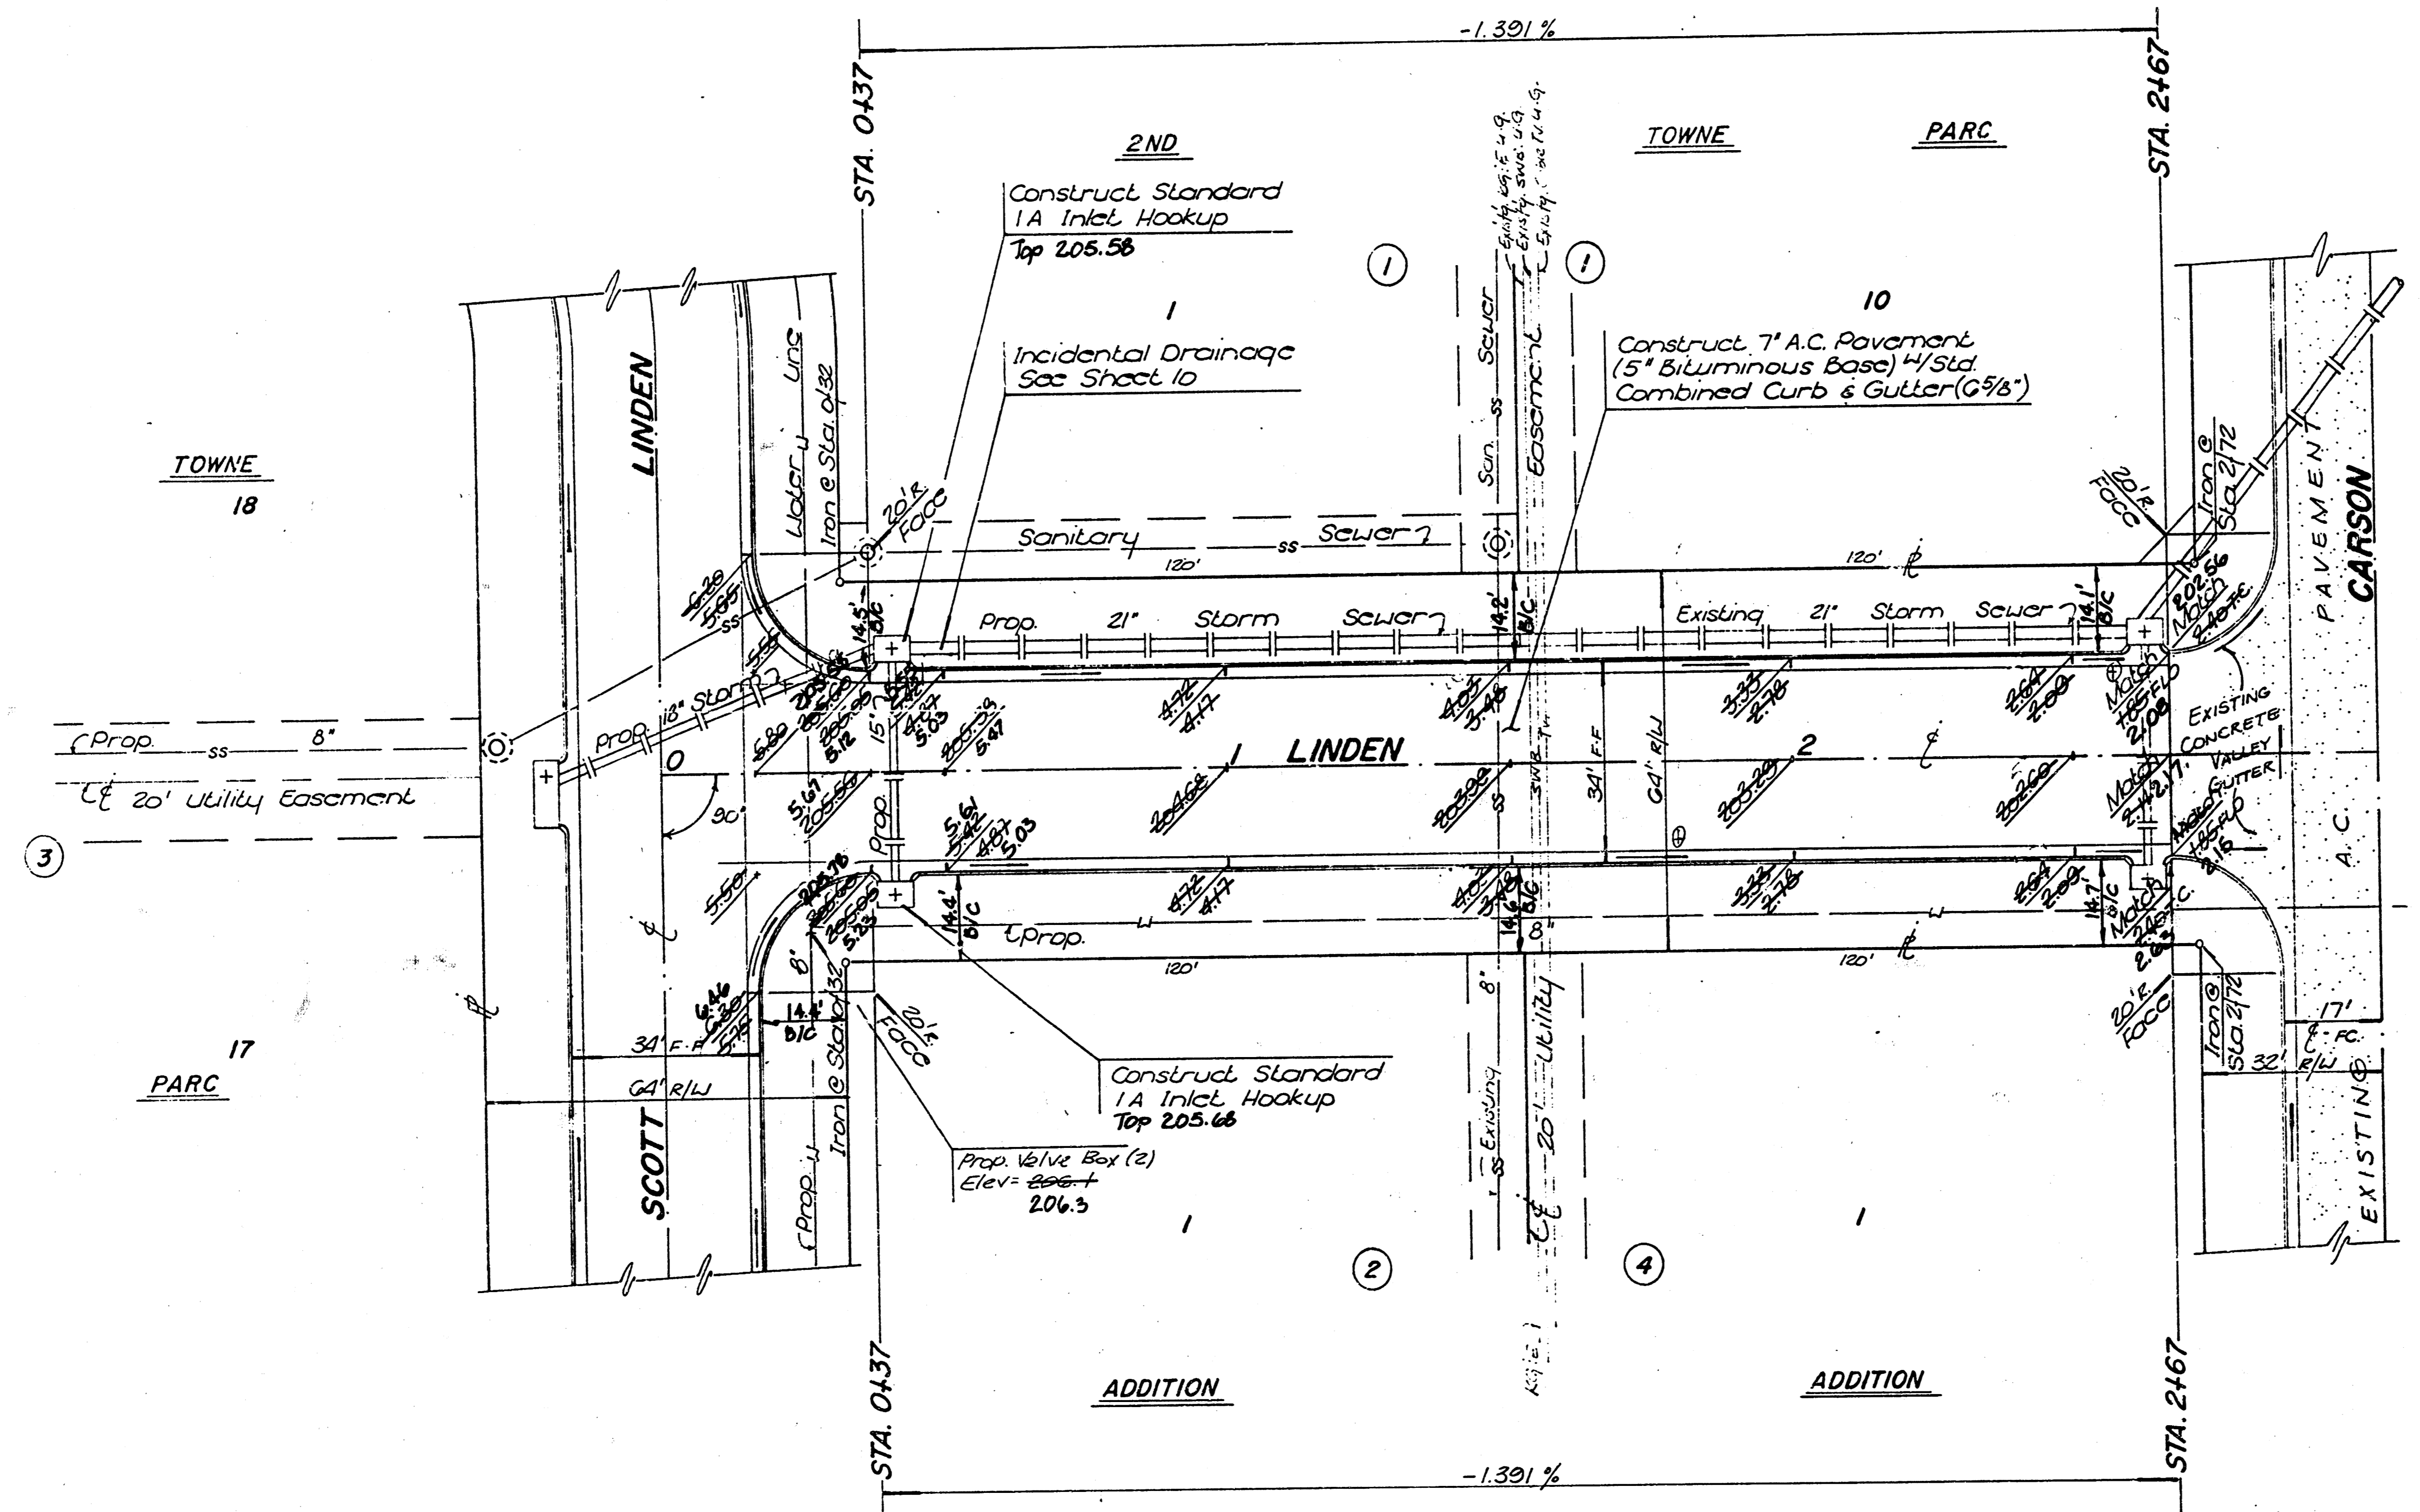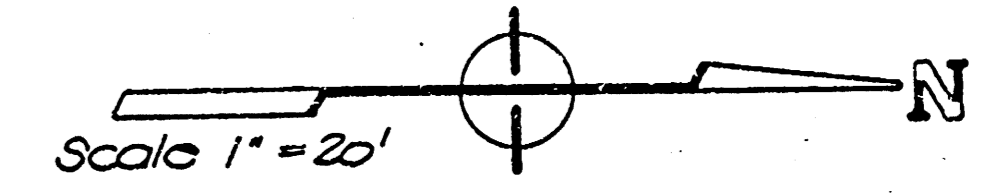

Rev. As built 20 Dec 88

LINDEN STA. 0+00 TO STA. 2+67				
BAUGHMAN COMPANY P. A. SURVEYING & ENGINEERING 316/282-7271 • 315 ELLIS • WICHITA, KANSAS 67211				
PROJECT NUMBER 472-76-245-80001-000-000-				
DESIGN C. Bohm	DRAWN R. J. Plush	APPROVED	DATE	SCALE 1" = 20'
				REV. SHEET 8/12 OF 8

BENCHMARKS
 Bench Mark 1: 1'0" Cut Top of Curb 68' ± W. of 1/4 Section Line S. side of Hurst. Elevation 211.22 City Datum
 Bench Mark 2: 1'0" Cut Top of Curb on the S. side of Carson and W. R. W. of Under. Elevation 201.71 City Datum

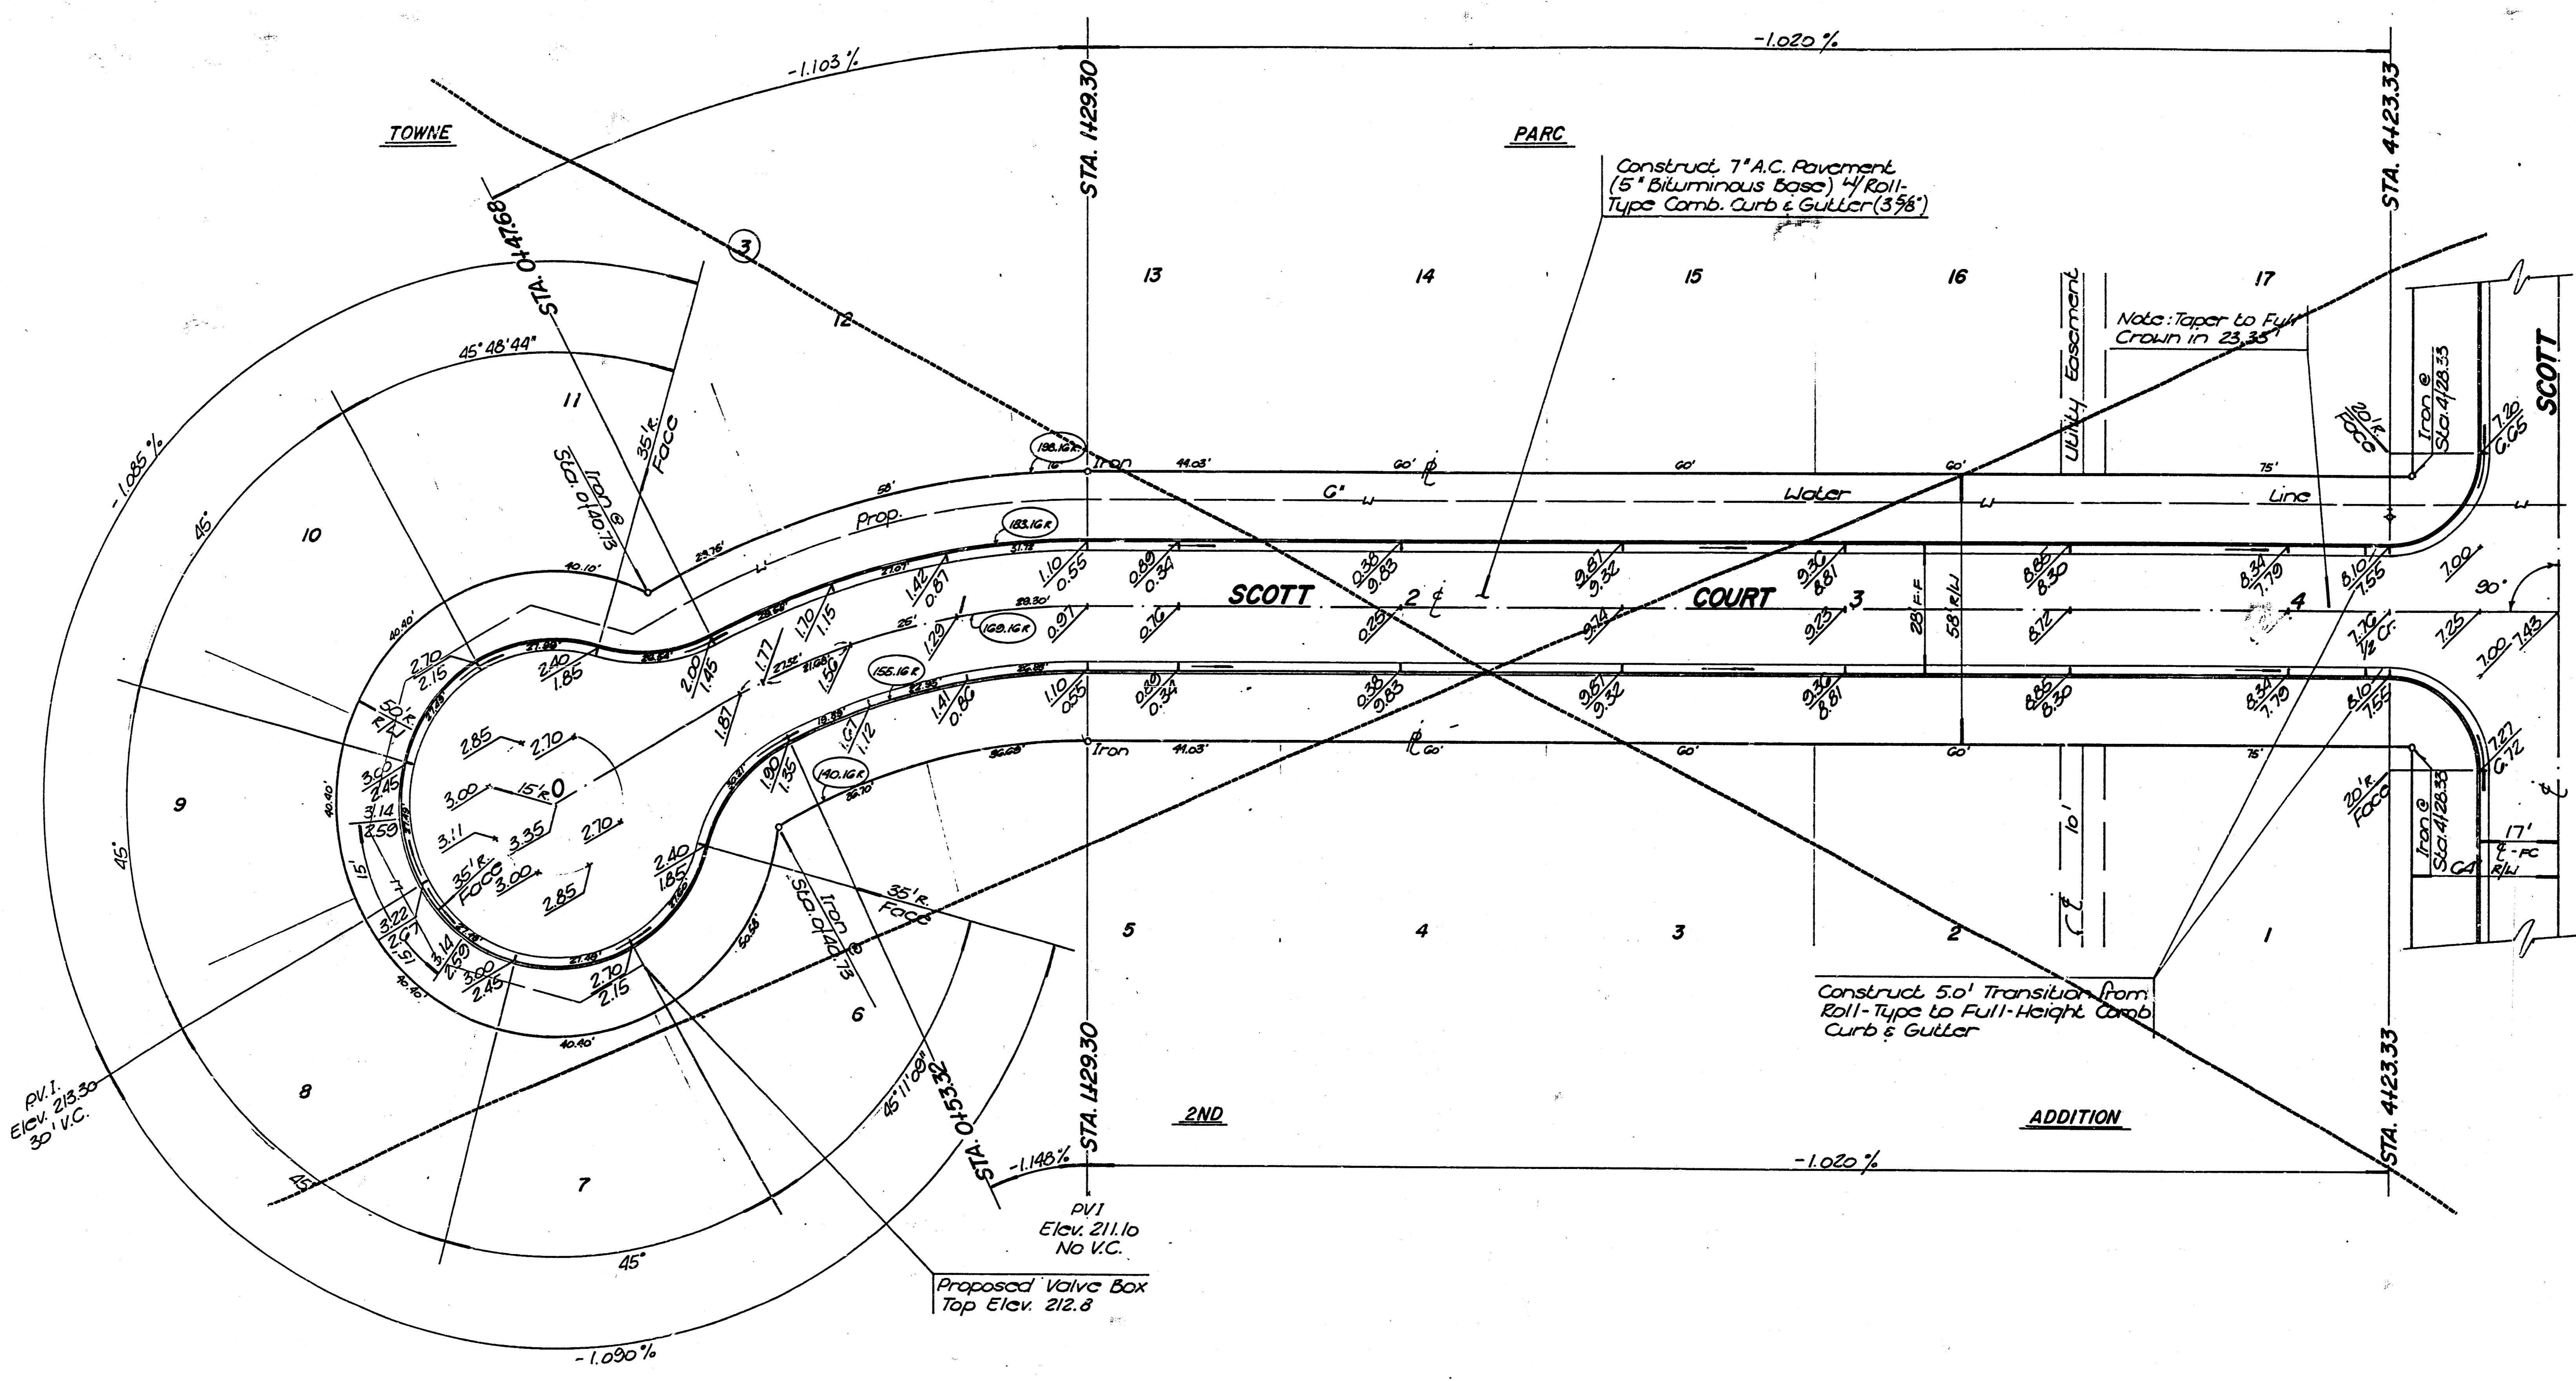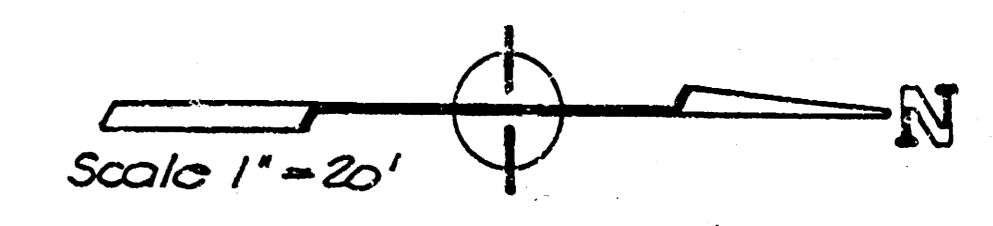

CURVE DATA BASED ON CENTERLINE DATA

$R = 109.16 \Delta = 30^\circ L = 88.57 \text{ Chd.} = 87.56 \text{ Tan.} = 45.33 \text{ Def/ft.} = 10.16145 \text{ min.}$

Station	Arc Length	CHORD LENGTHS		Deflection Angle	Total Deflection Angle
		8' Left/face	8' Right/face		
0+40.73 PC	—	—	—	0°00'	0°00'
0+47.08 PL	6.35	7.52	—	1°10'37"	1°10'37"
0+53.32 (PI)	6.24	—	5.17	0°57'10"	2°07'50"
0+75	21.68	15.95	19.87	3°40'18"	5°48'14"
1+00	25'	27.04	22.91'	4°14'02"	10°02'16"
1+20.30 PT	20.30	31.09	26.84'	4°57'44"	15°00'00"

NOTE
 Roll-Typs Combined Curb & Gutter (5 3/8") is to be Constructed in Scott Court. Transitions from Roll-Typs to Full-Height Curb to be paid for as LF of Full-Height Comb. Curb & Gutter (6 9/8")

NOTE
 PAVEMENT ON SCOTT COURT WILL NOT BE CONSTRUCTED WITH THIS PROJECT. PROVIDED FOR INFORMATION ONLY.

SCOTT COURT
 STA. 0+00 TO STA. 4+60.33




BAUGHMAN COMPANY P. A.
 SURVEYING & ENGINEERING
 316/282-7271 • 315 ELLIS • WICHITA, KANSAS 672.1

PROJECT NUMBER
472-76-245-80001-000-000-

SHEET
9

DESIGN: C. Bohm DRAWN: R.J. Plush APPROVED: _____ DATE: _____ SCALE: 1" = 20' OF 12 9/12

BENCHMARKS
 Bench Mark 1: 0' Cut Top of Curb 68' ± W. of Section Line S. side of Hurst. Elevation 211.22 City Datum
 Bench Mark 2: 0' Cut Top of Curb on the S. side of Carson and W. R. of Linden. Elevation 201.71 City Datum

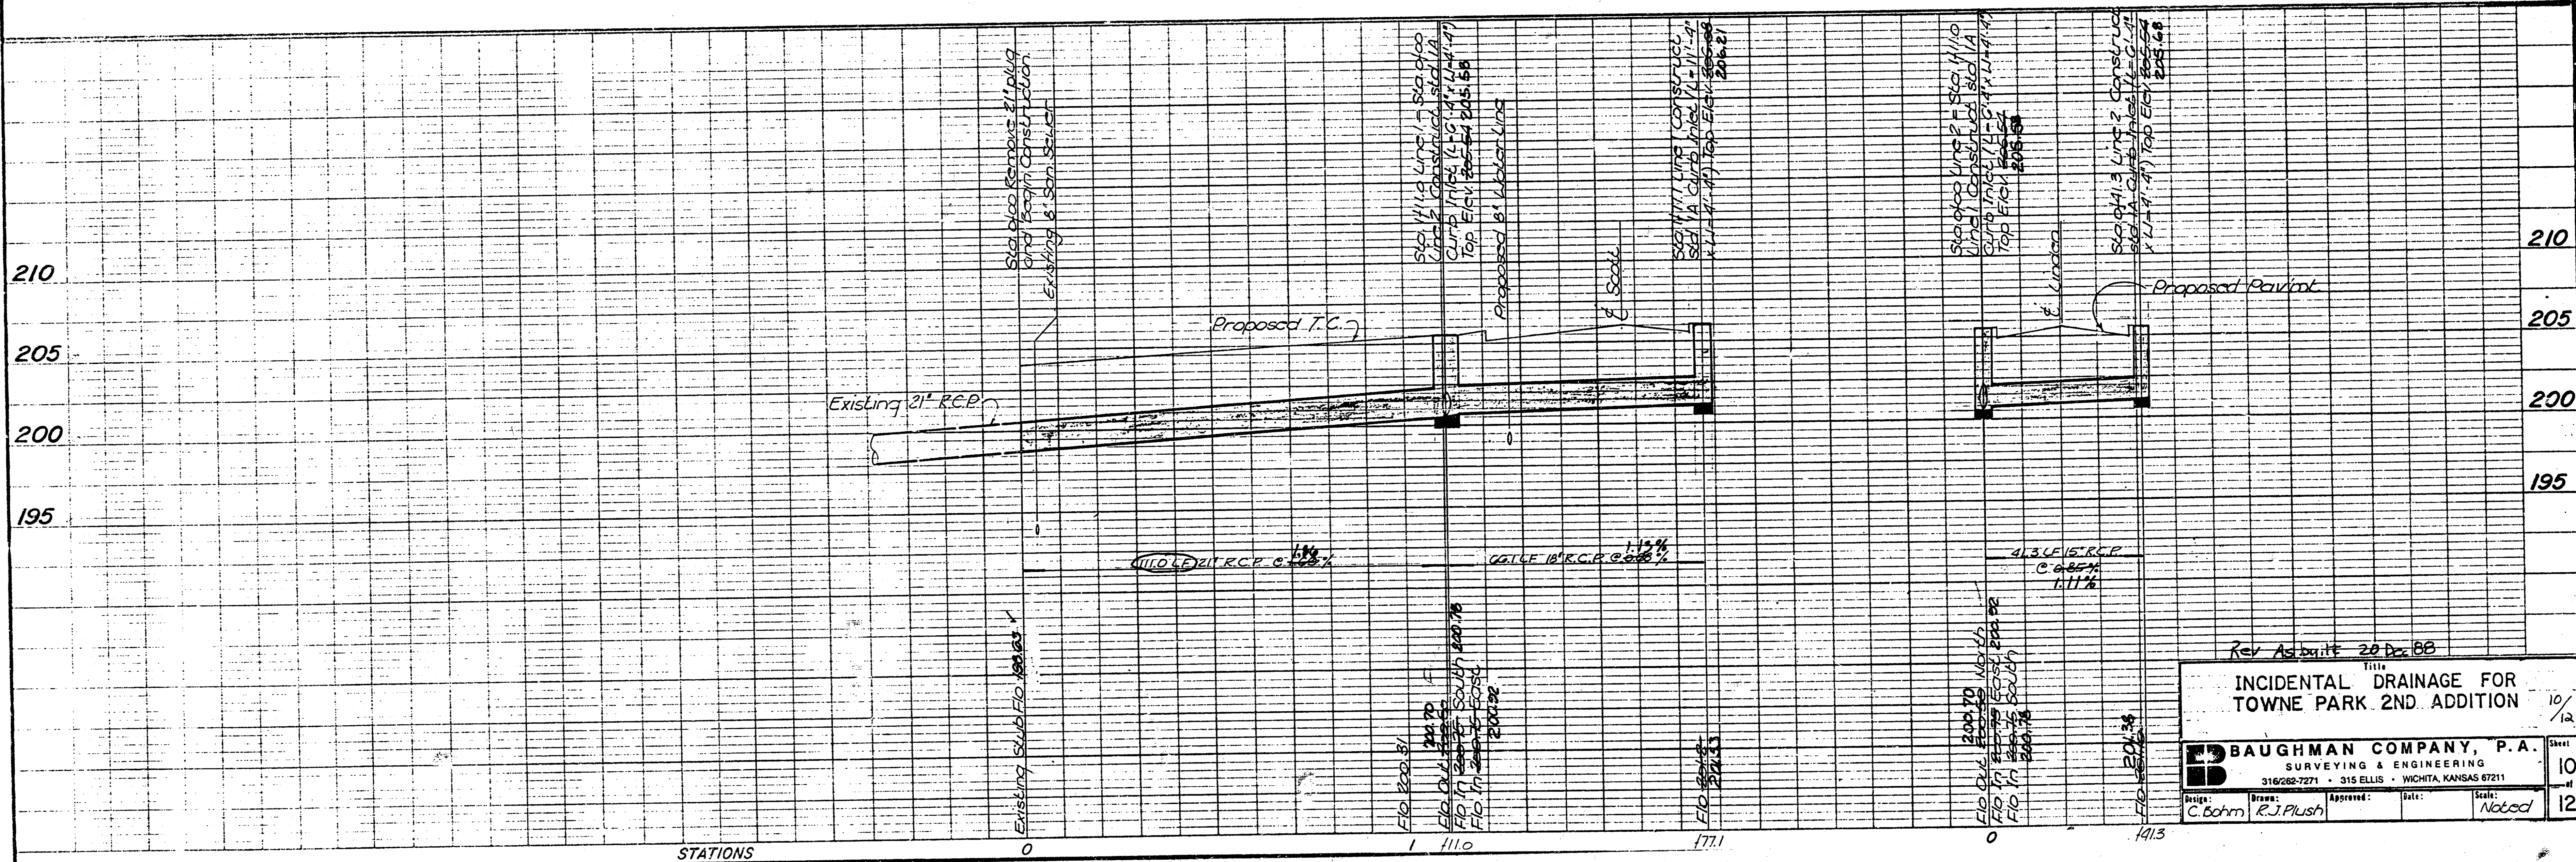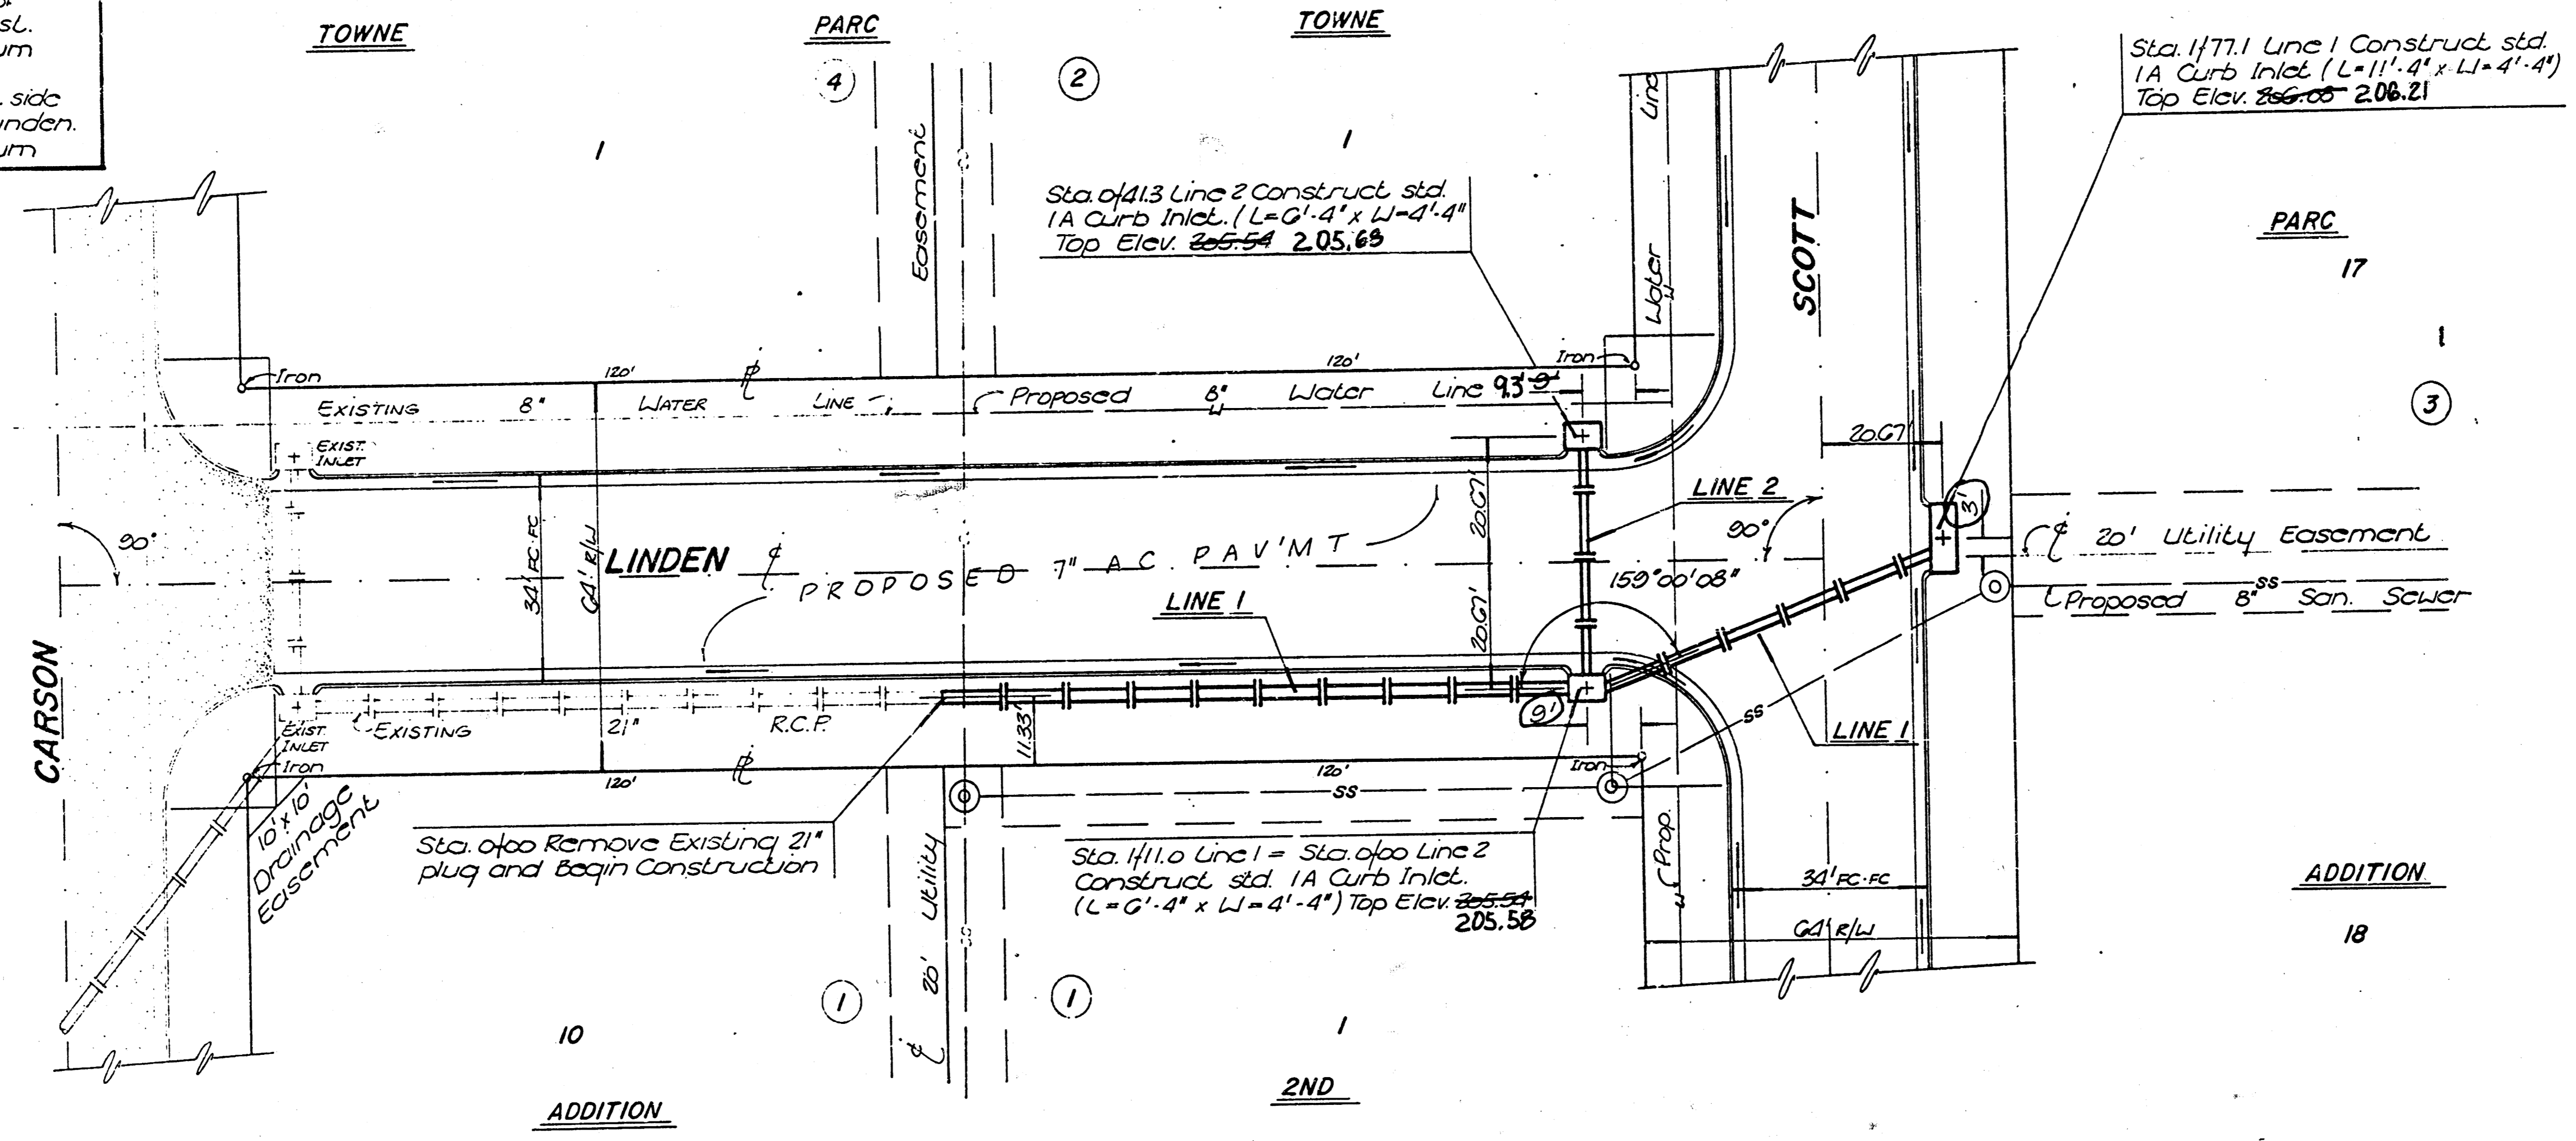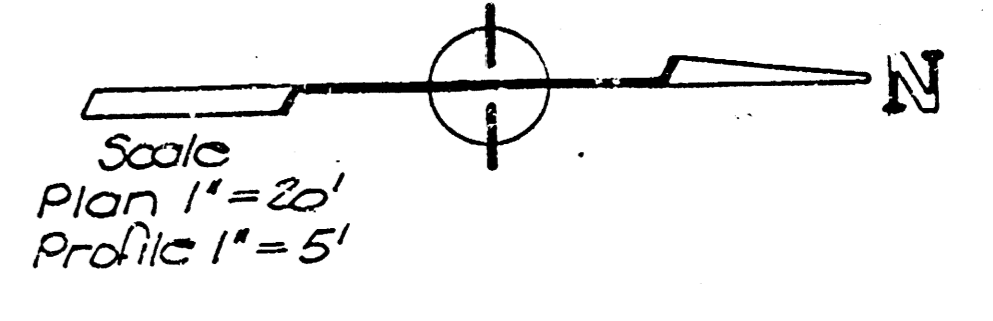

Rev As built 20 Dec 88

INCIDENTAL DRAINAGE FOR TOWNE PARK 2ND ADDITION




BAUGHMAN COMPANY, P.A.
 SURVEYING & ENGINEERING
 316/262-7271 • 315 ELLIS • WICHITA, KANSAS 67211

Design: C. Bohm, R.J. Plush
 Approved: _____
 Date: _____
 Scale: Noted

Sheet 10 of 12

DATE	
NO.	
BY	
CHECKED	
APPROVED	
SCALE	
PROJECT	
NO.	

PROFILE	
NO.	
DATE	
BY	
CHECKED	
APPROVED	
SCALE	
PROJECT	
NO.	

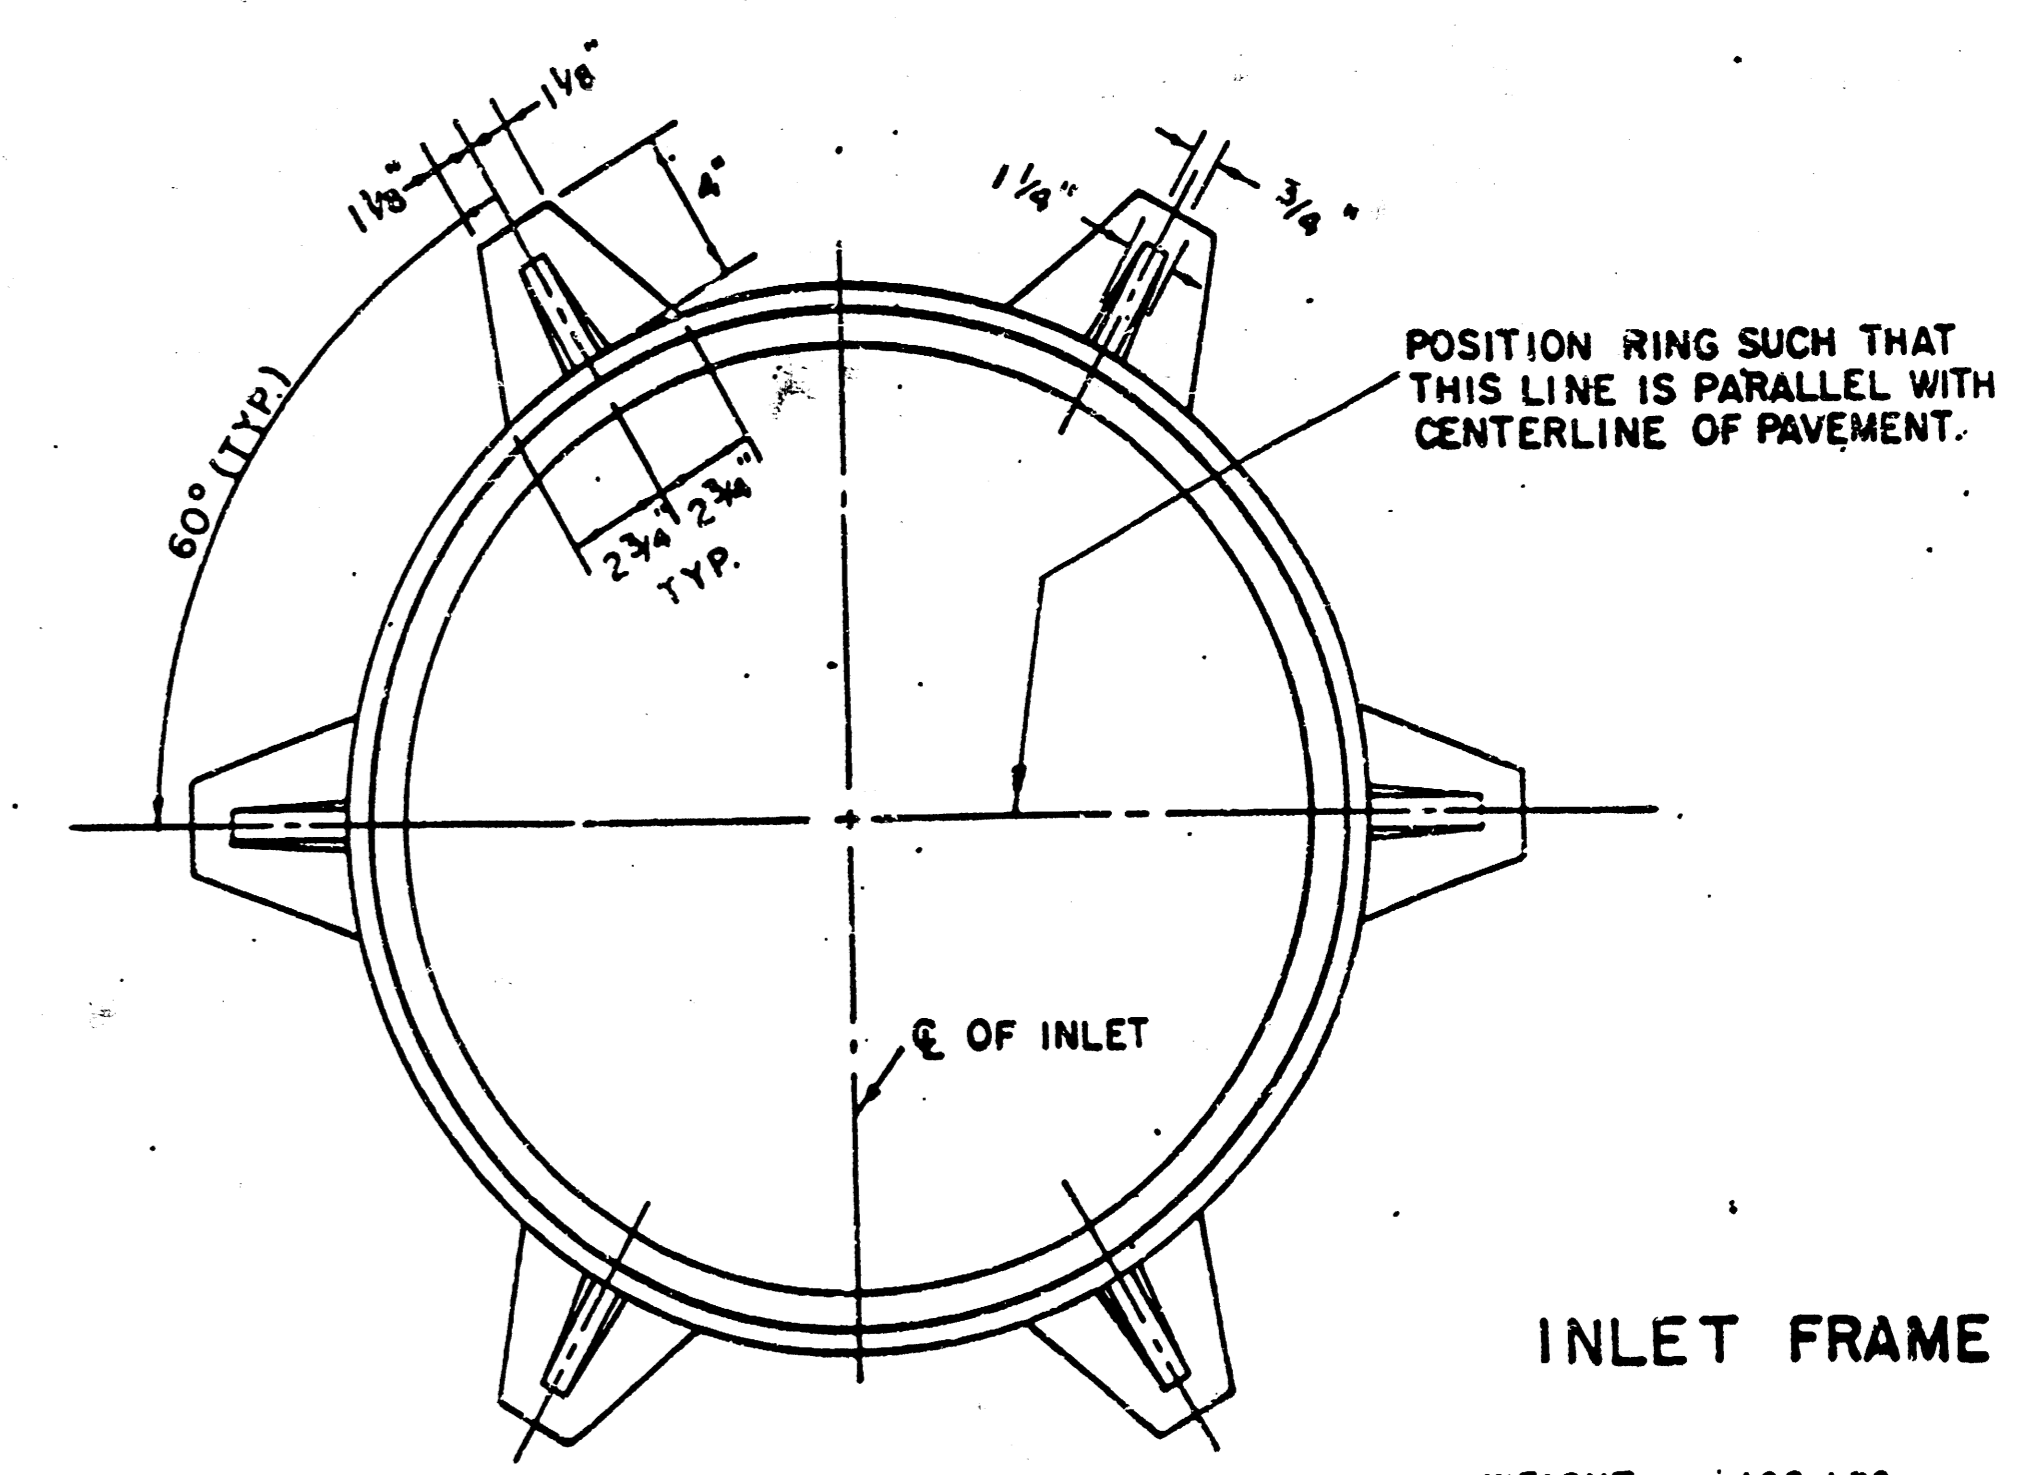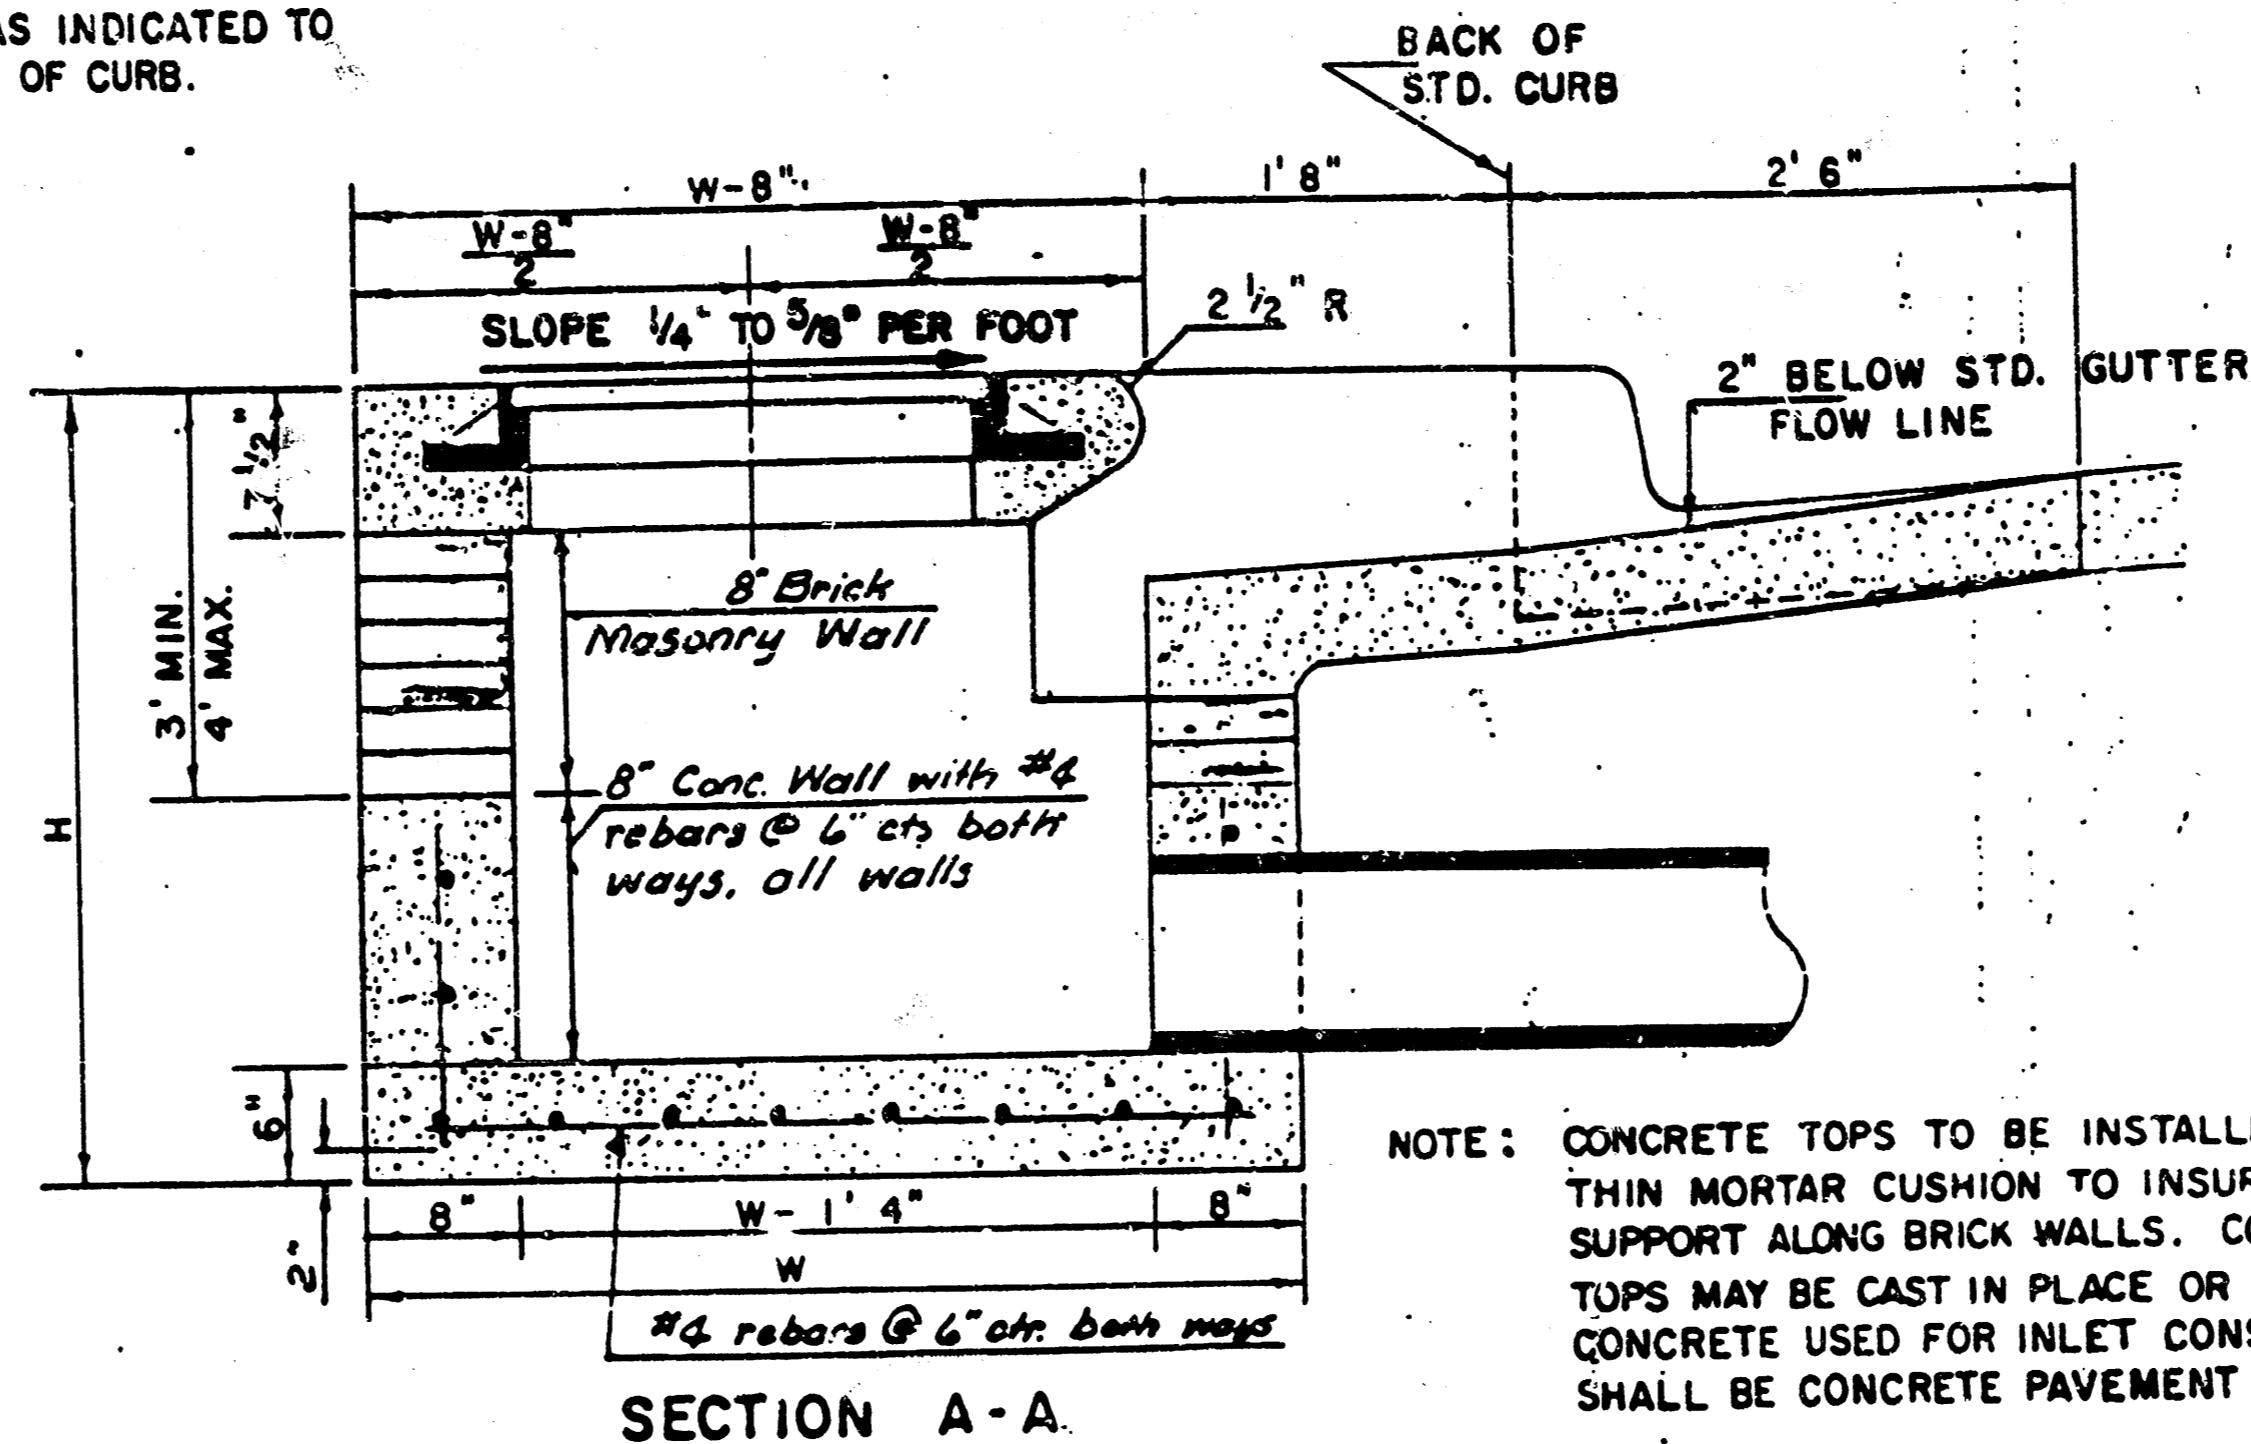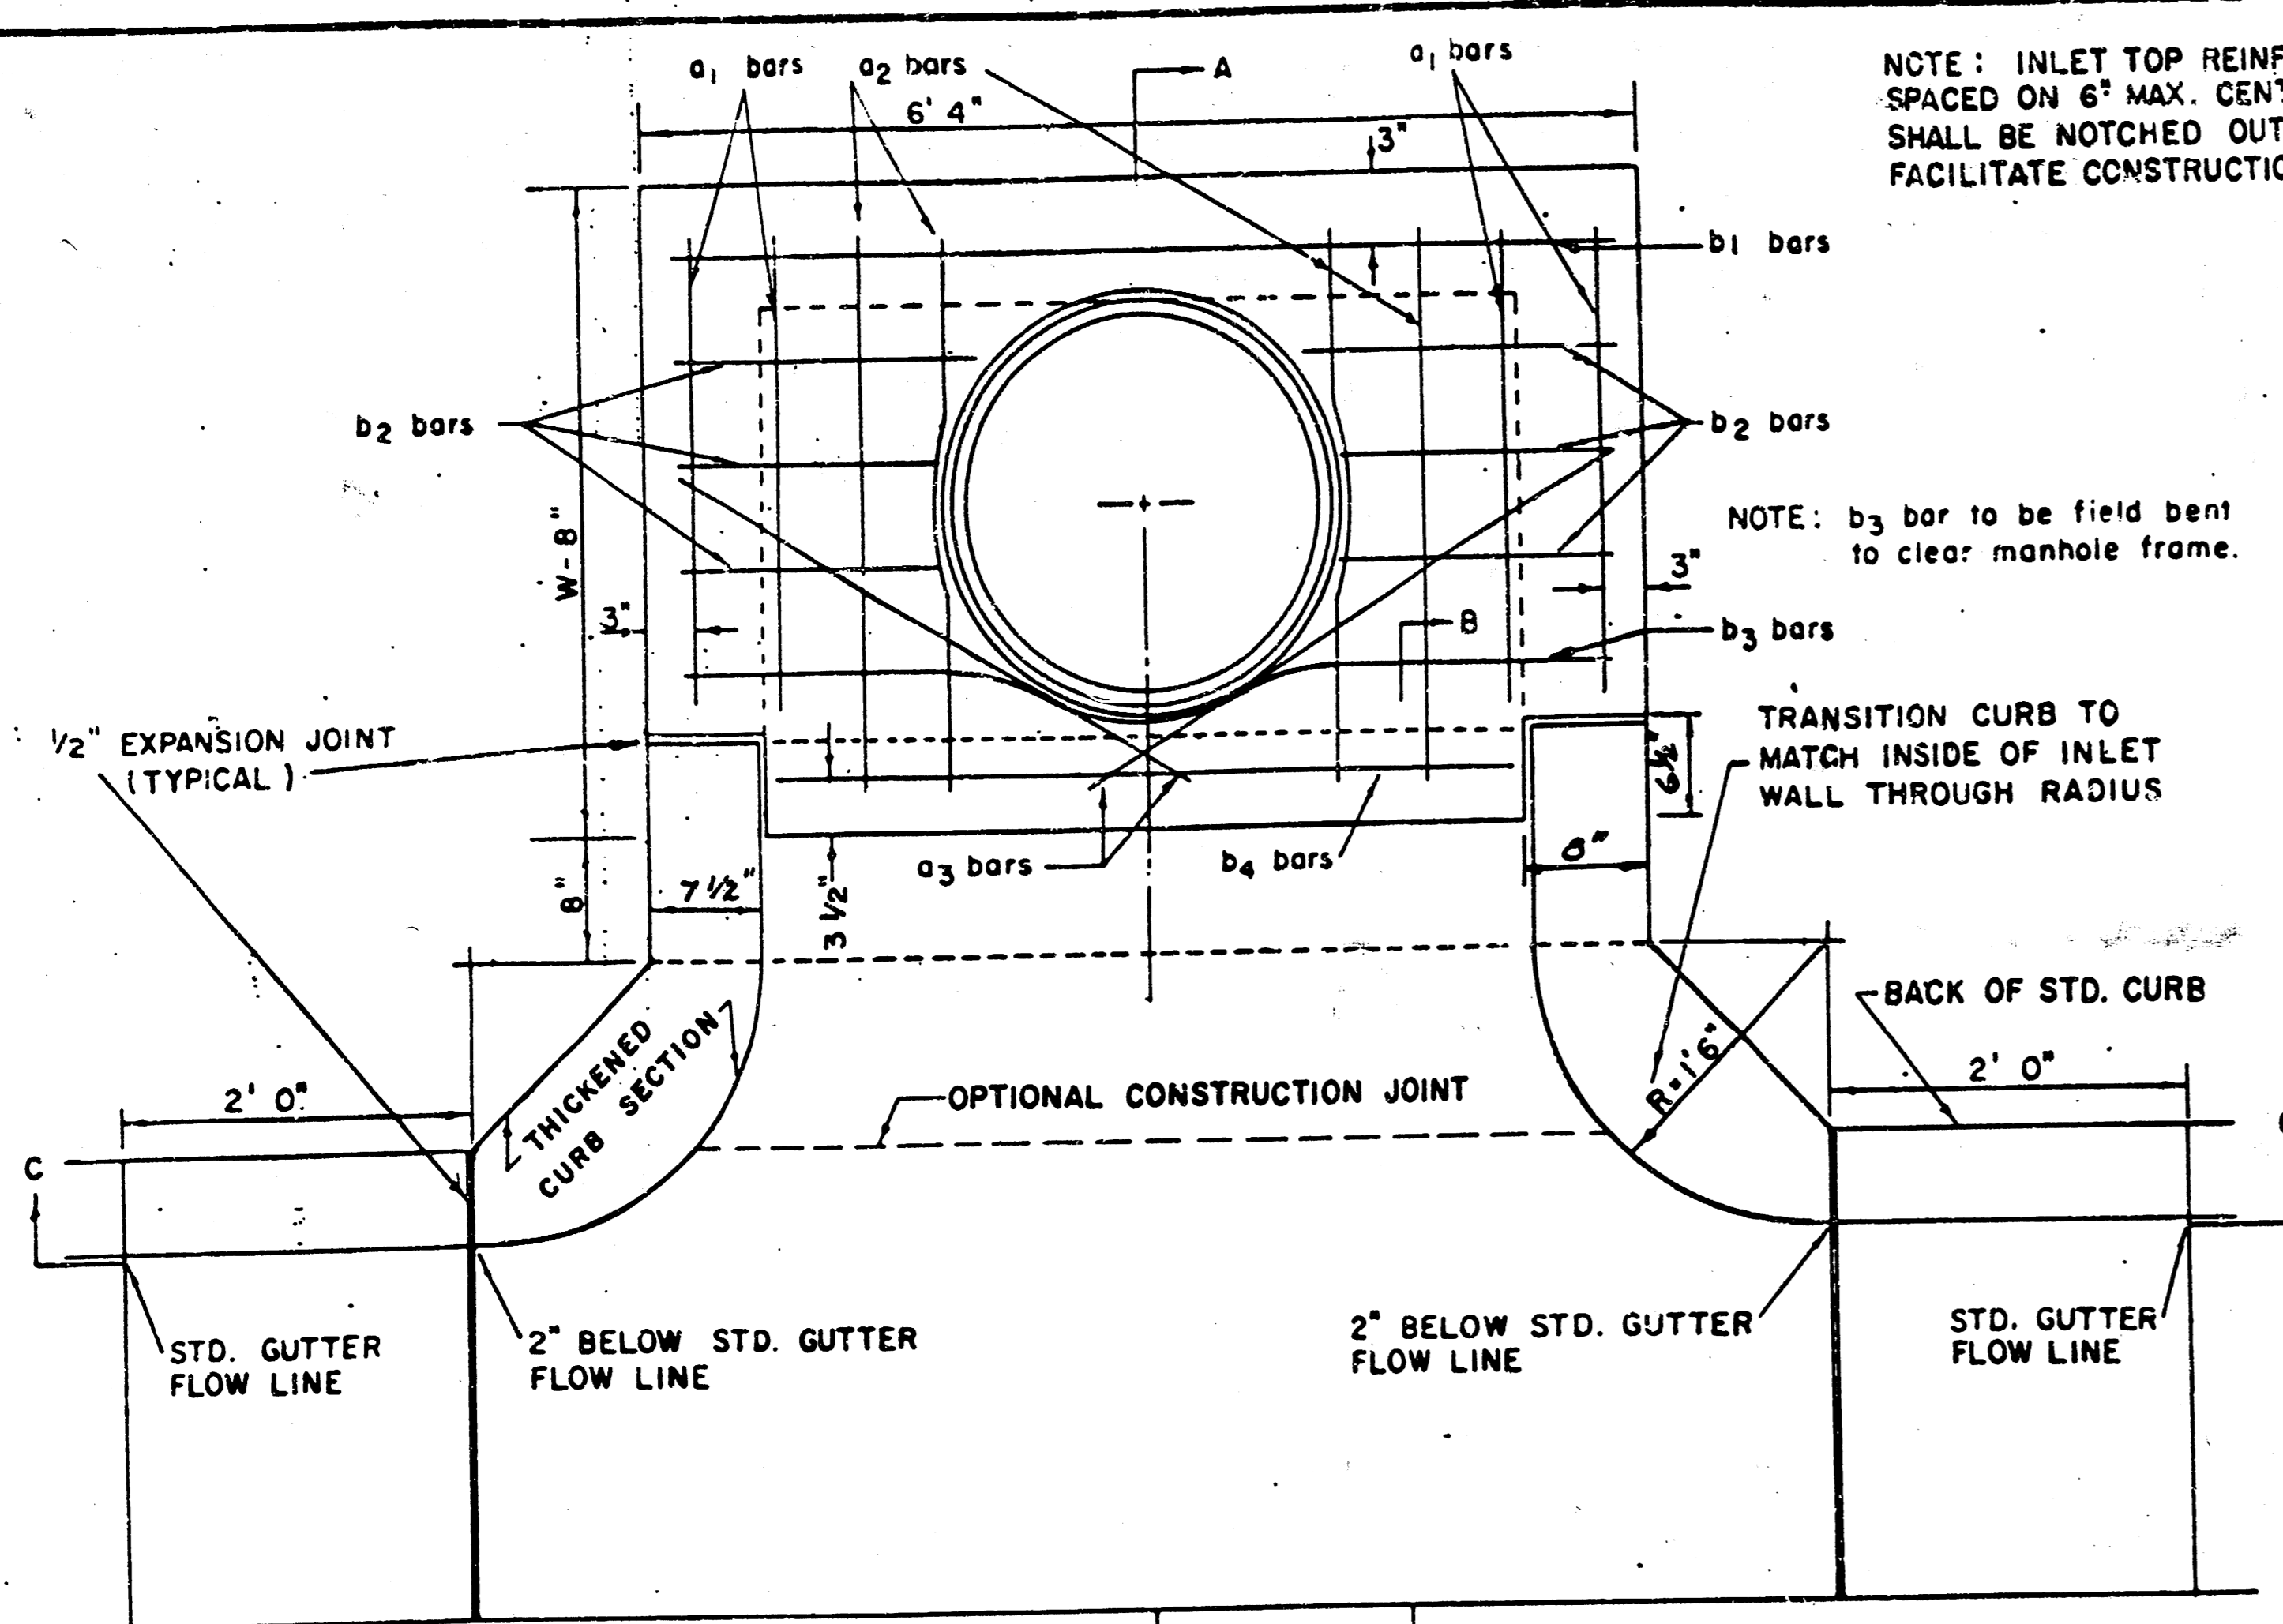

NOTE: CONTRACTOR SHALL HAVE THE OPTION OF CONSTRUCTING 8" BRICK MASONRY WALLS BETWEEN THE CONCRETE INLET BASE AND TOP ON THIS INLET WHEN $W = 6'4"$ AND $H = 7'0"$ OR LESS.

ADDITIONAL CURB AND GUTTER CONSTRUCTION NECESSARY TO CONNECT SET-BACK INLET TO PAVEMENT WILL BE PAID FOR AT THE UNIT PRICE BID FOR EACH INLET HOOKUP.


INLET INVERT SHALL BE SHAPED WITH 8 SACK SAND MIX CONCRETE TO CREATE FLOW CHANNELS AND TO INCREASE HYDRAULIC EFFICIENCY SUCH THAT THE INLET WILL BE SELF-CLEANING BETWEEN ALL INLET AND/OR OUTLET PIPES.

THE ENDS OF ALL PIPES INSTALLED IN INLETS SHALL BE CUT OFF FLUSH WITH THE INSIDE FACE OF THE INLET WALL.



STEEL SCHEDULE

BAR NUMBER	a ₁	a ₂	a ₃	b ₁				b ₂	b ₃	b ₄	WT. LBS.		
				W=4'4"	W=5'4"	W=6'4"	W=7'4"					W=8'4"	
4	4	2	1	3	5	7	9	6	1	1			
SIZE	#4	#4	#4	#4	#4	#4	#4	#4	#4	#6			
LENGTH	W=4'4"	5'7"	6'7"	4'0"	6'1"	-	-	-	1'5"	6'2"	4'5"	30±	
	W=5'4"	7'7"	8'7"	5'0"	-	6'1"	-	-	1'9"	6'2"	4'8"	81±	
	W=6'4"	9'7"	10'7"	6'0"	-	-	6'1"	-	1'9"	6'2"	4'5"	101±	
	W=7'4"	11'7"	12'7"	7'0"	-	-	-	6'1"	-	1'9"	6'2"	4'8"	121±
	W=8'4"	13'7"	14'7"	8'0"	-	-	-	-	6'1"	1'9"	6'2"	4'8"	141±

BENDING DIAGRAM

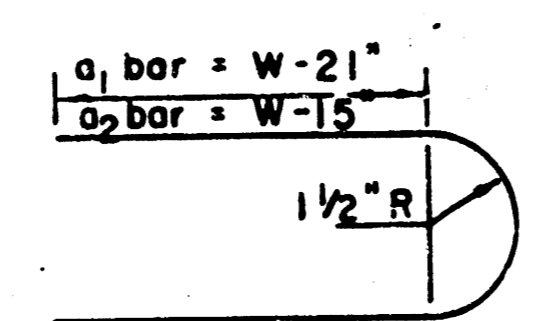

STANDARD CURB INLET PRECAST TOPS			
W	PRE-CAST TOP SIZE	PIPE SIZE	CU. YD. CONC.
4' 4"	3' 6" x 6' 4" x 7 1/2"	21" Ø SMALLER	0.38 ±
5' 4"	4' 8" x 6' 4" x 7 1/2"	24" Ø 30"	0.51 ±
6' 4"	5' 8" x 6' 4" x 7 1/2"	36" Ø 42"	0.64 ±
7' 4"	6' 8" x 6' 4" x 7 1/2"	48" Ø 54"	0.77 ±
8' 4"	7' 8" x 6' 4" x 7 1/2"	60" Ø 66"	0.90 ±

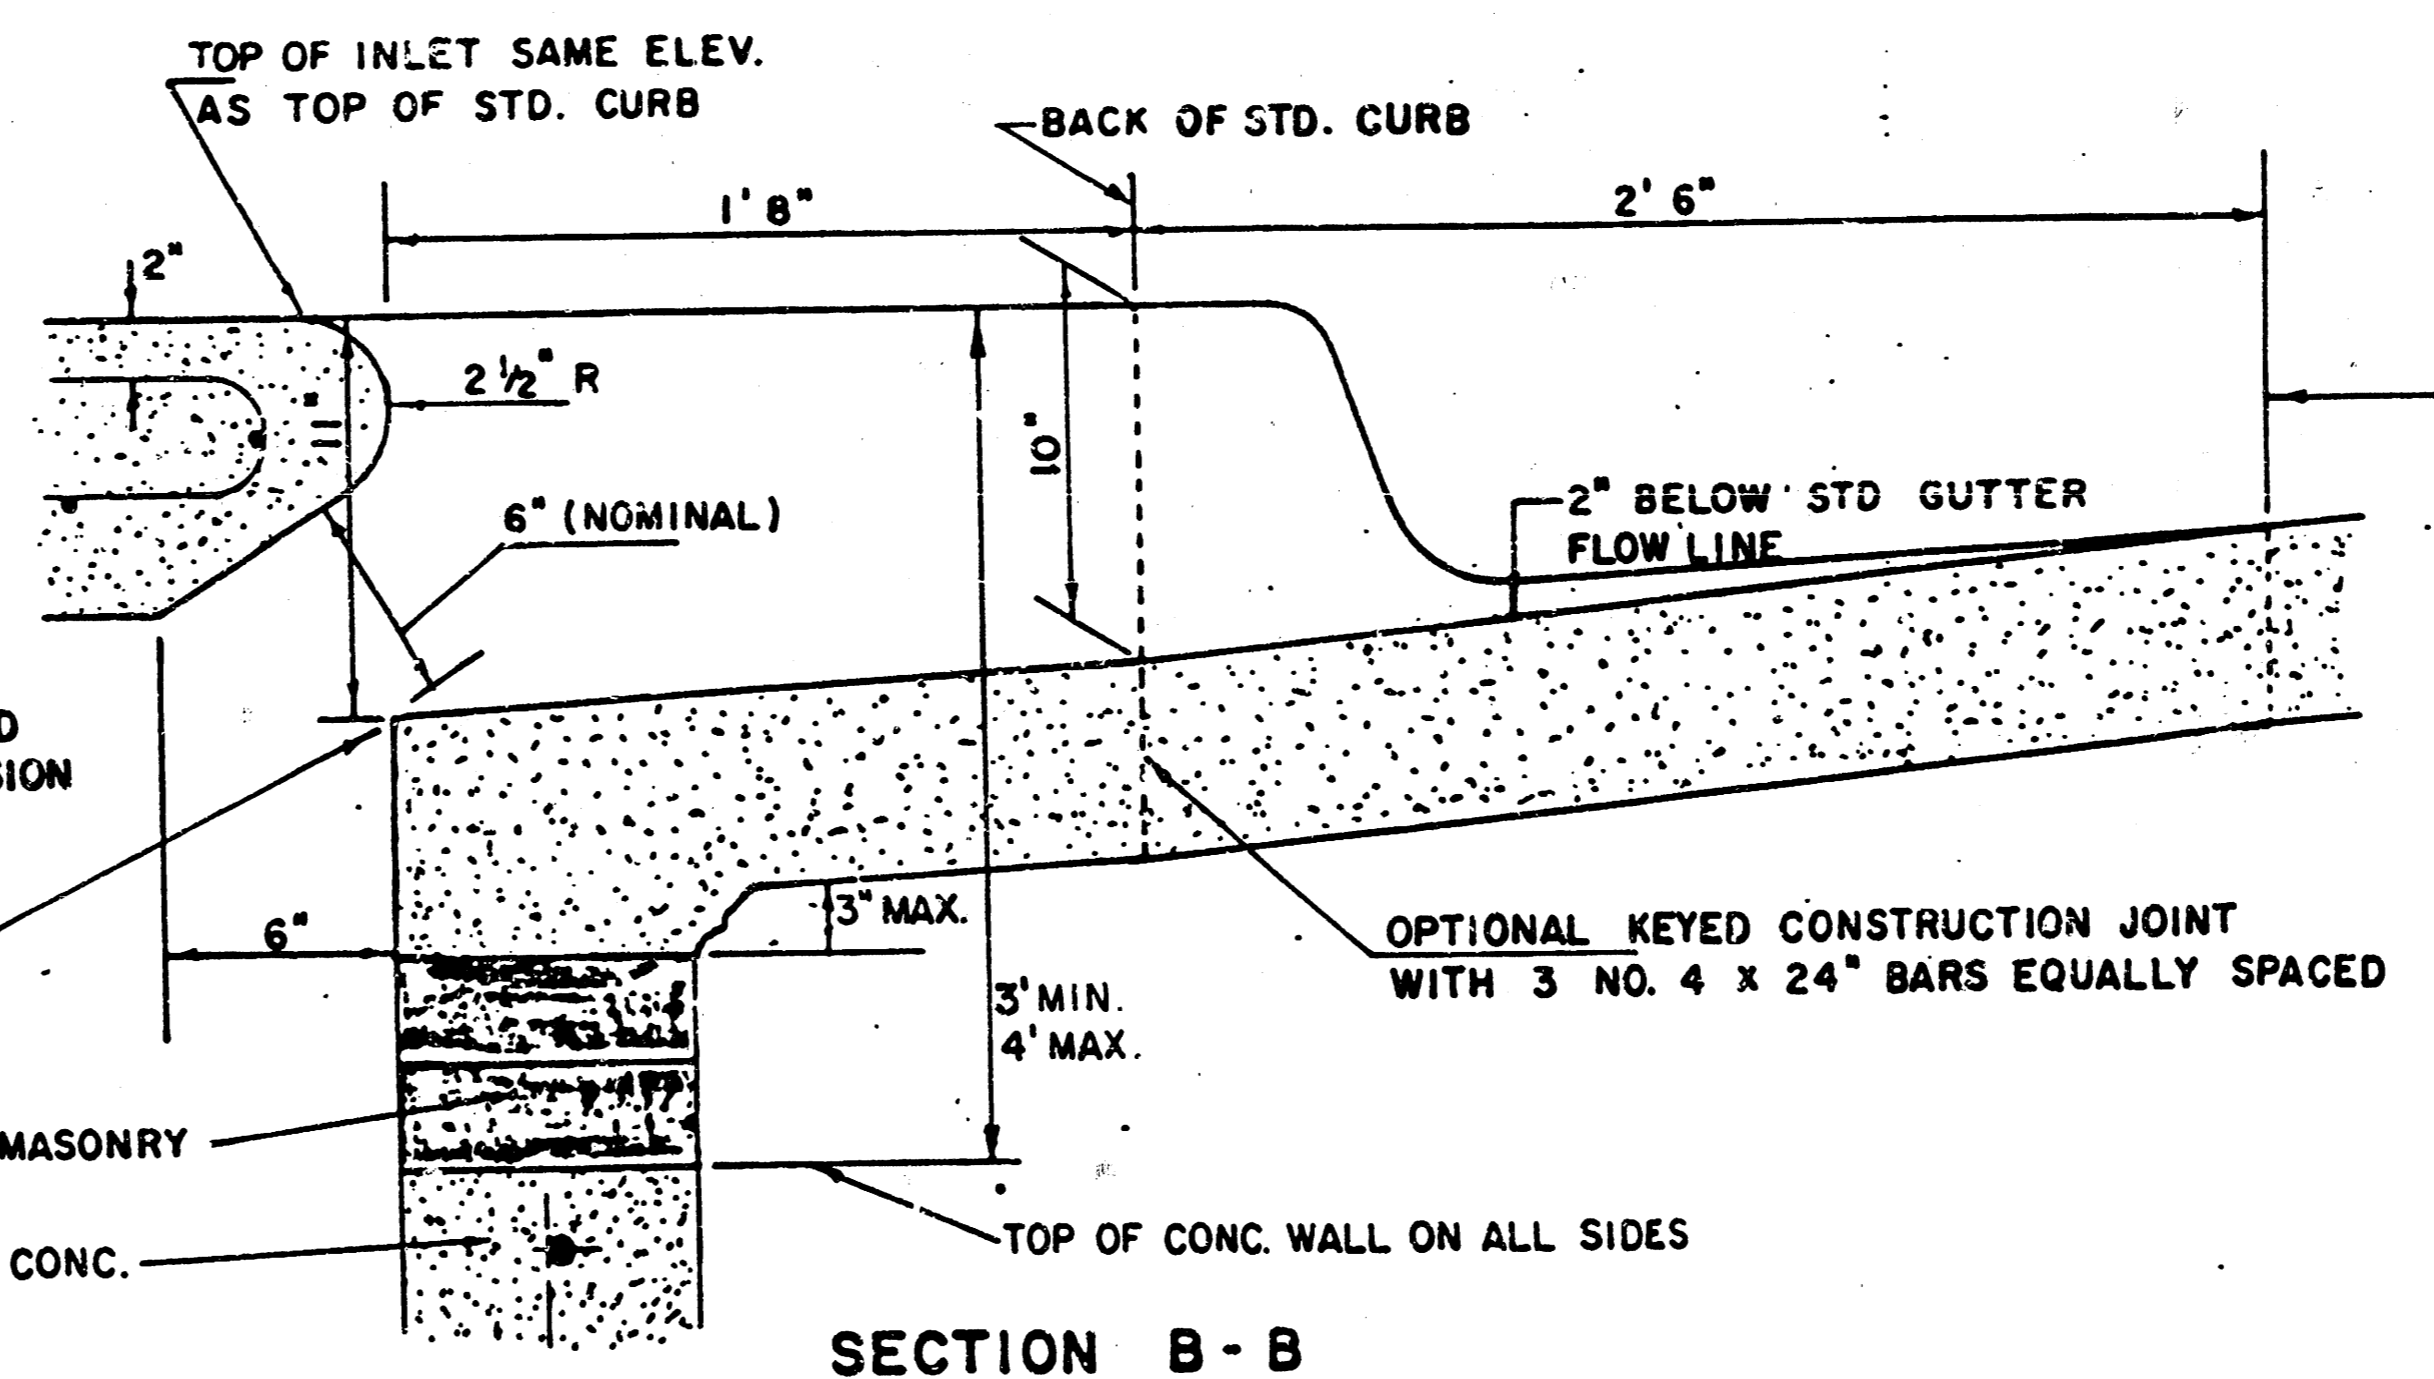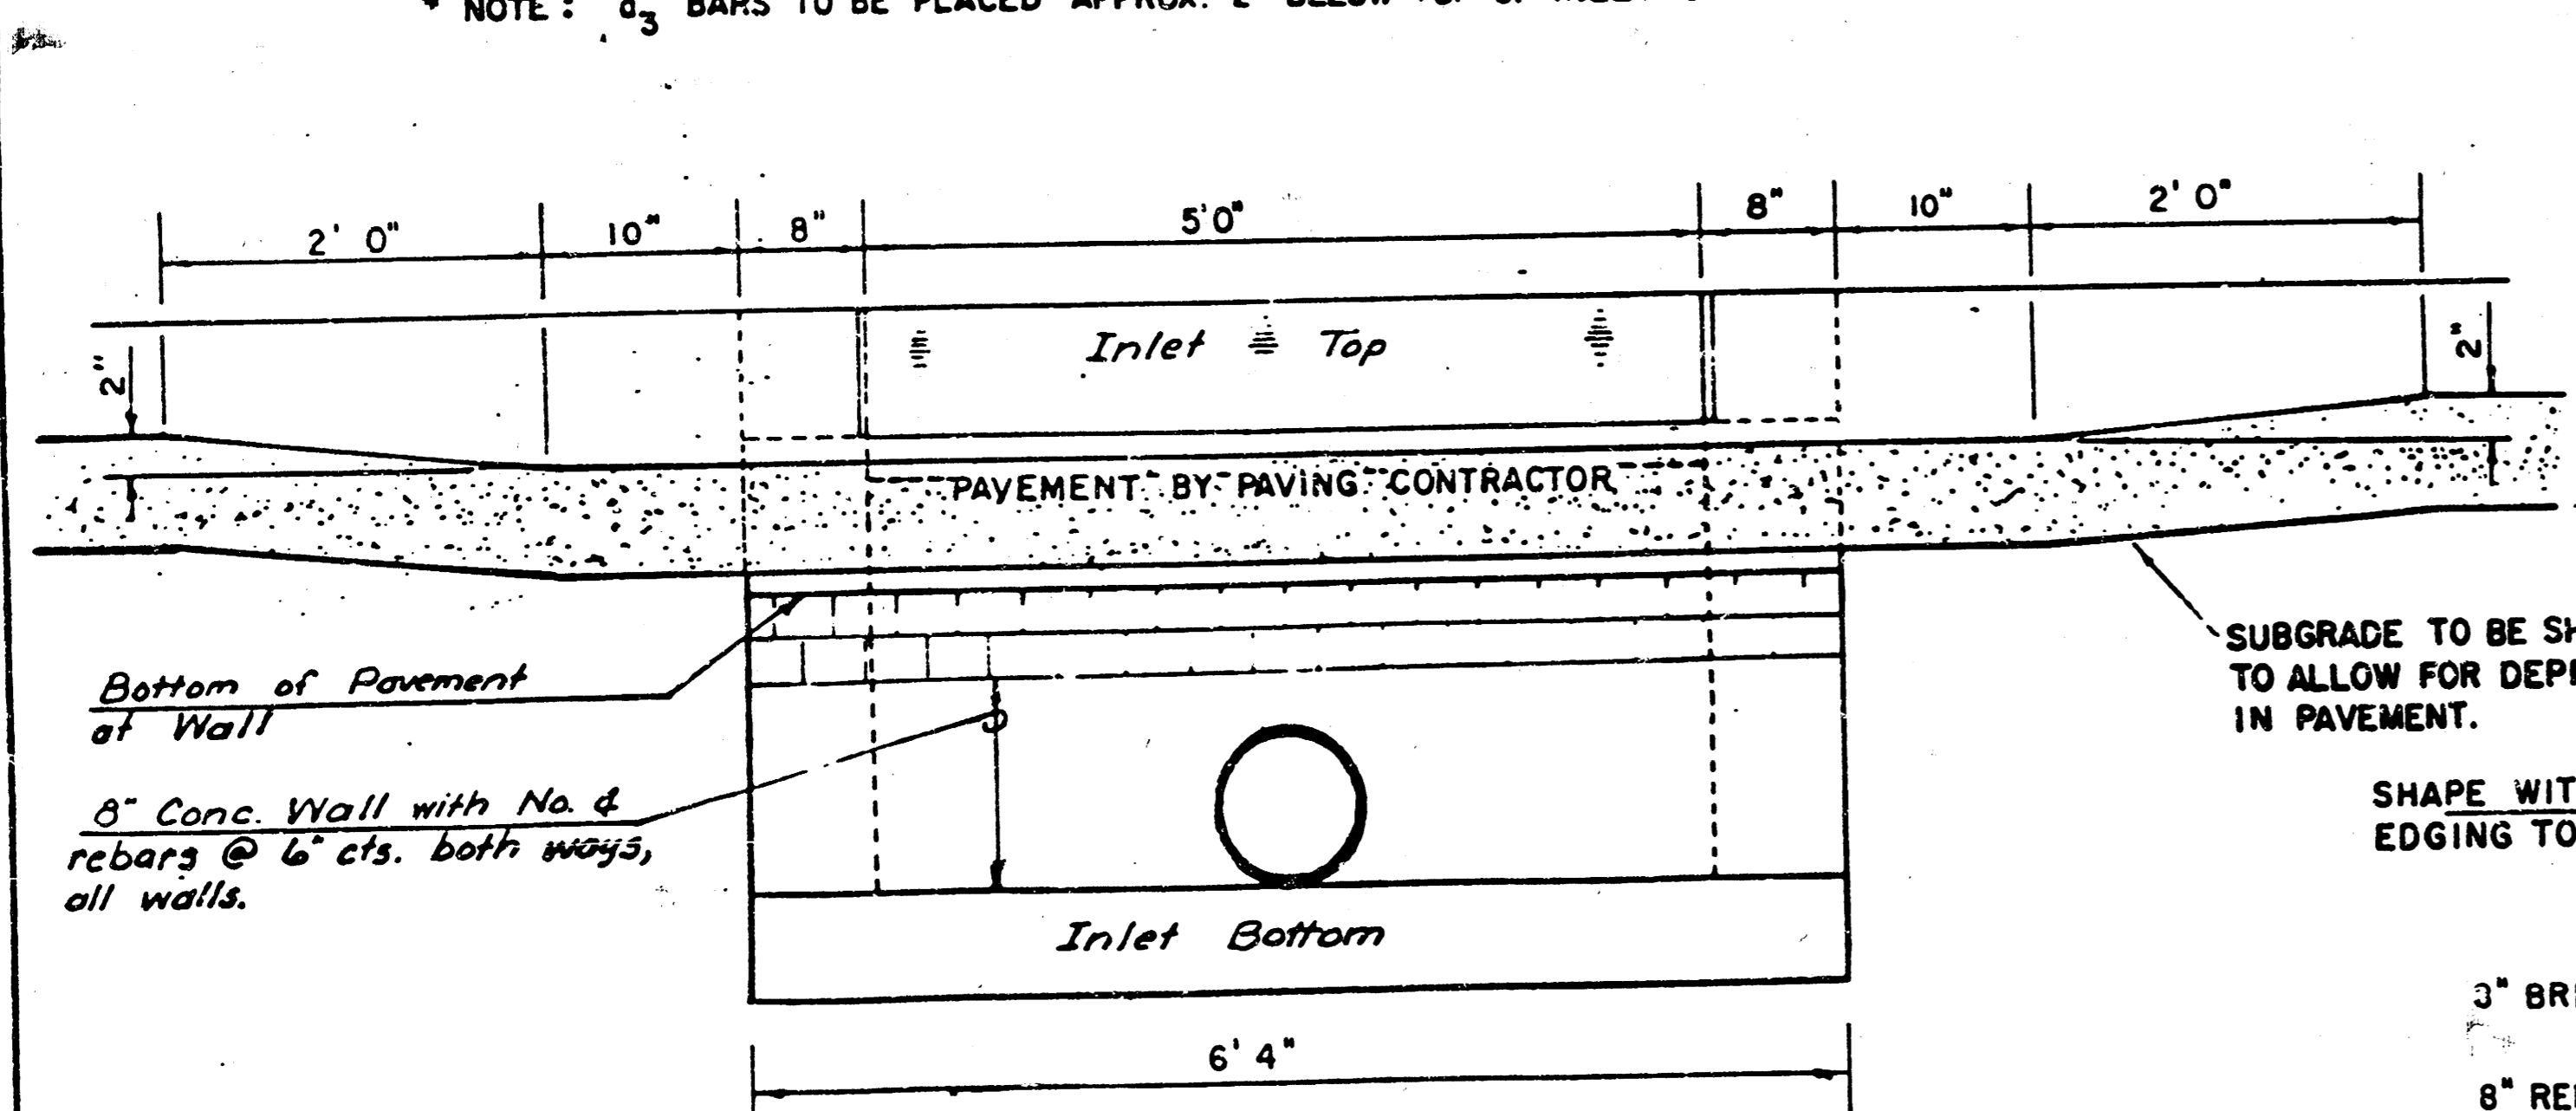

REVISED 12-21-1984












DETAIL STANDARD TYPE IA CURB INLET

CITY OF WICHITA, KANSAS

INLET OPENING = 6" x 5' 0"

472-76-245-80001-000-000

JUNE 1984

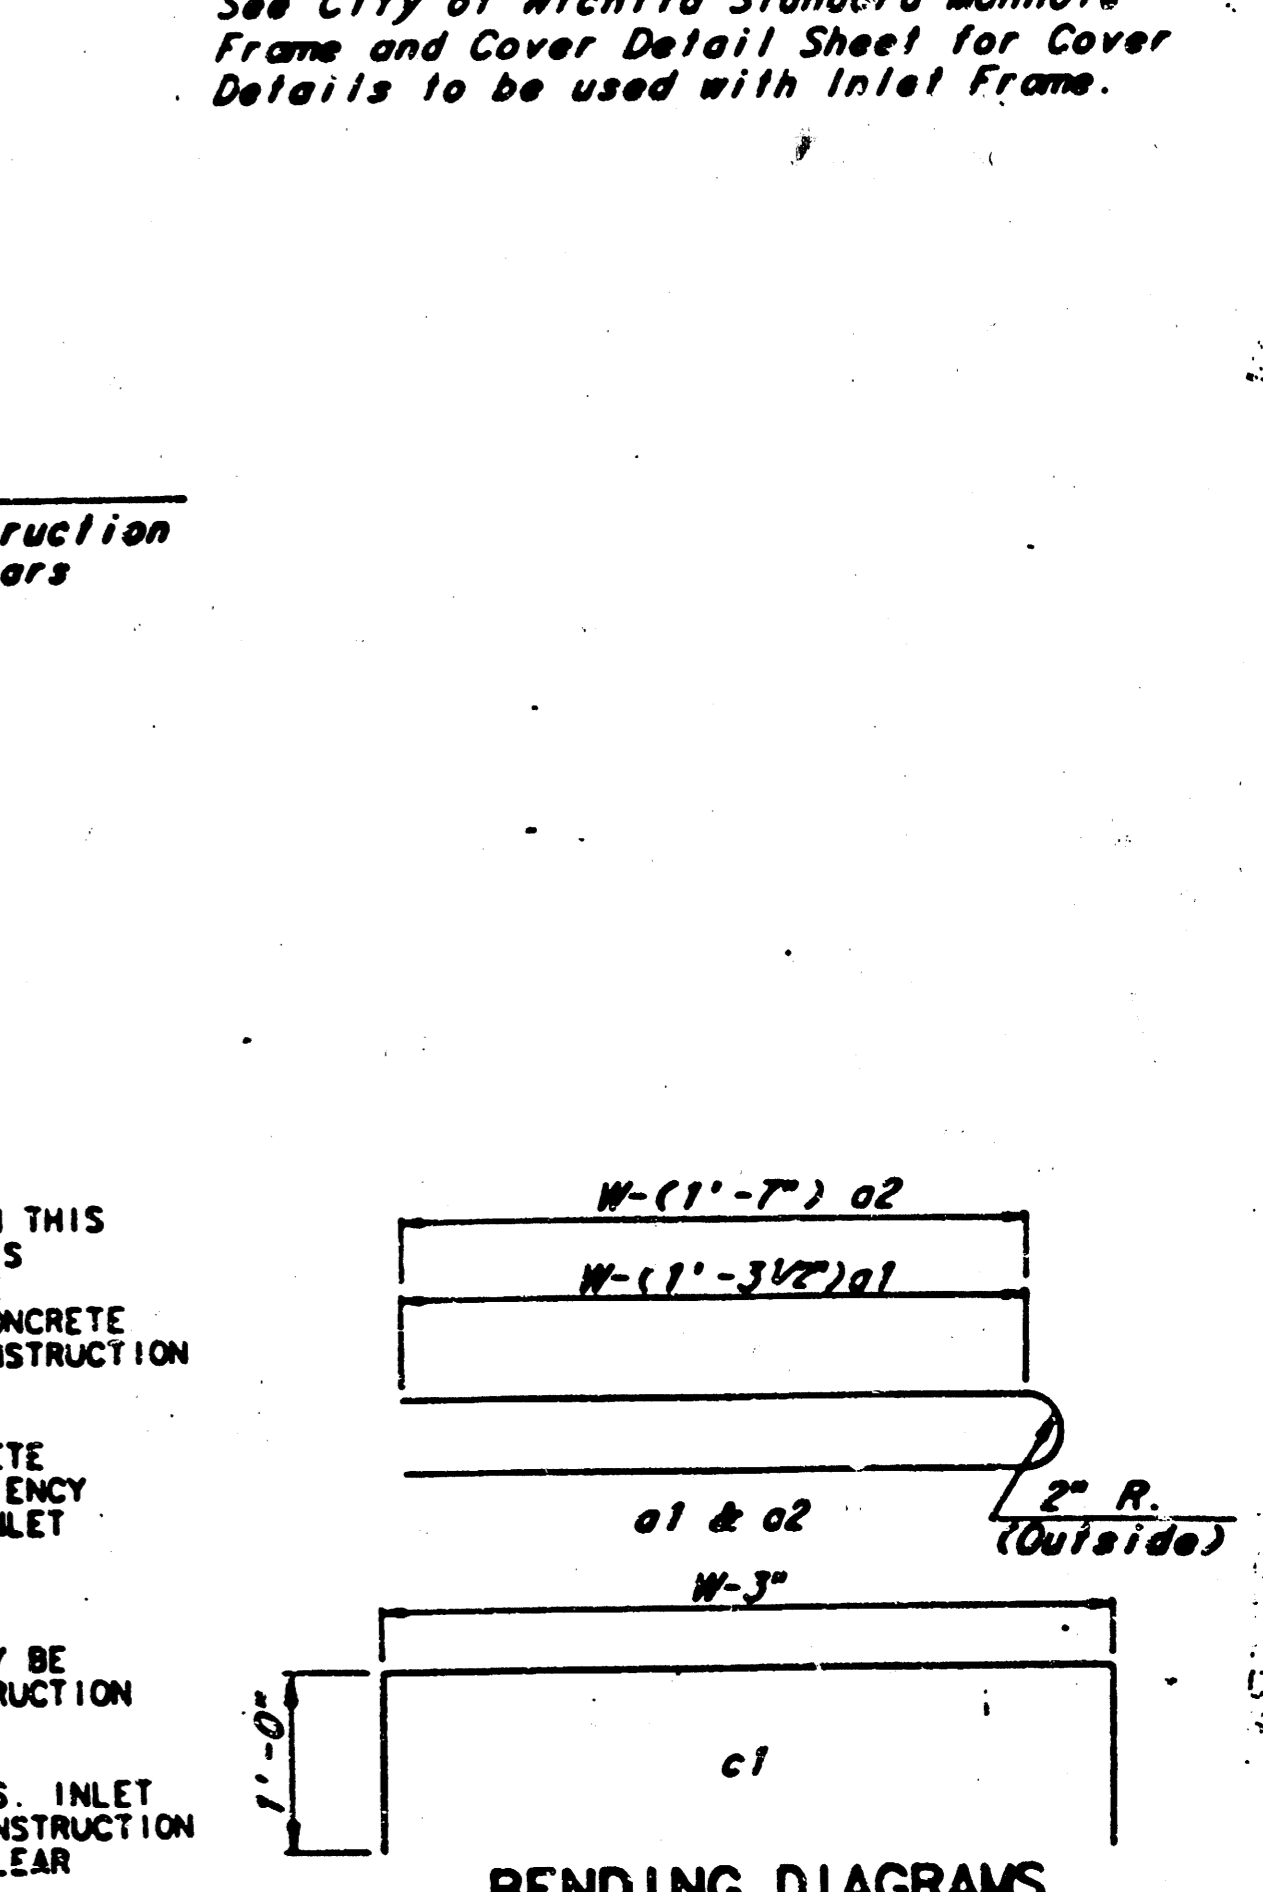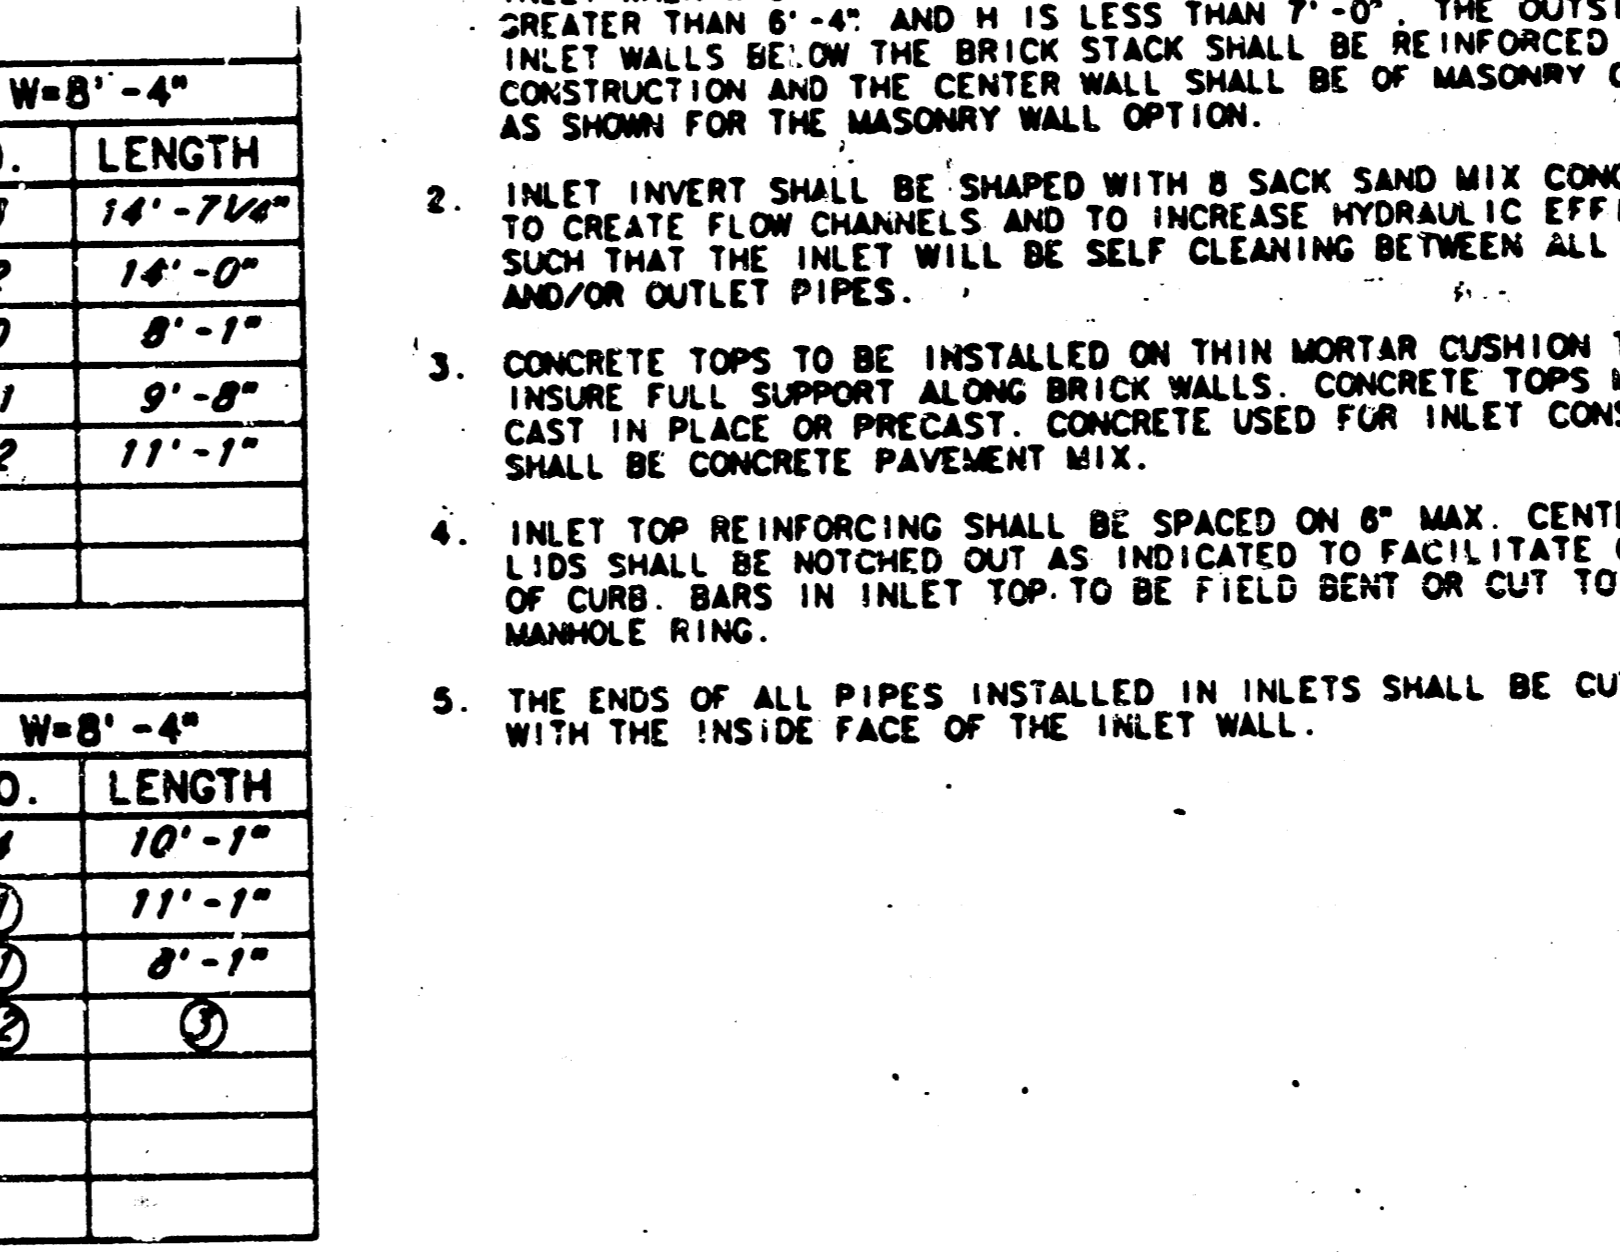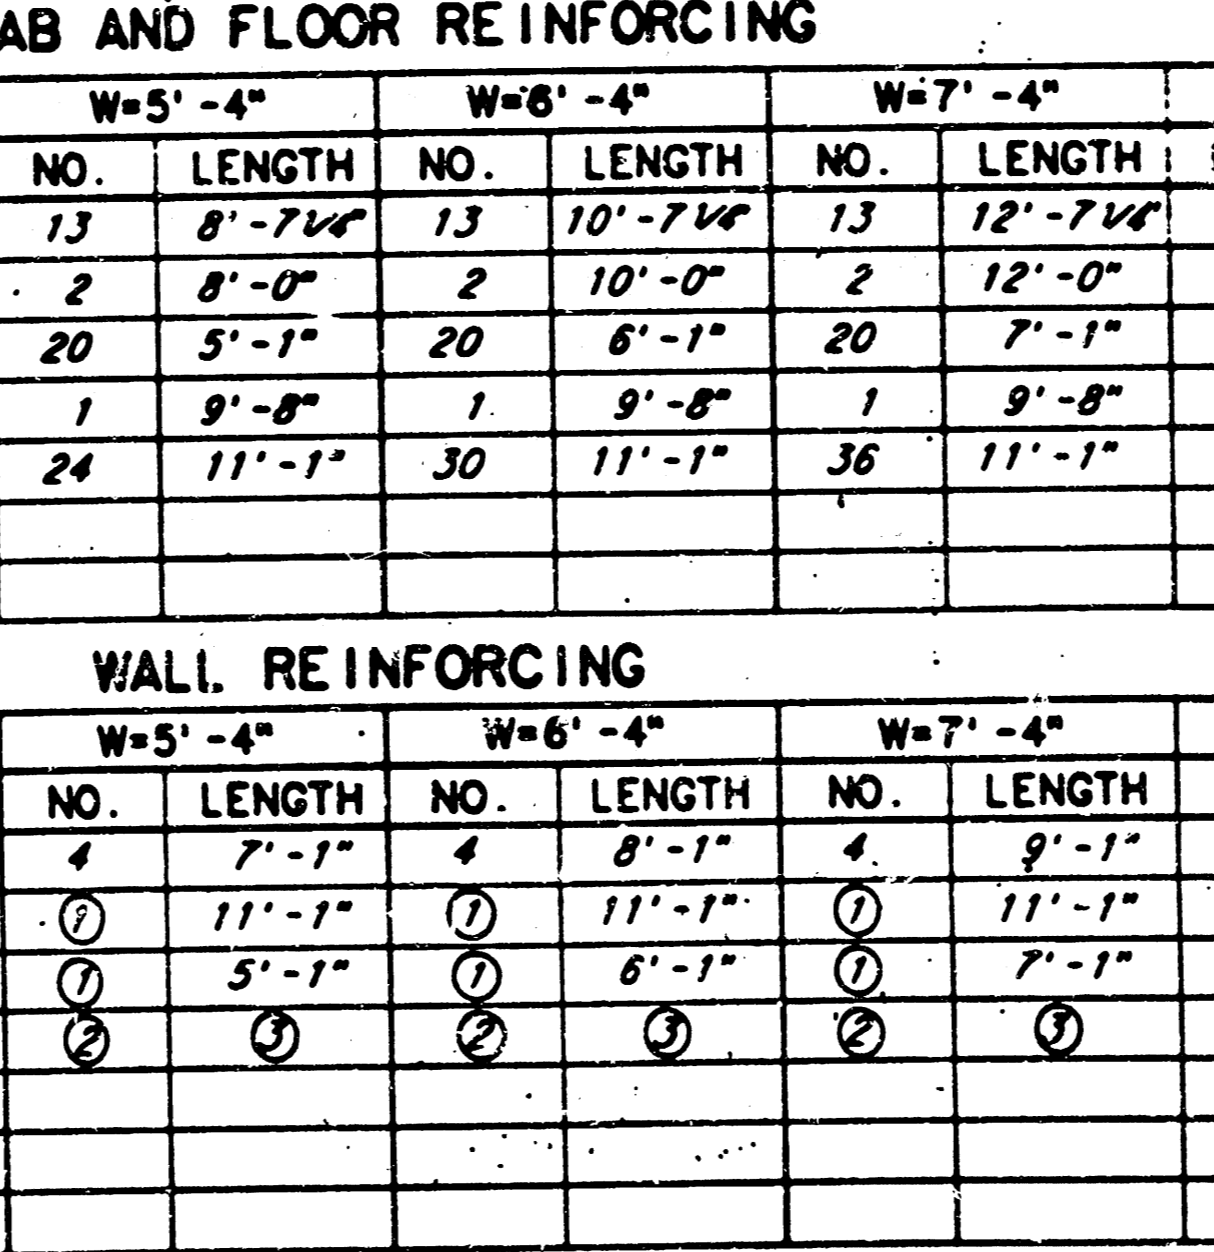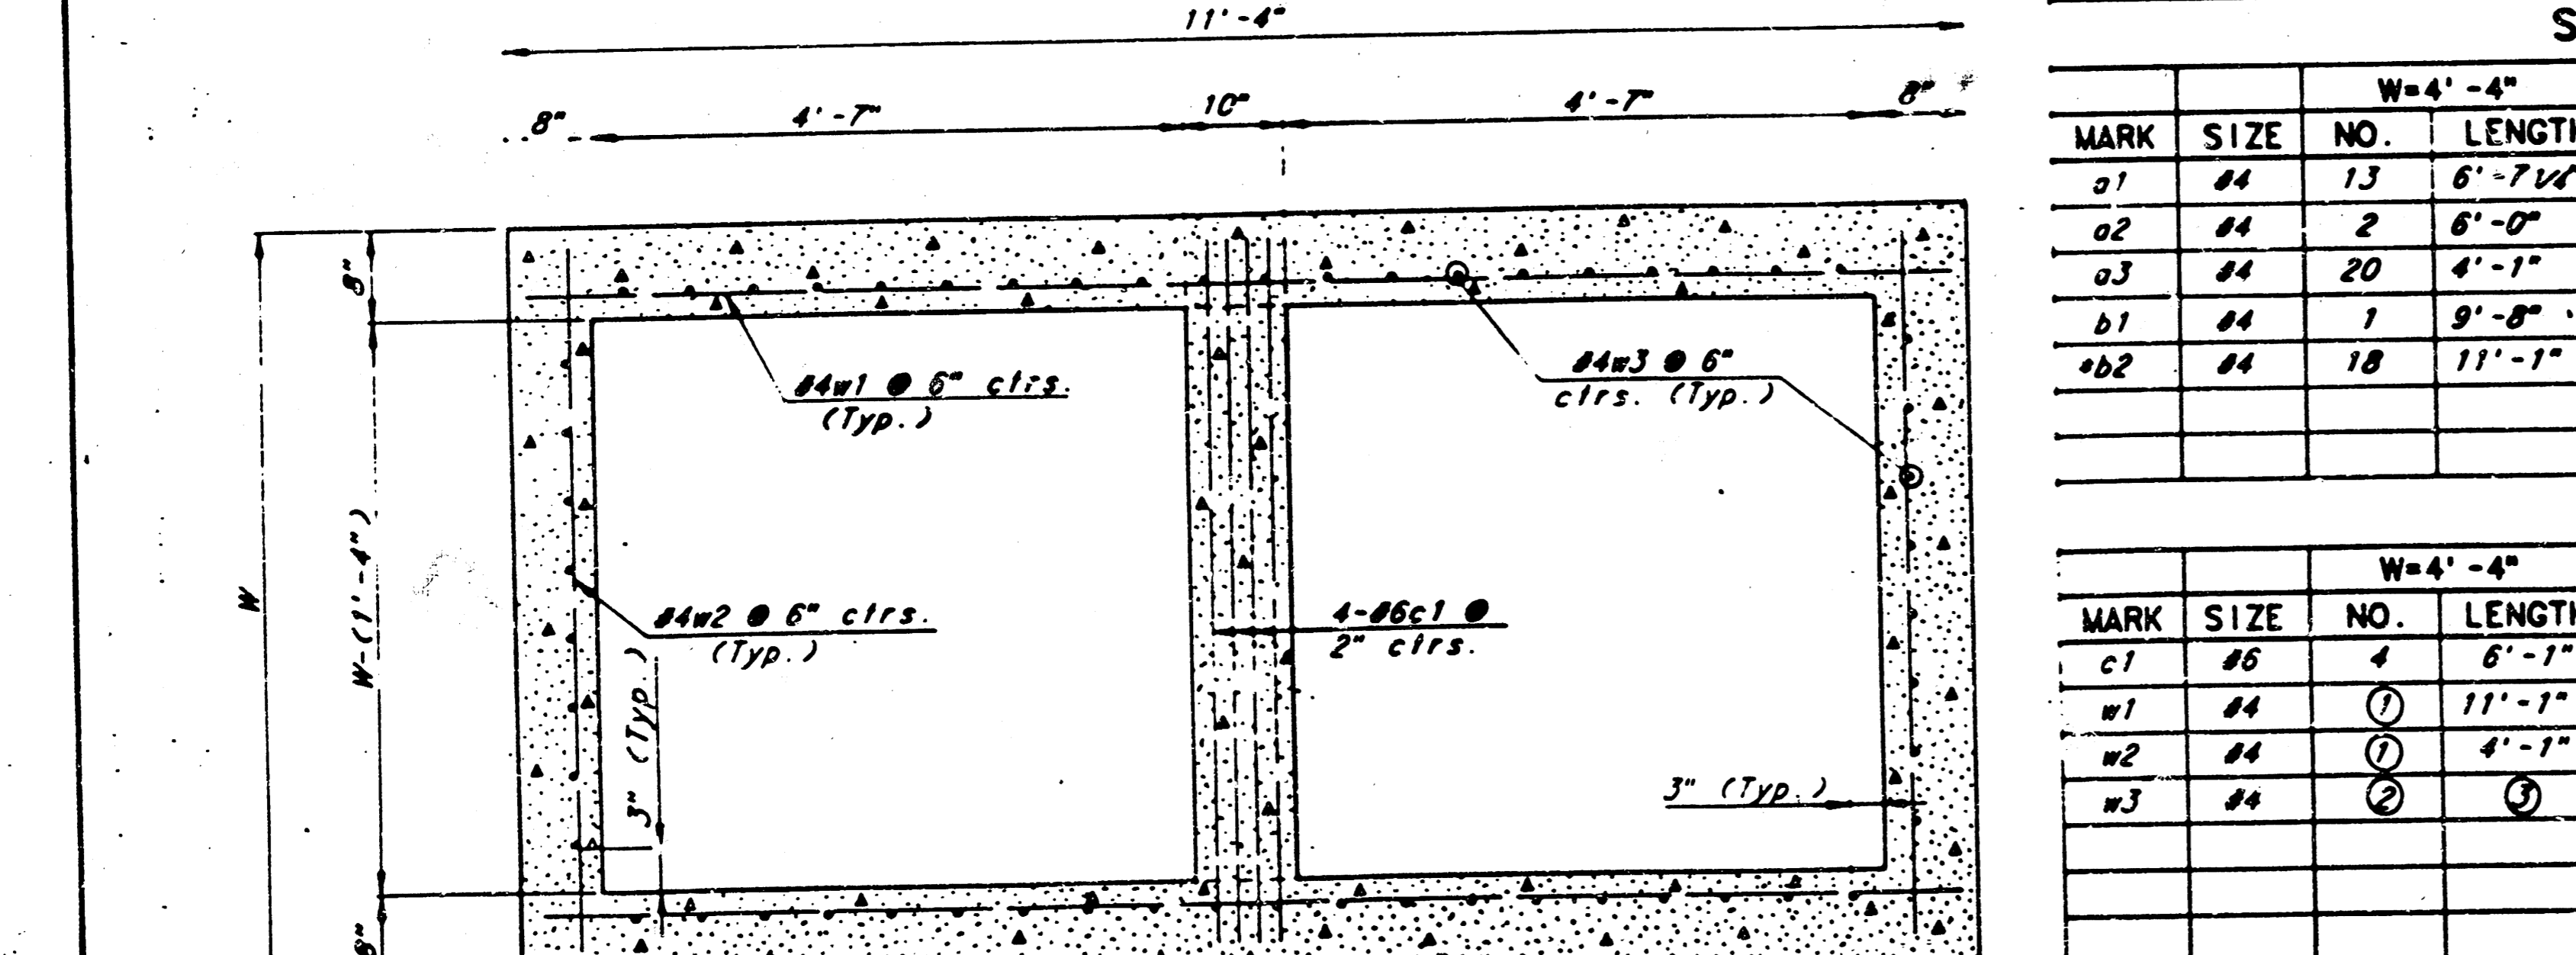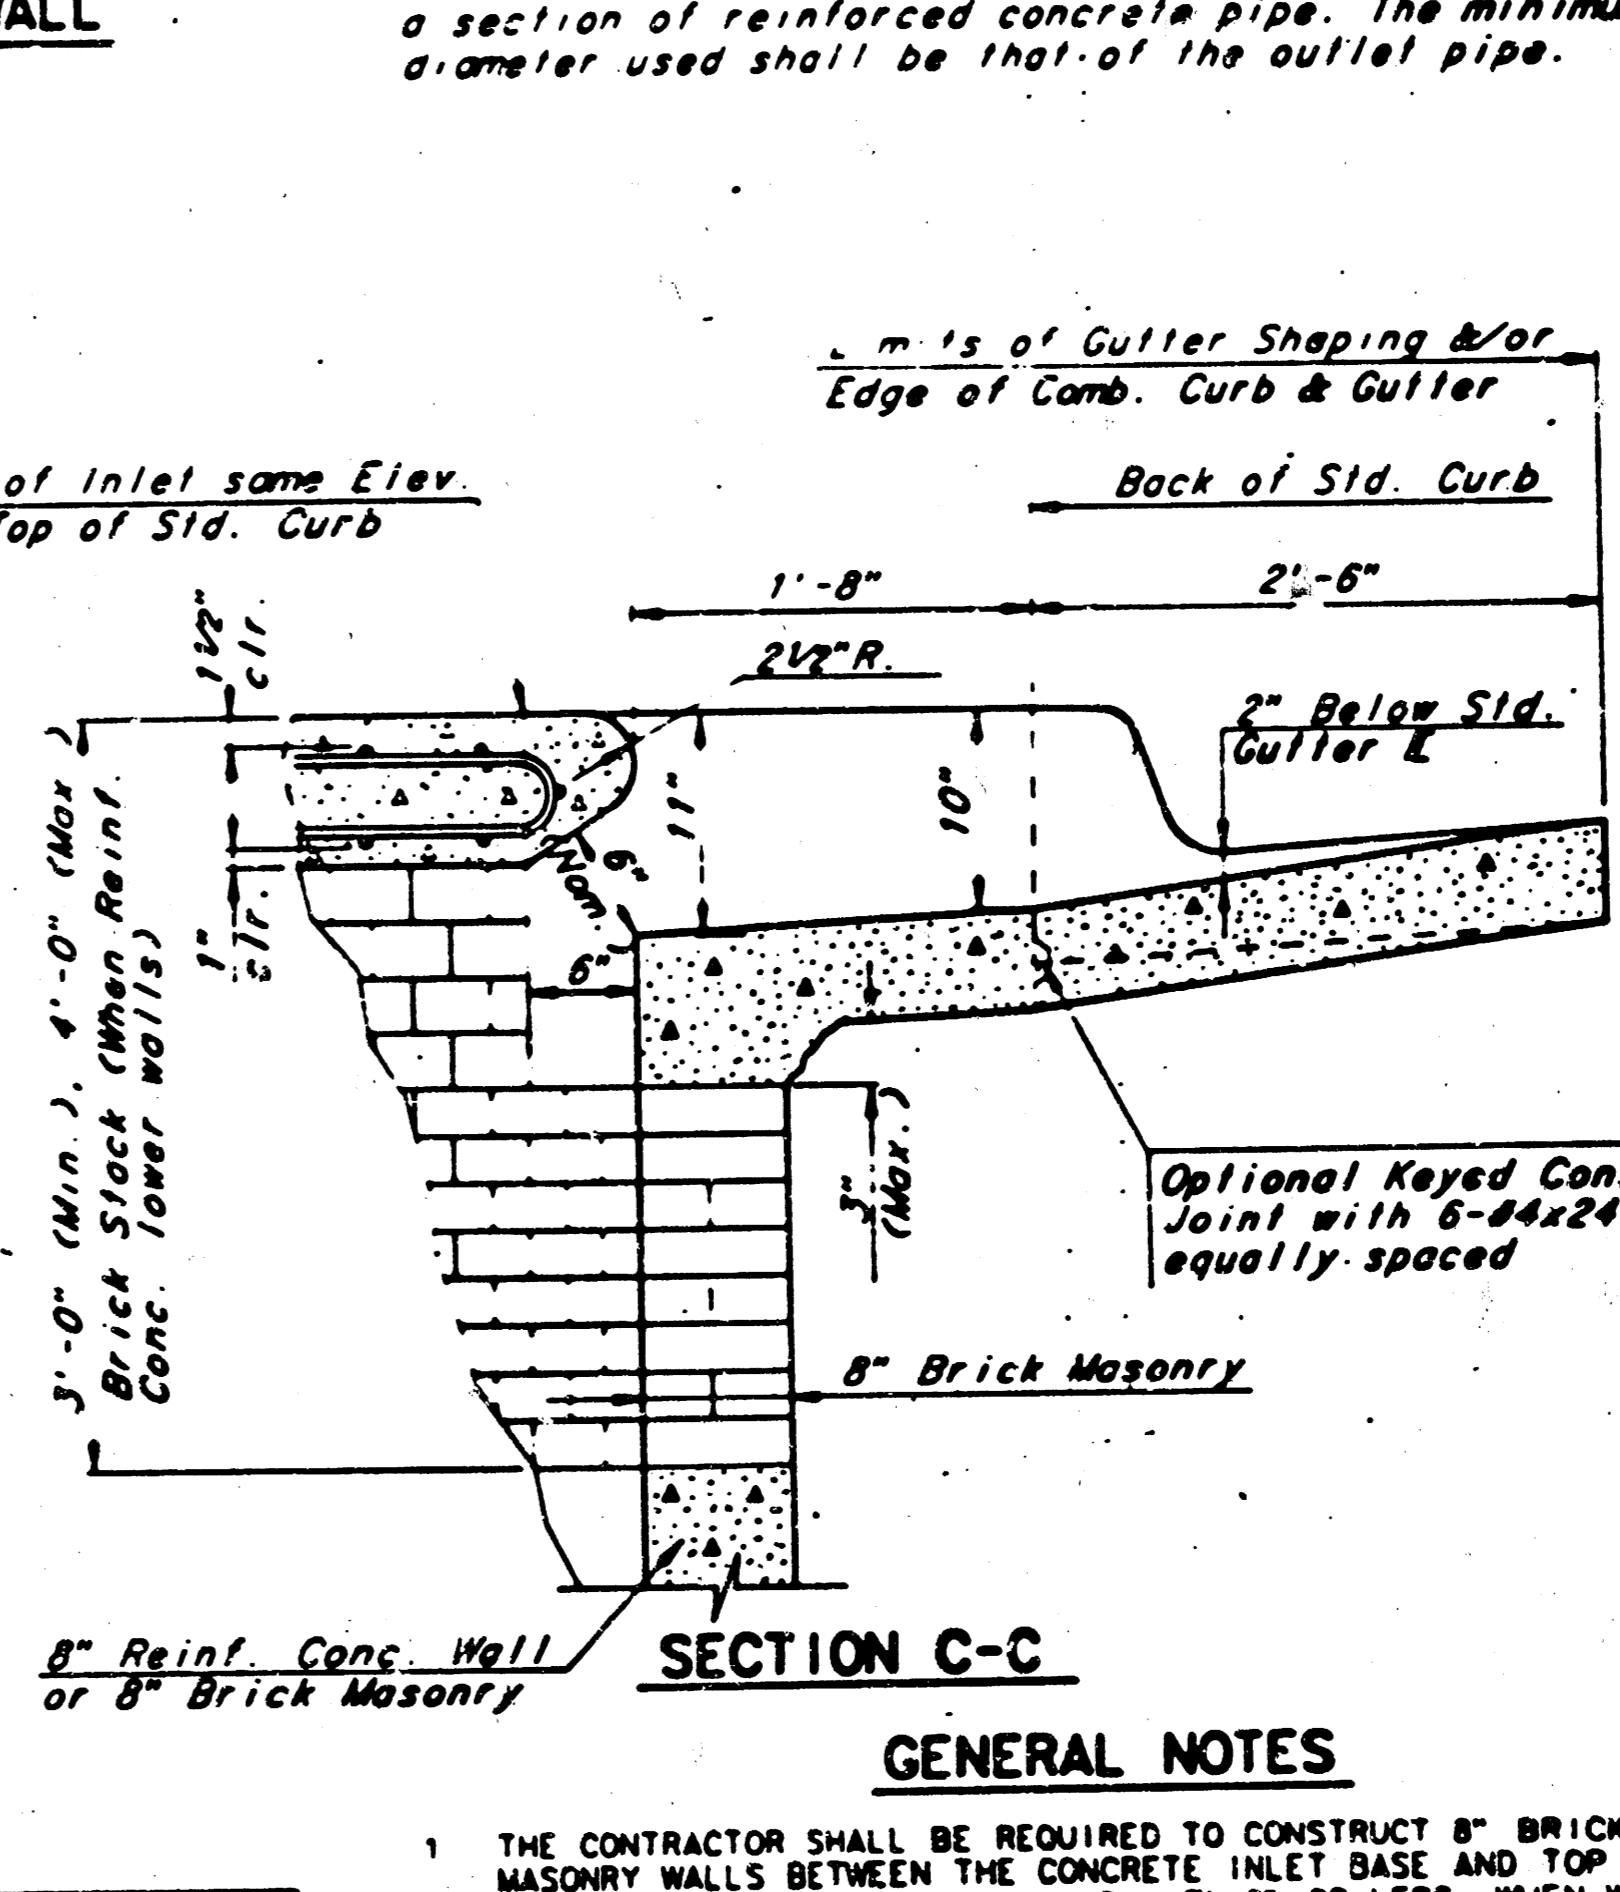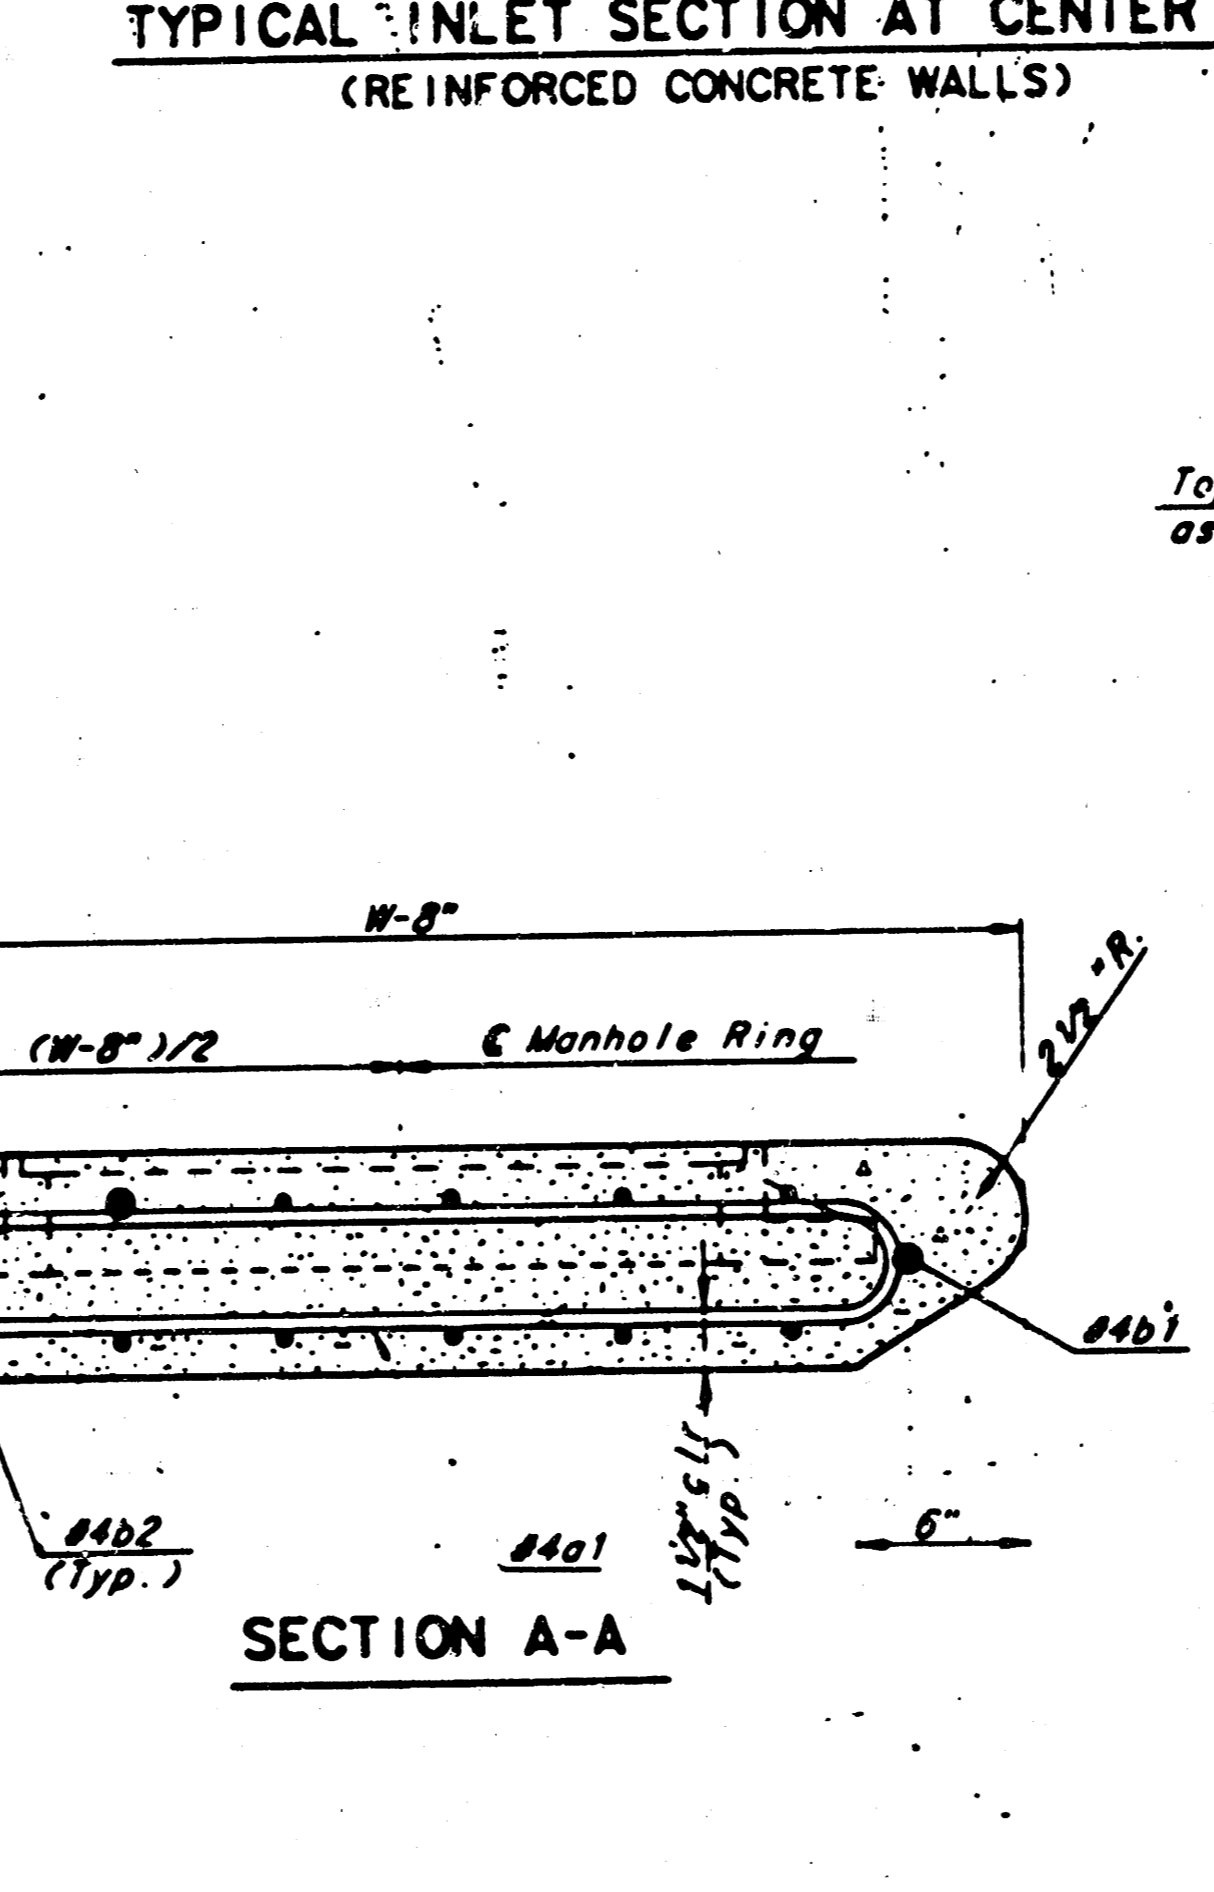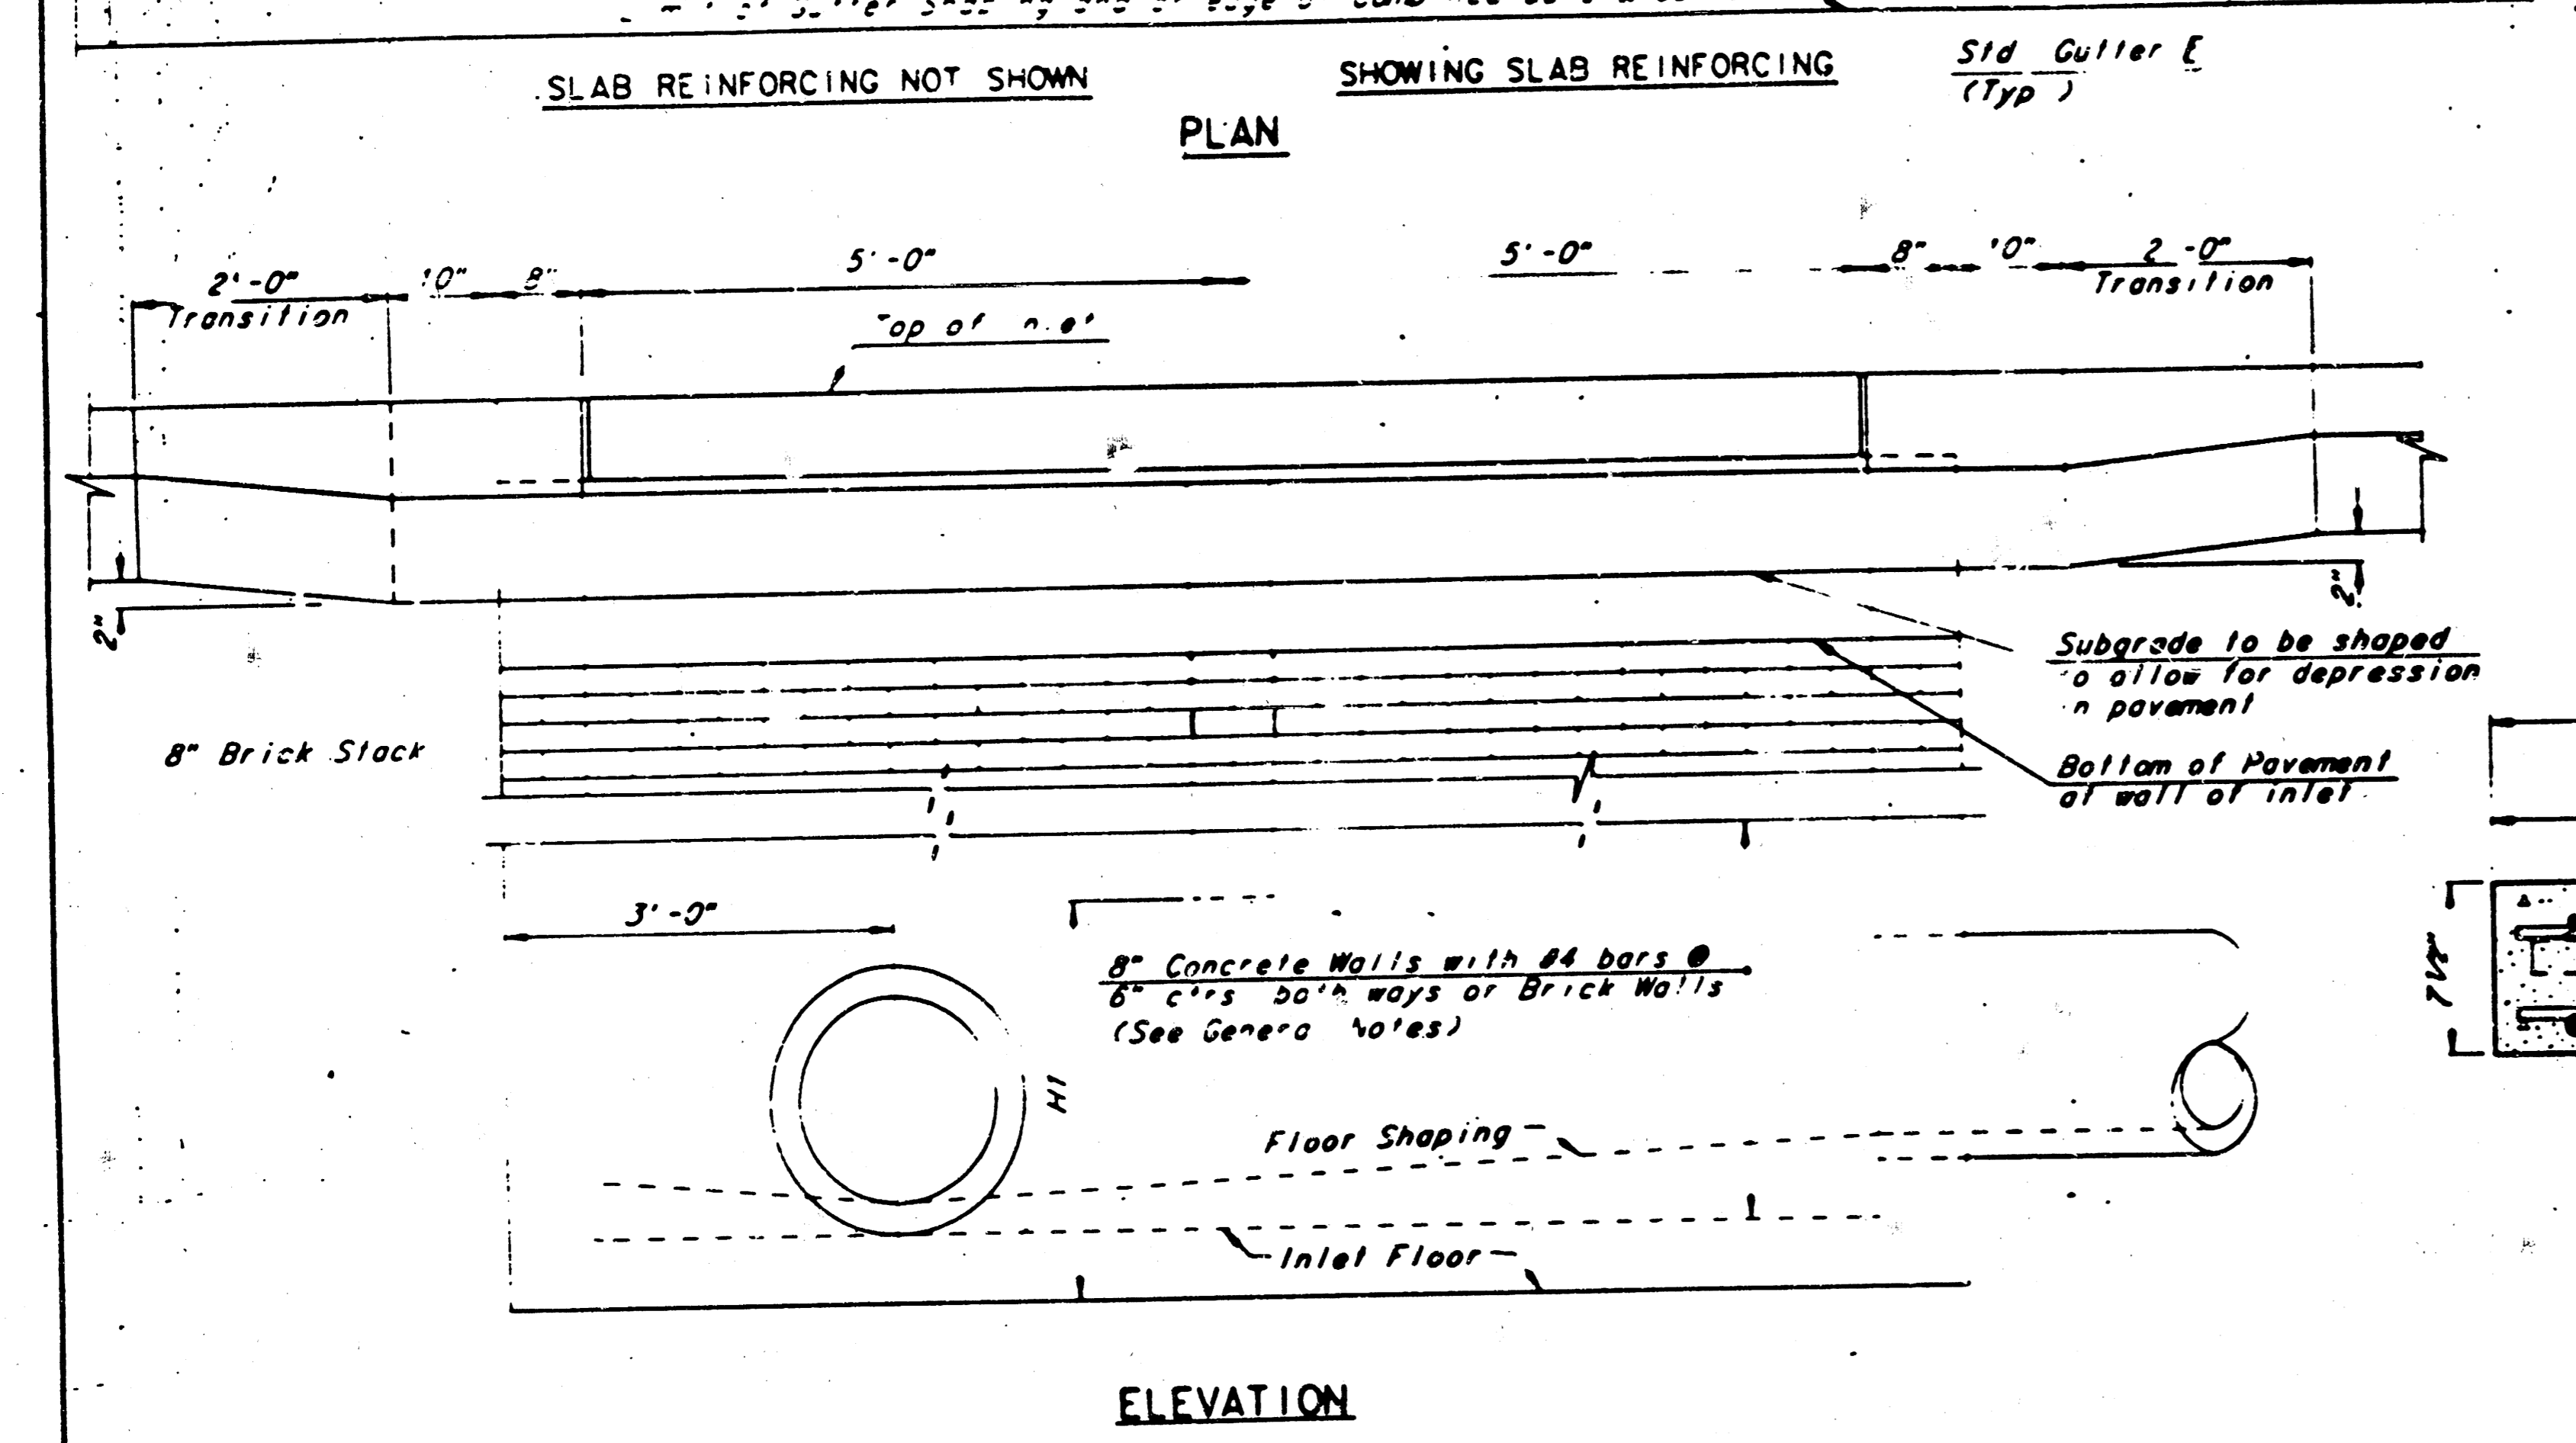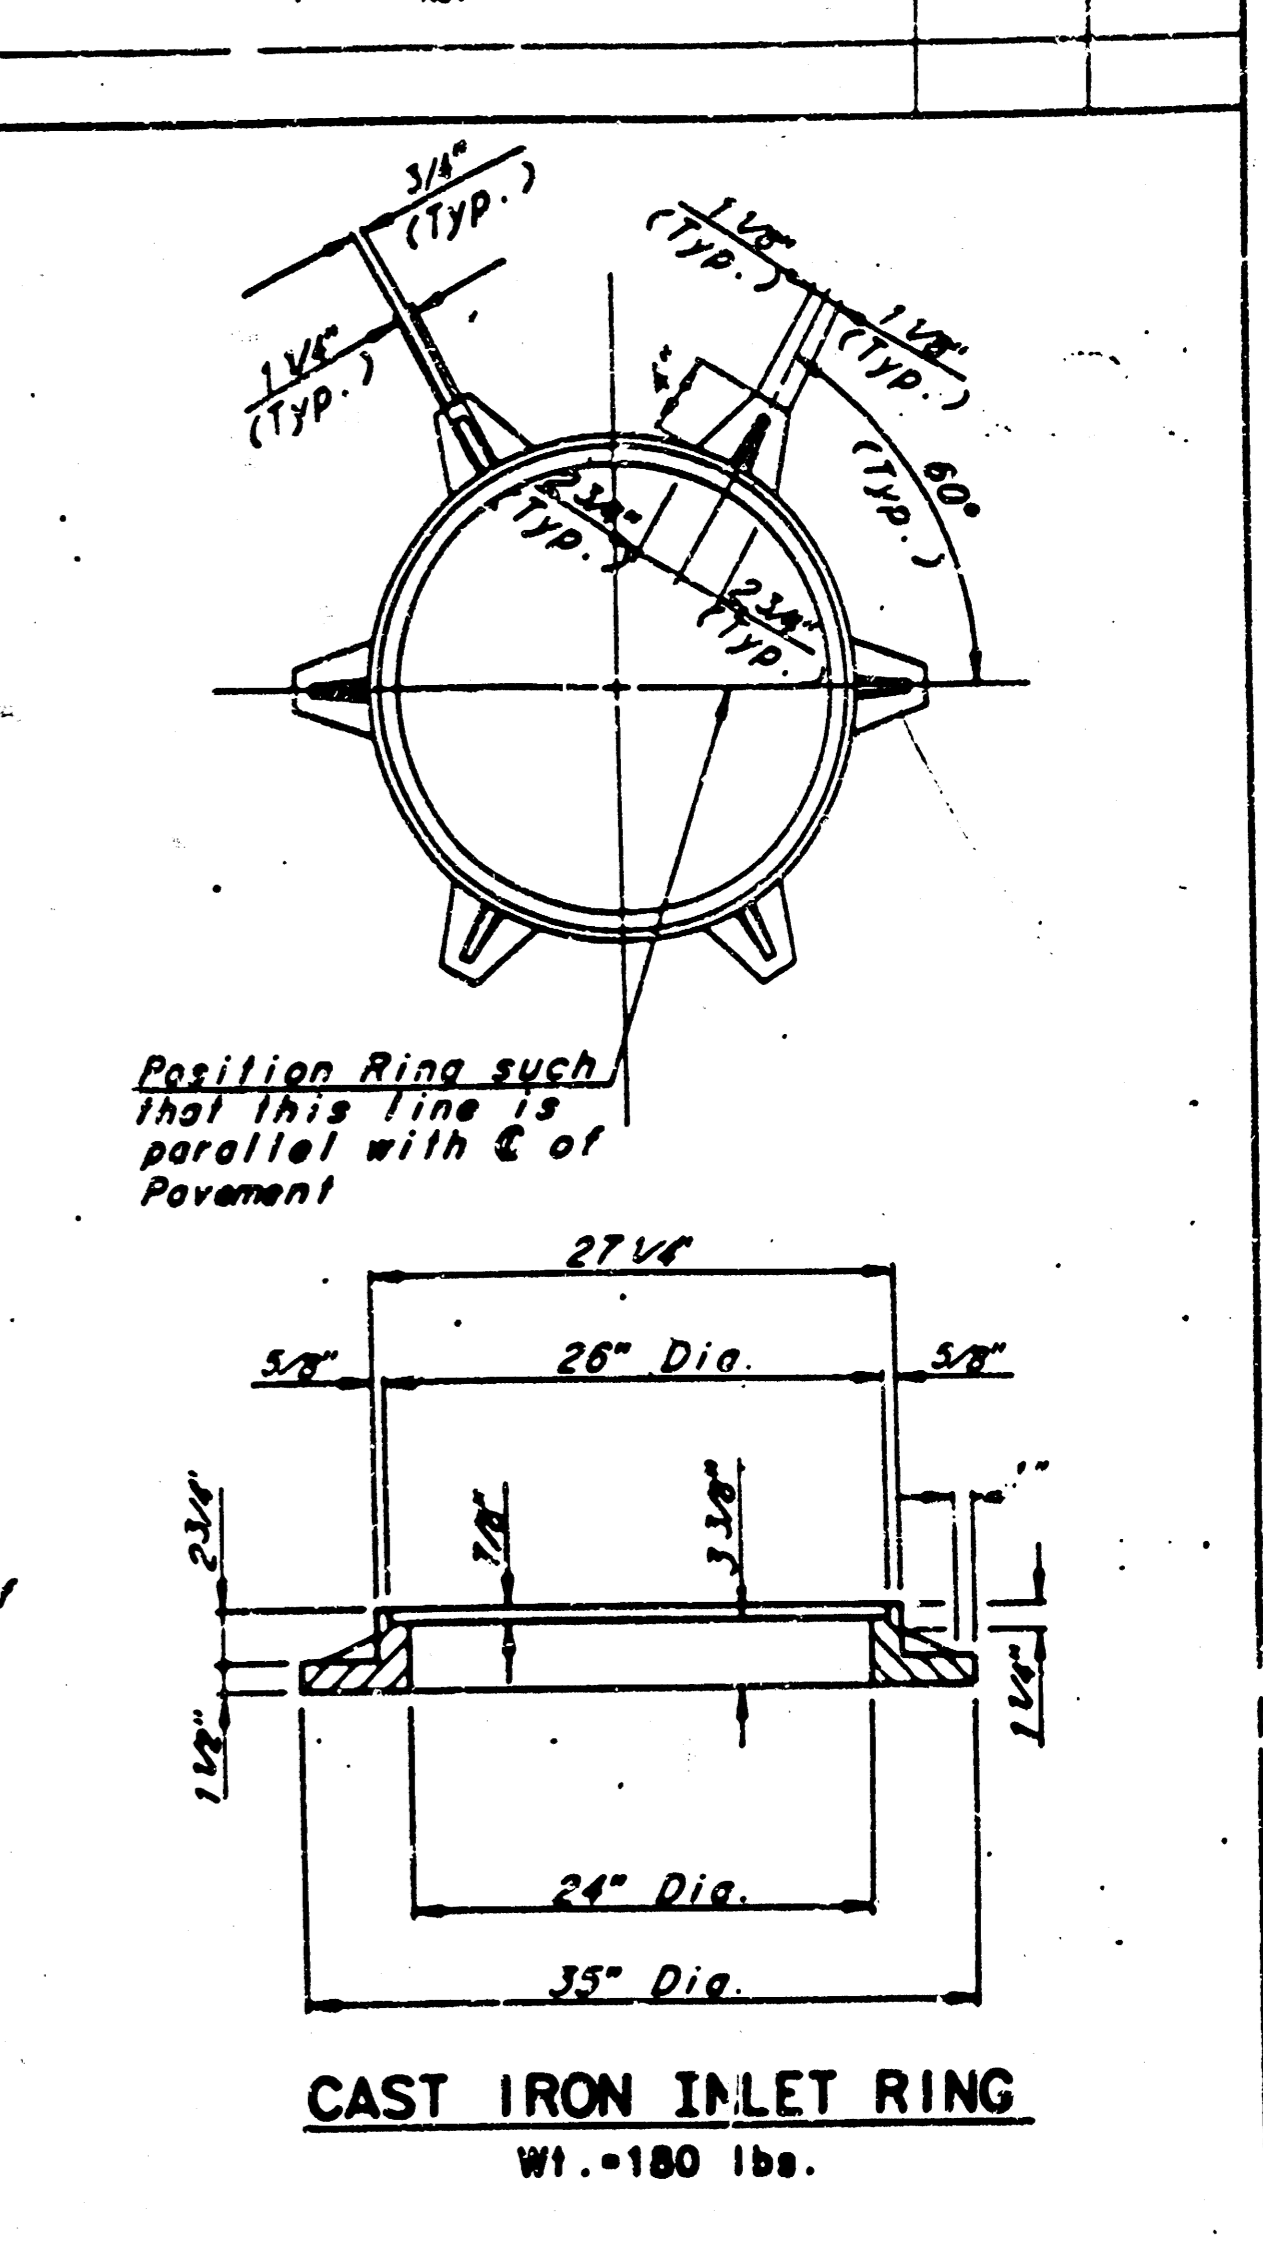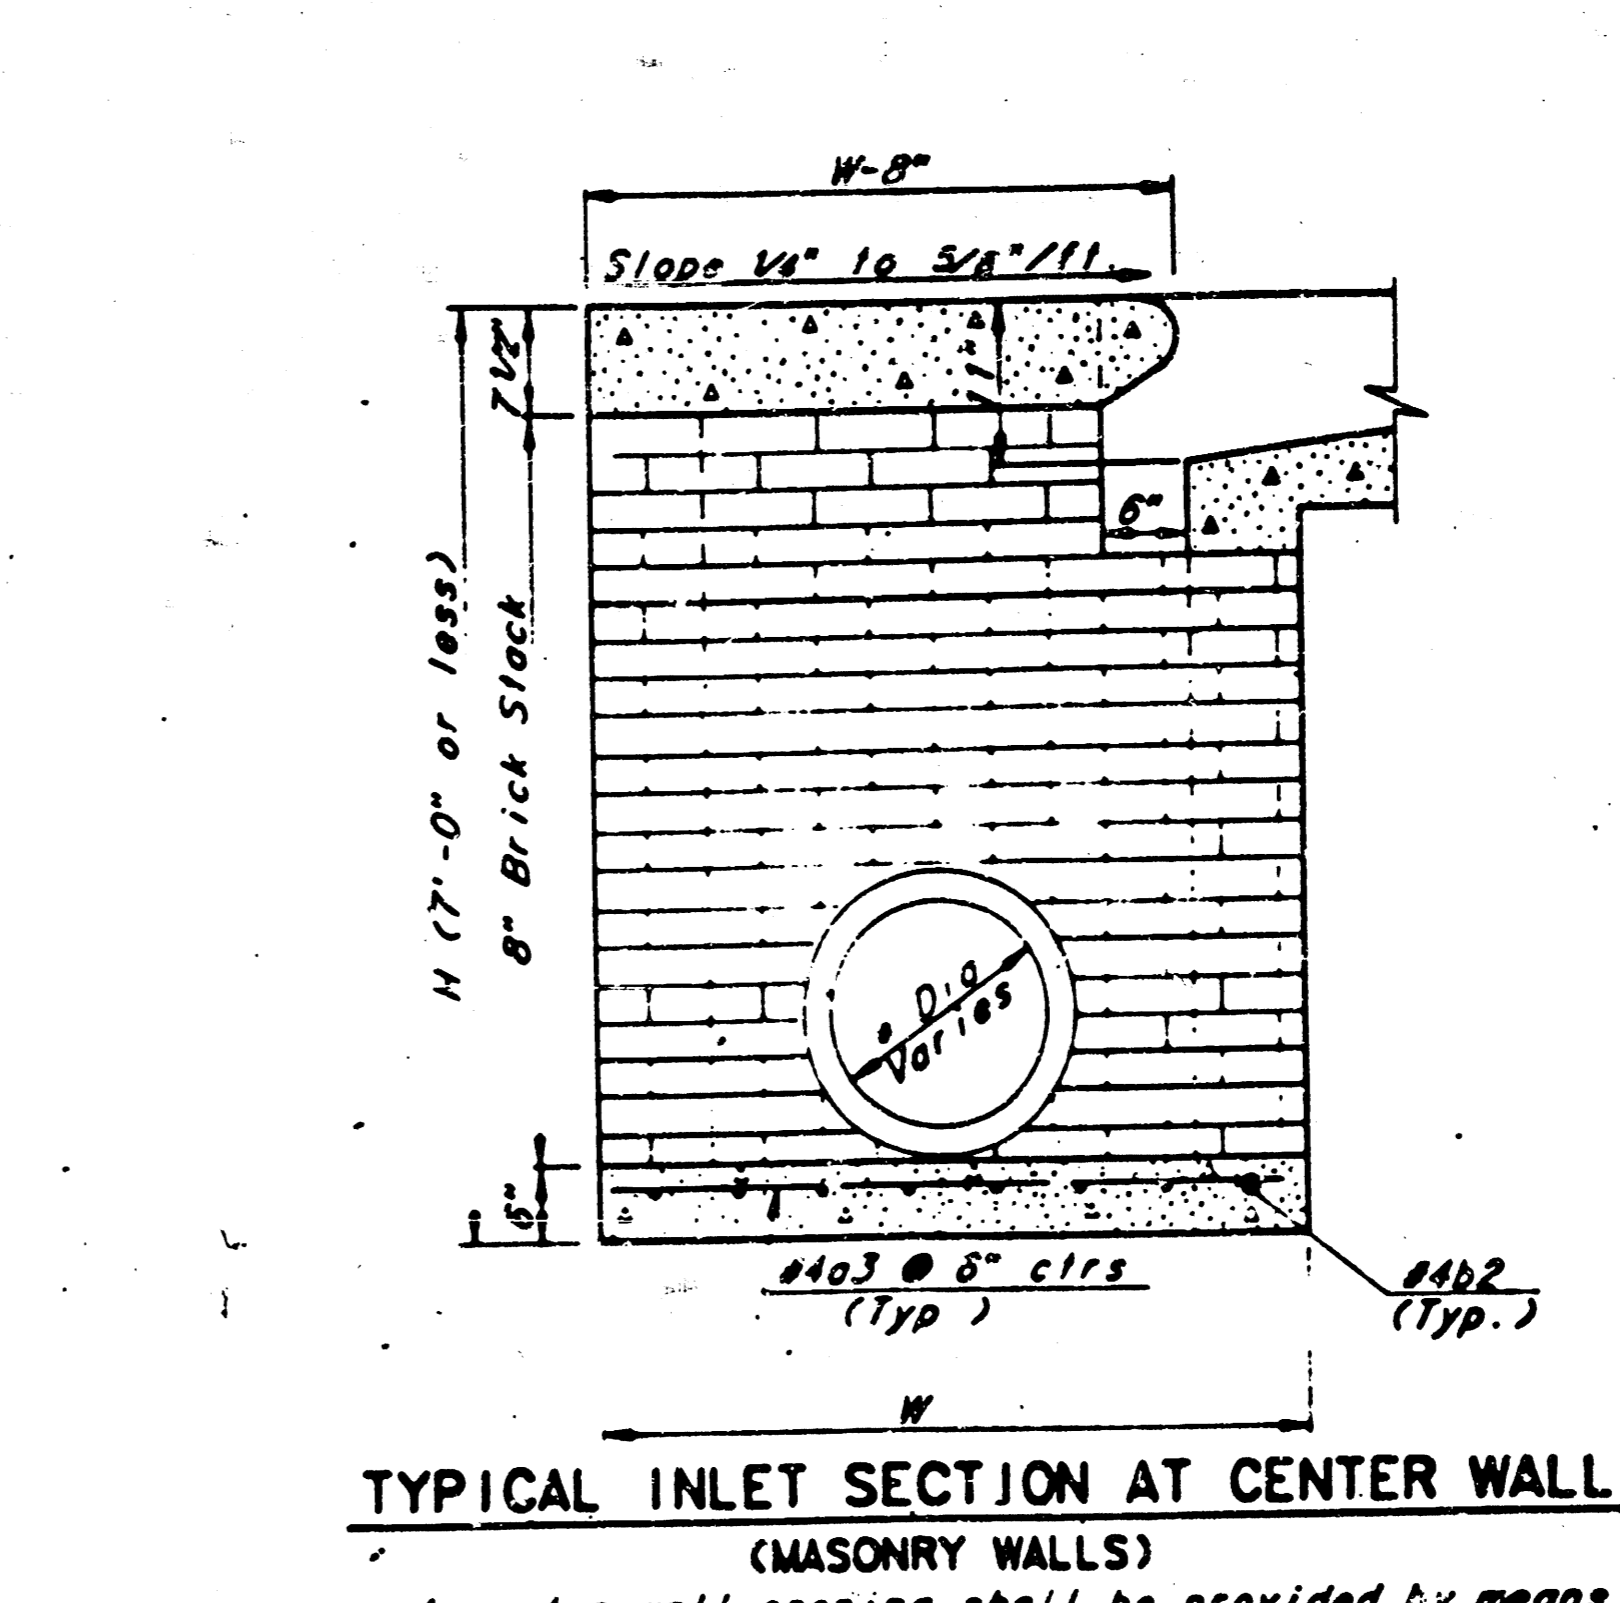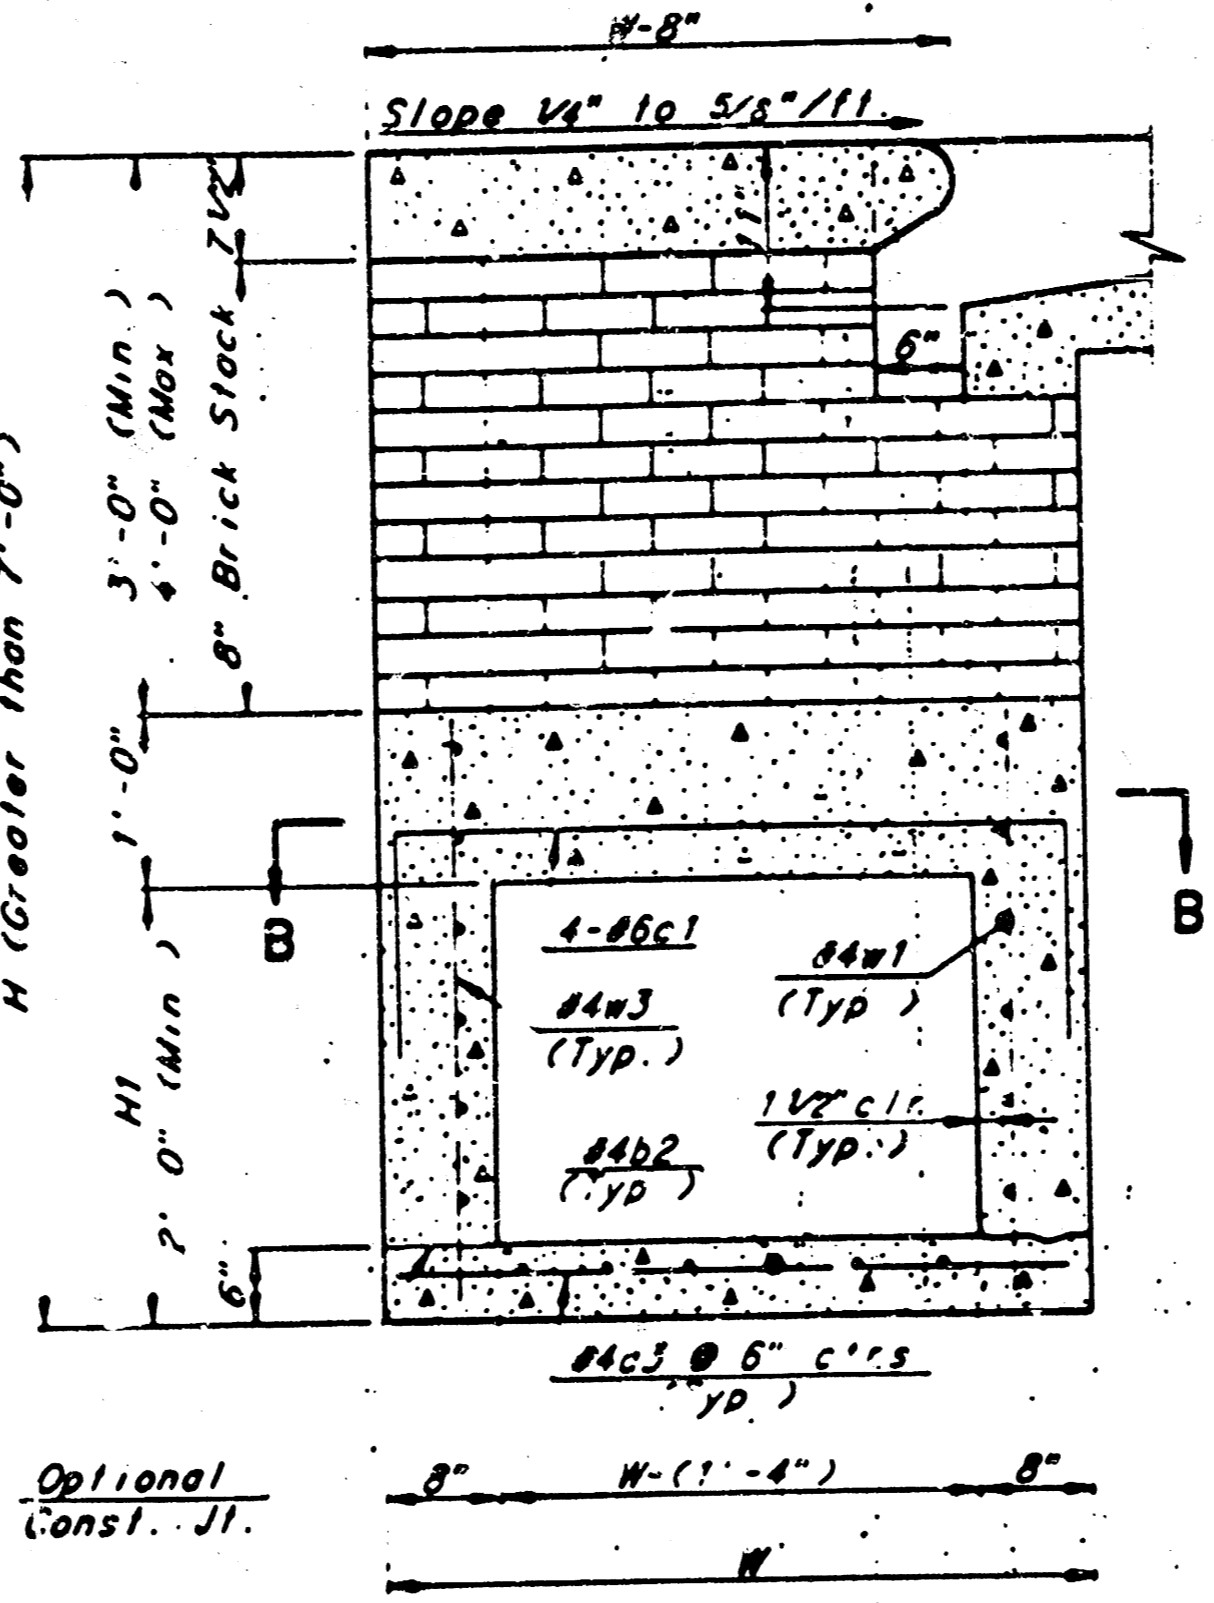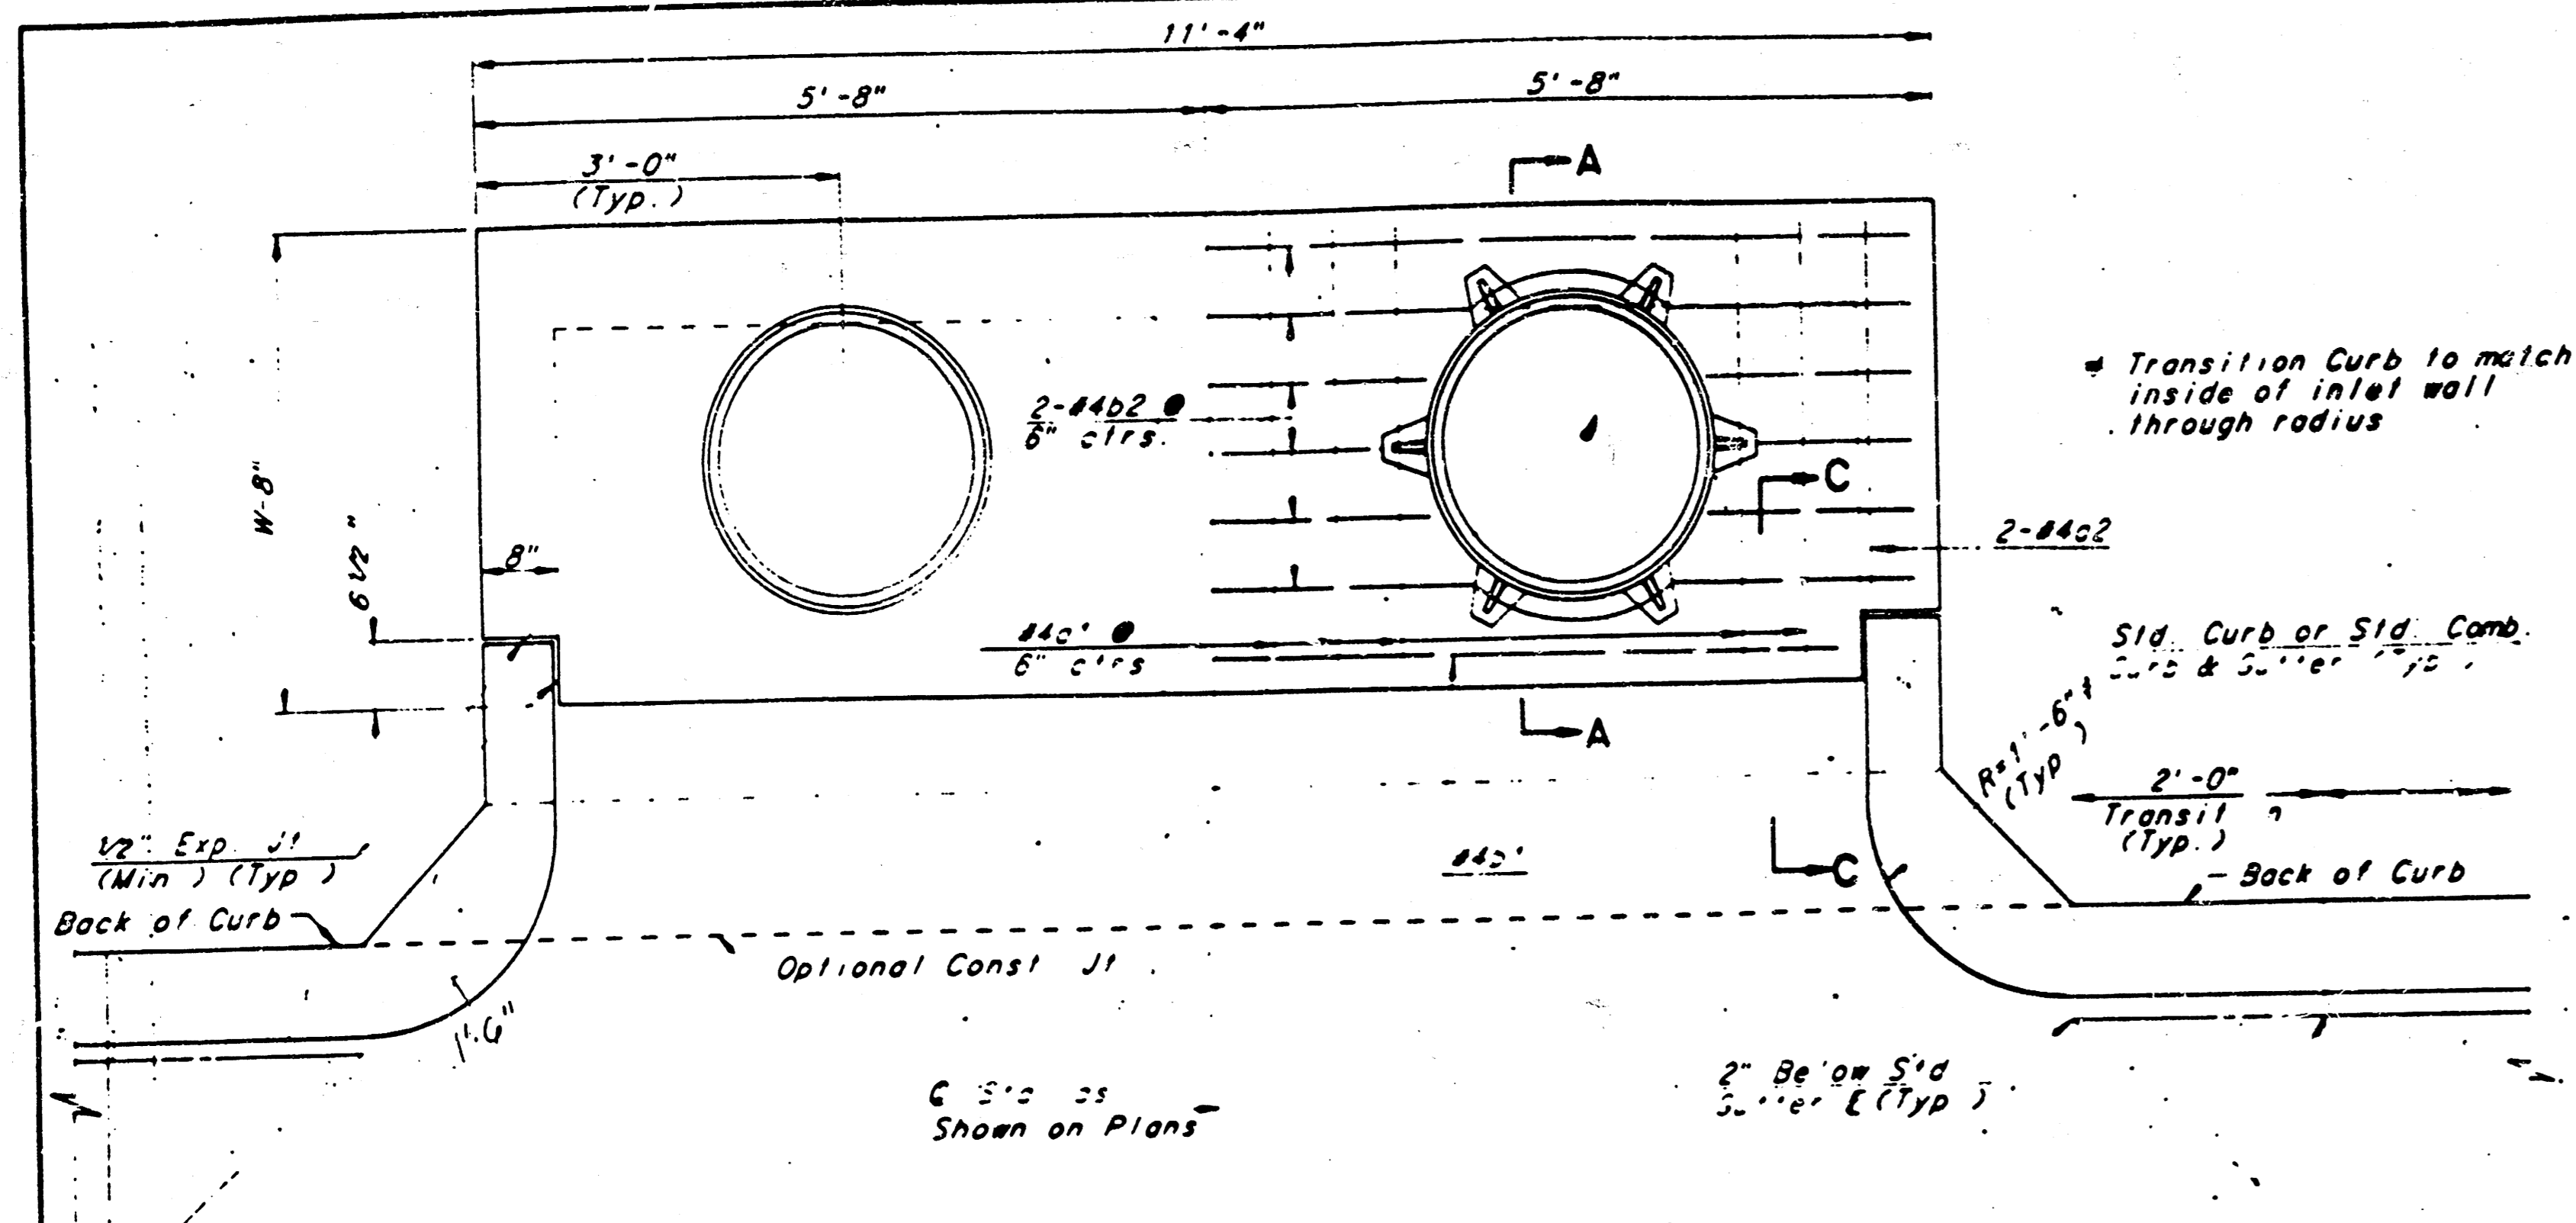

SLAB AND FLOOR REINFORCING											
MARK	SIZE	W=4'-4"		W=5'-4"		W=6'-4"		W=7'-4"		W=8'-4"	
		NO.	LENGTH	NO.	LENGTH	NO.	LENGTH	NO.	LENGTH	NO.	LENGTH
a1	#4	13	6'-7 1/4"	13	8'-7 1/4"	13	10'-7 1/4"	13	12'-7 1/4"	13	14'-7 1/4"
a2	#4	2	6'-0"	2	8'-0"	2	10'-0"	2	12'-0"	2	14'-0"
a3	#4	20	4'-1"	20	5'-1"	20	6'-1"	20	7'-1"	20	8'-1"
b1	#4	1	9'-8"	1	9'-8"	1	9'-8"	1	9'-8"	1	9'-8"
b2	#4	18	11'-1"	24	11'-1"	30	11'-1"	36	11'-1"	42	11'-1"

WALL REINFORCING											
MARK	SIZE	W=4'-4"		W=5'-4"		W=6'-4"		W=7'-4"		W=8'-4"	
		NO.	LENGTH	NO.	LENGTH	NO.	LENGTH	NO.	LENGTH	NO.	LENGTH
c1	#6	4	8'-1"	4	7'-1"	4	8'-1"	4	9'-1"	4	10'-1"
w1	#4	1	11'-1"	1	11'-1"	1	11'-1"	1	11'-1"	1	11'-1"
w2	#4	1	4'-1"	1	5'-1"	1	6'-1"	1	7'-1"	1	8'-1"
w3	#4	2	3	2	3	2	3	2	3	2	3

- GENERAL NOTES**
- THE CONTRACTOR SHALL BE REQUIRED TO CONSTRUCT 8" BRICK MASONRY WALLS BETWEEN THE CONCRETE INLET BASE AND TOP ON THIS INLET WHEN W=6'-4" OR LESS AND W=7'-0" OR LESS WHEN W IS GREATER THAN 6'-4" AND W IS LESS THAN 7'-0". THE OUTSIDE INLET WALLS BELOW THE BRICK STACK SHALL BE REINFORCED CONCRETE CONSTRUCTION AND THE CENTER WALL SHALL BE OF MASONRY CONSTRUCTION AS SHOWN FOR THE MASONRY WALL OPTION.
 - INLET INVERT SHALL BE SHAPED WITH 8 SACK SAND MIX CONCRETE TO CREATE FLOW CHANNELS AND TO INCREASE HYDRAULIC EFFICIENCY SUCH THAT THE INLET WILL BE SELF CLEANING BETWEEN ALL INLET AND/OR OUTLET PIPES.
 - CONCRETE TOPS TO BE INSTALLED ON THIN MORTAR CUSHION TO INSURE FULL SUPPORT ALONG BRICK WALLS. CONCRETE TOPS MAY BE CAST IN PLACE OR PRECAST. CONCRETE USED FOR INLET CONSTRUCTION SHALL BE CONCRETE PAVEMENT MIX.
 - INLET TOP REINFORCING SHALL BE SPACED ON 8" MAX. CENTERS. INLET LIDS SHALL BE NOTCHED OUT AS INDICATED TO FACILITATE CONSTRUCTION OF CURB. BARS IN INLET TOP TO BE FIELD BENT OR CUT TO CLEAR MANHOLE RING.
 - THE ENDS OF ALL PIPES INSTALLED IN INLETS SHALL BE CUT OFF FLUSH WITH THE INSIDE FACE OF THE INLET WALL.

STANDARD TYPE 1A CURB INLET
 INLET OPENING = 6" x 10'-0"

472-76-245-80001-000-000-12

WICHITA, KANSAS

Designed by BER, KLS, AMB Checked by AMB
 Drawn by JGP Date Nov. 1984 12/2

* Field bend or cut Reinforcing as required for clearance
 ① 4(HI-6") x 4 (HI-6") Rounded down to nearest 0.5'
 ② 40 x (W - 16") ③ HI-6"