
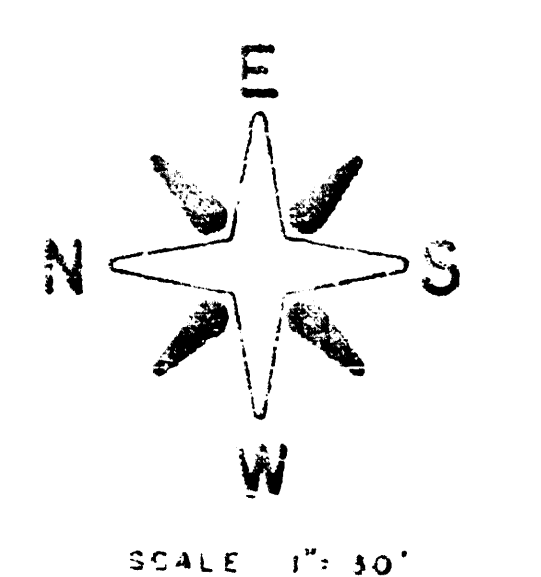


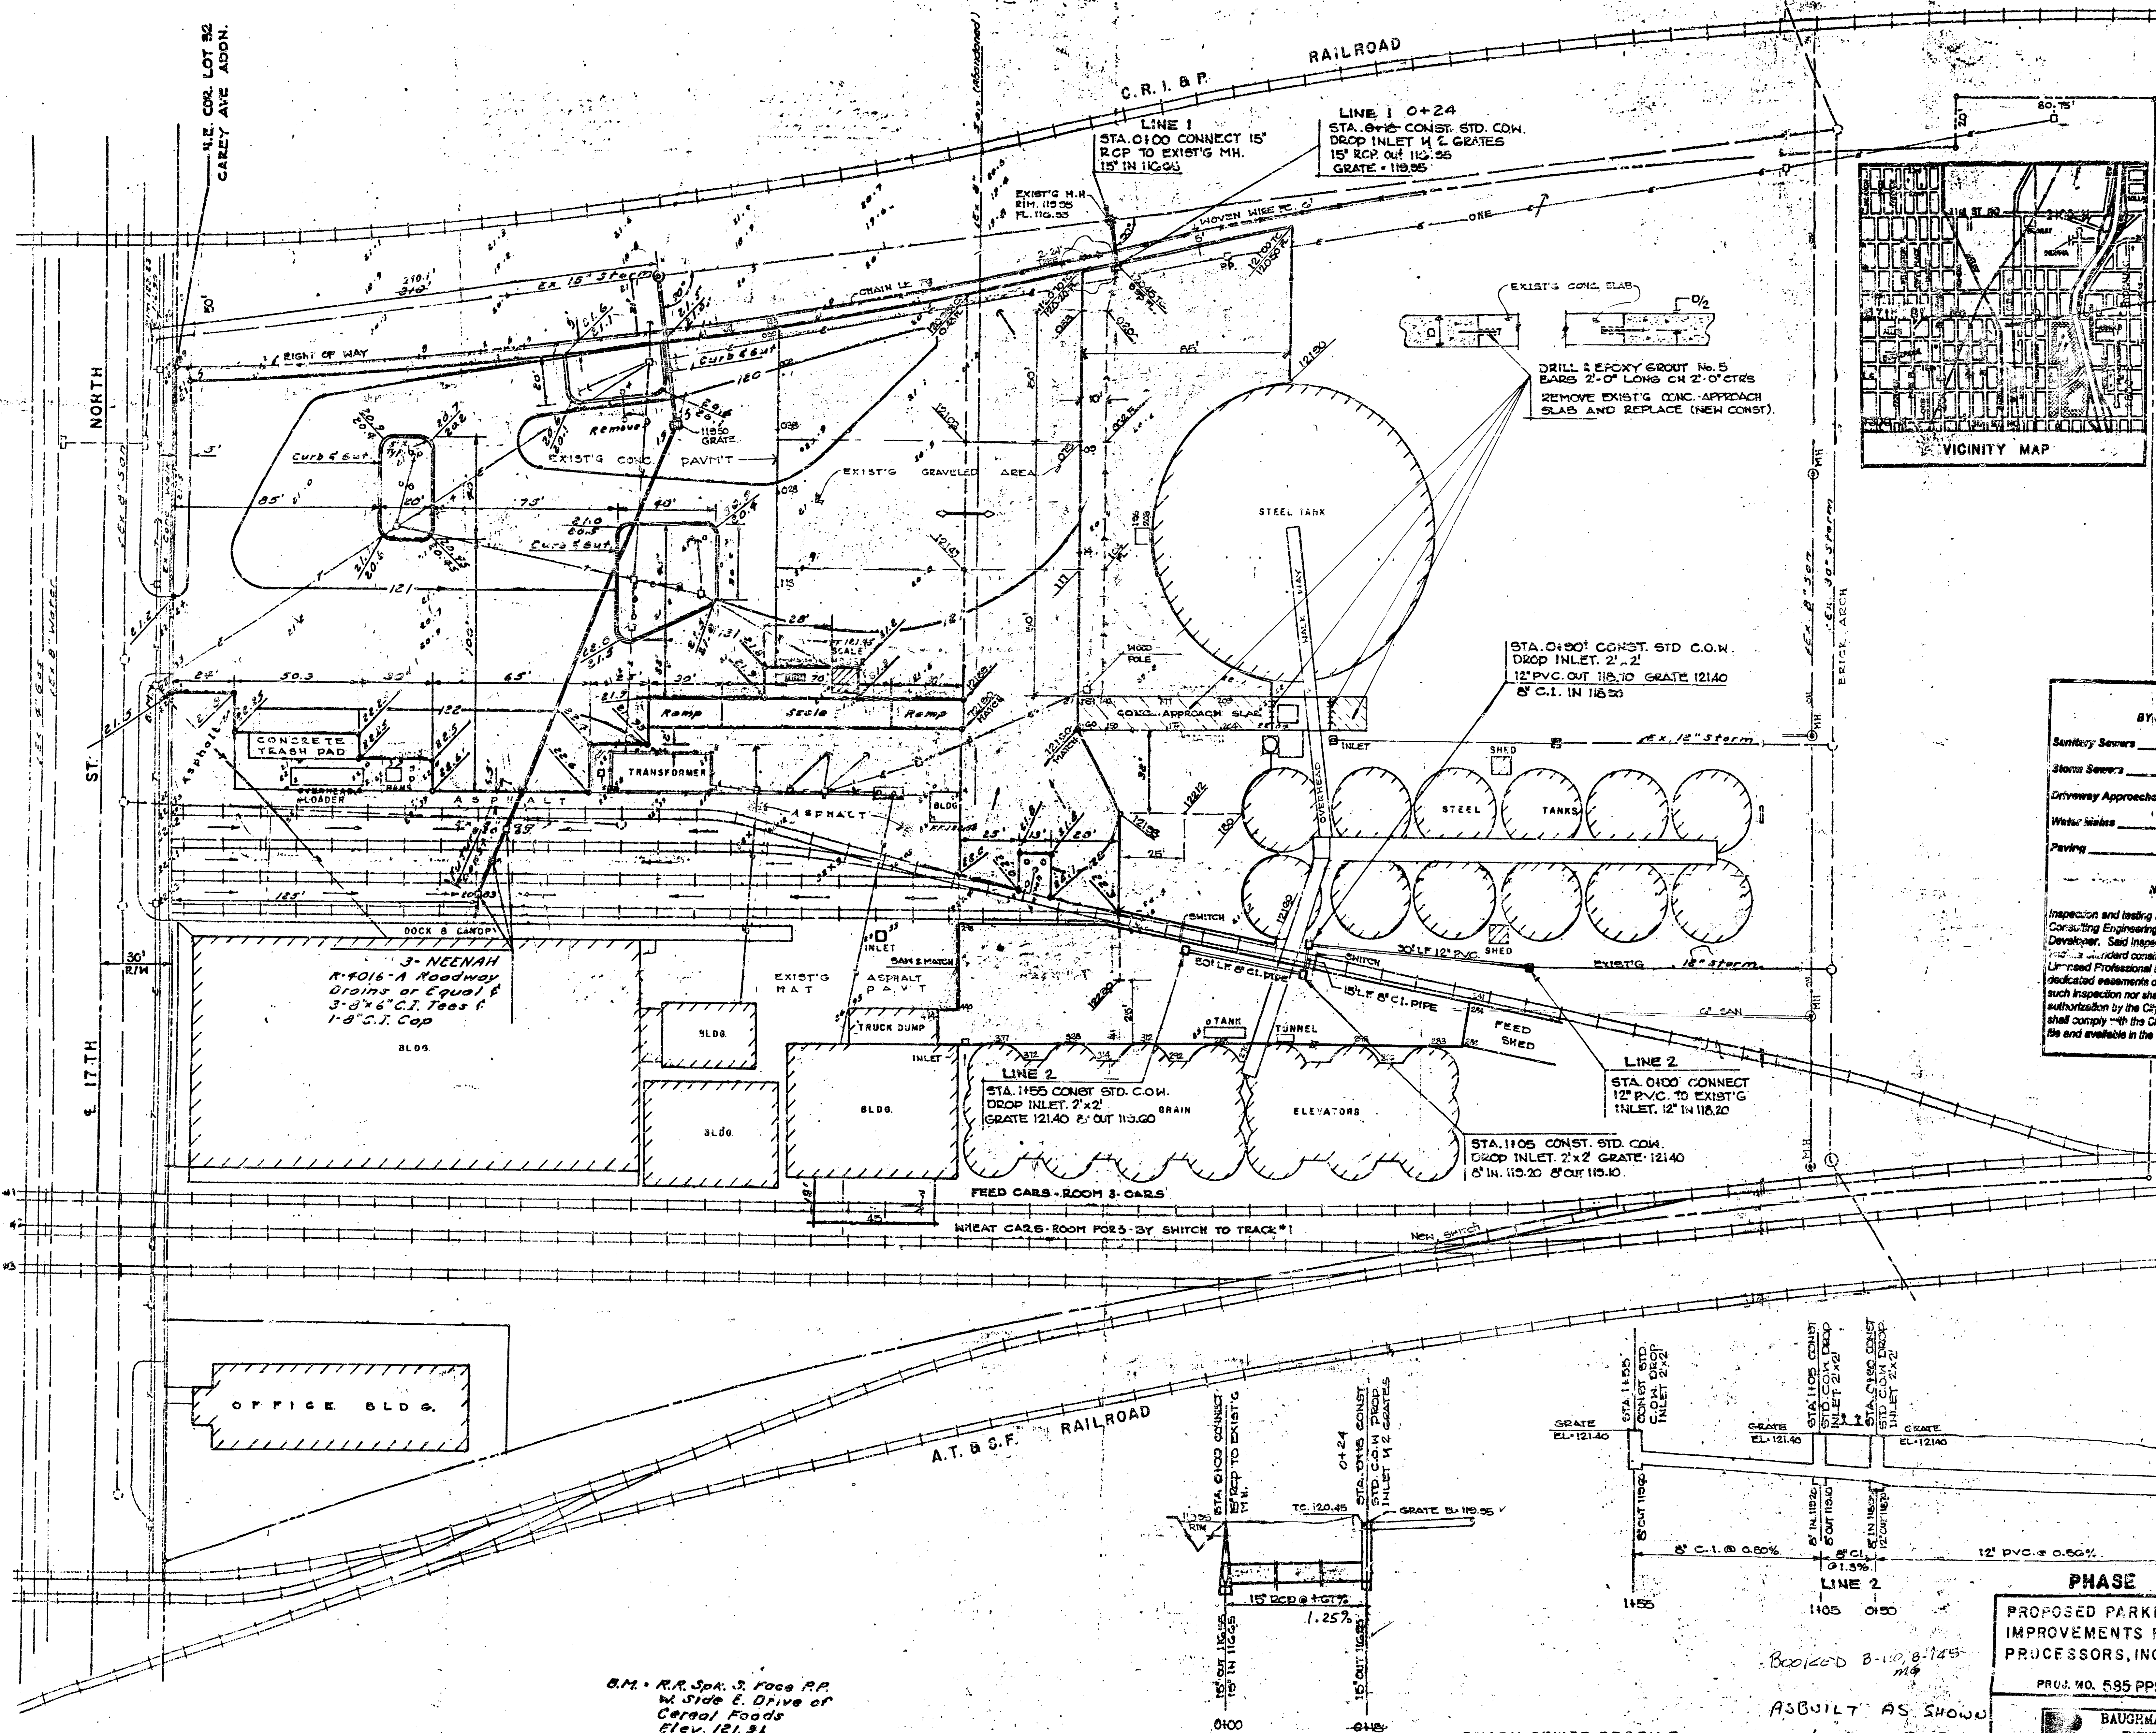


APPROVED AS NOTED
BY CITY ENGINEER OF MOBILE

Sanitary Sewers _____
Storm Sewers VRH 9/15/95
Driveway Approaches _____
Water Mains _____
Paving _____

NOTE TO CONTRACTORS

Inspection and testing for this project are to be provided by a Licensed Consulting Engineering Firm under contract with the Owner / Developer. Said inspection is to be in accordance with the City of Mobile's standard construction engineering practices and carried out by a Licensed Professional Engineer. No work shall be performed in dedicated easements or public right-of-way by the Contractor without such inspection by the City Engineer. All Construction and Materials shall comply with the City of Mobile's Specifications and Standards (on file and available in the City Engineer's Office).

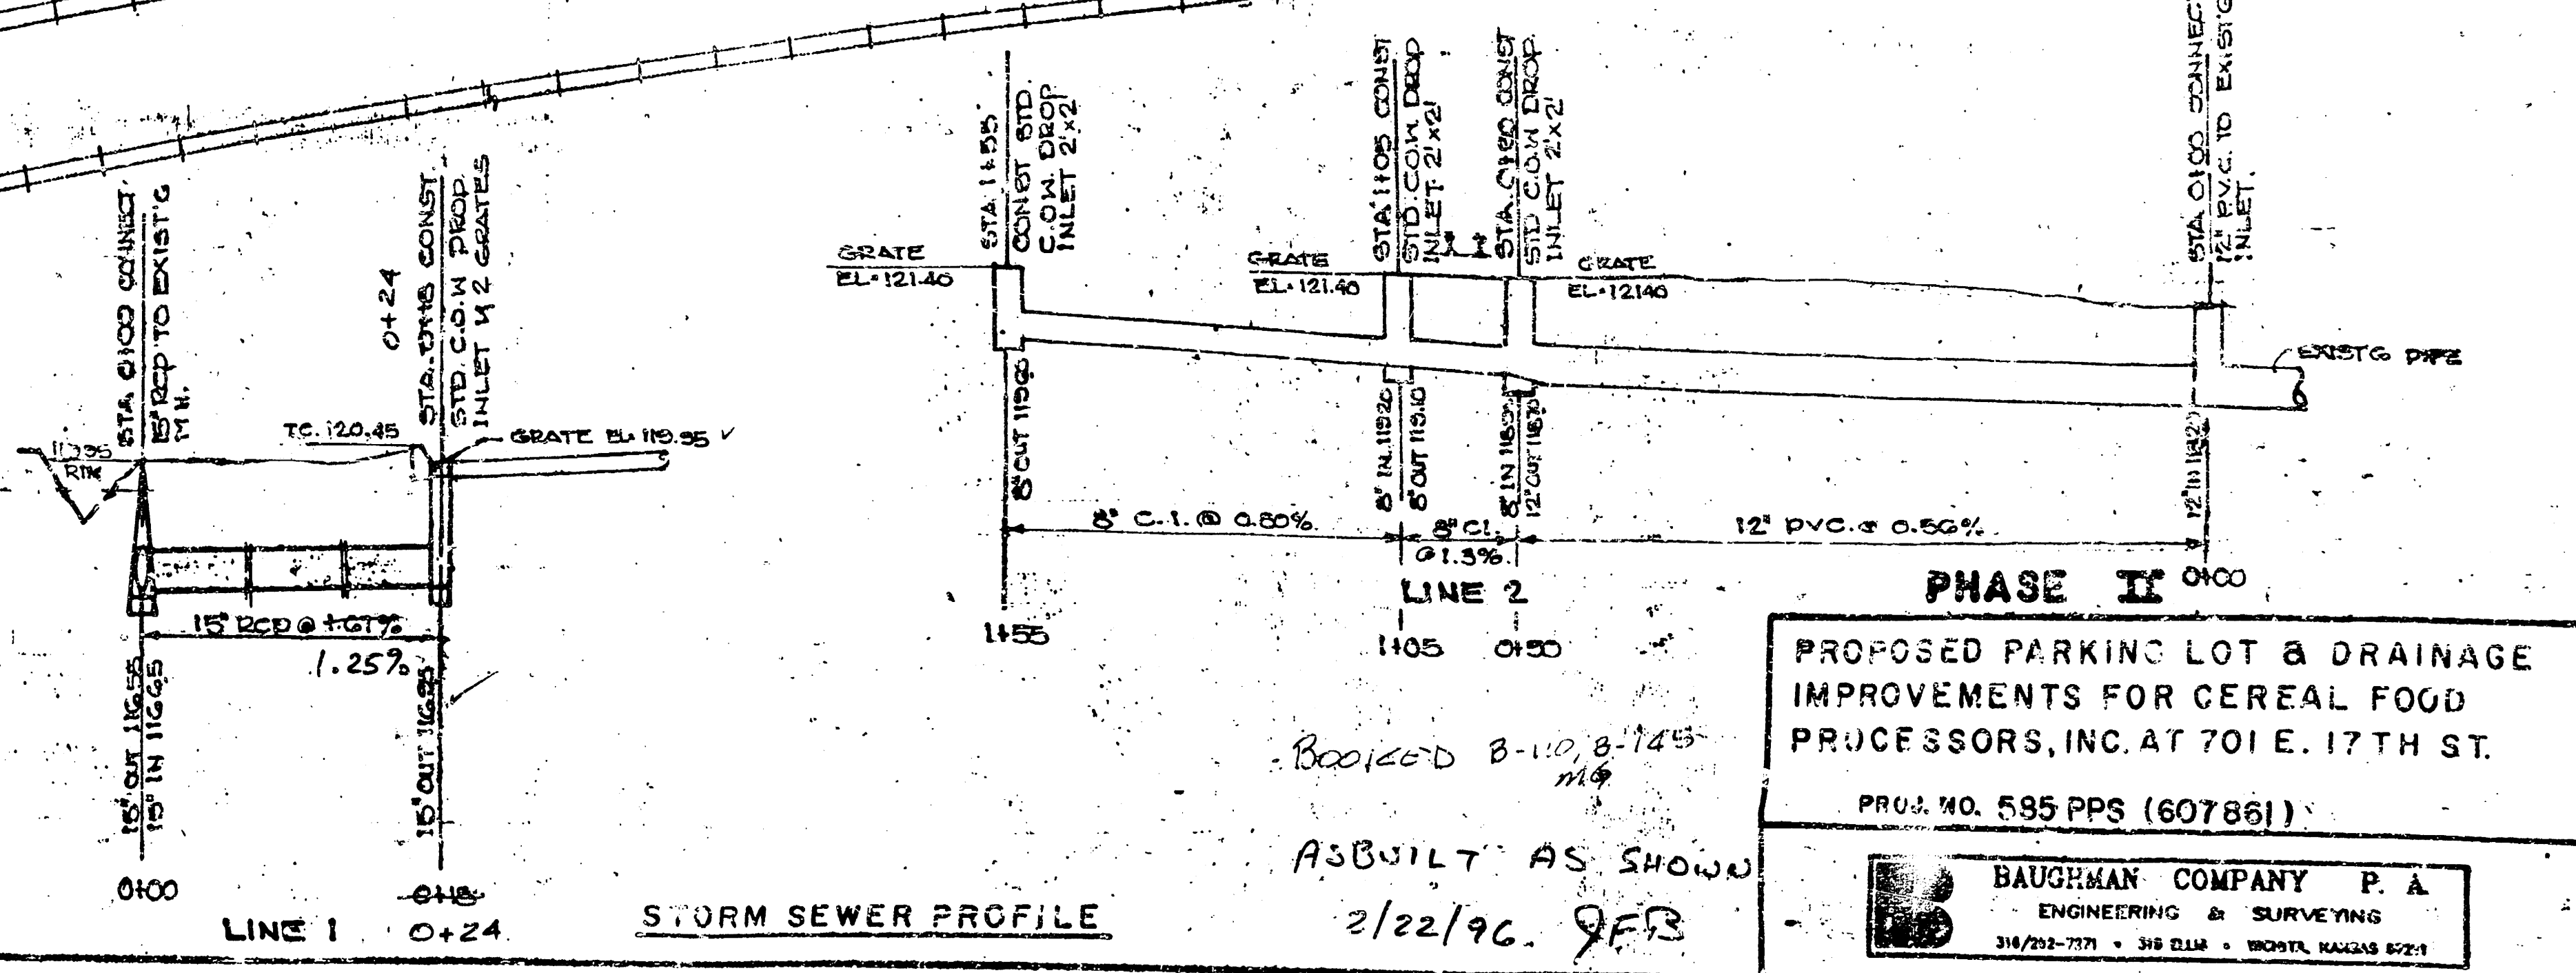

B.M. R.R. Sp. 3. Foss R.P.
W. Side E. Drive of
Cereal Foods
Elev. 121.51