



STORM SEWER IMPROVEMENTS
FOR
CASEY'S GENERAL STORE
IN
LOT 8, BLOCK 1,
SOUTH SENECA GARDENS FOURTH ADDITION
WICHITA, SEDGWICK COUNTY, KANSAS
 CITY OF WICHITA PRIVATE PROJECT NO. 609 PPS(607861)
 MIKE LINDEBAK, P.E., CITY ENGINEER
 JANUARY, 1996

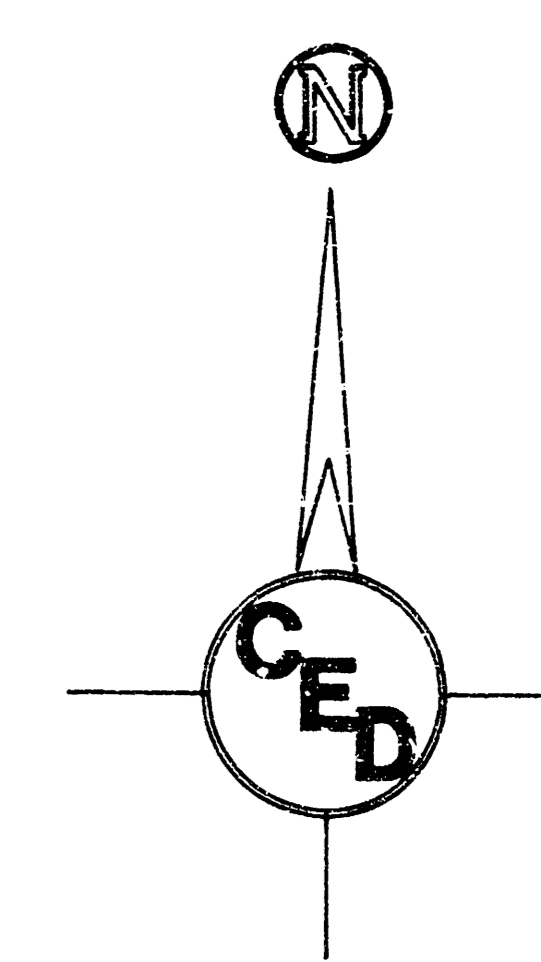

1" = 100'

*BOOKED
 12-14-00
 MCG
 D-491*

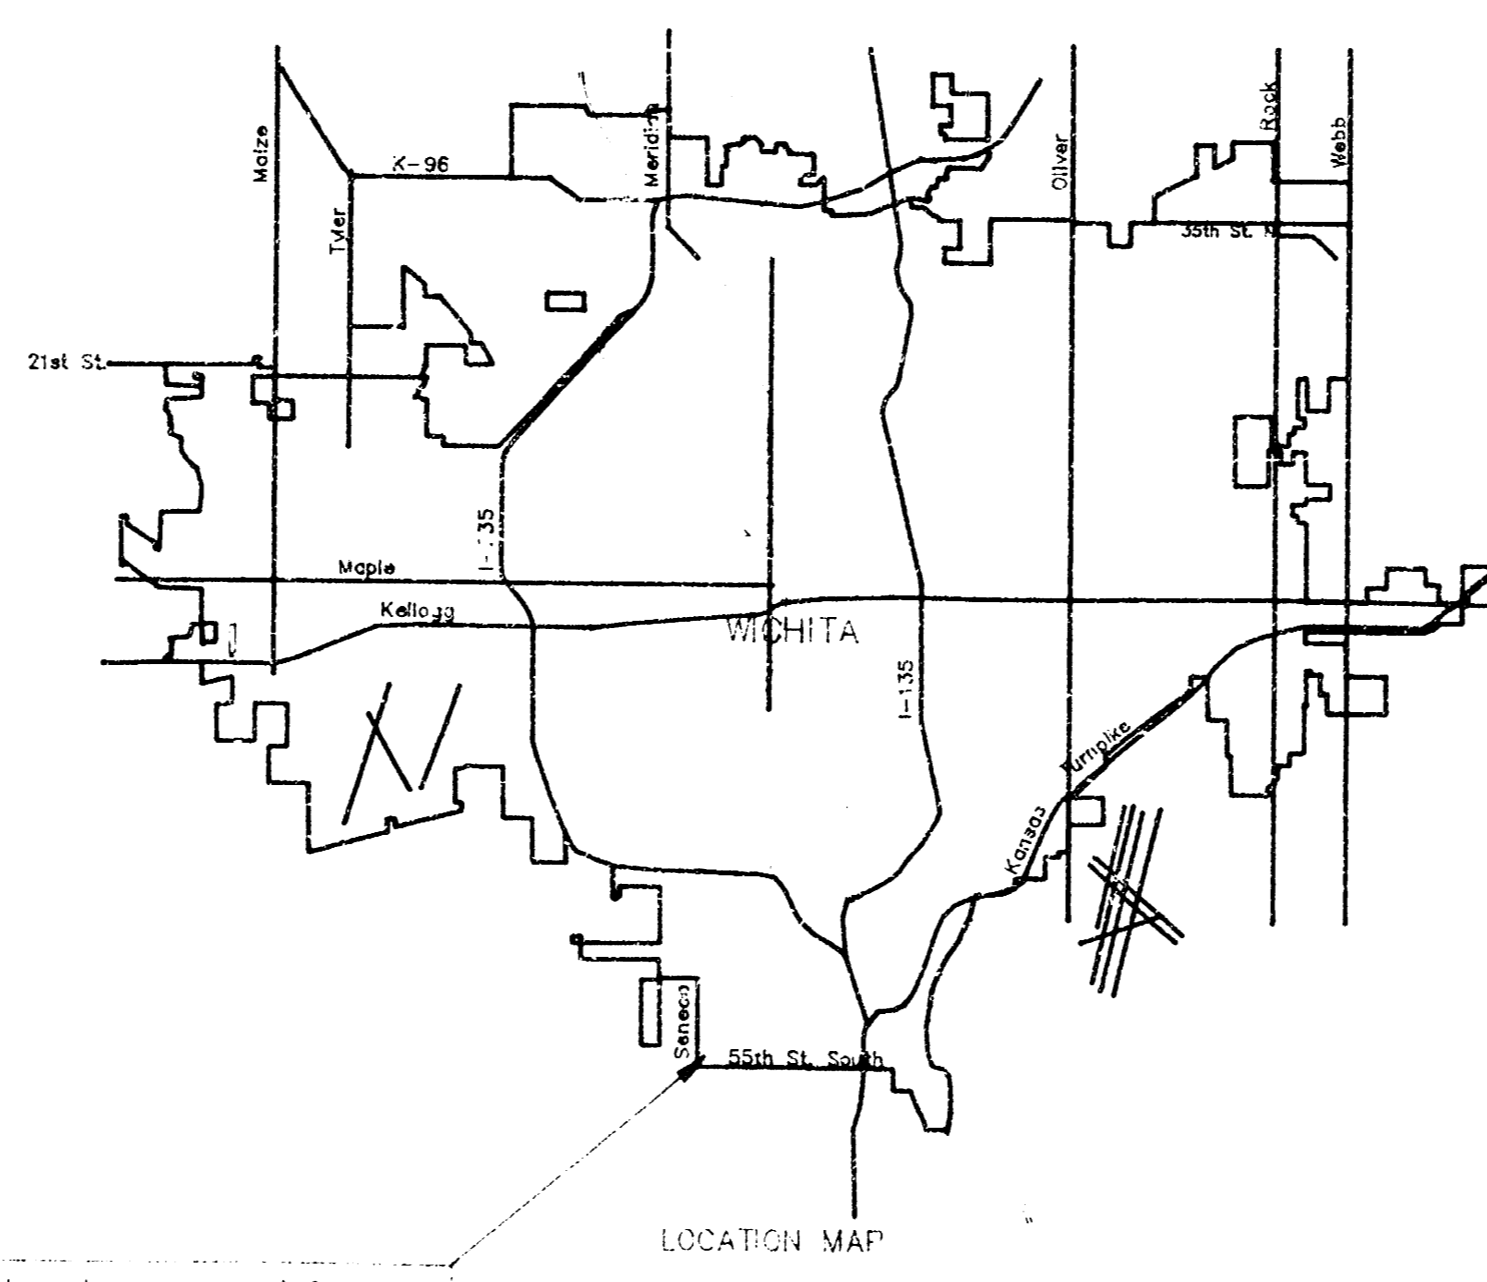

Project Location

PROJECT LOCATED IN
 SOUTH SENECA GARDENS FOURTH ADDITION BUSINESS PARK


- INDEX OF SHEETS
1. Title Sheet
 2. Plan-Profile Sheet
 3. Curb Inlet Detail
 4. Manhole Detail

APPROVED AS NOTED
 By CITY ENGINEER OF WICHITA

Sanitary Sewers _____
 Storm Sewers V.L.H. 1/16/96
 Driveway Approaches _____
 Water Mains _____
 Paving _____



NOTE TO CONTRACTOR

INSPECTION AND TESTING FOR THIS PROJECT IS TO BE PROVIDED BY A LICENSED CONSULTING ENGINEERING FIRM UNDER CONTRACT WITH THE OWNER/DEVELOPER. SAID INSPECTION TO BE IN ACCORDANCE WITH THE CITY OF WICHITA STANDARD CONSTRUCTION ENGINEERING PRACTICES AND CERTIFIED BY A LICENSED PROFESSIONAL ENGINEER. NO WORK SHALL BE PERFORMED IN DEDICATED EASEMENTS OR THE PUBLIC RIGHT-OF-WAY BY THE CONTRACTOR WITHOUT SUCH INSPECTION NOR SHALL ANY WORK BE COMMENCED IN DEDICATED EASEMENTS OR PUBLIC RIGHT-OF-WAY WITHOUT WRITTEN AUTHORIZATION BY THE CITY ENGINEER.

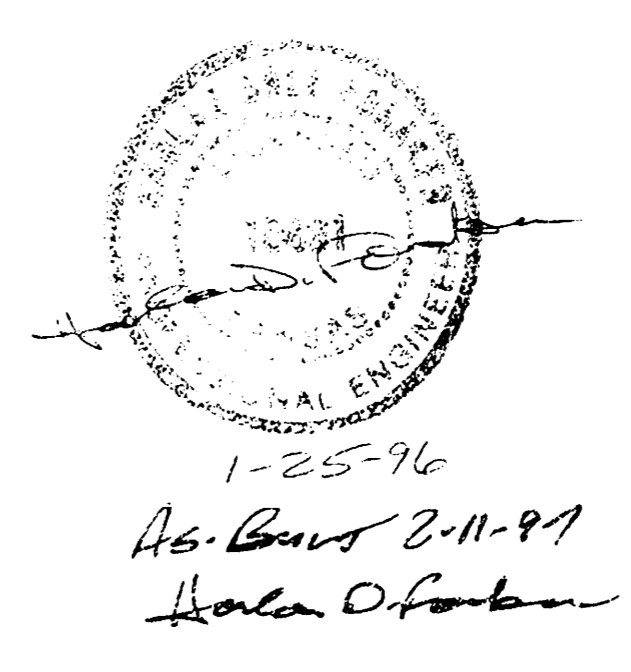

COW PRIV. PROJ. NO. 609 PPS(607861)
CERTIFIED ENGINEERING DESIGN
 CED
 226 NORTH OHIO
 WICHITA, KANSAS 67214
 (316) 262-8808

SHEET 1
 TOTAL

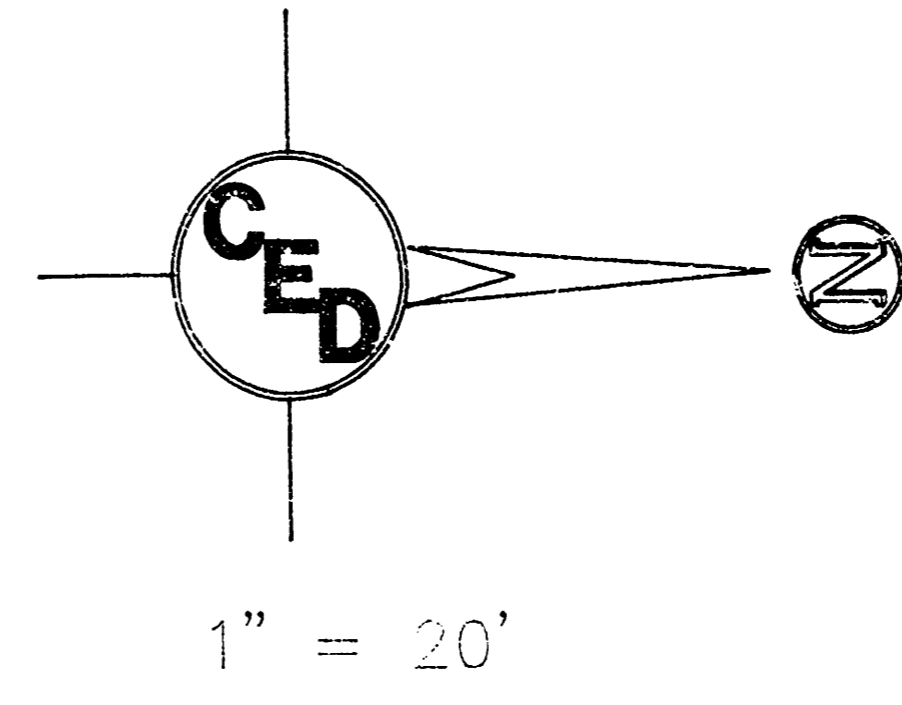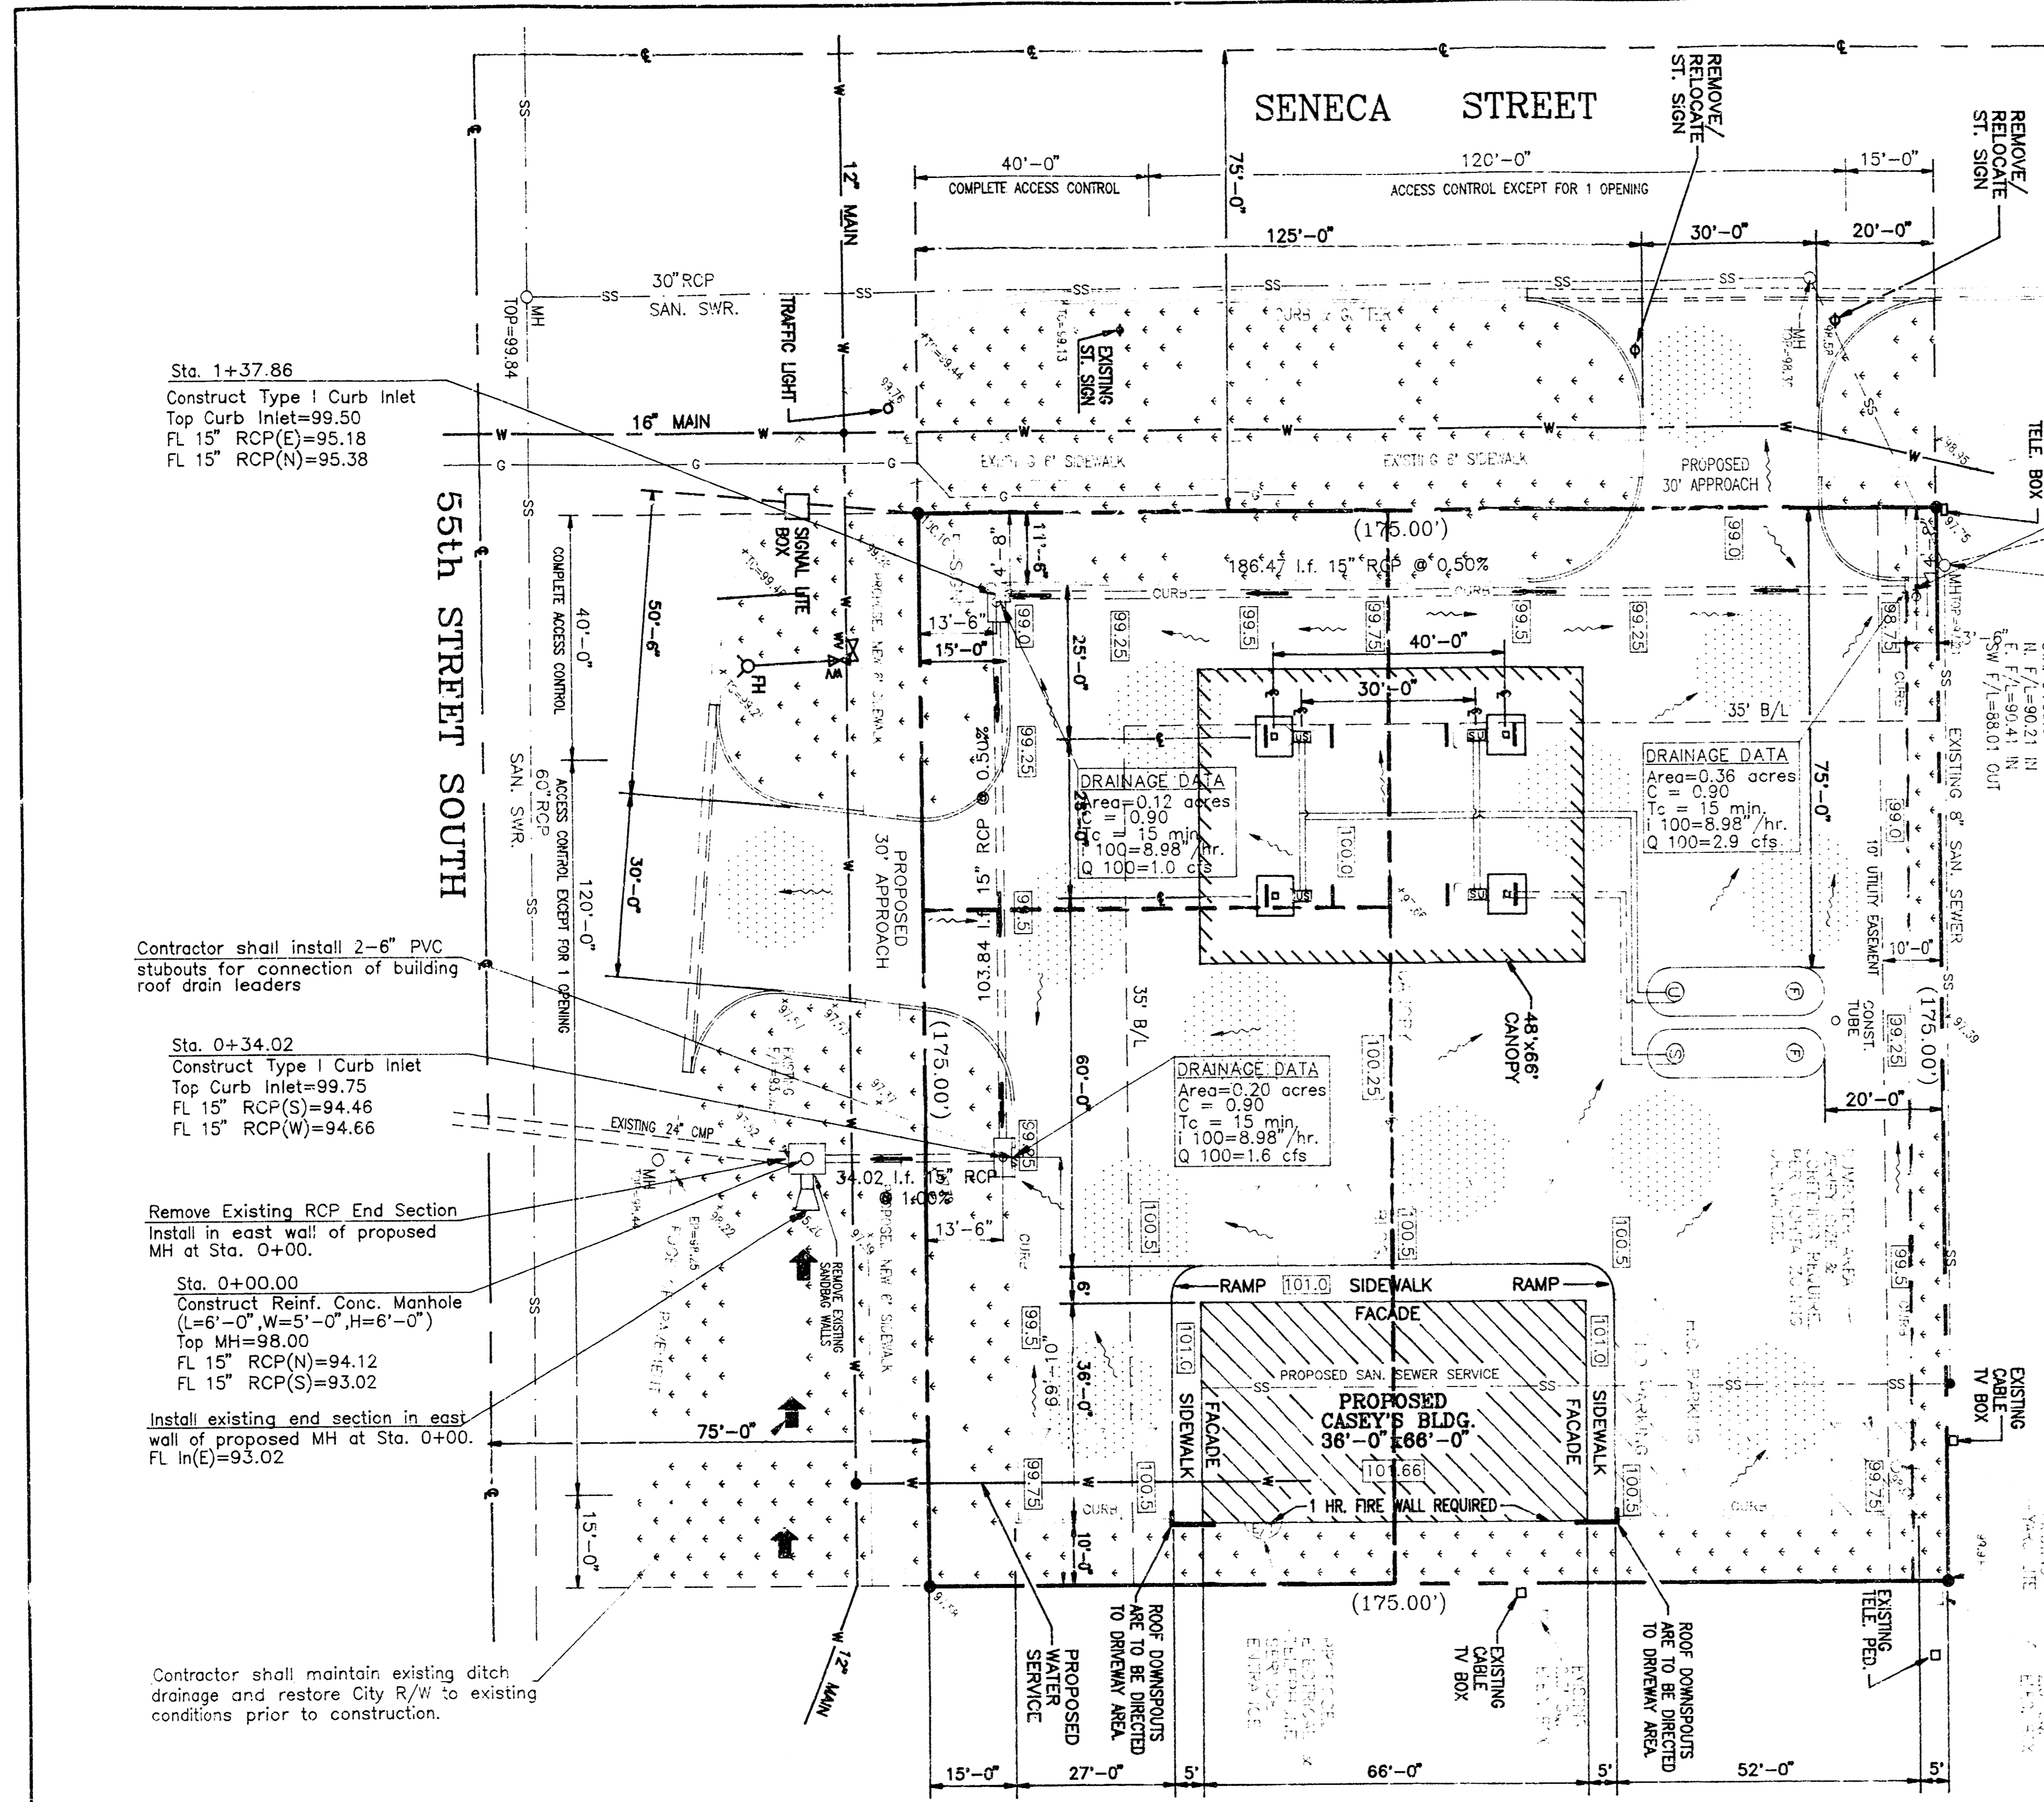

UTILITIES SHOWN REPRESENT THE BEST INFORMATION AVAILABLE FOR DESIG. ADDITIONAL UTILITIES MAY BE PRESENT ON THIS PROJECT. THE CONTRACTOR SHALL BE RESPONSIBLE FOR DETERMINING THE EXACT LOCATION, DEPTH AND SIZE OF ALL UNDERGROUND UTILITIES PRIOR TO CONSTRUCTION. THE CONTRACTOR SHALL BE LIABLE FOR ANY DAMAGE CAUSED BY THE FAILURE TO DO SO.


GENERAL NOTES

- The Contractor shall provide a minimum advance notice of 48 hours to utility companies prior to starting construction as follows:
 KANSAS ONE CALL 1-800-344-7233 or 687-2470 (LOCAL WICHITA)
 The Contractor must notify the following in the event of an emergency:
 Southwestern Bell Telephone 1-571-2115
 Kansas Gas Service Company 262-0661
 Kansas Gas & Electric 263-7511
 Arkia Gas Company 264-1141
 Multimedia Cablevision 262-0661
 City of Wichita Water & Sewer 268-4908
- Pavement grades shown are to the top of pavement.
- Existing elevations were provided by others. Contractor shall verify existing grades and notify Engineer of any discrepancies. Elevations are based on City Datum.
- Contractor shall be responsible for establishing and protecting Benchmark throughout construction.
- Contractor shall strip site of topsoil (6" min.) and stockpile this material to be used in grassed areas.
- Compaction of fill material and subgrade stabilization shall comply with Geotechnical Engineering Report.
- The Contractor shall not start work on the project until the project inspector assigned to the project is present on the site. The project inspector is Certified Engineering Design, 235 N. Ohio, Wichita, KS, (316)262-8808. All work done without inspection will be required to be uncovered for inspection. The contractor shall notify the inspector for the project 48 hours prior to beginning construction.
- The Contractor shall restore City right-of-way to conditions which existed prior to the commencement of work shown on this plan.

LEGEND:

SS	SS	SANITARY SEWER	W	WATER VALVE
C	C	GAS LINE	FH	FIRE HYDRANT
W	W	WATER LINE	PP	PROPERTY PIN
PL	PL	PROPERTY LINE	SS	STREET SIGN
CL	CL	CENTER LINE	SM	SAN. SEWER MANHOLE

Parking Summary
 Total Parking: 12
 (1 H.C. Stall)

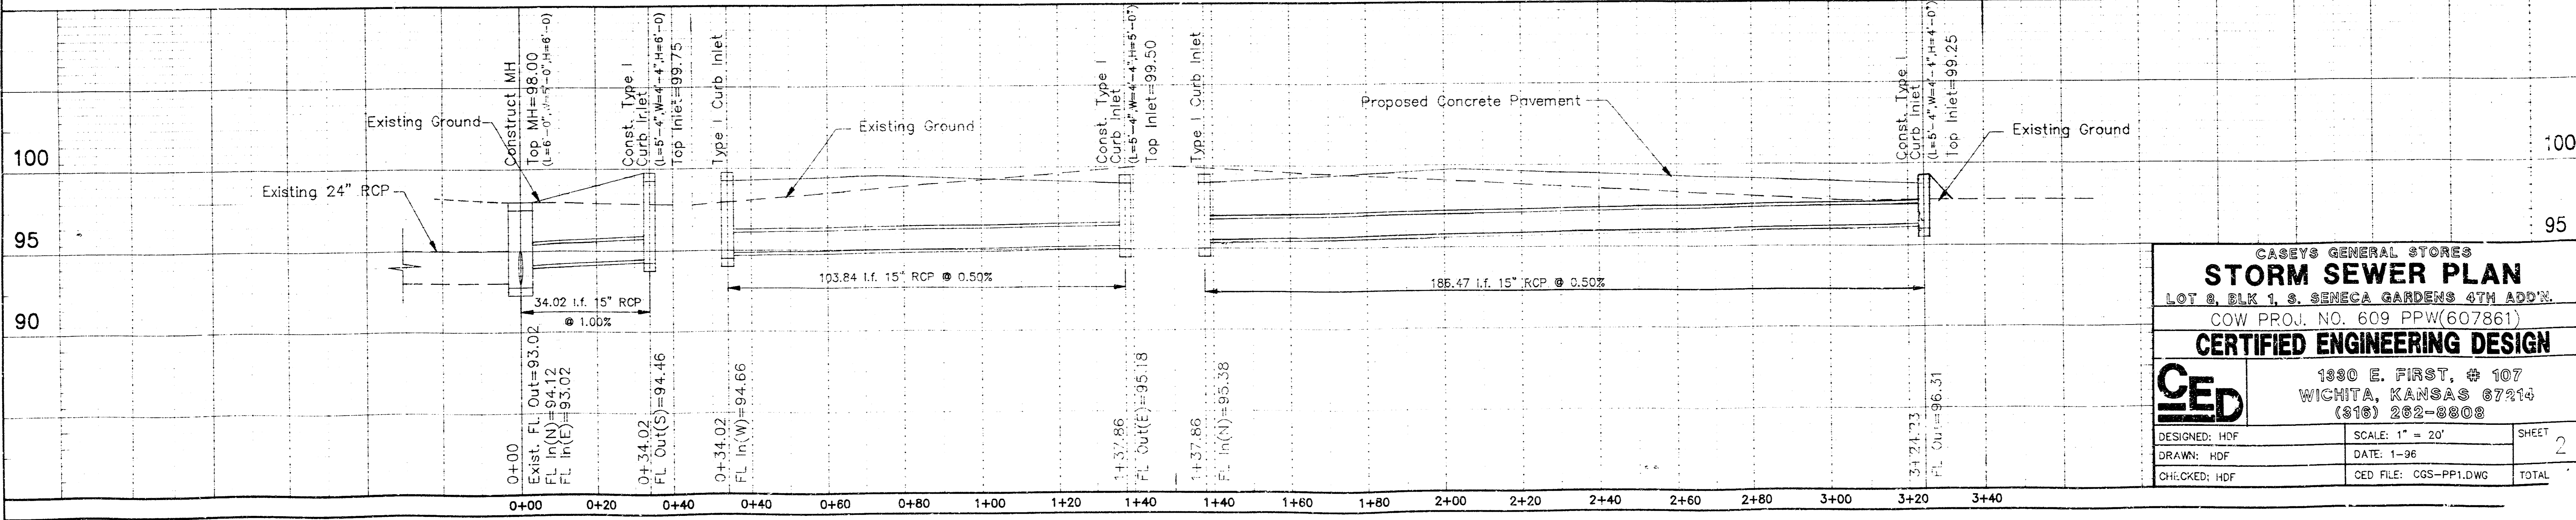


CASEY'S GENERAL STORES
STORM SEWER PLAN
 LOT 2, BLK 1, S. SENECA GARDENS 4TH ADDY.
 COW PROJ. NO. 609 PPW(607861)
CERTIFIED ENGINEERING DESIGN

GED 1330 E. FIRST, # 107
 WICHITA, KANSAS 67214
 (316) 262-8808

DESIGNED: HOF SCALE: 1" = 20'
 DRAWN: HOF DATE: 1-96
 CHECKED: HOF CED FILE: CGS-PP1.DWG TOTAL

SHEET 2


As-built 2-11-91
William O. Fisher

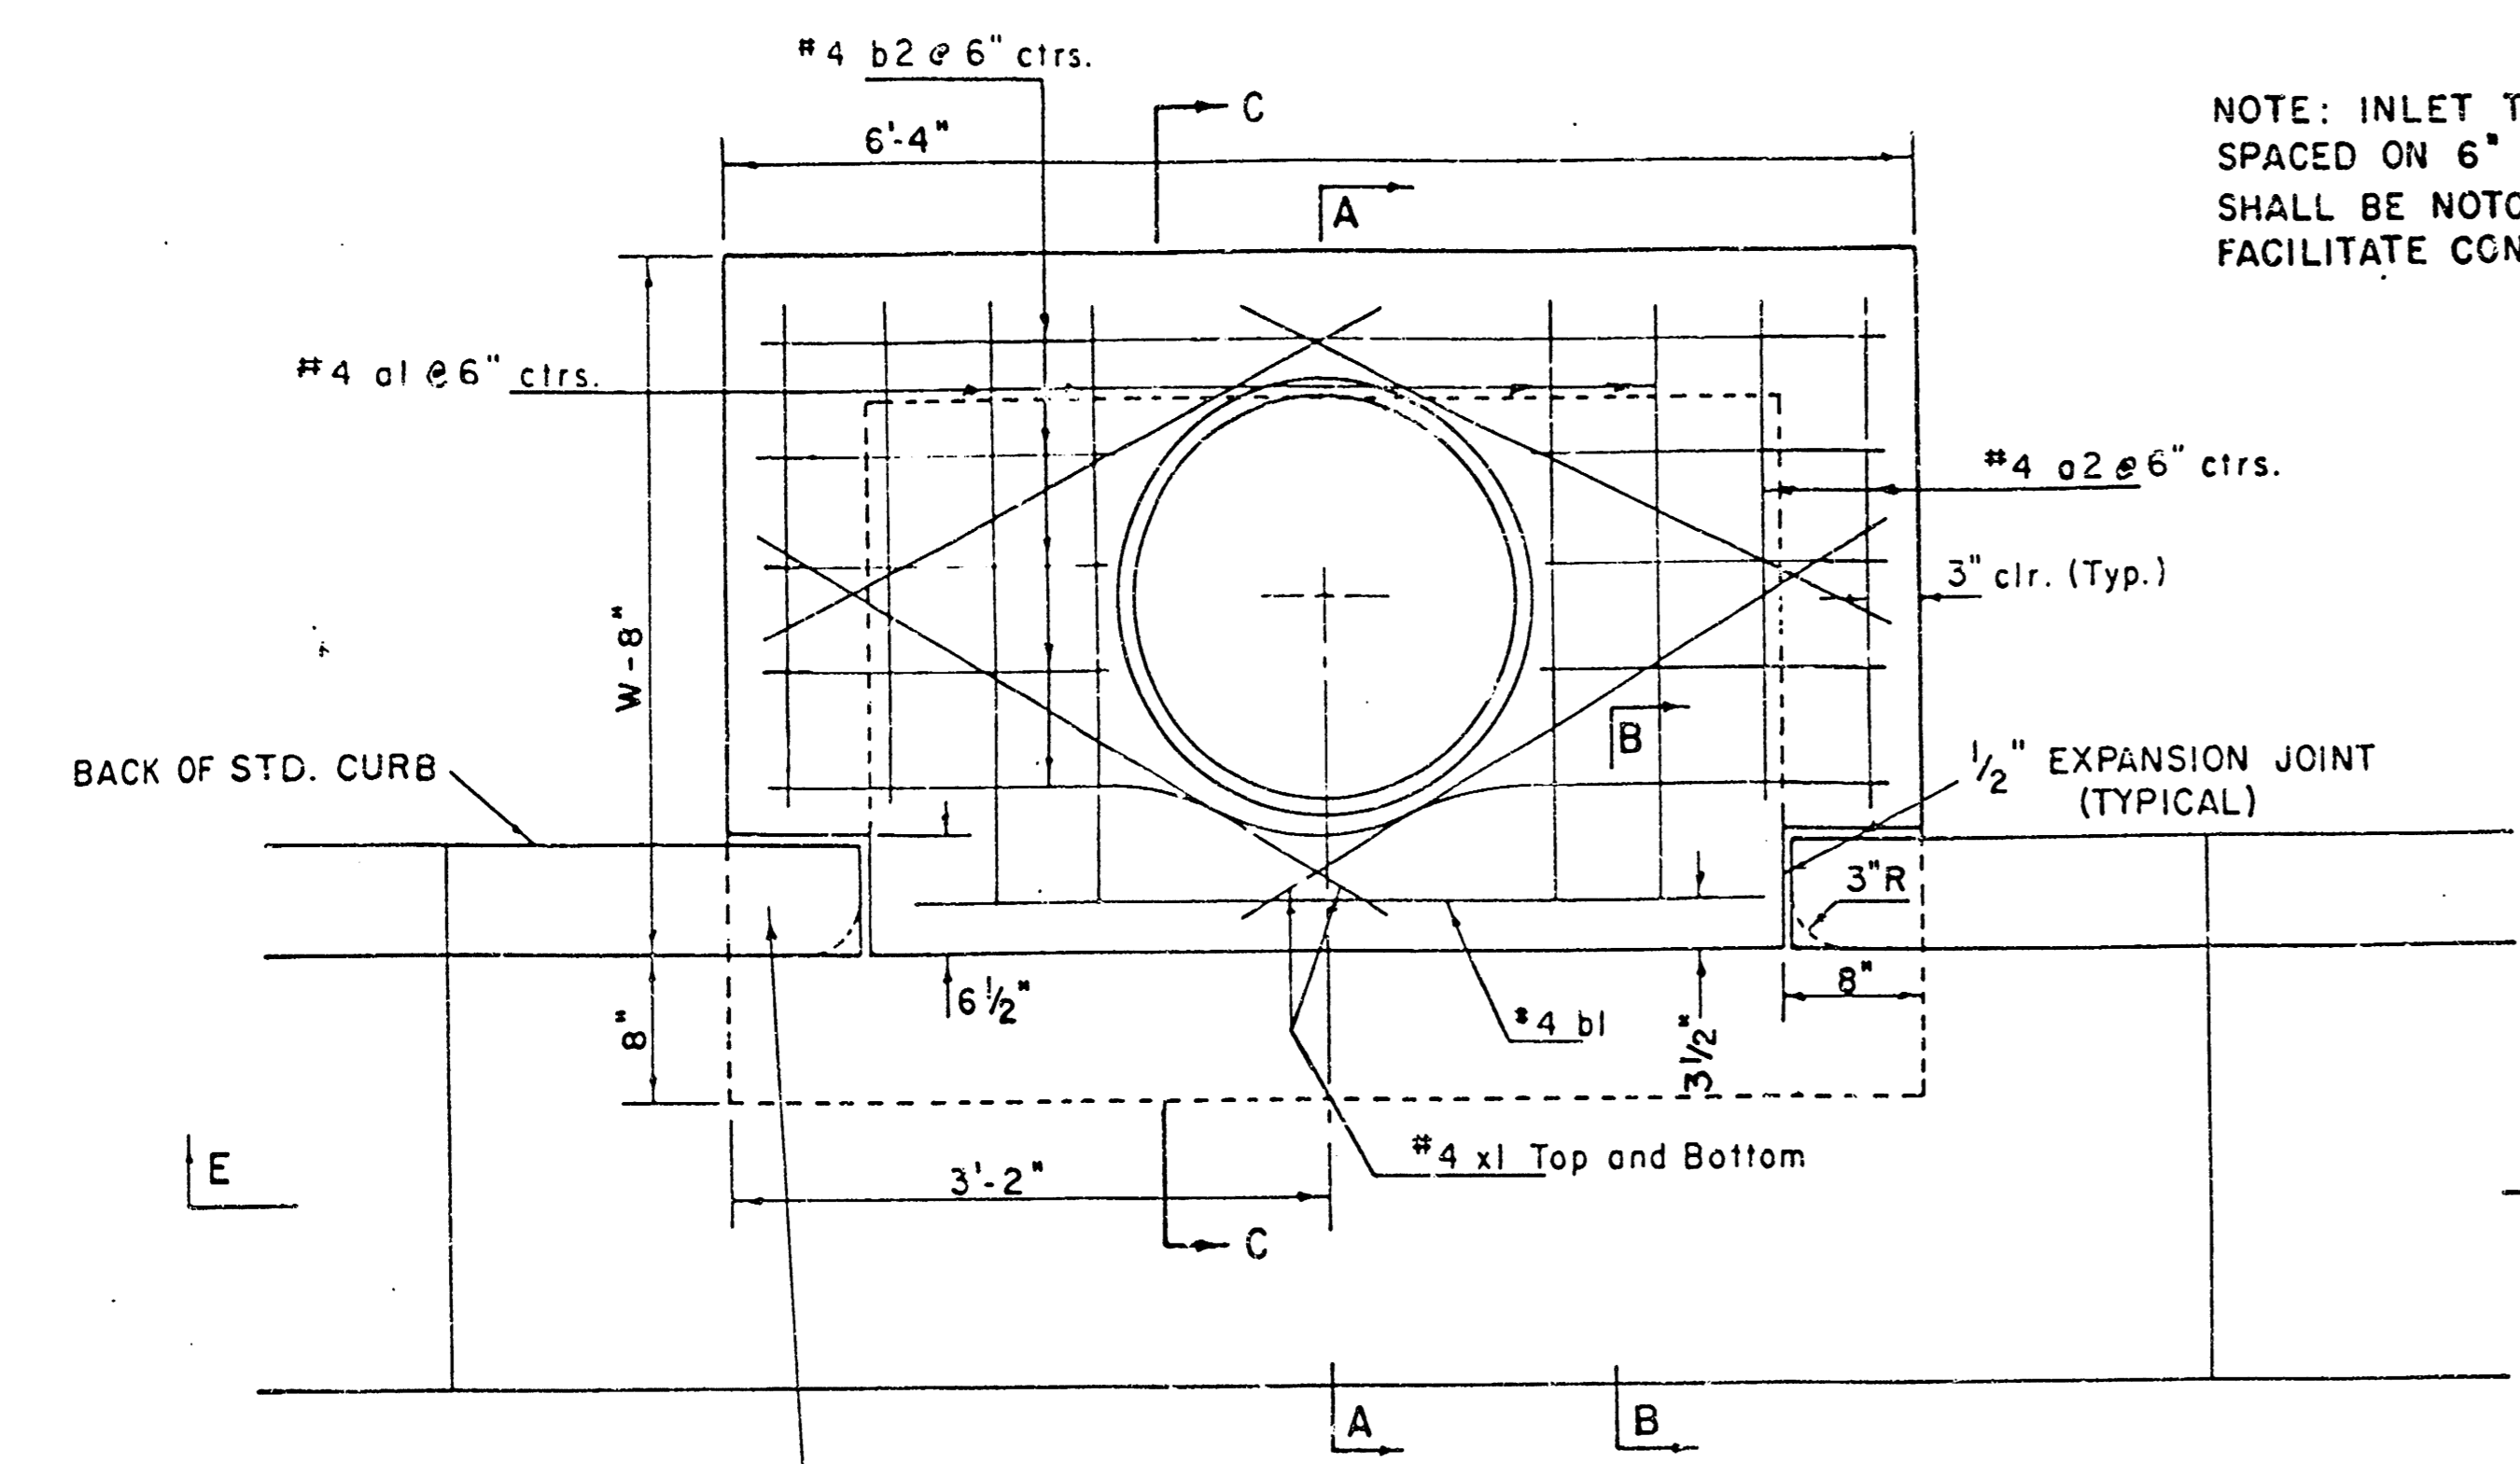

WARP CURB TO MATCH INLET TOP WITH 1' MIN. TRANSITION LENGTH

PLAN

NOTE: INLET TOP REINFORCING SHALL BE SPACED ON 6" MAX. CENTERS. INLET LIDS SHALL BE NOTCHED 3/4" AS INDICATED TO FACILITATE CONSTRUCTION OF CURB.

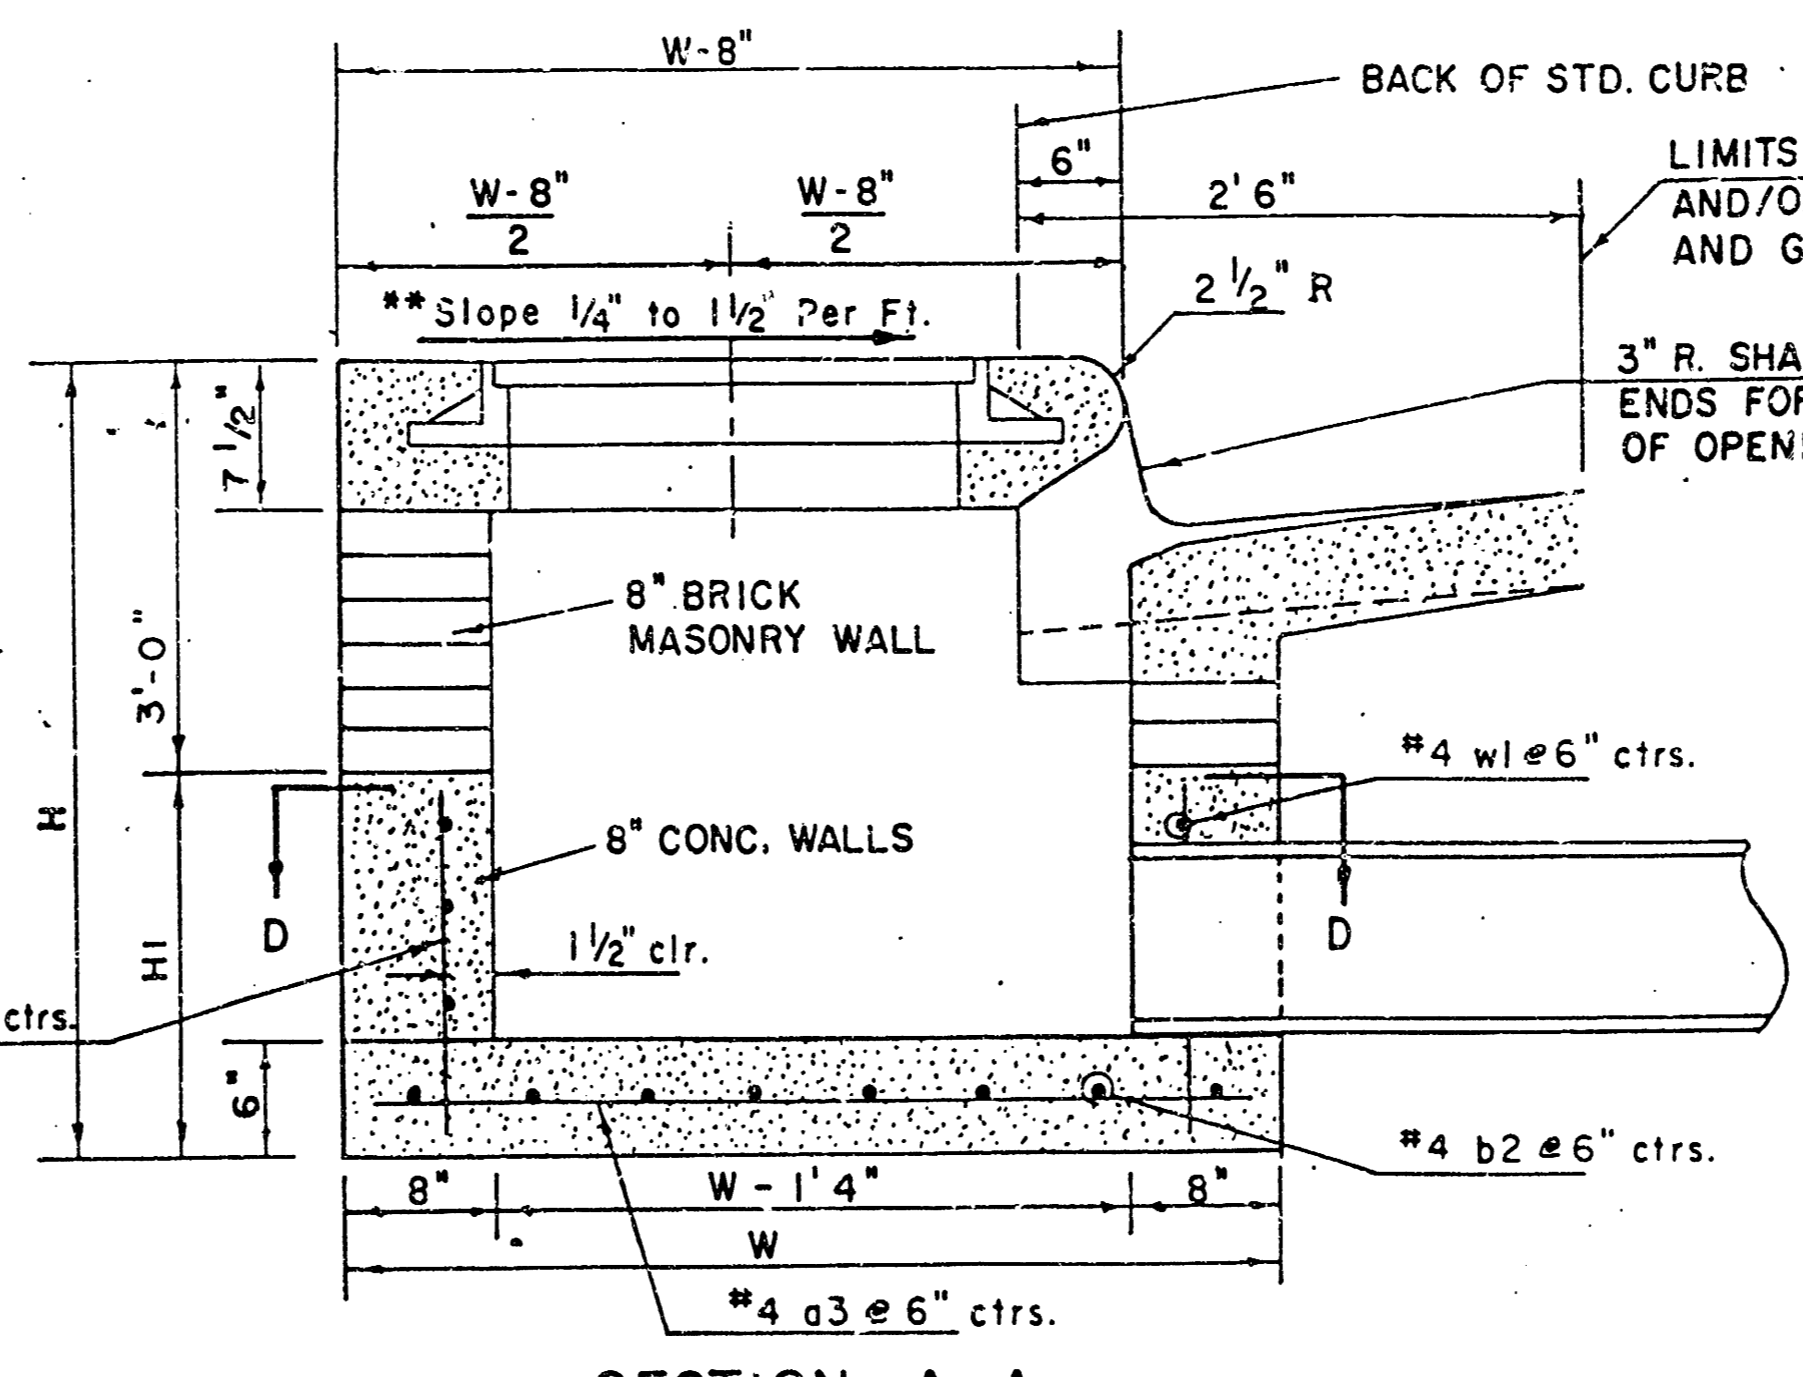

SECTION A-A


NOTE: CONCRETE TOPS TO BE INSTALLED ON THIN MORTAR CUSHION TO INSURE FULL SUPPORT ALONG BRICK WALLS. CONCRETE TOPS MAY BE CAST IN PLACE OR PRECAST. CONCRETE USED FOR INLET CONSTRUCTION SHALL BE CONCRETE PAVEMENT MIX.

** NOTE: Slope of Inlet Tops to match Sidewalk or Parking Slopes within Limits Indicated.

NOTE CONTRACTOR SHALL HAVE THE OPTION OF CONSTRUCTING 8" BRICK MASONRY WALLS BETWEEN THE CONCRETE INLET BASE AND TOP ON THIS INLET WHEN W = 6'-4" AND H = 7'-0" OR LESS.


INLET INVERT SHALL BE SHAPED WITH 8 SACK SAND MIX CONCRETE TO CREATE FLOW CHANNELS AND TO INCREASE HYDRAULIC EFFICIENCY SUCH THAT THE INLET WILL BE SELF CLEANING BETWEEN ALL INLET AND/OR OUTLET PIPES.

THE ENDS OF ALL PIPES INSTALLED IN INLETS SHALL BE CUT OFF FLUSH WITH THE INSIDE FACE OF THE INLET WALL.

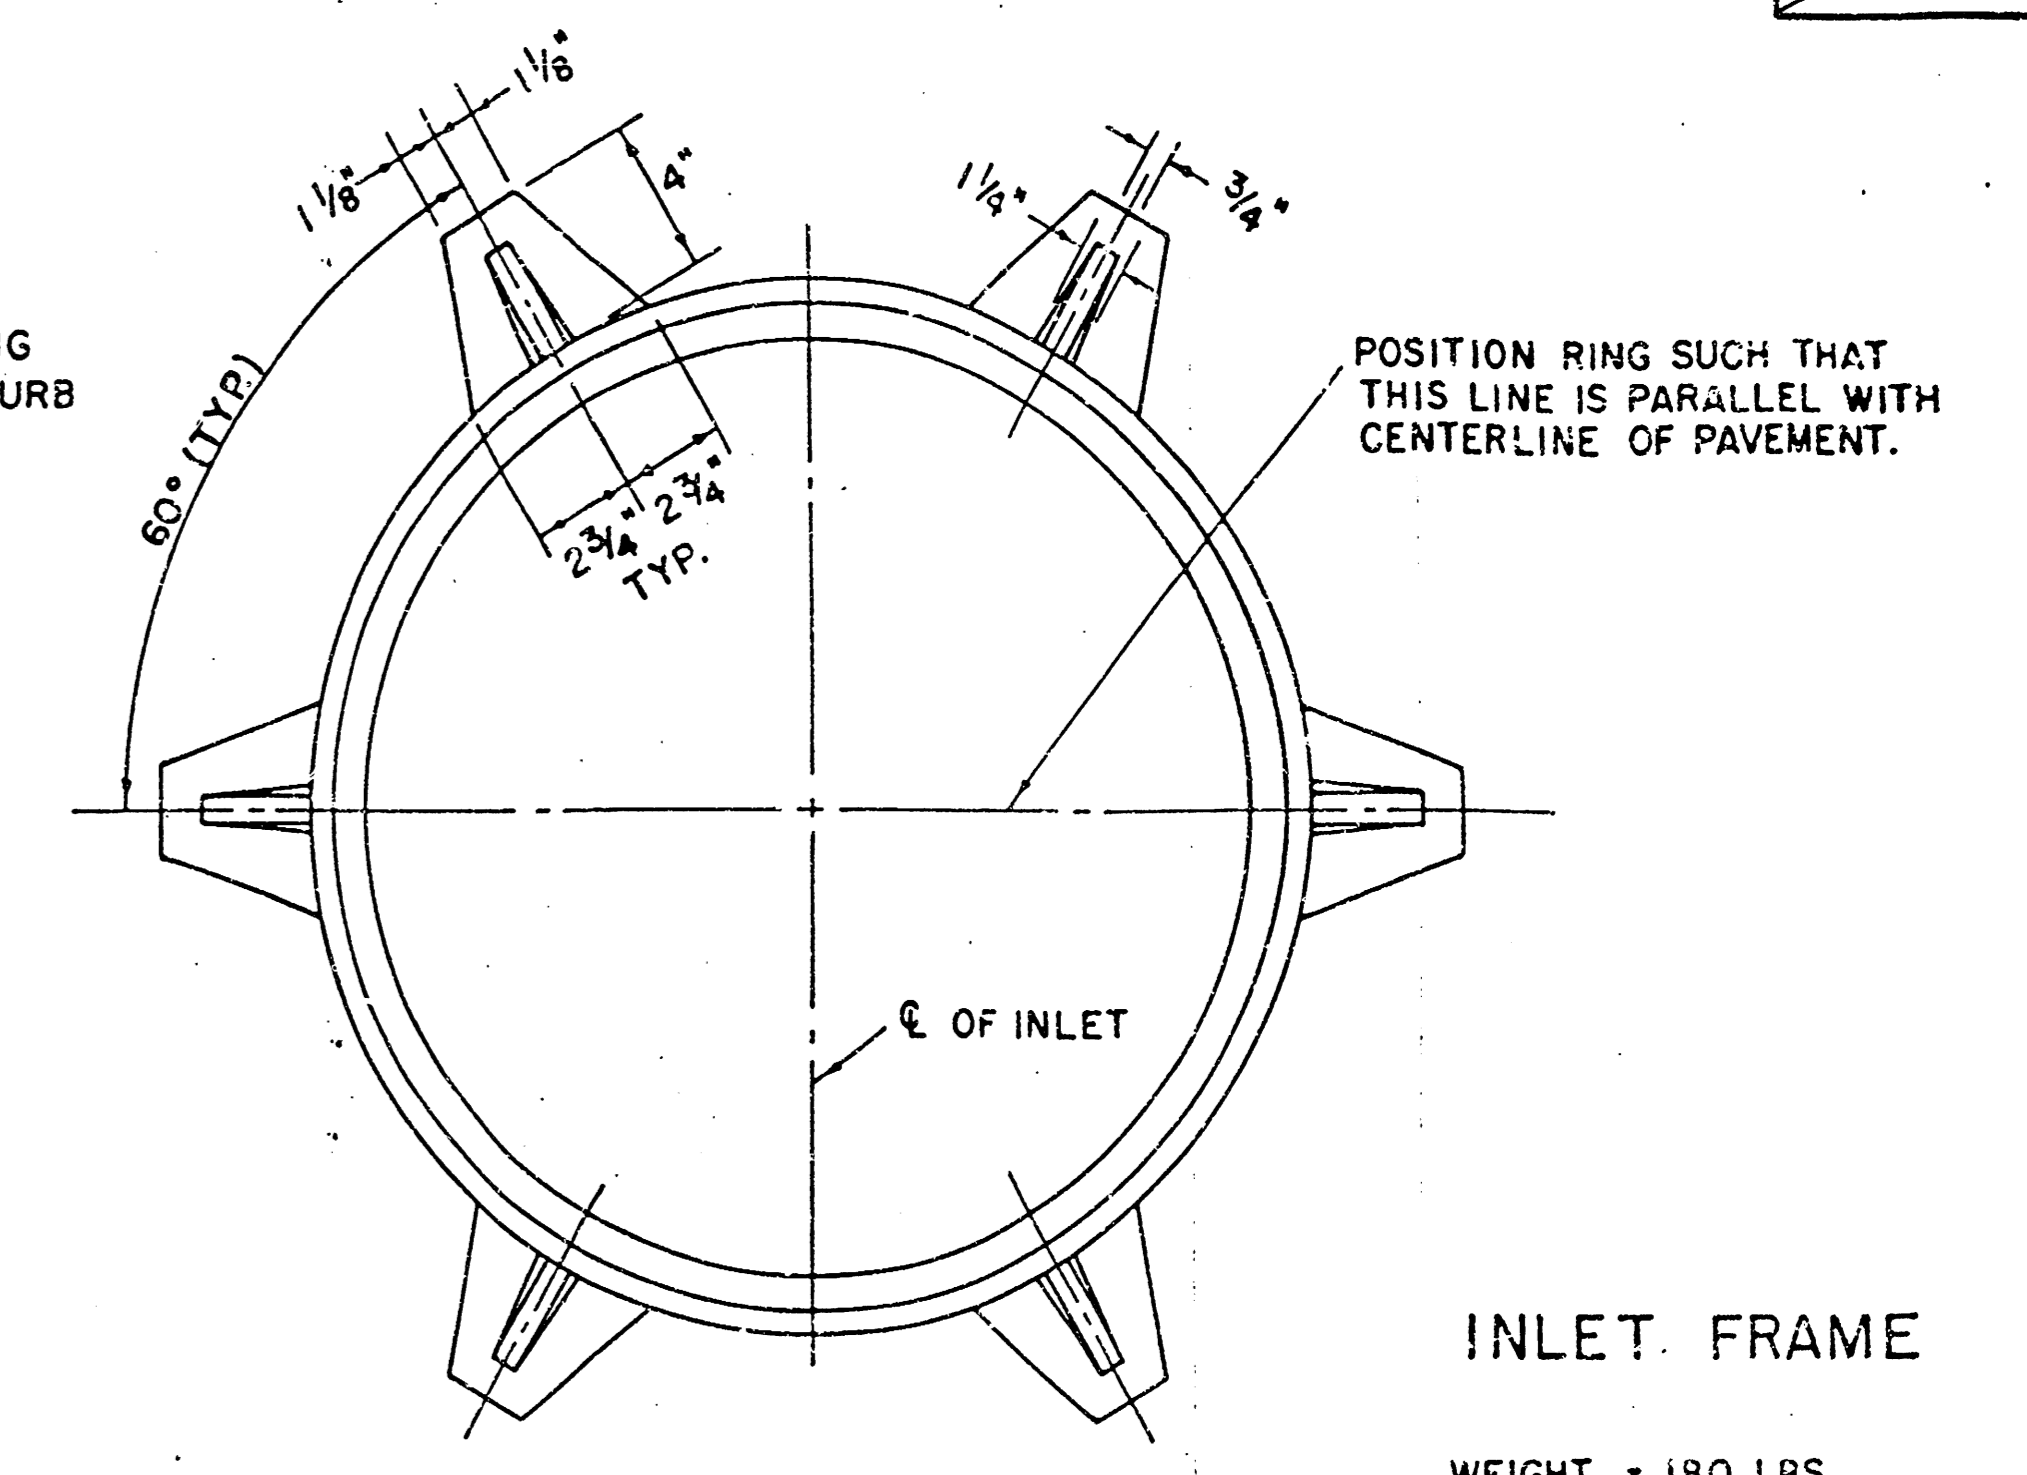

INLET FRAME

WEIGHT = 180 LBS.

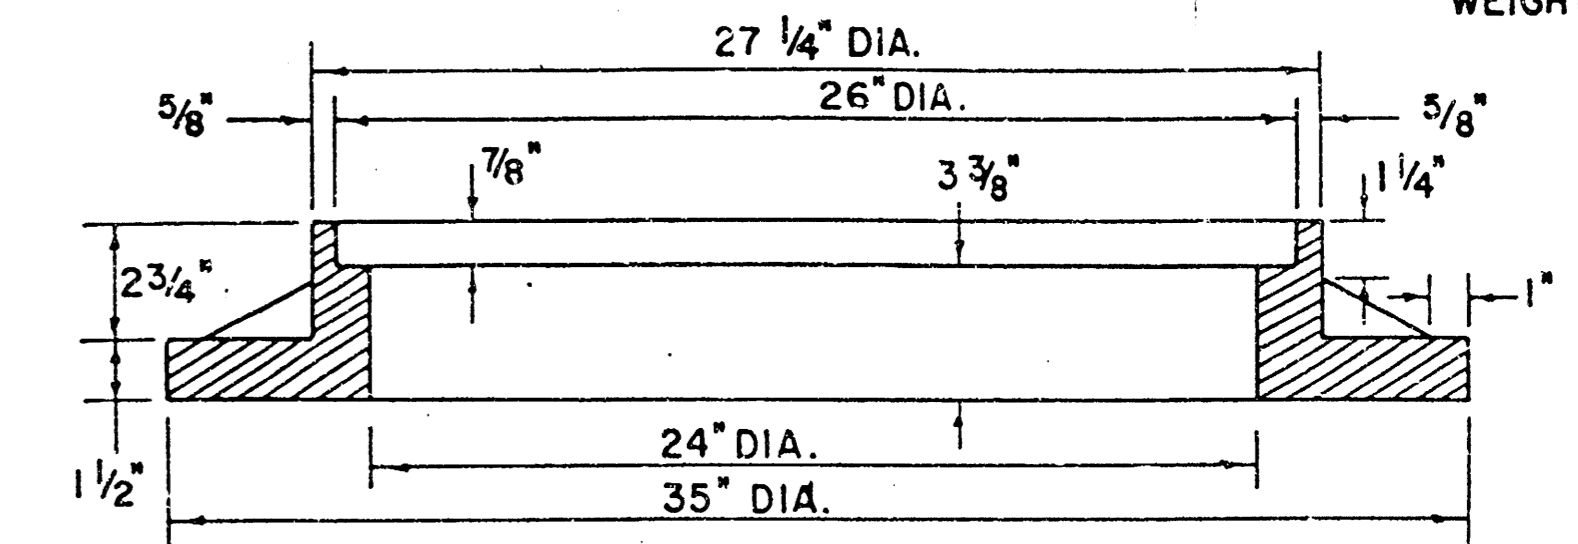


SEE CITY OF WICHITA STANDARD MANHOLE FRAME AND COVER DETAIL SHEET FOR COVER DETAILS TO BE USED WITH INLET FRAME.

PRECAST SLAB AND FLOOR REINFORCING											
Mark	Size	W = 4'-4"		W = 5'-4"		W = 6'-4"		W = 7'-4"		W = 8'-4"	
		No.	Length	No.	Length	No.	Length	No.	Length	No.	Length
a1	#4	6	6'-7"	6	8'-7"	6	10'-7"	6	12'-7"	6	14'-7"
a2	#4	4	6'-0"	4	8'-0"	4	10'-0"	4	12'-0"	4	14'-0"
a3	#4	13	4'-1"	13	5'-1"	13	6'-1"	13	7'-1"	13	8'-1"
b1	#4	1	4'-9"	1	4'-9"	1	4'-9"	1	4'-9"	1	4'-9"
b2	#4	23	6'-1"	29	6'-1"	35	6'-1"	41	6'-1"	47	6'-1"
x1	#4	8	3'-10"	8	4'-2"	8	4'-6"	8	4'-10"	8	5'-2"


WALL REINFORCING											
Mark	Size	W = 4'-4"		W = 5'-4"		W = 6'-4"		W = 7'-4"		W = 8'-4"	
		No.	Length	No.	Length	No.	Length	No.	Length	No.	Length
w1	#4	1	6'-1"	1	6'-1"	1	6'-1"	1	6'-1"	1	6'-1"
w2	#4	1	4'-1"	1	5'-1"	1	6'-1"	1	7'-1"	1	8'-1"
w3	#4	32	2	36	2	40	2	44	2	48	2

Field bend or cut Reinforcing as required for clearance.
 ① 4(HI-12"); (HI-12") Round down to nearest 0.5"
 ② HI-3"


STANDARD CURB INLET PRECAST TOPS			
W	PRE-CAST TOP SIZE	PIPE SIZE	CU. YD. CONC.
4'-4"	3'8" x 6'4"	7 1/2" x 21" & SMALLER	0.38 ±
5'-4"	4'8" x 6'4"	7 1/2" x 24" & 30"	0.51 ±
6'-4"	5'8" x 6'4"	7 1/2" x 36" & 42"	0.64 ±
7'-4"	6'8" x 6'4"	7 1/2" x 48" & 54"	0.77 ±
8'-4"	7'8" x 6'4"	7 1/2" x 60" & 66"	0.90 ±

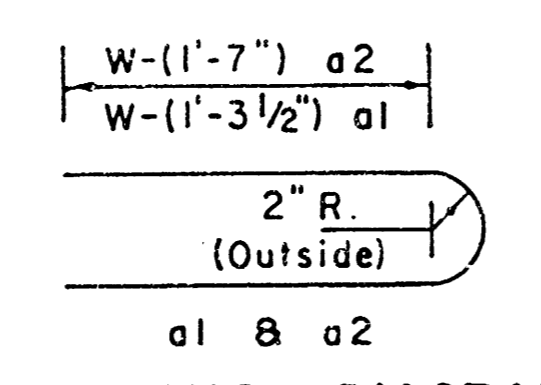


BENDING DIAGM

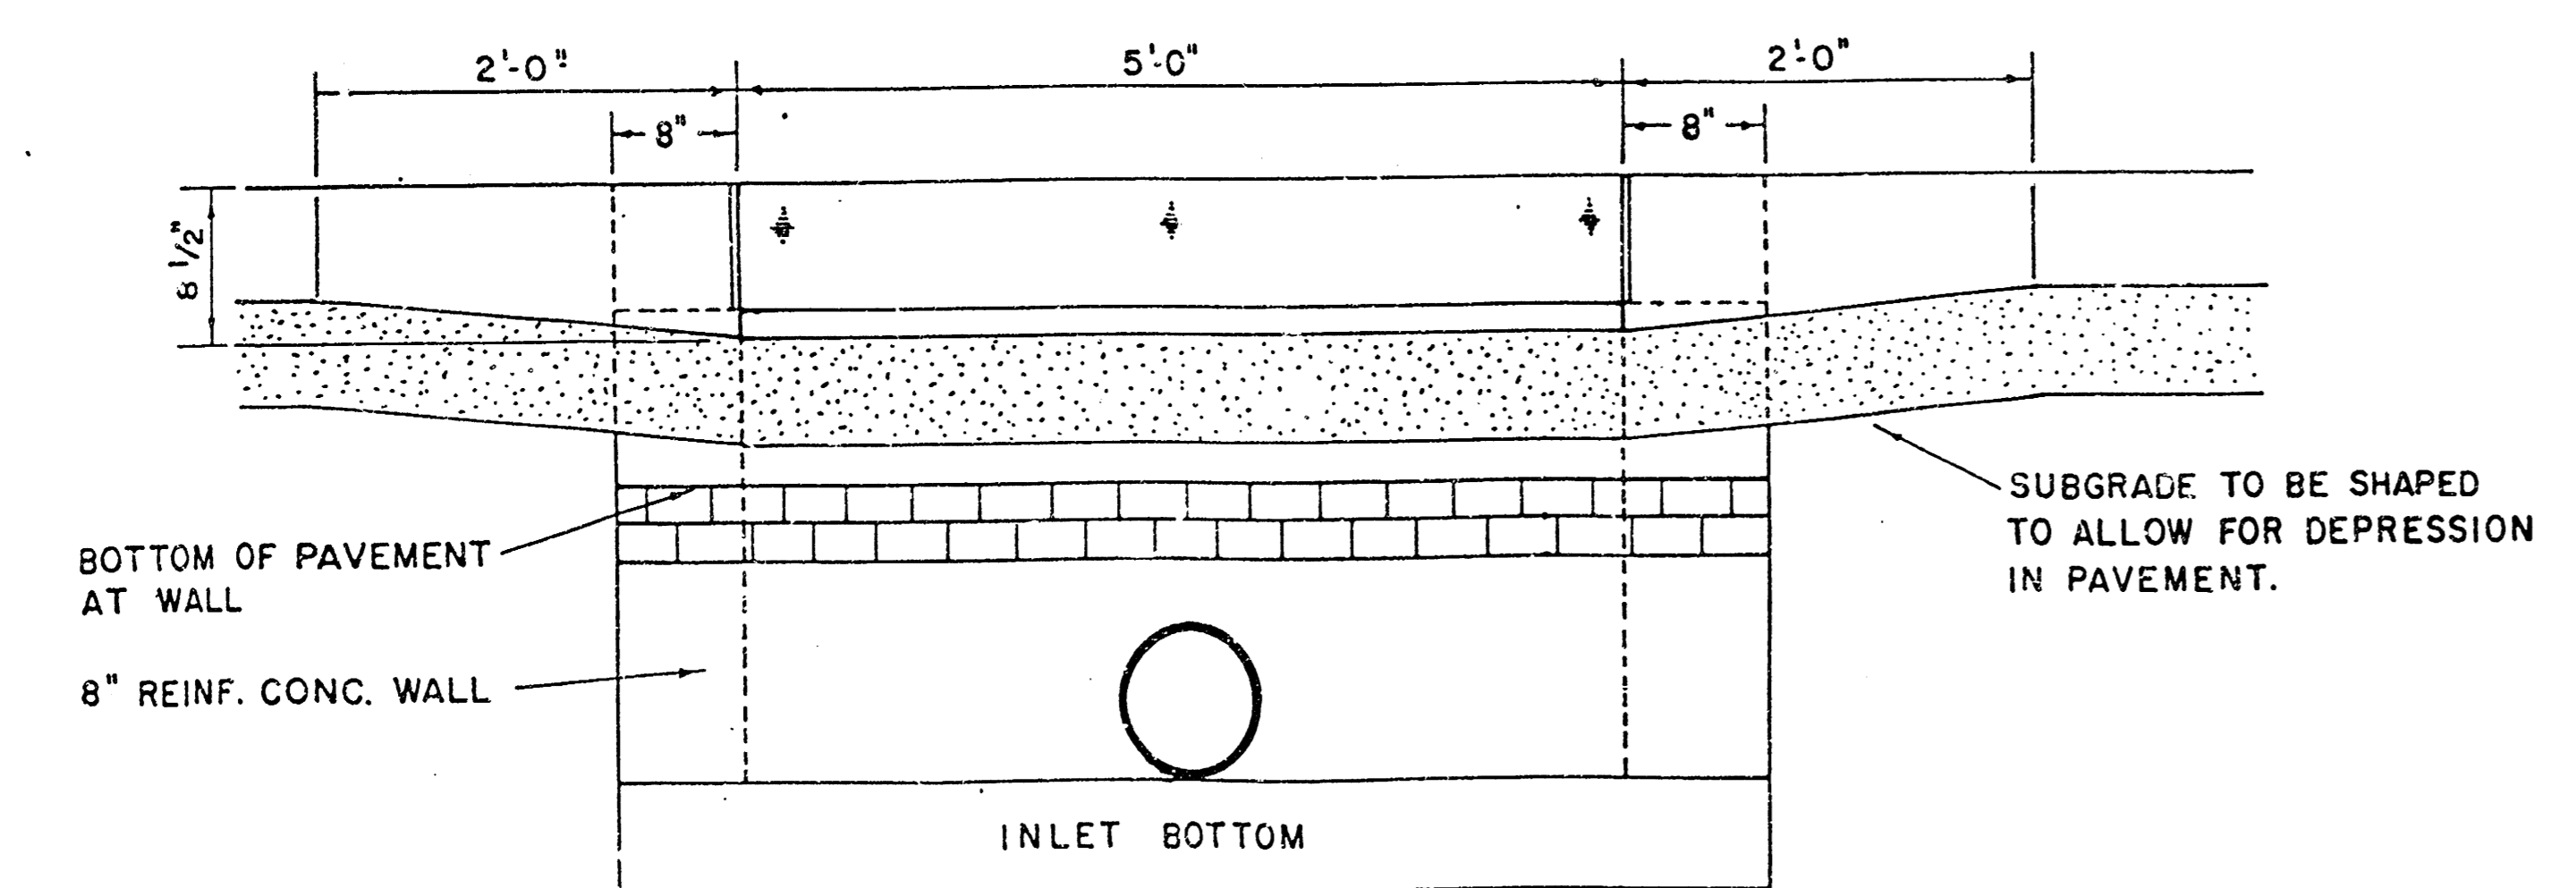


SECTION E-E

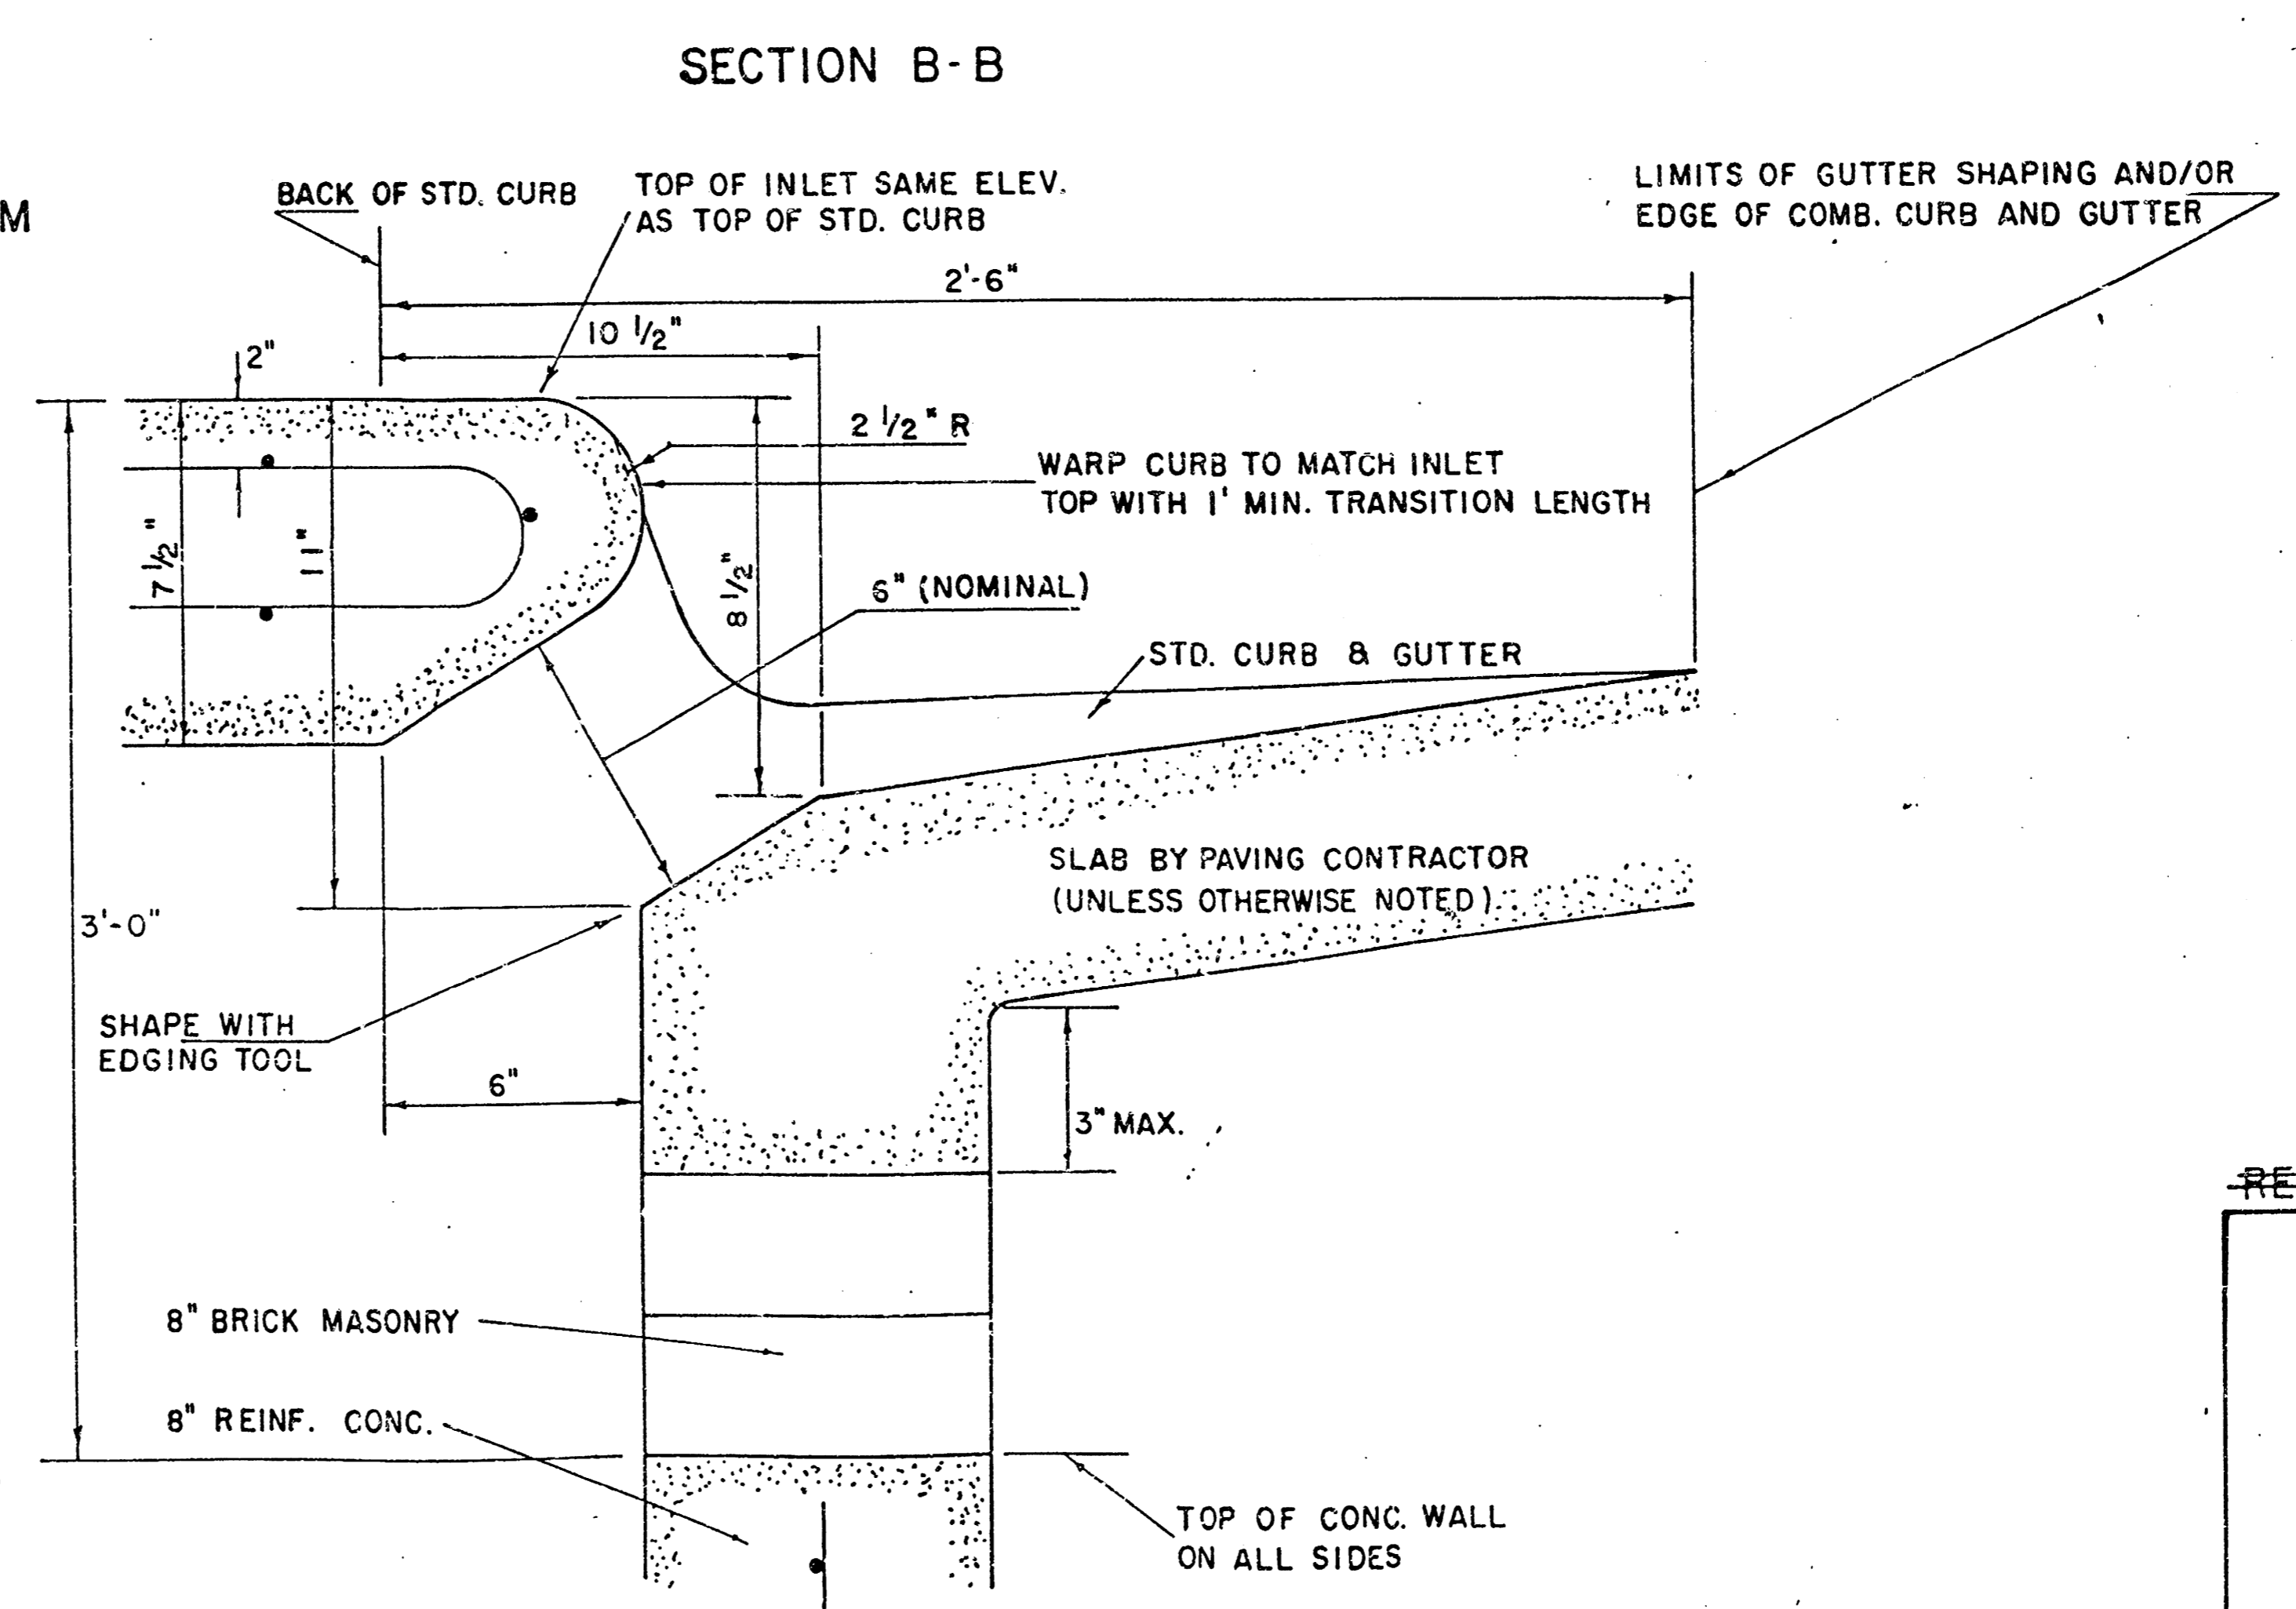

SECTION B-B

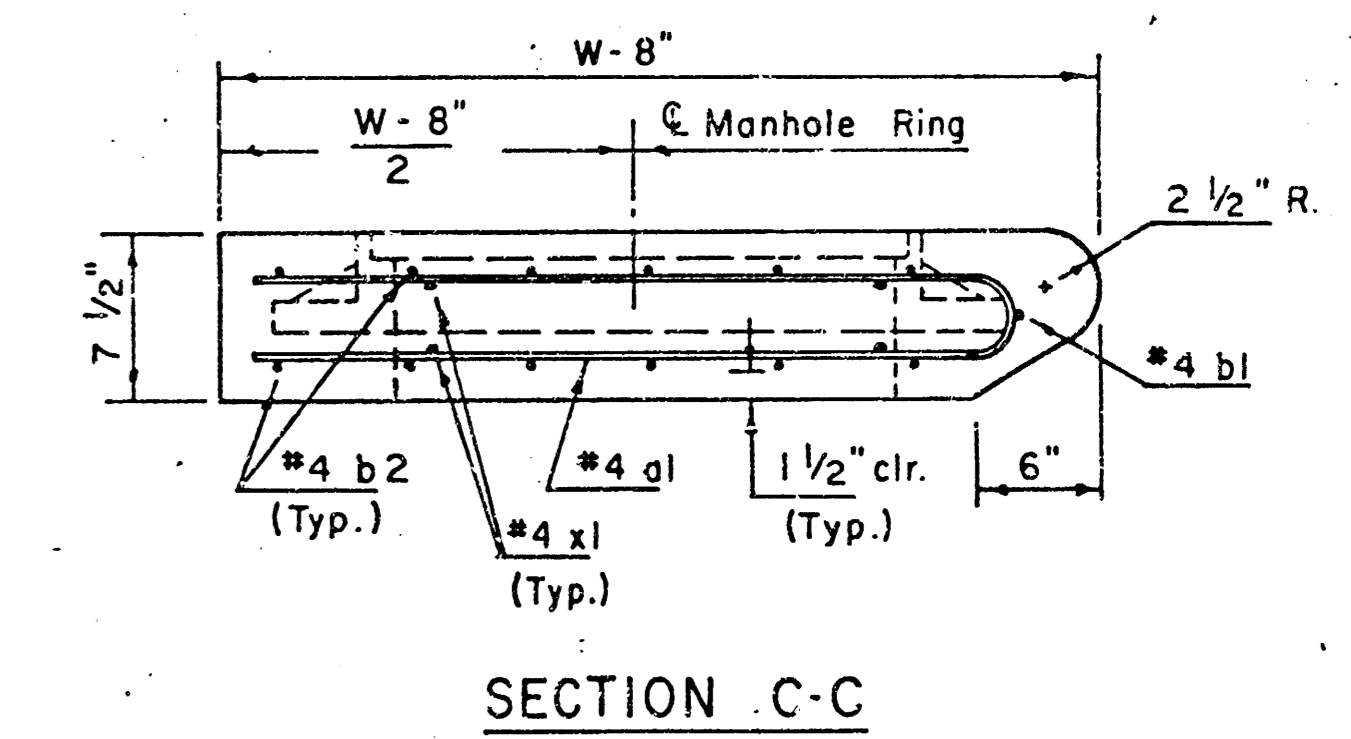


SECTION C-C

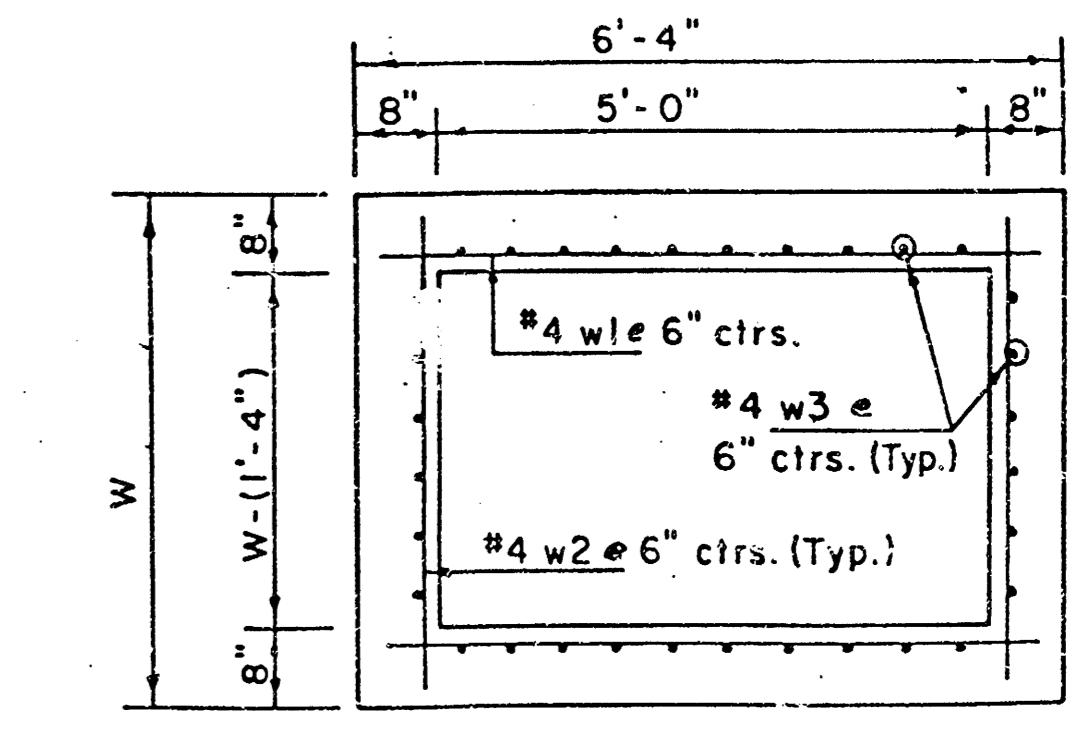


SECTION D-D

REVISD 12-21-1984 REVISED 2-15-1989
DETAIL STANDARD TYPE I CURB INLET
 CITY OF WICHITA, KANSAS
 INLET OPENING = 6" x 5' 0"
 JUNE 1984


FHWA REGION	STATE	PROJECT NO.	YEAR	SHEET NO.	TOTAL SHEETS
7	KANSAS		19	4	4

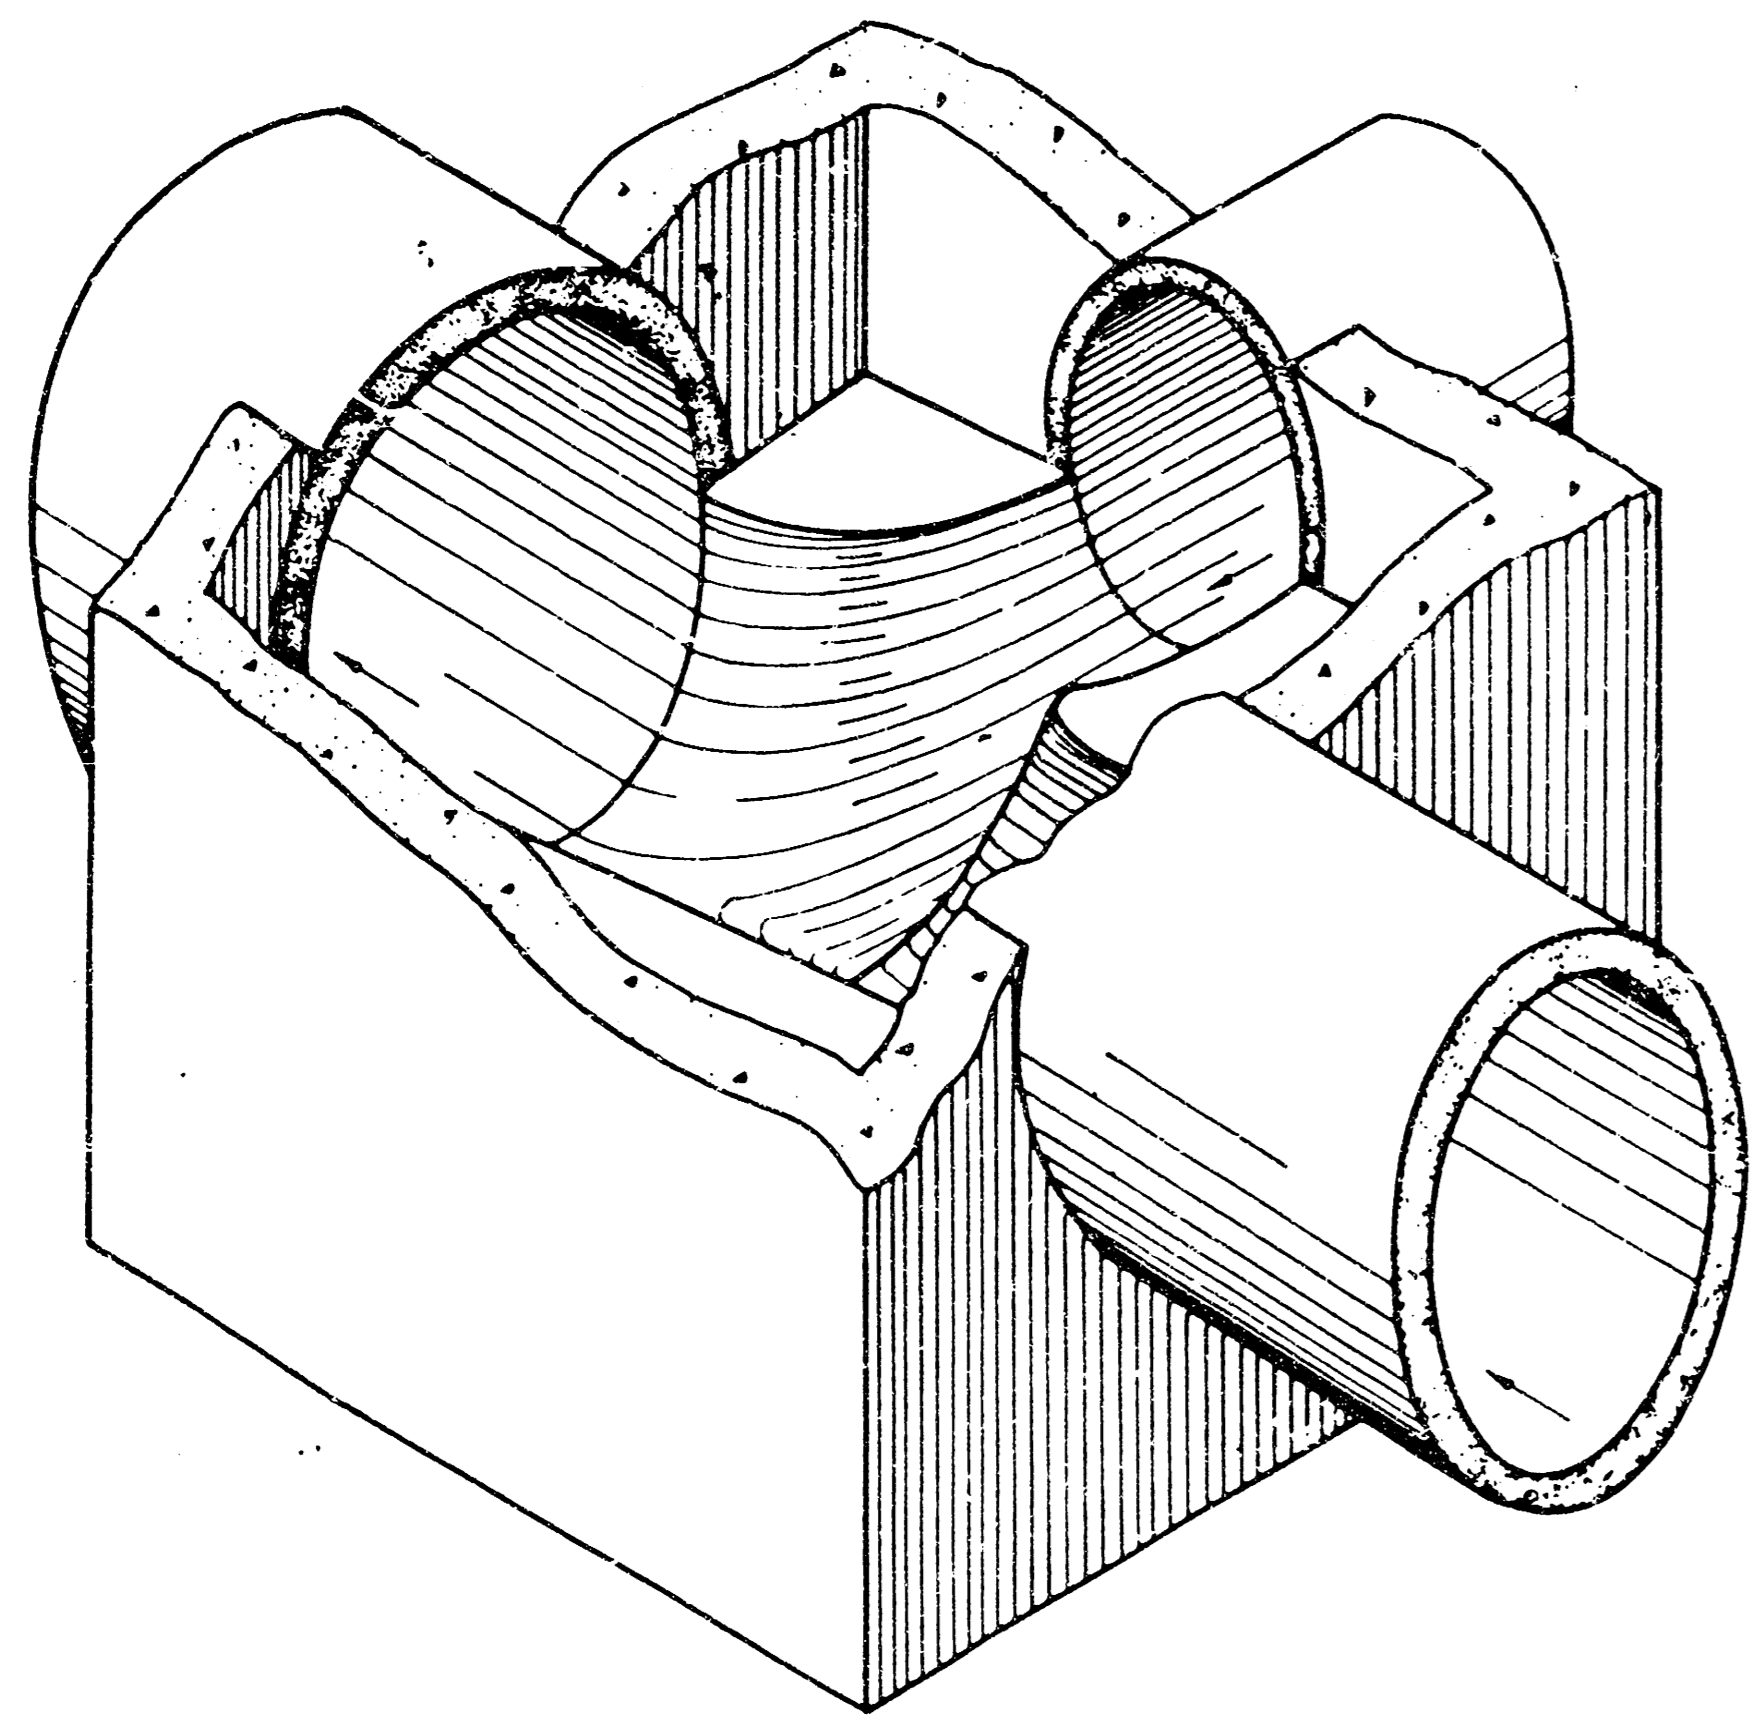



SECTIONAL VIEW (EXAMPLE IV)
Showing Floor Shaping

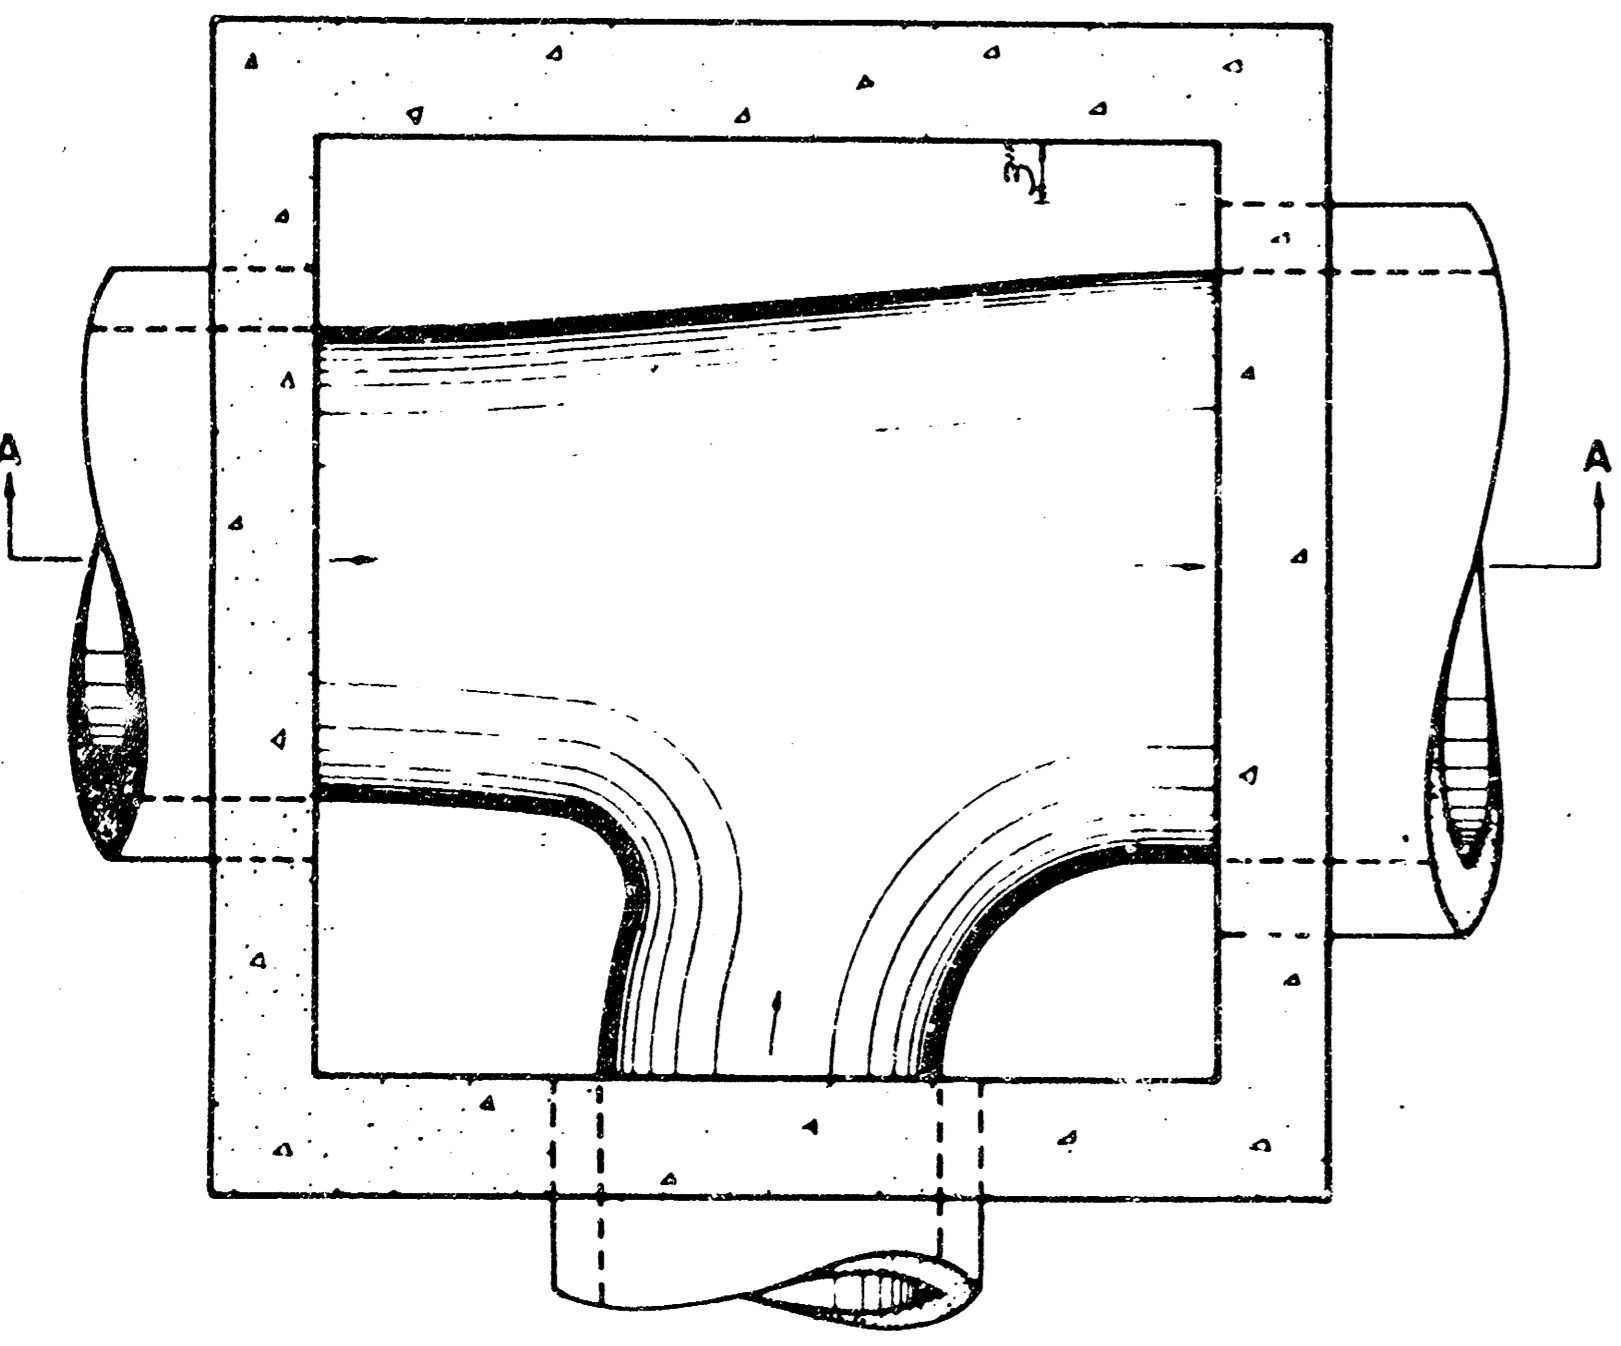


FLOOR PLAN (EXAMPLE IV)

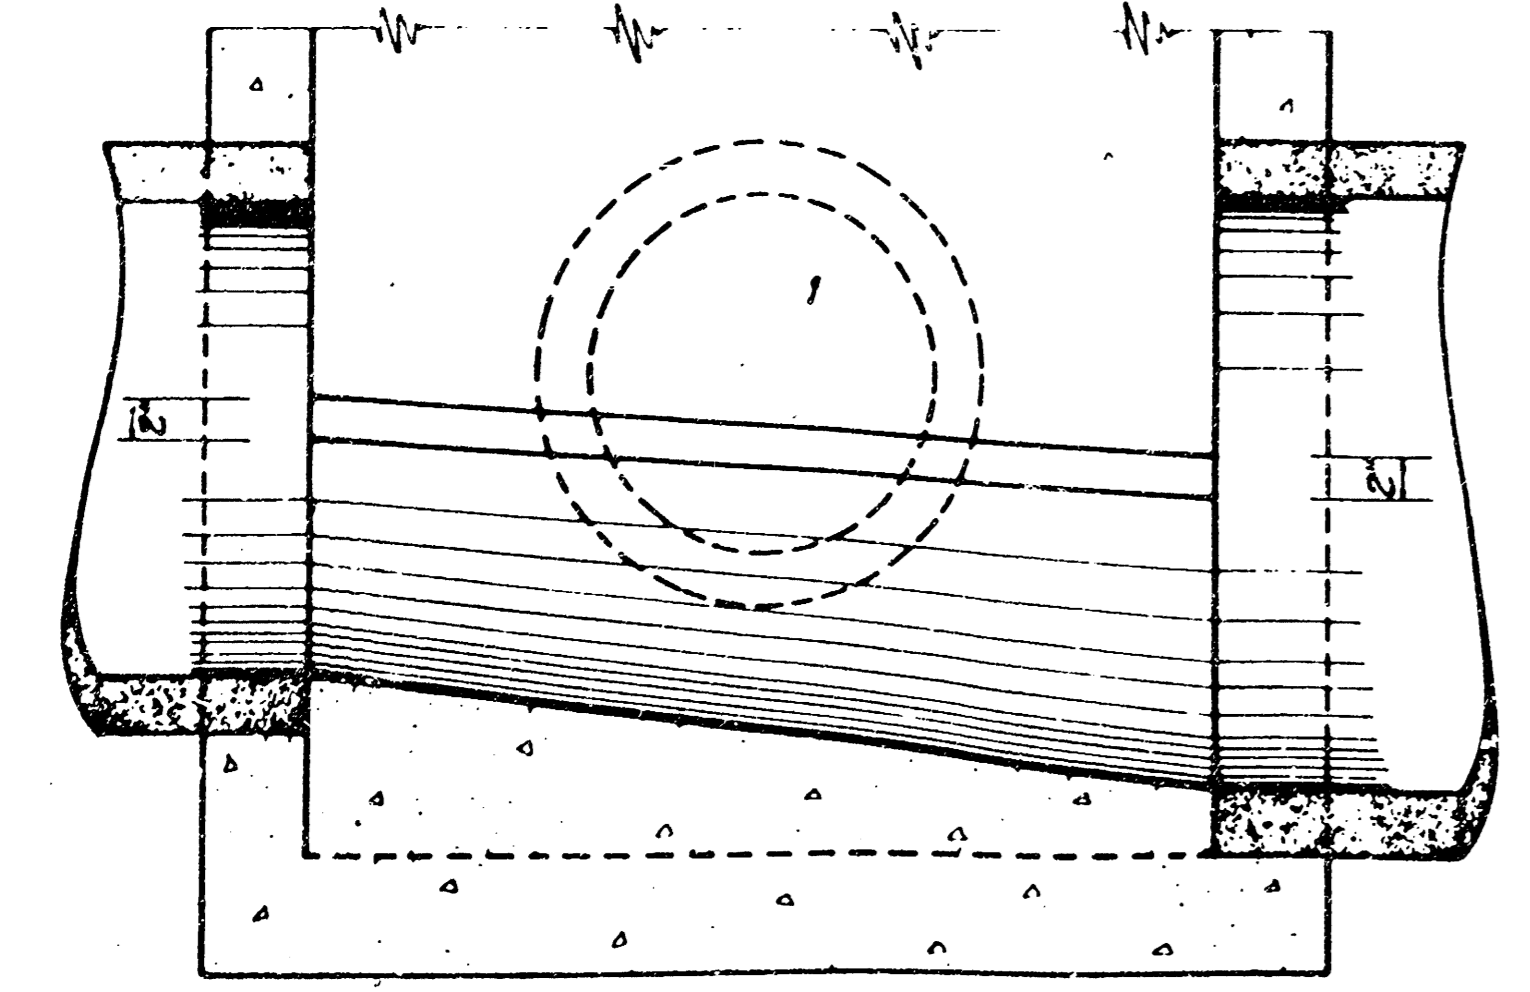


SECTION A-A (EXAMPLE IV)

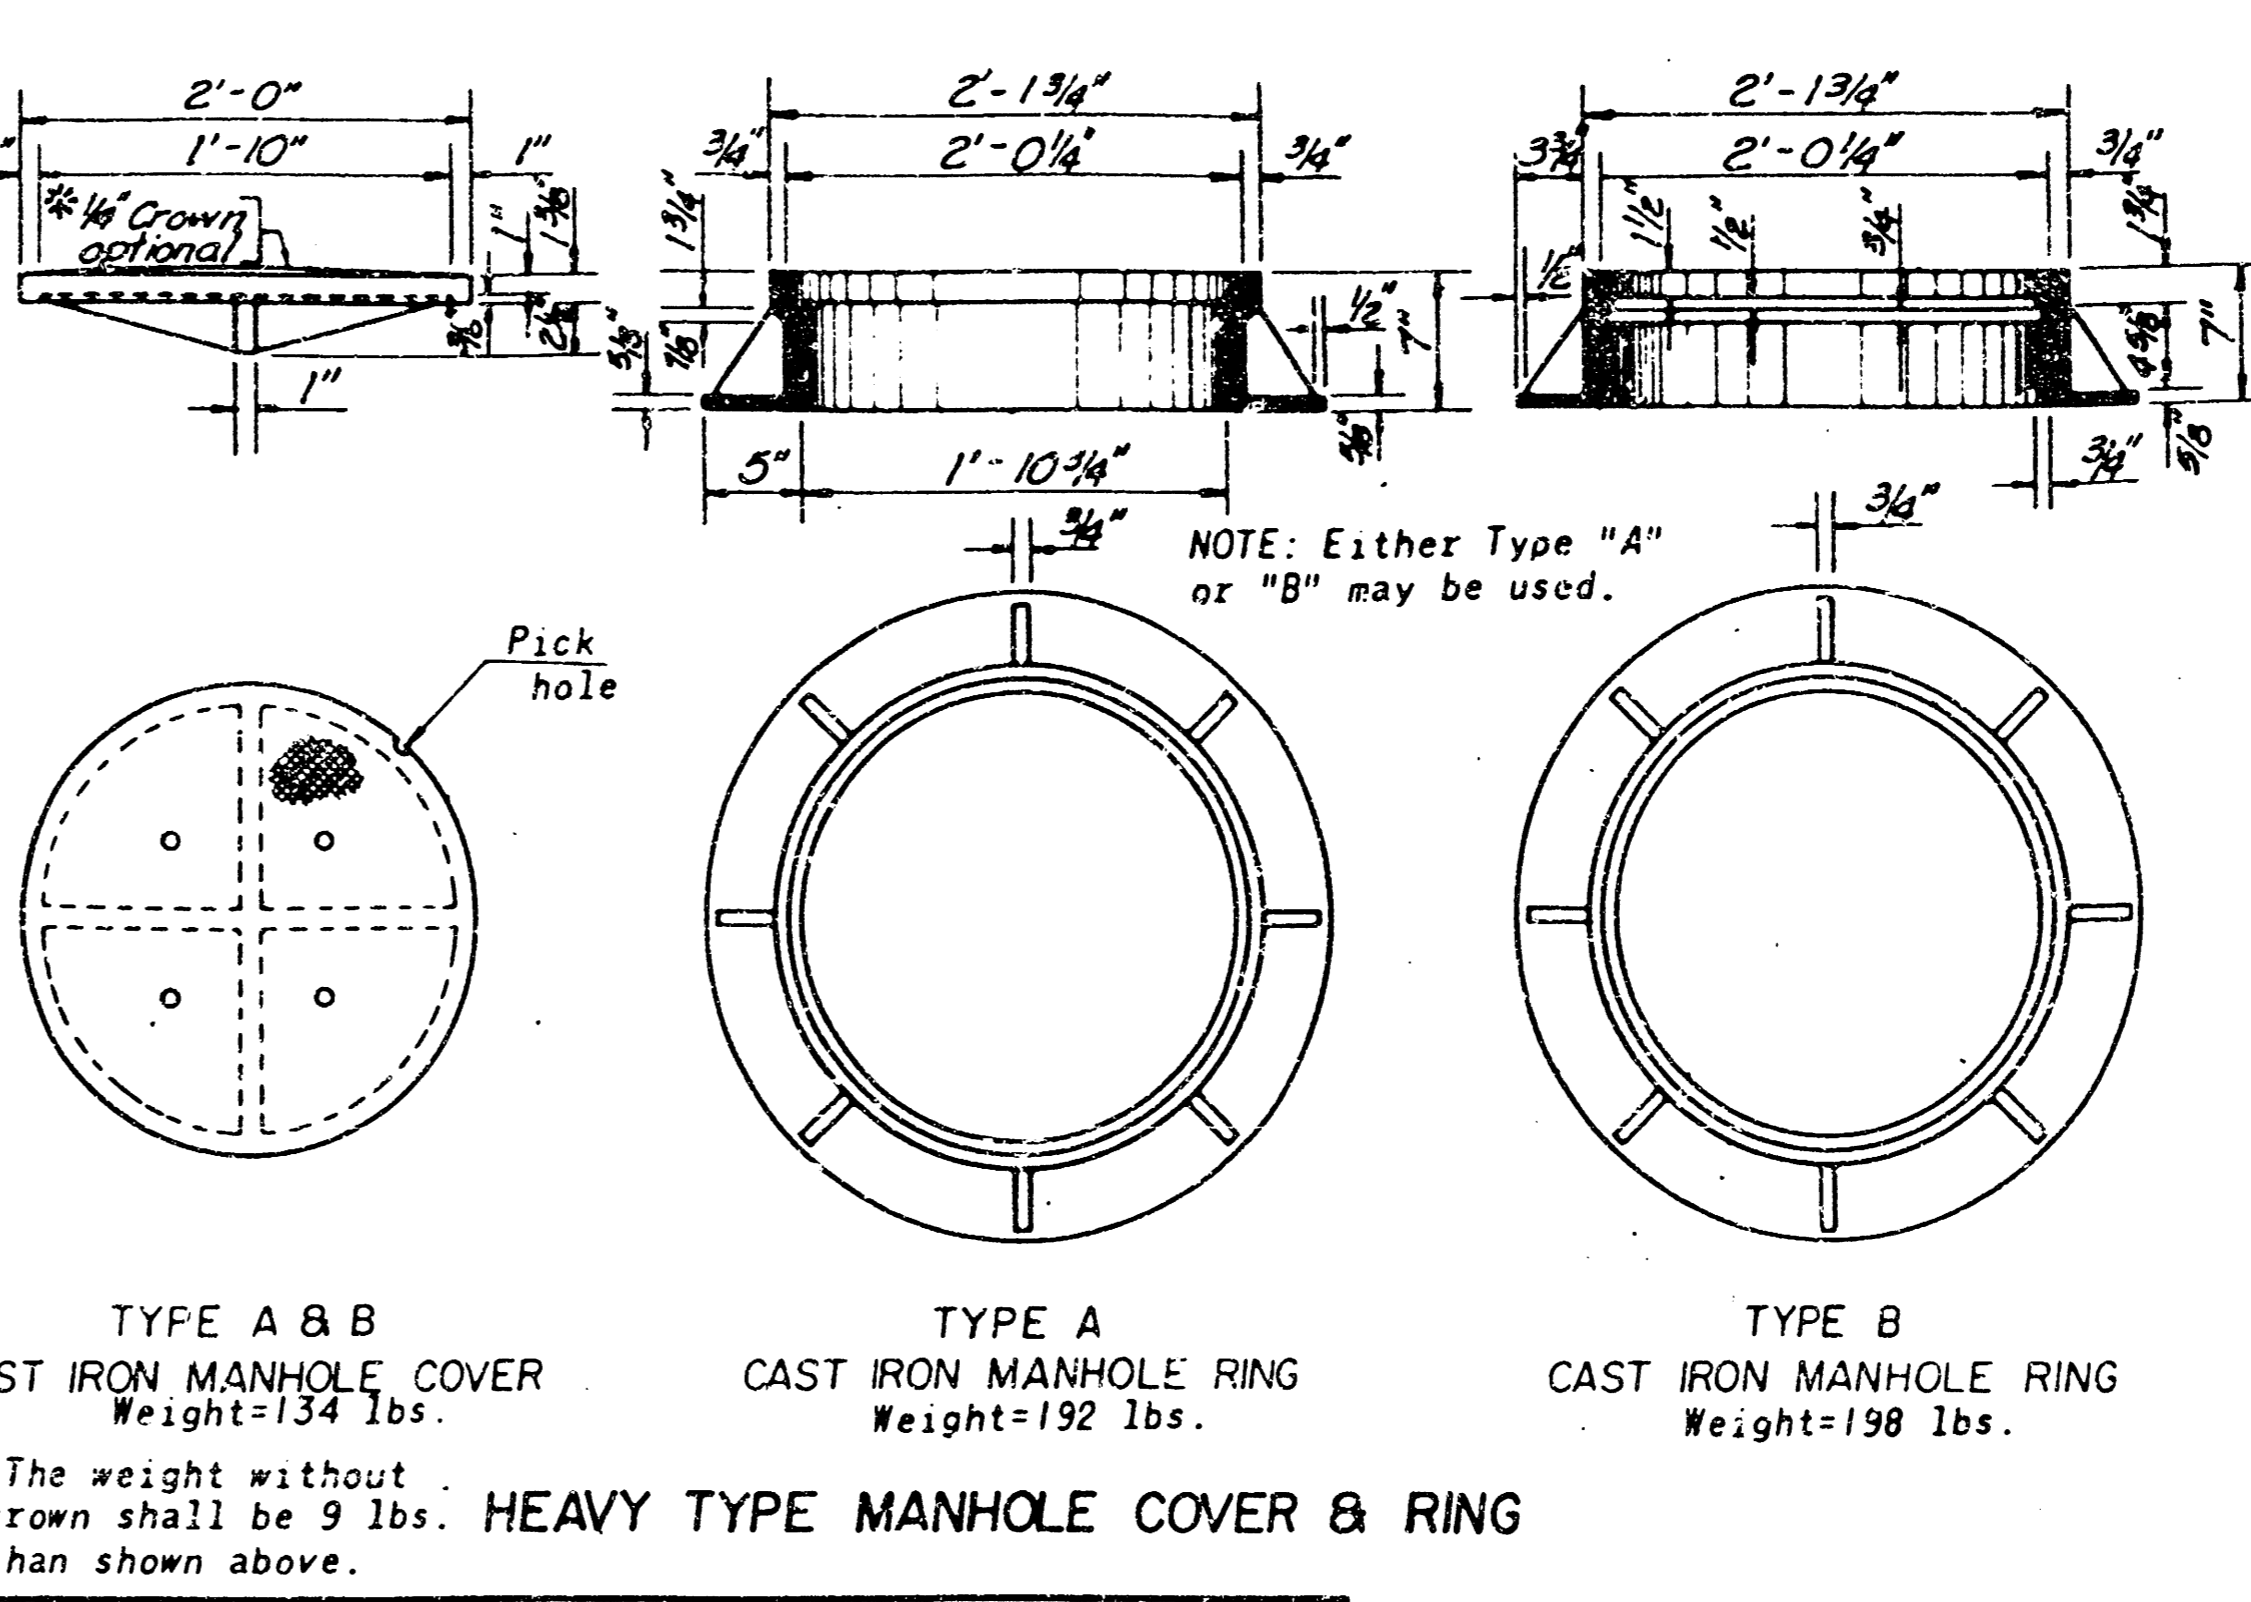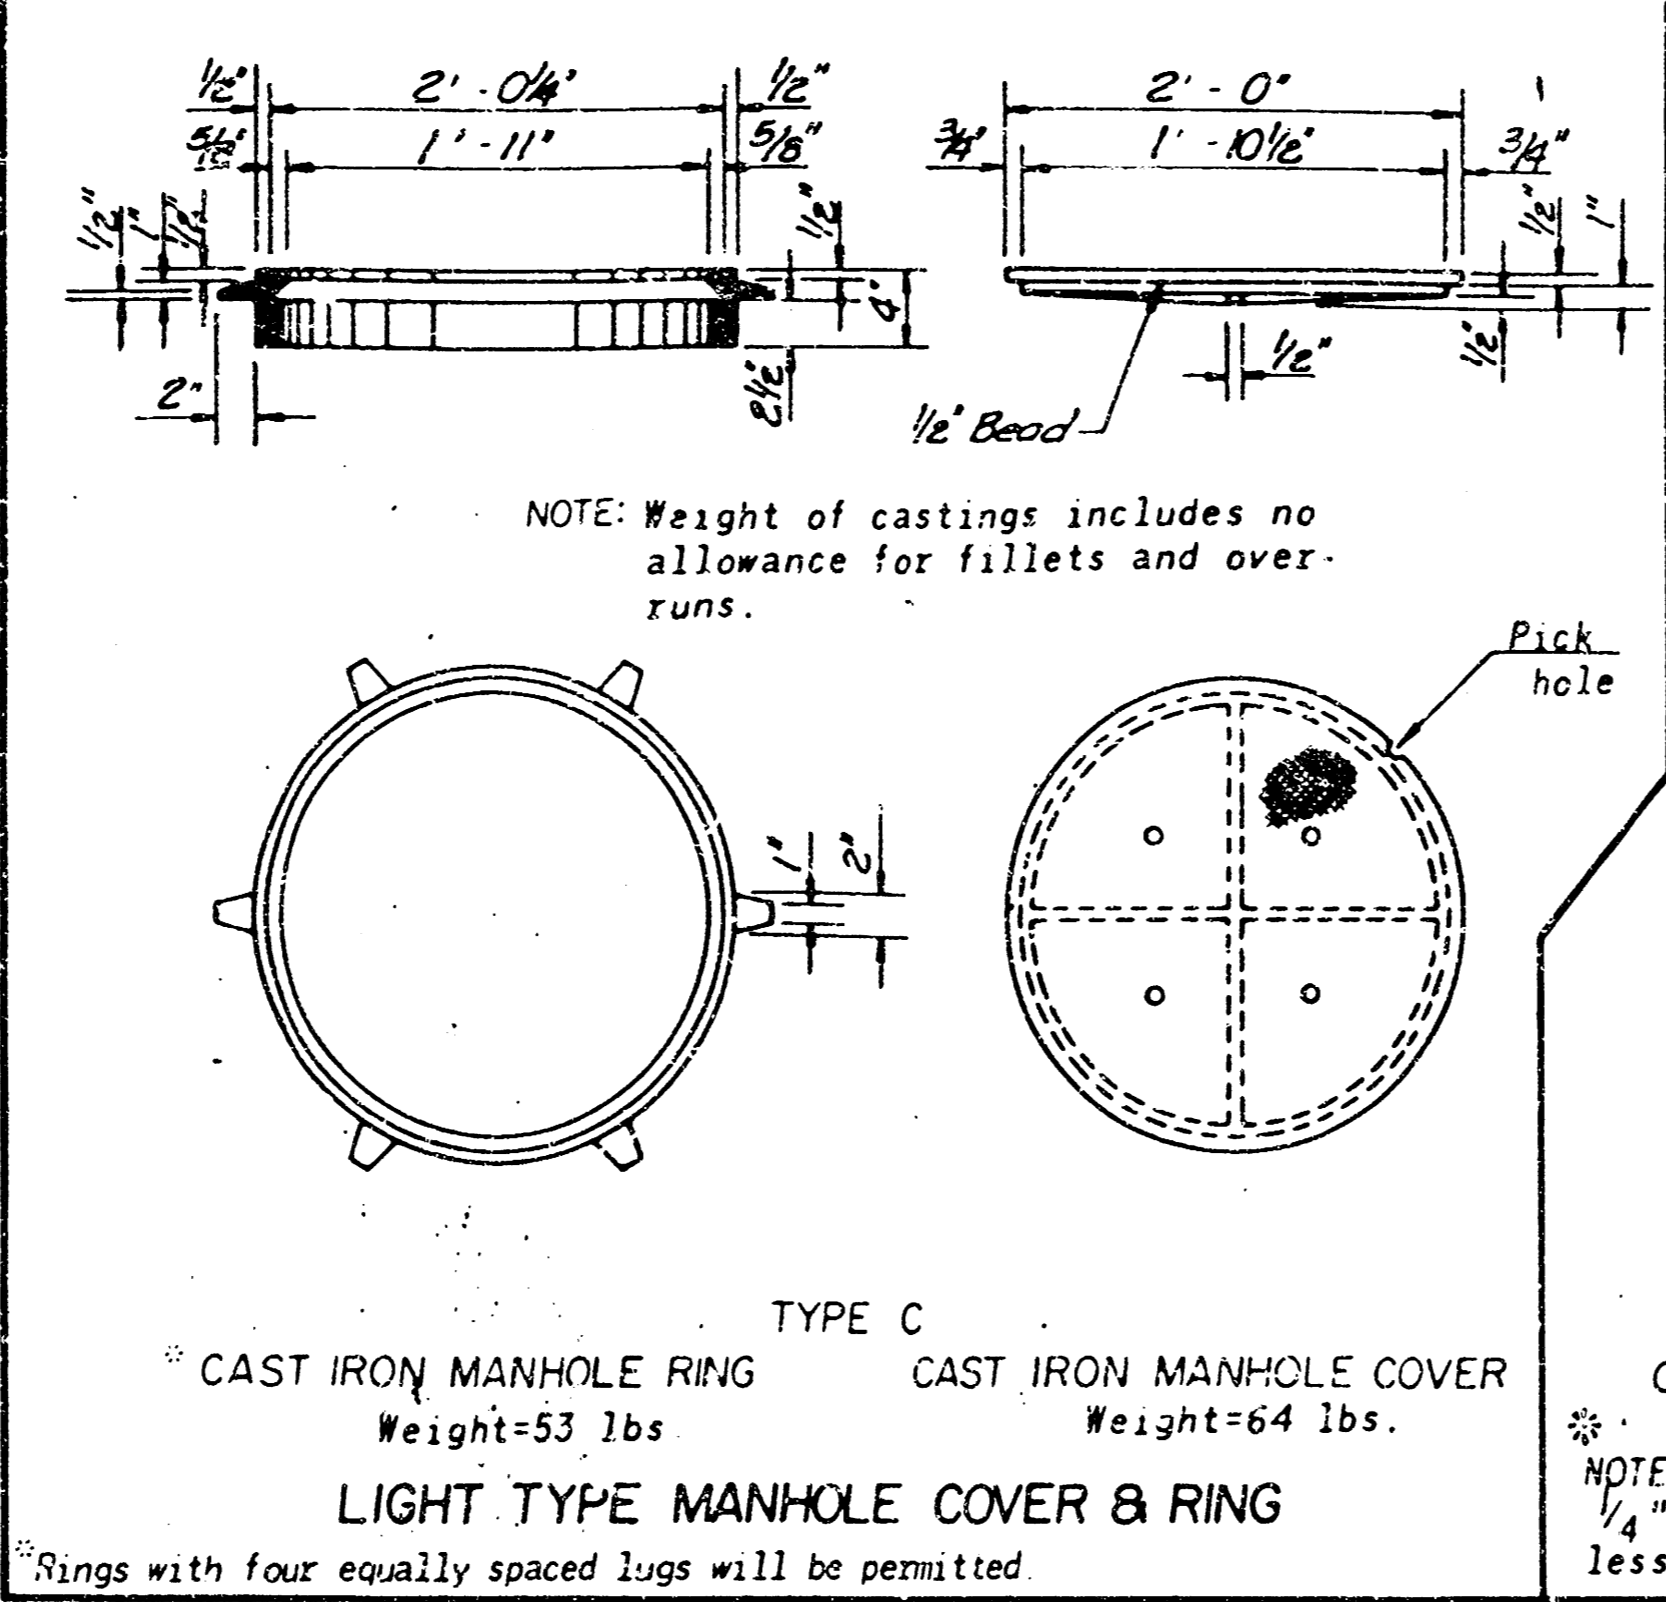


TYPICAL EXAMPLES OF VARIOUS PIPE COMBINATIONS
Showing method of shaping floor of manholes to provide increased hydraulic efficiency. For reinforcing & other features see "PLAN" and "SECTION"

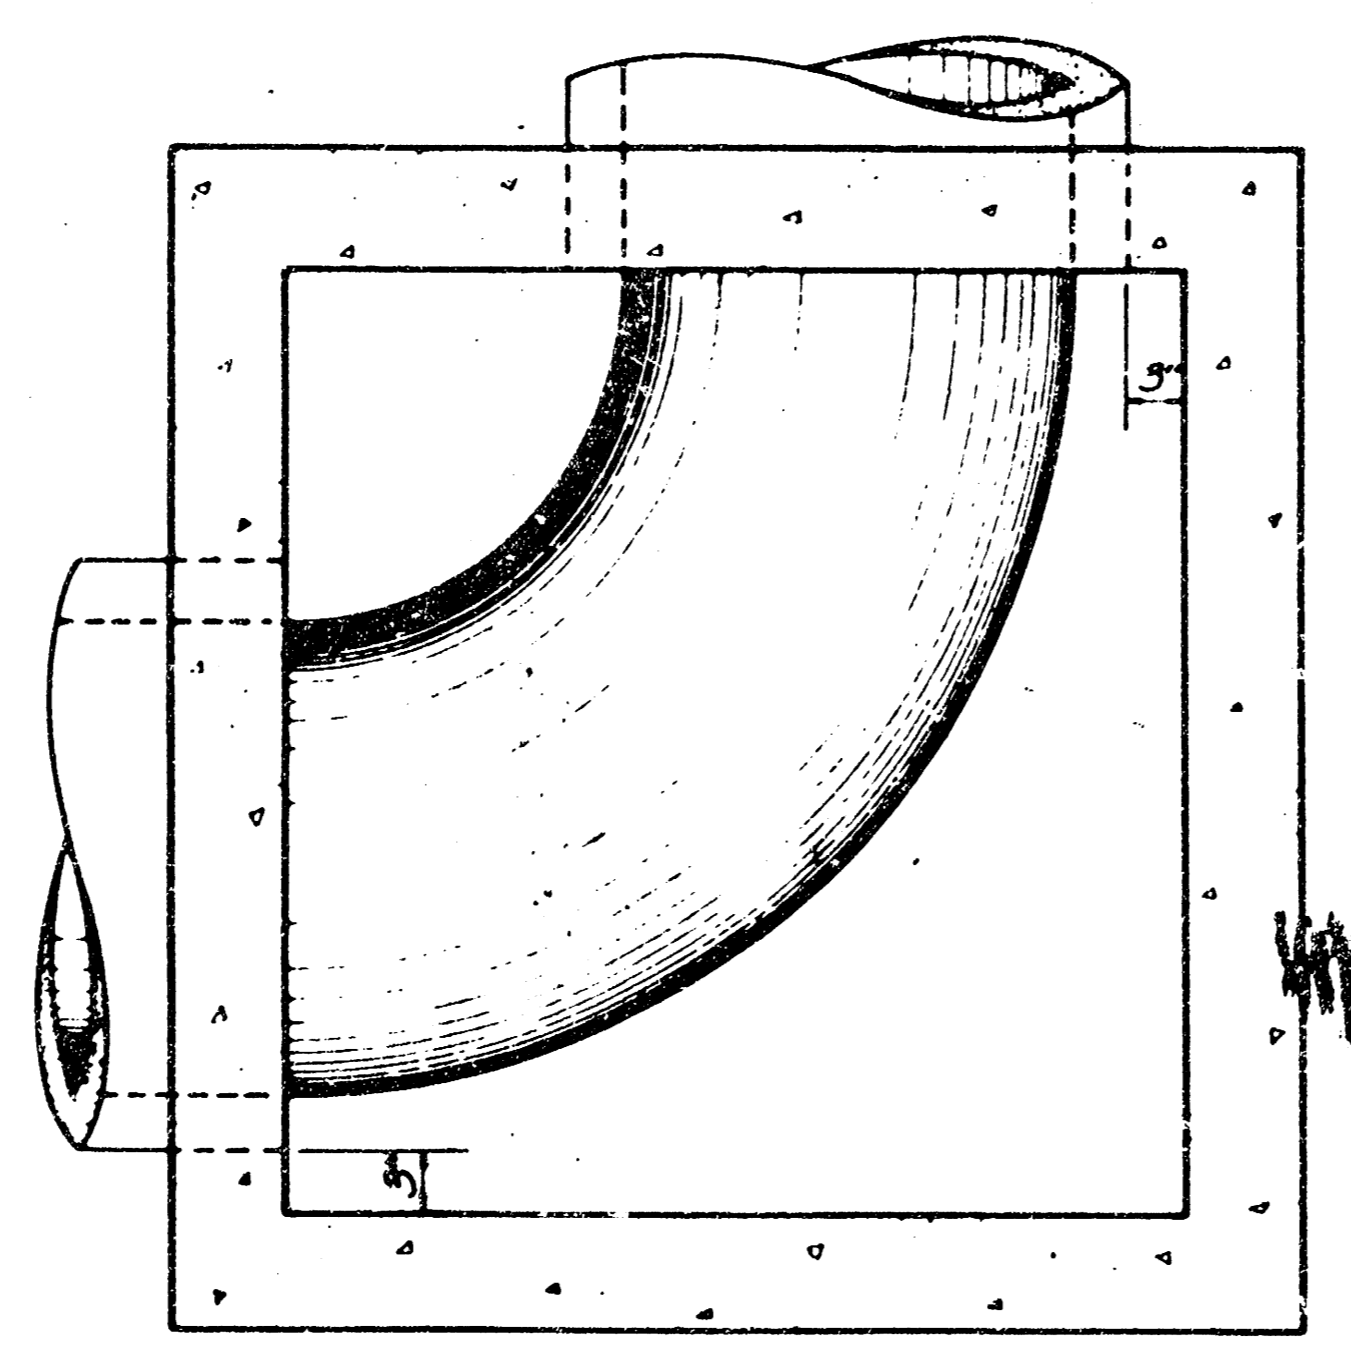


FLOOR PLAN (EXAMPLE II)

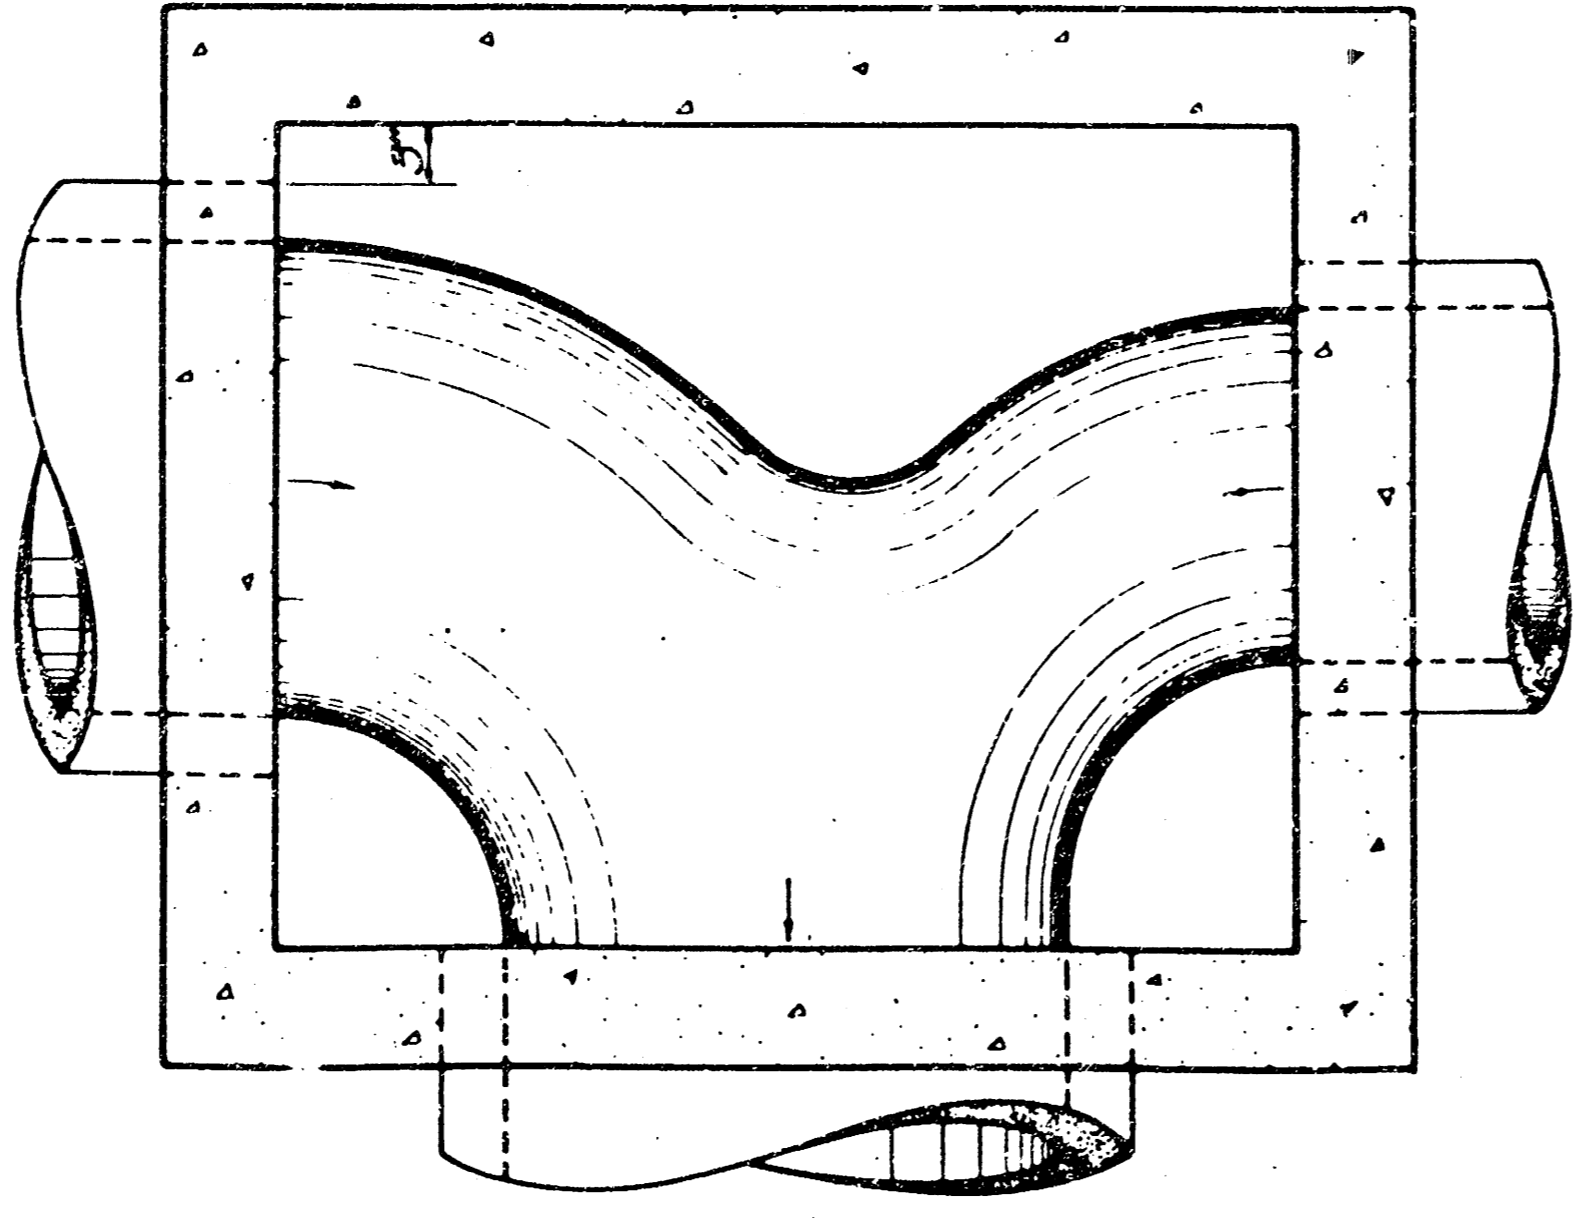


FLOOR PLAN (EXAMPLE III)

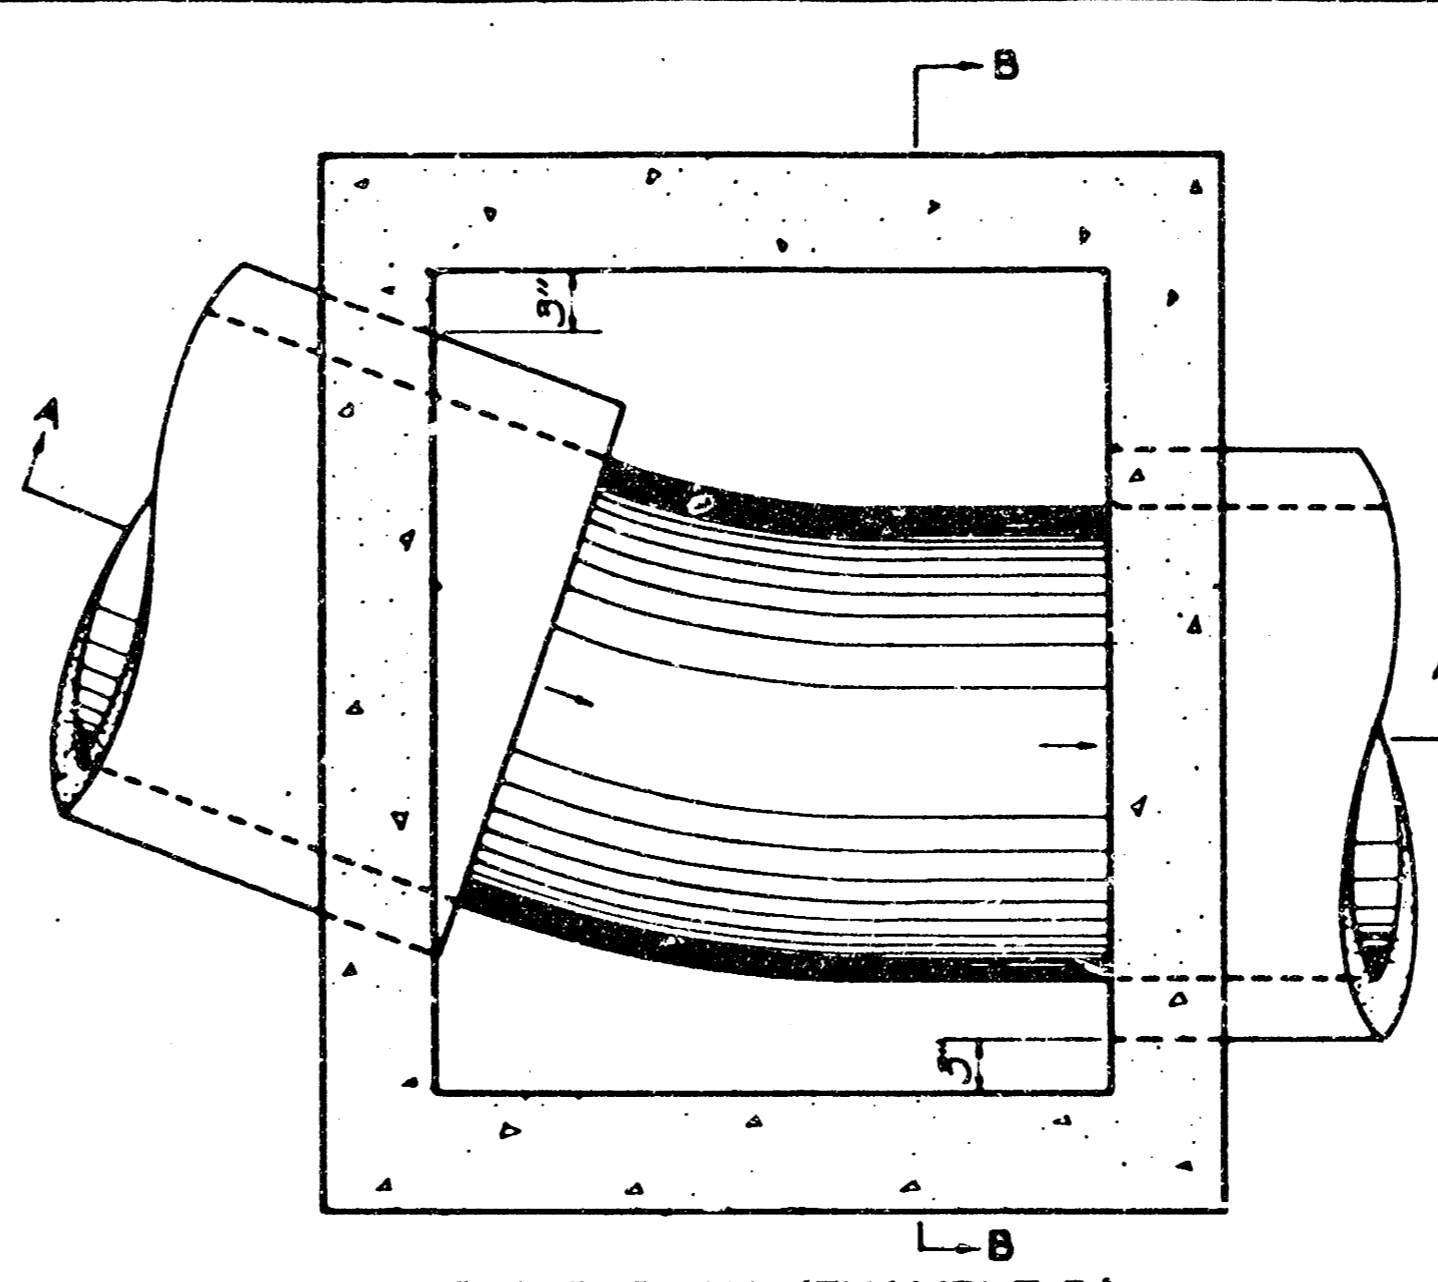

FLOOR PLAN (EXAMPLE I)

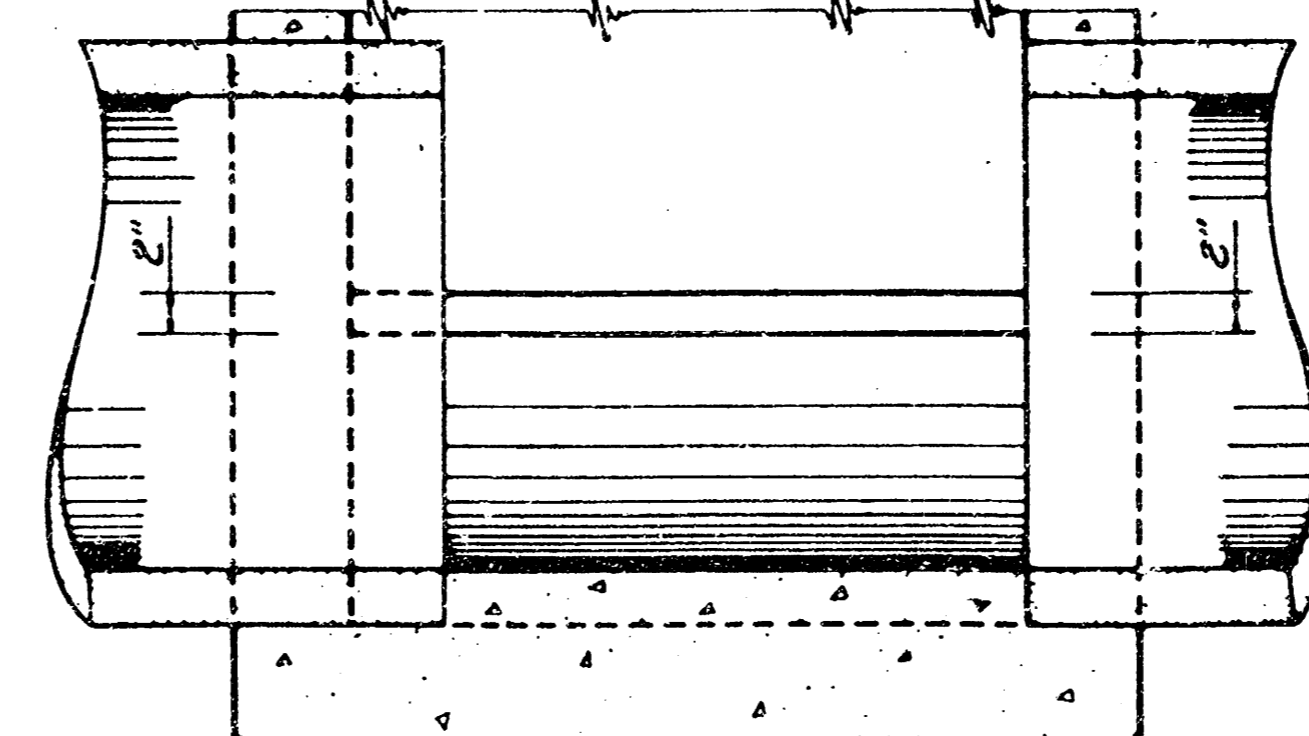


SECTION A-A (EXAMPLE I)

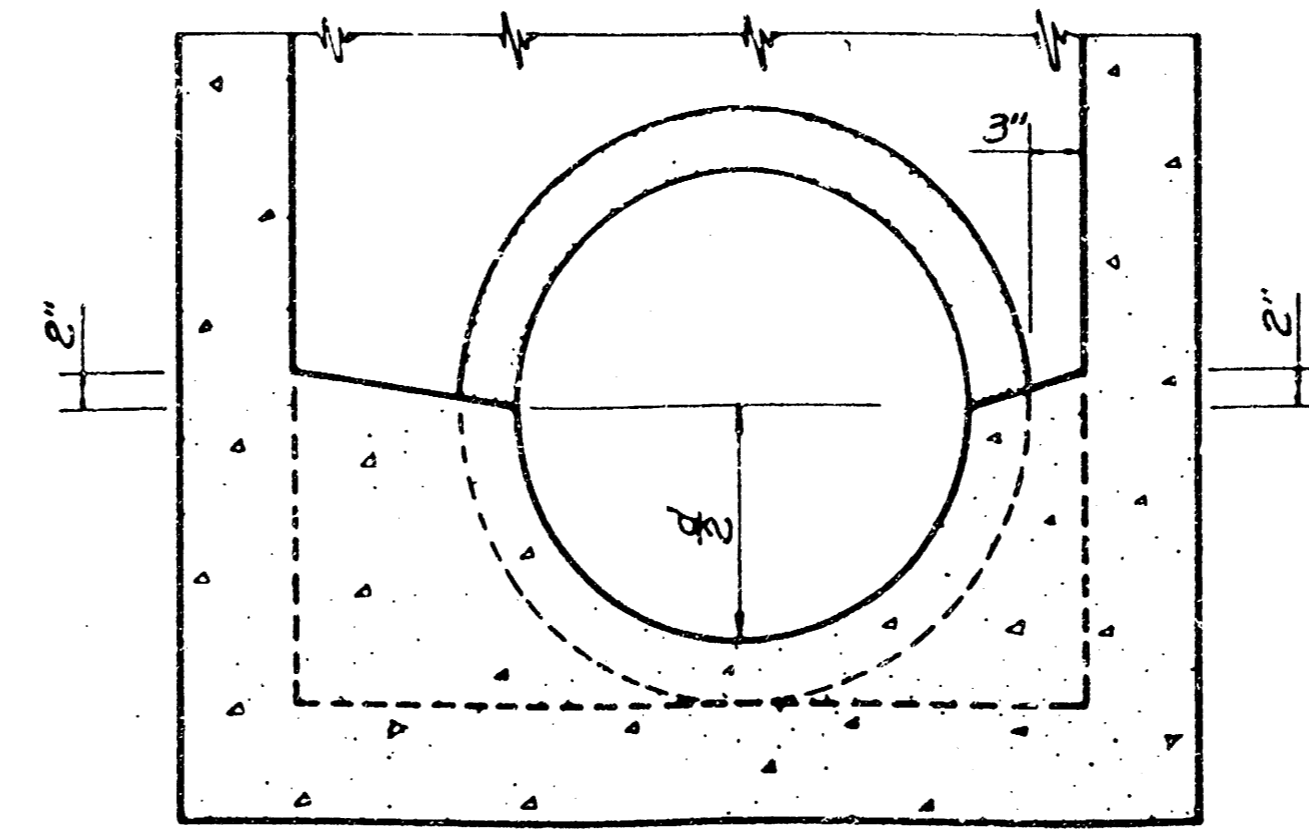



SECTION B-B (EXAMPLE I)

NOTE: Use class A Concrete throughout. All exposed edges shall be finished with an edging tool.
At the contractor's option, Class A Concrete (AE) or mix used in Conc. Pvt. may be used throughout.
In general, pipes will enter and leave the manhole at various positions. Where possible bend bars around pipes.
Floor of manhole to be shaped as shown in various "EXAMPLES" with unreinforced Class "A" concrete.
Manhole opening and steps, where used, shall be placed to afford easy access to top of shaped invert. Top reinforcing bars to be adjusted accordingly.
All castings shall be gray iron and shall comply with the Standard Specifications.
All exposed cast iron surfaces (rings & covers) not subjected to traffic, shall be painted either in the shop or in the field with one coat of a zinc dust paint, followed by two field coats of aluminum paint.
No deductions in concrete quantities shall be made for pipe openings.
No additions in concrete quantities shall be made for shaping floor of manholes.
When so ordered by the Engineer, the top of the manhole shall be sloped slightly to approximately fit the ground line or other conditions.
Dimensions and weights of cast iron as shown on this sheet are minimum. Larger dimensions and/or heavier weights of cast iron may be used.

NOTE: Contractor has the option of using precast manholes, as approved by the Engineer (See Special Provision). Payment of quantities shall be on a cast-in-place basis.

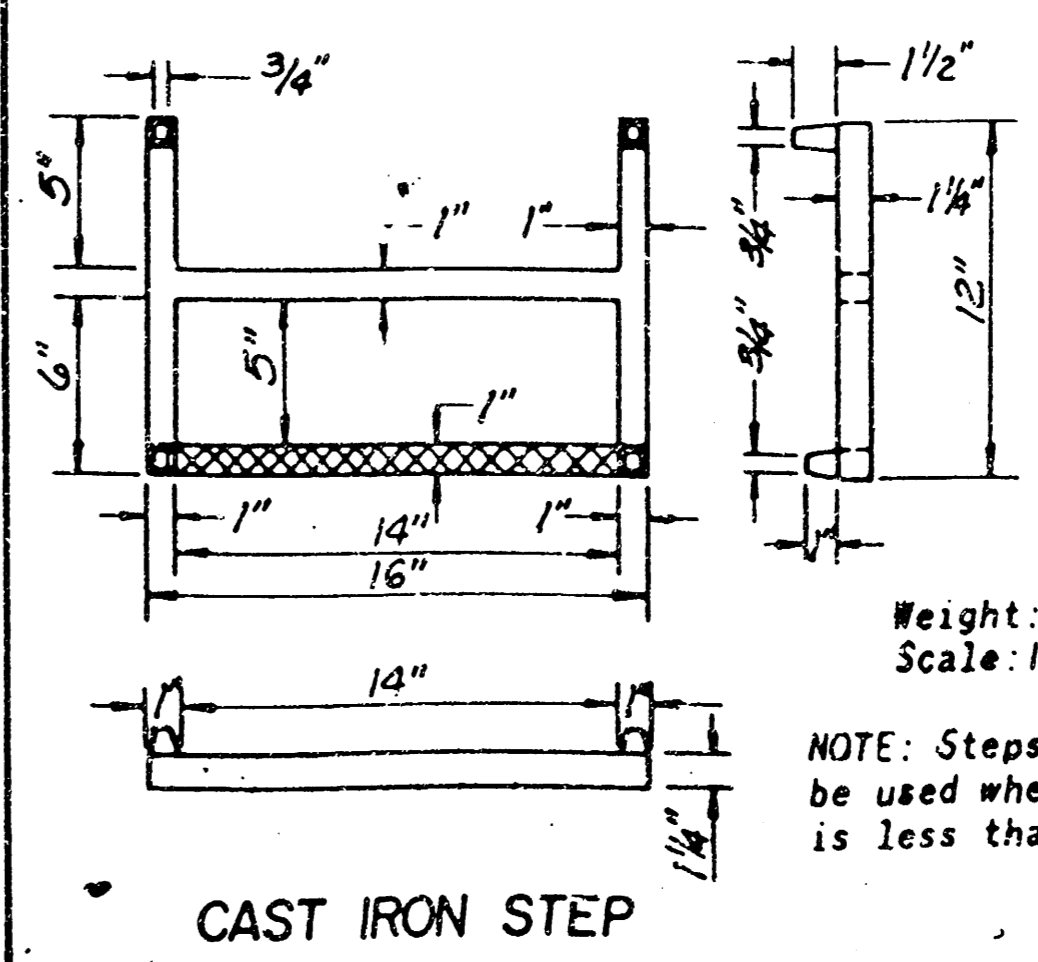

CAST IRON STEP

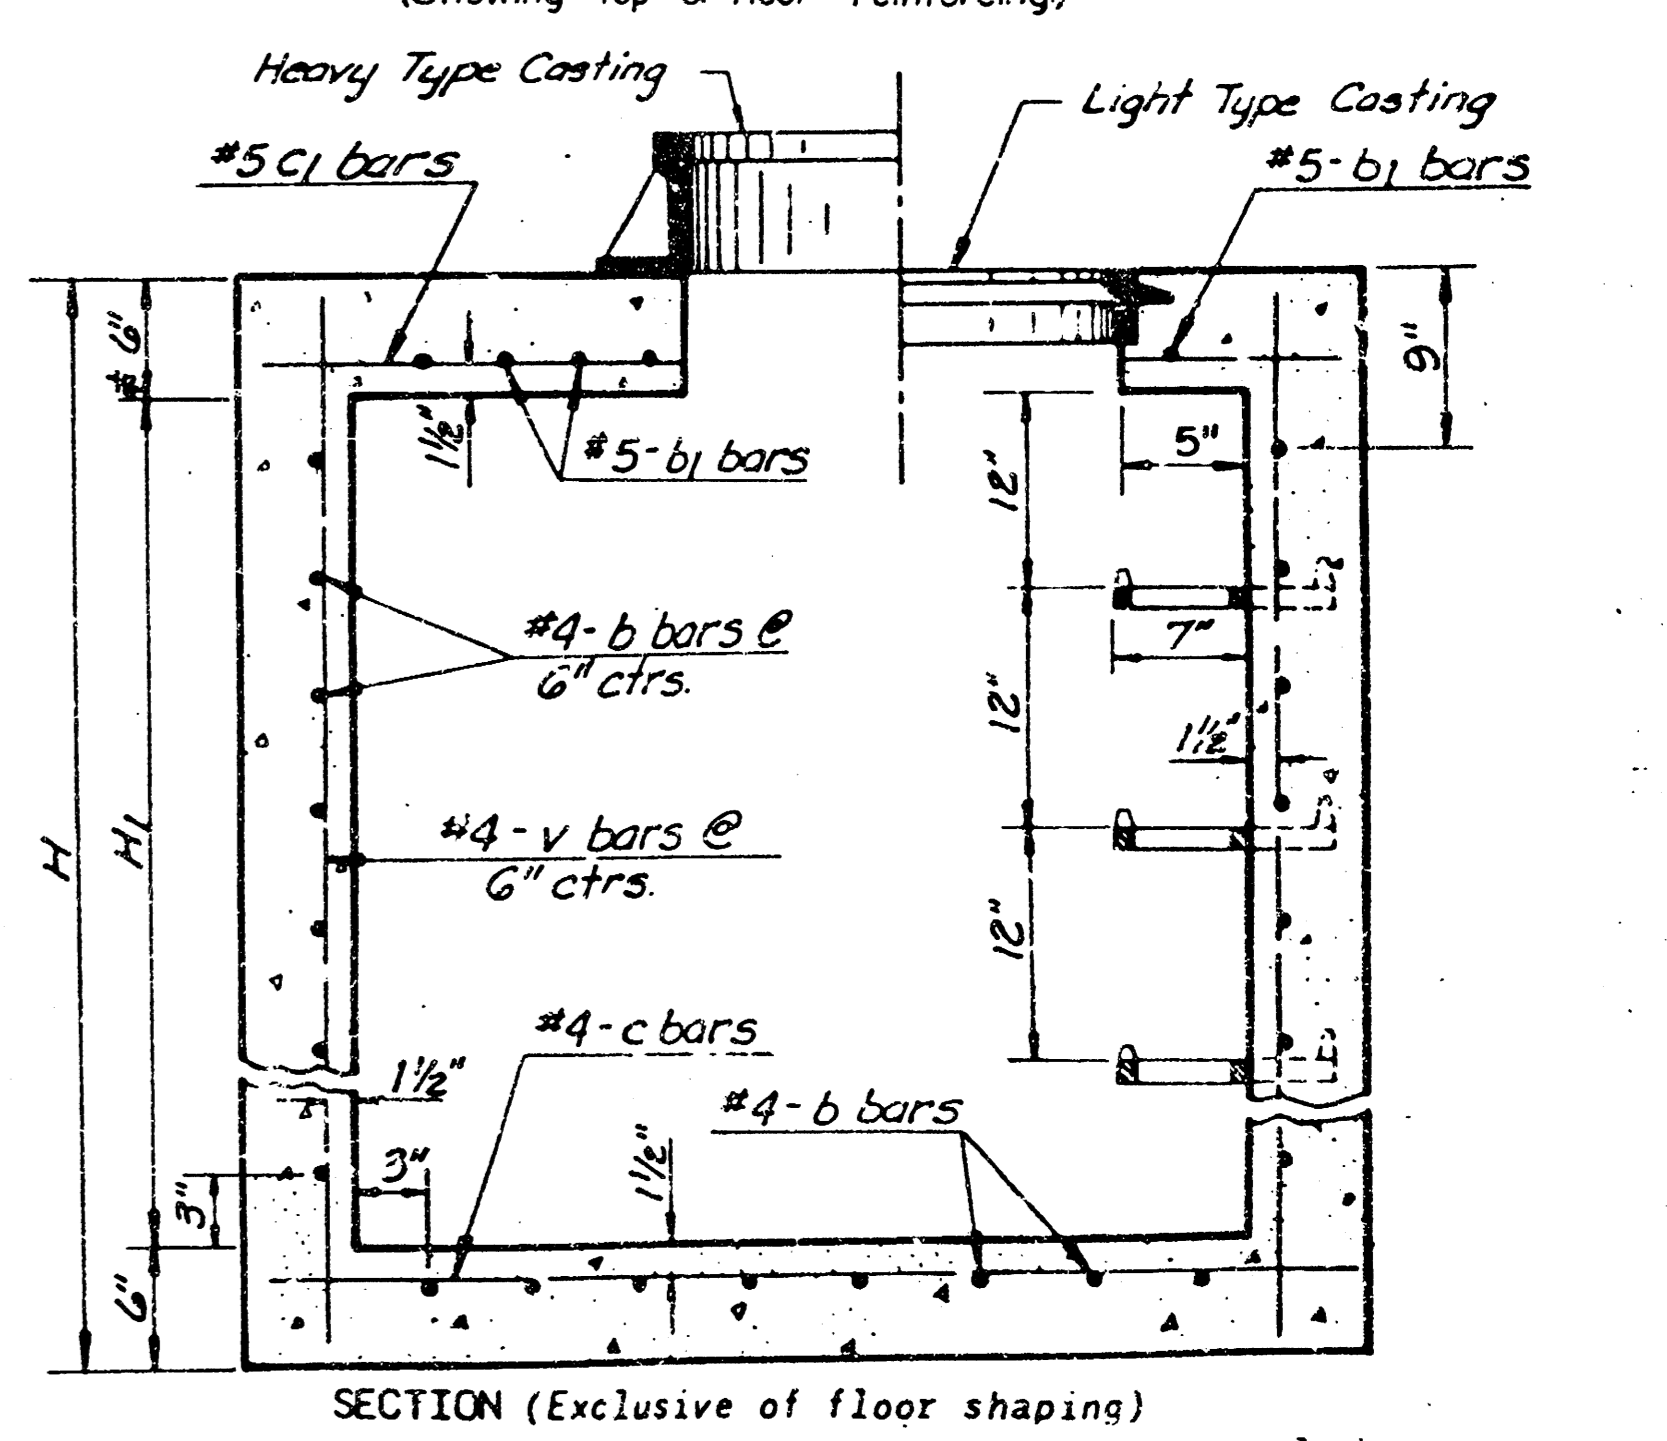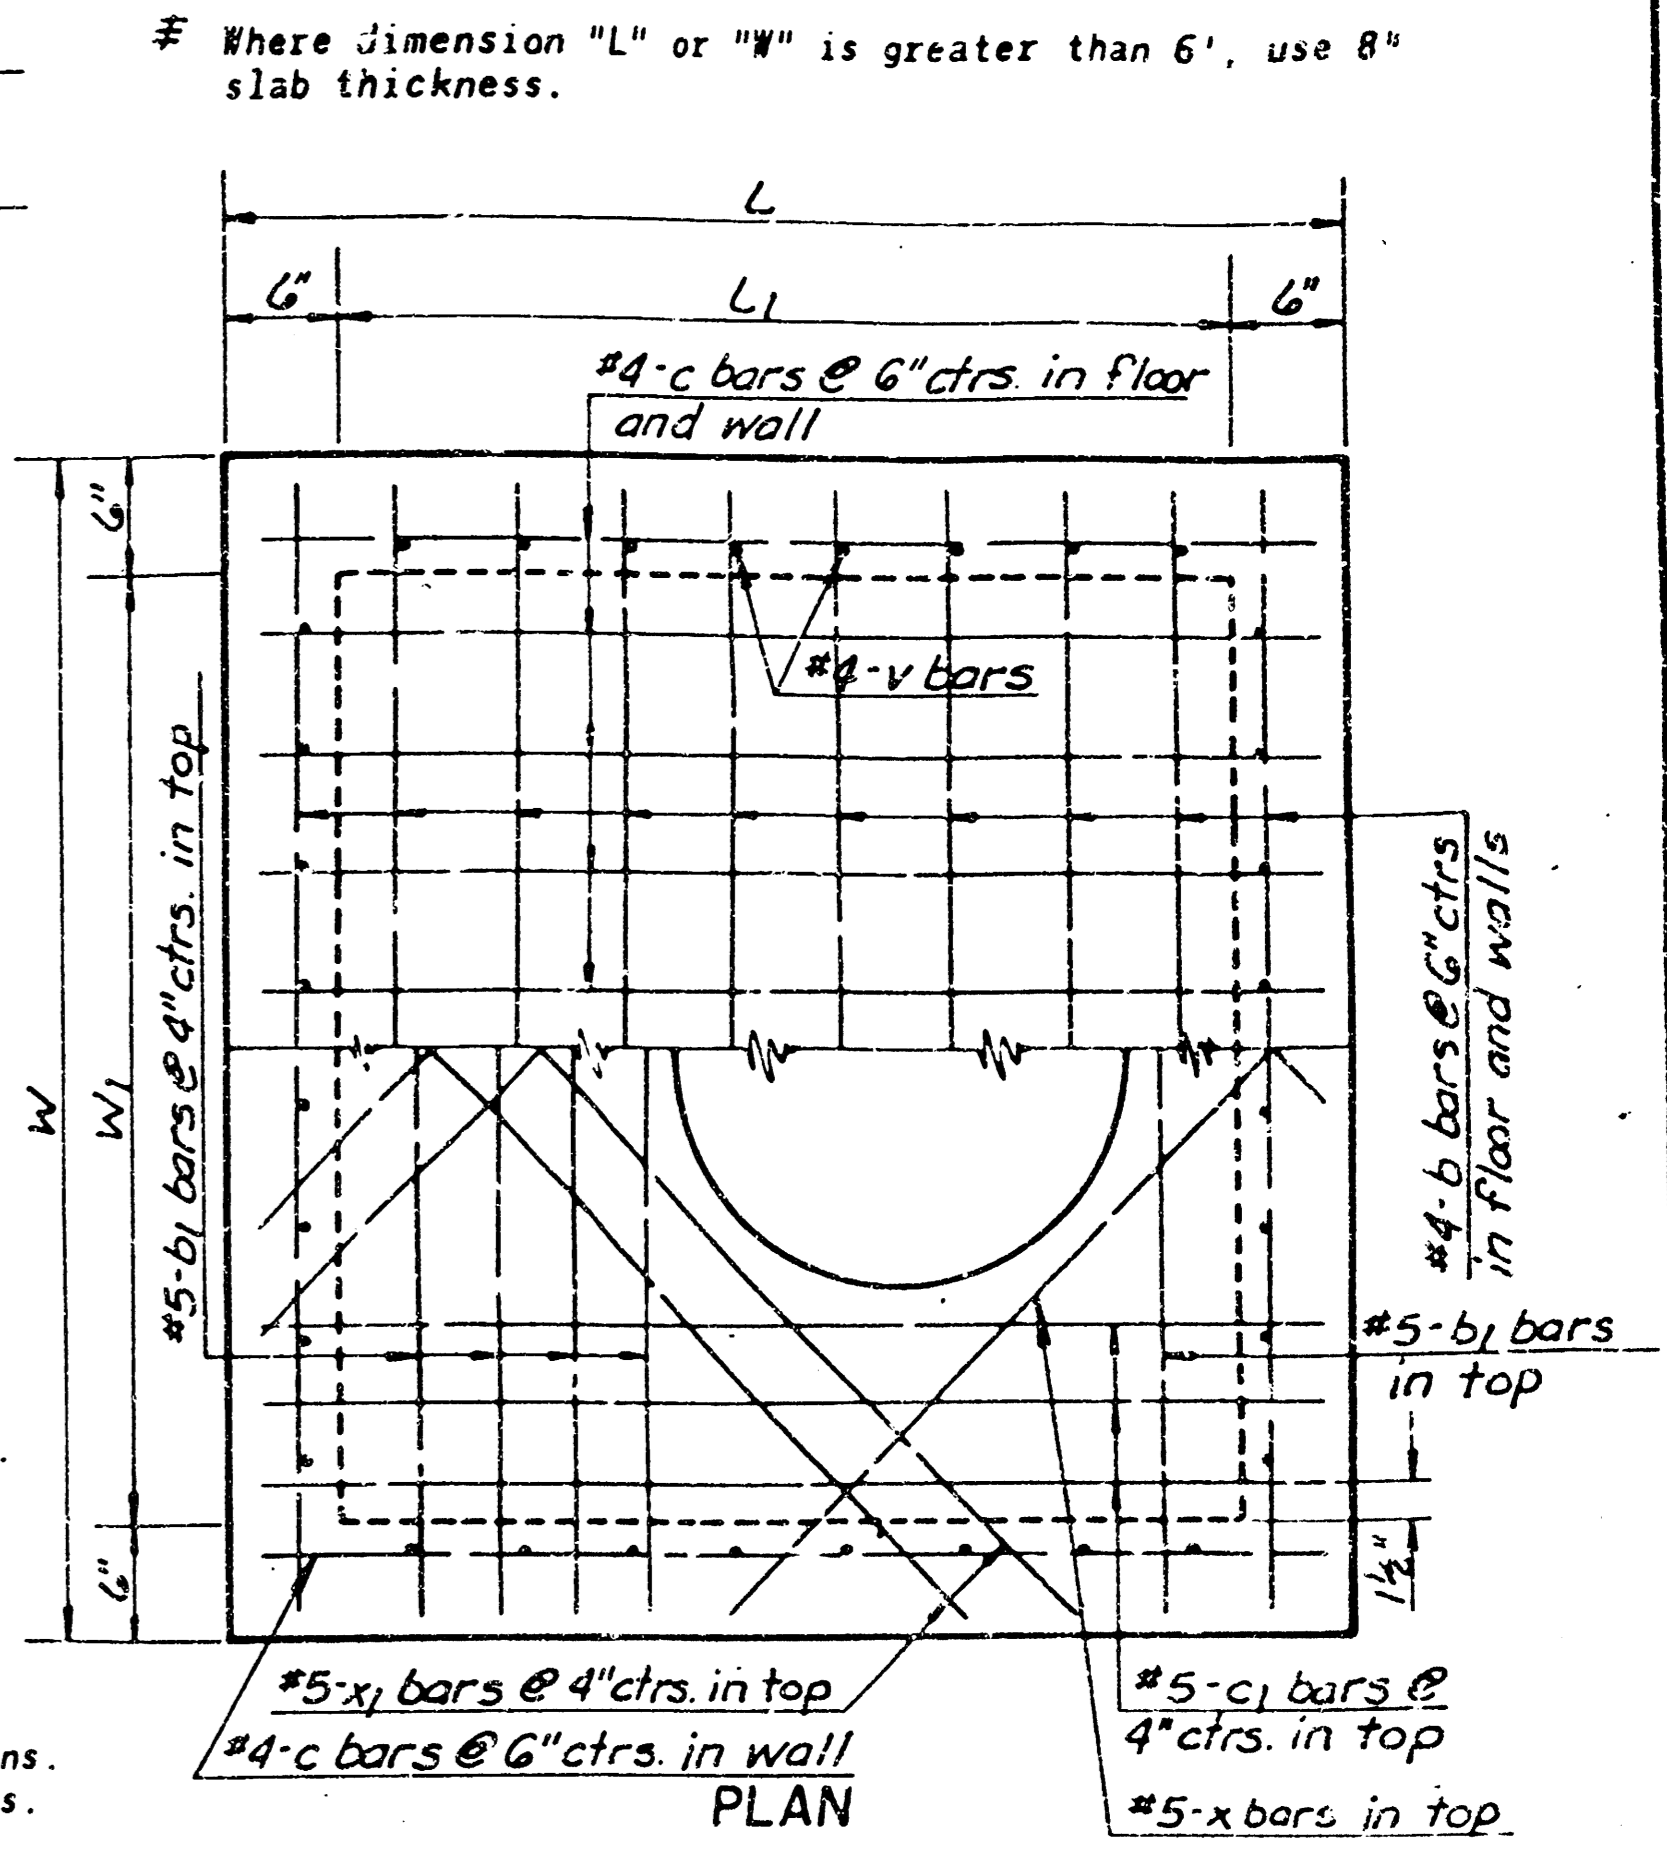

As an alternate to the cast iron step shown, either an aluminum or a plastic coated steel step complying with the same minimum clear opening dimensions may be used. The minimum length of rung shall be 14 inches and the minimum distance of rung from wall shall be 6 inches.
The solid aluminum extruded bar (1/2" minimum) shall comply with the Standard Specifications (ASTM B 221 Alloy 6005-T5).
The plastic coated step shall be made from a No. 3 steel reinforcing bar encapsulated in plastic to provide a minimum cross section of 1 inch by 1 inch and shall comply with the special provision. The rung shall be designed so the foot cannot slide off the end.

26	9-28-82	Rev step from 16" to 14" clear opening	NLR	L.R.P.
25	8-14-80	Revised to Standard Specs	W.L.H.	L.R.P.
24	4-2-80	Labeled bars same as steel table	W.L.H.	L.R.P.
NO.	DATE	REVISIONS	BY	APP'D
KANSAS DEPARTMENT OF TRANSPORTATION				
REINFORCED CONCRETE MANHOLE				
STD. NO. 633 4-5-44				
SHEET NO.	OF	SCALE 1" = 1'	APP'D	L.H.L./concrete
DESIGNED	BY	DETAILS	WAB	TRACED
DESIGN OK	BY	DETAIL OK	WAB	TRACE OK

Master