

CITY OF WICHITA, KANSAS



STORM SEWER IMPROVEMENTS

TO SERVE LOT 1, BLOCK 1, KUMC ADDITION TO WICHITA, KANSAS

PRIVATE PROJECT NO.: 536PPS (607661)

INDEX

SHEET 1 TITLE SHEET
 SHEET 2 PLAN PROFILE SHEET
 SHEET 3 DROP INLET DETAIL

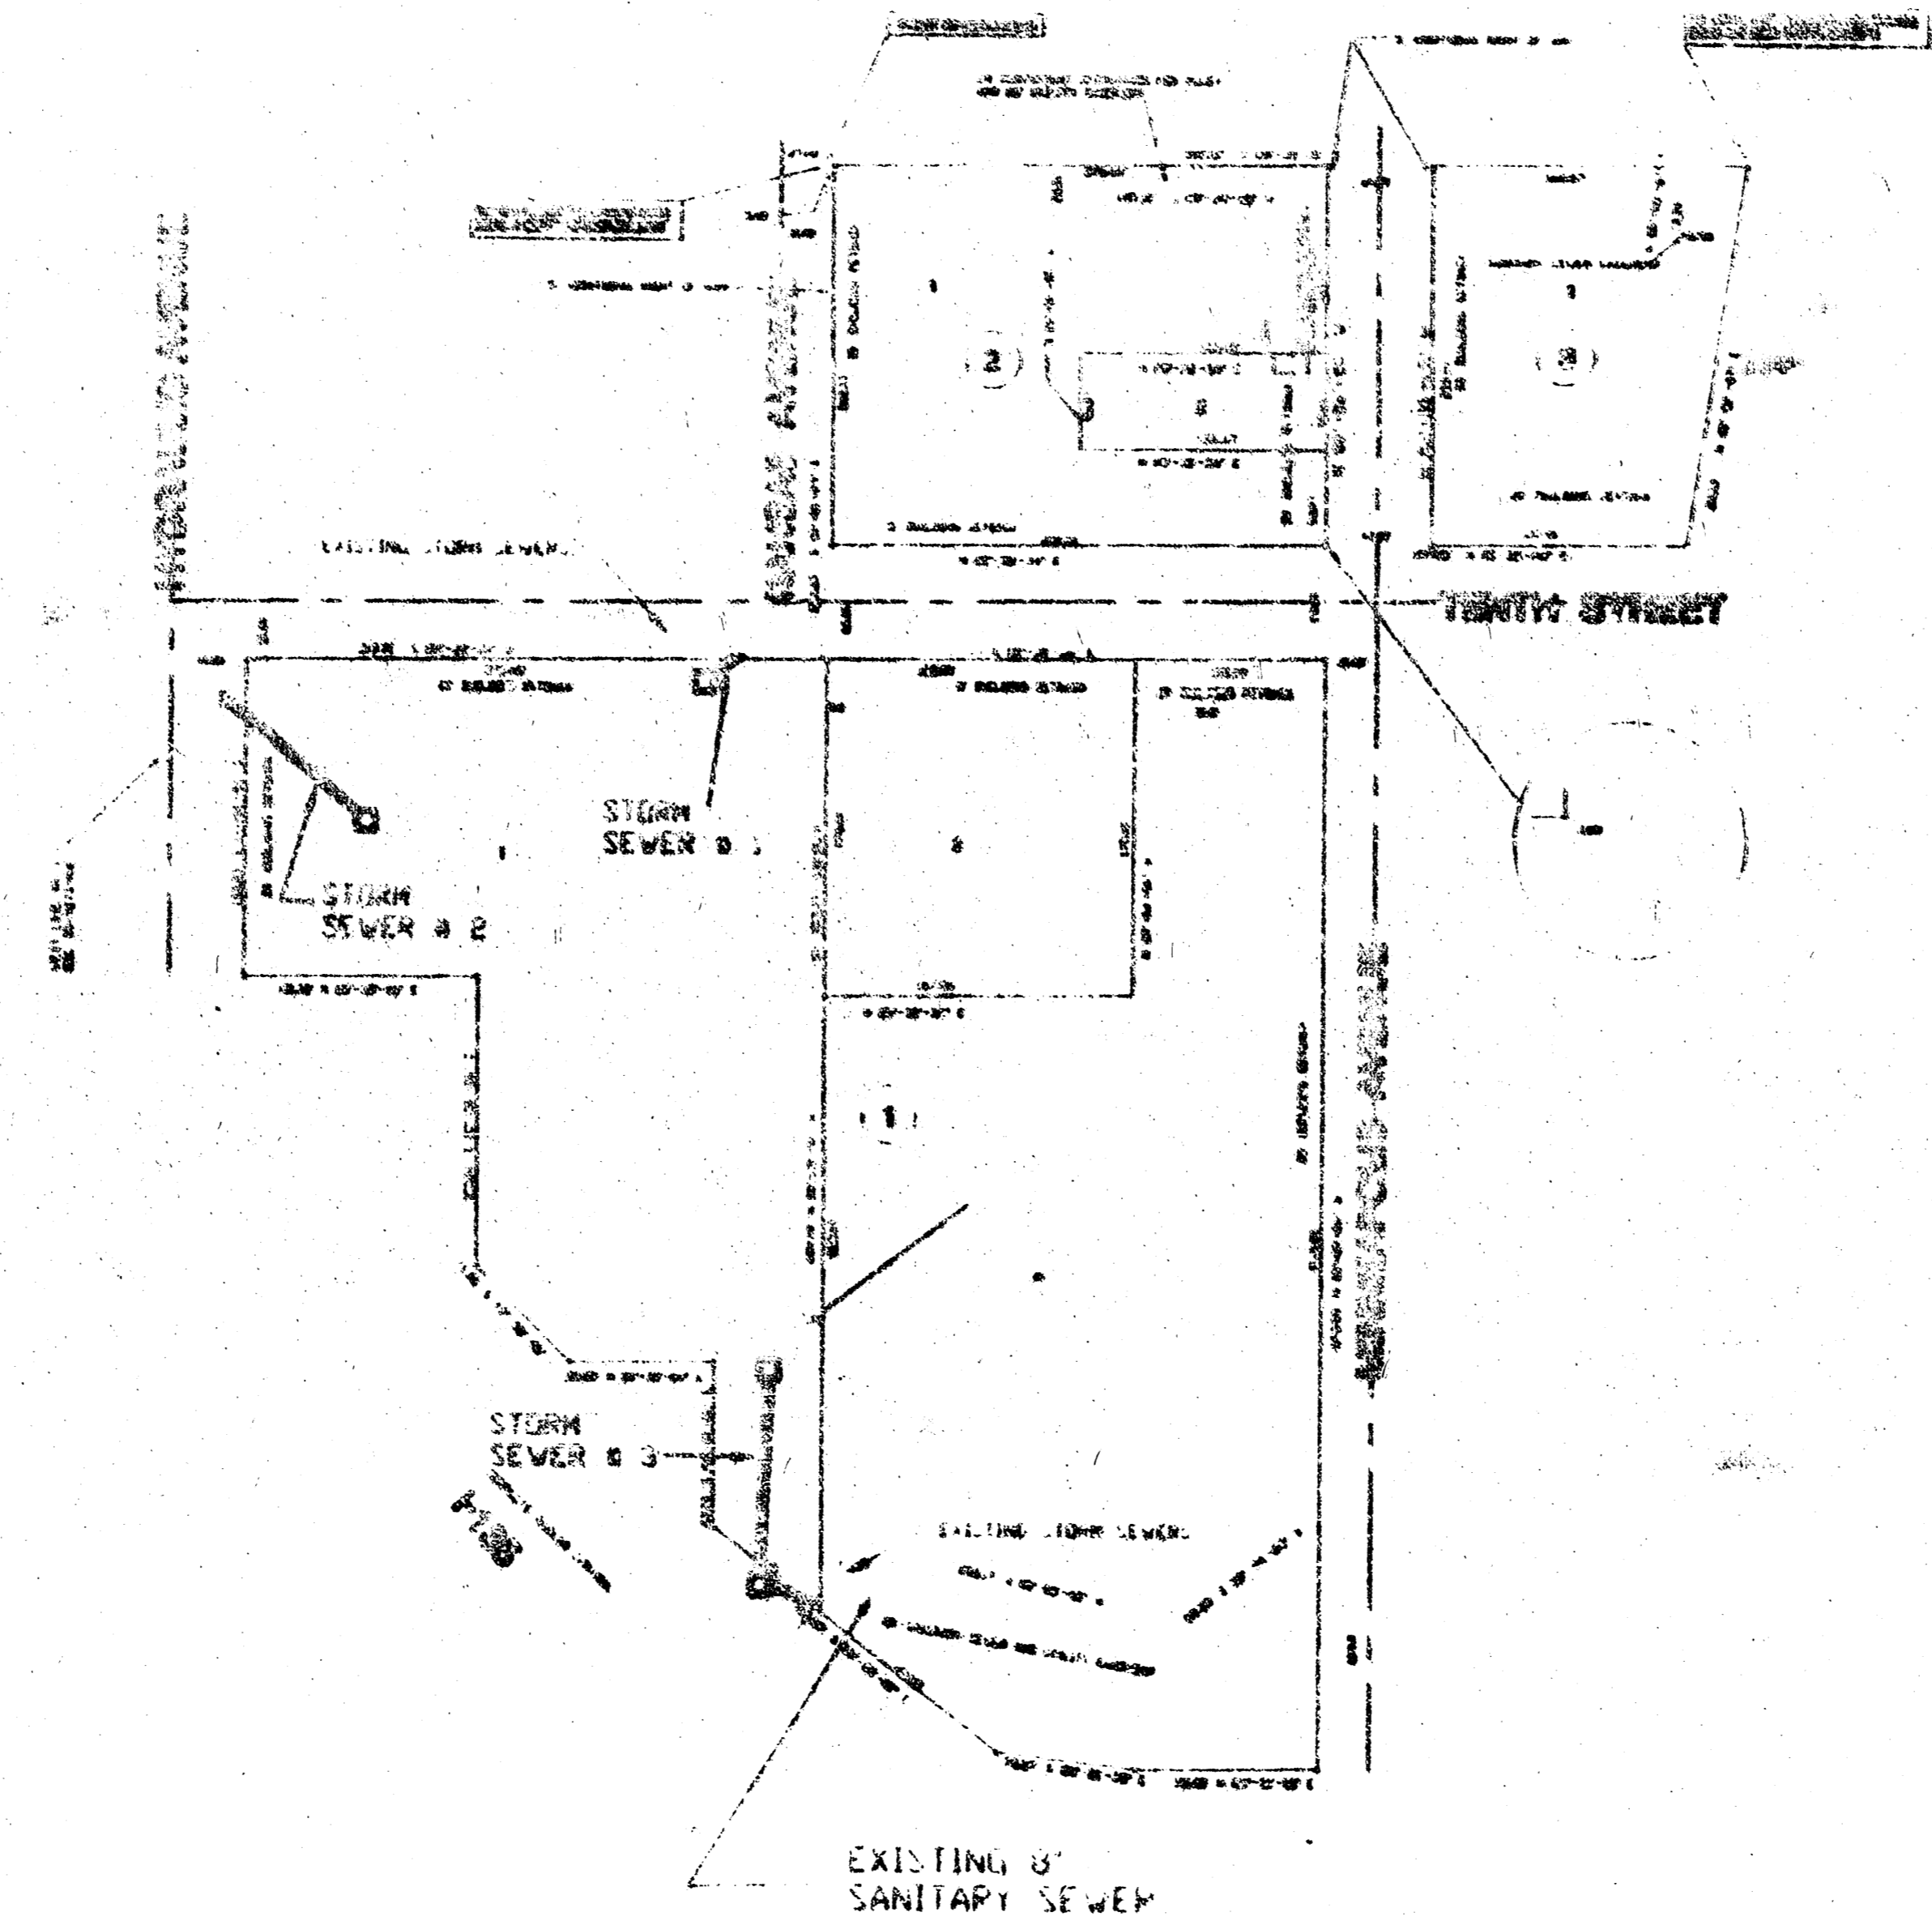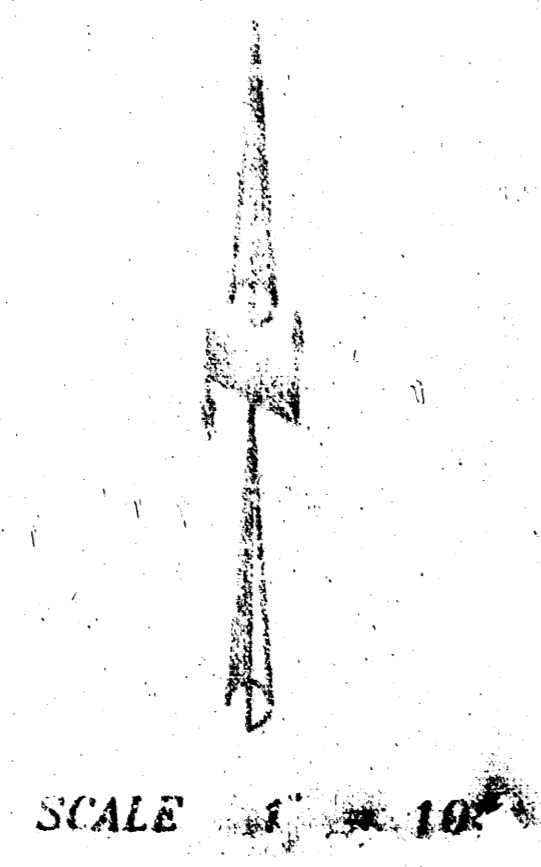

AS BUILT PLANS
 S.E. ANDERSON, P.E.
 DUBOISE, 1945

S.E. Anderson
 January 12, 1995

BOOKED
 7-18-97
 MCO
 8-35

NOTE TO CONTRACTOR:
 INSPECTION AND TESTING FOR THIS PROJECT IS TO BE PROVIDED BY A LICENSED CONSULTING ENGINEERING FIRM UNDER CONTRACT WITH THE OWNER/DEVELOPER. SAID INSPECTION TO BE IN ACCORDANCE WITH THE CITY OF WICHITA STANDARD ENGINEERING PRACTICES AND CERTIFIED BY A LICENSED PROFESSIONAL ENGINEER. NO WORK SHALL BE PERFORMED IN DEDICATED EASEMENTS OR PUBLIC RIGHT-OF-WAY BY THE CONTRACTOR WITHOUT SUCH INSPECTION NOR SHALL ANY WORK BE COVERED IN DEDICATED EASEMENTS OR PUBLIC RIGHT-OF-WAY WITHOUT WRITTEN AUTHORIZATION BY THE CITY ENGINEER.

APPROVED AS NOTED
 BY CITY ENGINEER OF WICHITA

SANITARY SEWER
 STORM SEWER *U.R.H. 3/17/95*
 DRIVEWAY APPROACH
 WATER MAINS
 PAVING



LOCATION MAP



MICHAEL E. LINDEBAK, P.E., CITY ENGINEER

TITLE SHEET			
SCALE	APPROVED	DRAWN BY: P.A.	CHECKED: S.K.
DATE			SHEET NO. 1 OF 3
PROJECT NO.			
MUNICIPAL ENGINEERS			
804 - LAUREL SUITE 201 WICHITA, KANSAS 67211 316 - 262-3048			

SCALE:


GENERAL NOTES:

1. ALL STRUCTURES AND PIPE LENGTHS ARE SHOWN TO THE CENTER OF EXISTING OR PROPOSED STRUCTURES.
2. ALL STRUCTURES, EXCEPT FOR SIZE AND TYPE OF ROOF DRAIN PIPES WHICH CORRESPOND TO NEW INLETS.
3. ALL STRUCTURES SHALL BE CONSTRUCTED TO BE A MINIMUM OF 18" DEEP UNLESS OTHERWISE SPECIFIED. ALL STRUCTURES SHALL BE CONSTRUCTED WITH 12" THICK CONCRETE WALLS. ALL STRUCTURES SHALL BE FINISHED WITH 1/2" THICK GYP. BOARD OR EXISTING WALLS OF EXISTING STRUCTURES SHALL BE GYPSUM FOLLO.
4. ALL STRUCTURES OF EXISTING STRUCTURES SHALL BE REPAIRED, AS NECESSARY, TO PROVIDE SMOOTH FLOW THROUGH STRUCTURES.
5. ALL STRUCTURES SHALL BE CONSTRUCTED TO BE A MINIMUM OF 18" DEEP UNLESS OTHERWISE SPECIFIED. ALL STRUCTURES SHALL BE CONSTRUCTED WITH 12" THICK CONCRETE WALLS. ALL STRUCTURES SHALL BE FINISHED WITH 1/2" THICK GYP. BOARD OR EXISTING WALLS OF EXISTING STRUCTURES SHALL BE GYPSUM FOLLO.
6. ALL STRUCTURES SHALL BE CONSTRUCTED TO BE A MINIMUM OF 18" DEEP UNLESS OTHERWISE SPECIFIED. ALL STRUCTURES SHALL BE CONSTRUCTED WITH 12" THICK CONCRETE WALLS. ALL STRUCTURES SHALL BE FINISHED WITH 1/2" THICK GYP. BOARD OR EXISTING WALLS OF EXISTING STRUCTURES SHALL BE GYPSUM FOLLO.
7. ALL STRUCTURES SHALL BE CONSTRUCTED TO BE A MINIMUM OF 18" DEEP UNLESS OTHERWISE SPECIFIED. ALL STRUCTURES SHALL BE CONSTRUCTED WITH 12" THICK CONCRETE WALLS. ALL STRUCTURES SHALL BE FINISHED WITH 1/2" THICK GYP. BOARD OR EXISTING WALLS OF EXISTING STRUCTURES SHALL BE GYPSUM FOLLO.
8. ALL STRUCTURES SHALL BE CONSTRUCTED TO BE A MINIMUM OF 18" DEEP UNLESS OTHERWISE SPECIFIED. ALL STRUCTURES SHALL BE CONSTRUCTED WITH 12" THICK CONCRETE WALLS. ALL STRUCTURES SHALL BE FINISHED WITH 1/2" THICK GYP. BOARD OR EXISTING WALLS OF EXISTING STRUCTURES SHALL BE GYPSUM FOLLO.
9. ALL STRUCTURES SHALL BE CONSTRUCTED TO BE A MINIMUM OF 18" DEEP UNLESS OTHERWISE SPECIFIED. ALL STRUCTURES SHALL BE CONSTRUCTED WITH 12" THICK CONCRETE WALLS. ALL STRUCTURES SHALL BE FINISHED WITH 1/2" THICK GYP. BOARD OR EXISTING WALLS OF EXISTING STRUCTURES SHALL BE GYPSUM FOLLO.
10. ALL STRUCTURES SHALL BE CONSTRUCTED TO BE A MINIMUM OF 18" DEEP UNLESS OTHERWISE SPECIFIED. ALL STRUCTURES SHALL BE CONSTRUCTED WITH 12" THICK CONCRETE WALLS. ALL STRUCTURES SHALL BE FINISHED WITH 1/2" THICK GYP. BOARD OR EXISTING WALLS OF EXISTING STRUCTURES SHALL BE GYPSUM FOLLO.

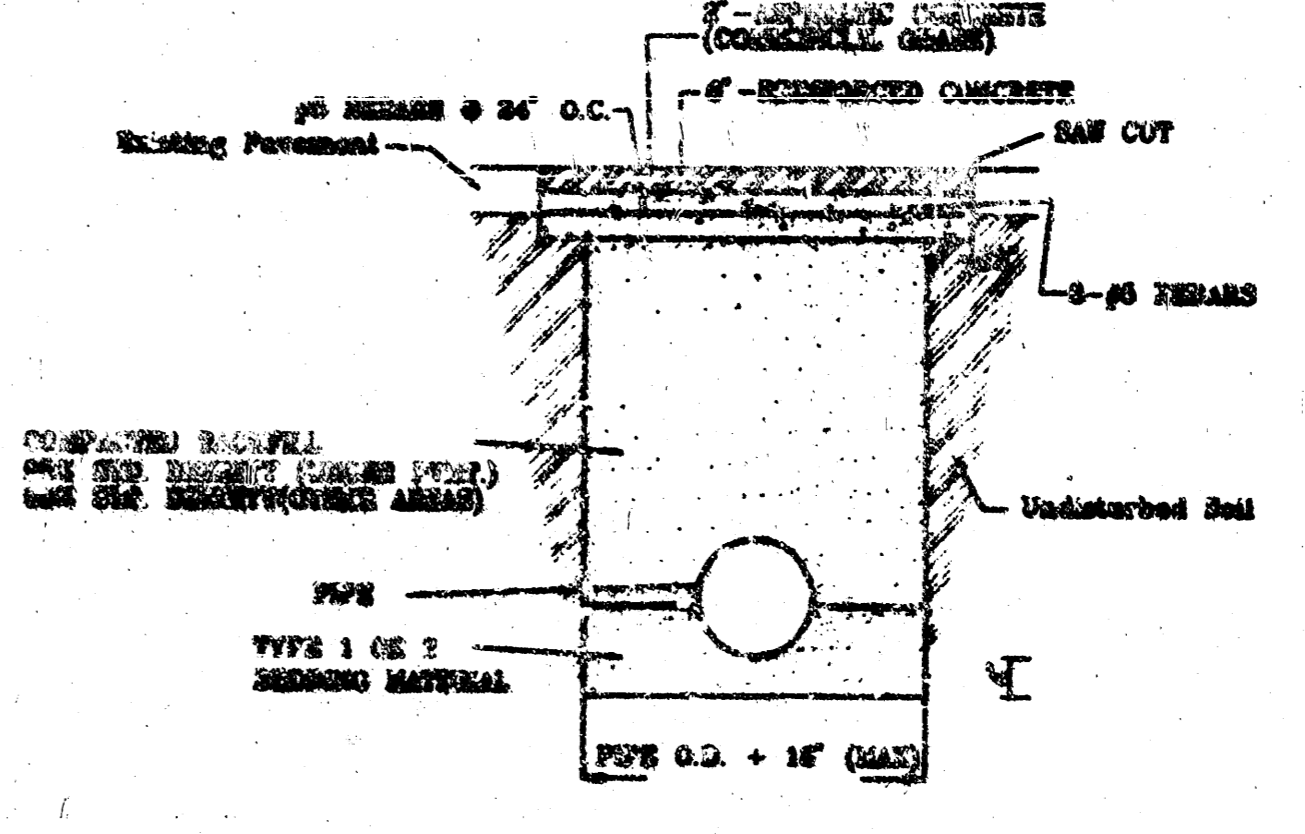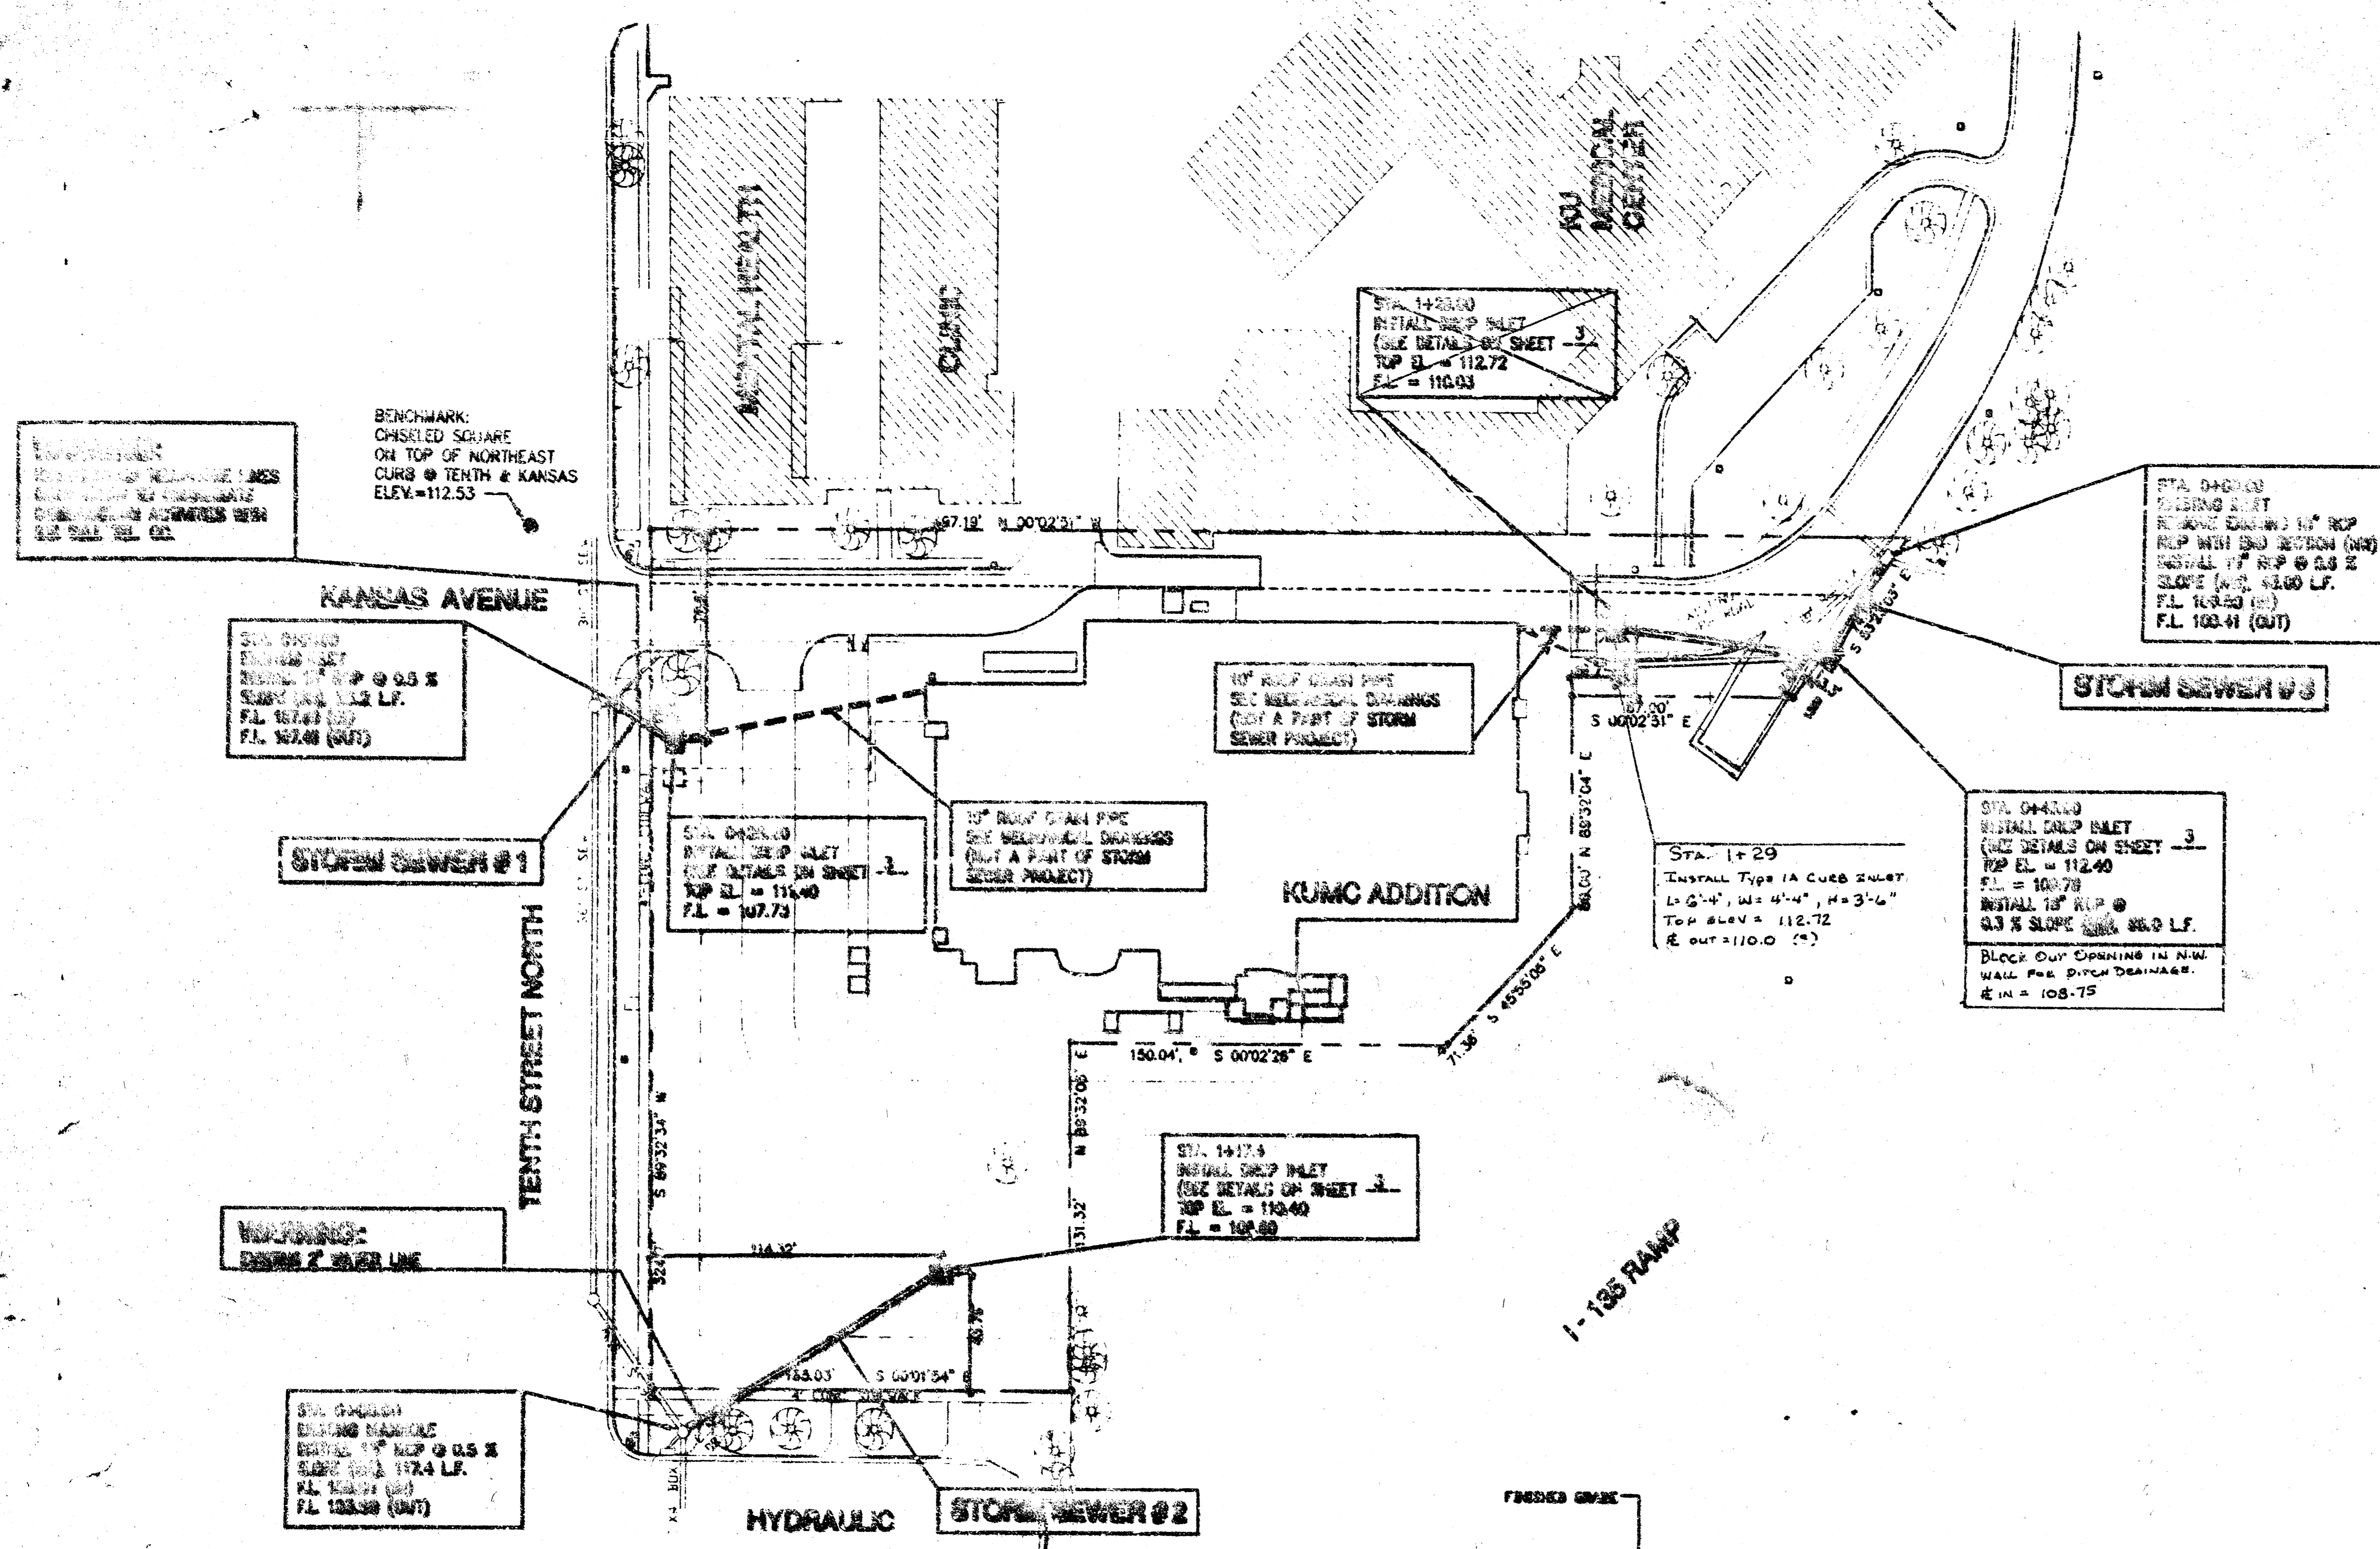

AS BUILT PLANS
 S.E. ANDERSON, P.E.
 DECEMBER, 1995



NOTE:
 CITY OF MOBILE DATUM = USGS DATUM - 1187.43

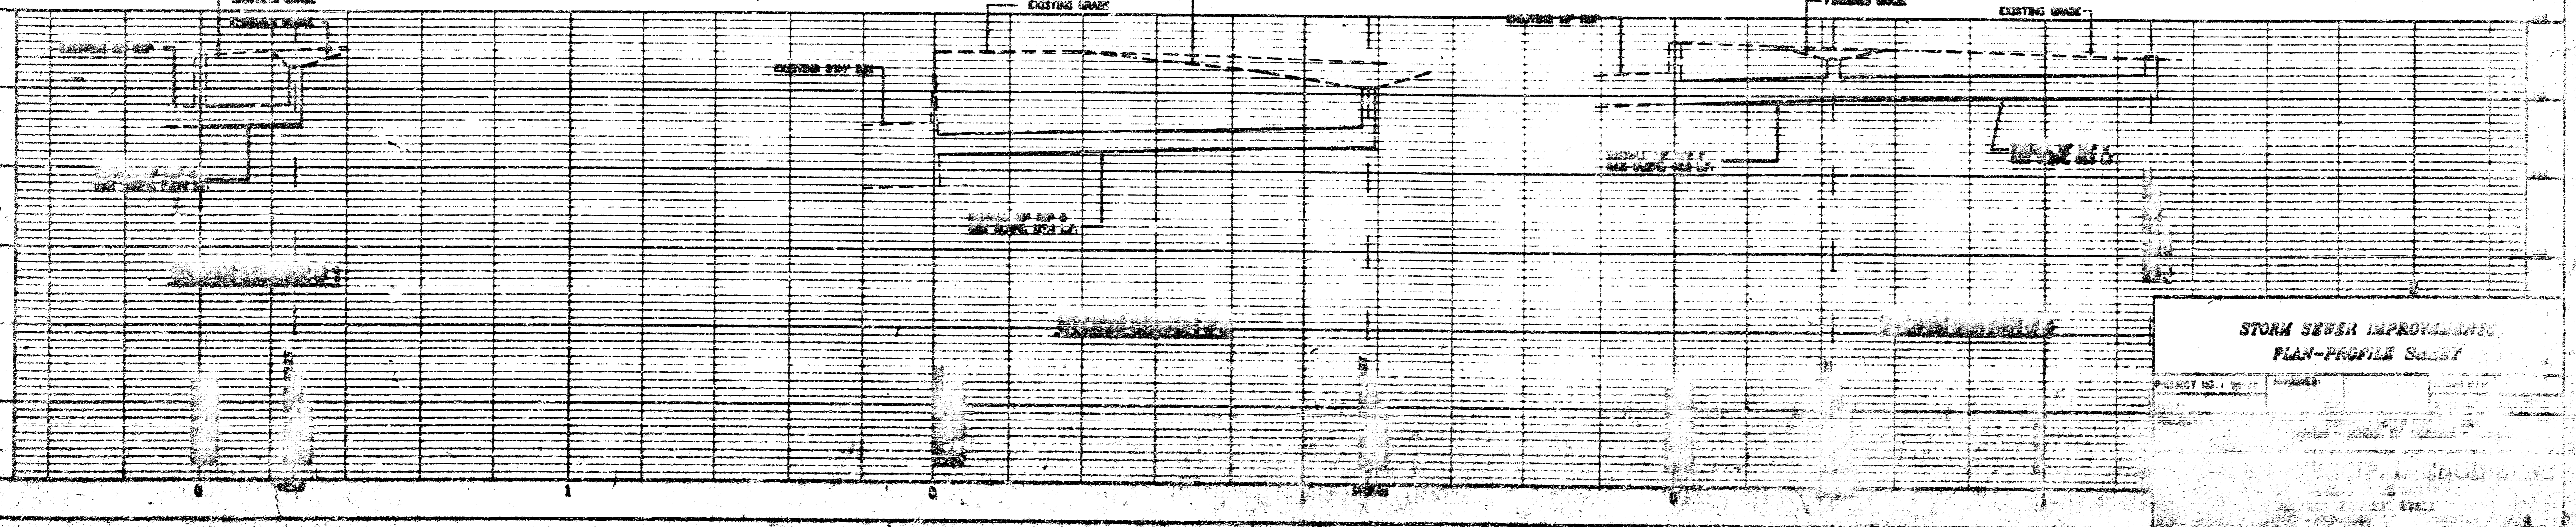


**STORM SEWER IMPROVEMENTS
 PLAN-PROFILE SHEET**

PROJECT NO. 100-100-100	DATE: 12/15/95
DRAWN BY: S.E. ANDERSON	CHECKED BY: S.E. ANDERSON
SCALE: AS SHOWN	DATE: 12/15/95


NOTE: Grates shall be imprinted on the top surface with CITY OF WICHITA using letters at least 1/2" high. Other marking methods may be used only if approved by the engineer.

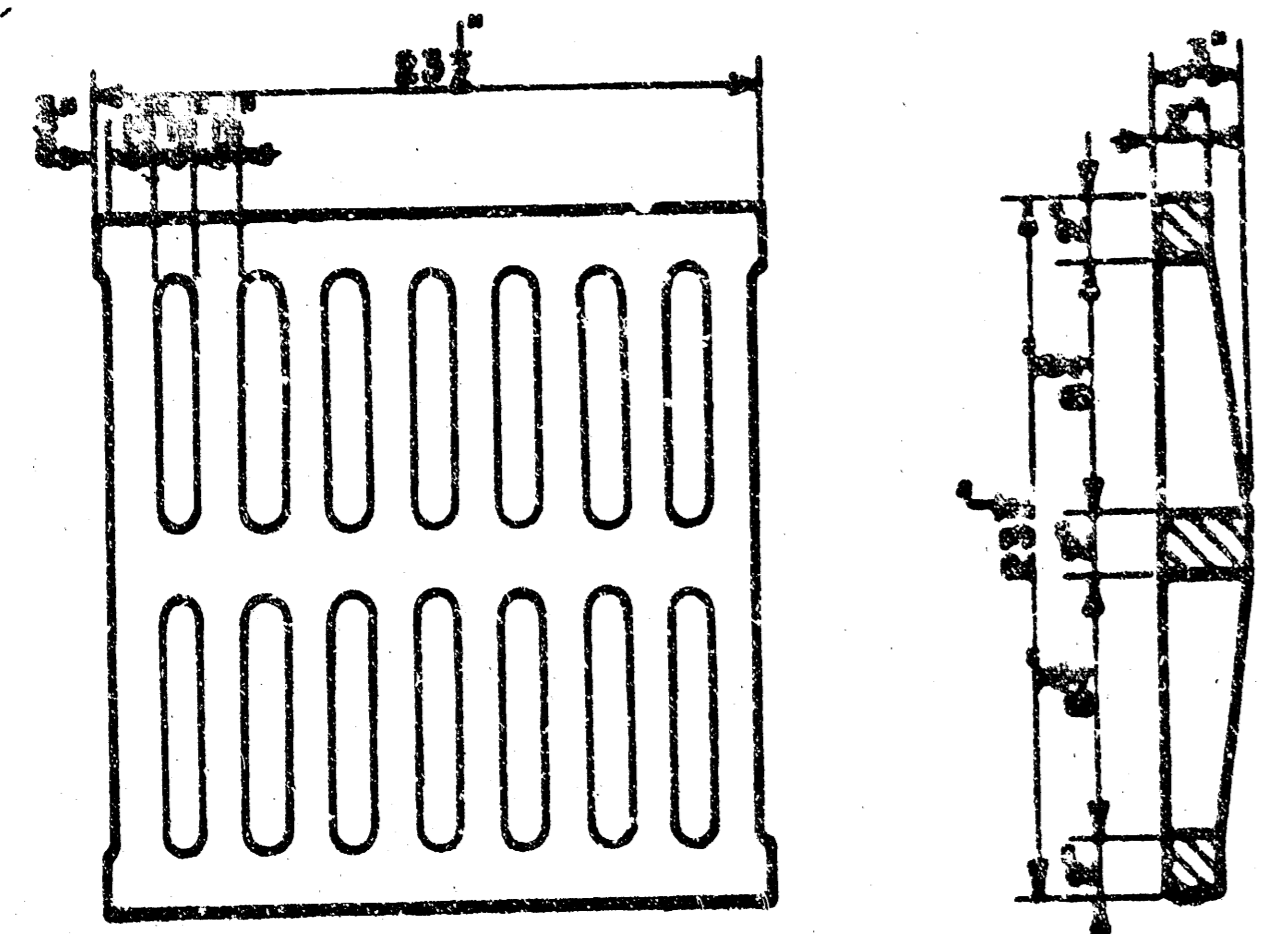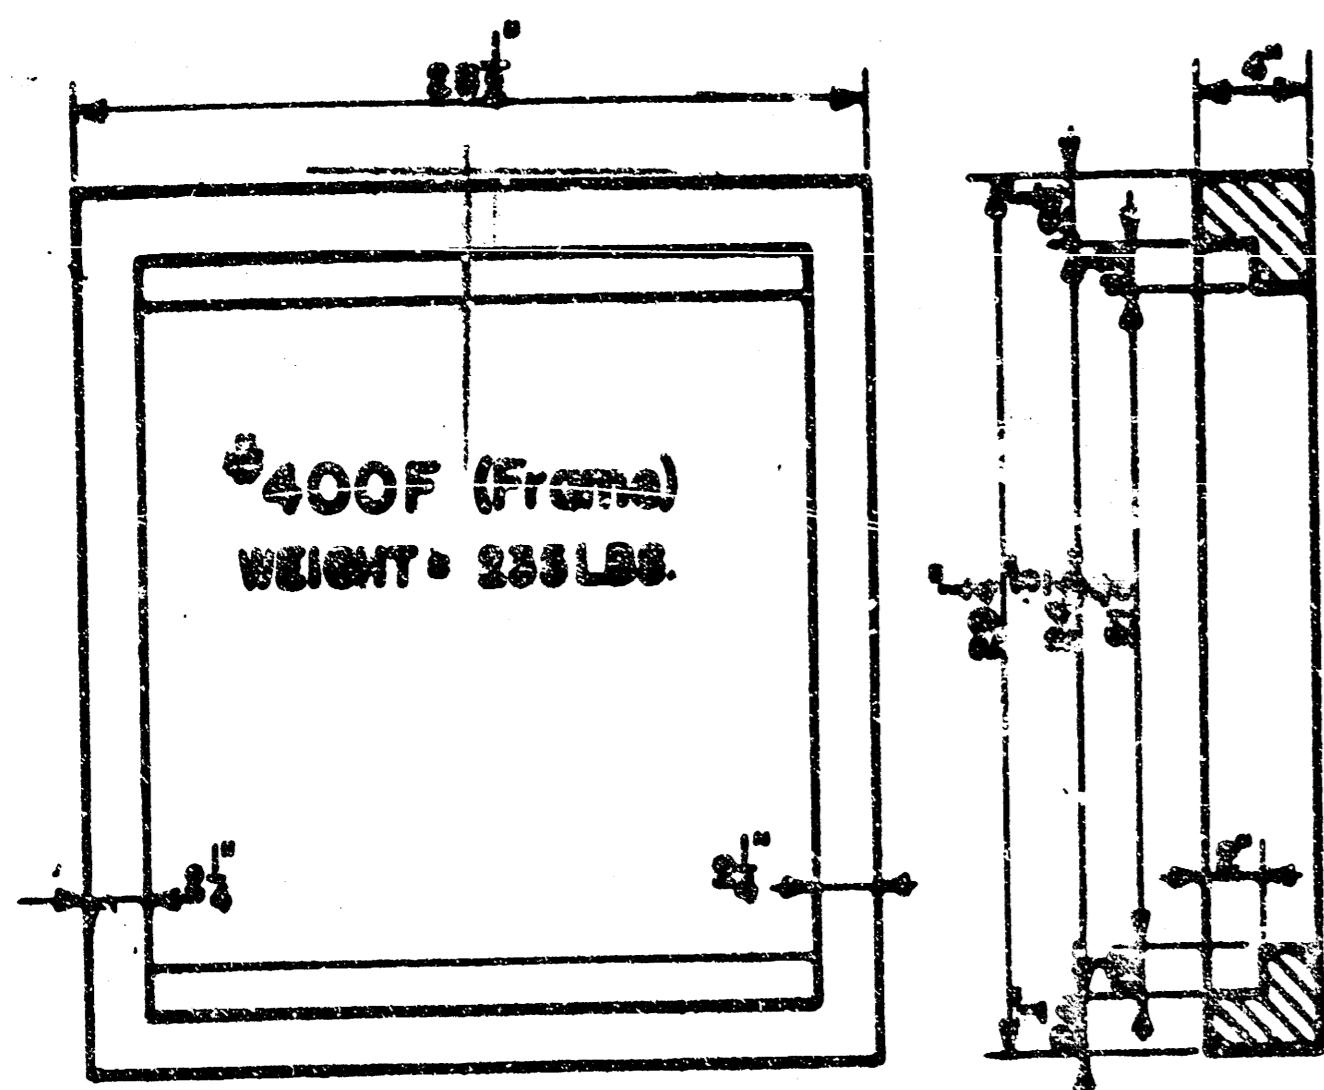


24"x24" Frame & Grate Detail

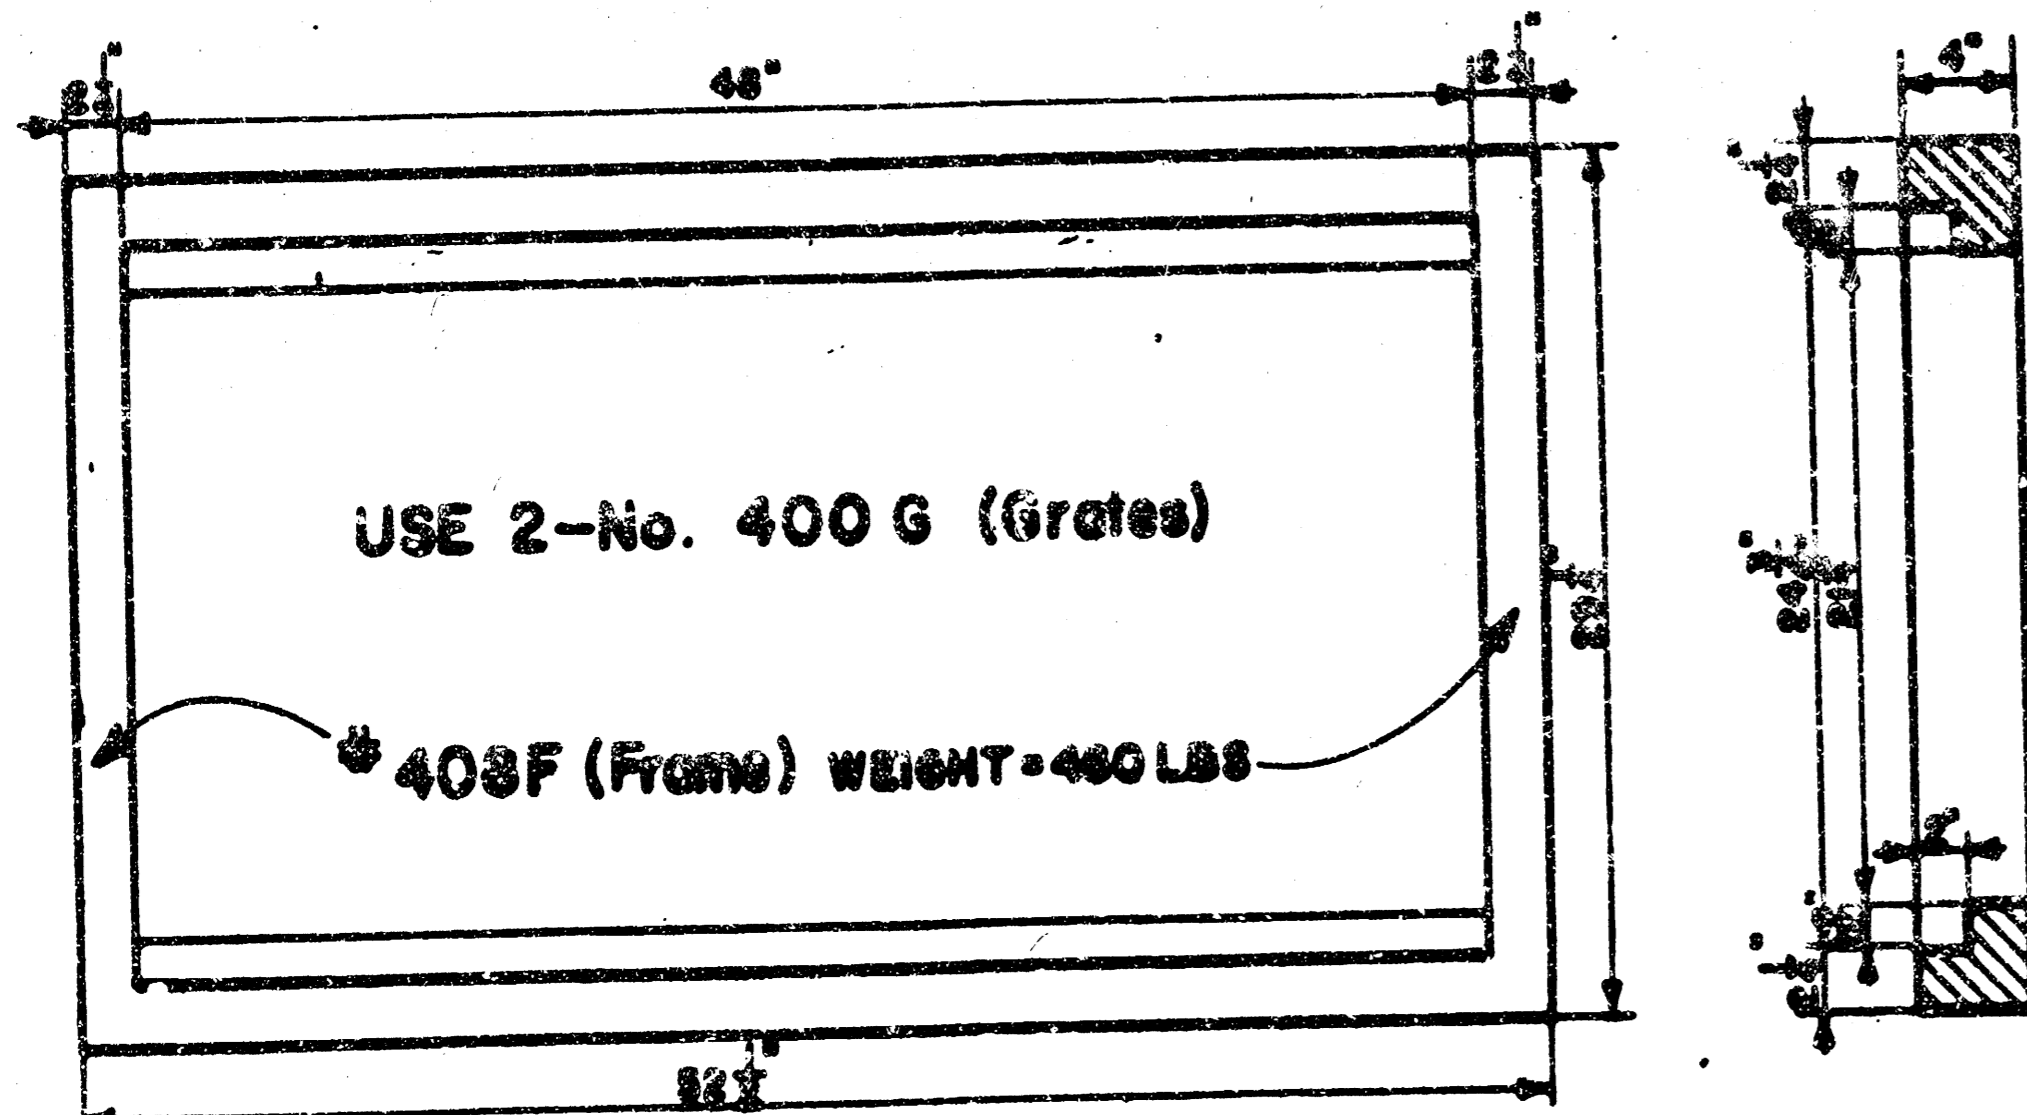


Double 24"x24" Frame Detail

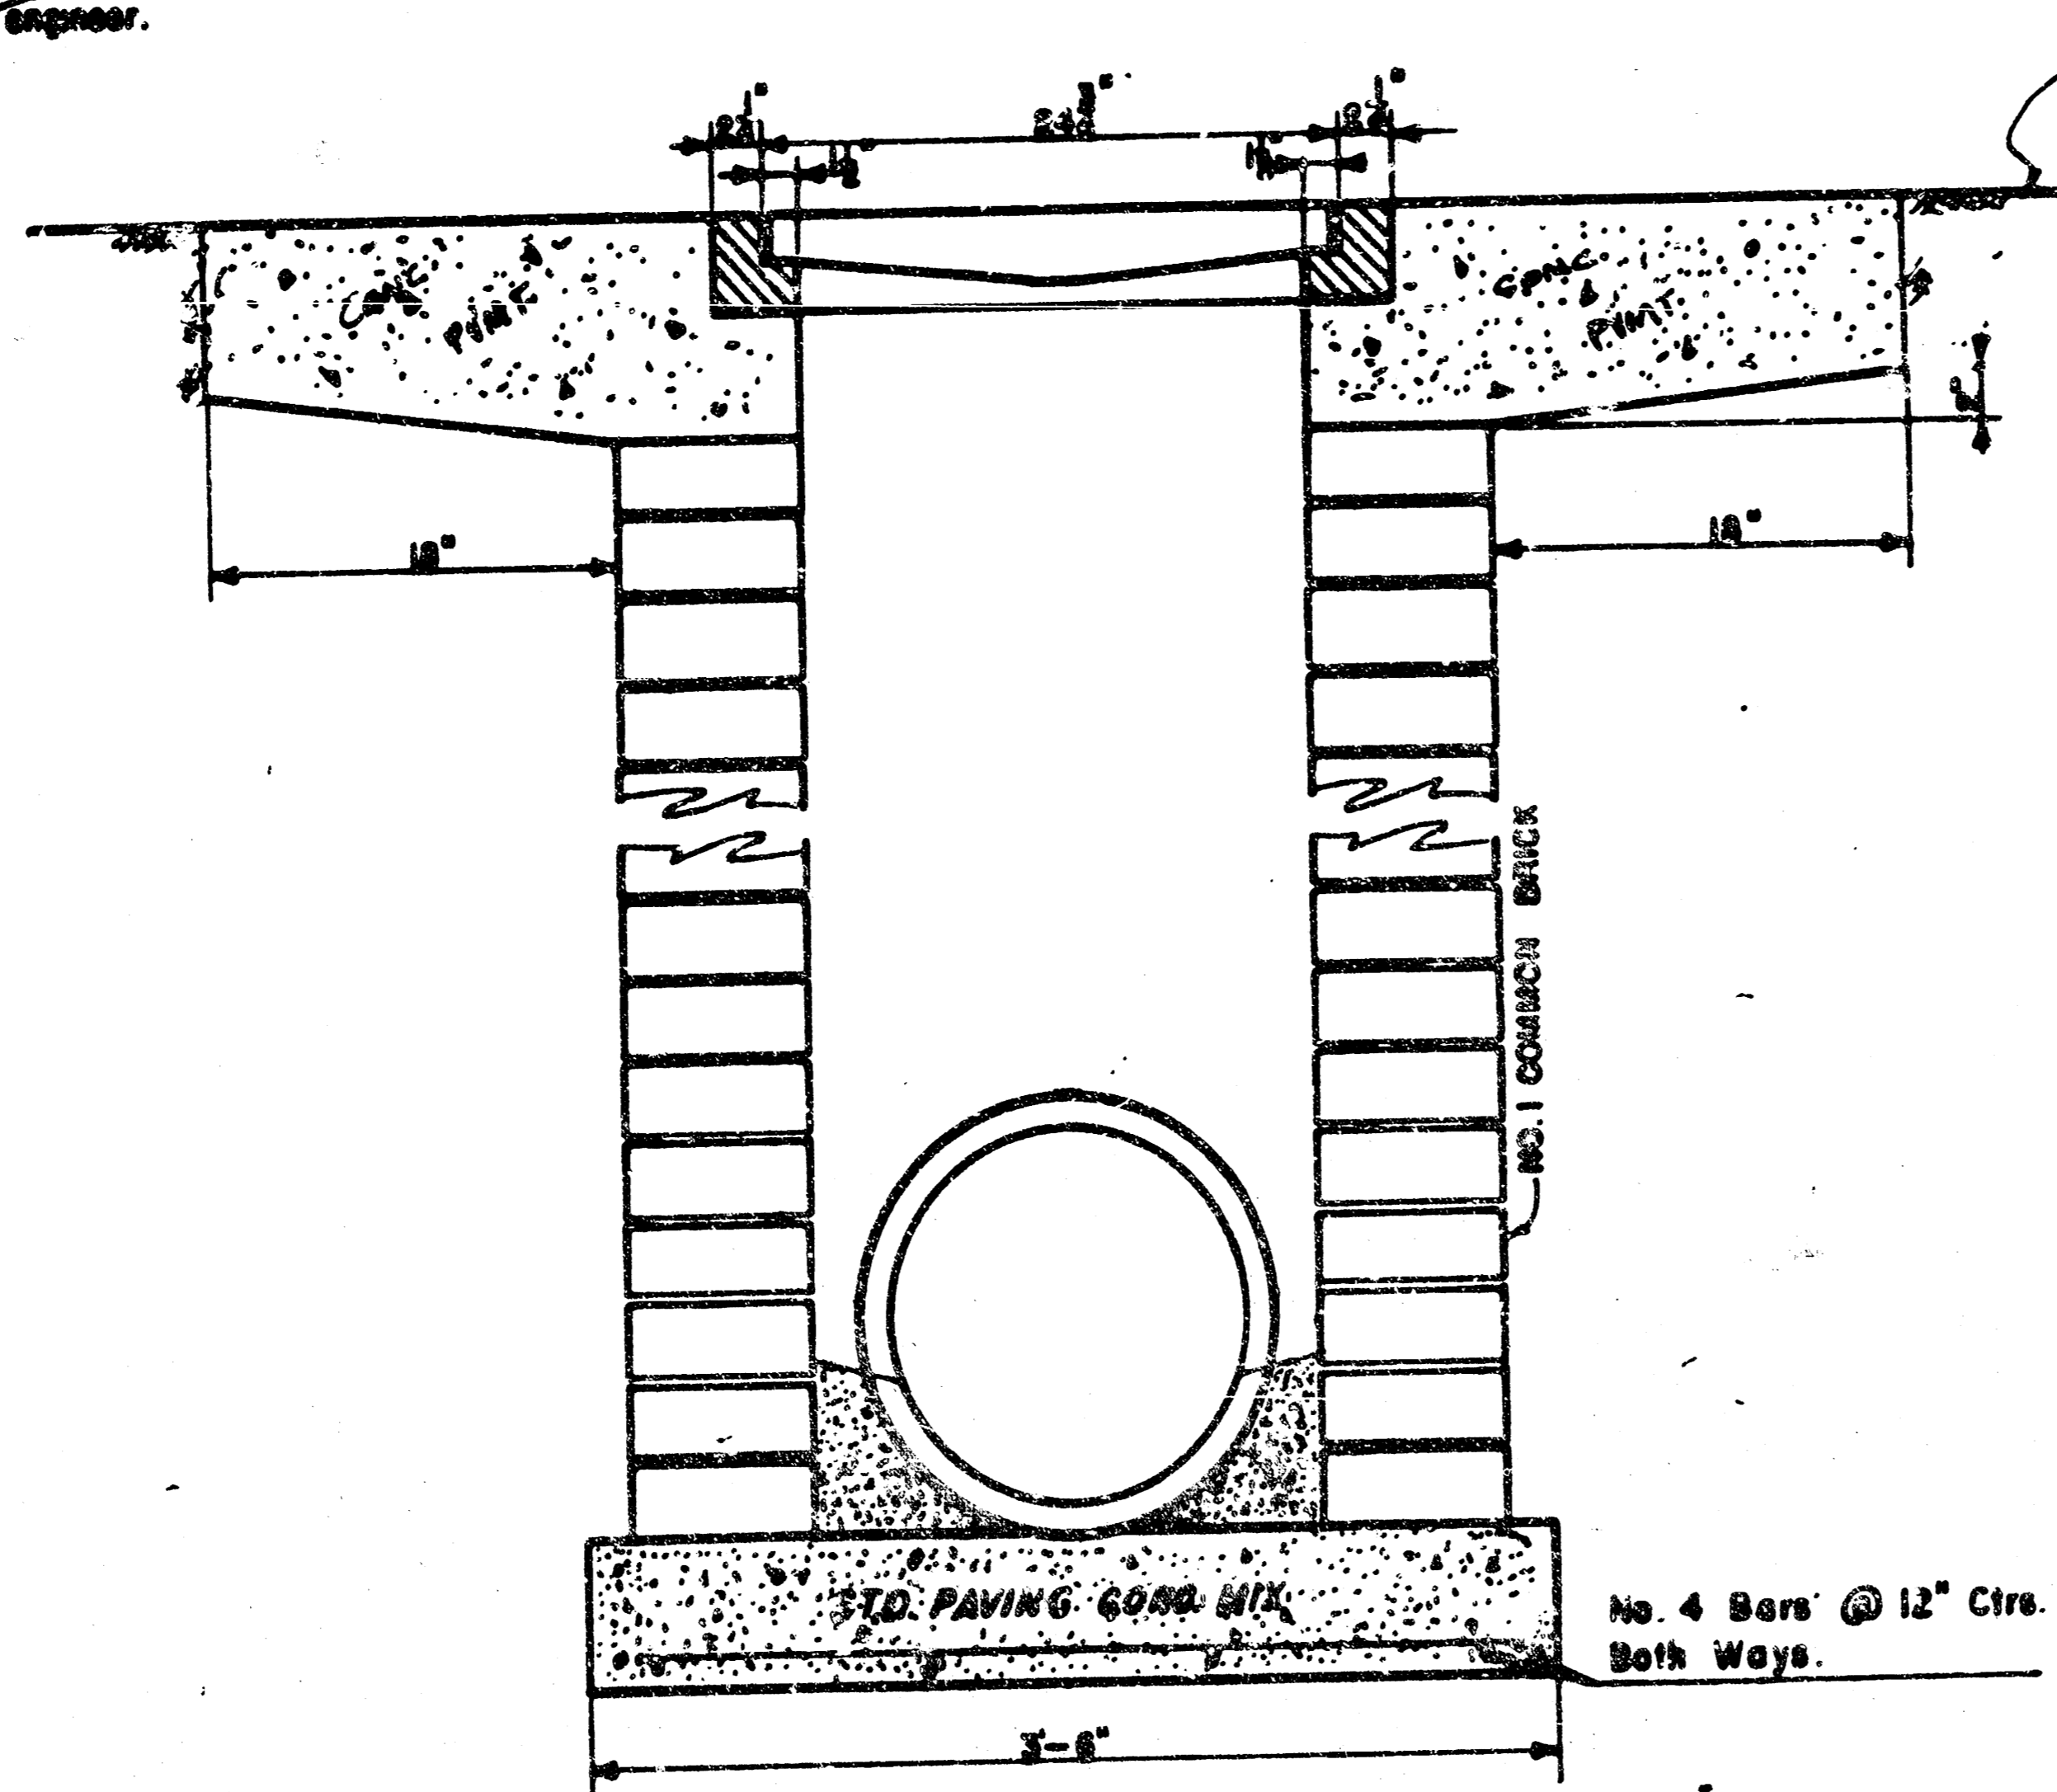

FINISH SETTING GRADE, FINISHED GRADE OR P.V.M.T.

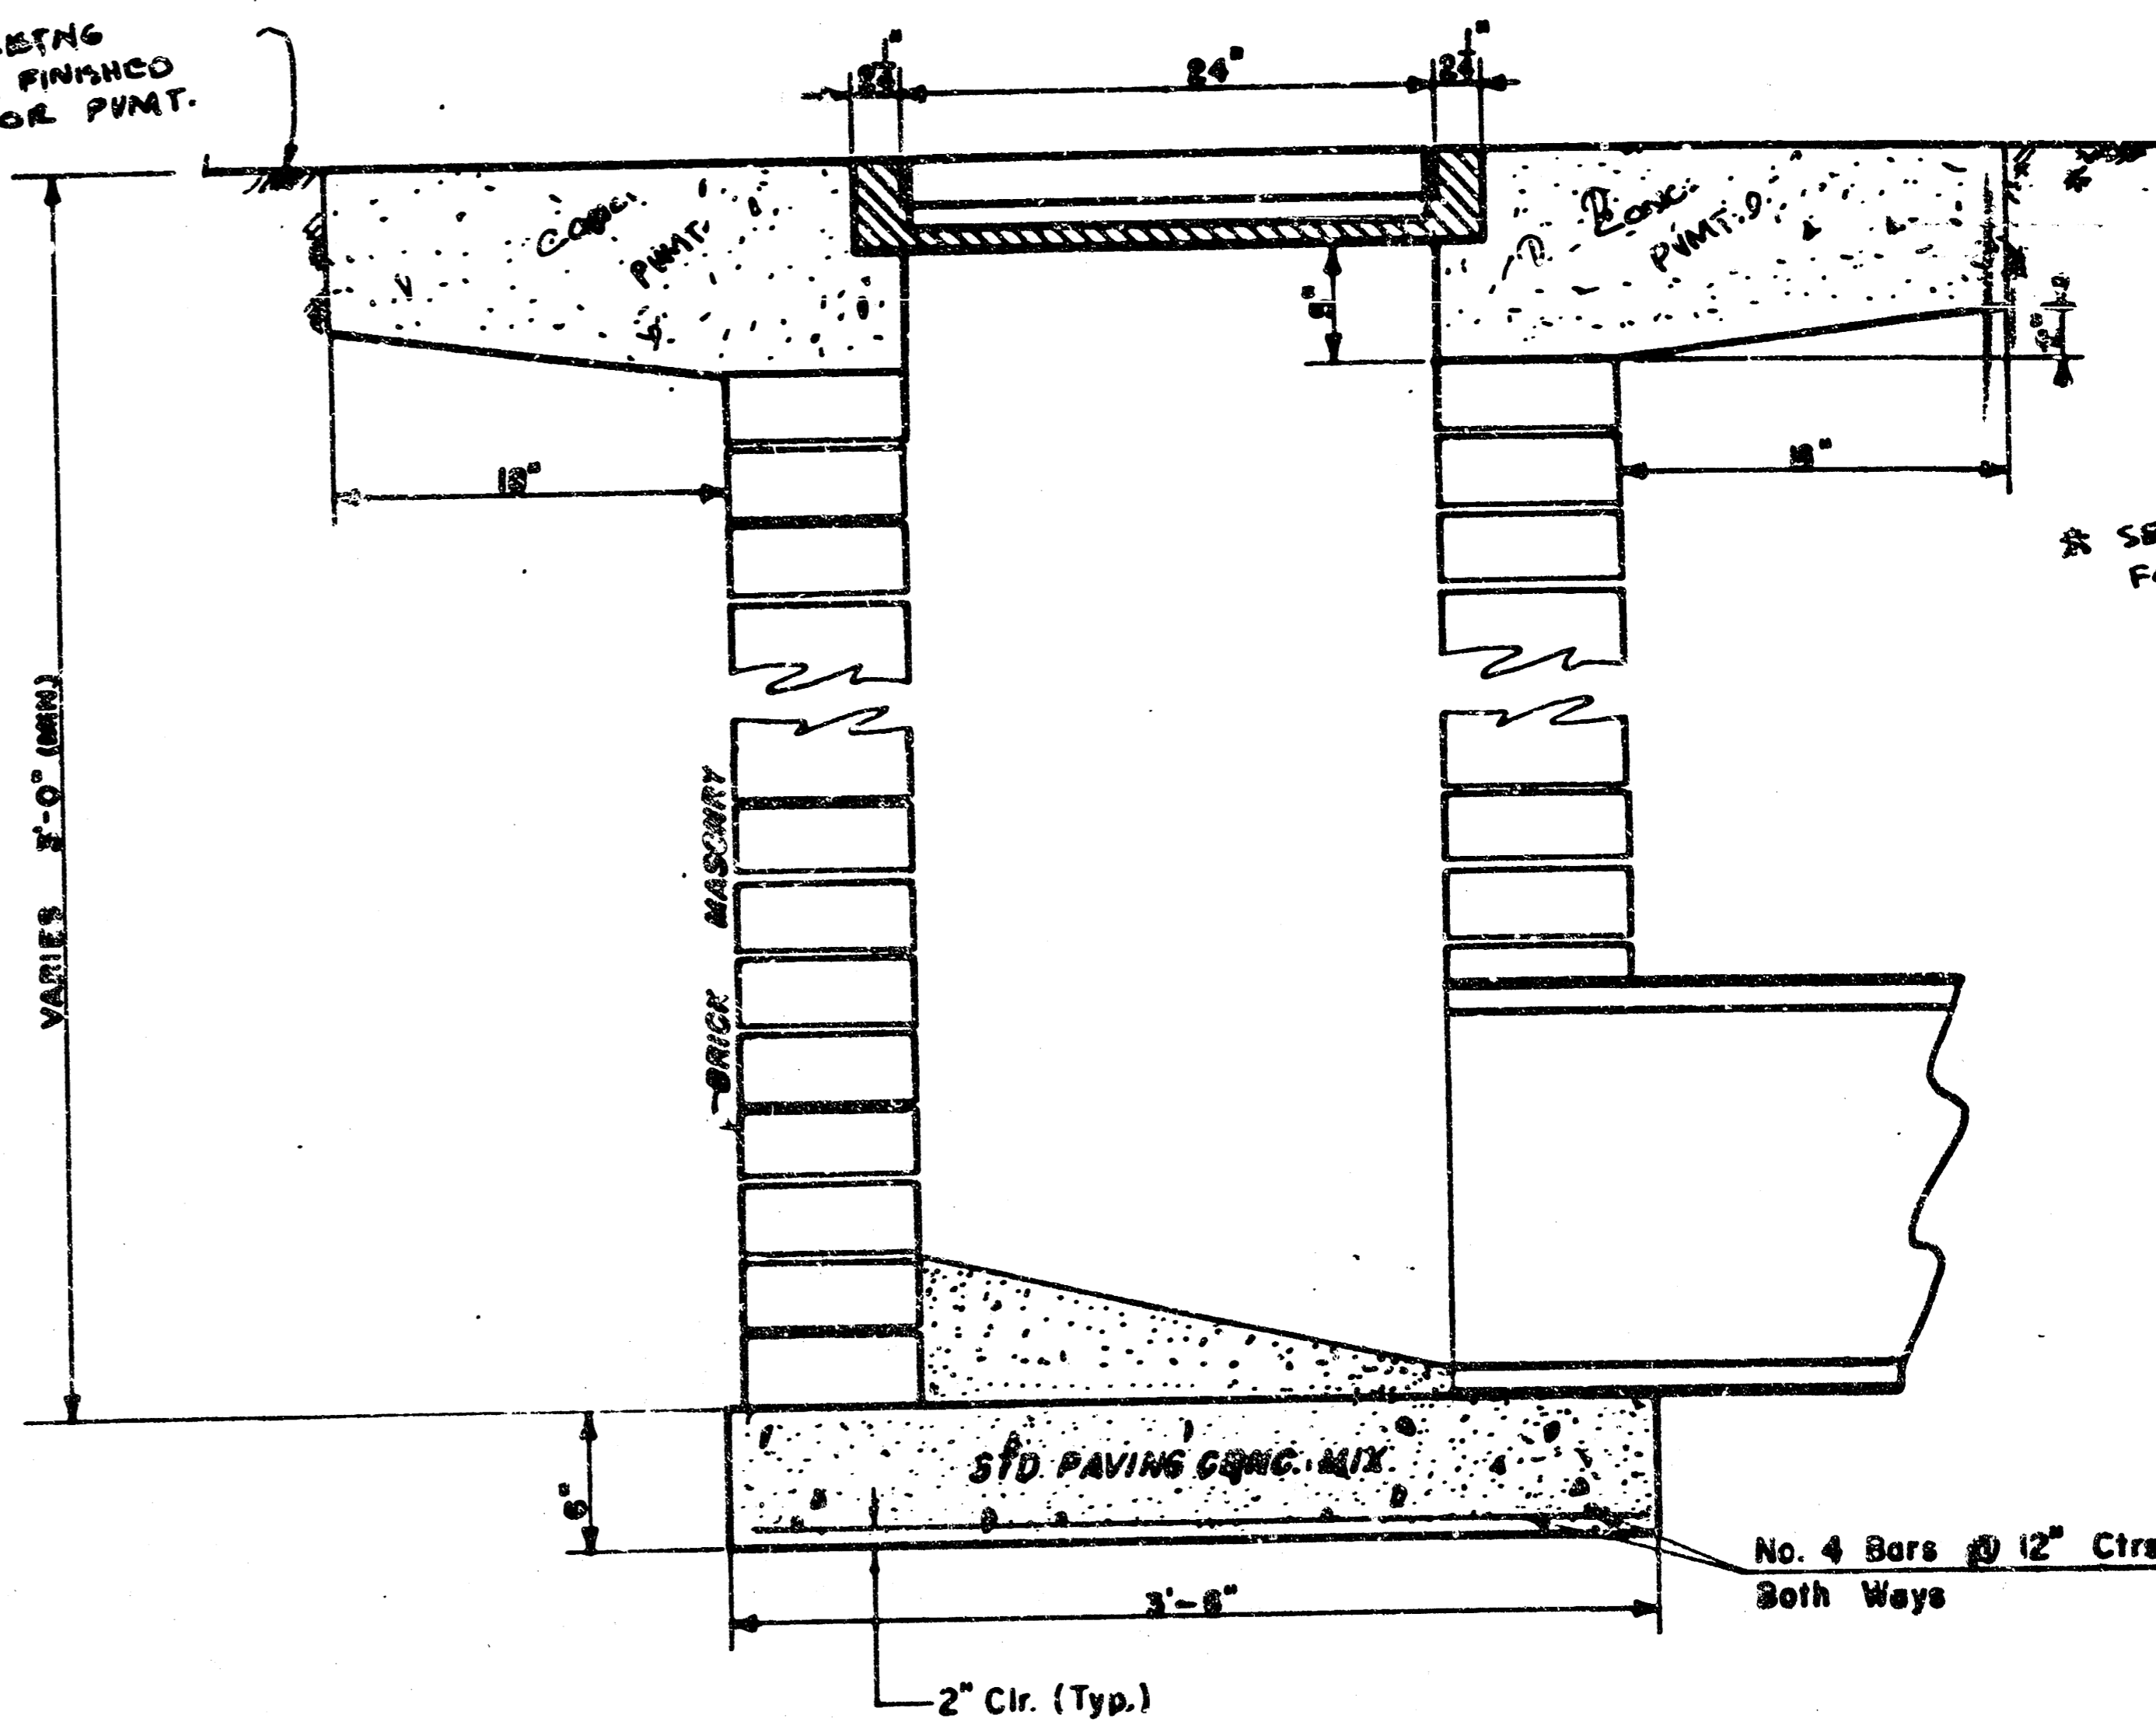

SEE SITE PLAN FOR P.V.M.T. THICKNESS

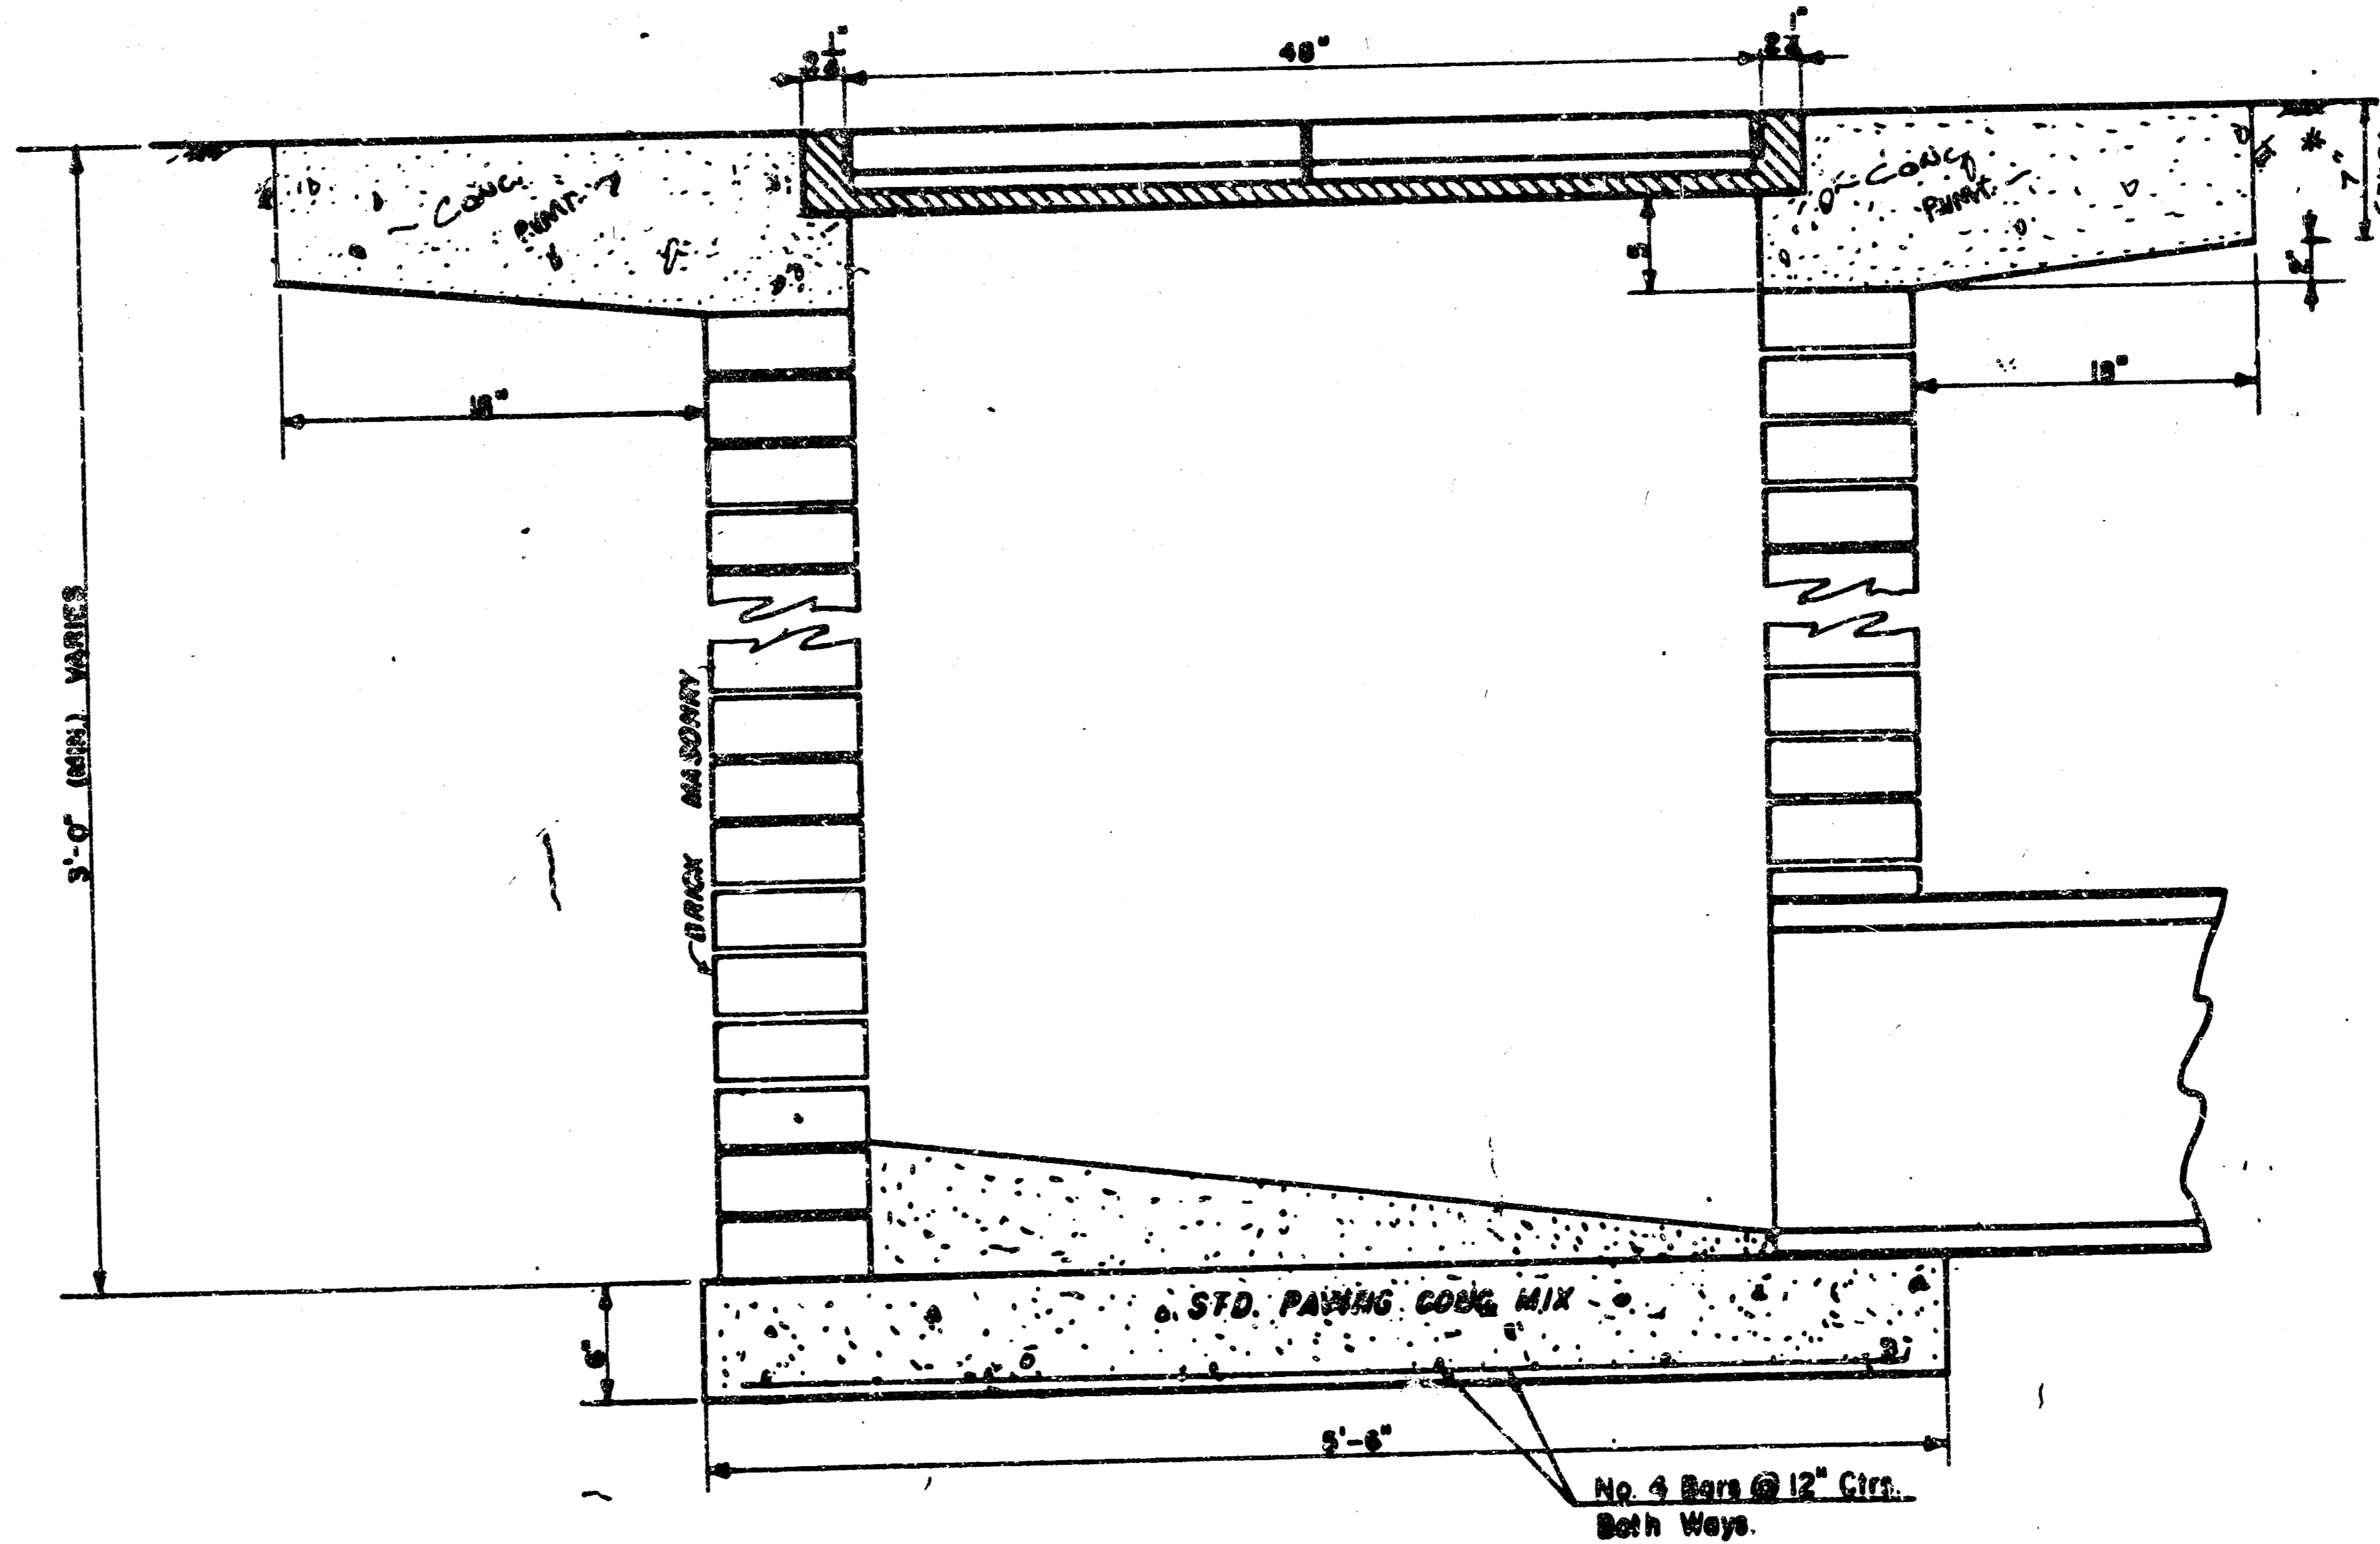

NOTE: CONTRACTOR MAY USE PRECAST CONC. INLETS AFTER REVIEW AND APPROVAL OF SHOP DRAWINGS BY OWNER'S REPRESENTATIVE.

DROP INLET DETAILS

STORM SEWER IMPROVEMENTS TO SERVE LOT 1, BLOCK 1, KUMC ADD. PRIVATE PROJECT NO. 538 PPS (60784)

Project WOMEN'S RESEARCH INSTITUTE UNIVERSITY OF KANSAS - SCHOOL OF MEDICINE WICHITA, KS.

Project No. 94-70

Date: 12-15-24

Scale: 1-1/2" = 1'-0"