
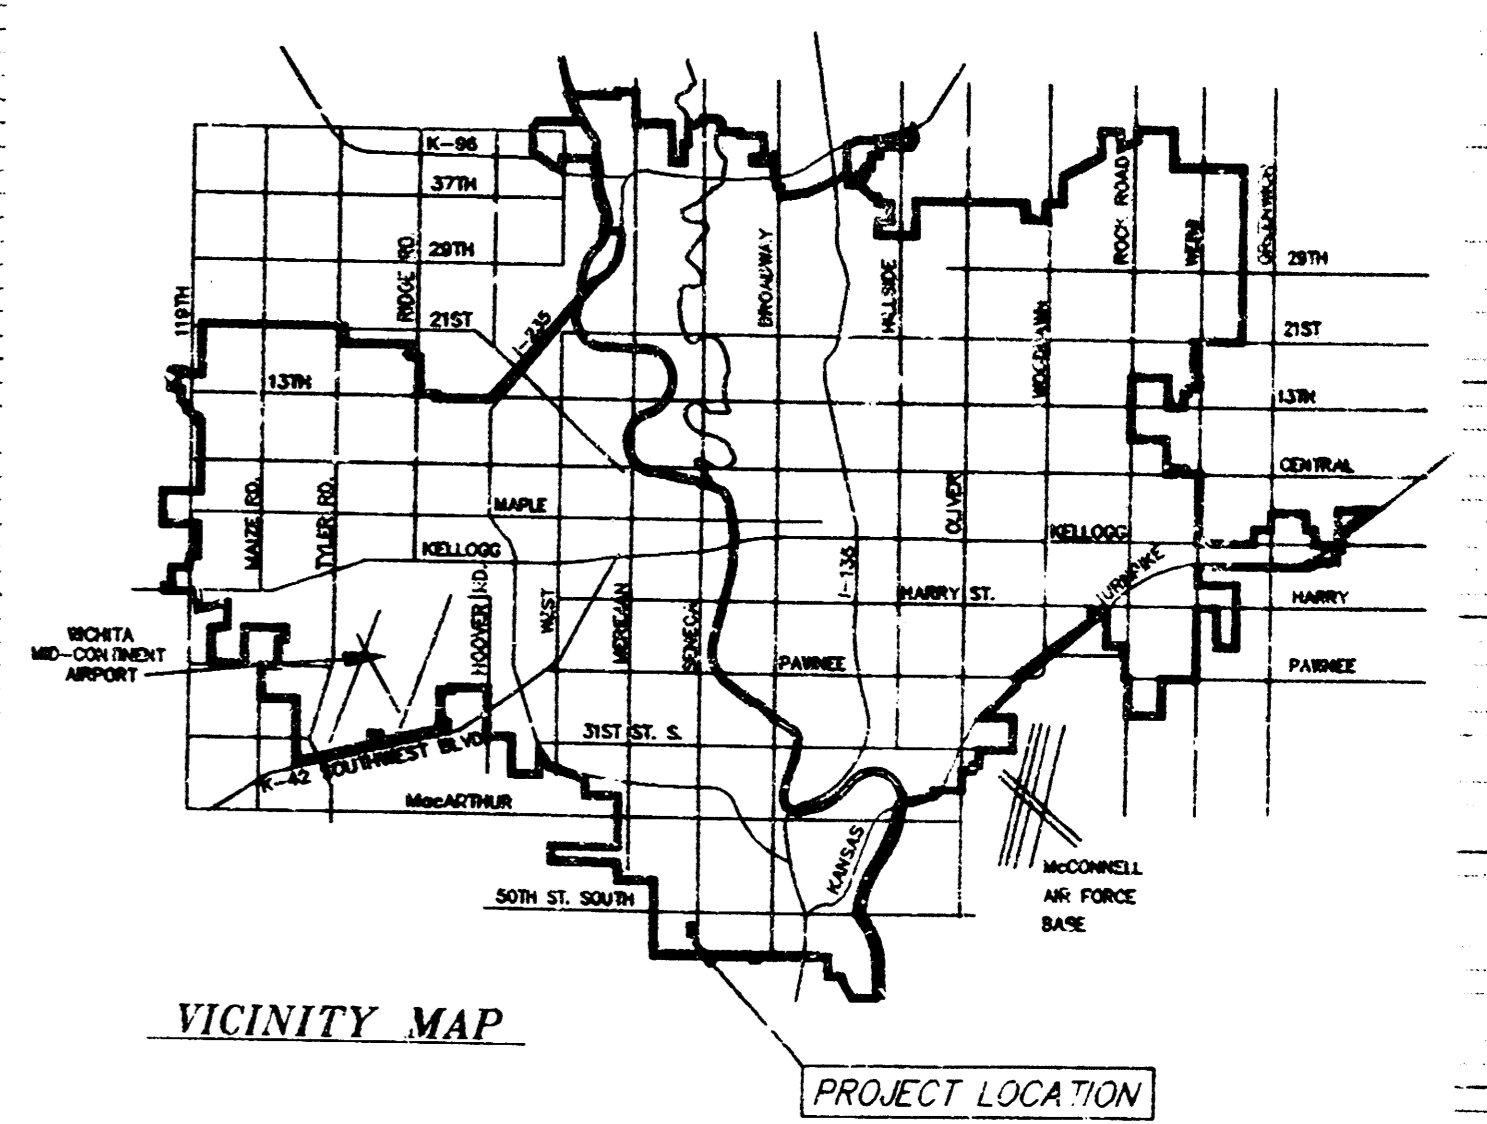


INSPECTION AND TESTING FOR THIS PROJECT TO BE PROVIDED BY A LICENSED CONSULTING ENGINEERING FIRM UNDER CONTRACT WITH THE OWNER/DEVELOPER. SAID INSPECTION TO BE IN ACCORDANCE WITH THE CITY OF WICHITA STANDARD CONSTRUCTION ENGINEERING PRACTICES AND CERTIFIED BY A LICENSED PROFESSIONAL ENGINEER. NO WORK SHALL BE PERFORMED IN DEDICATED EASEMENTS OR PUBLIC RIGHT-OF-WAY BY THE CONTRACTOR WITHOUT SUCH INSPECTIONS. WORK SHALL ANY WORK BE COMMENCED IN DEDICATED EASEMENTS OR PUBLIC RIGHT-OF-WAY WITHOUT WRITTEN AUTHORIZATION BY THE CITY ENGINEER.

APPROVED AS NOTED
By CITY ENGINEER OF WICHITA

Sanitary Sewers _____
Storm Sewers VRH 3/17/95
Driveway Approaches _____
Water Mains _____
Paving _____

- GENERAL NOTES**
- Underground utility service lines and overhead utility pole lines are to be adjusted as necessary by others prior to construction unless the plans specifically call for their adjustment by the Contractor or unless the plans specifically identify a utility to be adjusted by its owner during construction. Existing utilities and their location, as shown on the plans, represent the best information obtainable or design. Location information has been obtained from the various utility companies and is either from their record drawings or company provided field locations. The Contractor will be required to work around existing utilities within the right-of-way which do not conflict with proposed construction.
 - Trees and shrubs in public right-of-way which are in direct conflict with proposed new construction shall be removed by the Contractor with the Engineer's approval. Trees and shrubs which are not in direct conflict with proposed new construction shall be saved and protected from damage.
 - The Contractor shall be responsible for preserving property irons. The Contractor will be required to re-establish any property irons which are damaged or destroyed by his construction operations. Such irons shall be re-established by a licensed land surveyor or a licensed professional engineer in accordance with state laws.
 - The Contractor shall contact Kansas One Call at 687-2470 to have underground utilities located prior to construction of this project.
 - All disturbed areas to be seeded according to City of Wichita specifications.

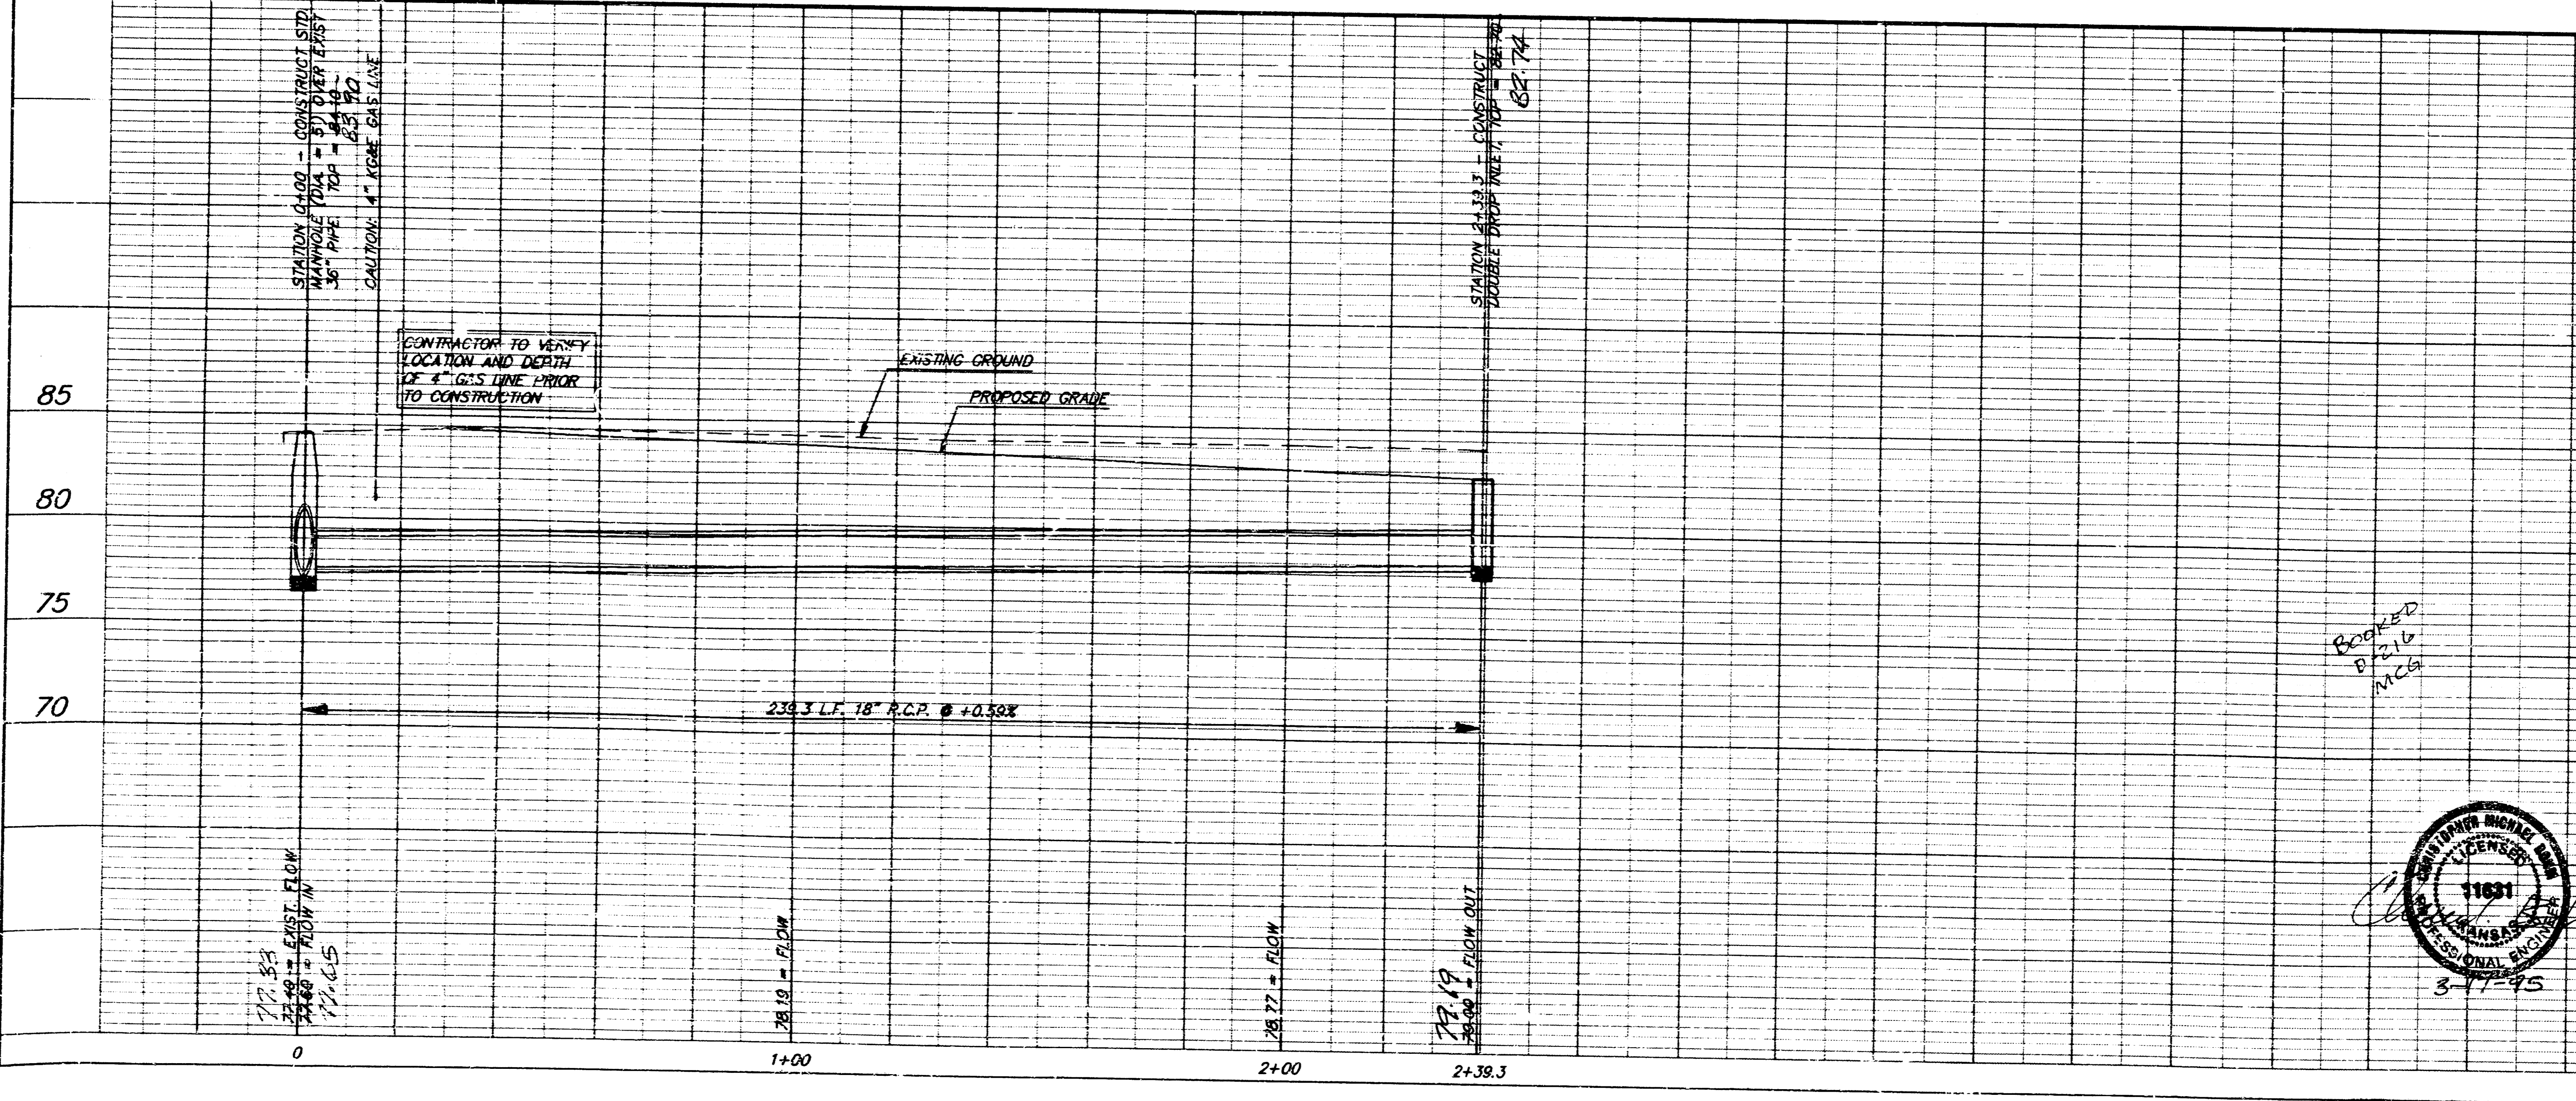

Checked
D.P. 1/6
M.C.B.

Professional Engineer
11631
3-17-95

AS BUILT 3-1-96

PRIVATE STORM WATER SEWER EXTENSION TO SERVE LOTS 31-34 A. VERNE ROBERTS ADDN.

SRB		934 NORTH MAIN WICHITA, KANSAS 67211	316-264-8008 FAX 264-8152	REVISION 3-1-96
SAVOY, RUGGLES & BOHM, P.A.		ENGINEERING & SURVEYING		1
PROJECT NUMBER 544 PPS		DATE 3-13-95	UTILITY CMB	1
DRAWN C. Bohm	DESIGN C. Bohm	REVIEW TCR	DATE 3-13-95	UTILITY CMB