

STORM WATER SEWER IMPROVEMENTS
TO SERVE

LOWE'S ADDITION

Private Project Number
740 PPS (607861)

CITY OF WICHITA, KANSAS
Michael E. Lindebak, P.E. City Engineer

GENERAL NOTES:

1. Contractor will be required to provide notice to utility companies a minimum of twenty-four (24) hours prior to any excavation, as follows:

Kansas One-Call 687-2470

The Contractor must notify the following in case of an emergency:

Cablevision 262-4270
or
K.P.L. Gas Service Company 263-2061
Kansas Gas & Electric Company 263-7511
Arkla Gas Company 264-1141
or
Southwestern Bell Telephone Company 942-8350
City of Wichita Water Department 263-8161
City of Wichita Sewer Maintenance 1-571-2611
268-4908
268-4071

2. Underground utility service lines and overhead utility pole lines are to be adjusted as necessary by others prior to construction unless the plans specifically call for their adjustment by the Contractor or unless the plans specifically identify a utility to be adjusted by its owner during construction. Existing utilities and their location, as shown on the plans, represent the best information obtainable for design. The Contractor will be required to work around existing utilities within the right-of-way which do not conflict with proposed construction.

3. The Contractor shall be responsible for preserving property irons. The Contractor will be required to re-establish any property irons which are damaged or destroyed by his construction operations. Such irons shall be re-established by a licensed land surveyor in accordance with state laws.

4. Contractor shall not start work on the project until the project inspector is assigned to the project and is present on the site. Any work done without inspection will be required to be uncovered for inspection.

5. All areas disturbed by construction operations shall be seeded with Kansas Premium Fescue Blend at the rate of 340 lbs./acre. Fertilizer (16-20-6) shall be applied at the rate of 170 lbs./acre.

6. The Contractor shall notify pipeline companies at least 24 hours in advance of any work being performed across and/or adjacent to pipelines.

7. Trees and shrubs in public right-of-way which are in direct conflict with proposed new construction shall be removed by the Contractor with the Engineer's approval. Trees and shrubs which are not in direct conflict with proposed new construction shall be saved and protected from damage.


8. Rubble from the removal of miscellaneous structures and excess excavation which is to be wasted shall be disposed of on sites to be provided by the Contractor. These sites shall be approved by the engineer as to suitability, appearance and site location. Locations that, in the opinion of the Engineer, will leave an unsightly appearance will not be approved.

BENCHMARK:

City of Wichita Benchmark Disk -
S.W. Corner of Intersection, 69'
South & 97' West of G Ridge
Road and Maple, 10.5' North of
Face of Sidewalk.
Elev. = 142.07 City Datum


INDEX:

- 1 Title Sheet
2 Pond Plan
3 SWPPP & Site Clrg.
4-5 Storm Water Sewer Line 1
6 Storm Water Sewer Lines 1A & 2
7-8 Storm Water Sewer Line 3
9 Storm Water Sewer Lines 4 & 4A
10 Storm Water Sewer Line 4B
11 Junction Box and Inlet Details
12 Copy of Lowe's Addition Plat

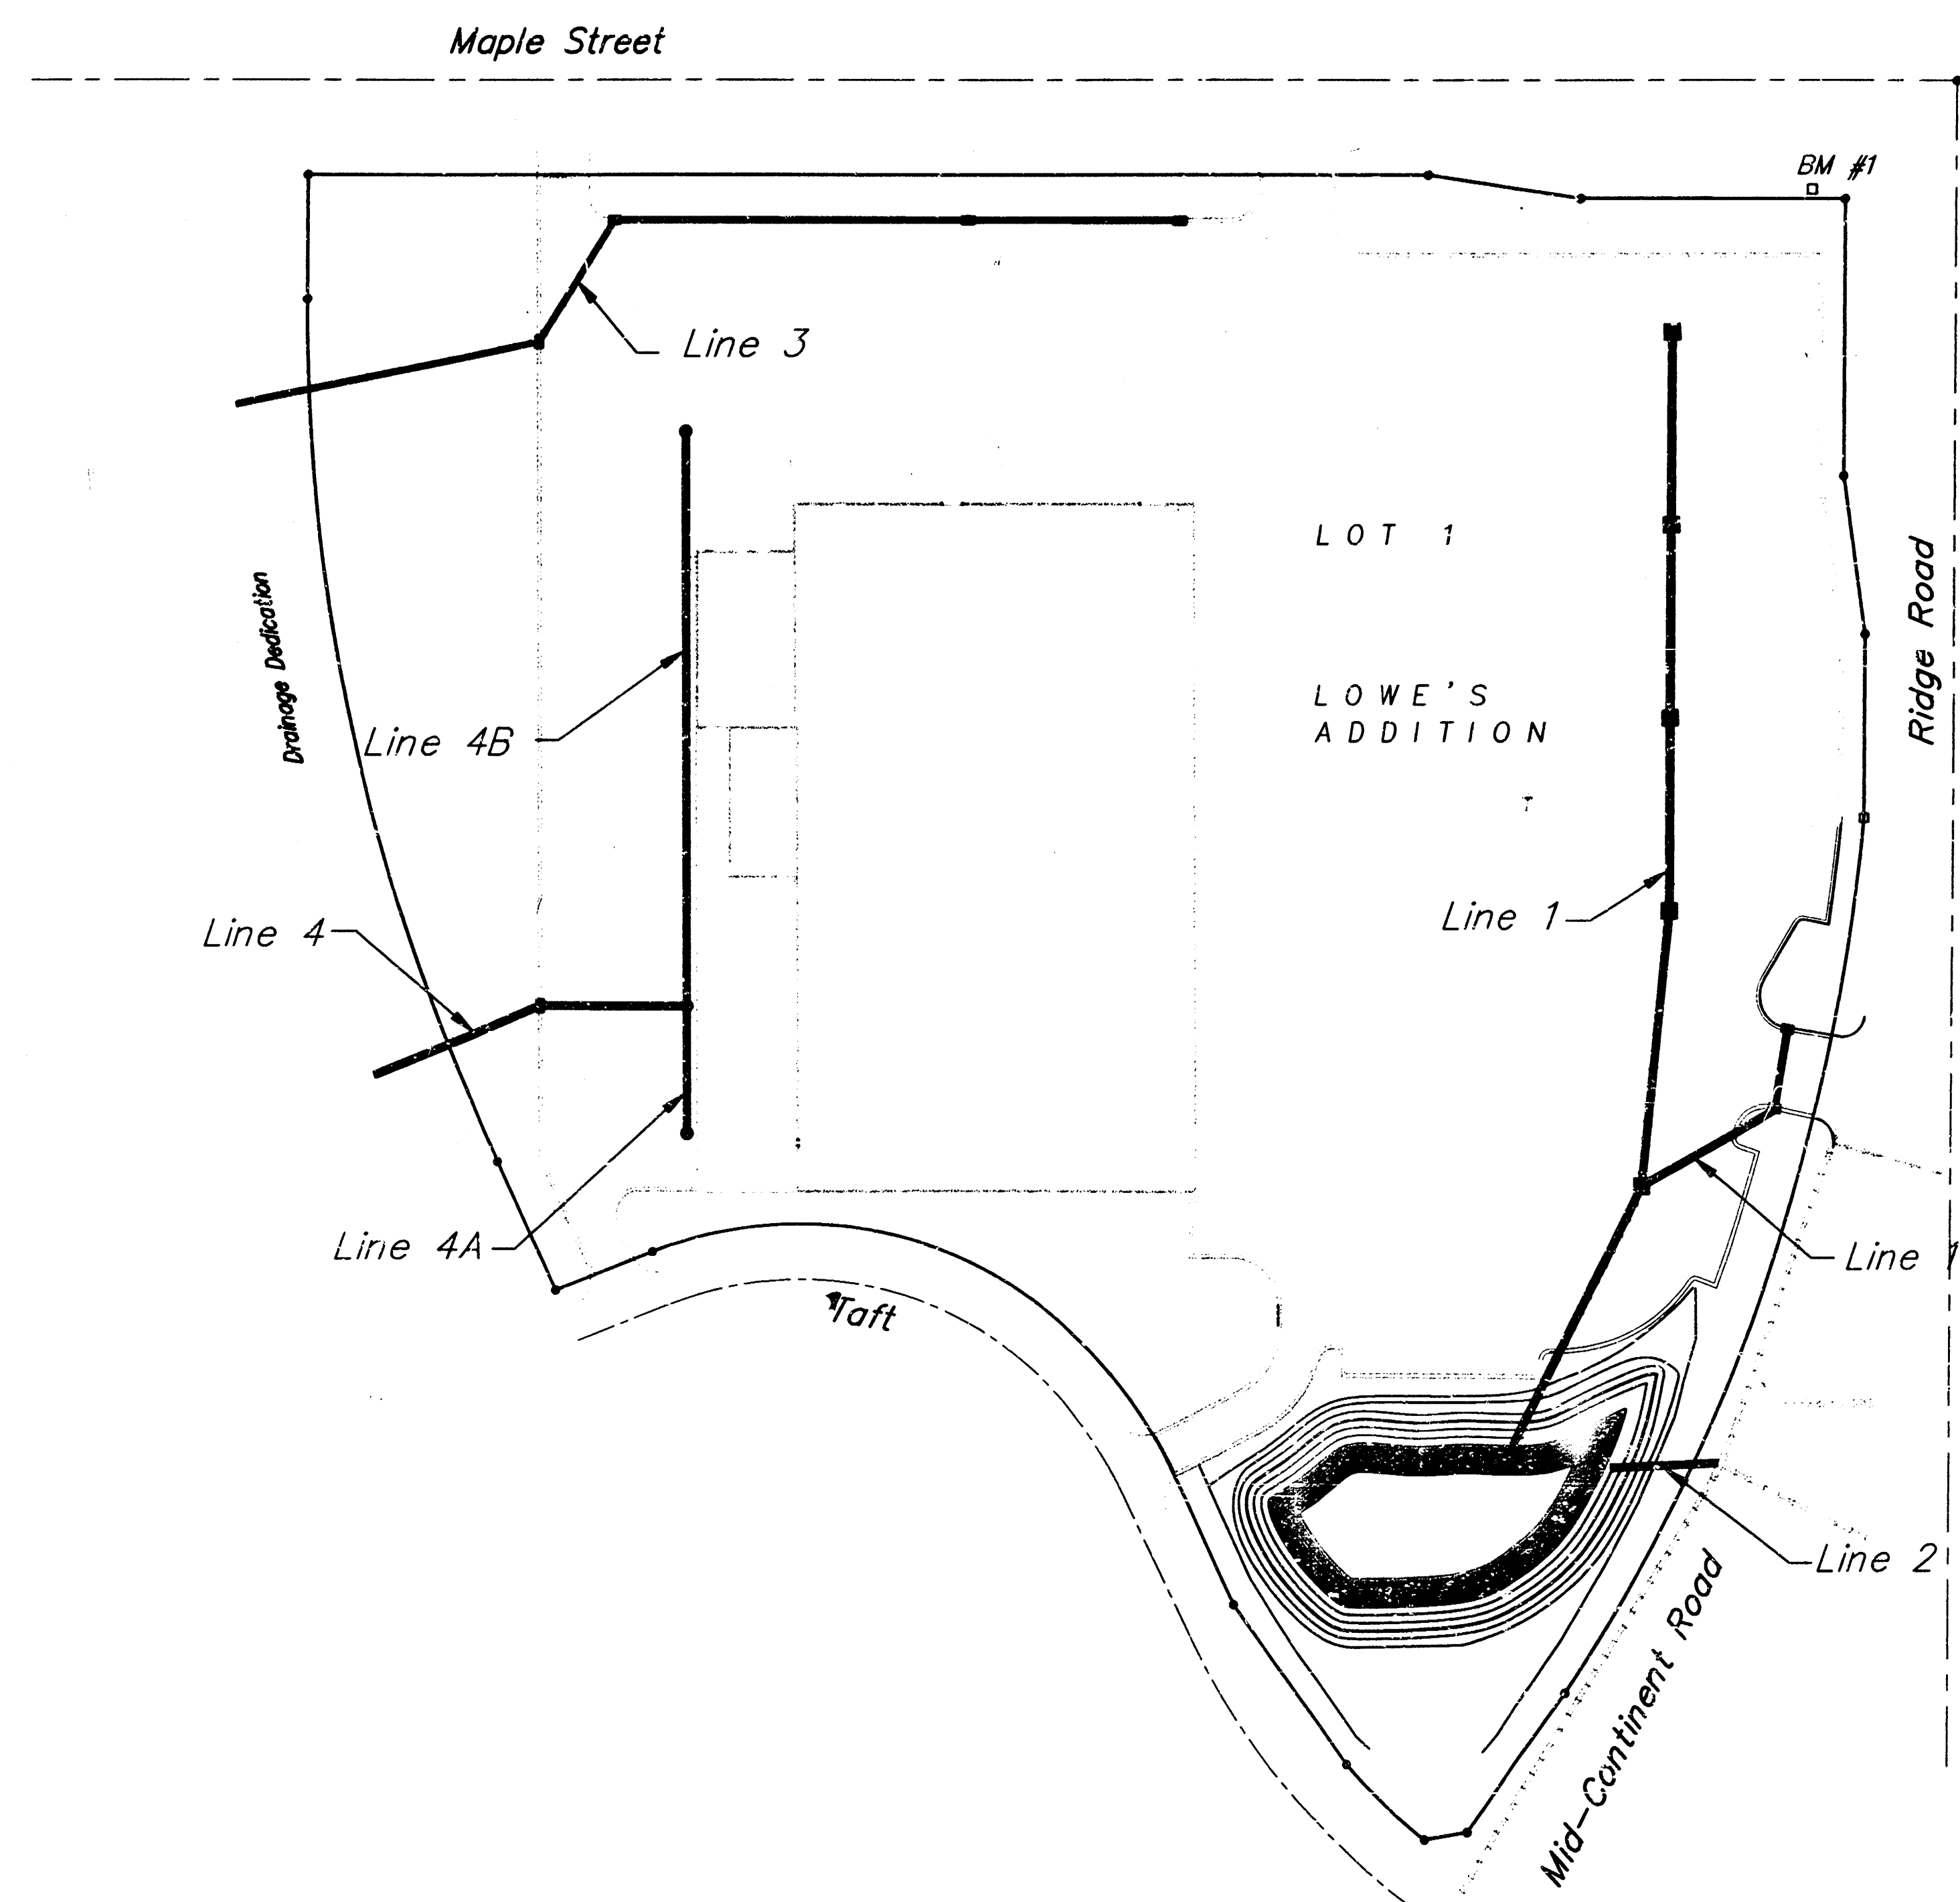

SCALE:
1" = 100'
• = Iron

BOOKED
7-23-98
MCS
D-397

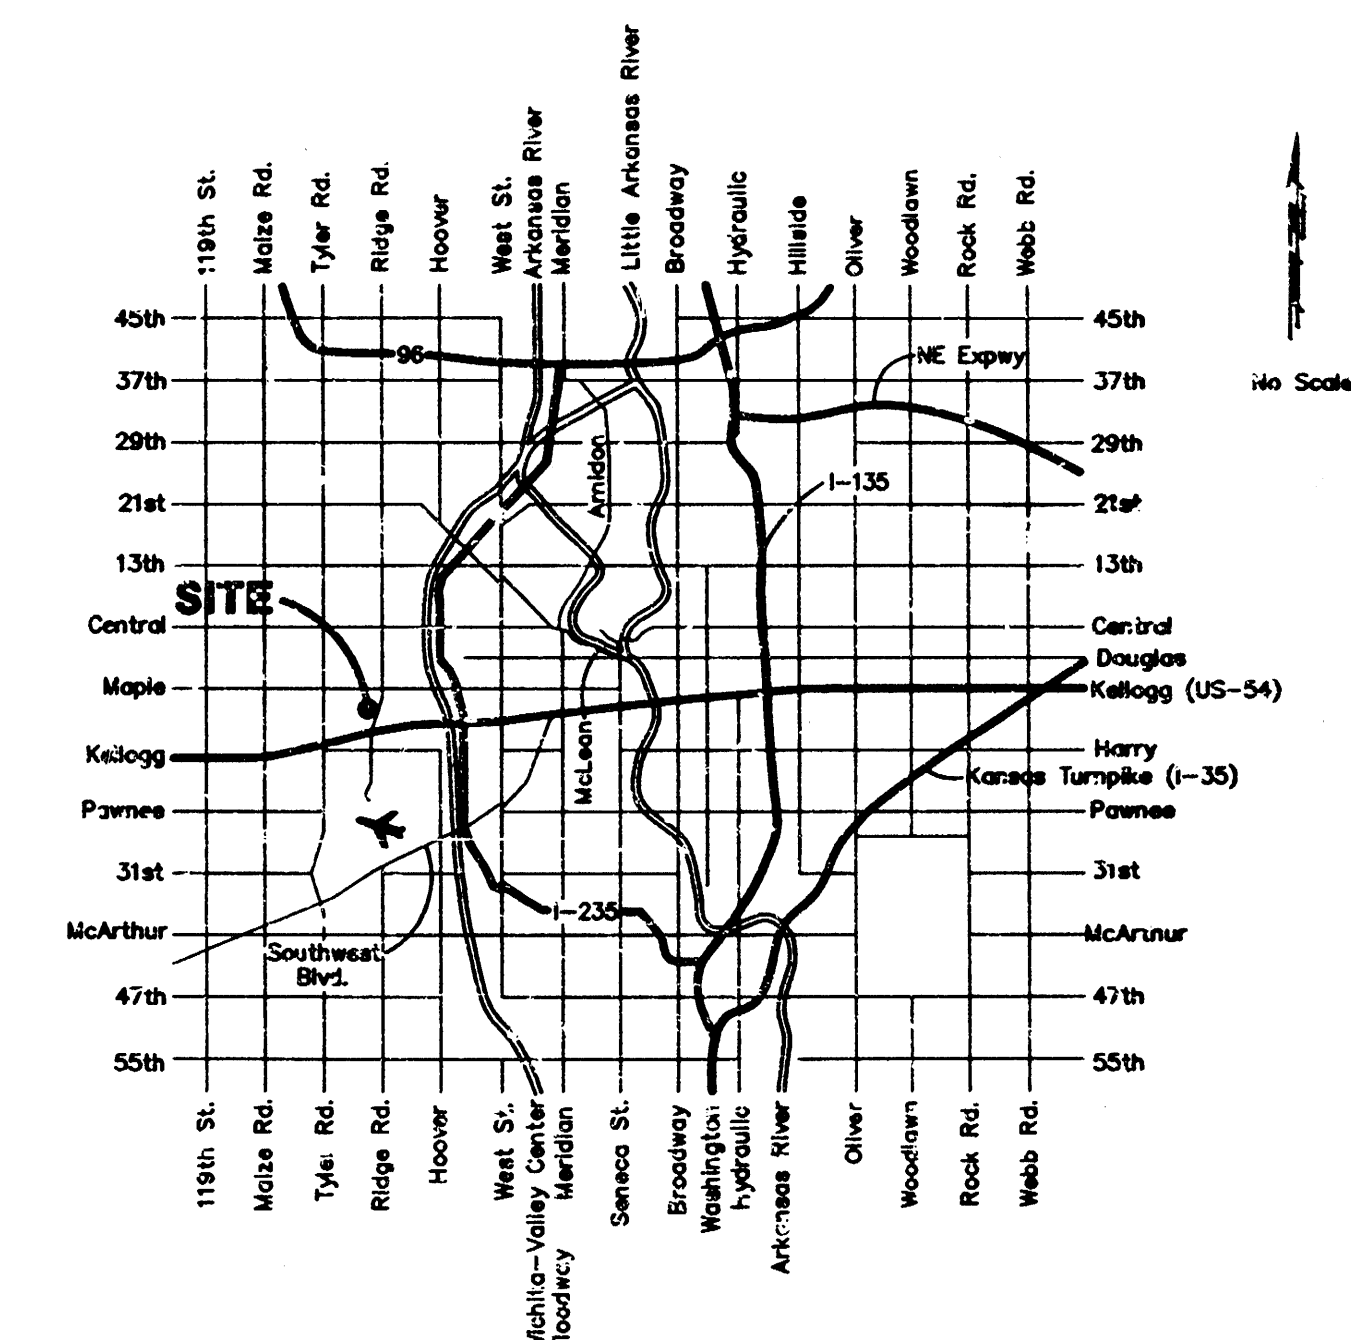

APPROVED AS NOTED
BY CITY ENGINEER OF WICHITA

Storm Sewers VRH 10/3/97

NOTE TO CONTRACTORS

Inspection and testing for this project is to be provided by a Licensed Consulting Engineering Firm under contract with the Owner/Developer. Said inspection to be in accordance with the City of Wichita standard construction engineering practices and certified by a Licensed Professional Engineer. No work shall be performed in dedicated easements or public right-of-way by the Contractor without such inspection nor shall any work be commenced without written authorization by the City Engineer. All Construction and Materials shall comply with the City of Wichita Specifications and Standards (on file and available in the City Engineer's Office).




PROJECT INSPECTED BY BAUGHMAN COMPANY P.A.
ASSET 112190 - BAUGHMAN CO.



BAUGHMAN COMPANY P.A.
ENGINEERING, SURVEYING, & PLANNING
2101 W. 24TH ST. • WICHITA, KANSAS 67203

[illegible]

Project: Lowe's			
Point statistics:			
	Starting point number:	1	
	Max point number used:	6025	
	Min point number used:	1	
	Current point number:	6026	
Point	Current Coordinate Listing (All)		Elevation
	Northing	Easting	
6001	4229.597	10173.040	137.00
6002	4183.037	10135.003	137.00
6003	4183.539	10107.615	123.00
6004	4138.649	10132.053	137.00
6005	4101.489	10085.077	123.00
6006	4101.480	10099.047	137.00
6007	4124.097	10056.263	123.00
6008	4076.021	10062.042	137.00
6009	4114.128	10017.939	123.00
6010	4070.037	10006.737	137.00
6011	4112.325	9977.869	123.00
6012	4069.567	9956.755	137.00
6013	4094.365	9935.555	137.00
6014	4126.963	9943.369	123.00
6015	4135.084	9885.788	137.00
6016	4182.020	9860.701	123.00
6017	4157.807	9929.225	123.00
6018	4210.801	9928.599	137.00
6019	4180.055	9962.181	123.00
6020	4224.006	9975.774	137.00
6021	4178.146	10002.074	123.00
6022	4227.877	10025.772	123.00
6023	4179.288	10042.039	123.00
6024	4229.827	10097.273	137.00
6025	4200.872	10142.670	137.00

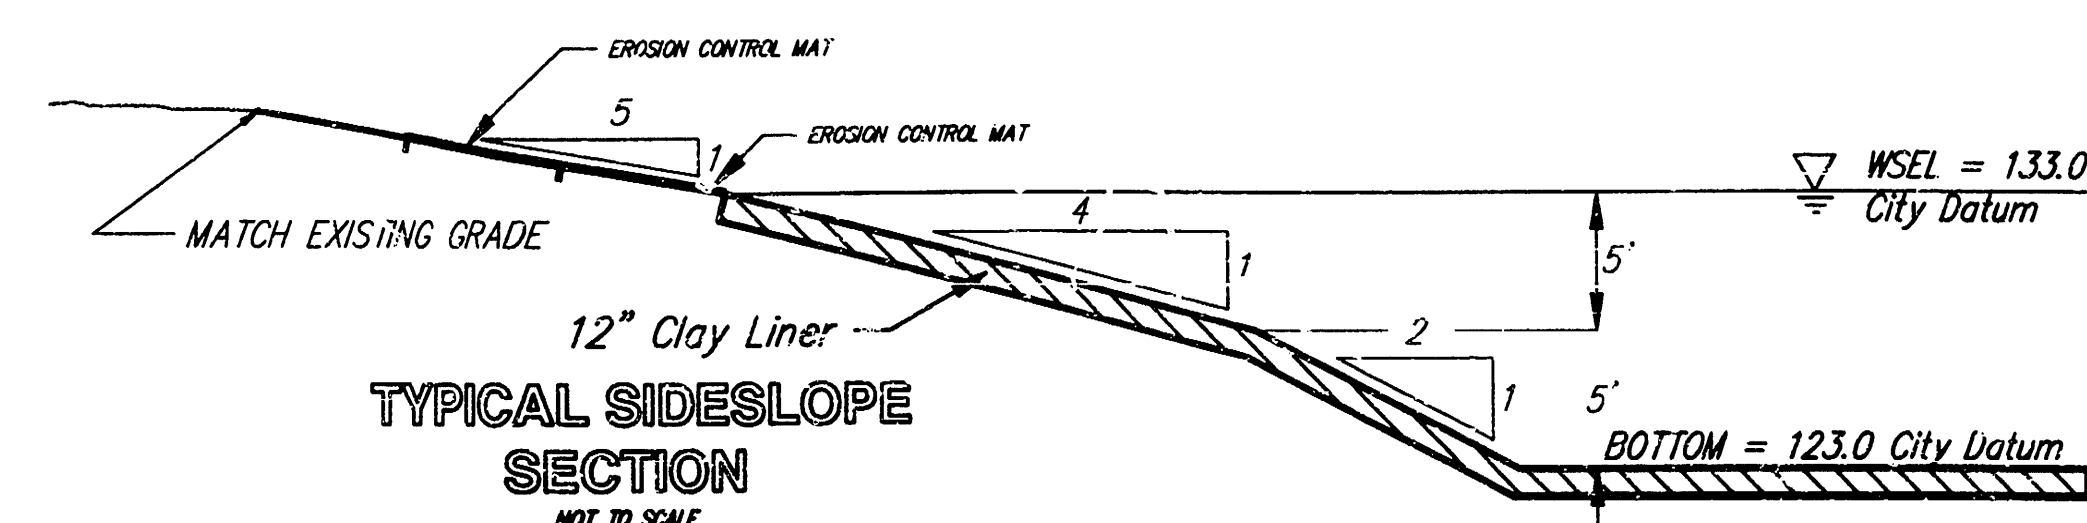

LOWE'S STORE POND PLAN				
 BAUGHMAN COMPANY P.A. ENGINEERING, SURVEYING, & PLANNING 316-262-7271 • 315 ELLIS • WICHITA, KANSAS 67211				
PROJECT NUMBER 740 PPS(607861)				
DESIGN	DR-WN	DATE	SCALE	SHEET
	2/80	10-97	NOTED	2
				12

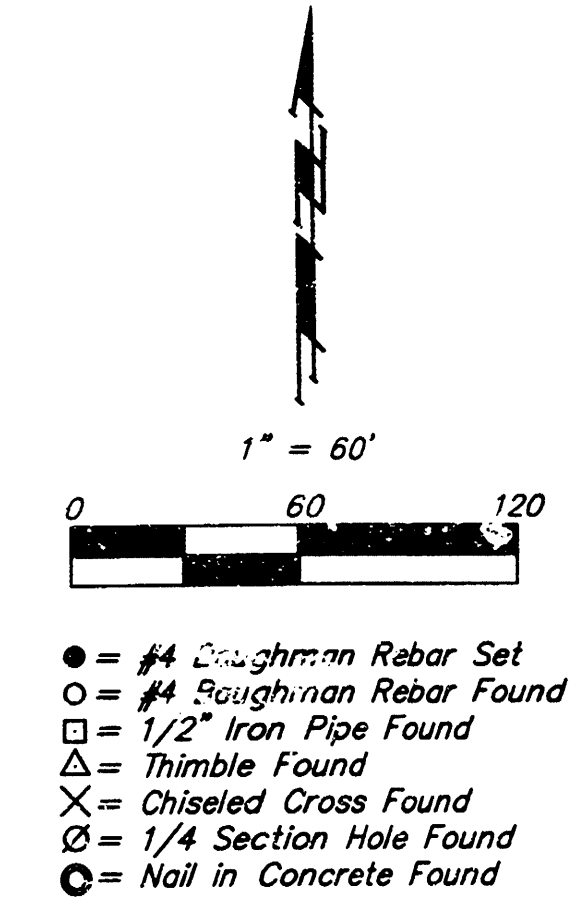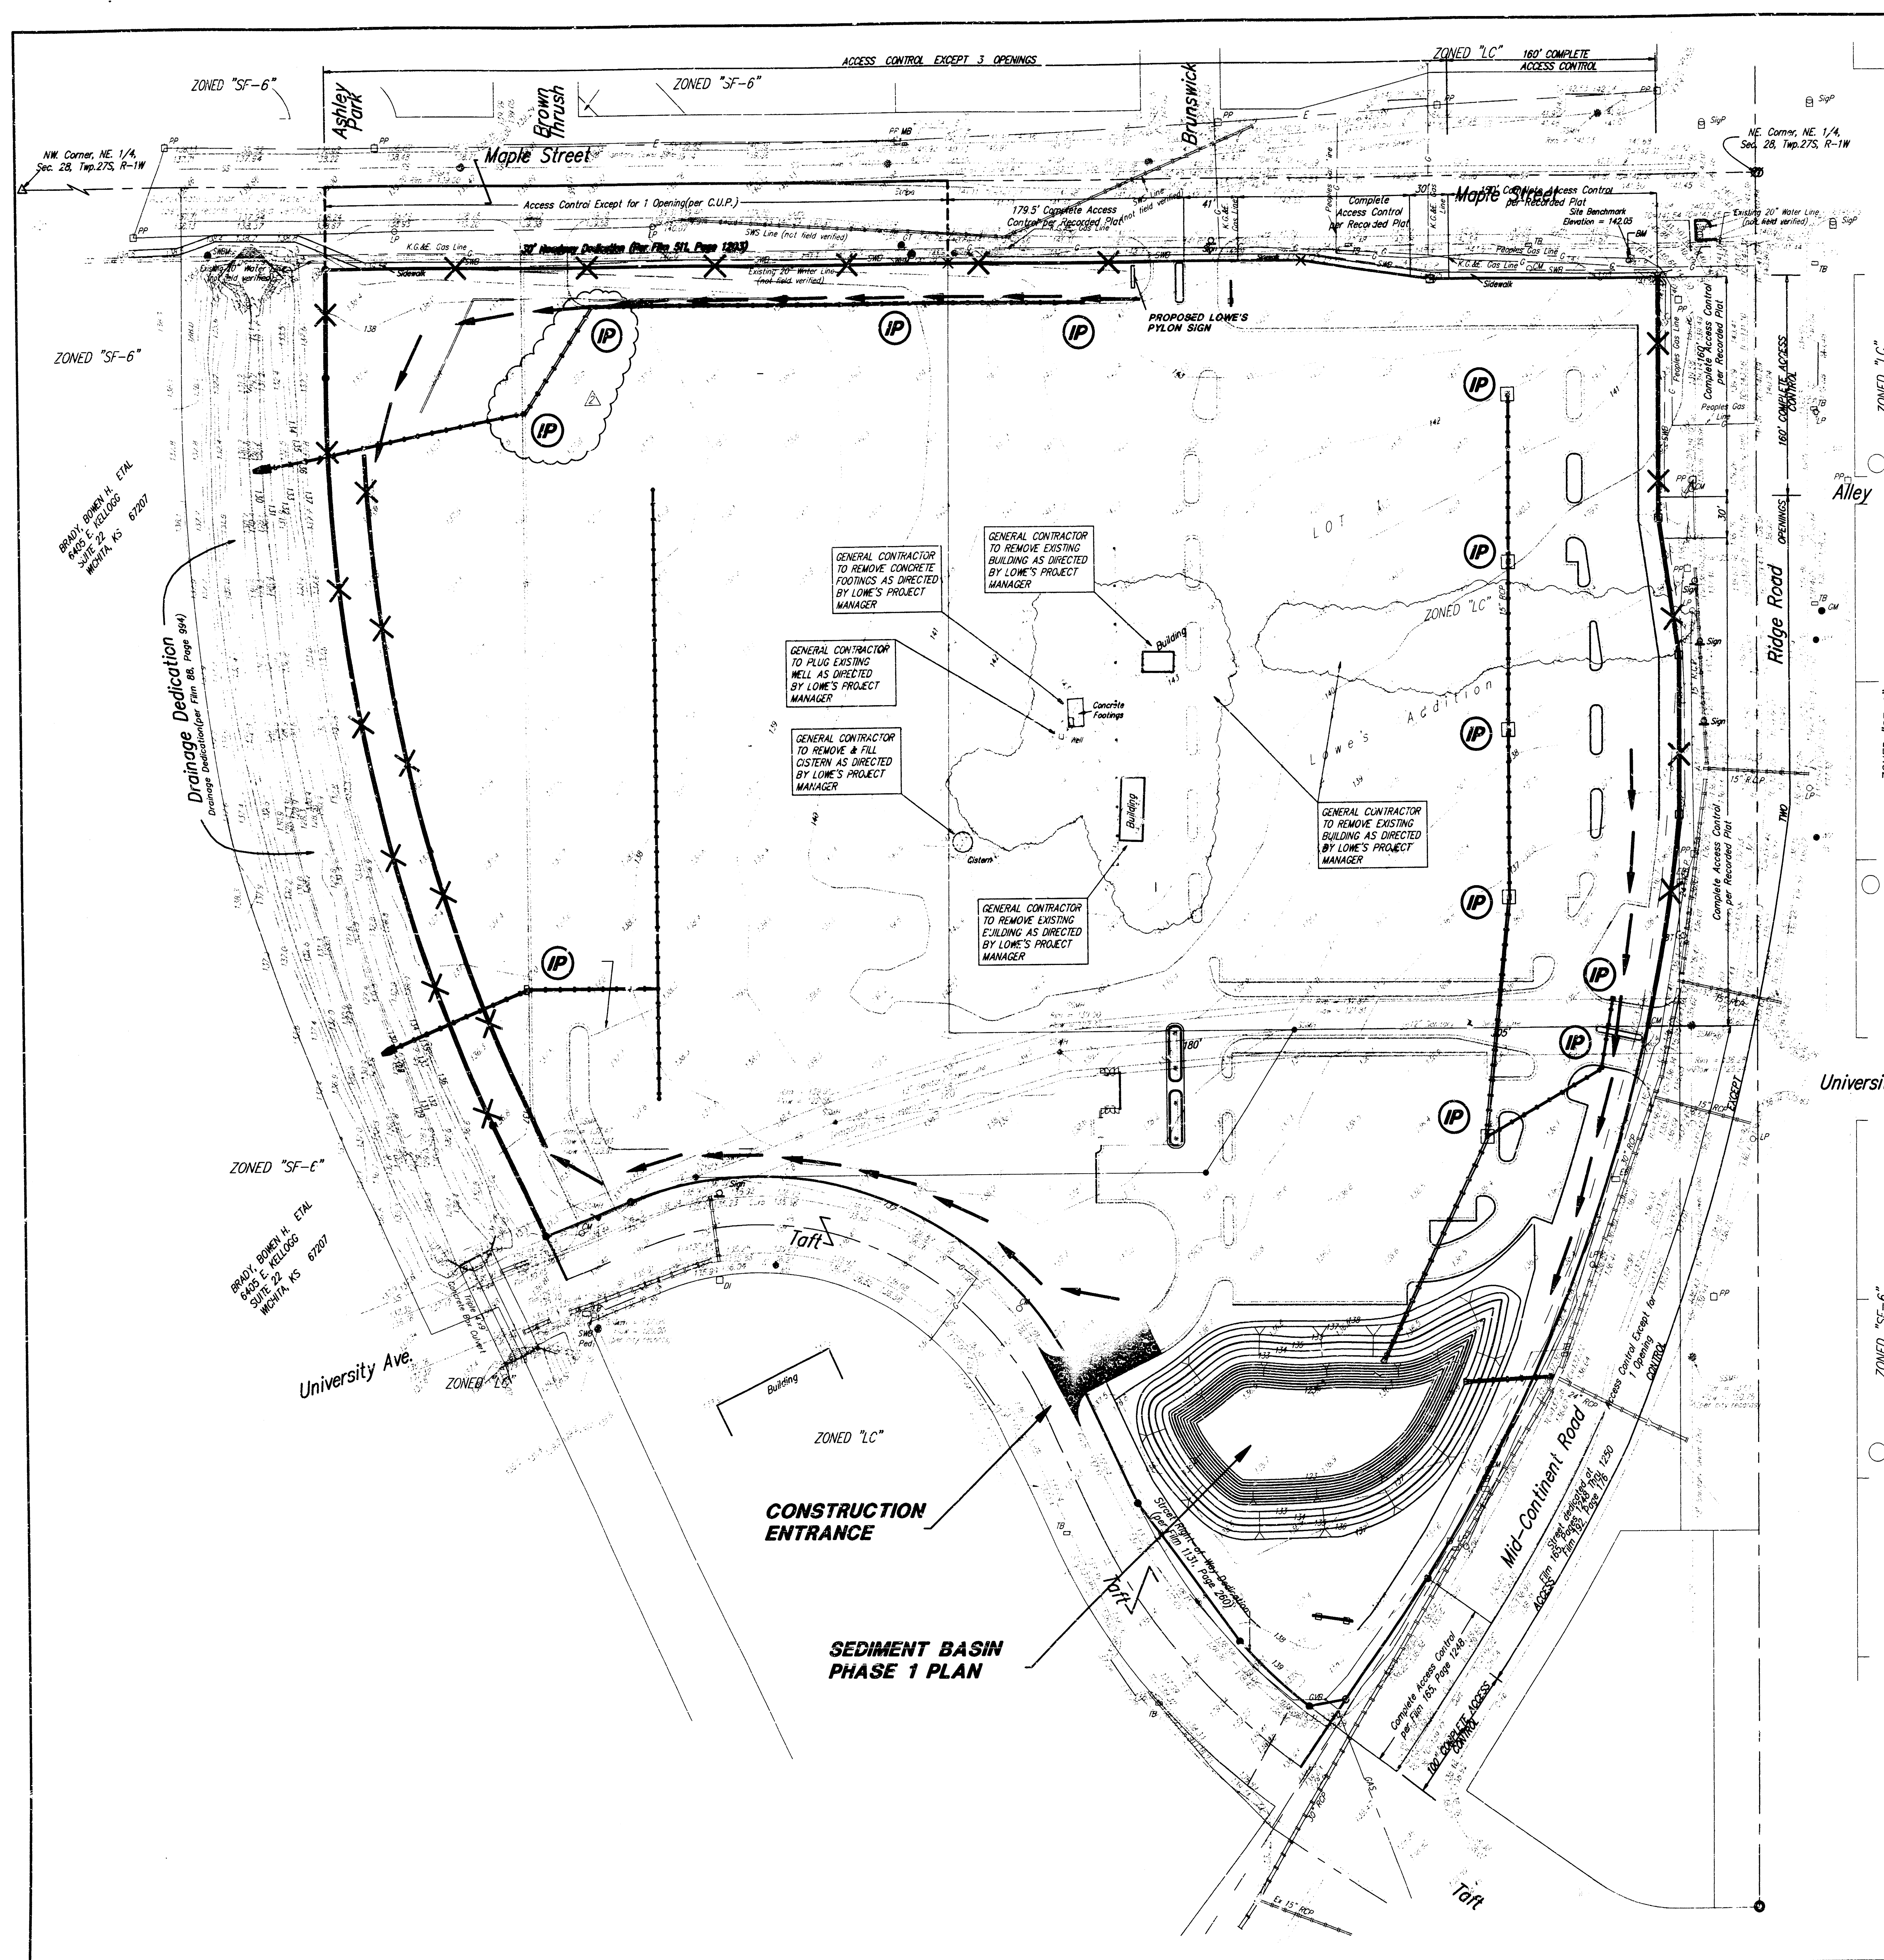

SYMBOL LEGEND:

- CM = Cable TV Marker
- DI = Drop Inlet
- EB = Electric Box
- TH = Fire Hydrant
- GM = Gas Meter
- GT = Gas Test
- GP = Gas Pile
- LP = Light Pole
- MB = Mail Box
- MW = Monitoring Well
- PP = Power Pole
- SP = Signal Pole
- Sign = Sign
- SSM = Sanitary Sewer Manhole
- SWM = Southwestern Bell Marker
- SWB Ped = Southwestern Bell Pedestal
- Tree = Tree
- TB = Traffic Box
- WM = Water Meter
- WV = Water Valve

- ✕ = Silt Fence
- = Diversion Dike
- IP = Inlet Protection

BENCHMARK:

○ BM:
City of Wichita Benchmark Disc - SW Corner of Intersection, 60' South and 97' West of Centerline of Ridge Road and Maple, 10.5' North of Face of Sidewalk.
ELEV. = 142.07 CITY DATUM

LEGAL DESCRIPTION:

Lot 1, Lowe's Addition, Wichita, Sedgewick County, Kansas.

LOCAL ADDRESS:

333 S. Ridge Road
Wichita, Kansas 67212

EROSION CONTROL NOTES

1. NO LAND CLEARING OR GRADING SHALL BEGIN UNTIL ALL APPLICABLE EROSION CONTROL MEASURES HAVE BEEN INSTALLED.
2. ALL EXPOSED AREAS SHALL BE SEEDED AS SPECIFIED WITHIN 30 DAYS OF FINAL GRADING.
3. SHOULD CONSTRUCTION STOP FOR LONGER THAN 15 DAYS, THE SITE SHALL BE SEEDED AS SPECIFIED.
4. MAINTAIN EROSION CONTROL MEASURES AFTER EACH RAIN AND AT LEAST ONCE A WEEK.
5. THIS PLAN SHALL NOT BE CONSIDERED AS INCLUSIVE AS THE CONTRACTOR SHALL TAKE ALL NECESSARY PRECAUTIONS TO PREVENT SOIL SEDIMENT FROM LEAVING THE SITE.
6. CONTRACTOR SHALL COMPLY WITH ALL STATE AND LOCAL ORDINANCES THAT APPLY.
7. ADDITIONAL EROSION AND SEDIMENT CONTROL MEASURES WILL BE INSTALLED IF DEEMED NECESSARY BY ON SITE INSPECTION TO DO SO HAS BEEN RECEIVED BY GOVERNING AUTHORITIES.
8. LAND DISTURBING ACTIVITIES SHALL NOT COMMENCE UNTIL APPROVAL TO DO SO HAS BEEN RECEIVED BY GOVERNING AUTHORITIES.
9. IF INSTALLATION OF STORM DRAINAGE SYSTEM SHOULD BE INTERRUPTED BY WEATHER OR NIGHTFALL, THE PIPE ENDS SHALL BE COVERED WITH FILTER FABRIC.
10. ALL EXISTING STRUCTURES, FENCING, TREES, AND ETC. WITHIN CONSTRUCTION AREA SHALL BE REMOVED AND DISPOSED OF OFF SITE. ANY BURNING ON SITE SHALL BE SUBJECT TO LOCAL ORDINANCES AND LOWE'S SPECIFICATIONS.
11. CONTRACTOR SHALL BE RESPONSIBLE TO TAKE WHATEVER MEANS NECESSARY TO ESTABLISH PERMANENT SOIL STABILIZATION.
12. ALL EROSION CONTROL MEASURES ARE PER LOWE'S DETAILS.

CONSTRUCTION NOTES:

1. AFTER PERMITS HAVE BEEN OBTAINED & EROSION CONTROL MEASURES INSTALLED, THE CONTRACTOR SHALL GRADE BUILDING PAD, GARDEN CENTER & APRONS TO 0.1' ± OF SUBGRADE AS PER DIVISION 2 COMPACTION SPECIFICATIONS.
2. IMMEDIATELY APPLY & COMPACT STONE BASE FOR BUILDING PAD TO 1 1/2" OF CONCRETE SUBGRADE AS PER DIVISION 2 SPECIFICATIONS. STONE SHALL BE APPLIED PRIOR TO EXCAVATING INTERIOR & PERIMETER FOOTINGS.
3. COMPACT & MAINTAIN 30,000 SQ. FT. OF 4" THICK STONE MATERIAL LAYDOWN AREA & 25' WIDE GRAVEL ACCESS ROAD TO BUILDING. LAYDOWN AREA TO BE LOCATED BY ONE'S PROJECT MANAGER.

GENERAL NOTES

1. Contractor will be required to provide notice to utility companies a minimum of twenty-four (24) hours prior to any excavation, as follows:
Kansas One-Call 687-2470
The Contractor must notify the following in case of an emergency:
Cablevision 262-4270
K.P.L. Gas Service Company 383-8650
Kansas Gas & Electric Company 383-8600
Southwestern Bell Telephone Company 1-571-2611
City of Wichita Sewer Maintenance 268-4071
2. Exist. utilities and their locations, as shown on the plans, represent the best information obtainable for design. Location information has been obtained from the various utility companies and is either from company record drawings or company-provided field locations. The Contractor will be required to work around existing utilities which do not conflict with proposed construction.
3. Traffic affected by the construction on this project shall be handled in accordance with the latest edition of the Manual on Uniform Traffic Control Devices.
4. The Contractor to verify utility locations prior to construction of this project.
5. All disturbed areas shall be seeded with Kansas Premium Rescue Blend at the rate of 140 lbs. per acre. Fertilizer (16-20-6) shall be applied at the rate of 170 lbs. per acre.
6. Signing and striping shall be installed in accordance with City of Wichita Specifications and Codes. Striping shall be painted markings in accordance with the latest edition of the Standard Specifications for State Road and Bridge Construction by the Kansas Department of Transportation.
7. Contractor to remove and replace existing sidewalk in conflict of construction of entrance drives. Remove sidewalk at nearest expansion joint for a clean and smooth edge connection.
8. All trees and shrubs in direct conflict with construction shall be removed.

REVISION: Per Lowe's Comments BLG Sep. 17, 1997

LOWE'S COMPANIES, INC.
SWPPP & CLRG.
SW CORNER - MAPLE AND RIDGE

BAUGHMAN COMPANY P.A.
ENGINEERING, SURVEYING, & PLANNING
316-262-7271 • 315 ELLIS • WICHITA, KANSAS 67211

PROJECT NUMBER
740 PPS(607861)


DESIGN: NWJ/JLR DRAWN: JLL APPROVED: NWJ DATE: 9-30-97 SCALE: 1"=60'

SHEET
OF
12


BENCHMARK:
City of Wichita Benchmark Disk -
S.W. Corner of Intersection, 69'
South & 97' West of G Ridge
Road and Maple, 10.5' North of
Face of Sidewalk.
Elev. = 142.07 City Datum

LOT 1
LOWE'S
ADDITION

SCALE:
1" = 20' HORIZONTAL
1" = 5' VERTICAL

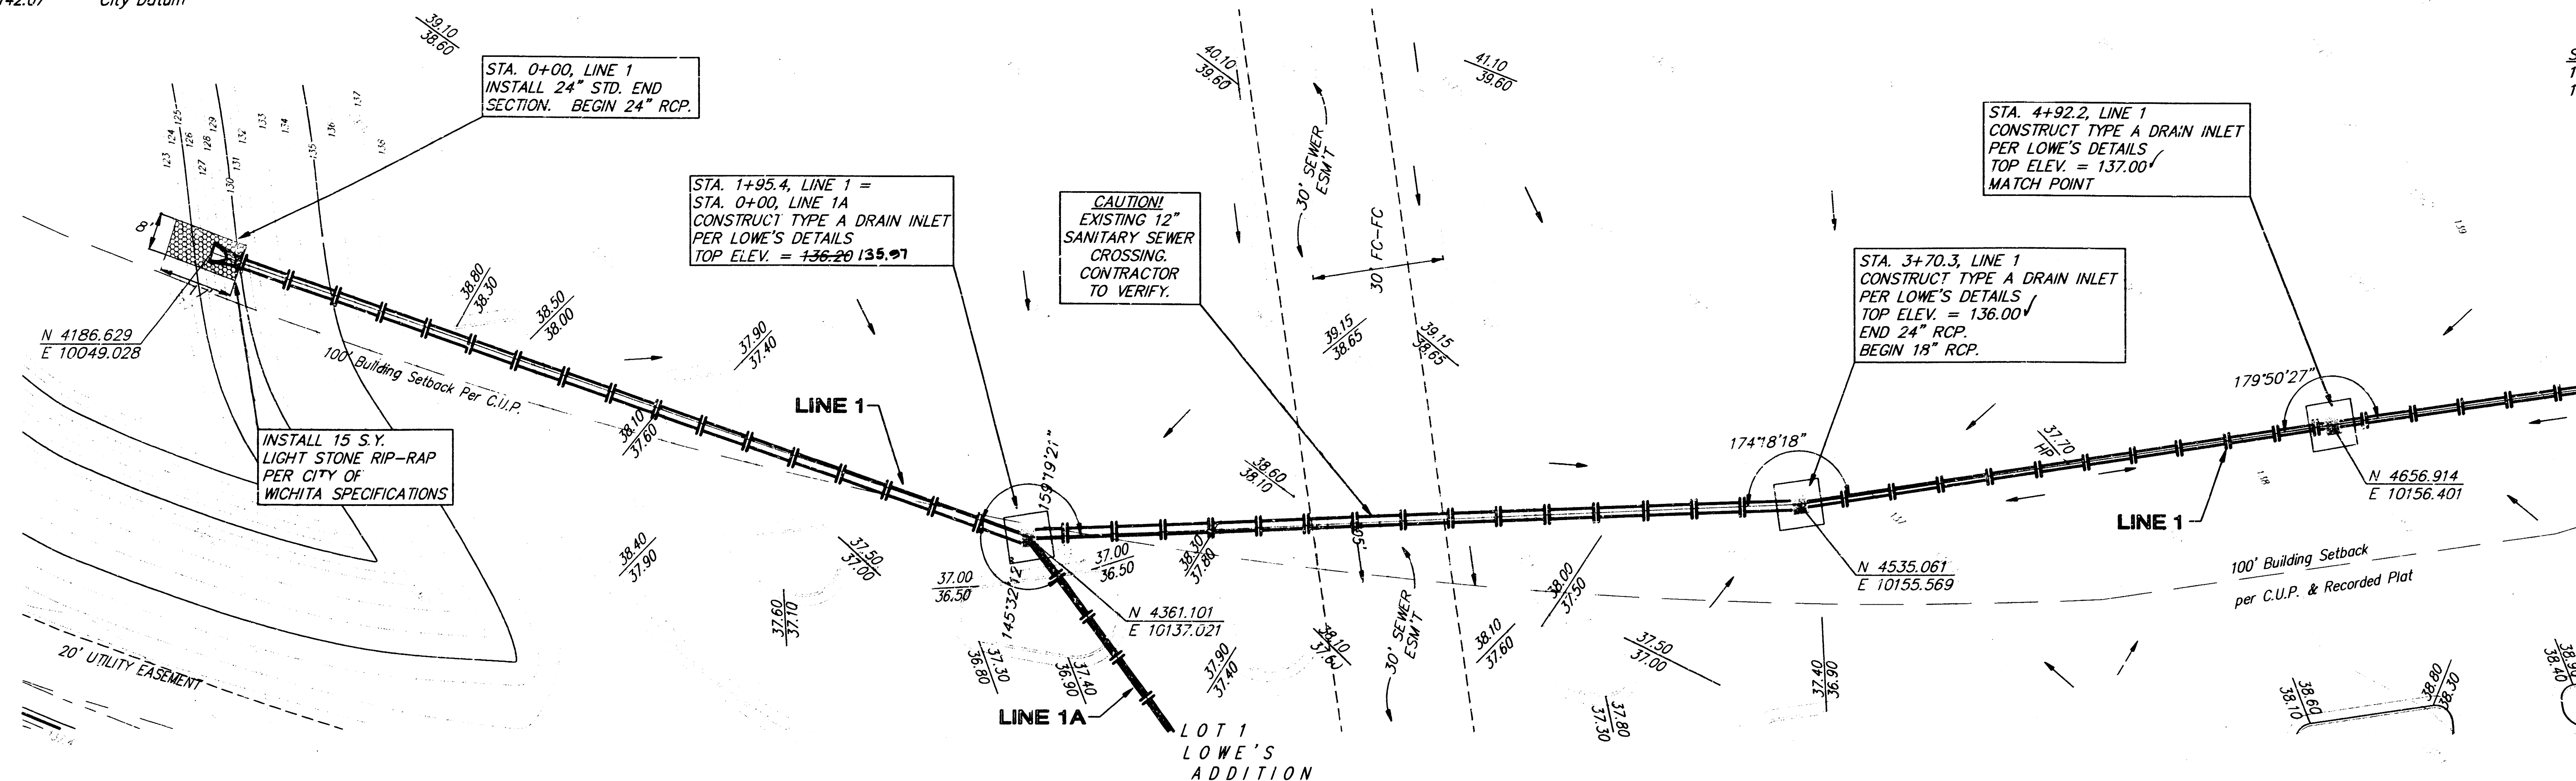


REVISION: Per C.O.W. Comments BLC Oct. 2, 1997

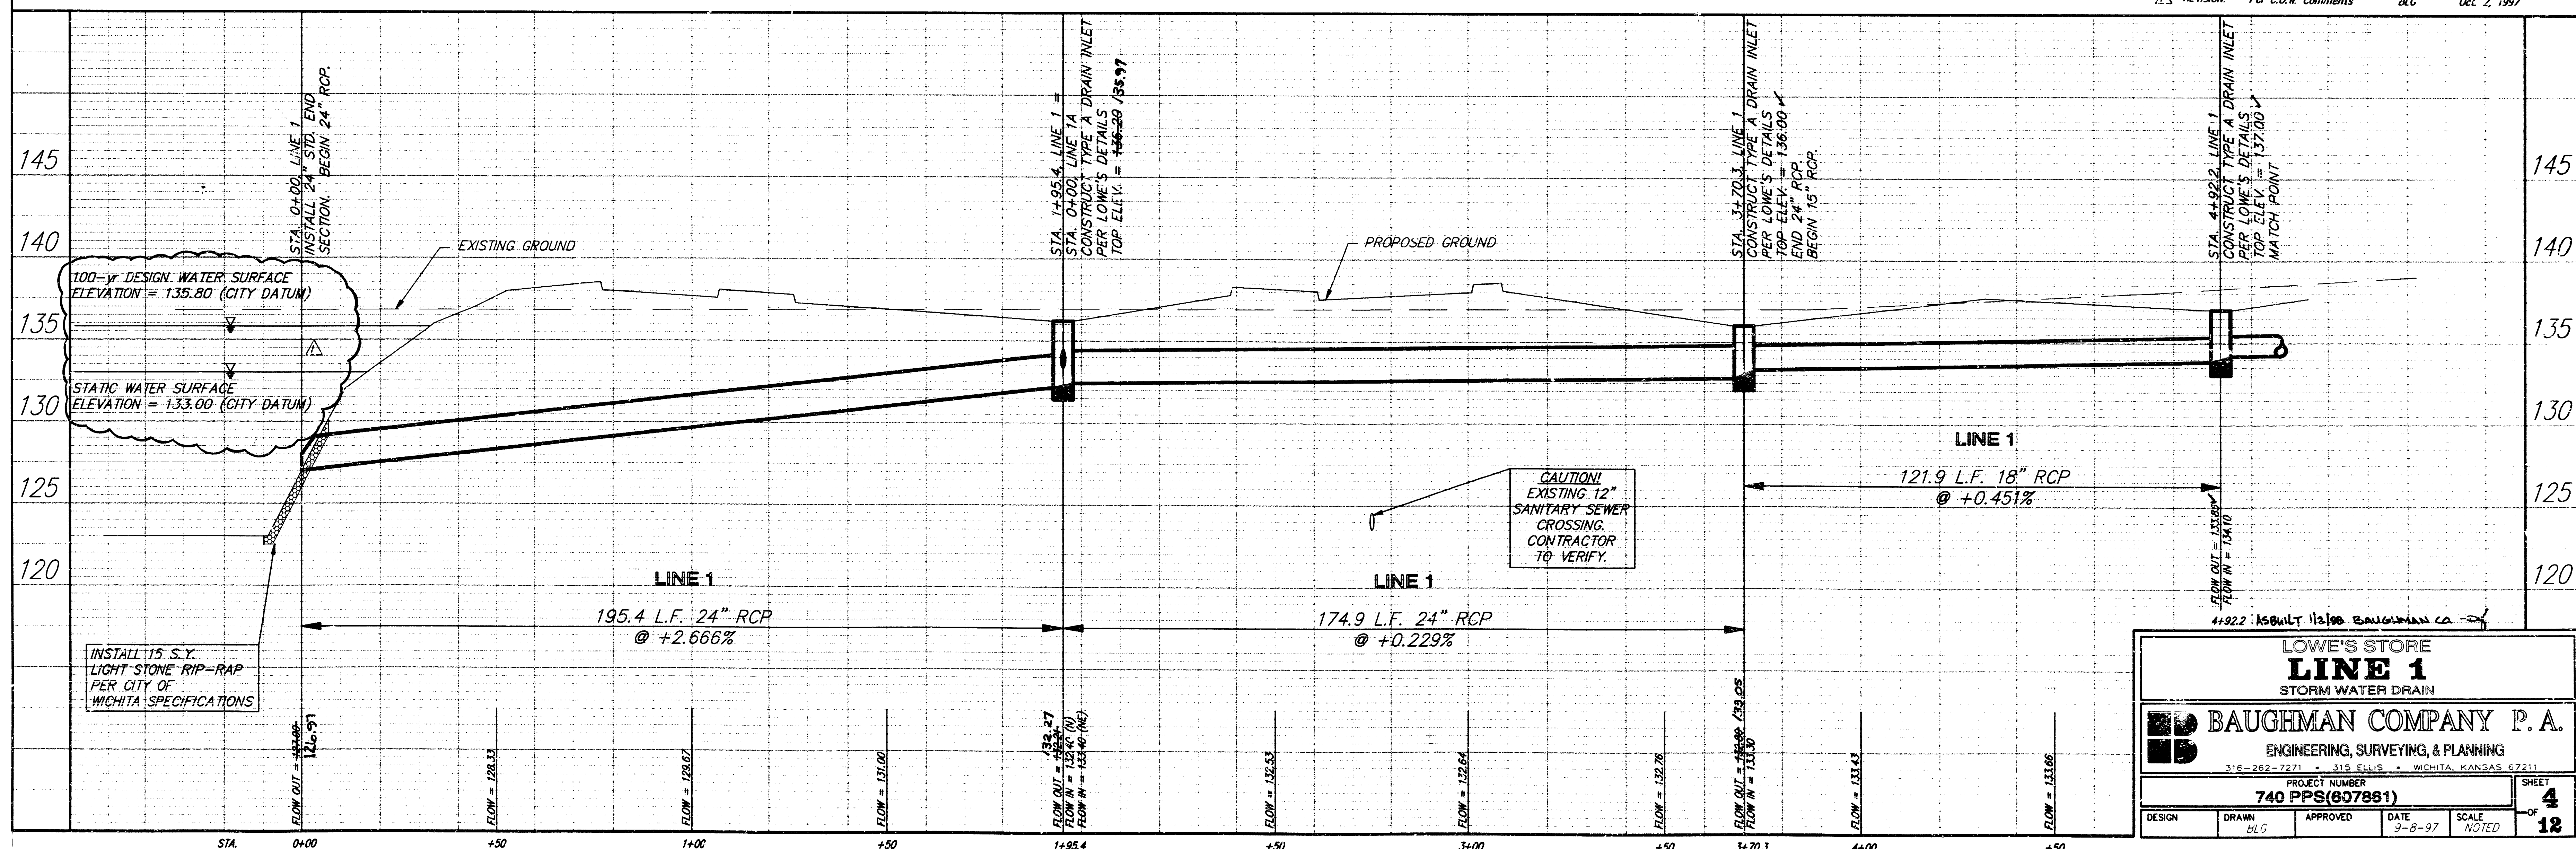


LOWE'S STORE LINE 1 STORM WATER DRAIN			
BAUGHMAN COMPANY P. A. ENGINEERING, SURVEYING, & PLANNING			
PROJECT NUMBER 740 PPS(607881)			
DESIGN	DRAWN	APPROVED	DATE
BLC	BLC		3-8-97
SCALE			NOTED
SHEET			4
OF			12

BENCHMARK:
City of Wichita Benchmark Disc
SW corner of intersection, 69' South
and 97' West of Centerline of
Ridge Road and Maple,
10.5' North of Face of Sidewalk.
ELEVATION = 142.07 CITY DATUM

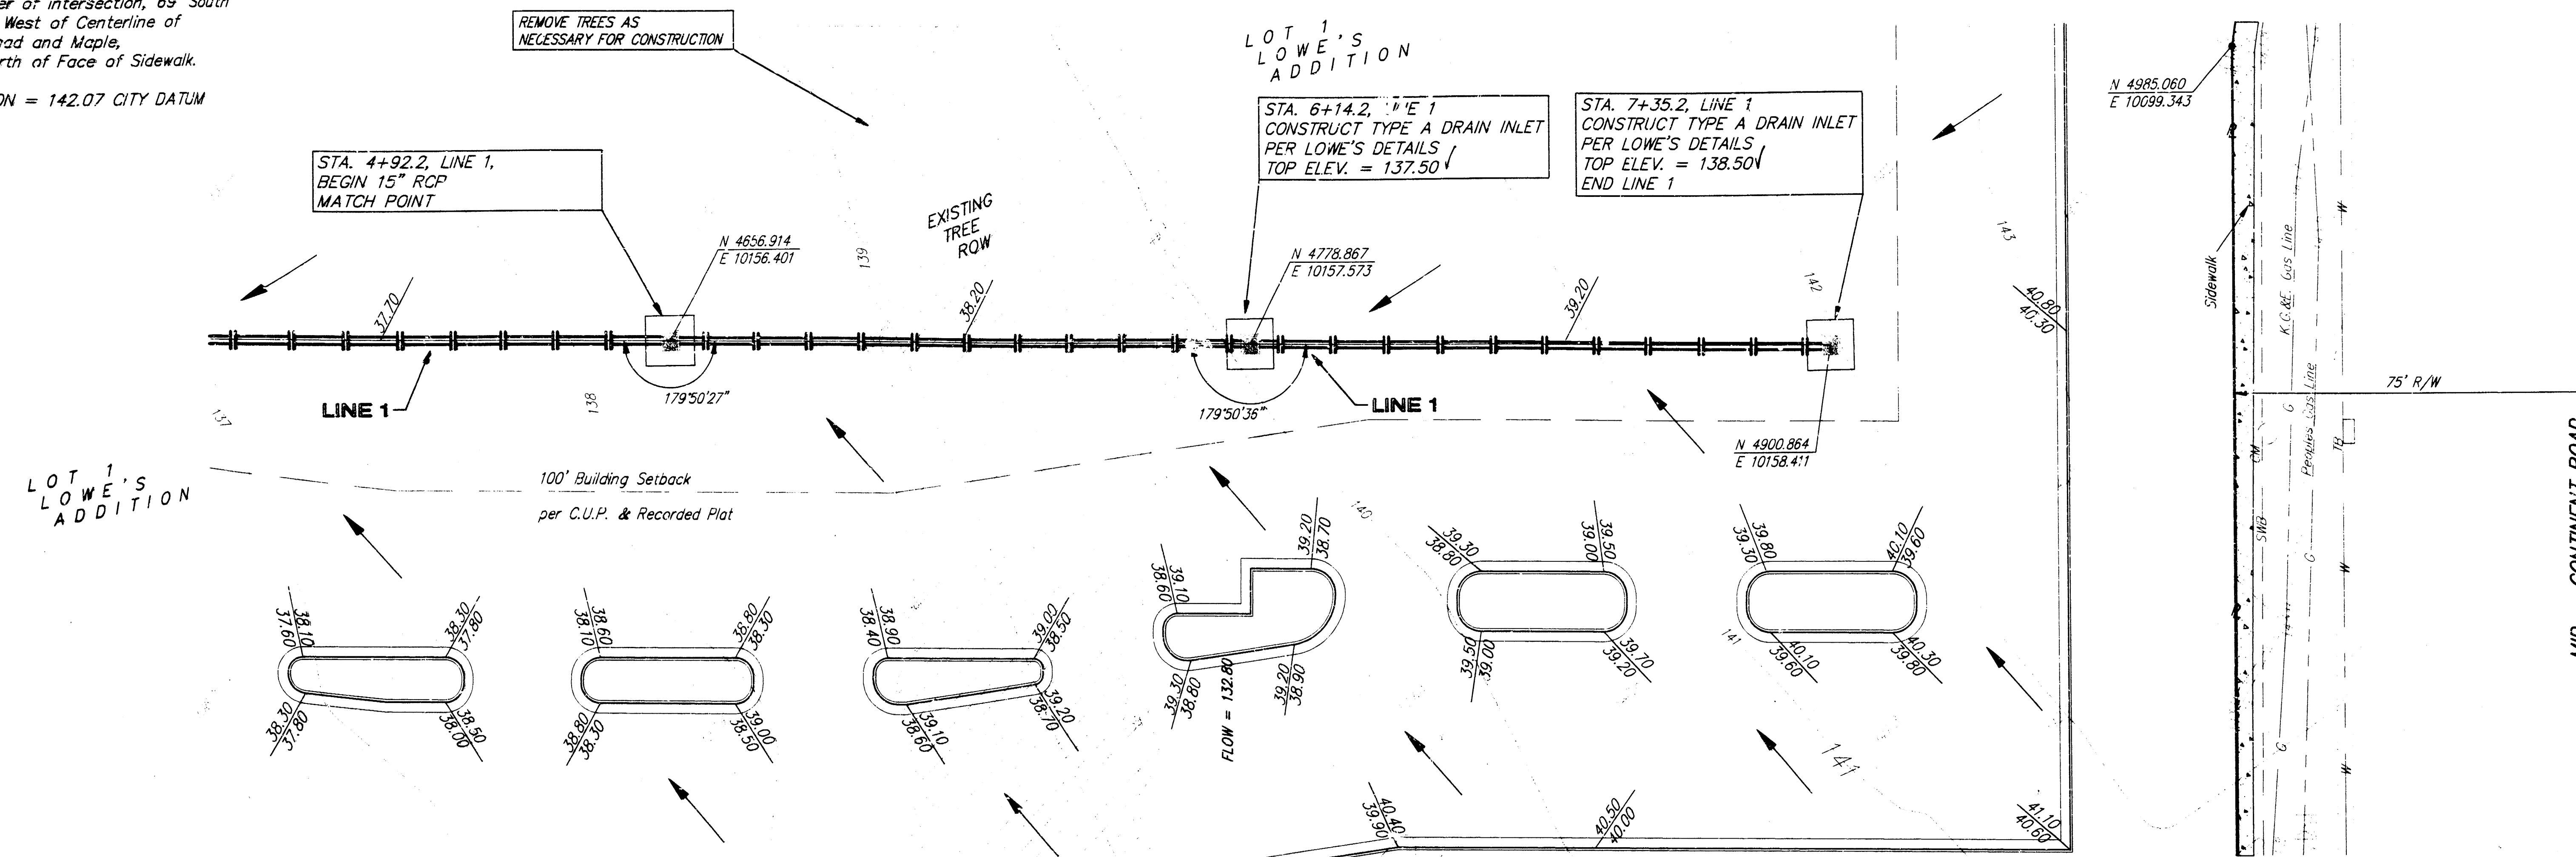



1" = 20' HORIZONTAL
1" = 5' VERTICAL
• = IRON

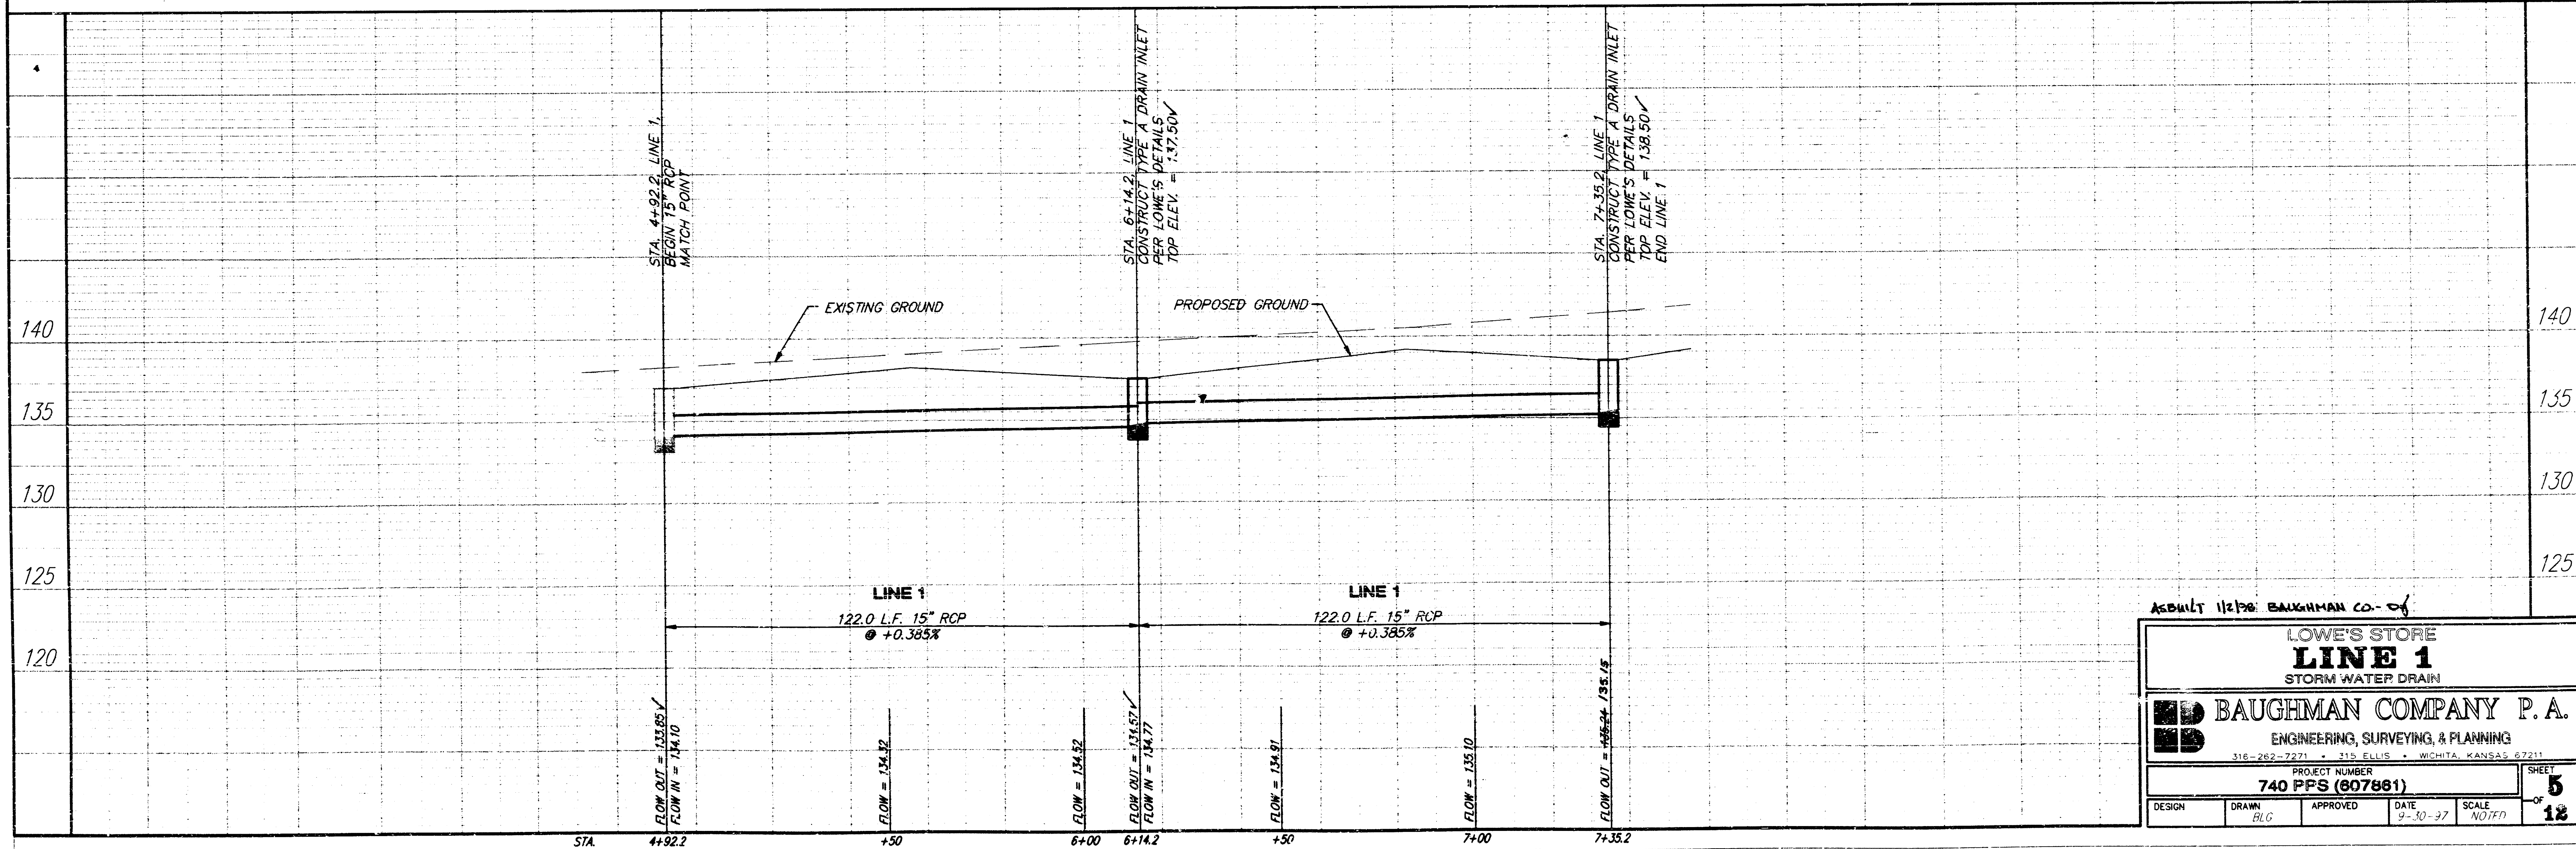


ASBUILT 11/2/00: BAUGHMAN CO. - OK

LOWE'S STORE LINE 1 STORM WATER DRAIN			
BAUGHMAN COMPANY P. A. ENGINEERING, SURVEYING, & PLANNING 316-262-7271 • 315 ELLIS • WICHITA, KANSAS 67211			
PROJECT NUMBER		SHEET	
740 PPS (807881)		5	
DESIGN	DRAWN	APPROVED	DATE
	RLG		9-30-97
SCALE		NOTED	
		12	

BENCHMARK:
City of Wichita Benchmark Disc
SW corner of intersection, 69' South
and 97' West of Centerline of
Ridge Road and Maple,
10.5' North of Face of Sidewalk.
ELEVATION = 142.07 CITY DATUM

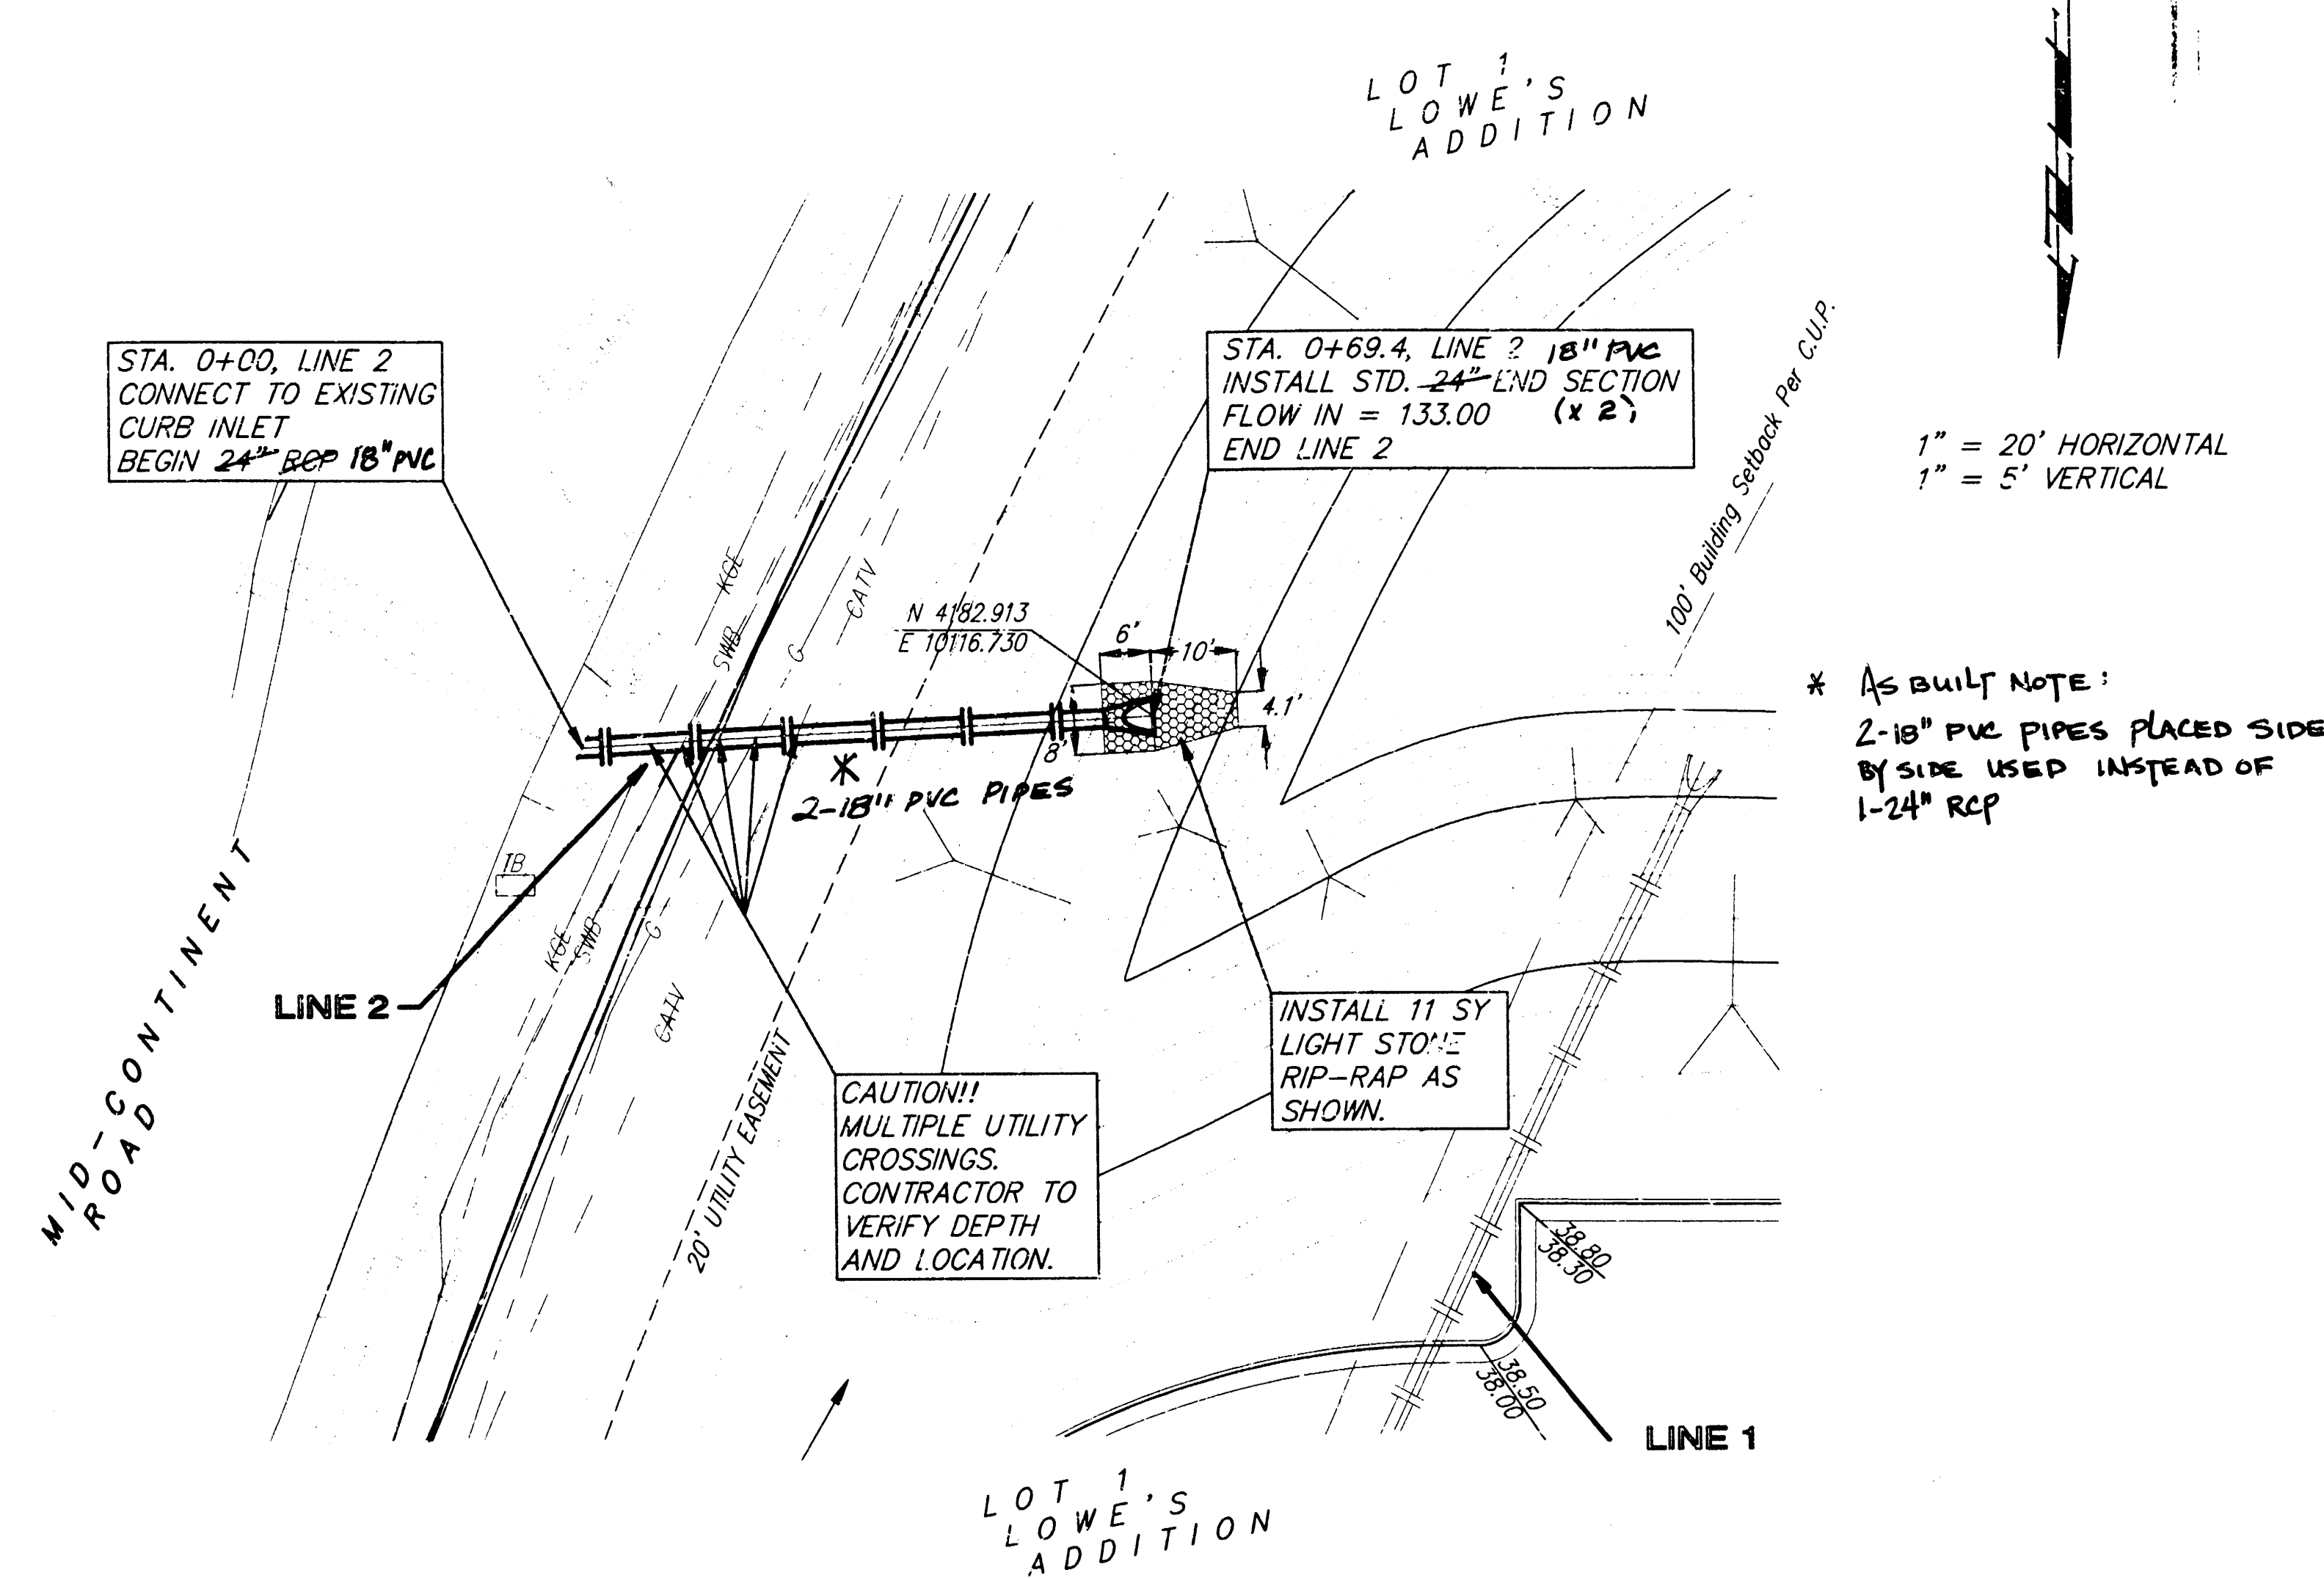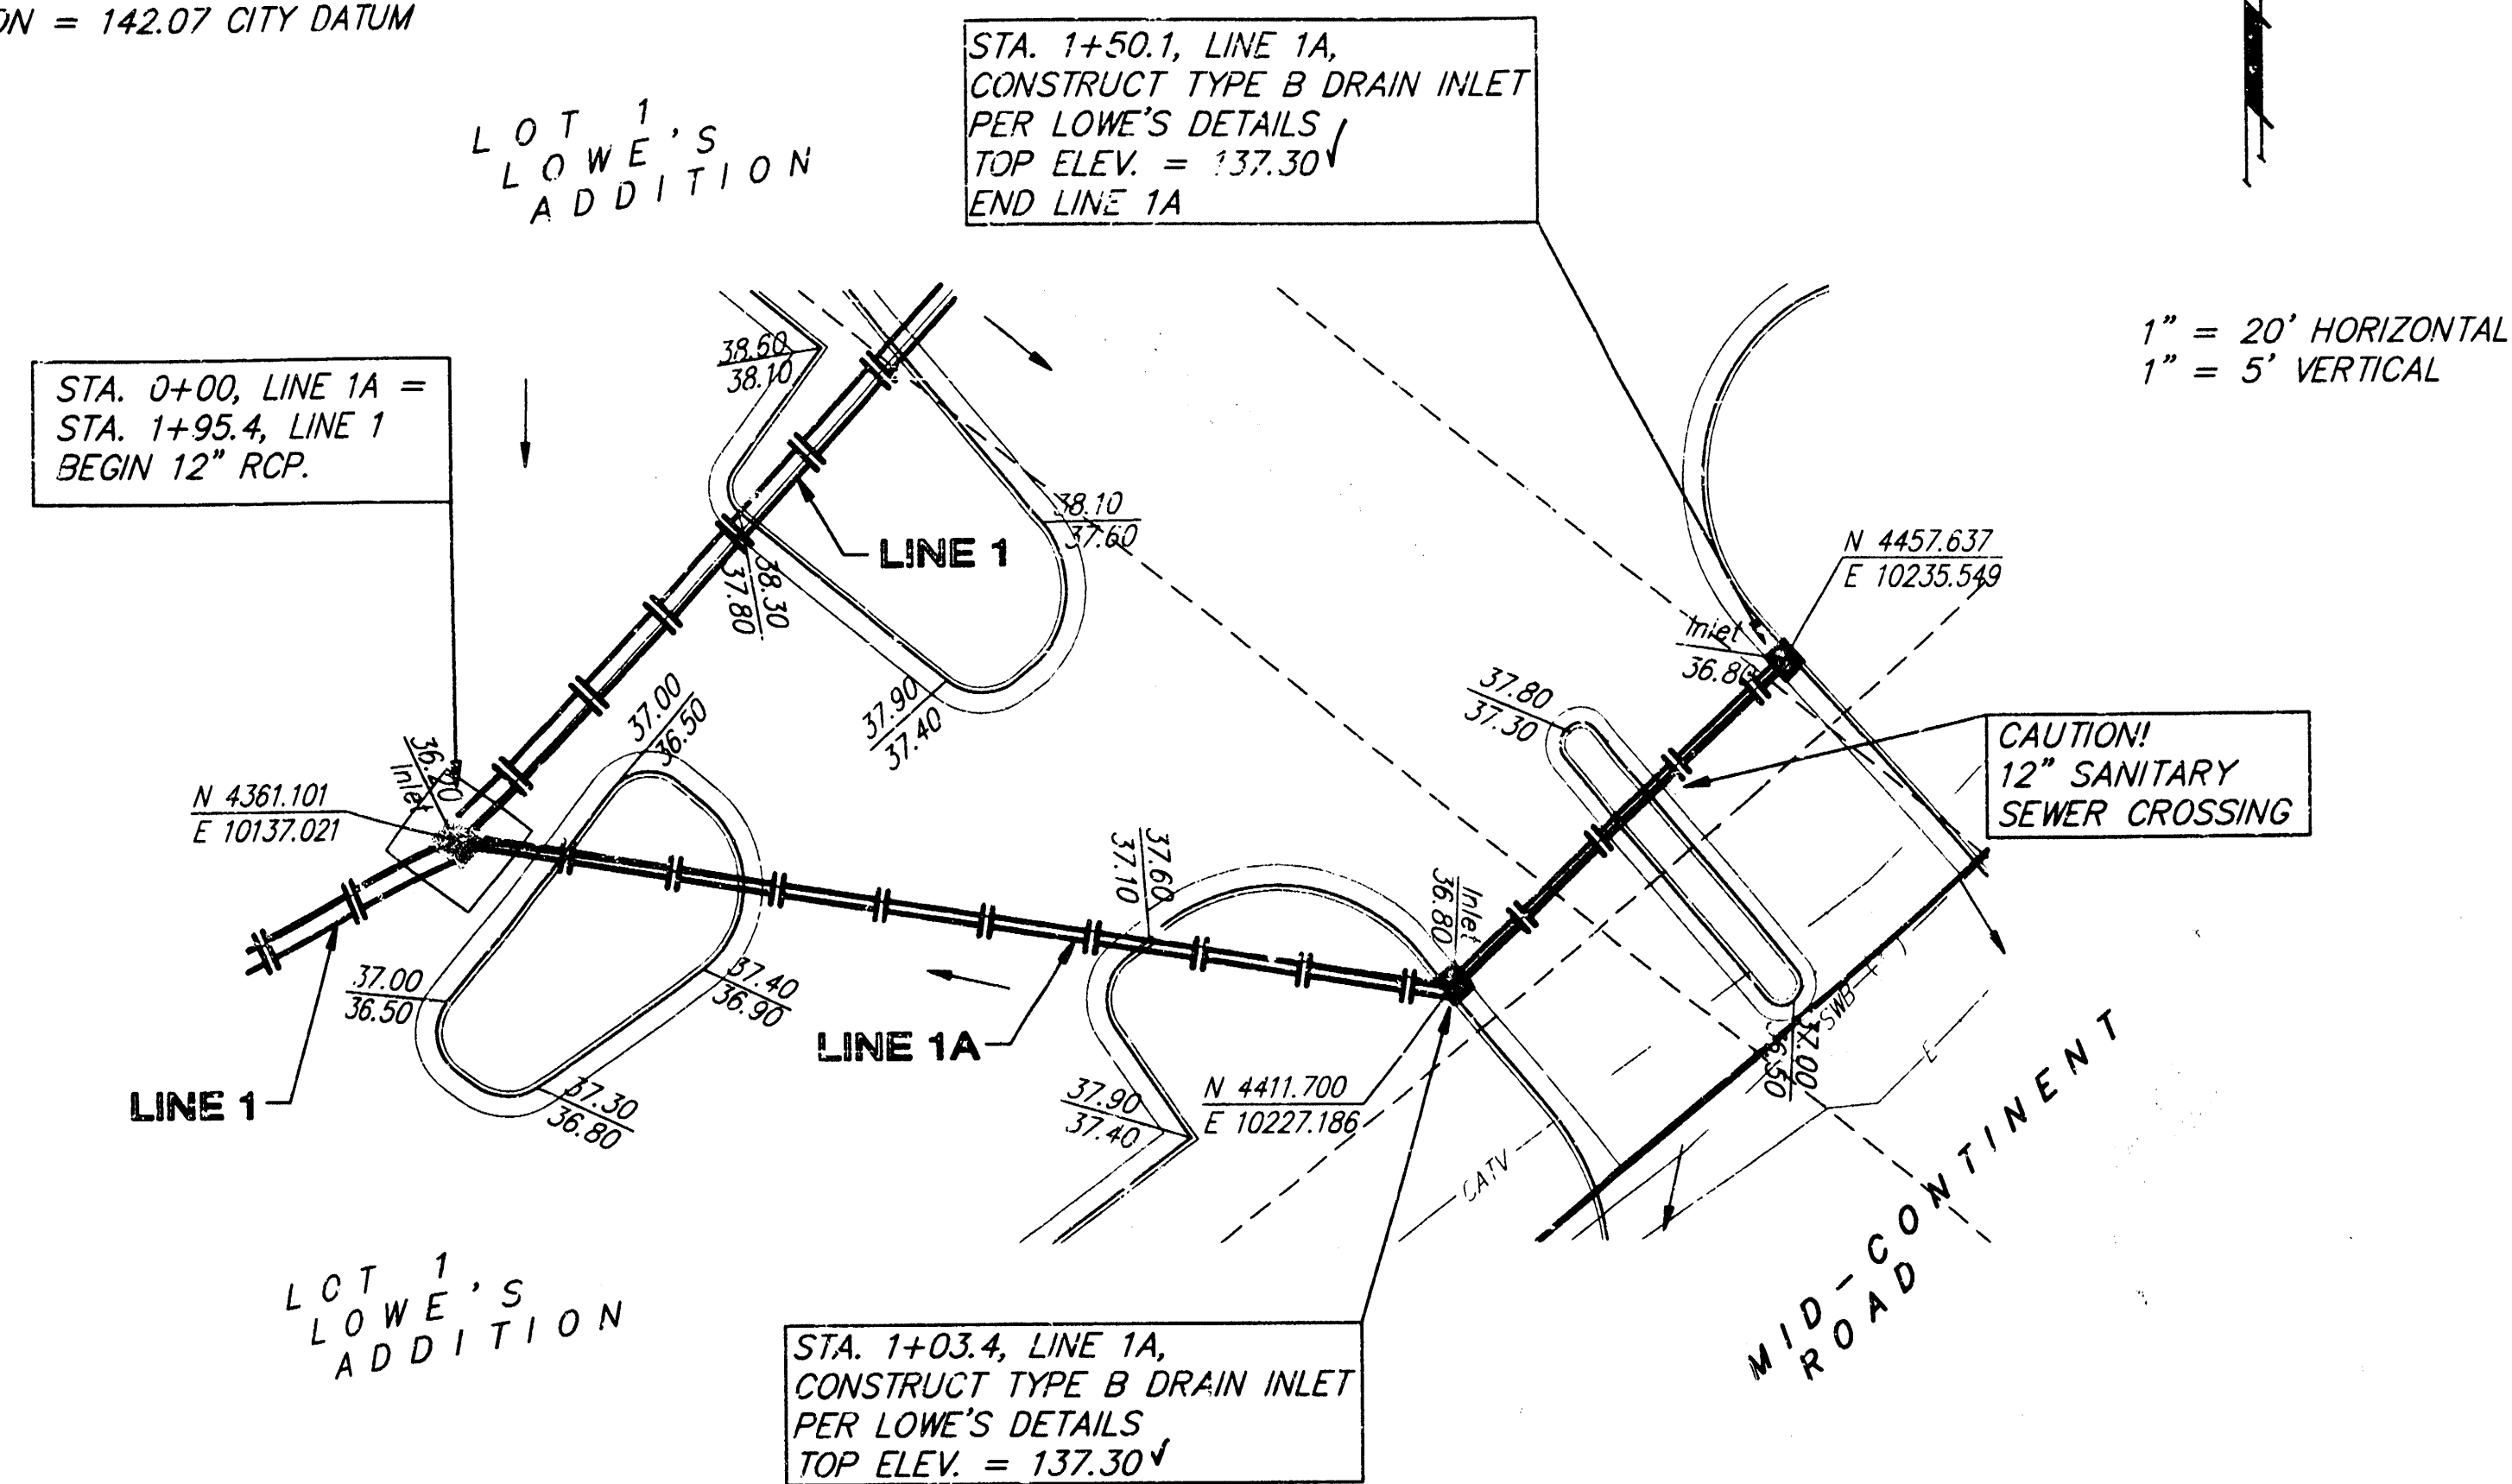

* AS BUILT NOTE:
2-18" PVC PIPES PLACED SIDE
BY SIDE USED INSTEAD OF
1-24" RCP

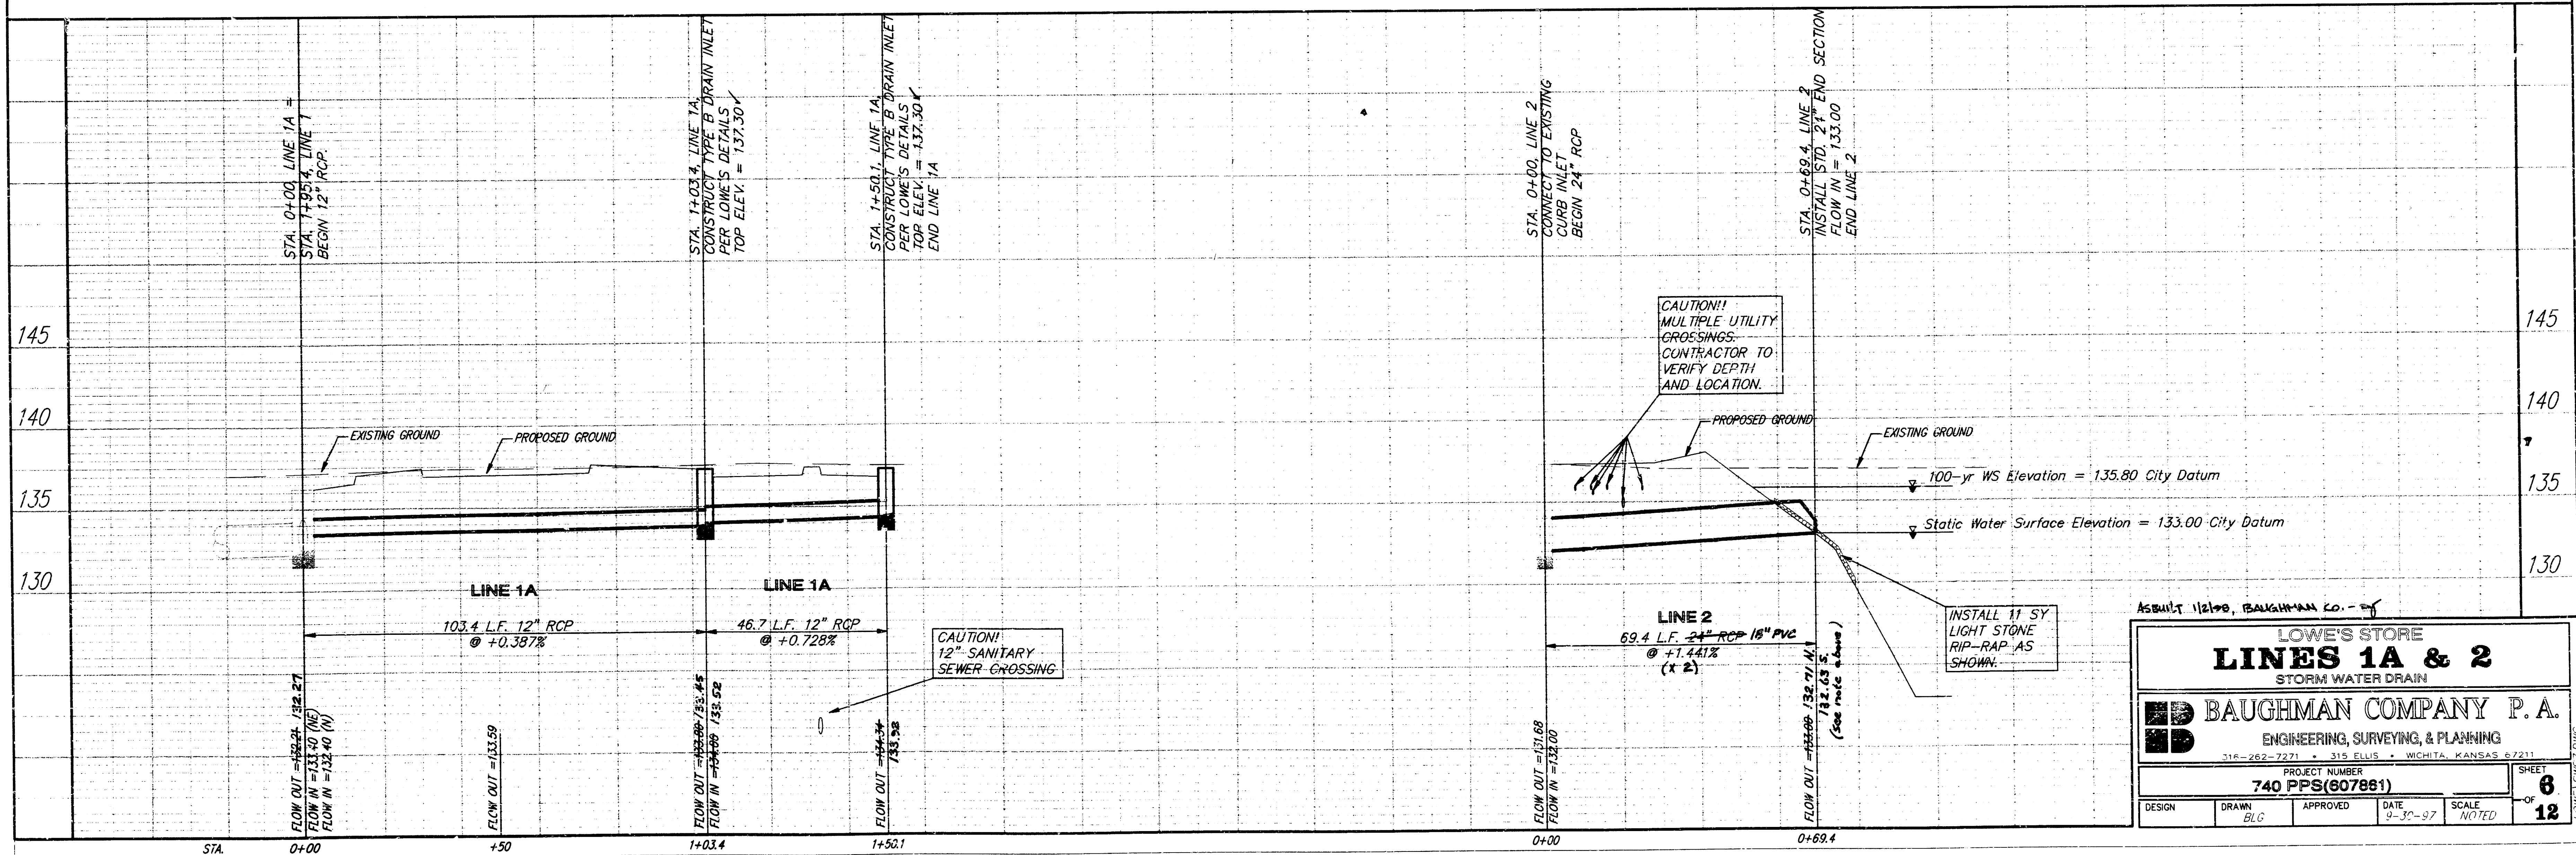

AS BUILT 1/2/00, BAUGHMAN CO. - E


LOWE'S STORE
LINES 1A & 2
STORM WATER DRAIN

BAUGHMAN COMPANY P.A.
ENGINEERING, SURVEYING, & PLANNING
310-262-7221 • 1119 ELLIS • WICHITA, KANSAS 67211

PROJECT NUMBER: **740 PPS(607861)**


DESIGN: [] DRAWN: **BLG** APPROVED: [] DATE: **9-30-97** SCALE: **NOTED** SHEET: **6** OF **12**

BENCHMARKS:
 BM #1 NE Corner of SW 1/4,
 Sec. 7, T-19-S, R-11-E.
 Elev. = 1147.37 (MSL)
 BM #2 "Cut on Top Center
 of South Side of 7" X 3.5" RCBC.
 Elev. = 1140.28 (MSL)

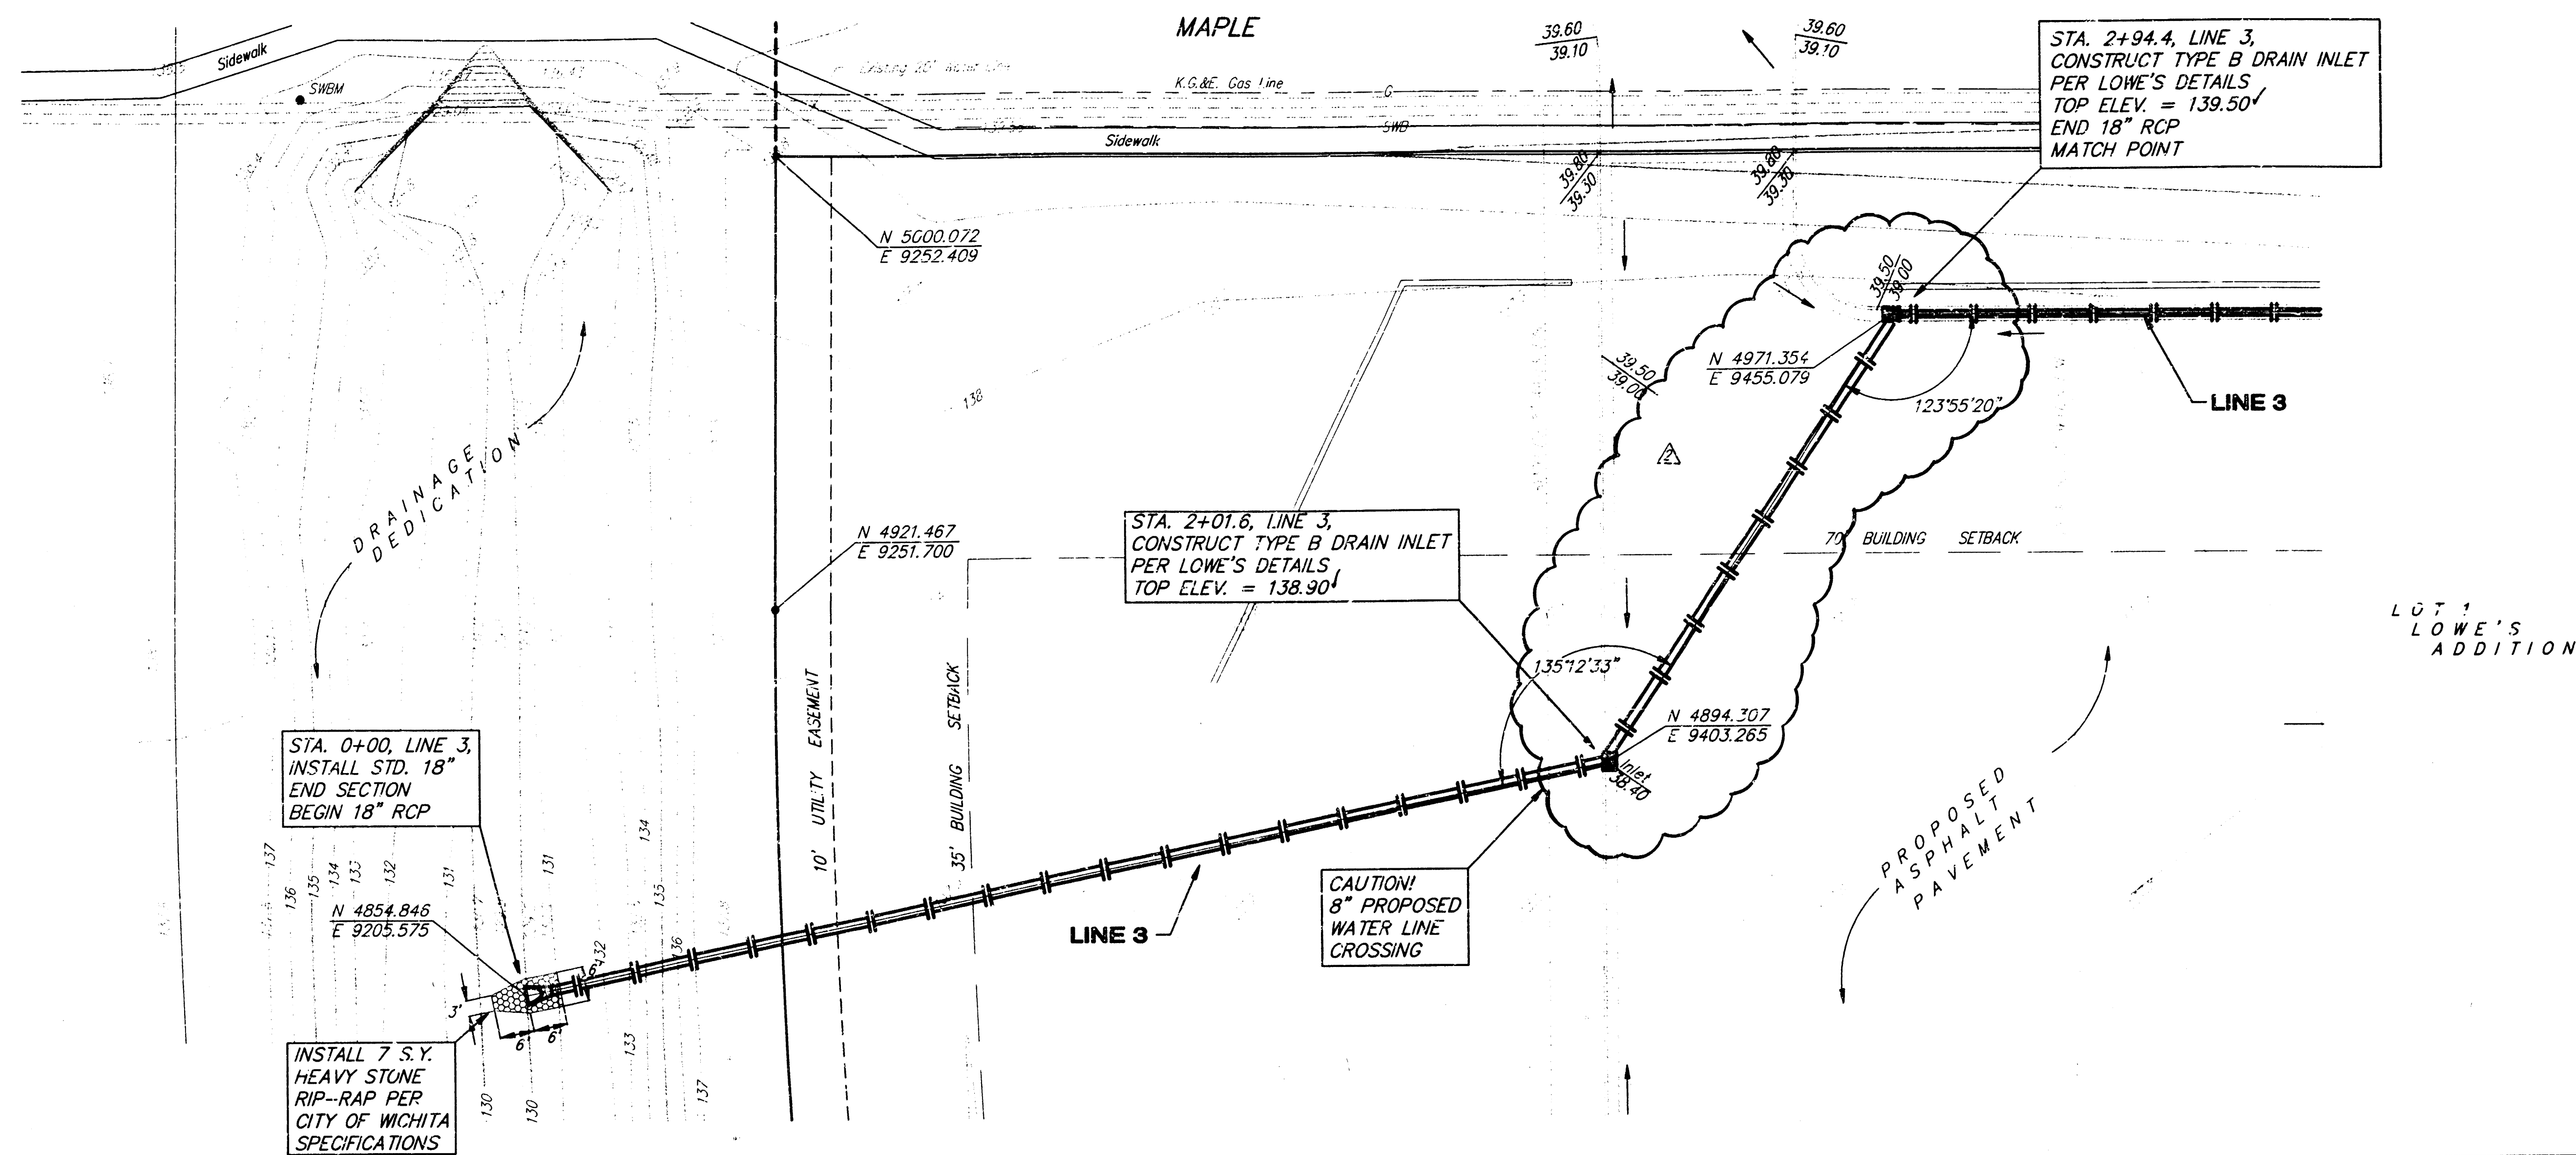

SCALE:
 1" = 20' HORIZONTAL
 1" = 5' VERTICAL
 • = IRON

REVISION: Per C.O.W. Comments BLG Oct. 2, 1997
 REVISION: Per Lowe's Comments BLG Sept. 17, 1997

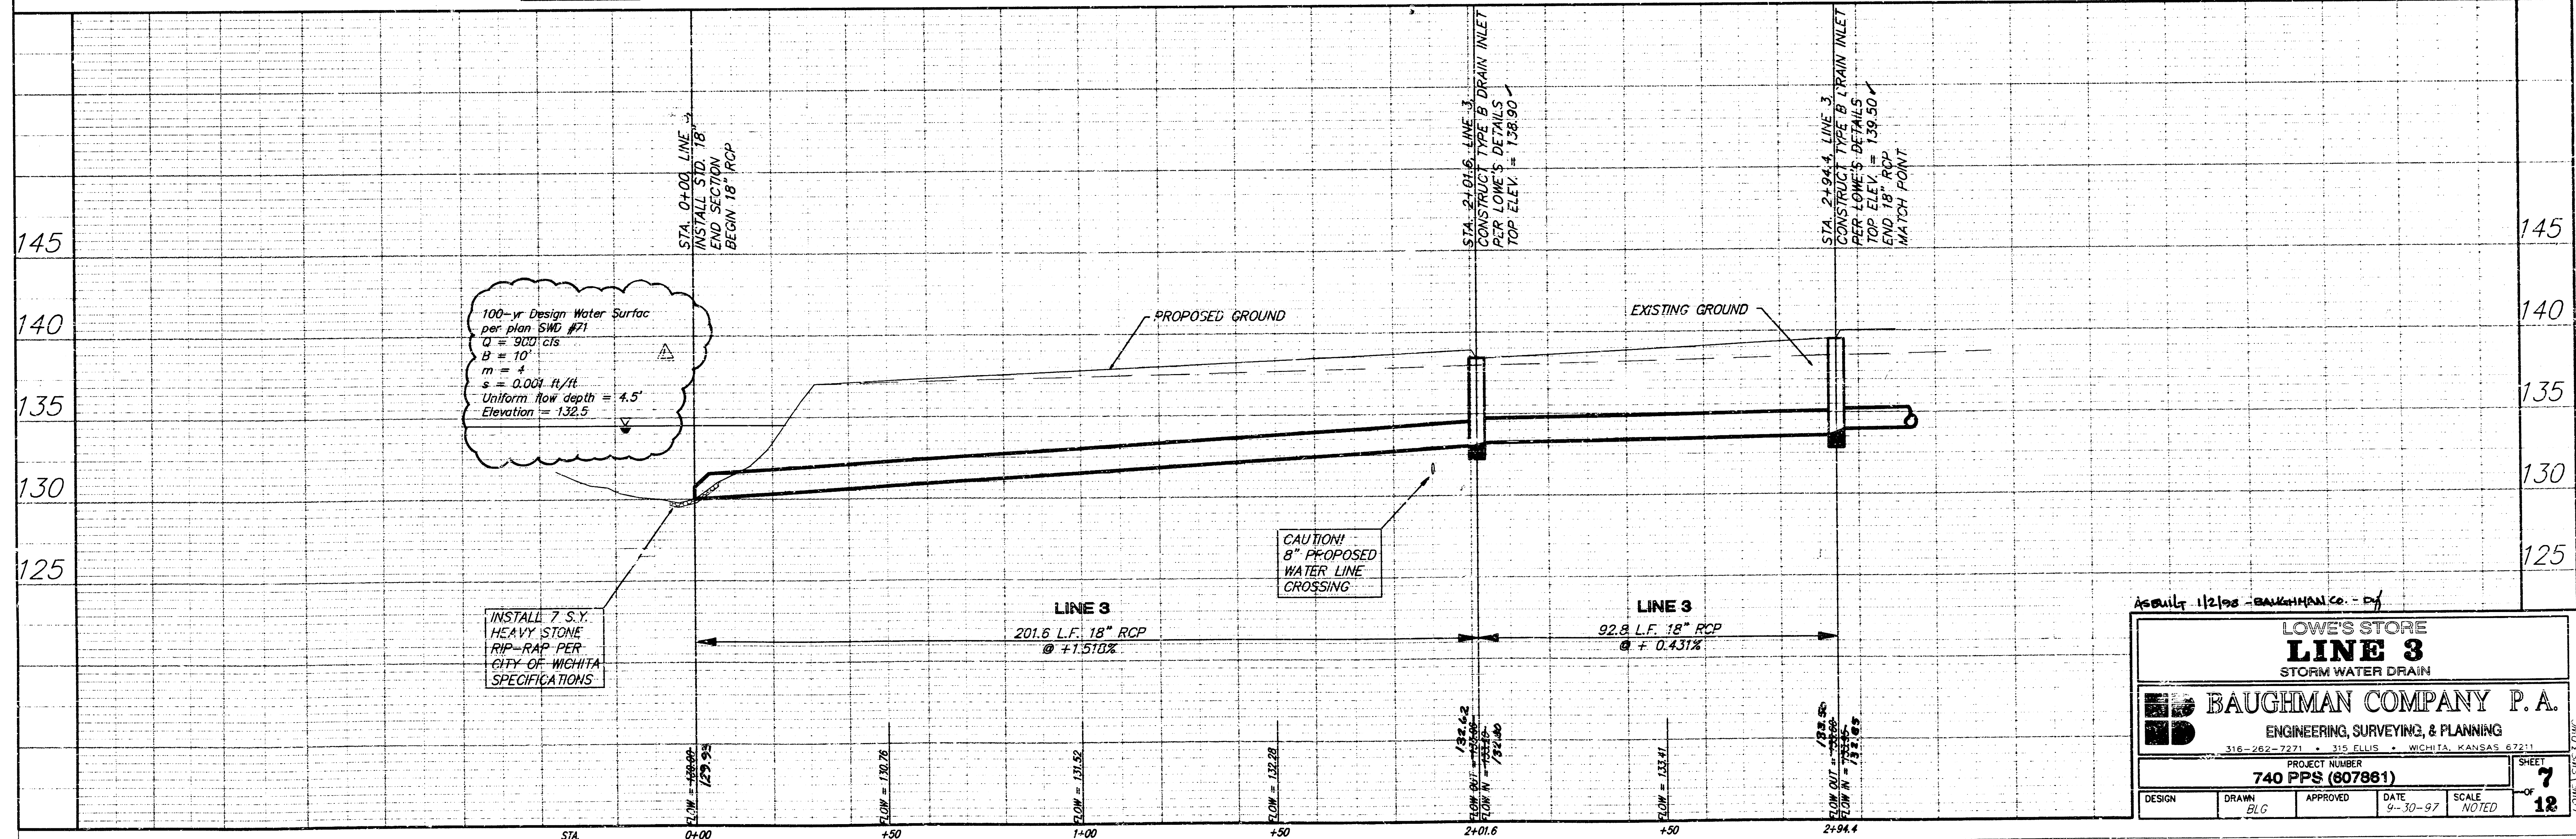

As built 11/2/98 - BAUGHMAN CO. - DJ

LOWE'S STORE
LINE 3
 STORM WATER DRAIN



BAUGHMAN COMPANY P.A.
 ENGINEERING, SURVEYING, & PLANNING
 316-282-7721 • 315 ELLIS • WICHITA, KANSAS 67213

PROJECT NUMBER: **740 PPS (607861)**

DESIGN: [] DRAWN: [] APPROVED: [] DATE: 6-30-97 SCALE: NOTED

SHEET **7** OF **12**

BENCHMARK:
City of Wichita Benchmark Disk --
S.W. Corner of Intersection, 69°
South & 97° West of C Ridge
Road and Maple, 10.5' North of
Face of Sidewalk.
Elev. = 142.07 City Datum

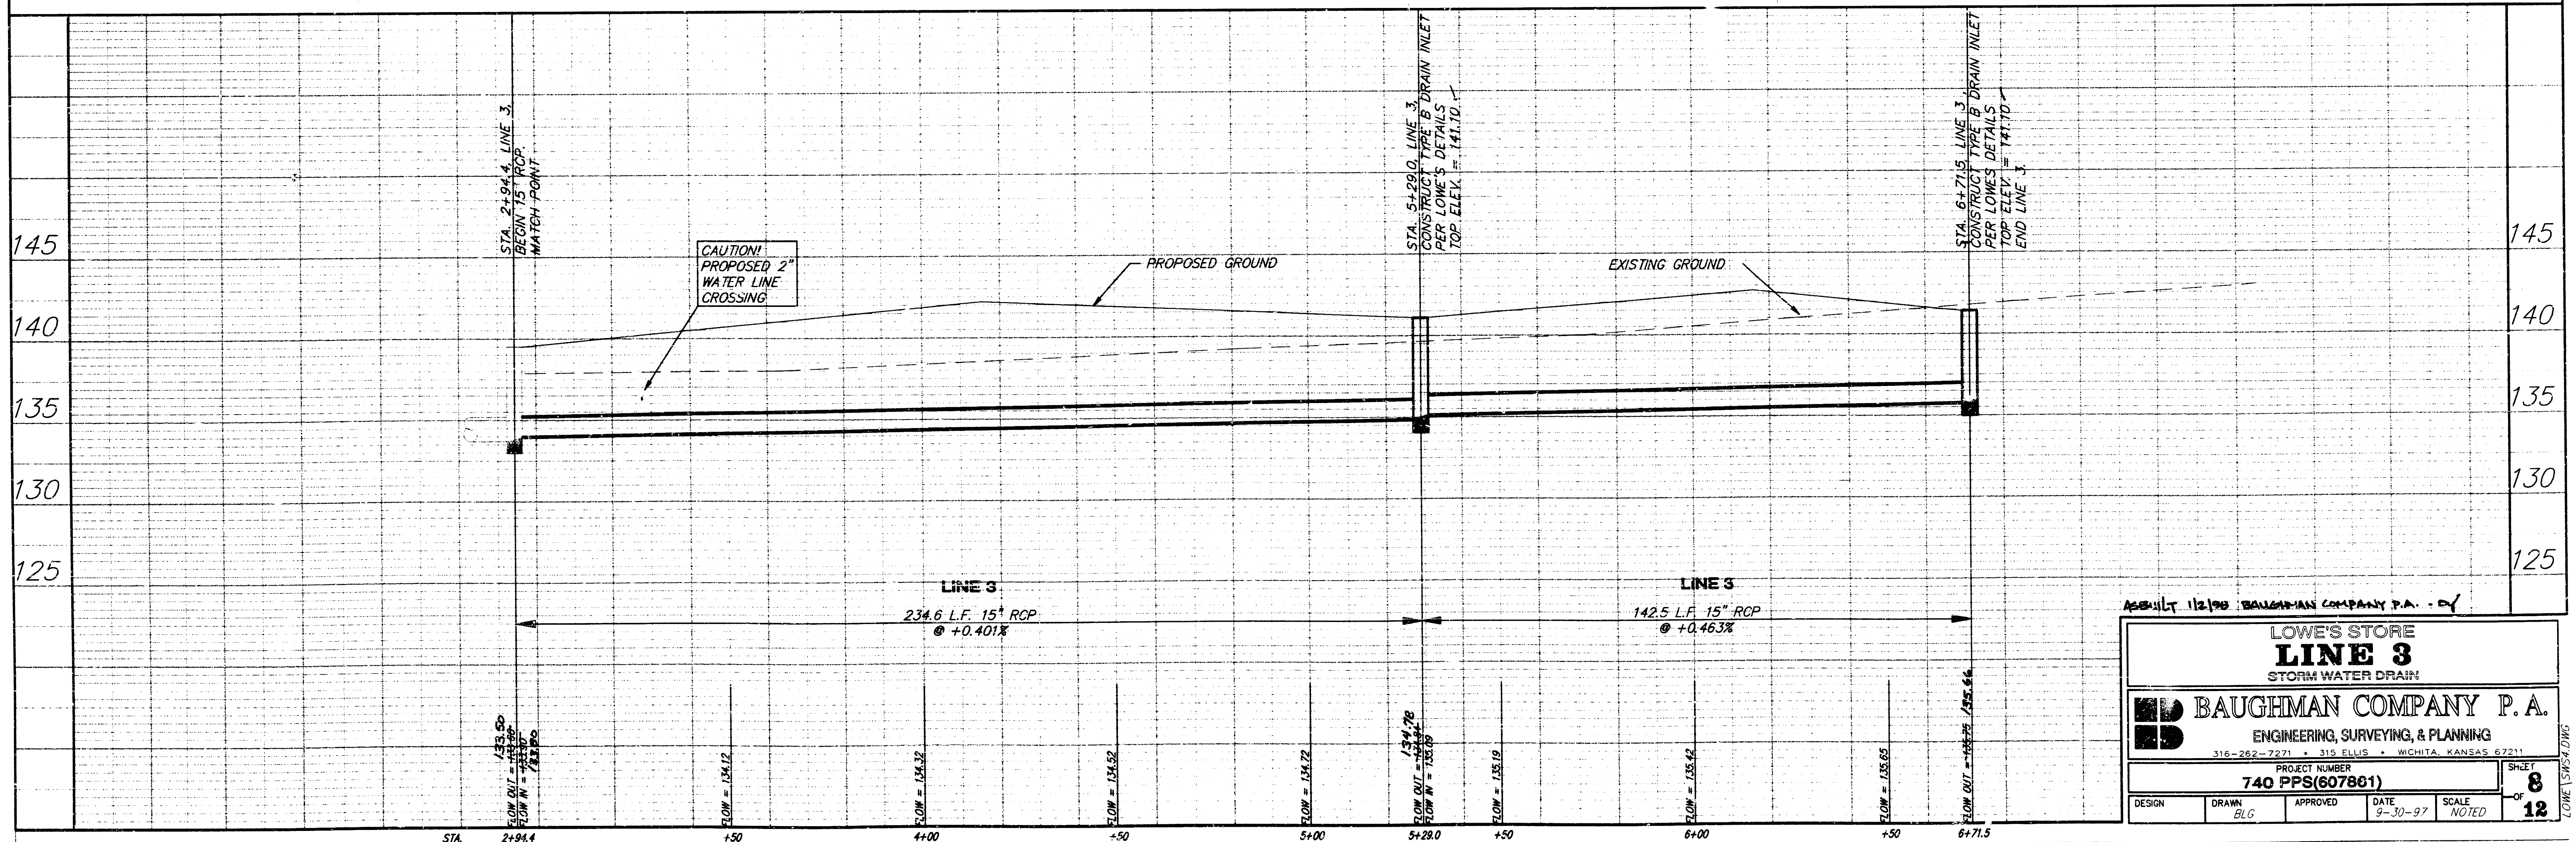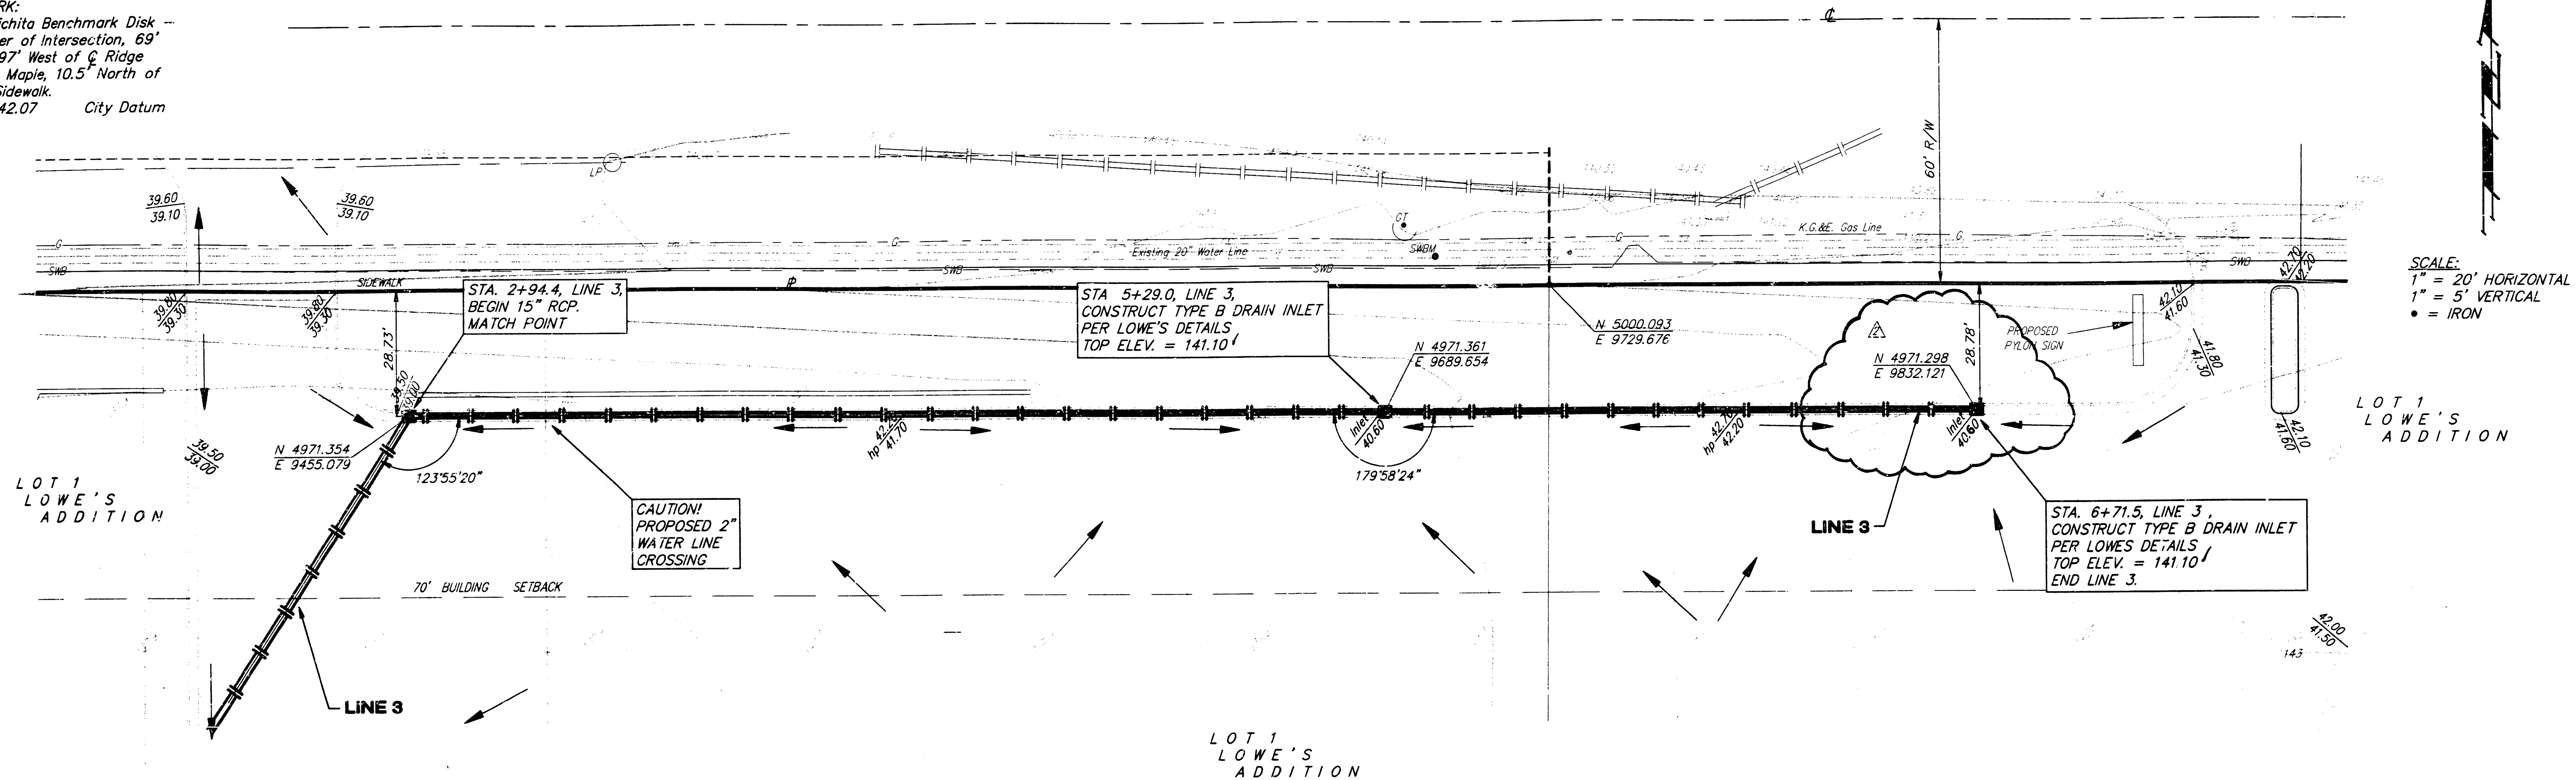


ASSEMBLY 11/2/98 BAUGHMAN COMPANY P.A. - D


LOWE'S STORE LINE 3 STORM WATER DRAIN			
BAUGHMAN COMPANY P.A. ENGINEERING, SURVEYING, & PLANNING 316-282-7271 • 315 ELLIS • WICHITA, KANSAS 67211			
PROJECT NUMBER		SHEET	
740 PPS(607861)		8	
DESIGN	DRAWN	APPROVED	DATE
	BLG		9-30-97
SCALE		NOTED	
		12	

LOWE'S STORE


BENCHMARK:
City of Wichita Benchmark Disk -
S.W. Corner of Intersection, 69'
South & 97' West of Ridge
Road and Maple, 10.5' North of
Face of Sidewalk.
Elev. = 142.07 City Datum

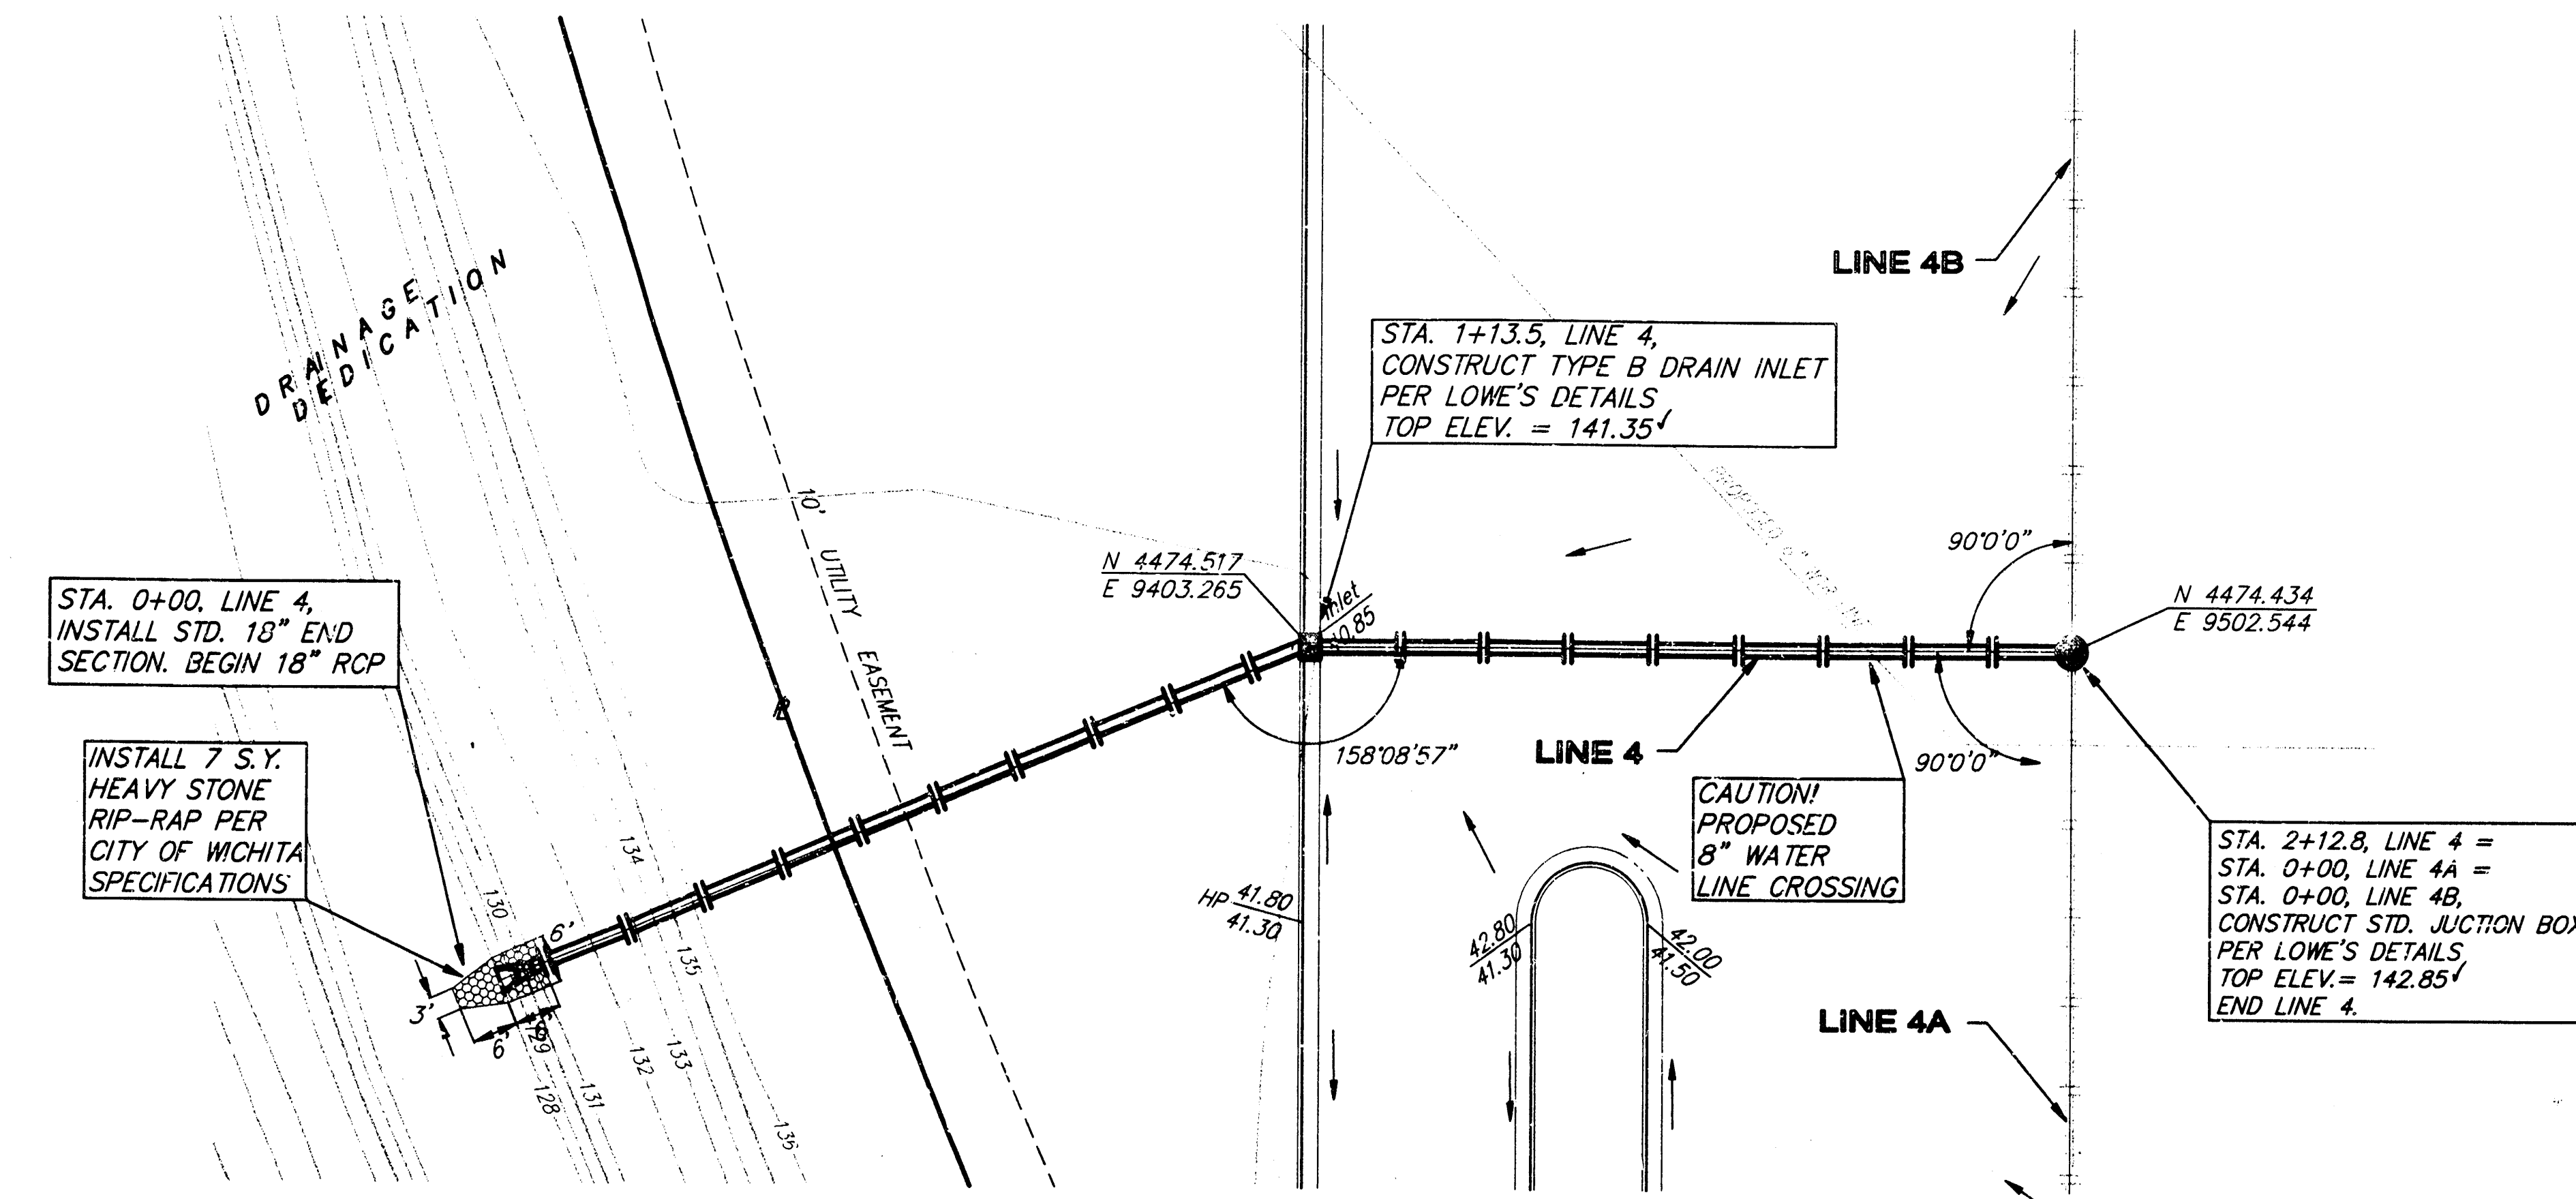

SCALE:
1" = 20' HORIZONTAL
1" = 5' VERTICAL
• = IRON

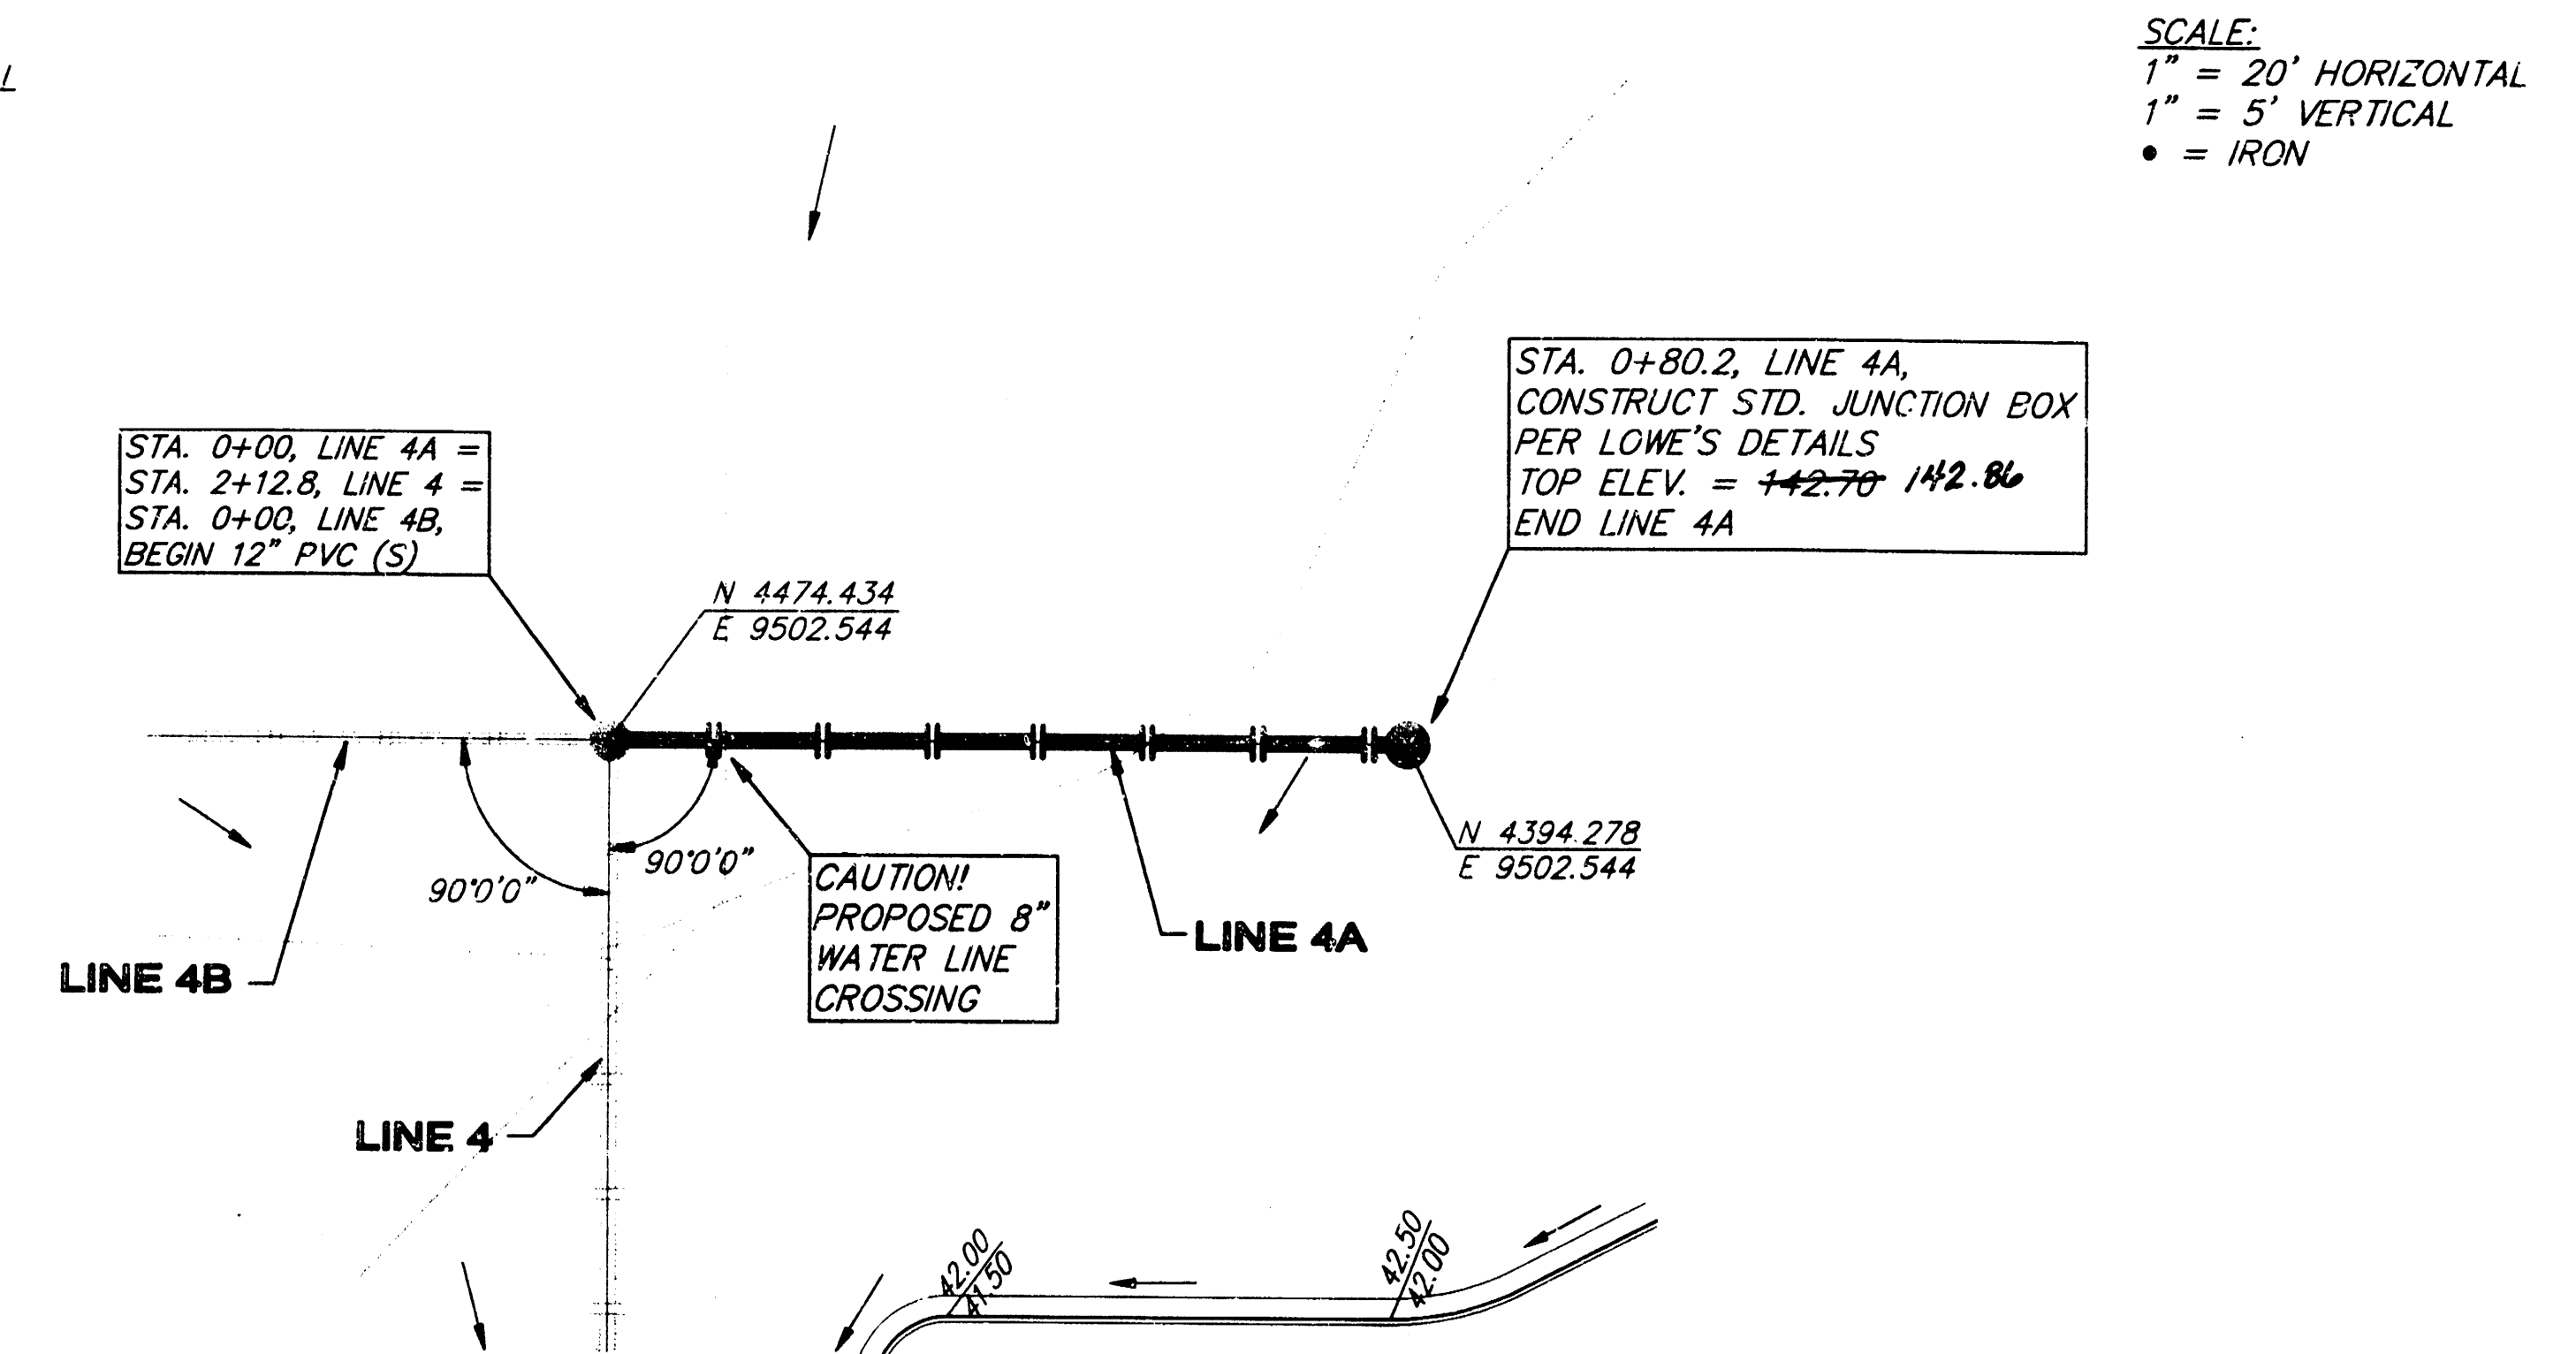

SCALE:
1" = 20' HORIZONTAL
1" = 5' VERTICAL
• = IRON

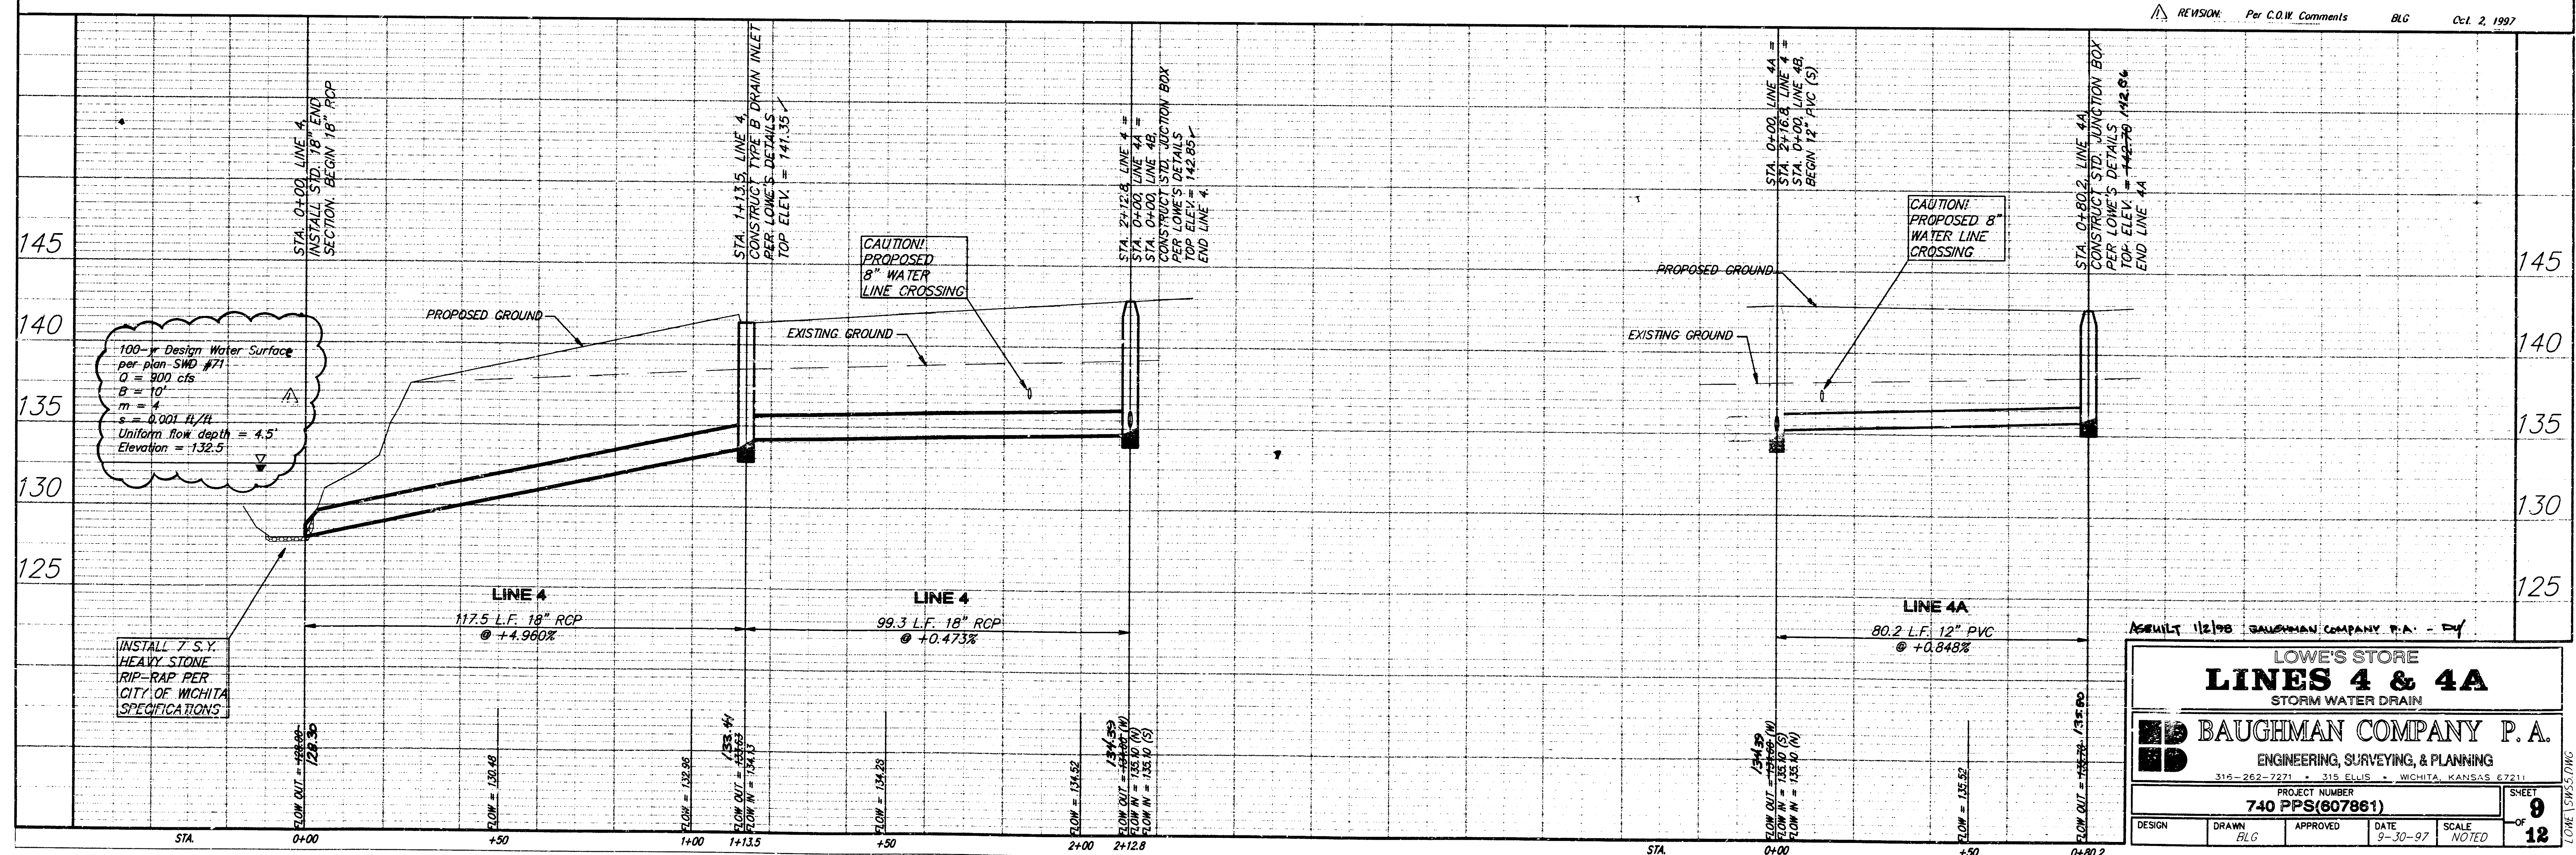

REVISION: Per C.O.W. Comments BLG Oct. 2, 1997

LOWE'S STORE
LINES 4 & 4A
STORM WATER DRAIN

BAUGHMAN COMPANY P.A.
ENGINEERING, SURVEYING, & PLANNING
315-262-7271 • 315 ELLIS • WICHITA, KANSAS 67211



PROJECT NUMBER
740 PPS(607861)

DESIGN	DRAWN	APPROVED	DATE	SCALE
	BLG		9-30-97	NOTED

SHEET
9
OF
12

BENCHMARK:
City of Wichita Benchmark Disk -
S.W. Corner of Intersection, 69'
South & 97' West of Ridge
Road and Maple, 10.5' North of
Face of Sidewalk.
Elev. = 142.07 City Datum

SCALE:
1" = 20' HORIZONTAL
1" = 5' VERTICAL
• = IRON

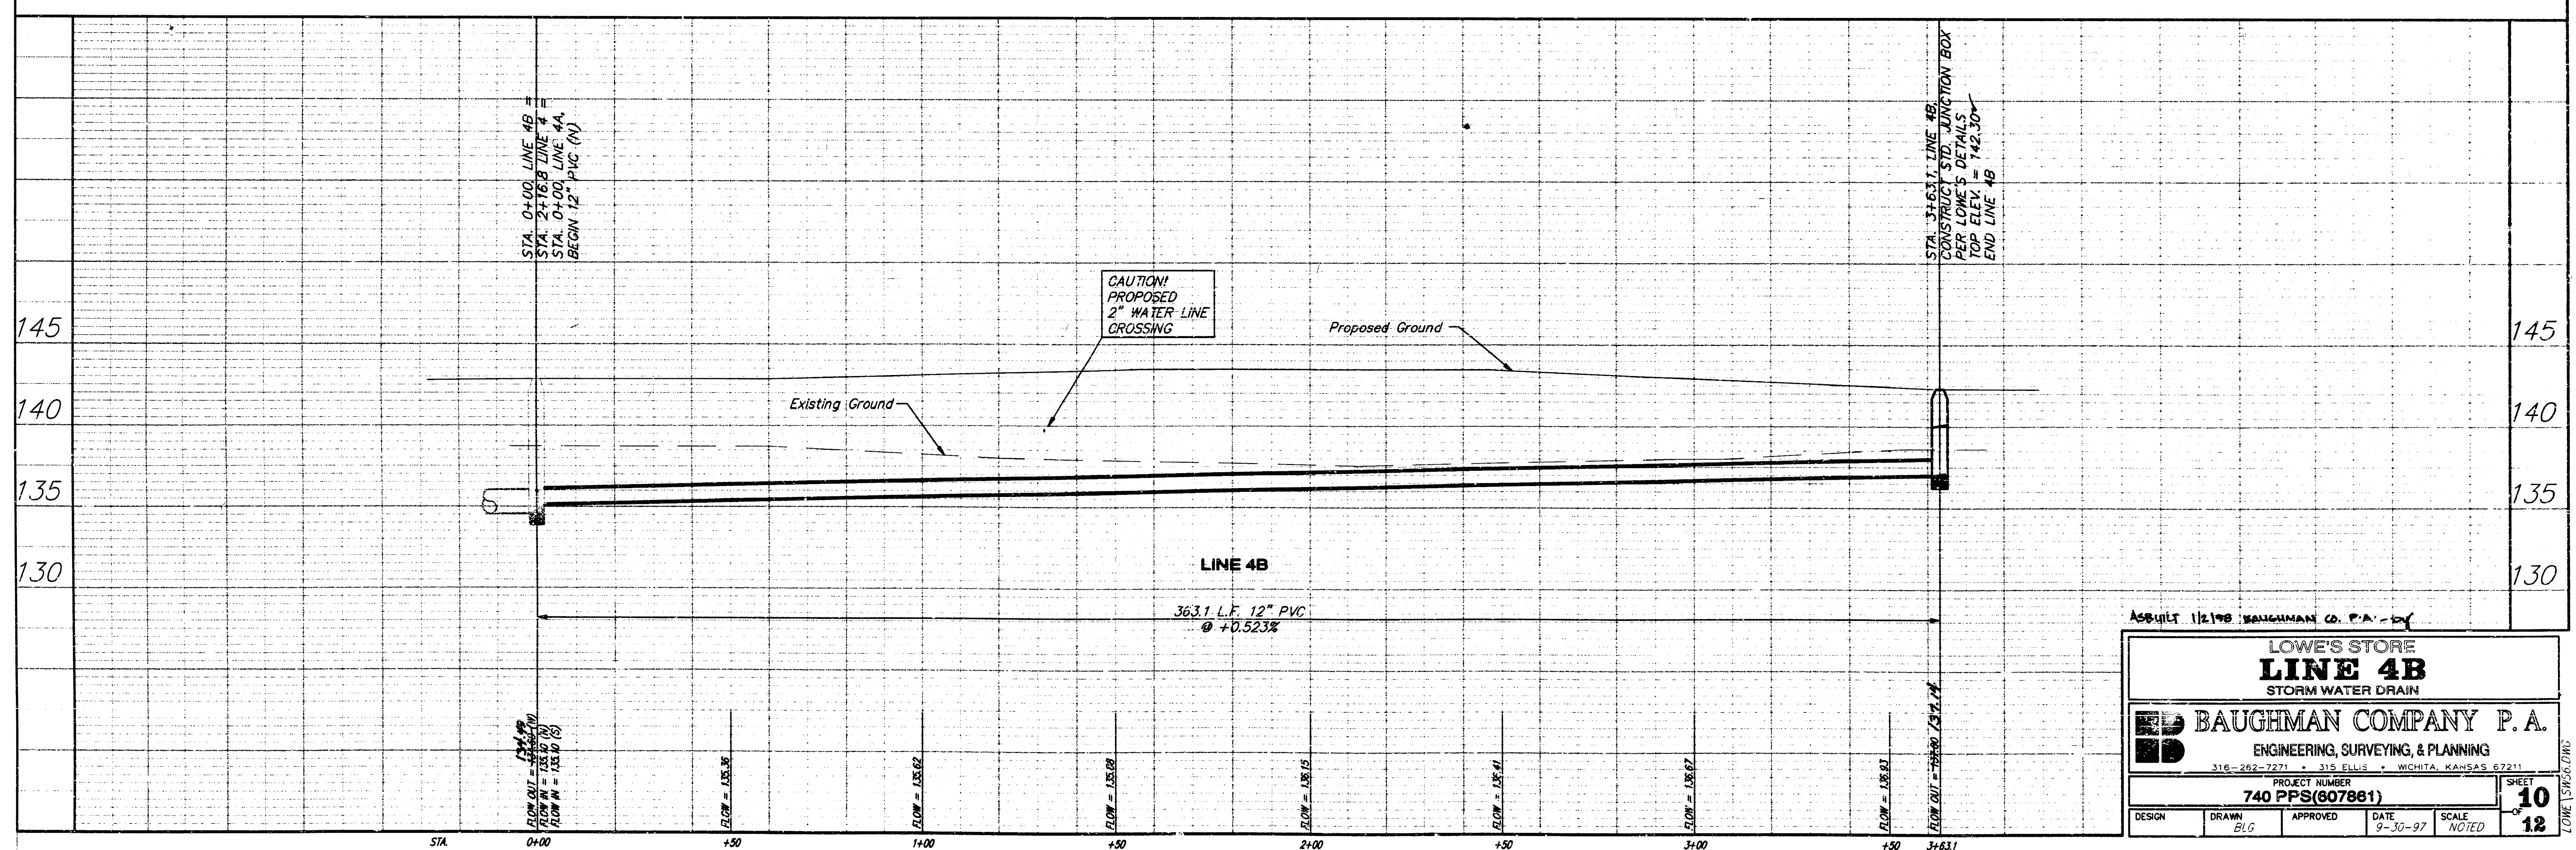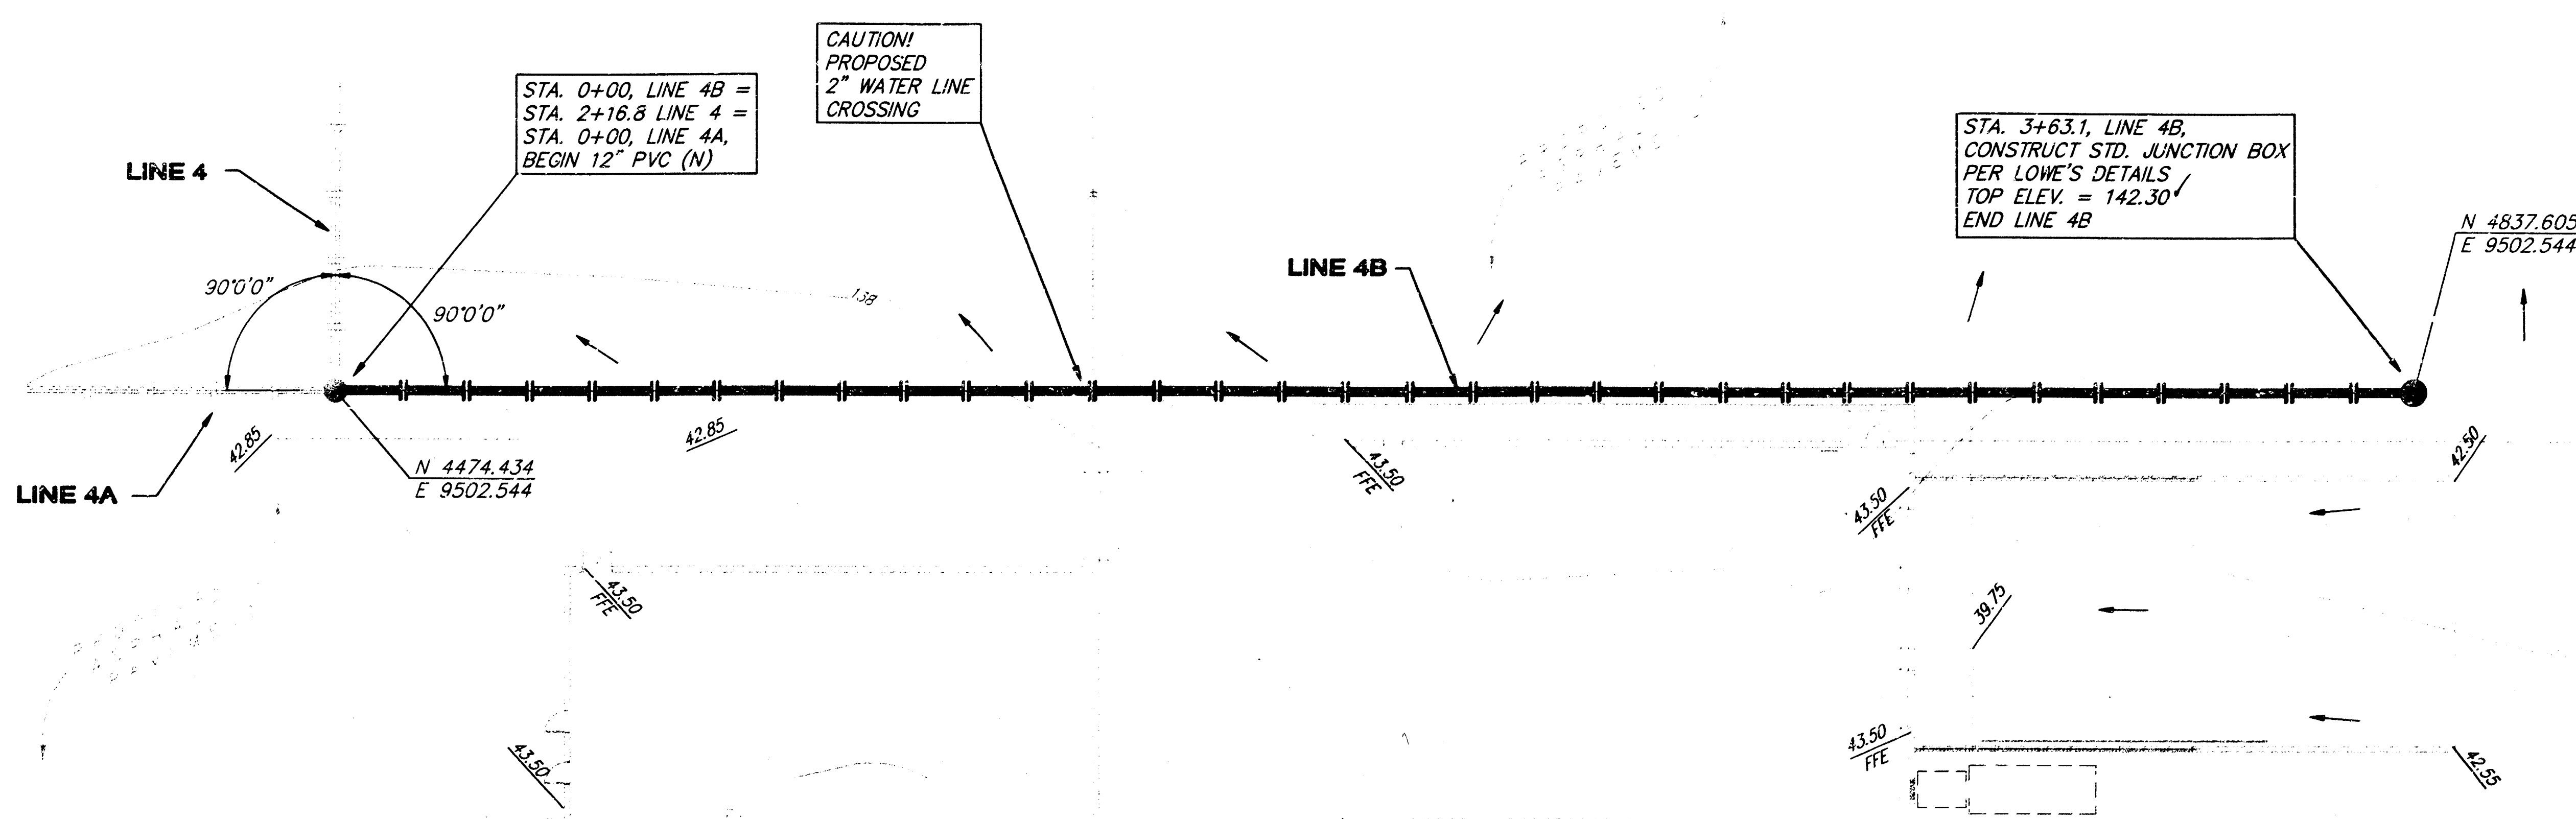

ASBUILT 11/2/98 BAUGHMAN CO. P.A. - 10

LOWE'S STORE
LINE 4B
STORM WATER DRAIN


BAUGHMAN COMPANY P.A.
ENGINEERING, SURVEYING, & PLANNING
316-262-7271 • 315 E. 10th St. • WICHITA, KANSAS 67211

PROJECT NUMBER
740 PPS(607881)


DESIGN	DRAWN	APPROVED	DATE	SCALE
	BLG		9-30-97	NOTED

SHEET
10
OF
12


LOWE'S STORE

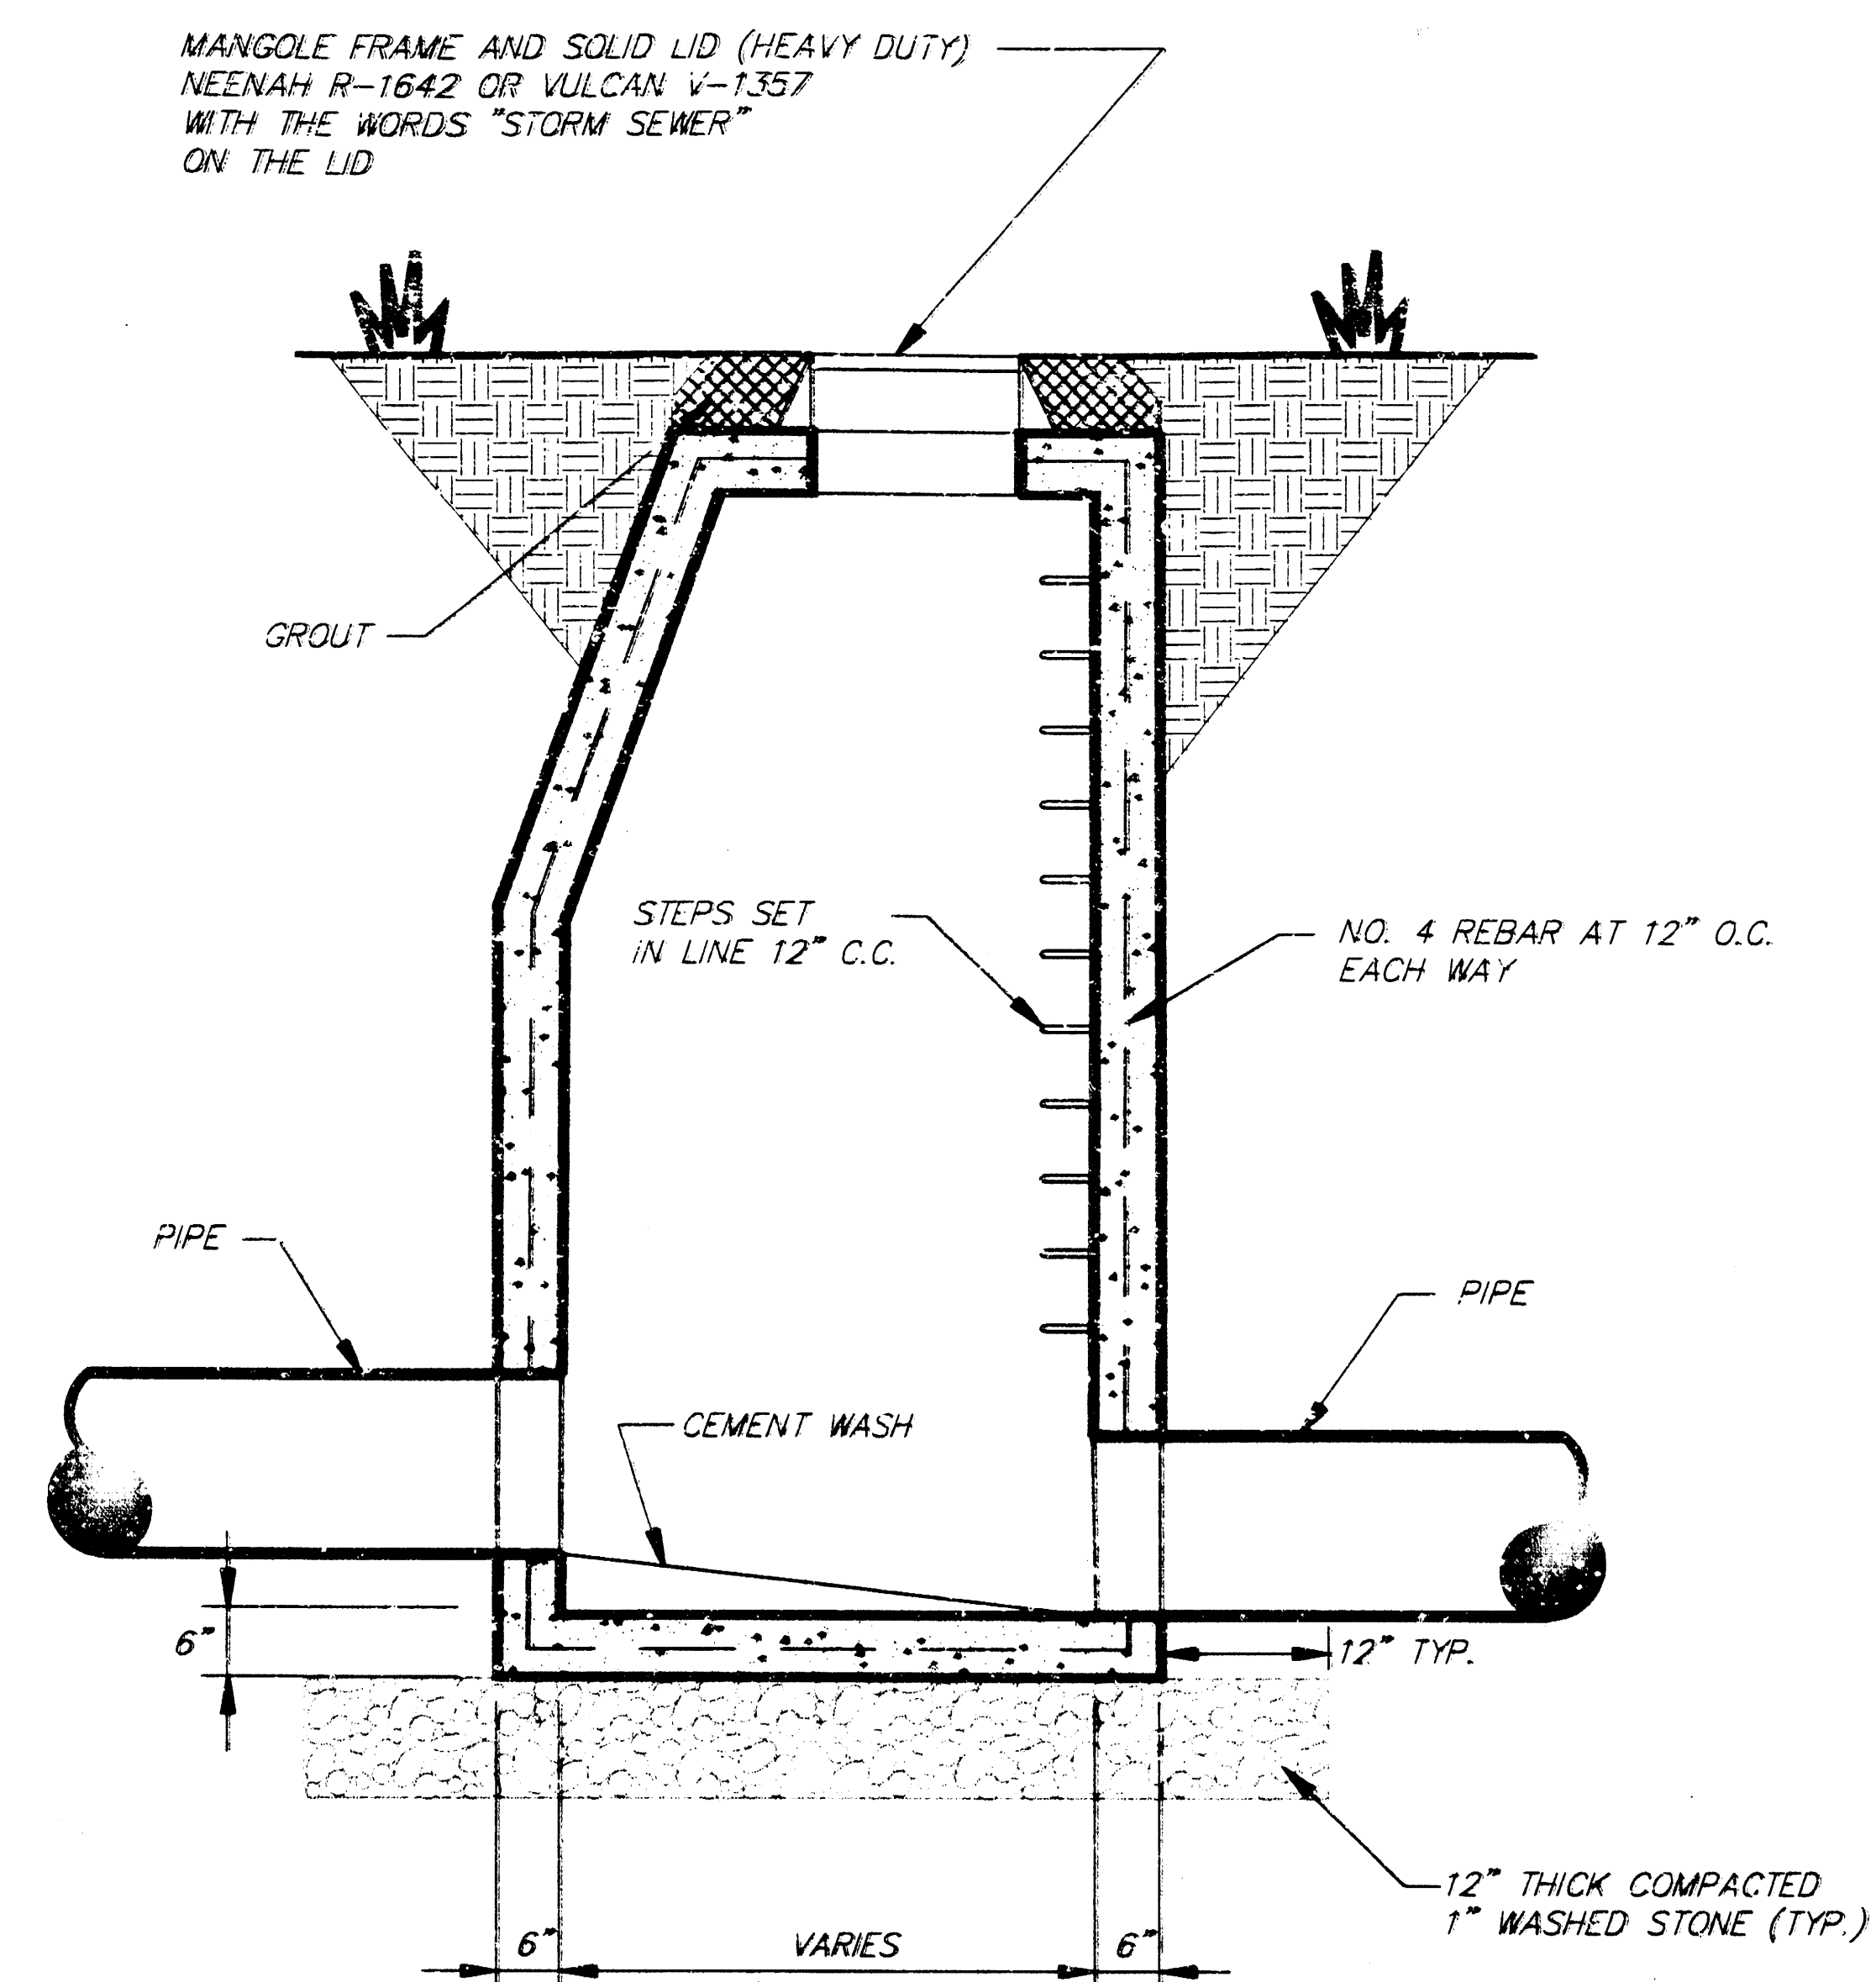


JUNCTION BOX DETAIL
SECTION VIEW
NO SCALE

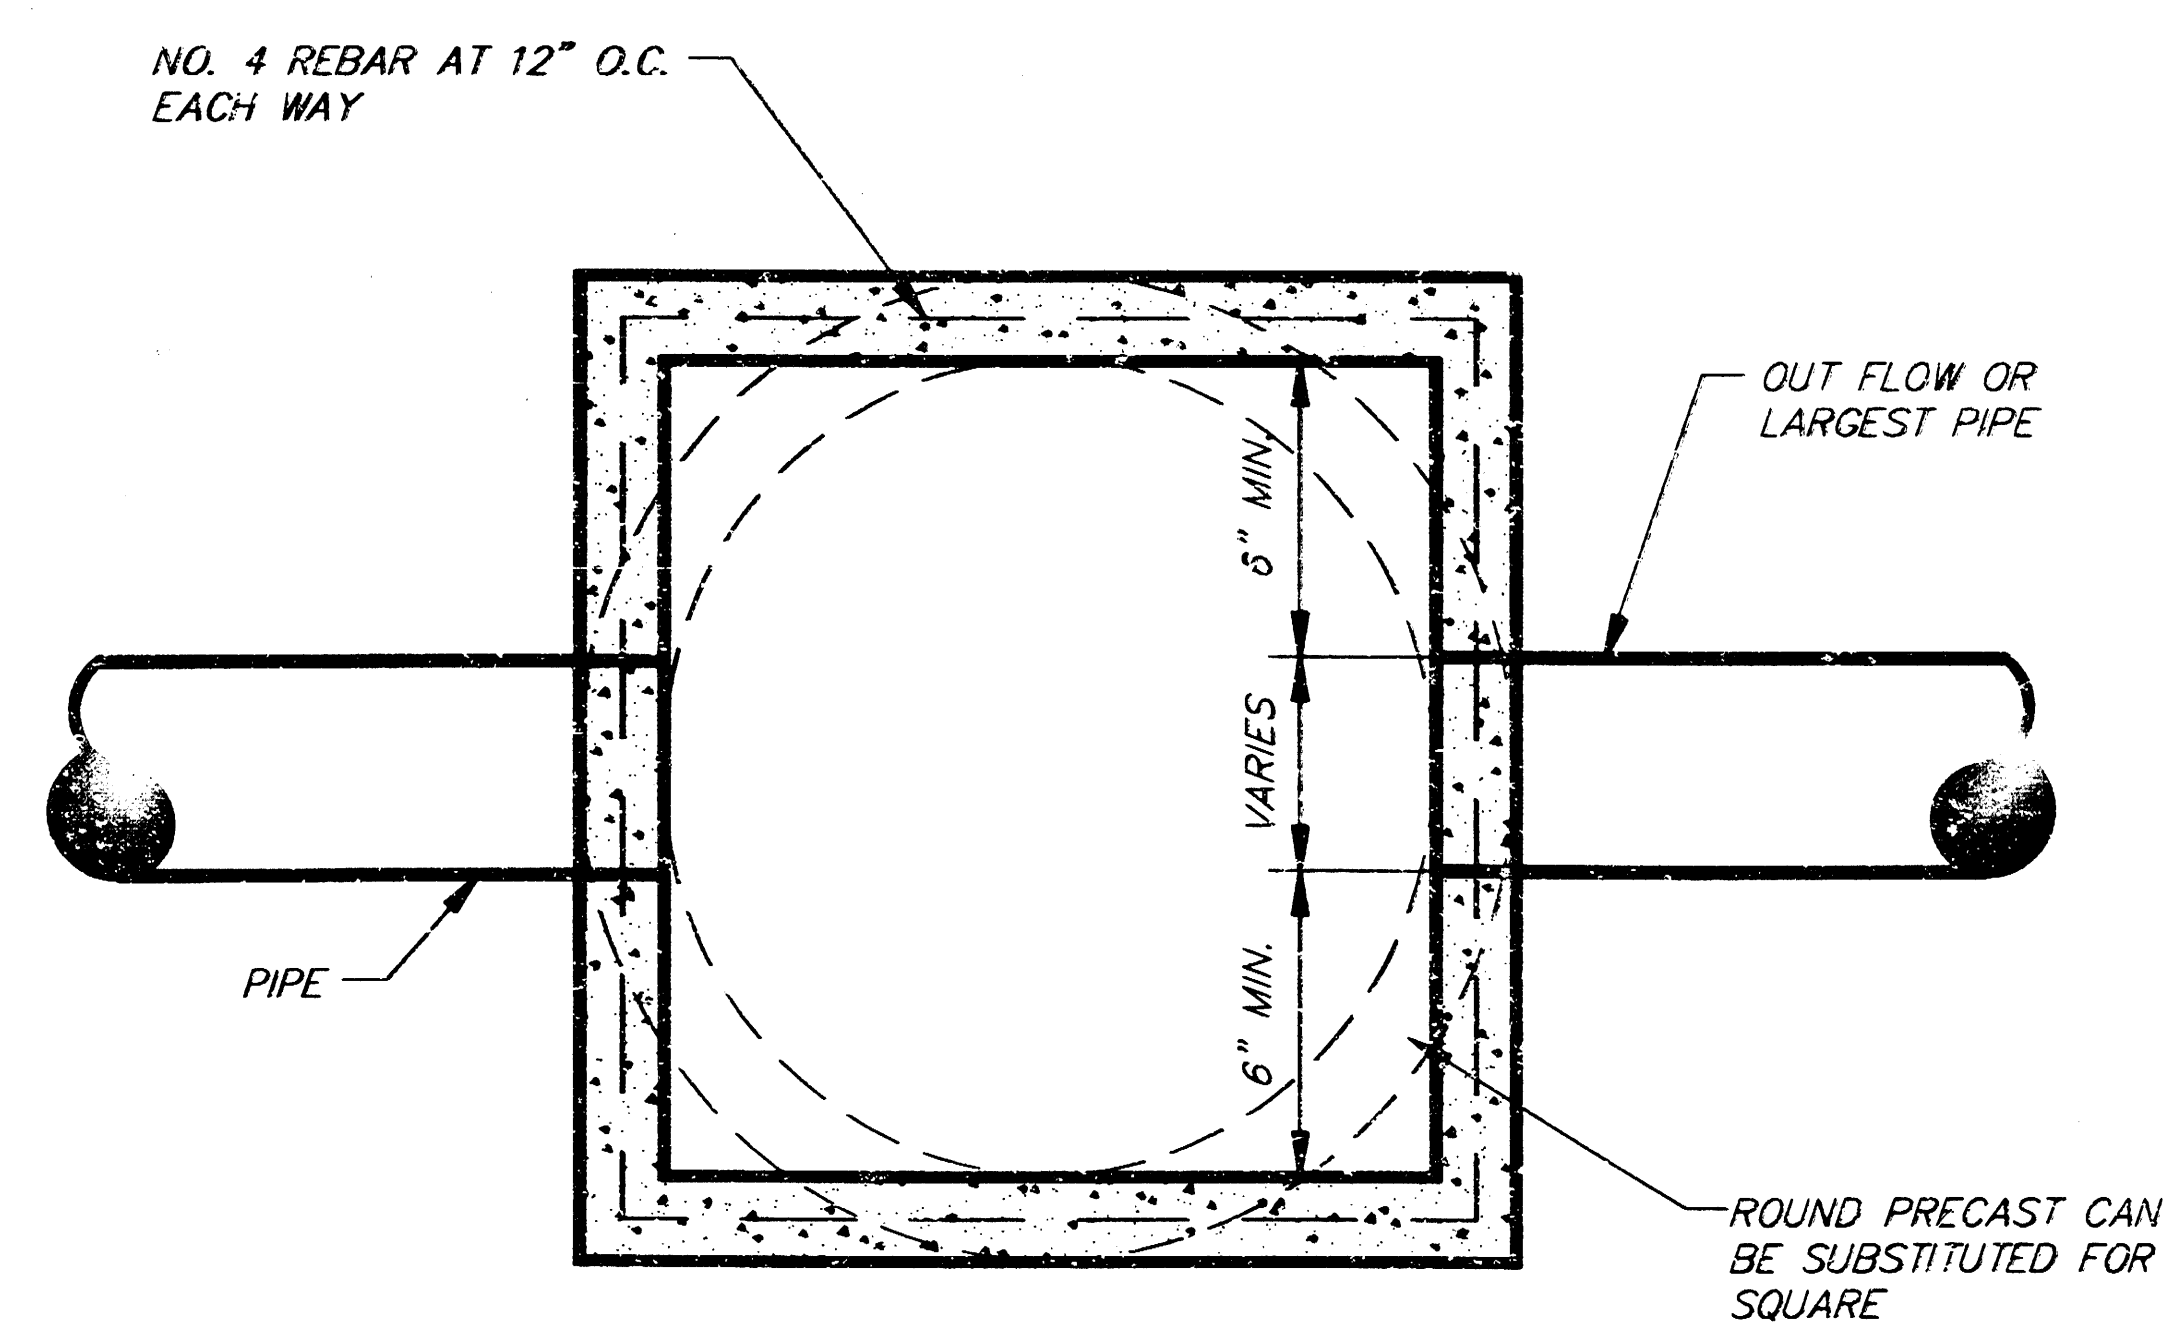

JUNCTION BOX DETAIL
PLAN VIEW
NO SCALE

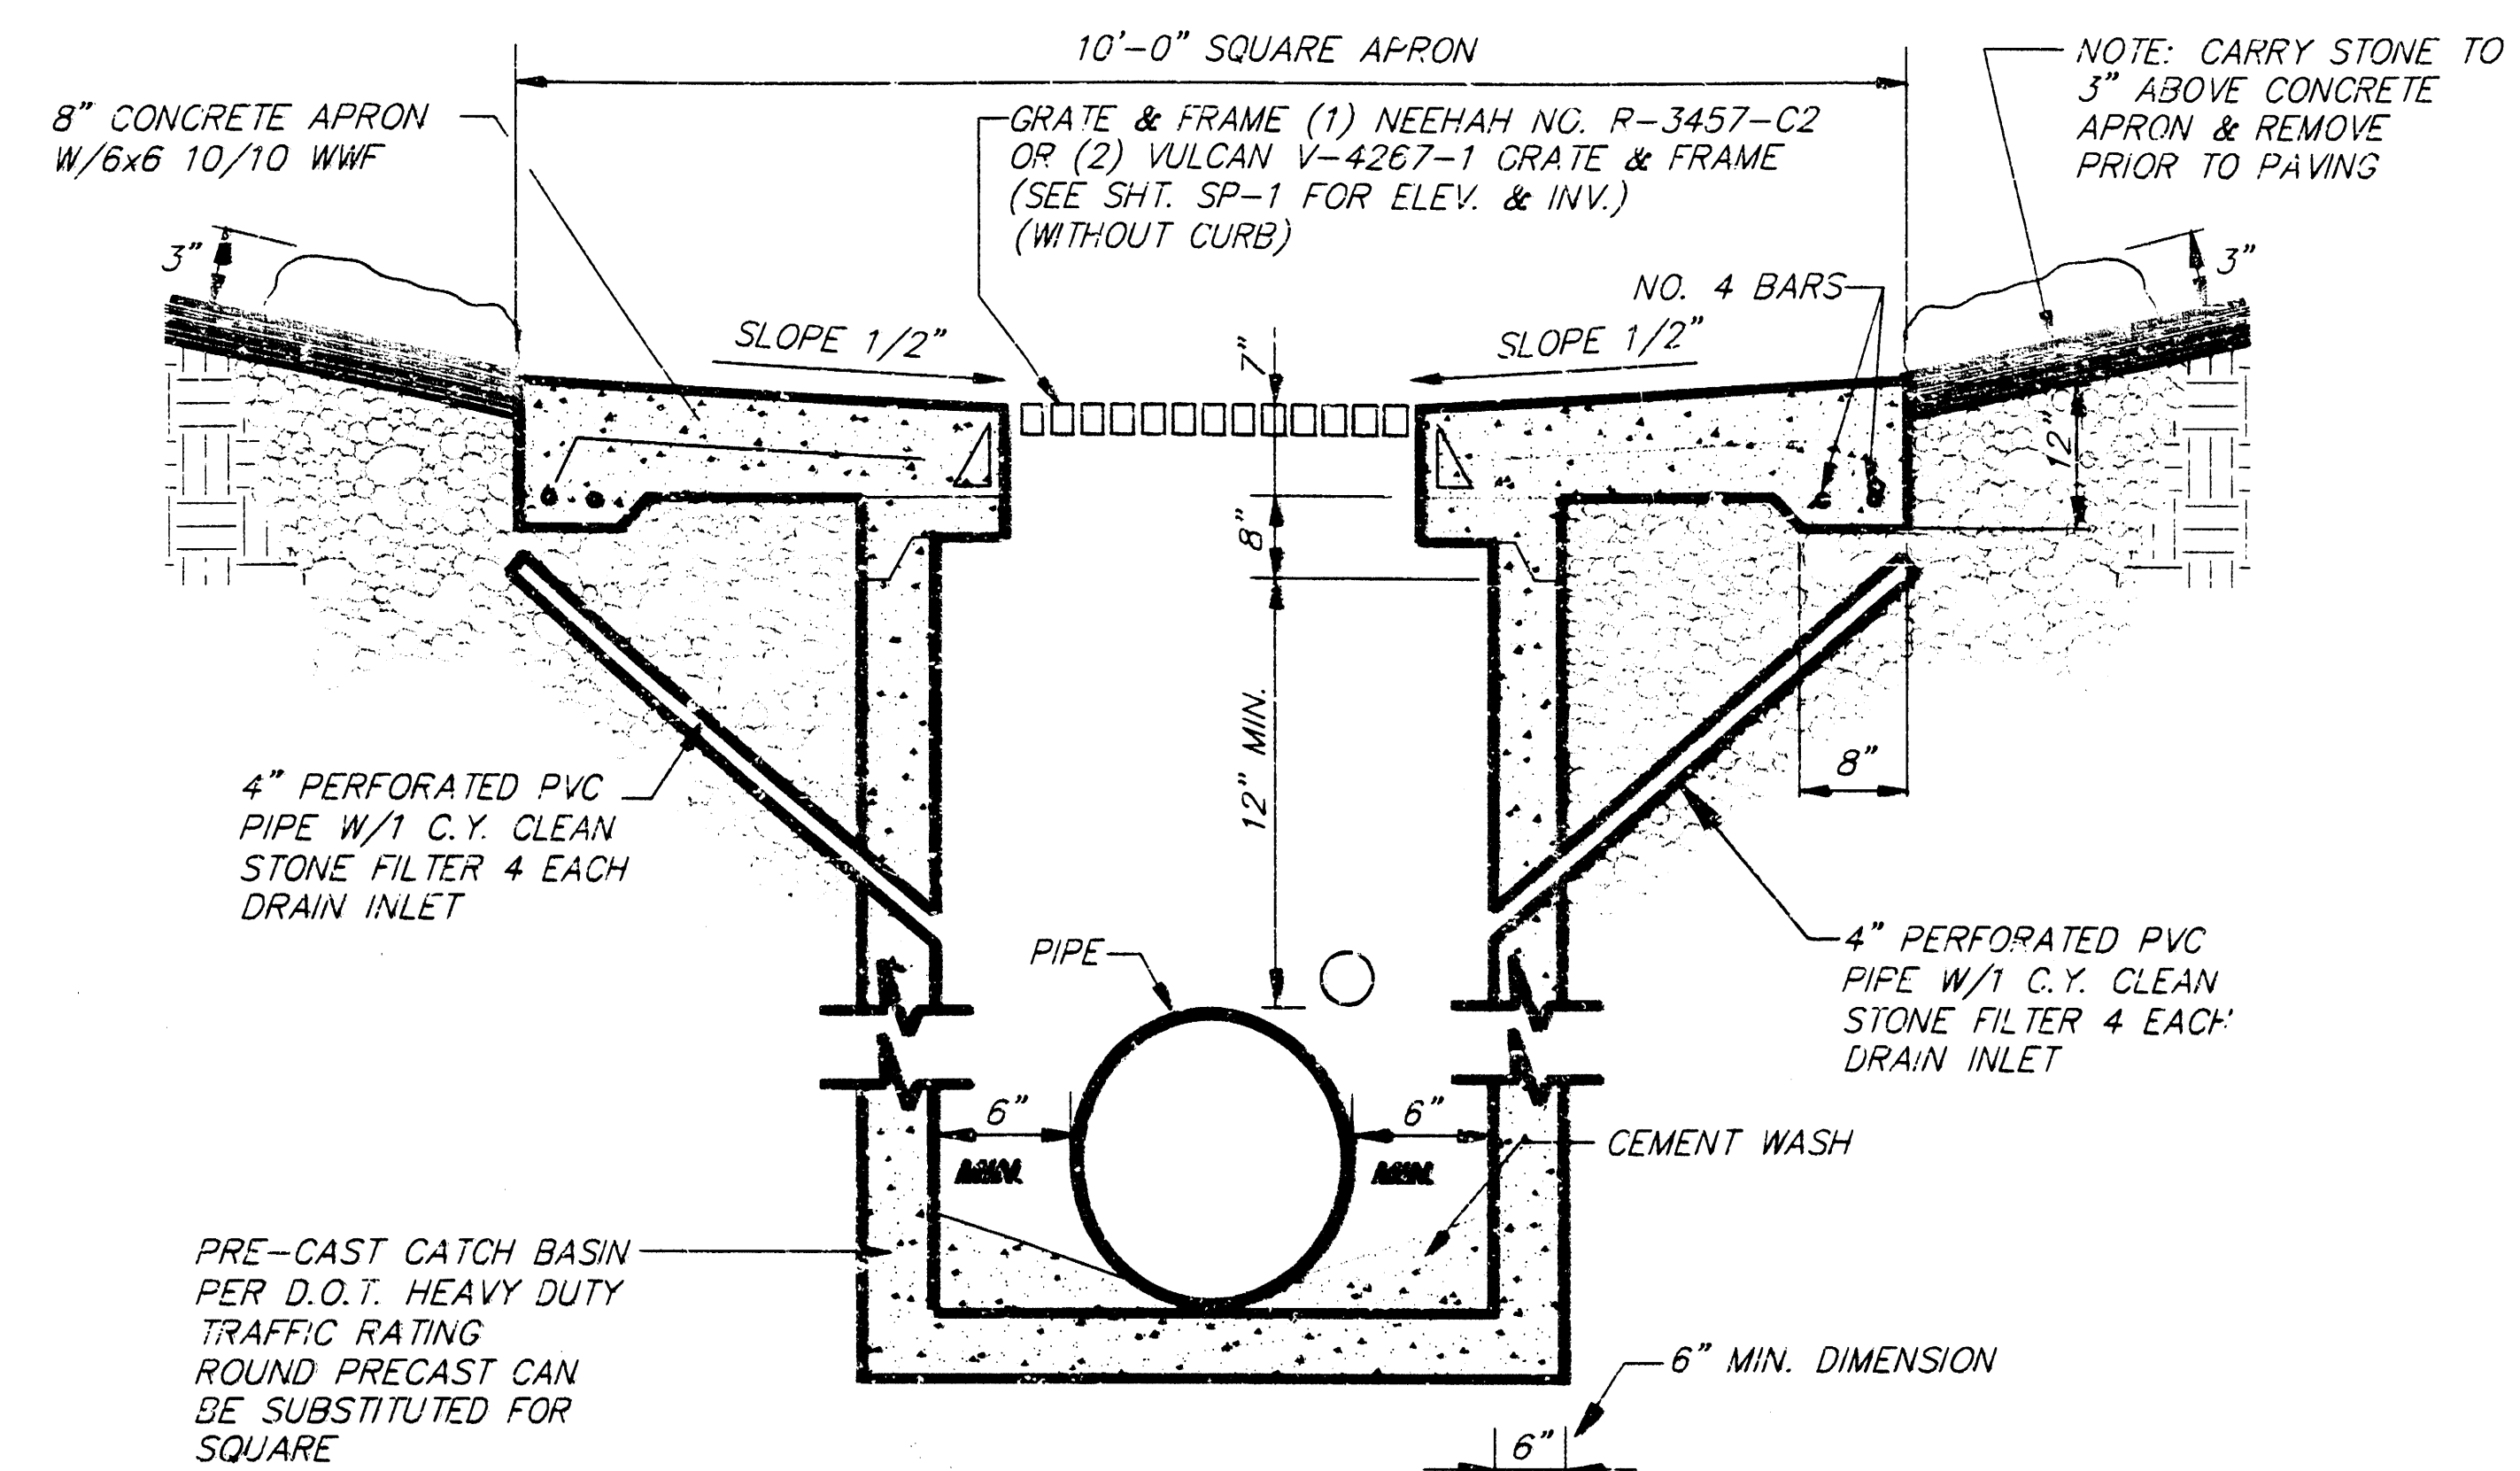

DRAIN INLET TYPE A
NO SCALE

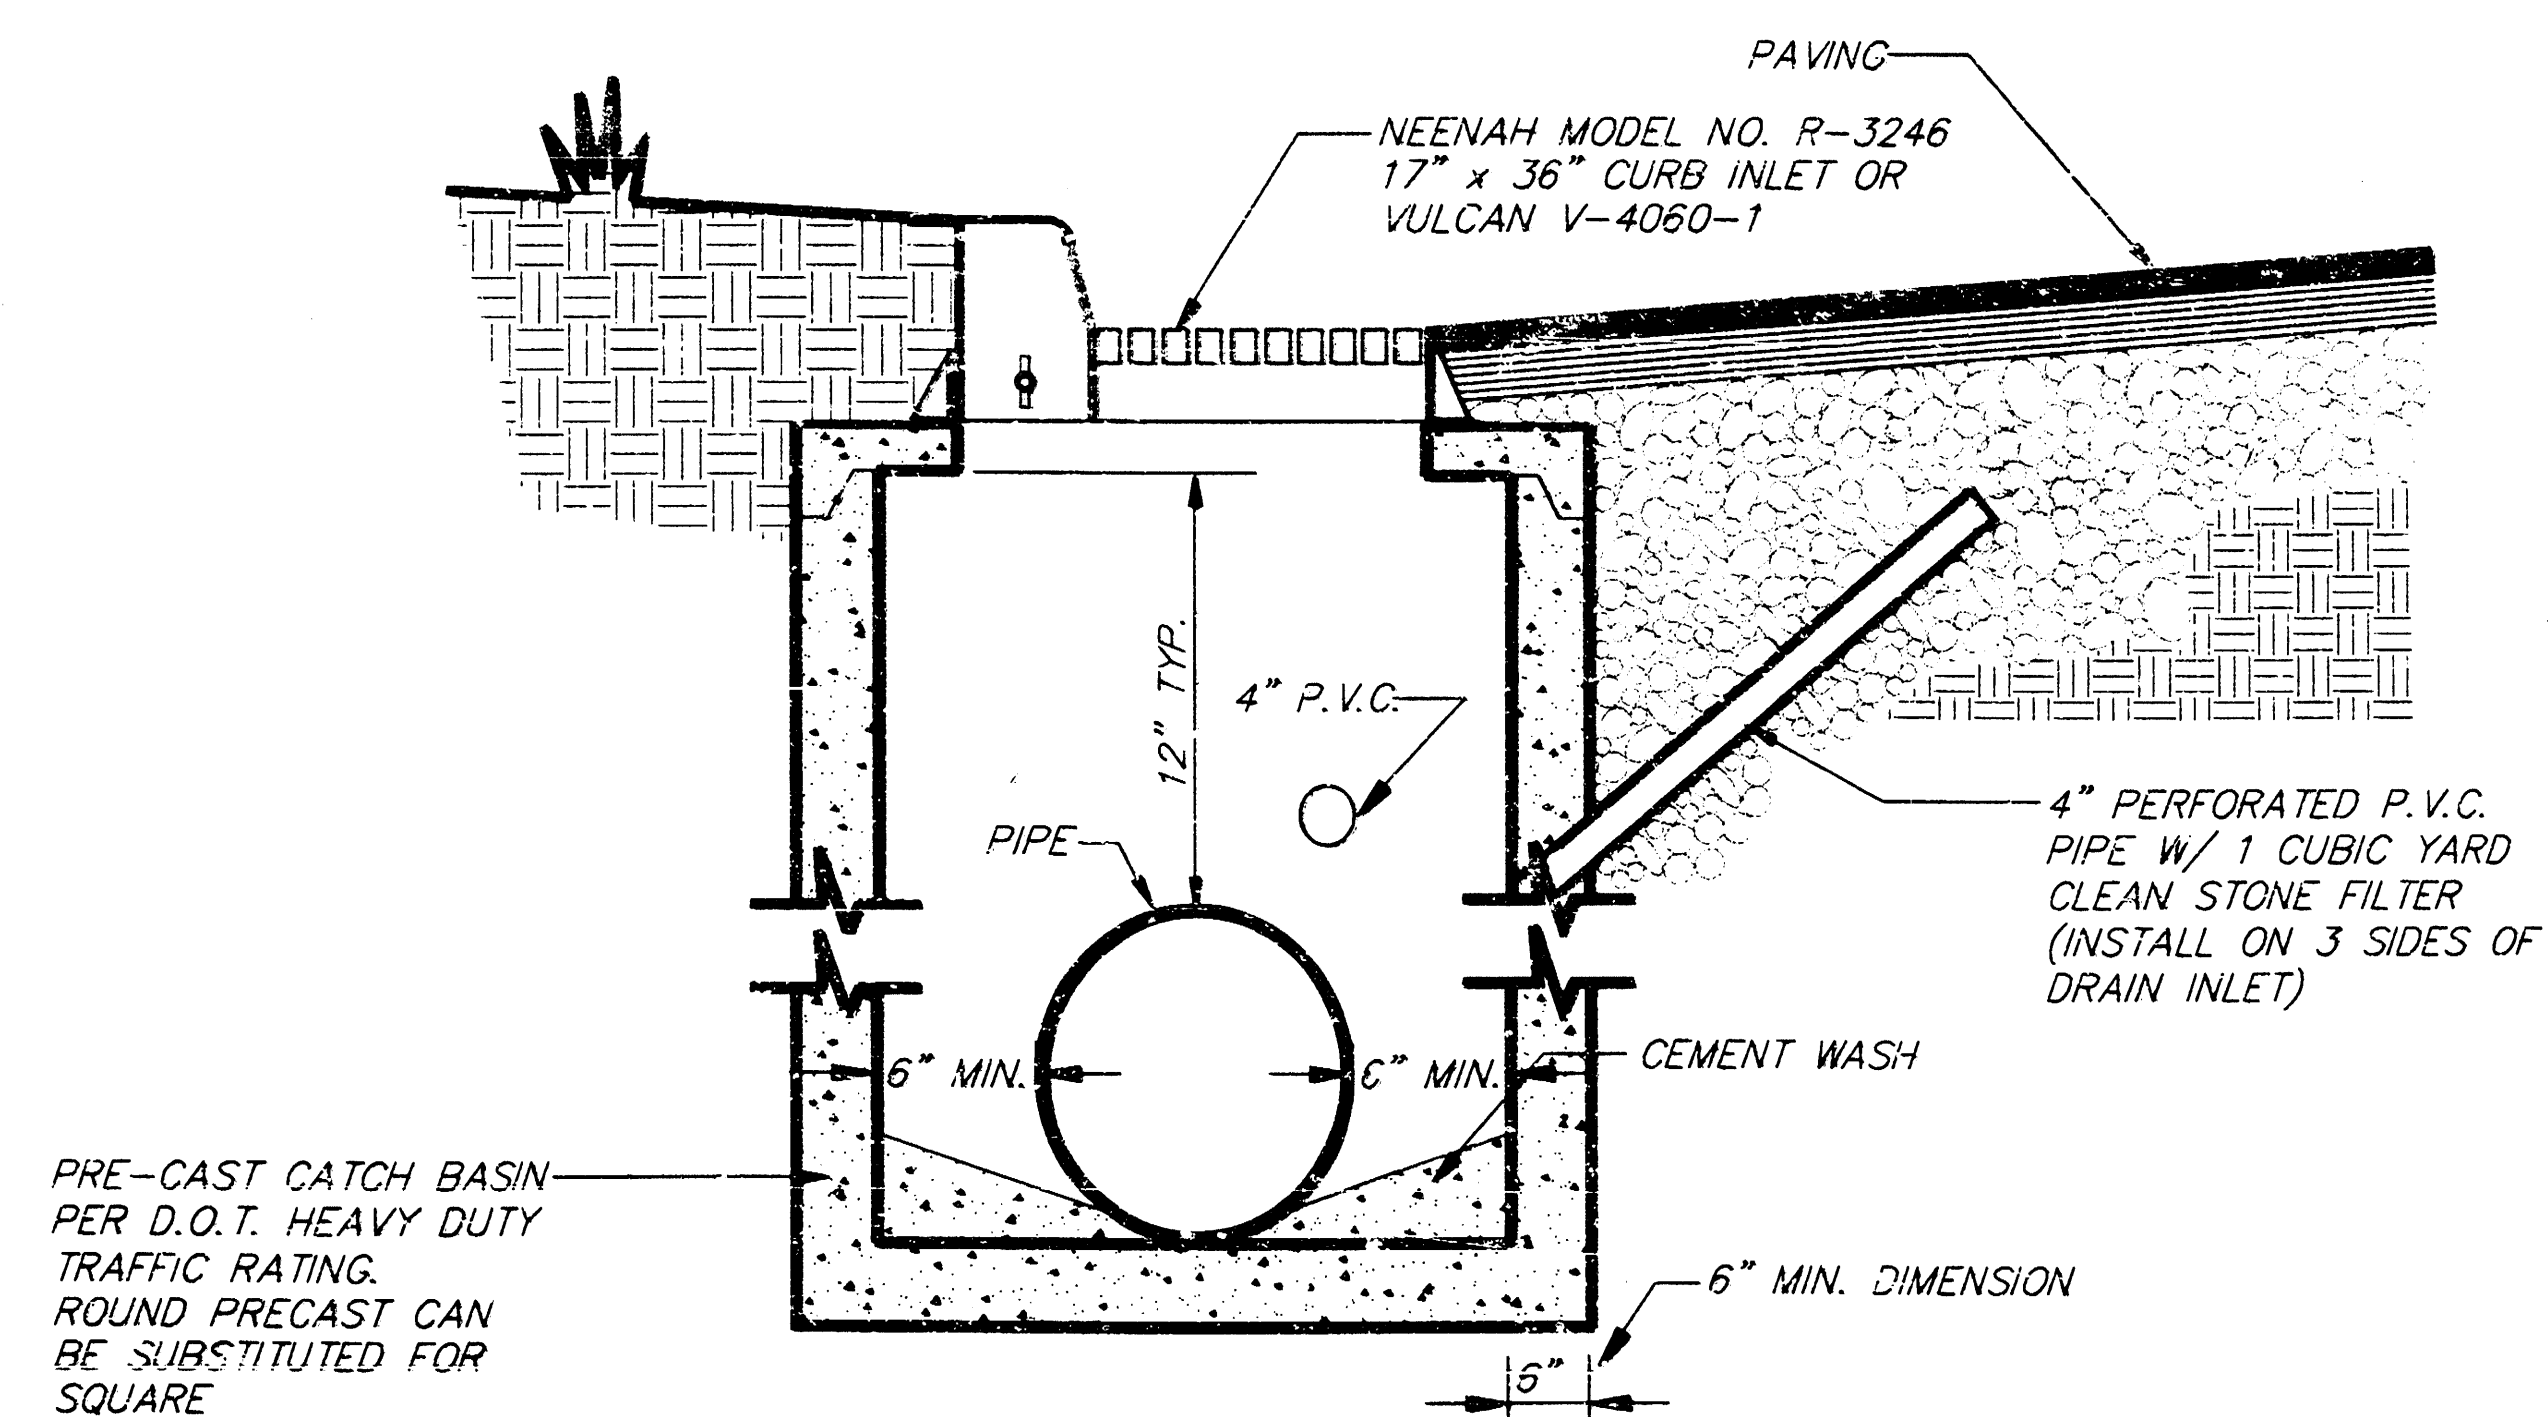

DRAIN INLET TYPE B
NO SCALE

Lowe's Addition				
Drainage Details				
BAUGHMAN COMPANY P.A.				
ENGINEERING, SURVEYING, & PLANNING				
318-202-2271 • 315 ELLIS • WICHITA, KANSAS 67211				
PROJECT NUMBER 740 FPS (607881)				SHEET 11
DESIGN	DRAWN STAFF	APPROVED	D.T.E.	SCALE NONE
				12

LOWE'S ADDITION

WICHITA, SEDGWICK COUNTY, KANSAS

State of Kansas, Sedgwick County) We, Baughman Company, P.A. Surveyors in aforesaid County and State do hereby certify that we have surveyed and platted "LOWE'S ADDITION", Wichita, Sedgwick County, Kansas and that the accompanying plot is a true and correct exhibit of the property surveyed, described as follows:


Lot 1, Ridge Plaza 7th Addition TOGETHER with a tract in the Northeast Quarter of Section 28, Township 27 South, Range 1 West of the Sixth Principal Meridian, Sedgwick County, Kansas described as beginning at a point on the North line of said Northeast Quarter, 1097 feet West of the Northeast corner of said Northeast Quarter; thence Southerly, along the East line of the Drainage Dedication recorded on film 88, page 994 and parallel with the East line of said Northeast Quarter, 138.61 feet to the point of curvature of a curve to the left having a radius of 1228.04 feet and a central angle of 26 degrees, 19 minutes, 15 seconds; thence Southeasterly along said curve 564.14 feet to the point of tangency of said curve; thence Southeasterly, along said curve, 125.33 feet; thence Easterly, with a deflection angle to the left of 84 degrees, 42 minutes, 67.45 feet to the point of curvature of a curve to the right having a radius of 240 feet and a central angle of 84 degrees, 42 minutes; thence Southwesterly, along said curve 354.1 feet to the point of tangency of said curve; thence Southeasterly, tangent to said curve, 94.31 feet to the point of curvature of a curve to the left having a radius of 447.88 feet and a central angle of 30 degrees, 29 minutes, 30 seconds; thence Southeasterly, along said curve, 238.35 feet to the West line of Ridge Road as dedicated on film 165, page 1248;

thence Northeasterly, along said West line of said Ridge Road, with a deflection angle to the left from the tangent of said curve of 87 degrees, 40 minutes, 11 seconds, 168.81 feet; thence continuing along said West line of said Ridge Road on a curve to the left having a radius of 1218.24 feet and a central angle of 20 degrees, 36 minutes, 04 seconds, 438.03 feet to the Southeast corner of said Ridge Plaza 7th Addition; thence Westerly, along said South line of said Ridge Plaza 7th Addition to the Southwest corner of said Ridge Plaza 7th Addition; thence Northerly, along the West line of said Ridge Plaza 7th Addition to a point on the North line of said Northeast Quarter, 619.83 feet West of the Northeast corner of said Northeast Quarter; thence West along said North line, 477.17 feet to the point of beginning.

Existing public easements and dedications being vacated by virtue of K.S.A. 12-512(b).

Baughman Company, P.A.

Gregory F. Severns

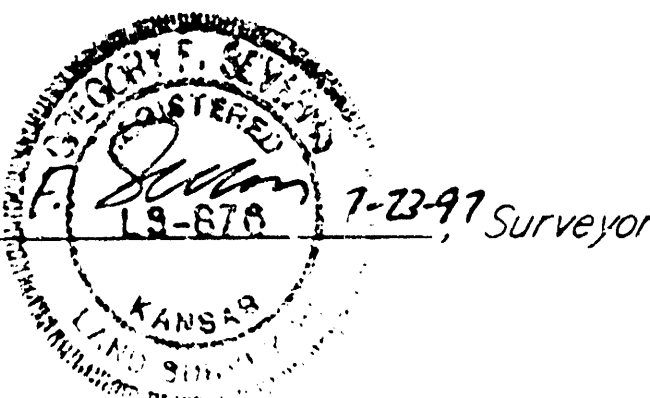

Know all men by these presents that we, the undersigned, have caused the land in the surveyors certificate to be platted into a Lot and Streets to be known as "LOWE'S ADDITION", Wichita, Sedgwick County, Kansas. The utility easements are hereby granted as indicated for the construction and maintenance of all public utilities. The streets are hereby dedicated to and for the use of the public. All abutters rights of access to or from Maple Street, Ridge Road, Mid-Continent Road, and Taft shall be as indicated on the face of the plot. The Minimum Building Pad Elevation for the lowest opening to the structures shall be as shown on the face of the plot.

The Trustees under the Will and of the Estate of James Campbell, deceased

C.D. Pratt, Jr., Trustee

P.R. Cassidy, Trustee

C.R. Churchill, Trustee

D.A. Heenan, Trustee

This plat of "LOWE'S ADDITION", Wichita, Sedgwick County, Kansas has been submitted to and approved by the Wichita-Sedgwick County Metropolitan Area Planning Commission, Wichita, Kansas.

Dated this 19th day of July, 1997. Wichita-Sedgwick County Metropolitan Area Planning Commission

John C. Frye, Chairman

Marvin S. Krout, Secretary

This plat approved and all dedications shown hereon accepted by the City Council of the City of Wichita, Kansas, this 19th day of July, 1997.

Bob Knight, Mayor

Pat Burnett, City Clerk

Entered on transfer record this 19th day of July, 1997.

James Alford, County Clerk

State of Kansas) SS This is to certify that this plat has been filed for record in the office of the Register of Deeds, this 19th day of July, 1997, at 10 o'clock A.M. and is duly recorded.

Larry Conslaver, Register of Deeds

Michael D. Hurtt, Deputy

State of Hawaii) SS Be it remembered, that on this 25th day of July, 1997, before me, the undersigned, a Notary Public, in and for the County and State aforesaid, came D.A. Heenan, Trustee under the Will and of the Estate of James Campbell, deceased, who is personally known to me to be the same person who executed the within instrument of writing and such person duly acknowledged the execution of the same. In testimony whereof, I have hereunto set my hand and affixed my official seal the day and year above written.

My App'l. Exp. Feb. 11, 2000. Lydia L. Hammann, Notary Public

State of Hawaii) SS Be it remembered, that on this 25th day of July, 1997, before me, the undersigned, a Notary Public, in and for the County and State aforesaid, came C.D. Pratt, Jr., Trustee under the Will and of the Estate of James Campbell, deceased, who is personally known to me to be the same person who executed the within instrument of writing and such person duly acknowledged the execution of the same. In testimony whereof, I have hereunto set my hand and affixed my official seal the day and year above written.


My App'l. Exp. Feb. 11, 2000. Lydia L. Hammann, Notary Public

State of Hawaii) SS Be it remembered, that on this 25th day of July, 1997, before me, the undersigned, a Notary Public, in and for the County and State aforesaid, came P.R. Cassidy, Trustee under the Will and of the Estate of James Campbell, deceased, who is personally known to me to be the same person who executed the within instrument of writing and such person duly acknowledged the execution of the same. In testimony whereof, I have hereunto set my hand and affixed my official seal the day and year above written.

My App'l. Exp. Feb. 11, 2000. Lydia L. Hammann, Notary Public

State of Hawaii) SS Be it remembered, that on this 25th day of July, 1997, before me, the undersigned, a Notary Public, in and for the County and State aforesaid, came C.R. Churchill, Trustee under the Will and of the Estate of James Campbell, deceased, who is personally known to me to be the same person who executed the within instrument of writing and such person duly acknowledged the execution of the same. In testimony whereof, I have hereunto set my hand and affixed my official seal the day and year above written.

Lydia L. Hammann, Notary Public

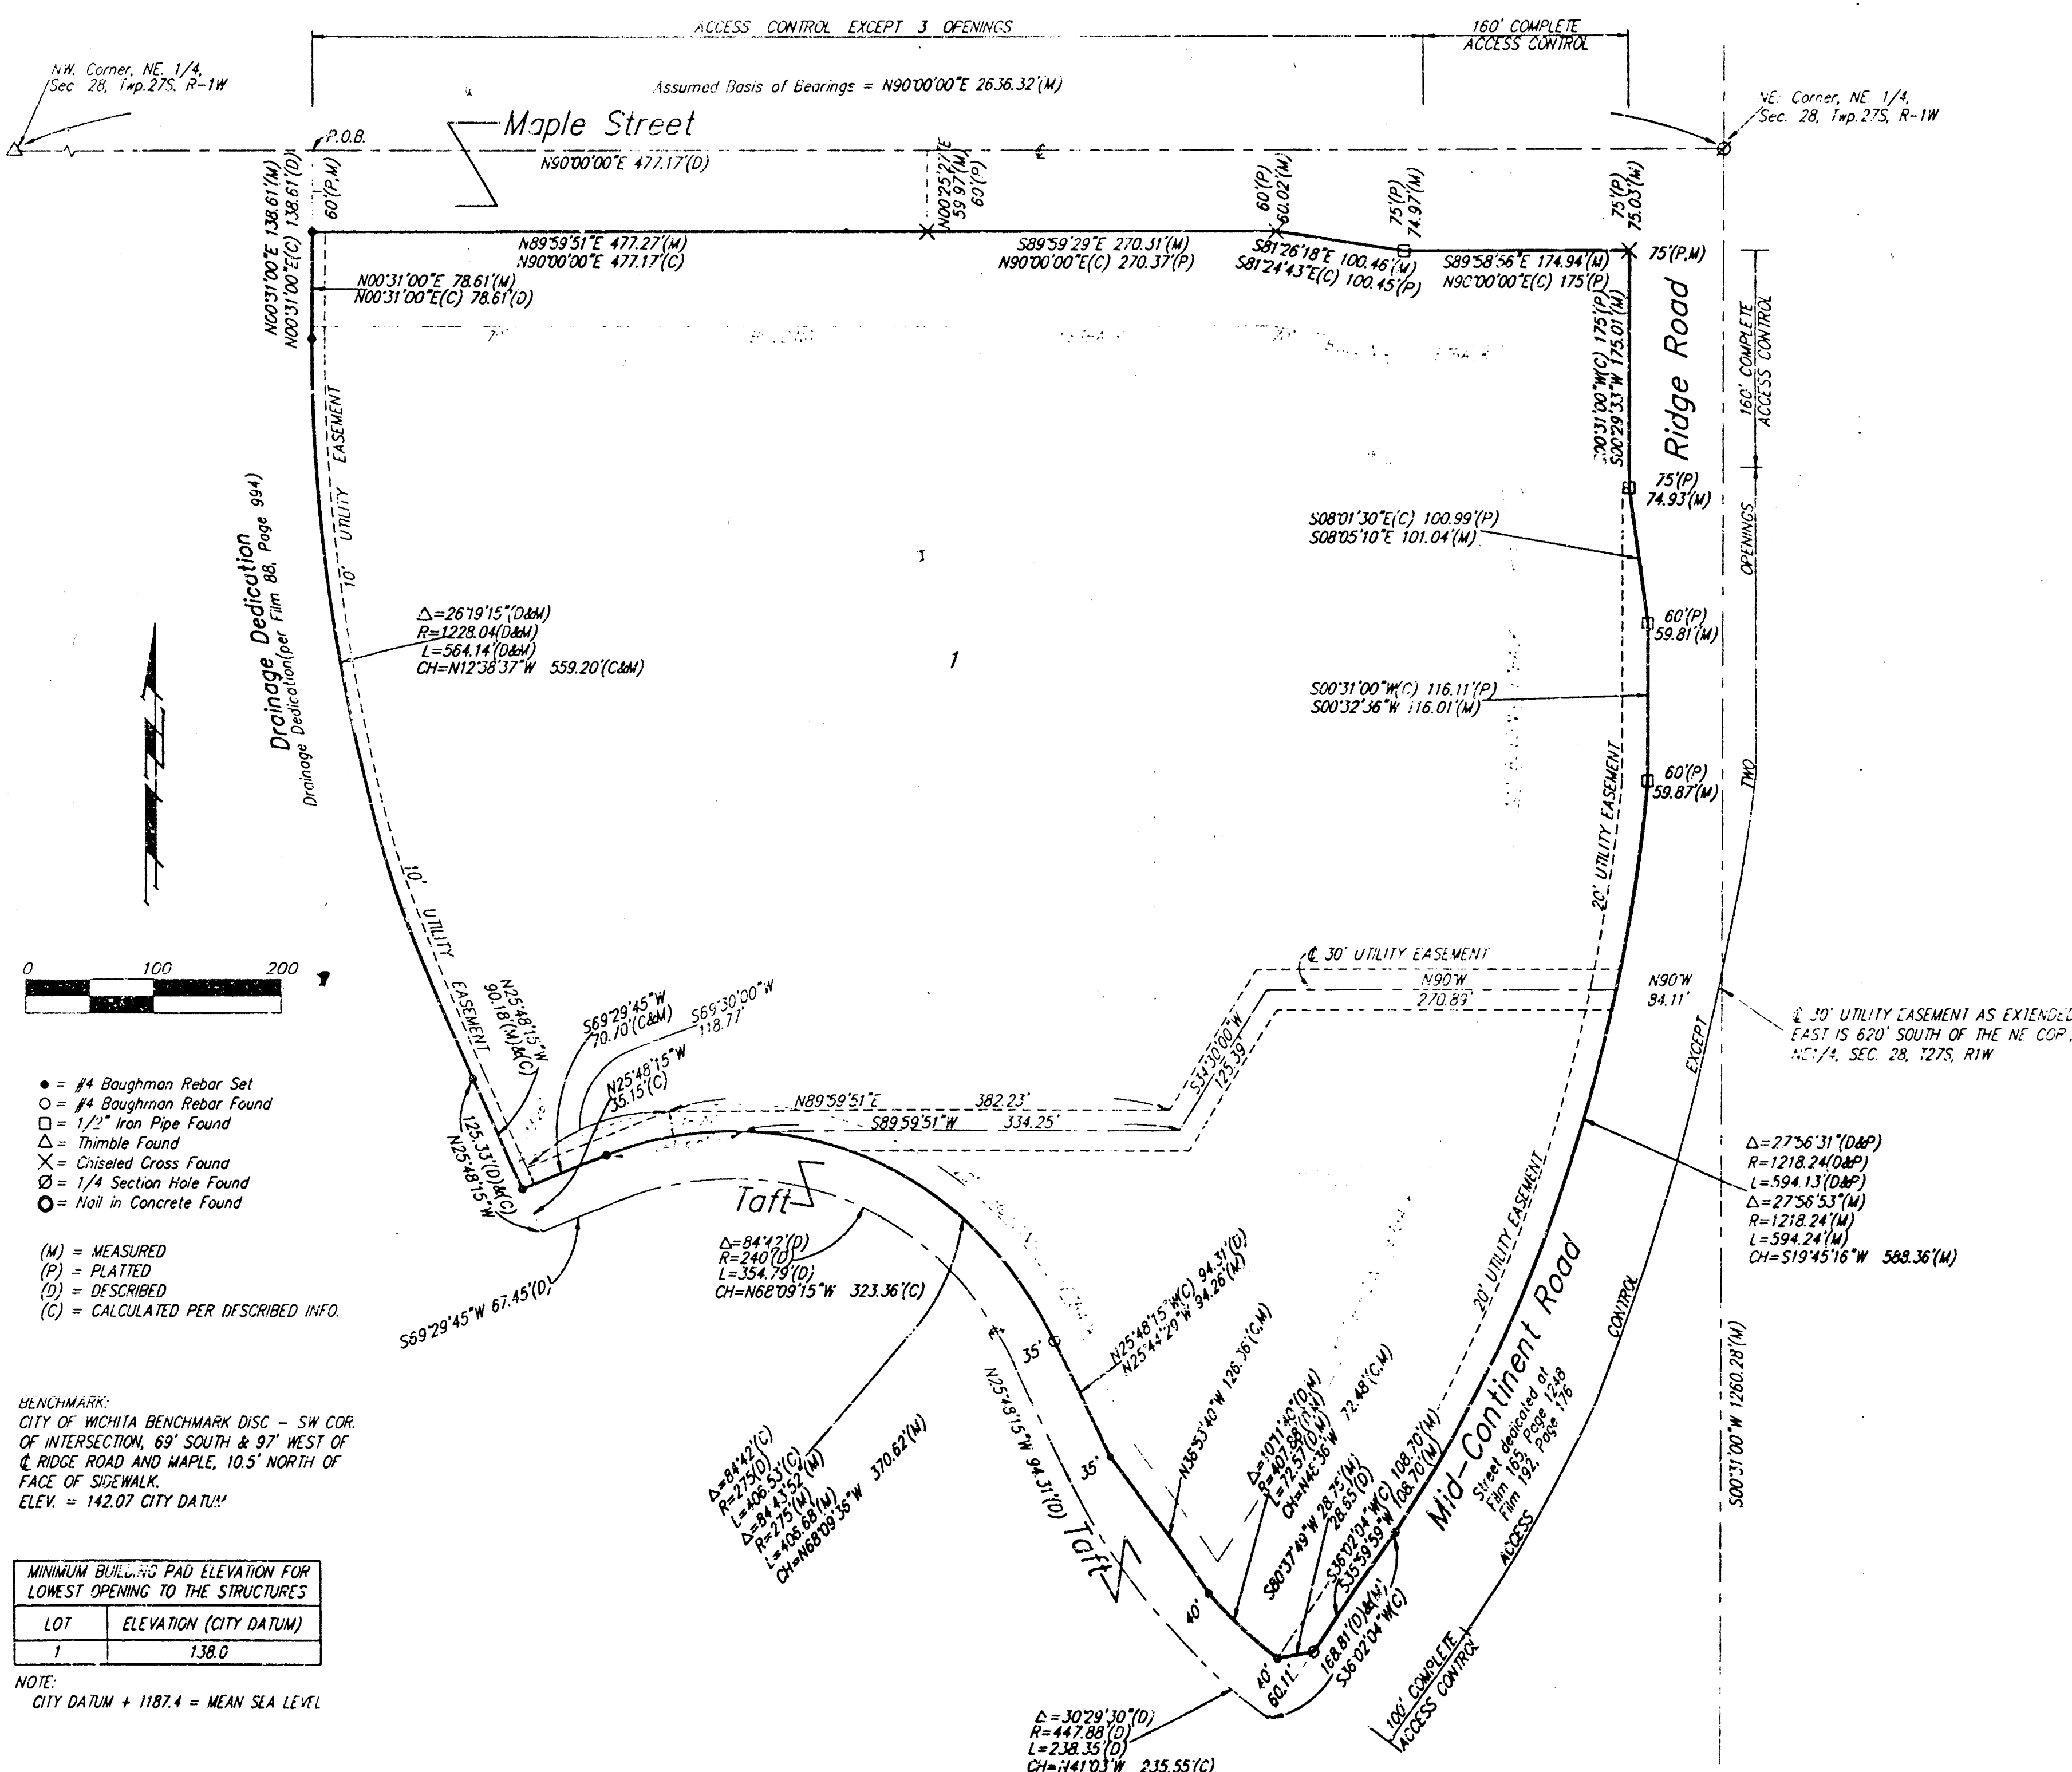

NOTE: