
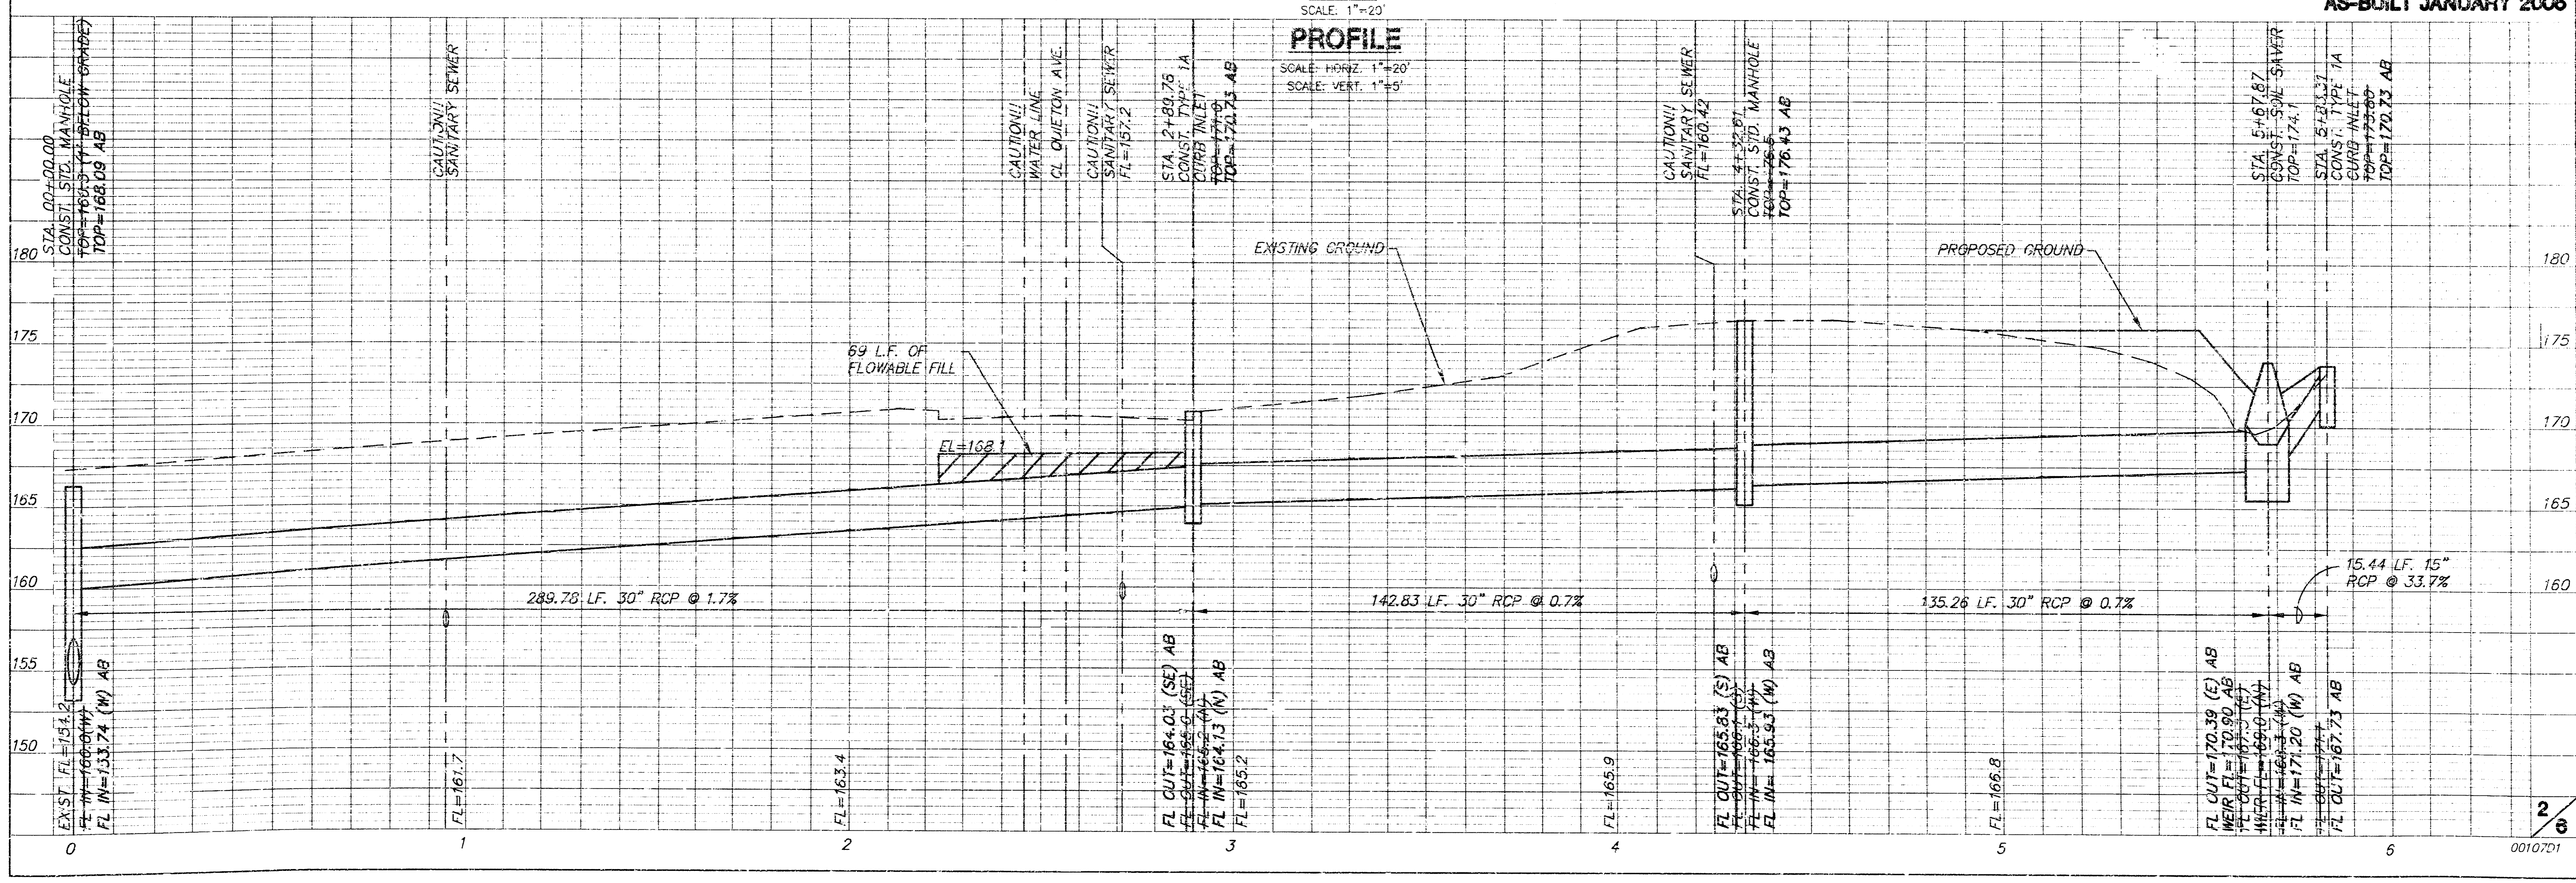


**BLESSED SACRAMENT PHASE II
STORM WATER SEWER PLANS
LINE 1**

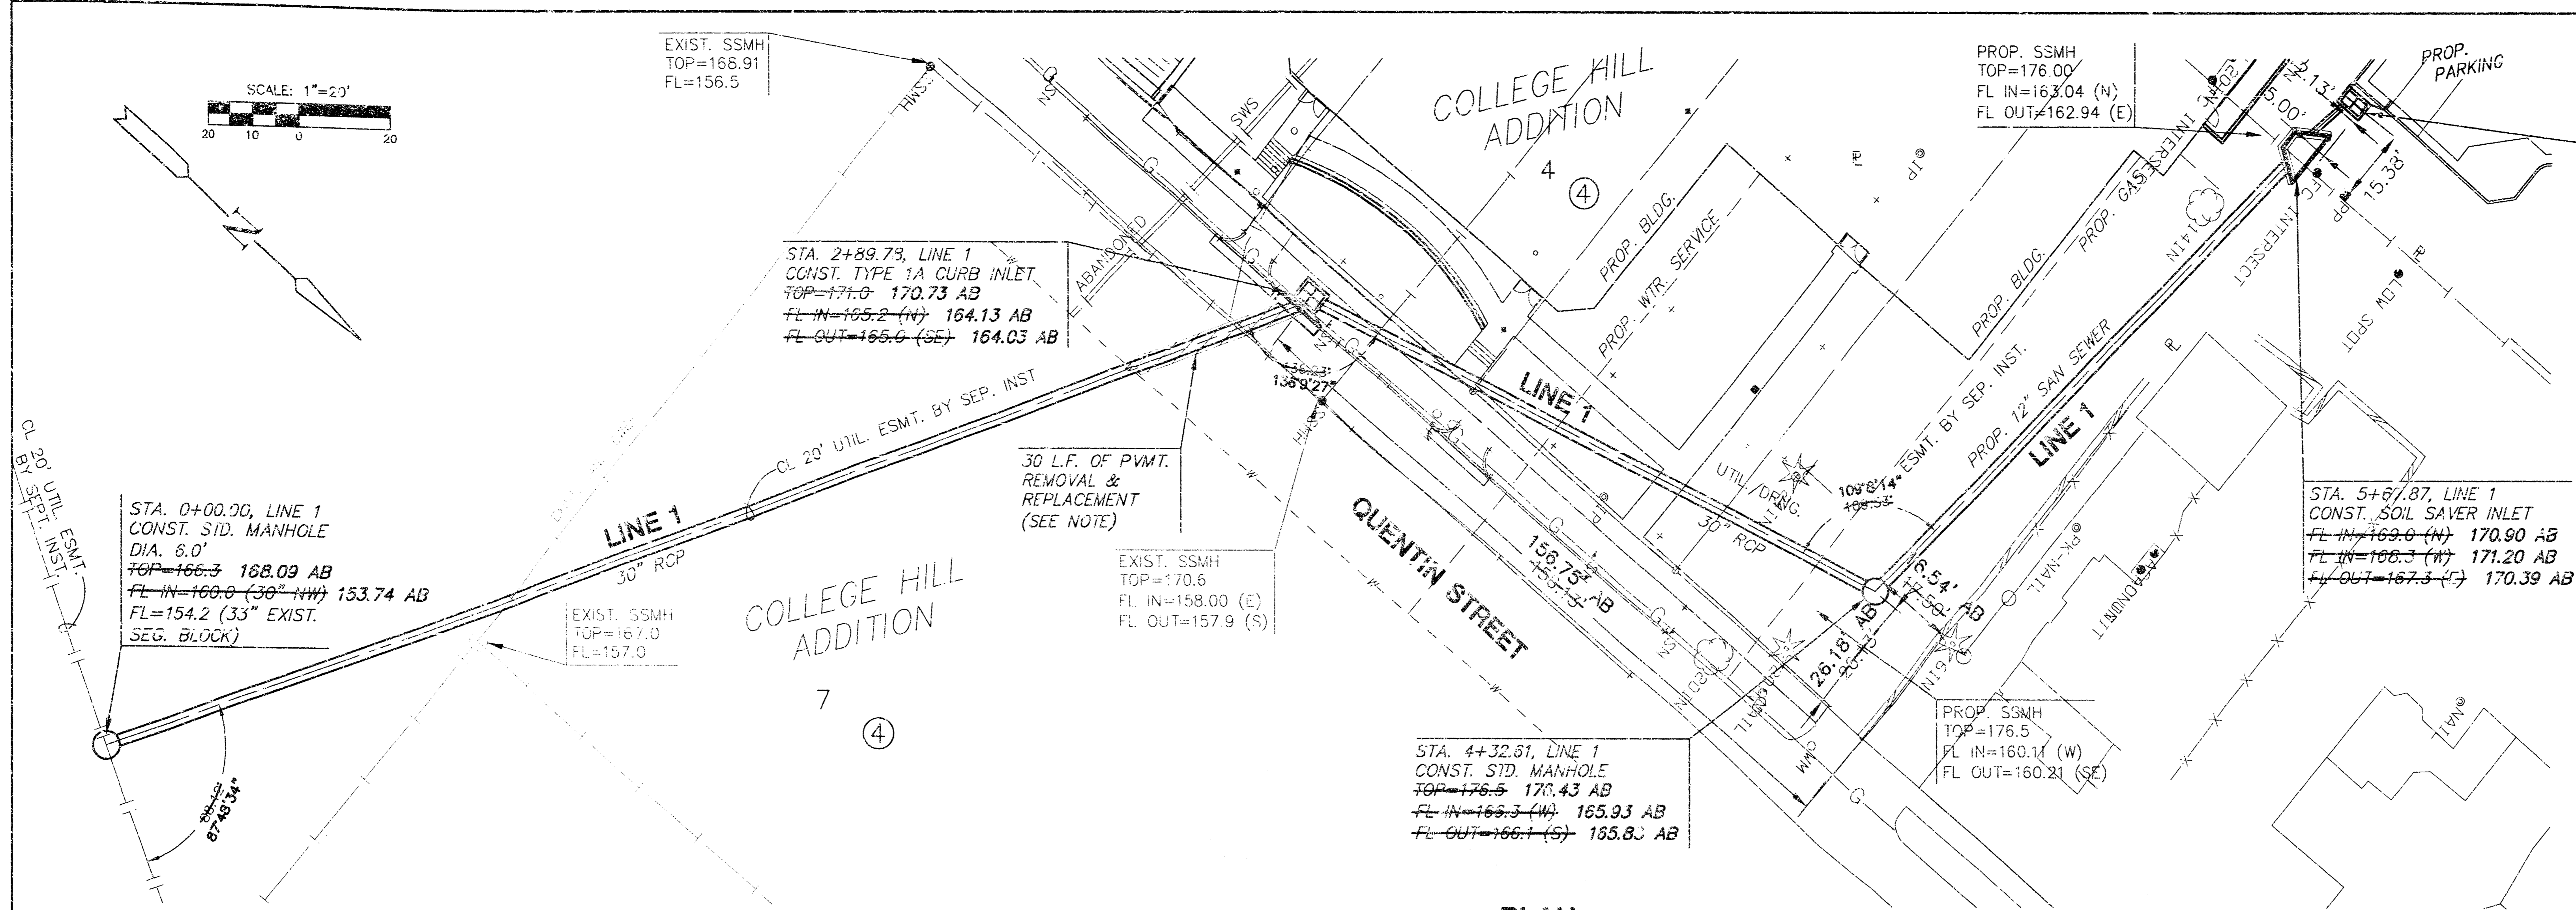

AS-BUILT JANUARY 2006