



BENCHMARK:
 Railroad Spike in the E side of Power Pole, @ the NW Corner intersection of Eisenhower & 3rd St. N.
 Elevation = 122.76 (City Datum)

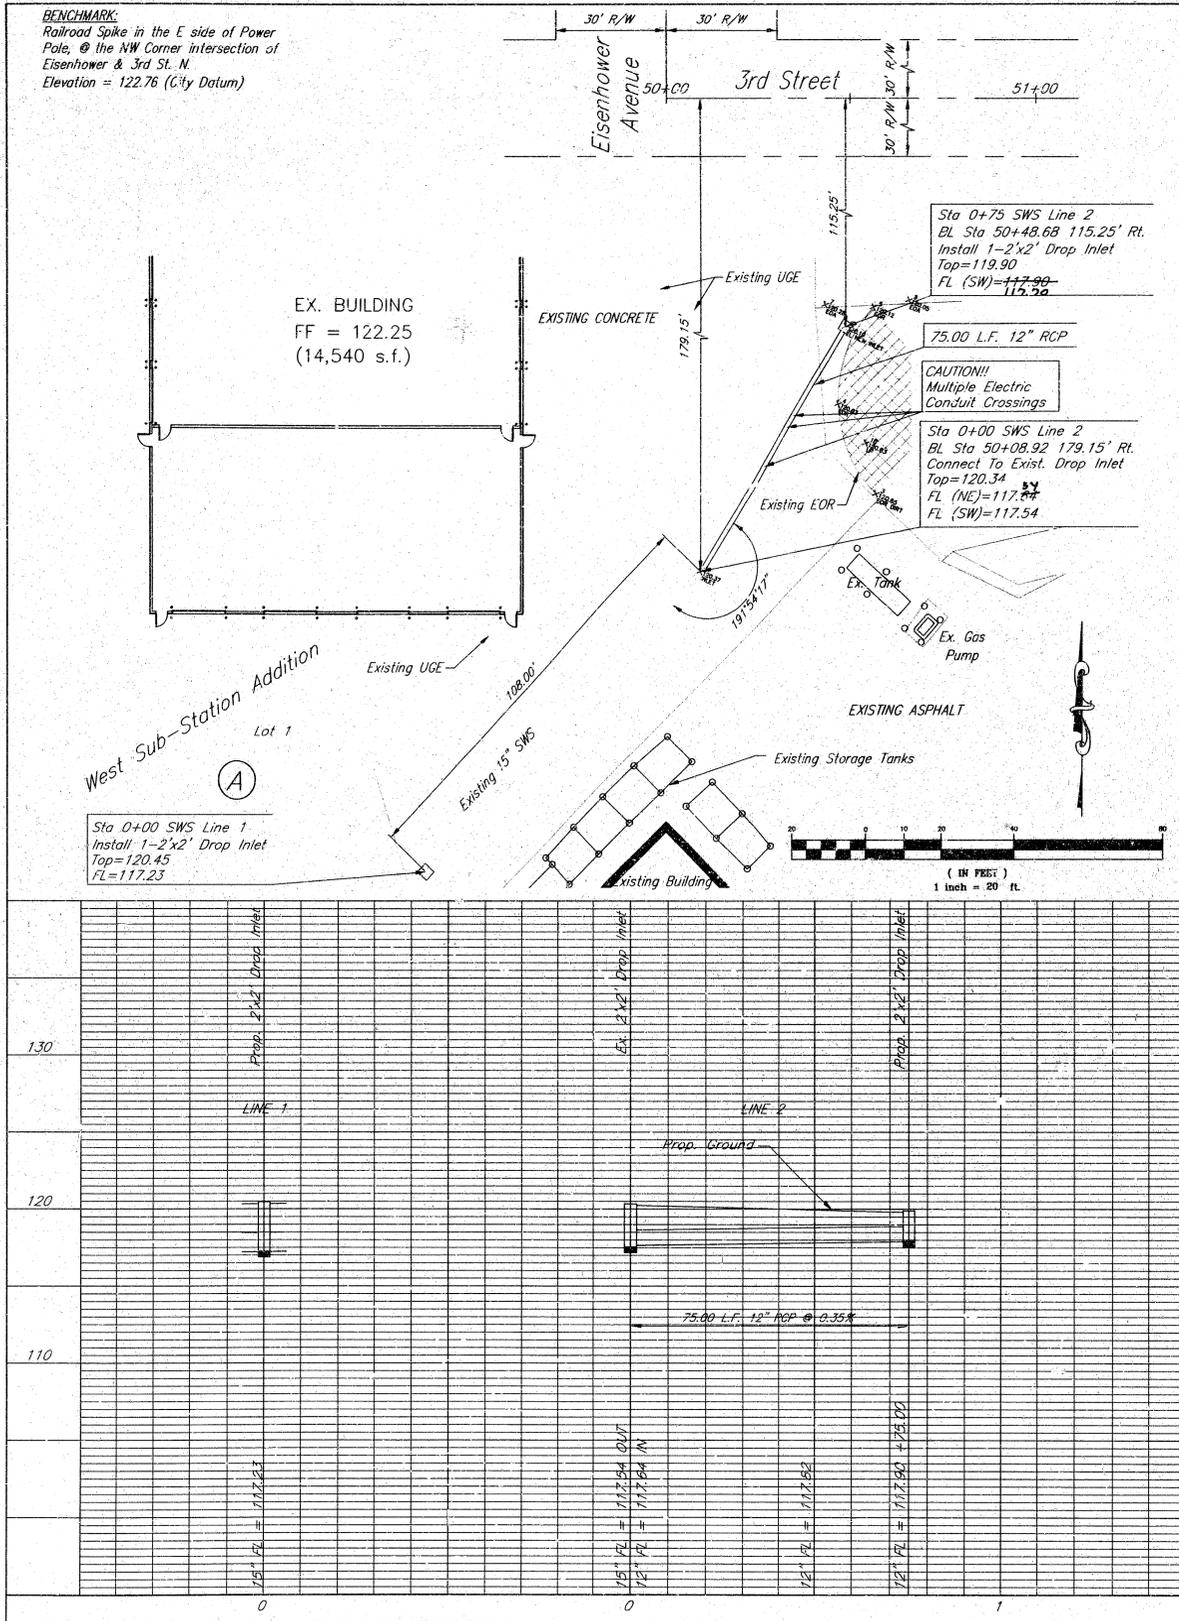

STORM SEWER TO SERVE WEST SUB-STATION


5801 W. 3RD STREET
 LOT 1, BLOCK A
 WEST SUB-STATION ADDITION
 1263 PPS (607861)
 CITY OF WICHITA, KANSAS

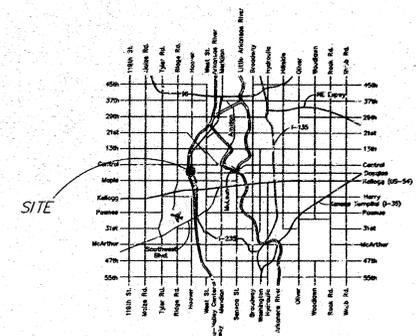

GENERAL NOTES

- Contractor will be required to provide notice to utility companies a minimum of twenty-four (24) hours prior to any excavation, as follows:
 Kansas One-Call 687-2470
 The Contractor must notify the following in case of an emergency:
 Kansas Gas & Electric 363-8850
 Kansas Gas & Electric Company 363-8800
 Peoples Natural Gas 942-8811
 Southwestern Bell Telephone Company 1-571-2611
 City of Wichita Water Department 268-4908
 City of Wichita Sewer Department 268-4071
 Kansas Gas Service 832-3168
 Kansas Gas Service 832-3167
 Peoples Natural Gas 942-8811
 or 1-800-301-0357
- Exist. utilities and their locations, as shown on the plans, represent the best information obtainable for design. Loc. information has been obtained from the various utility companies and is either from company record drawings or company-provided field locations. The Contractor will be required to work around existing utilities which do not conflict with proposed construction.
- The Contractor to verify utility locations prior to construction of this project.
- Utility service and installation shall be coordinated with the respective utility owners. Contacts are:
 Kansas Gas Service James Stutz 831-3122
 Kansas Gas & Electric Russ Chilwood 261-8251
 Peoples Natural Gas John Stark 942-8811
 Wichita Water Paul Bryant 268-4555
 Steve Palmer 268-4908
 Southwestern Bell Jim Tobin 268-2759
 Multimedia Cablevision Mark Anaya 262-4270
- All lawn/turf areas disturbed by construction of proposed improvements shall be restored with sod. All sodding work shall be in accordance with the City of Wichita Standard Specifications and the City of Wichita Administrative Regulation No. AR78 which governs cleanup and replacement following construction. All costs for this work shall be subsidiary to the lump sum price bid for "Site Restoration."
- Traffic affected by the construction of this project shall be handled in accordance with the latest edition of the Manual on Uniform Traffic Control Devices.
- All commercial signs to be moved by others prior to construction.
- Properties within the project may have underground irrigation systems (lawn sprinklers) which conflict with the new construction. Contractor shall remove such components as needed during construction of the project. The irrigation systems shall be reinstalled in like and before project completion. Any irrigation system modifications required because of project improvements shall be coordinated with the property owner. Portions of underground irrigation systems not in conflict with construction shall be protected from storage and shall remain in place. All work related to underground irrigation/sprinklers shall be subsidiary to Site Restoration.
- Cuts made to paved surfaces on public property will be required by the City's contractor and charged against the owner / applicant. Unit repair prices are available from the City at 268-4116. A surcharge may be applicable. Call 268-4116 for details. Repair costs to be paid prior to release of water service if water service is affected.

24" x 24" Frame and Grate Detail

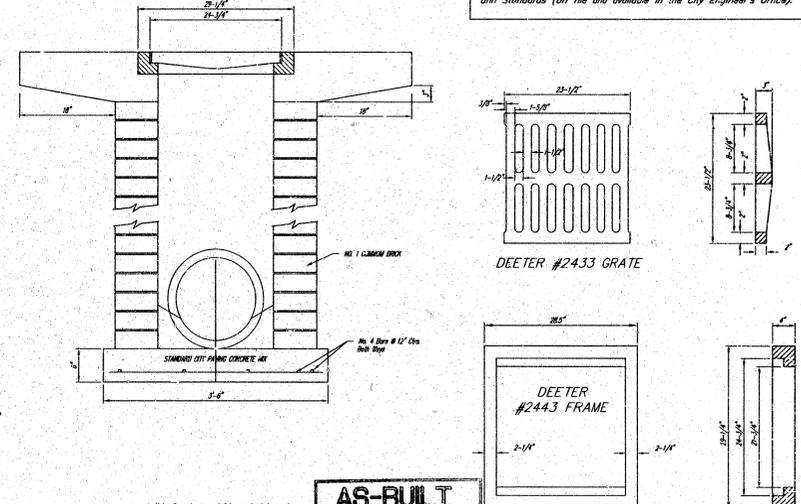

APPROVED AS NOTED

Storm Sewers

Julianne Kellman 7-23-02

NOTE TO CONTRACTORS

Installation, inspection and testing for this project is to be provided by a Licensed Consulting Engineering firm under contract with the Owner/Developer. Solid inspection to be in accordance with the City of Wichita standard construction engineering practices and certified by a Licensed Professional Engineer. No work shall be performed in dedicated easements or public right-of-way by the Contractor without such inspection nor shall any work be commenced without written authorization by the City Engineer. All Construction and Materials shall comply with the City of Wichita Specifications and Standards (on file and available in the City Engineer's Office).

- NOTES:
- Grates shall be imprinted on the top surface with "CITY OF WICHITA" using letters of least 1" in height. Other marking methods may be approved by the engineer.
 - Cuts made to paved surfaces on public property will be required by the City's contractor and charged against the owner / applicant. Unit repair prices are available from the City of 268-4116. A surcharge may be applicable. Call 268-4116 for details. Repair costs to be paid prior to release of water service if water service is affected.



| Wichita Water & Sewer Department Storm Sewer Wichita, Kansas | | | |
|--|---------|--------------|---------|
| PROJECT NUMBER | | | |
| kemiller engineering | KEY NO. | FILE | DATE |
| | 02061 | SWS1 | 7/02 |
| 516 S. Market Wichita, KS 67202 | DESIGN | DRAIN | REVISED |
| | KM | TR | |
| | | SHEET | 1 |
| | | OF | 1 |
| | | 316/264-0242 | |