

WATER DISTRIBUTION SYSTEM IMPROVEMENTS

TO SERVE

SEDGWICK COUNTY JUVENILE COURT COMPLEX


CITY OF WICHITA PRIVATE PROJECT NO. 1201 PPW (607853)

CITY OF WICHITA, KANSAS

JAMES L. ARMOUR, P.E. - ACTING CITY ENGINEER

INDEX OF SHEETS

1	TITLE SHEET
2	KEY MAP AND GENERAL NOTES
3	STANDARD WATER ASSEMBLY DETAILS
4-6	PLAN/PROFILE
CV601	SOIL EROSION BMP COMMERCIAL
CV602	SOIL EROSION BMP
CV603	SOIL EROSION BMP
CV604	SOIL EROSION BMP

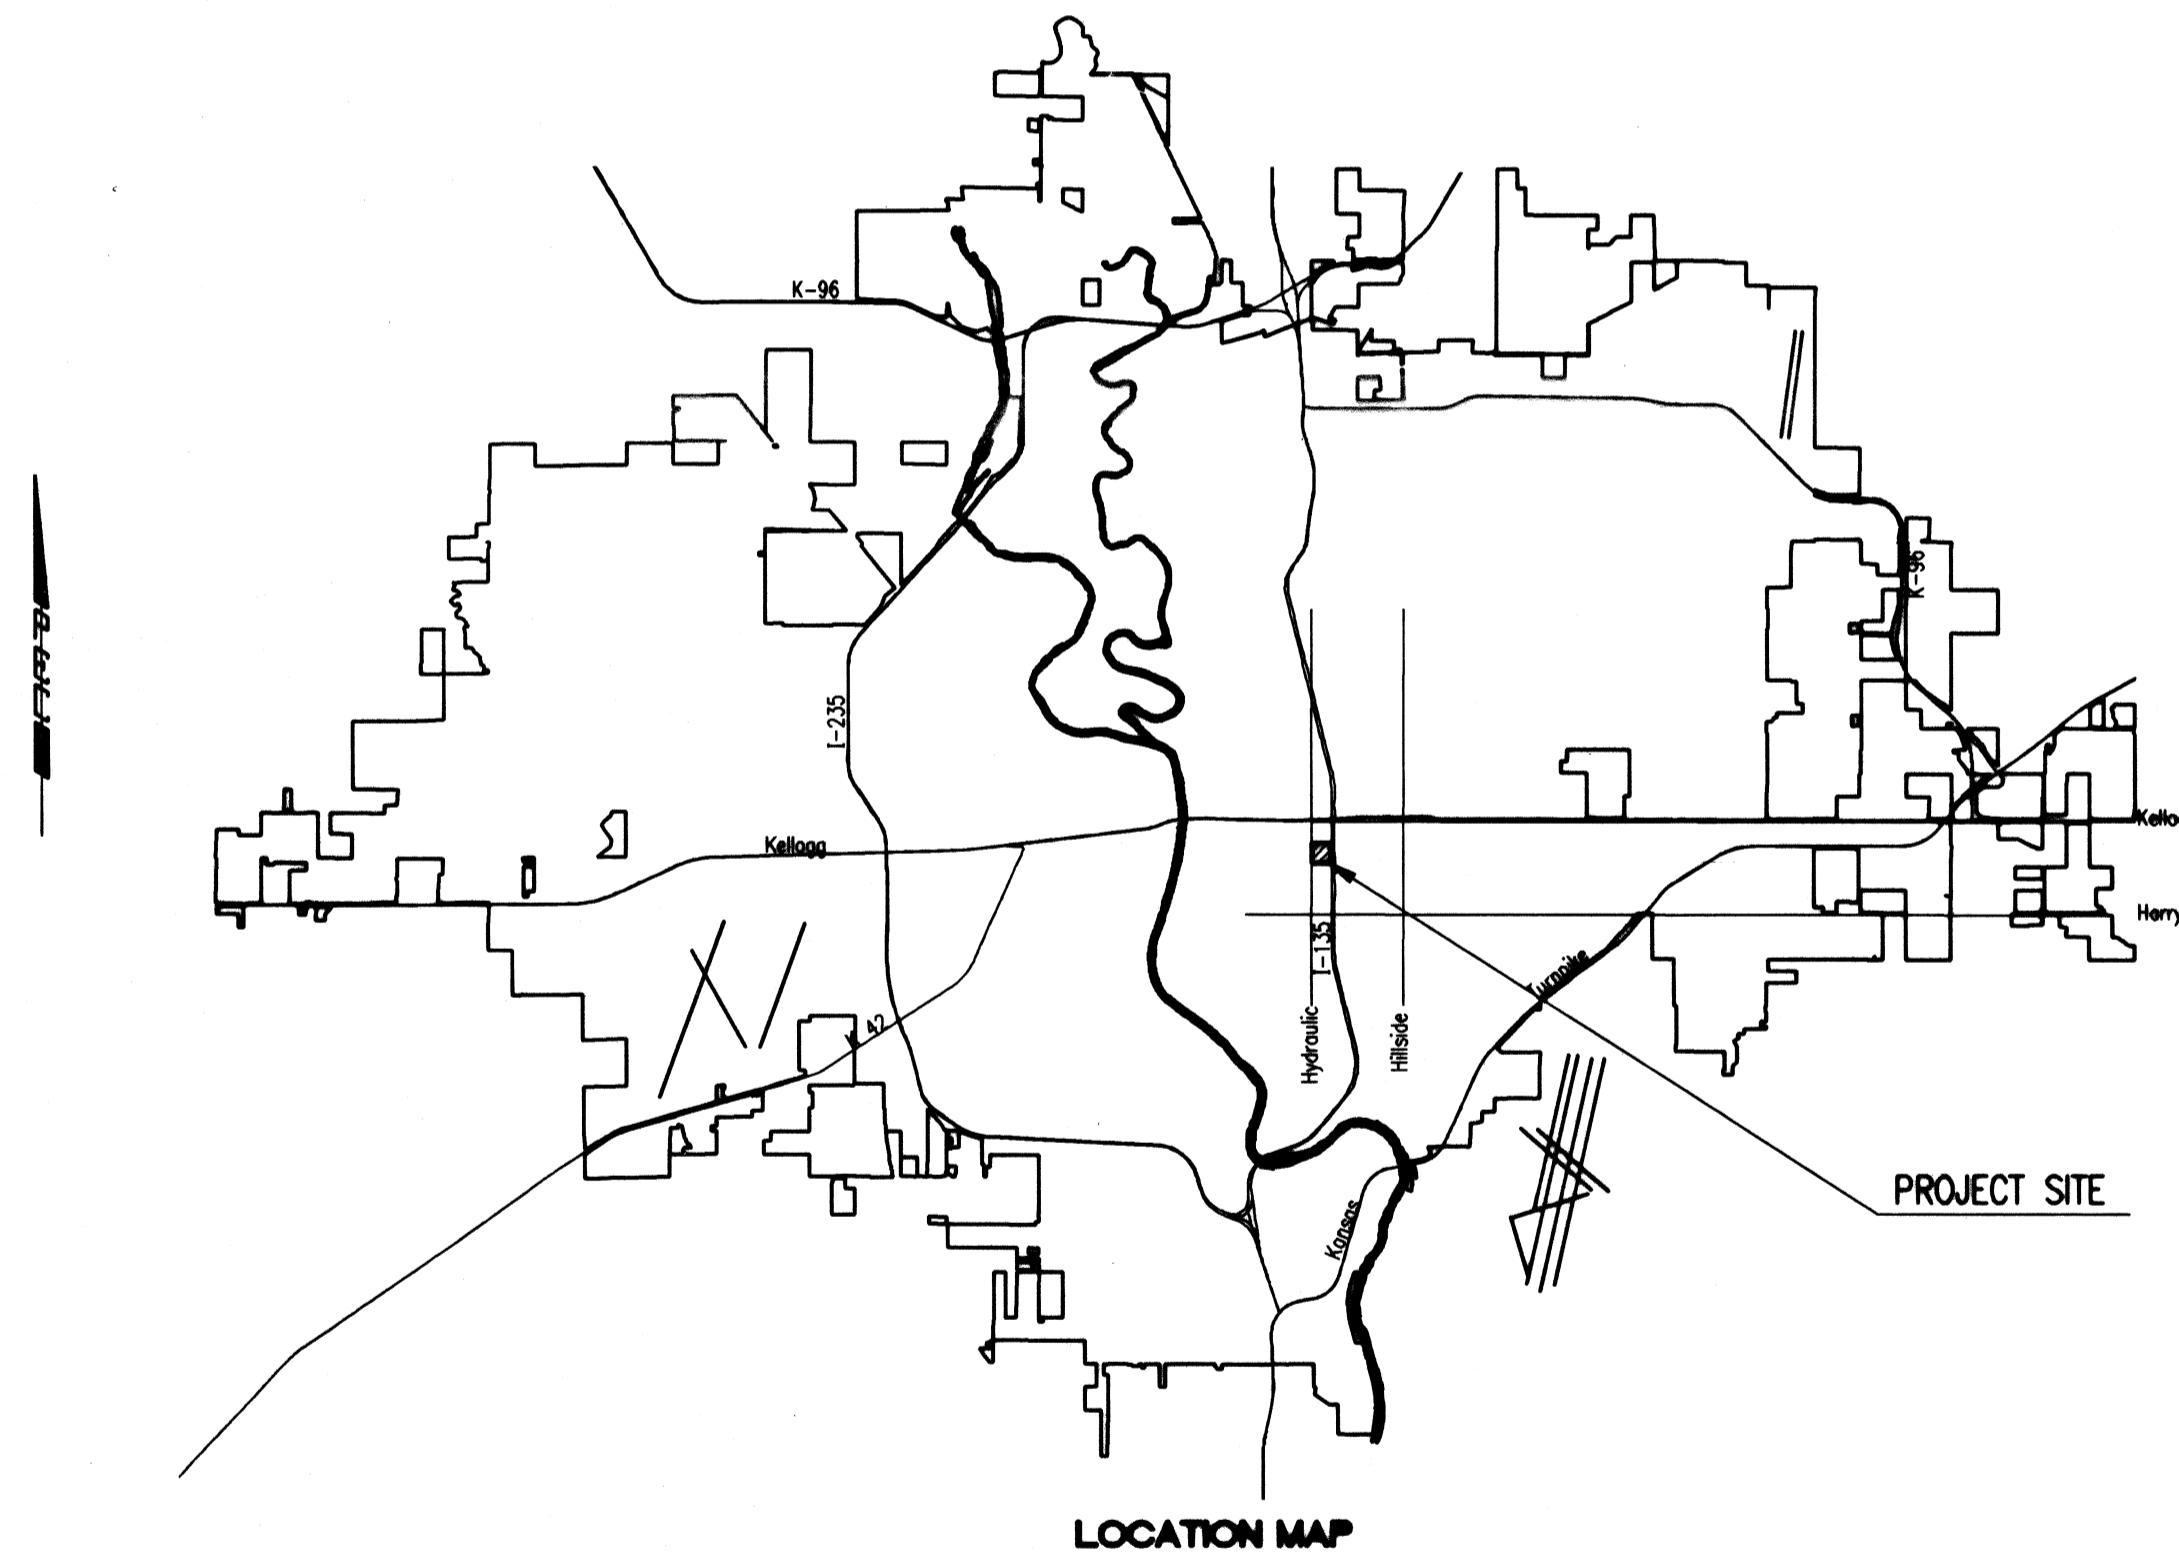

As Built Plans:

CONTRACTOR: McCollough Exc.
 INSPECTOR: Larry Gann, K E Miller Engineering
 .PDF by: NWS, 10-17-07

APPROVED AS NOTED
 BY CITY ENGINEER OF WICHITA,
 BY WICHITA WATER & SEWER DEPARTMENT,
 & BY WICHITA FIRE DEPARTMENT

Water Mains (Public Works) *[Signature]* 2/6/06
 Water Mains (Water and Sewer Dept.) *[Signature]* 2/6/06
 Fire Prot. Line *[Signature]* 2-8-06

NOTE TO CONTRACTORS

PUBLIC PROPERTY:
 Inspection and testing for the waterline is to be provided by a Licensed Consulting Engineering Firm under contract with the Owner/Developer. Said inspection to be in accordance with the City of Wichita standard construction engineering practices and certified by a Licensed Professional Engineer licensed in the State of Kansas. No work shall be performed in dedicated easements or public right-of-way by the Contractor without such inspection nor shall any work be commenced without written authorization by the City Engineer. All Construction and Materials shall comply with the City of Wichita Specifications and Standards (on file and available in the City Engineer's Office).

PRIMATE PROPERTY:
 Installation and testing for the fire protection line is to be performed by a City of Wichita licensed fire protection contractor in accordance with the fire codes as adopted by the City of Wichita. All materials and construction practices for the fire protection line shall comply with the fire codes as adopted by the City of Wichita (available from the City of Wichita Fire Department). The Contractor shall not commence work without notification and approval of the Wichita Fire Department.
 Inspection of the fire protection line is to be provided by the City of Wichita Fire Department and by a licensed Consulting Engineering Firm under contract with the Owner/Developer.
 The contractor shall not start work until the project inspector is assigned to the project and present on the site. Any work done without inspection will be required to be uncovered for inspection.

FEBRUARY 2006

PLANS PREPARED BY
PROFESSIONAL ENGINEERING CONSULTANTS, P.A.
 ENGINEERS
 WICHITA, KANSAS

