
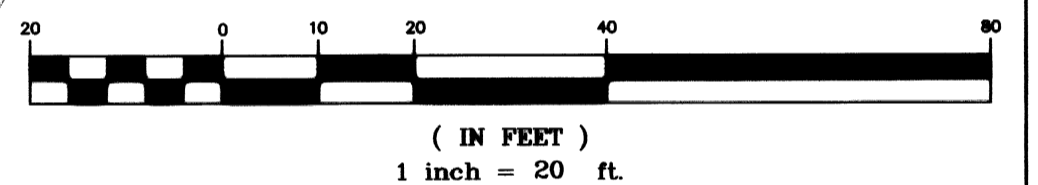



Baseline
West R/W Line of Ohio SW Corner of Lot 1, Block 1, Groendyke Addition being Sta. 10+00.

Benchmark:
Rail Road Spike in Hubguard SW Corner of RCBC under Ohio St. 75' N. of 29th St. N. Elev. = 1317.01

On Site BM: "□" on Top of Curb at S. End of Catch Basin E. Side of Ohio at S. Curb Return. Elev. = 1316.75

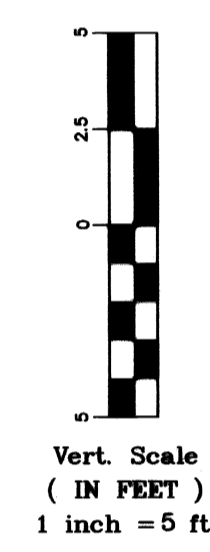

PAGE REMOVED
SEE SHEET 2 REVISED

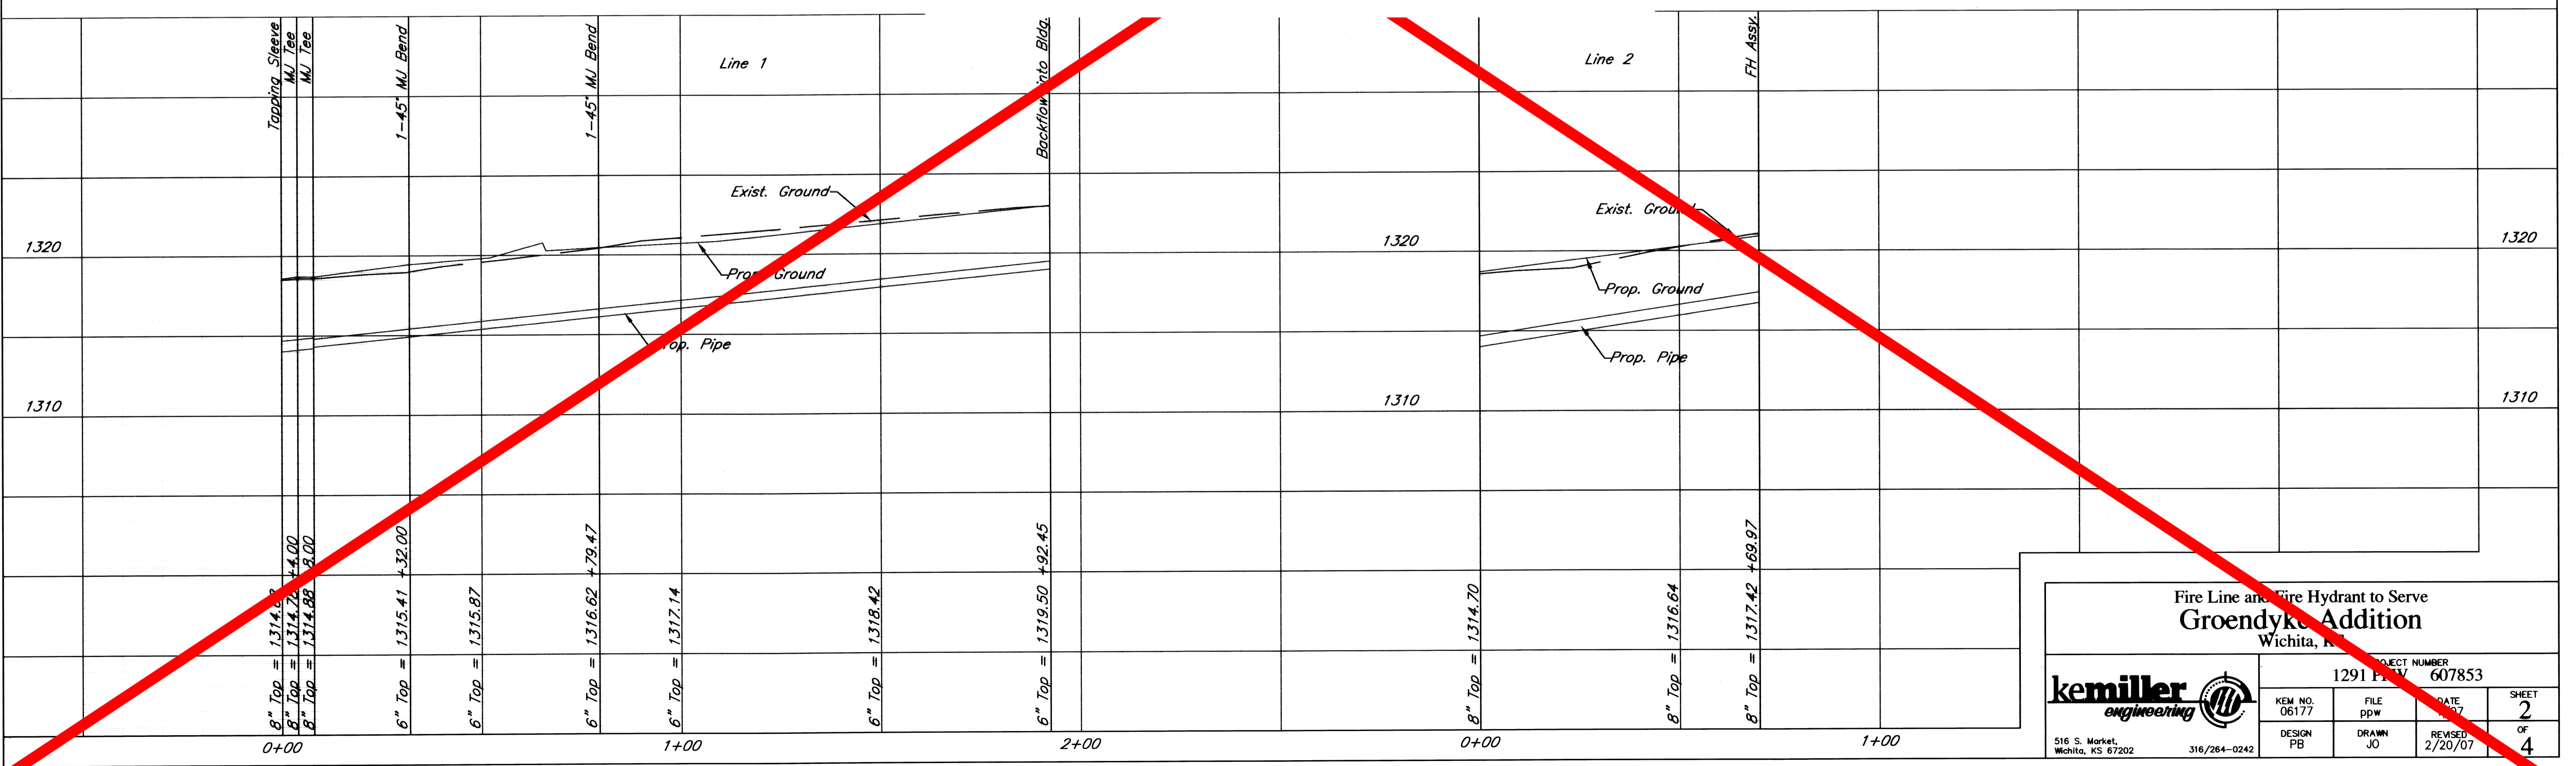

Fire Line and Fire Hydrant to Serve Groendyke Addition
Wichita, KS

kemiller engineering

PROJECT NUMBER: 1291 P.W. 607853

KEM NO. 06177	FILE DPW	DATE 1/07	SHEET 2 OF 4
DESIGN PB	DRAWN JO	REVISED 2/20/07	

516 S. Market, Wichita, KS 67202 316/264-0242