

Golf Course

CRESTWAY

10TH ST. NORTH

1-1

MH # 5748-309
1043 N. Terrace
Replace Manhole Frame & Cover
(removal of dead tree stump around manhole
frame shall be incidental to the Site)
Approx MH depth = 15.2 ft

Replace Service Connection:
Located 33 lf north of MH 5748-308,
service for 1023 N. Terrace. Approx
pipe depth is 18.0 ft.

MH # 5748-308
1017 N. Terrace
Replace Manhole Frame & Cover
Approx MH depth = 18.5 ft

TERRACE

1043

204'



221'

1017

209'

9TH ST. NORTH

SITE 1

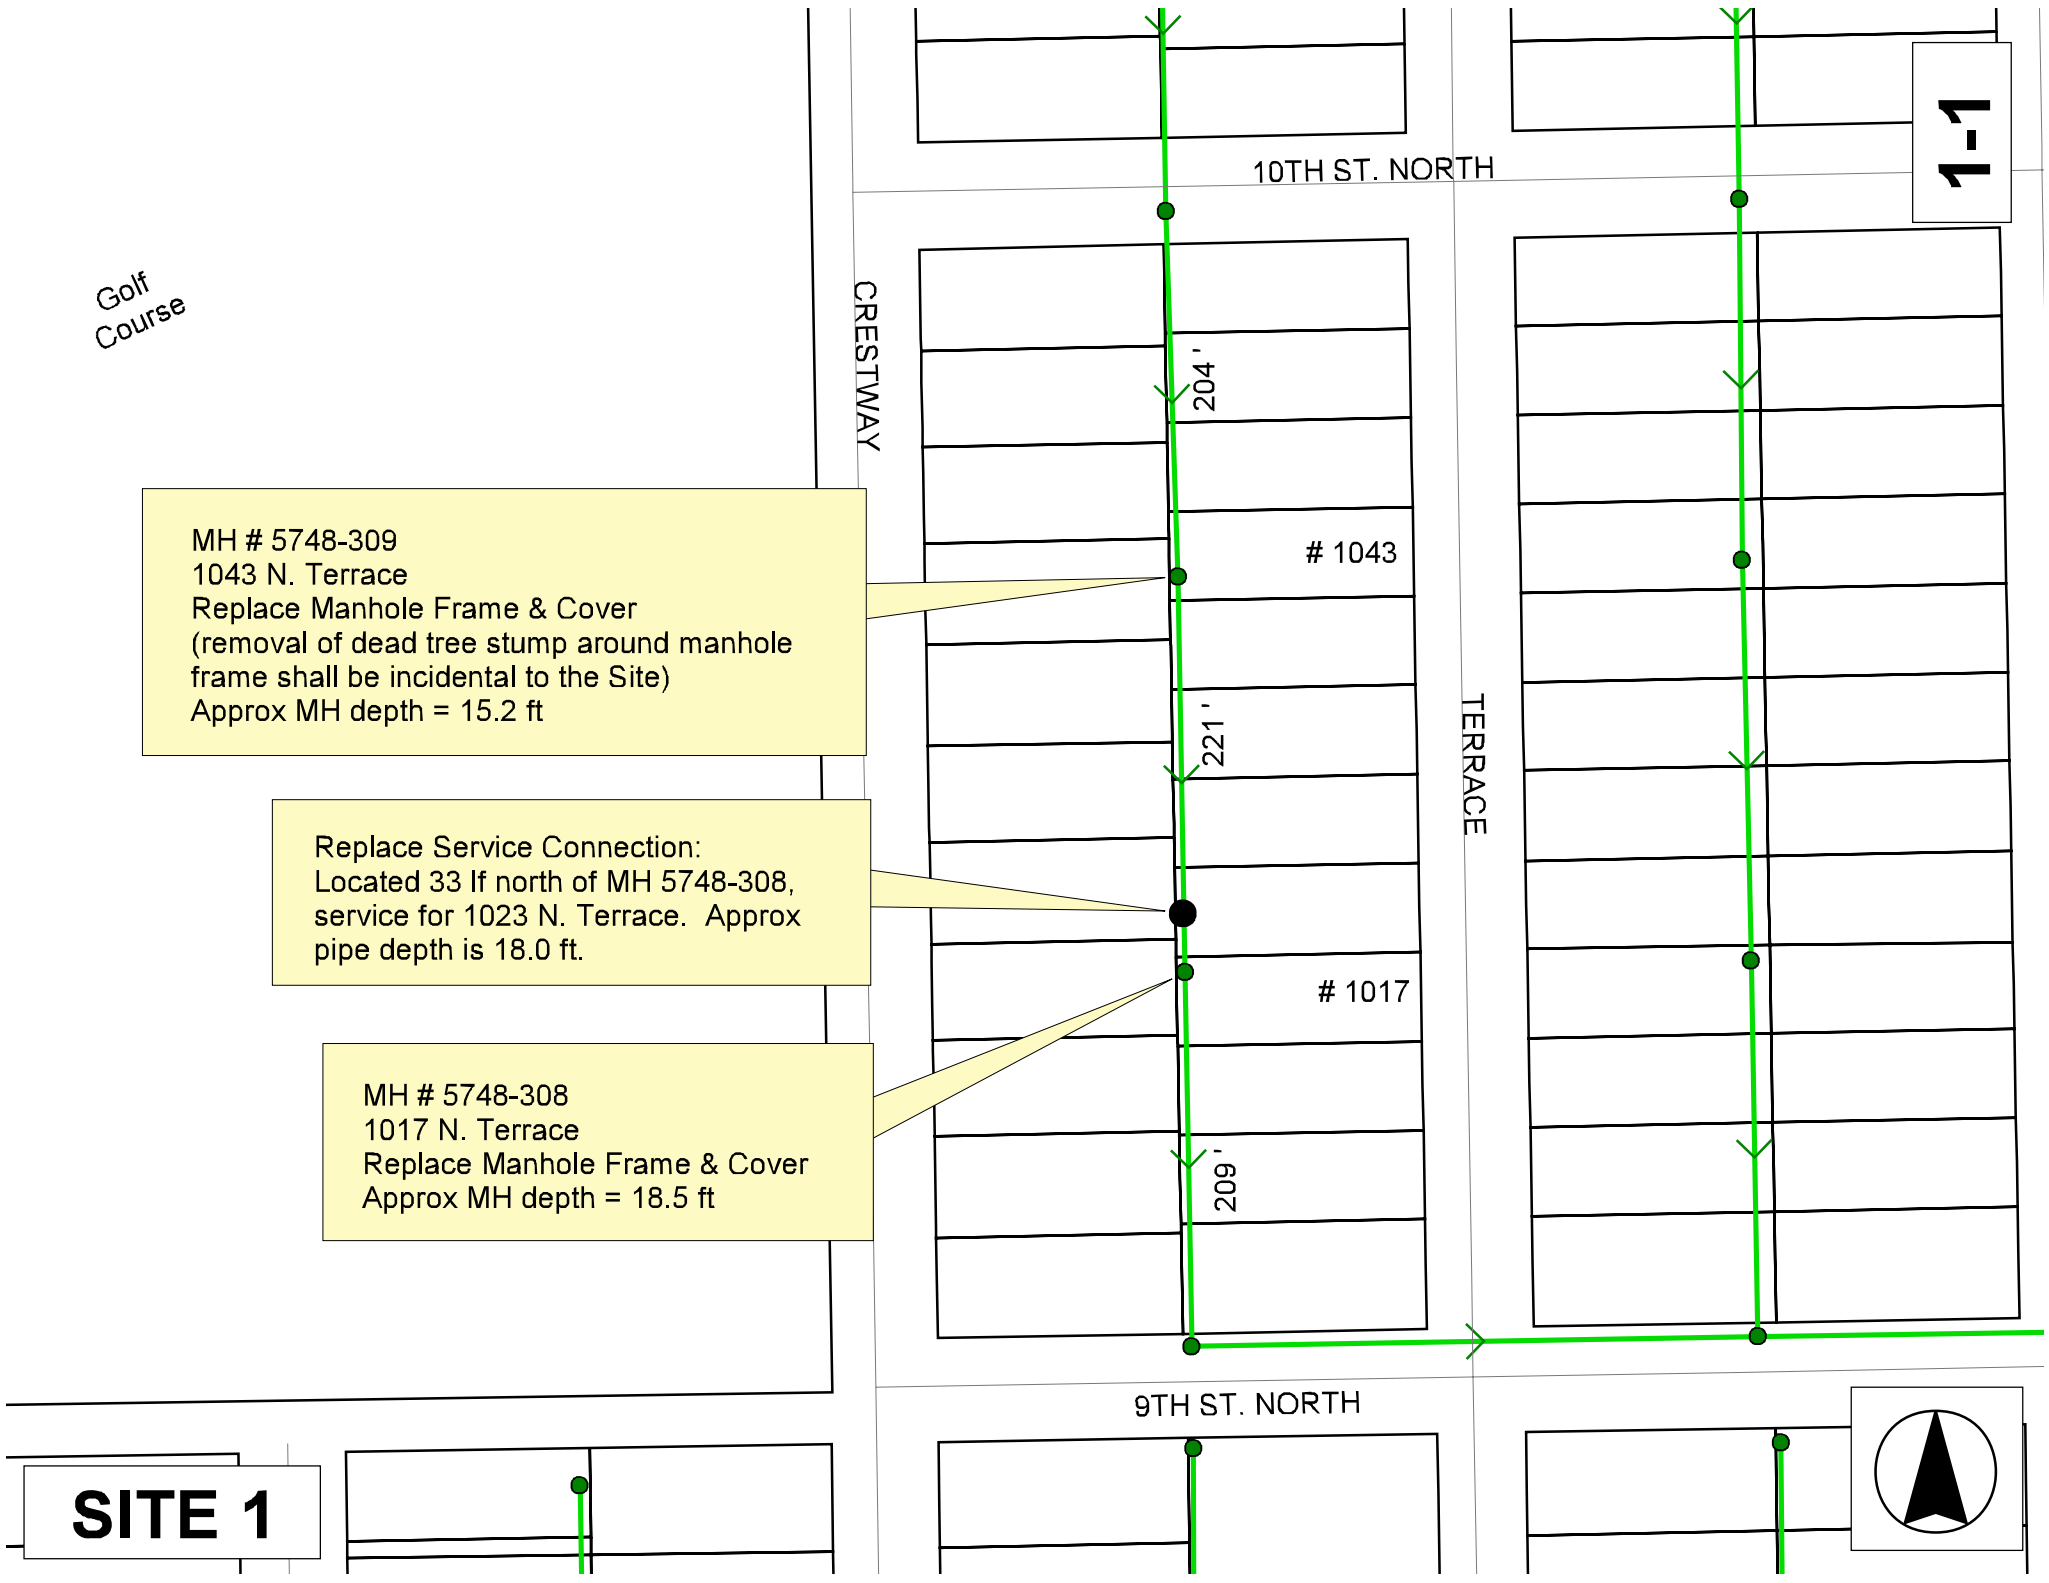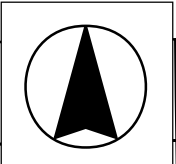

LOCATION

1023

5748-308

1017

CRESTWAY

TERRACE

9TH

Aerial View



Television Inspection Master Report

9/10/2007
2:37:46PM

US Manhole: 5748-309 1043 N TERRACE ST Date Insp: 1/3/2007 Basin: E041
 DS Manhole: 5748-308 1017 N TERRACE ST Dir Televised: Upstream To Downstream

Pipe Information

Shape: Round Length Status: Project No.: E-072
 Dia/Ht Width: 8 0 Material: VCP Index:
 Length: 222.3 Slope: 0.099 Surface: Rear Easement

Inspection Information

Crew: 690 Percent Full: Tape ID: DVD #0229
 Weather: Sunny Purpose: TV Existing Line Counter Start:
 Surface Cond: Trees, Fences, Buildings Flow: Normal Flow Counter Stop:

Obs. #	VTR Counter	Distance	Location	Description	Obs Rating	Obsrvd (gpm)	Est. (gpm)	Ratings Struct	Clean	Remain (gpm)
	Svc. Address		Connection type:							
1	0.0		US Manhole	5748-309	1		0.000	0	0	0.000
2	12.7		West	Wye Service	2		0.000	0	0	0.000
	1040 NORTH CREST WAY			4" Clay Wye Connection						
3	21.2		Joint	Roots	3		0.008	5	8	0.008
4	21.7		East	Break-In Conn	2		0.002	0	0	0.002
	1039 NORTH TERRACE			4" Break In Connection						
5	36.7		West	Wye Service / Sealed	1		0.000	0	0	0.000
6	42.1		Joint	Roots	2		0.004	2	4	0.004
7	60.4		West	Wye Service / Sealed	1		0.000	0	0	0.000
8	71.8		Joint	Roots	3		0.008	5	8	0.008
9	83.9		Joint	Roots	2		0.004	2	4	0.004
10	84.4		West	Wye Service	1		0.000	0	0	0.000
	1036 NORTH CREST WAY			4" Clay Wye Connection						
11	96.2		East	Wye Service	2		0.000	0	0	0.000
	1033 NORTH TERRACE			4" Clay Wye Connection						
12	111.3		West	Wye Service / Sealed	1		0.000	0	0	0.000
13	129.0		East	Wye Service	1		0.000	0	0	0.000
	1029 NORTH TERRACE			4" Clay Wye Connection						
14	135.1		West	Wye Service	1		0.000	0	0	0.000
	1030 NORTH CREST WAY			4" Clay Wye Connection						
15	156.1		West	Wye Service	2		0.000	0	0	0.000
				4" Clay Wye Connection						
16	159.1		East	Wye Service / Sealed	1		0.000	0	0	0.000
17	183.1		West	Wye Service	1		0.000	0	0	0.000
	1024 NORTH CREST WAY			4" Clay Wye Connection						
18	185.8 East			Wye Service	4		0.000	60	0	0.000
	1023 NORTH TERRACE			4" Clay Wye Connection						
19	204.2		West	Wye Service	1		0.000	0	0	0.000
				4" Clay Wye Connection						
20	207.1		East	Wye Service	1		0.000	0	0	0.000
				4" Clay Wye Connection						
21	209.5		Joint	Roots	2		0.004	2	4	0.004
22	212.4		Joint	Roots	2		0.004	2	4	0.004
23	215.6		Joint	Roots	3		0.008	5	8	0.008
24	219.6		DS Manhole	5748-308	1		0.000	0	0	0.000