


STORM WATER SEWER NO. 99

CITY OF WICHITA, KANSAS

R. W. LINN, CITY ENGINEER

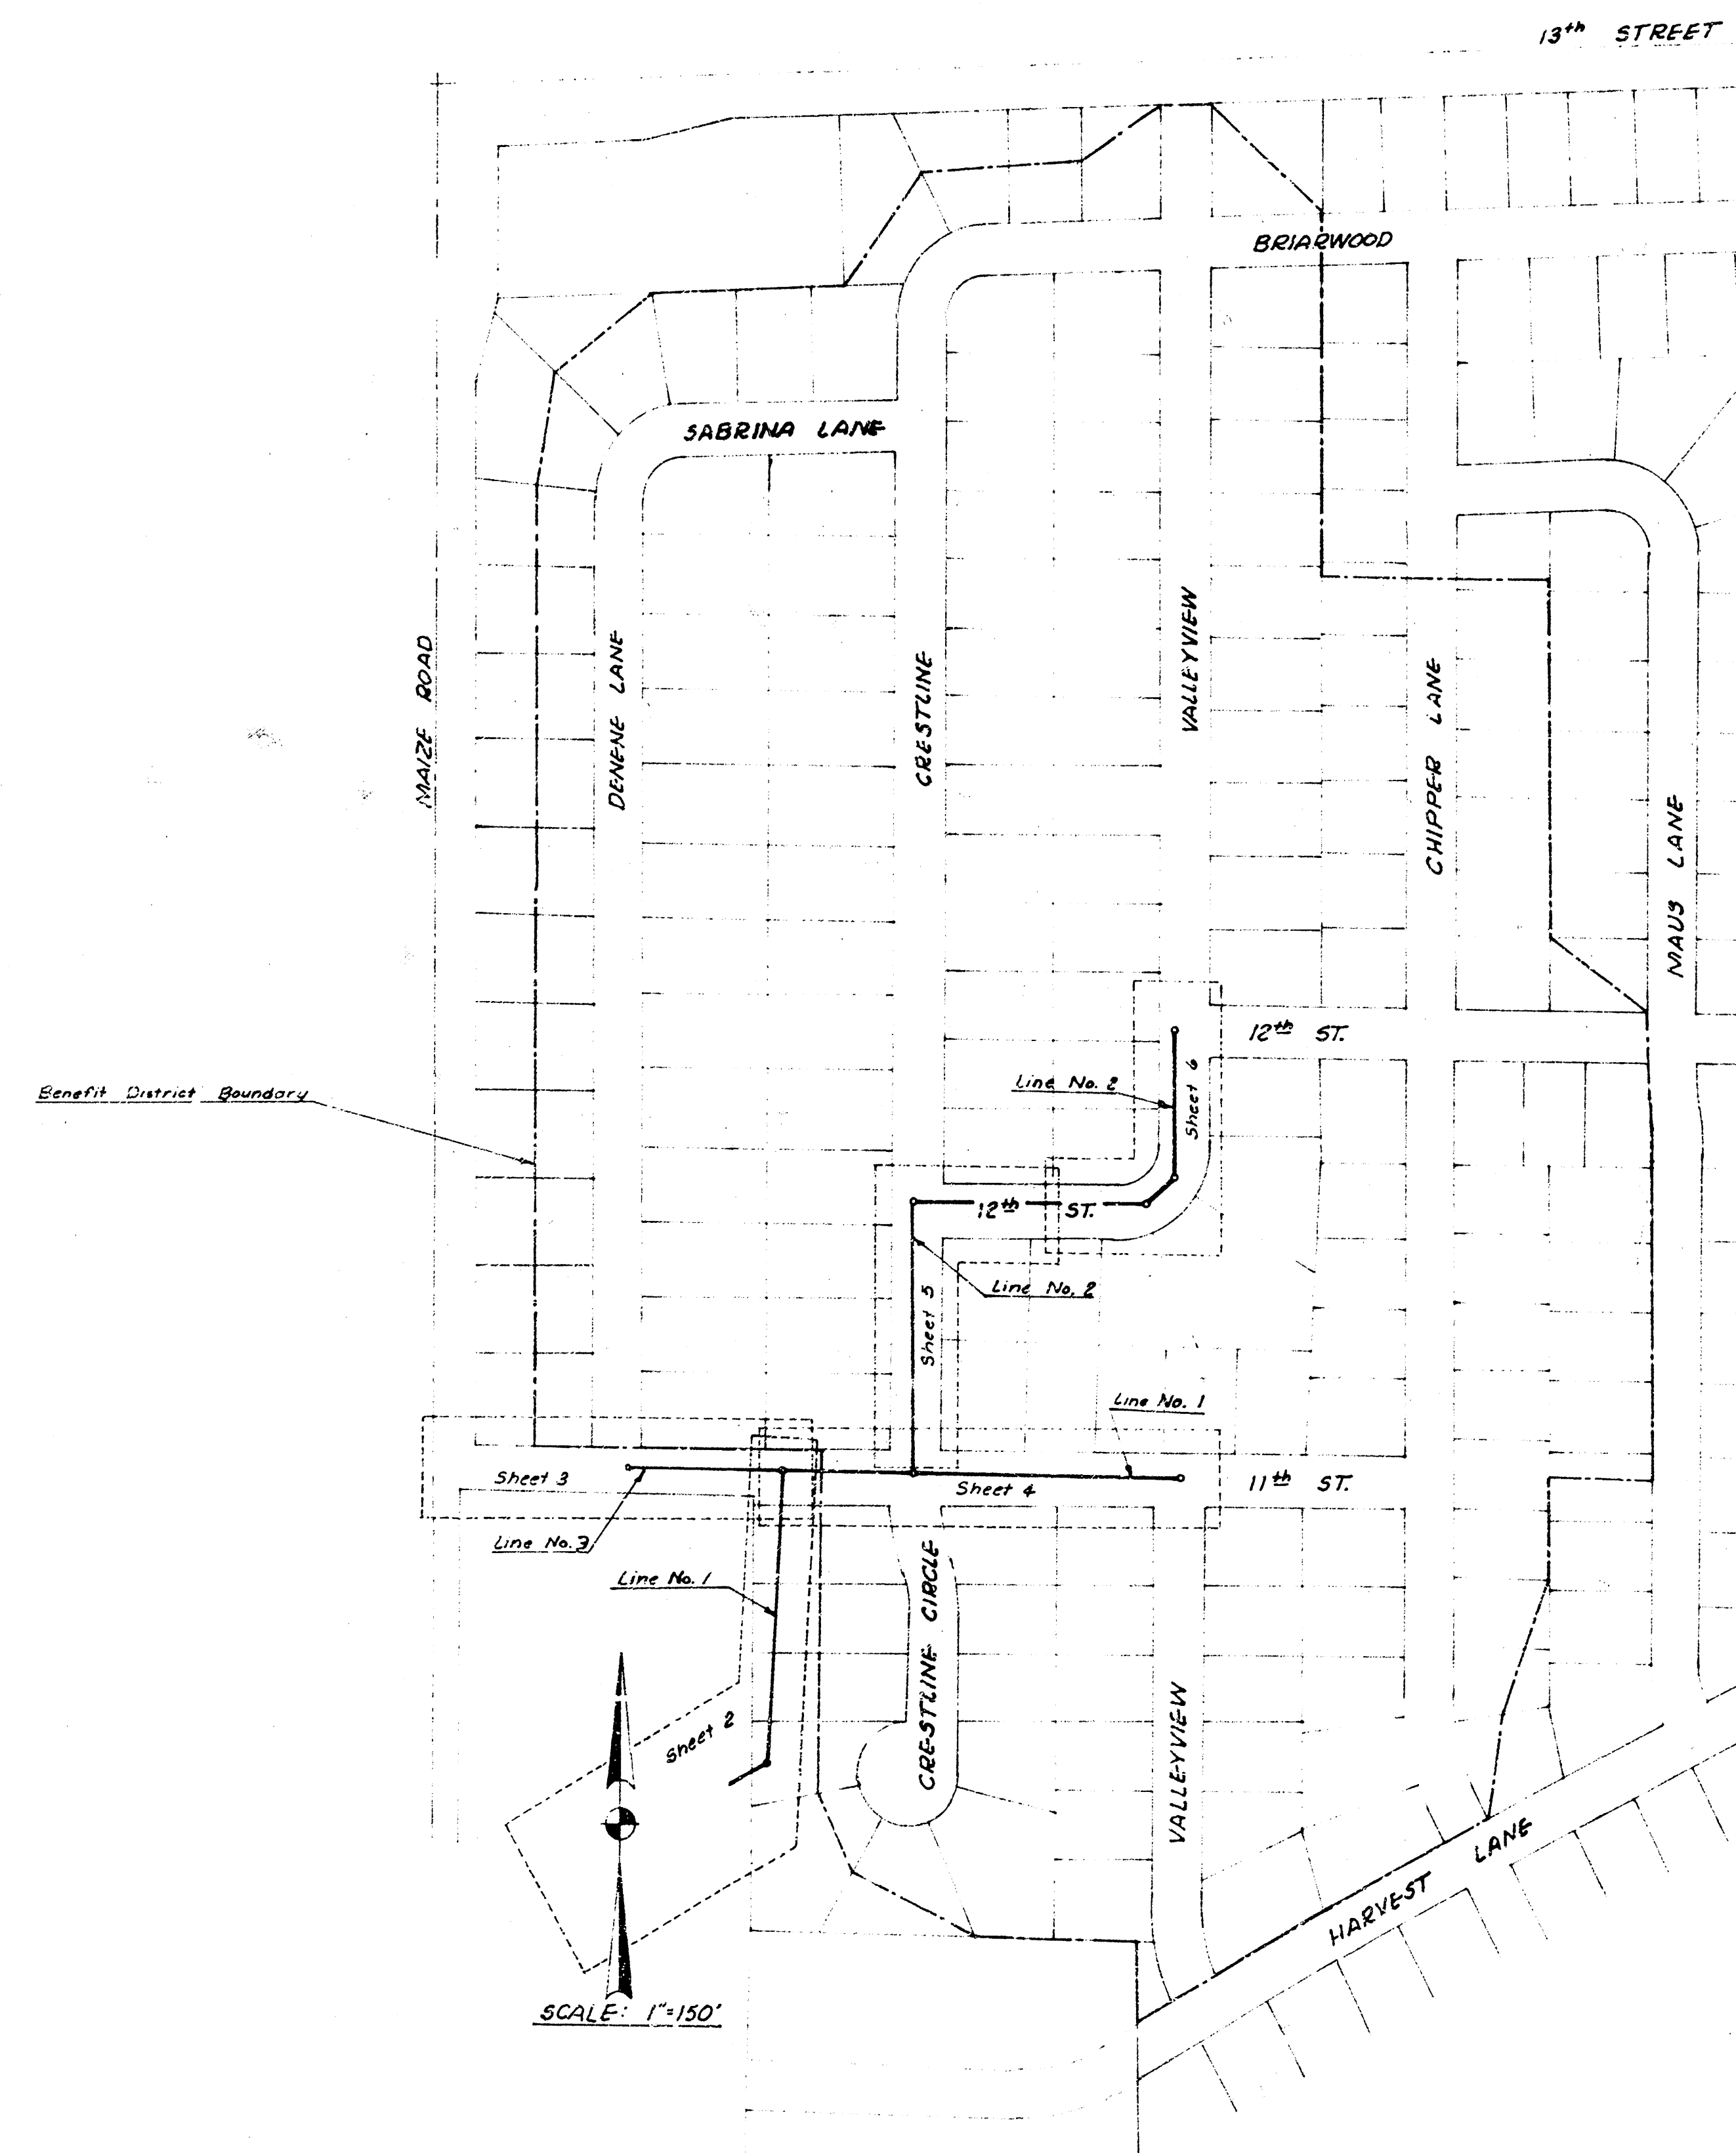

PROJECT NO. DBKA 572071

DATE: May 14, 1992

As Built, Final Mts
K-110

STORM WATER SEWER #99

Sheet 1 of 7

B.M. 152.283 City Sid on Maple Rd.
1/4 mile S. of 13th Street, 320' N.
of 38.0' E. of 1/4 Sec. Cor.


SEEDING: All disturbed areas south of west of Sta. 16+00 to be seeded in accordance with Kansas State Highway Dept. Standard Specifications using mixed native grass seed and prairie hay mulch. Seed shall be applied at 80 lbs. per acre and fertilizer at 500 lbs. per acre. Fertilizer shall contain 12% Nitrogen, 12% Phosphate and 12% Potassium. Cost for seeding, mulching and other appurtenant work to be paid for as per state bid for "Seeding".

Remove and replace fence in kind as required for construction. (3 strand barbed wire fence)


Iron Pin Sta. 10+89.71 (323' S. of N.E. Cor. of unplatted tract)

SCALE: 1"=20'
Hor. 1"=5'

Iron Pin @ NW Cor. Lot 1, Blk. B Westlink 10th Addn, (10' S. of NE Cor. of unplatted tract)

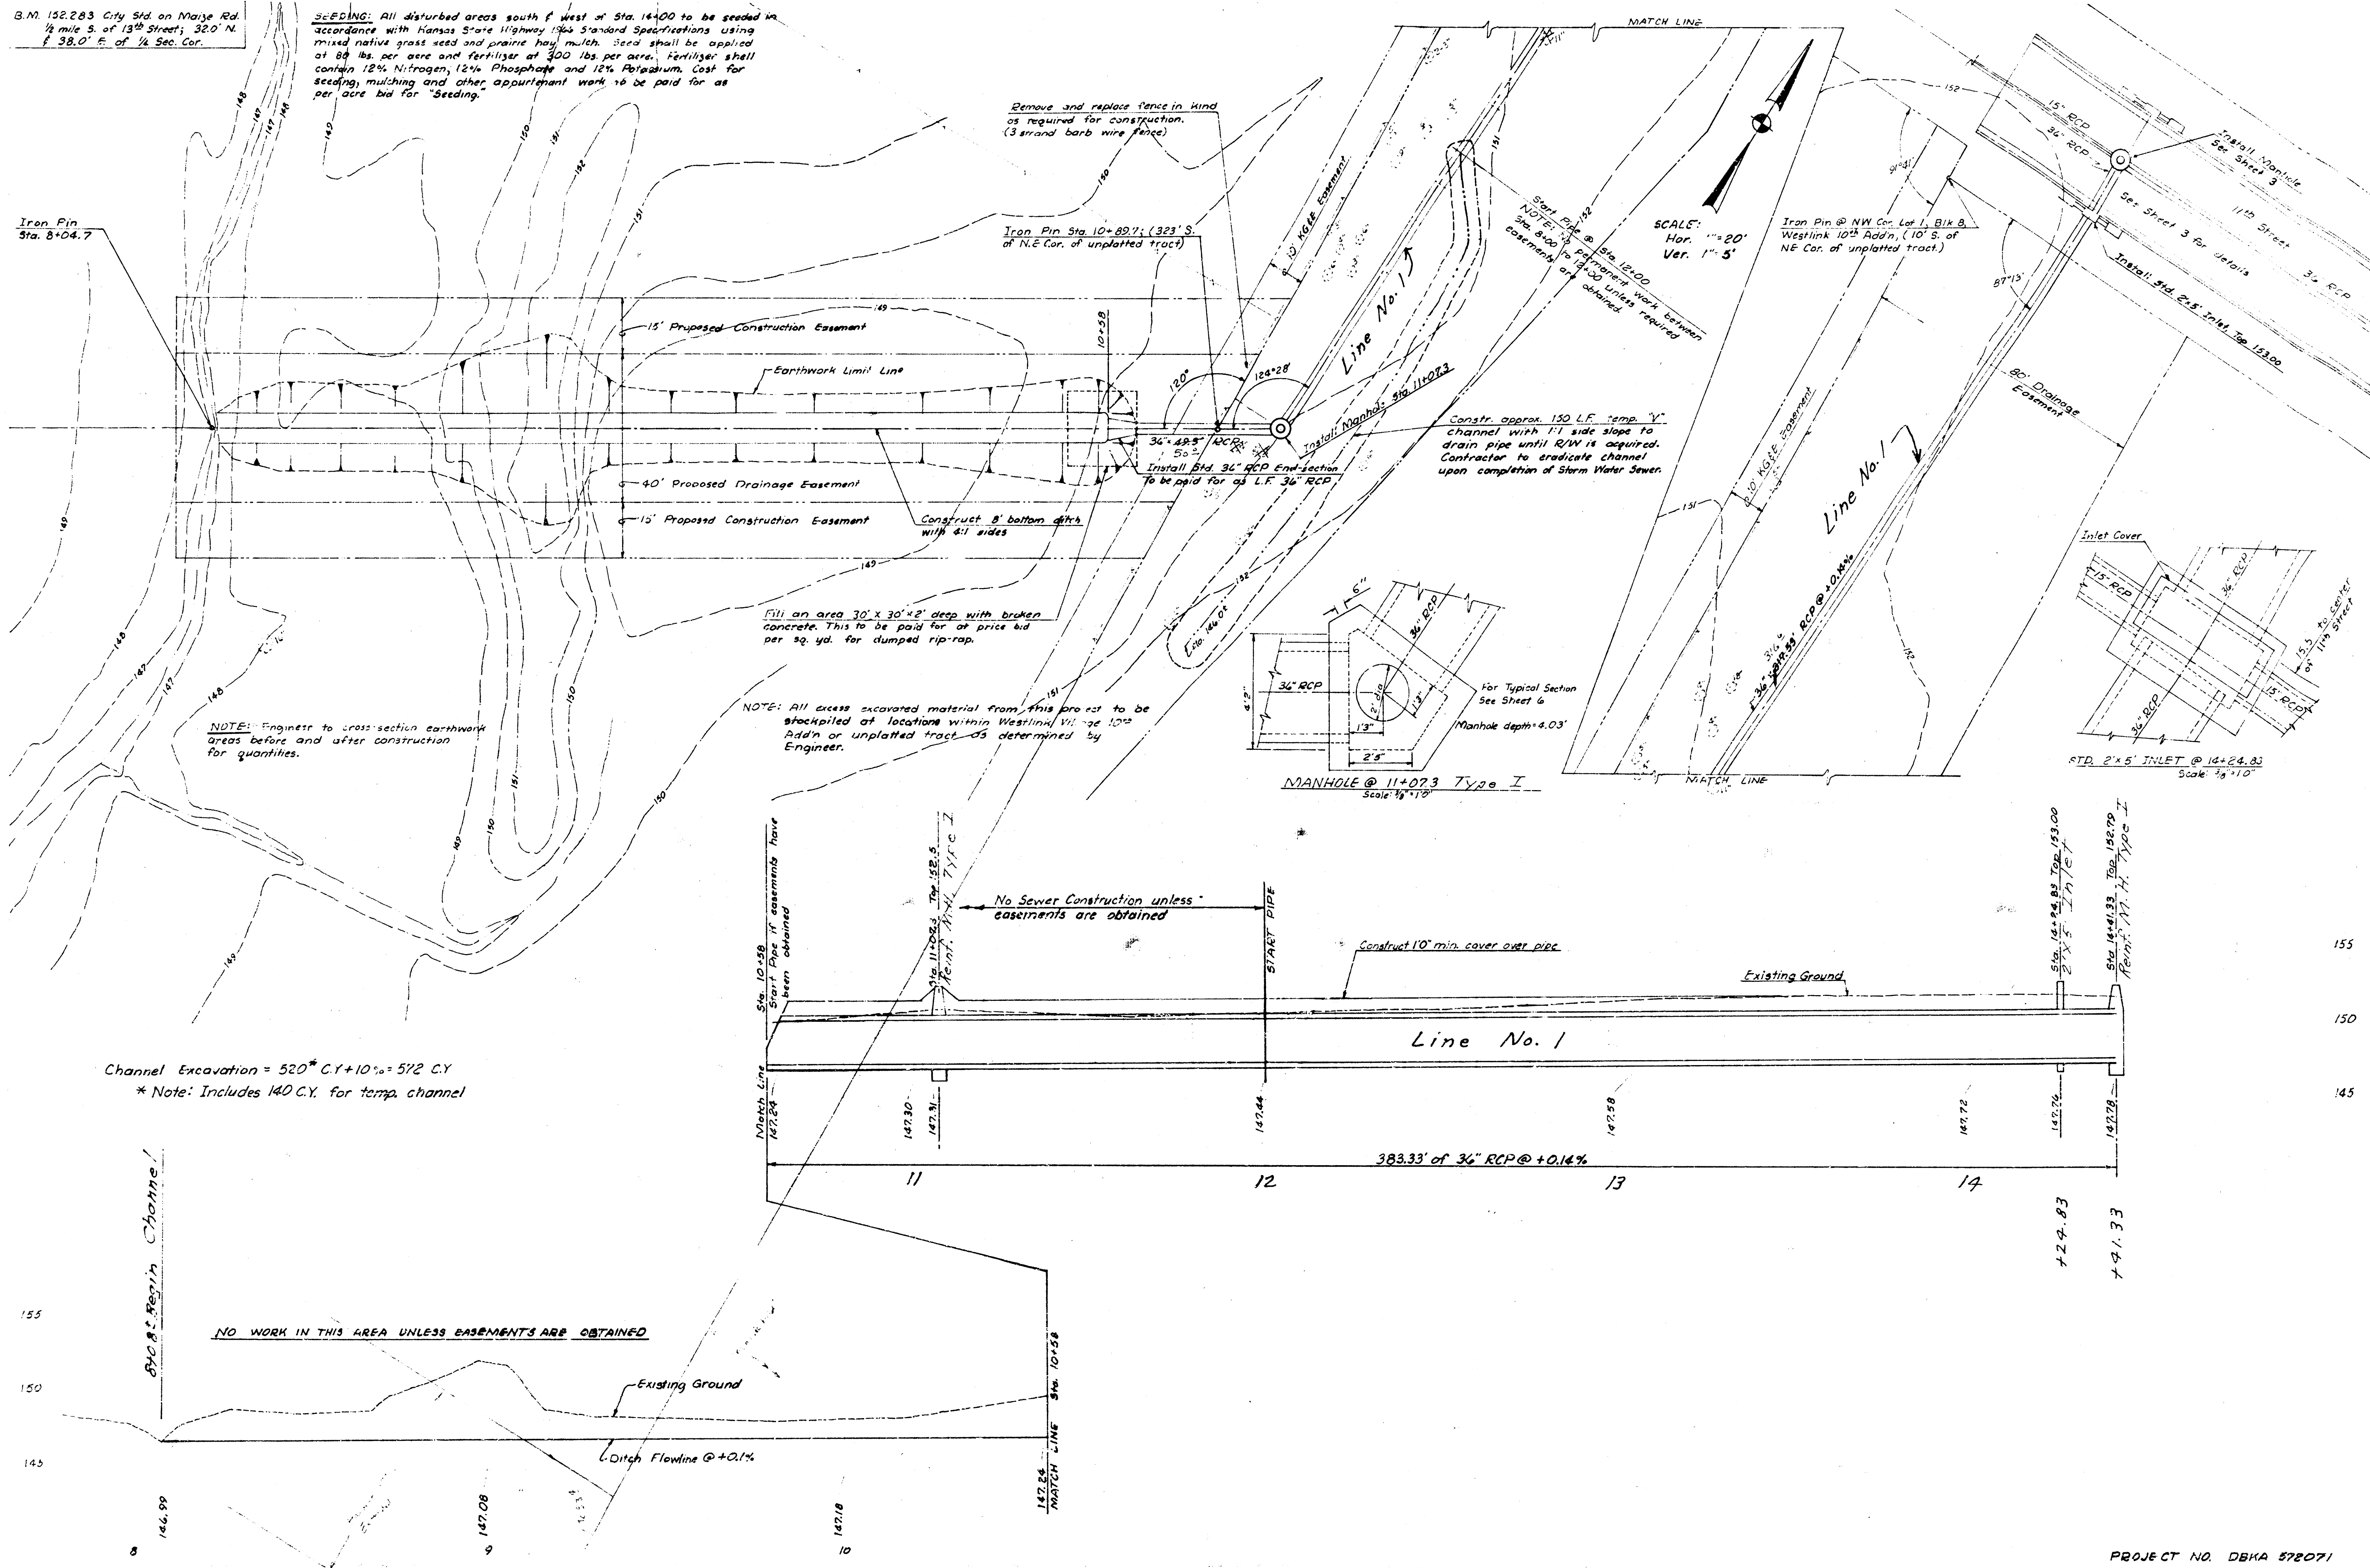

155
150
145
140
135
130

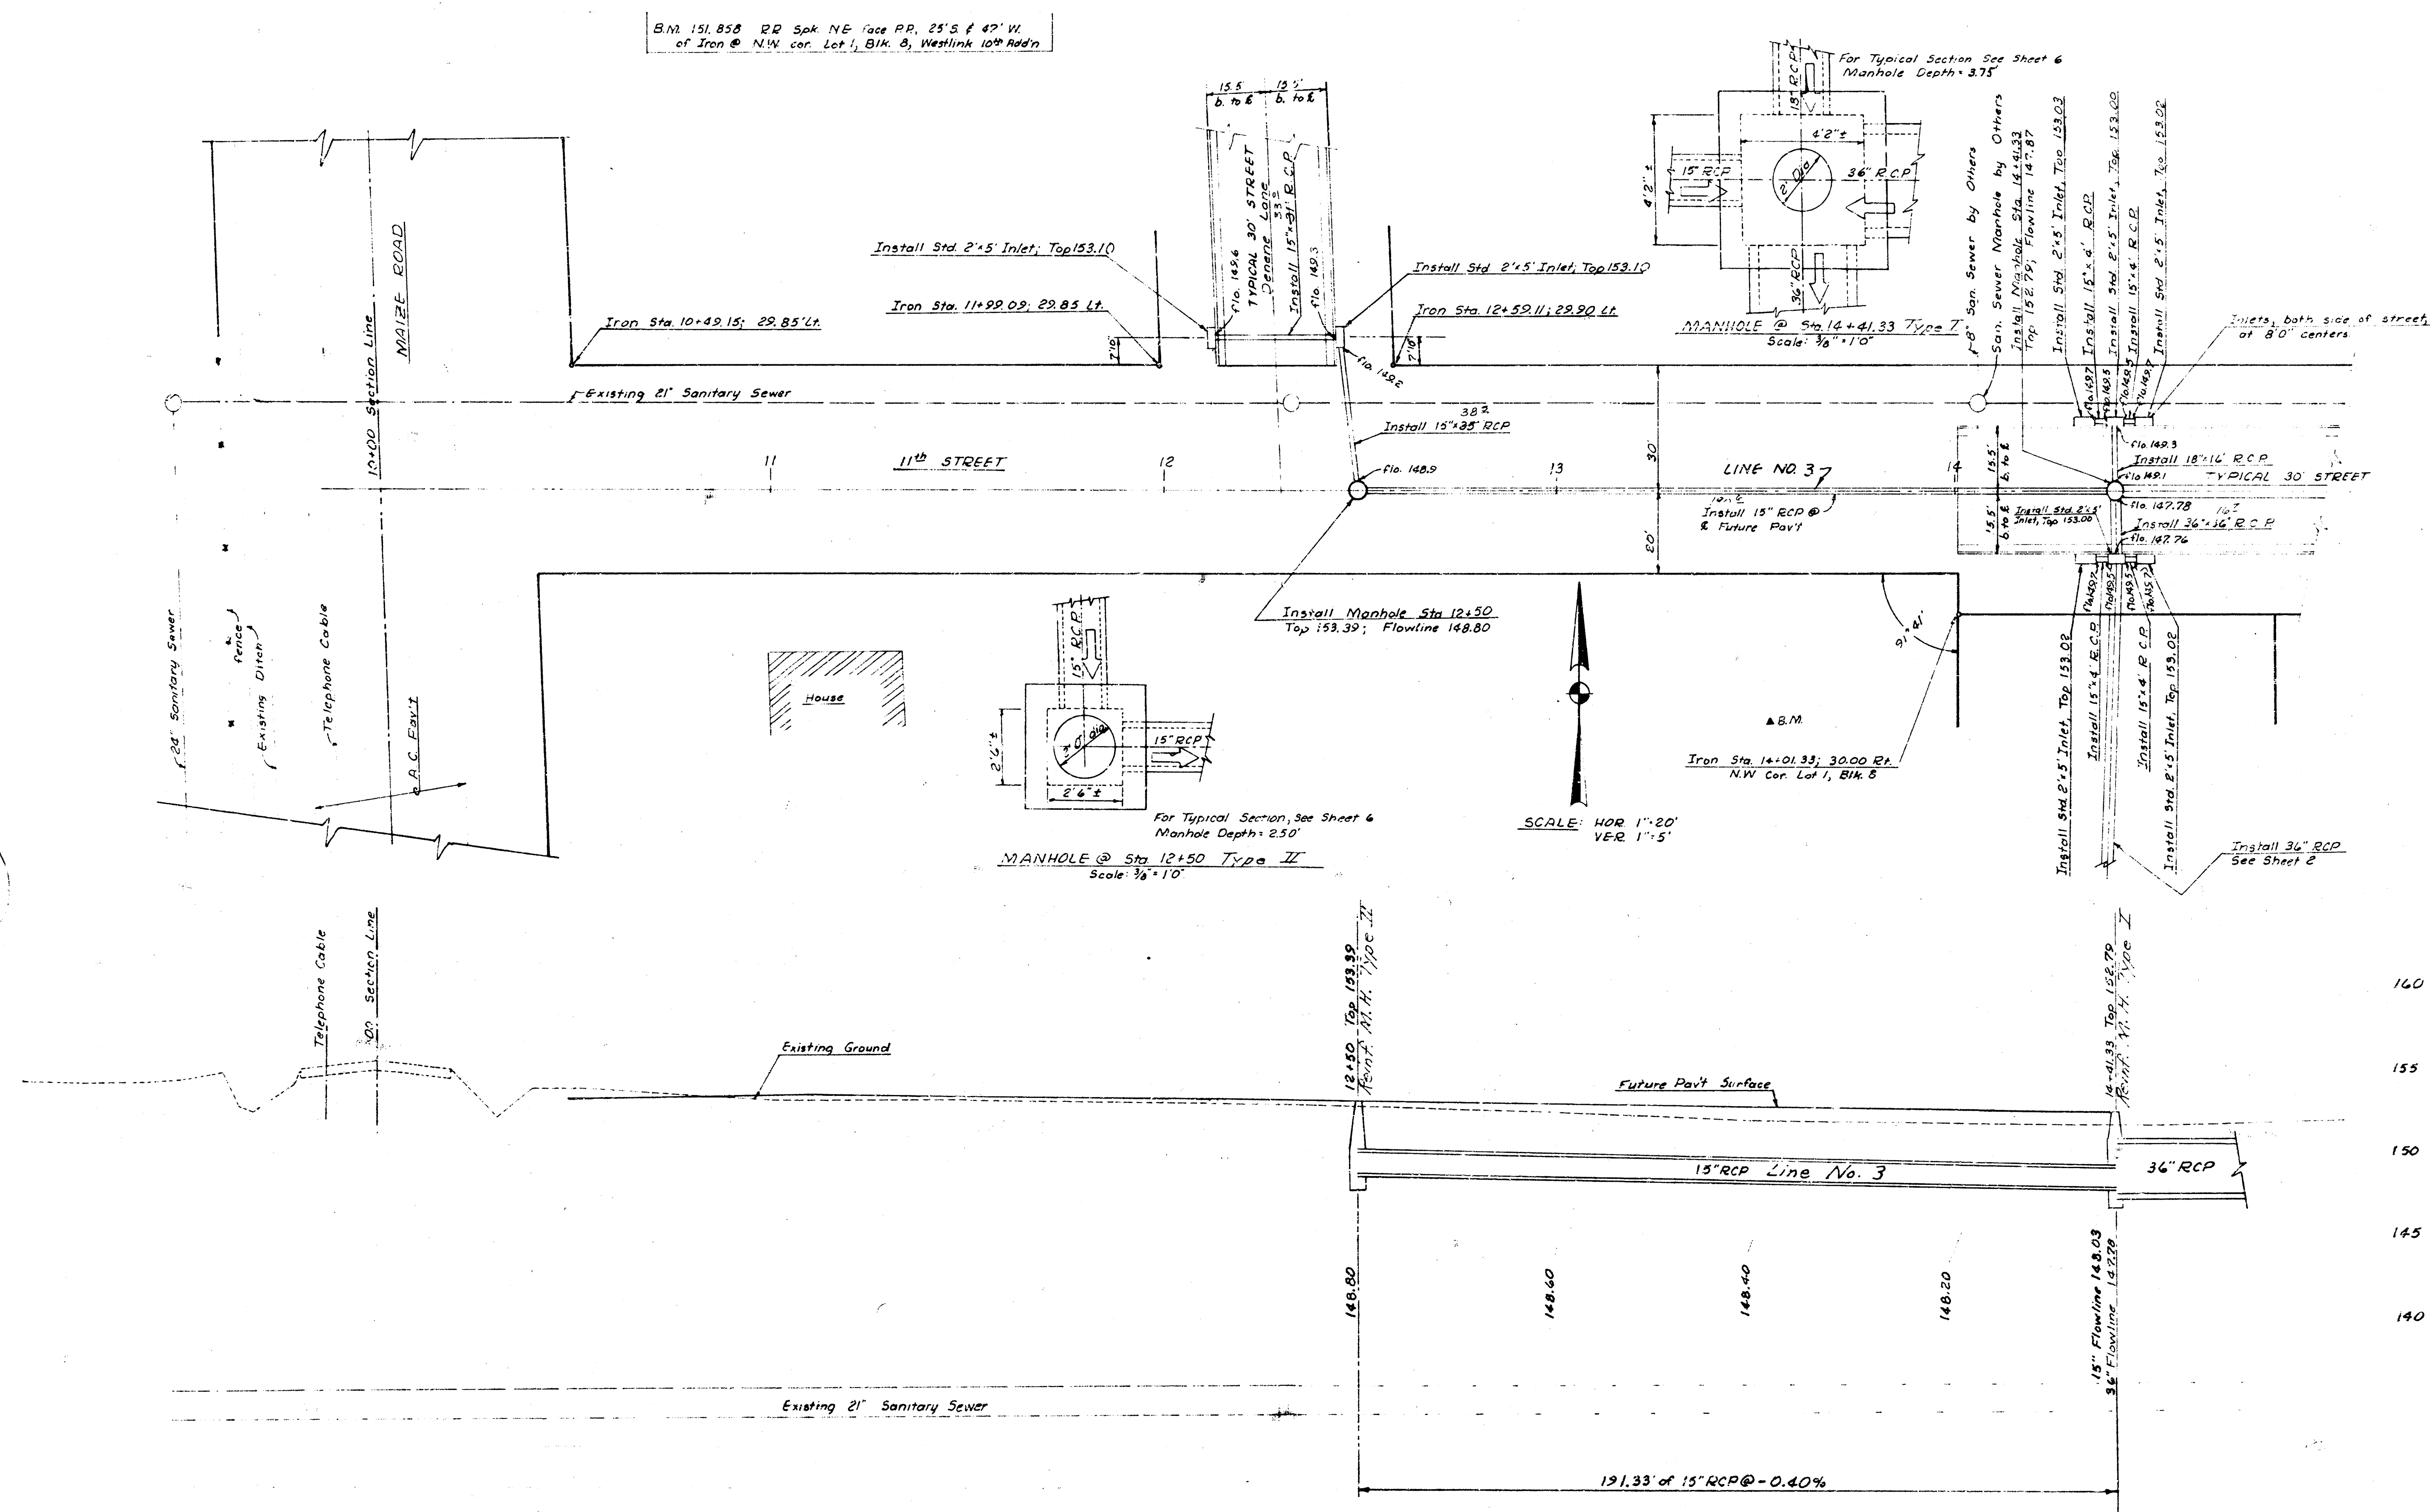

B.M. 151.258 RR Spike N.E. Face RR 25' S. & 7' W. of Iron @ N.W. Cor. Lot 1, B.M. 8, Westlink Village 10th Add'n.

