




CHERRY CREEK HILLS



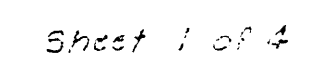

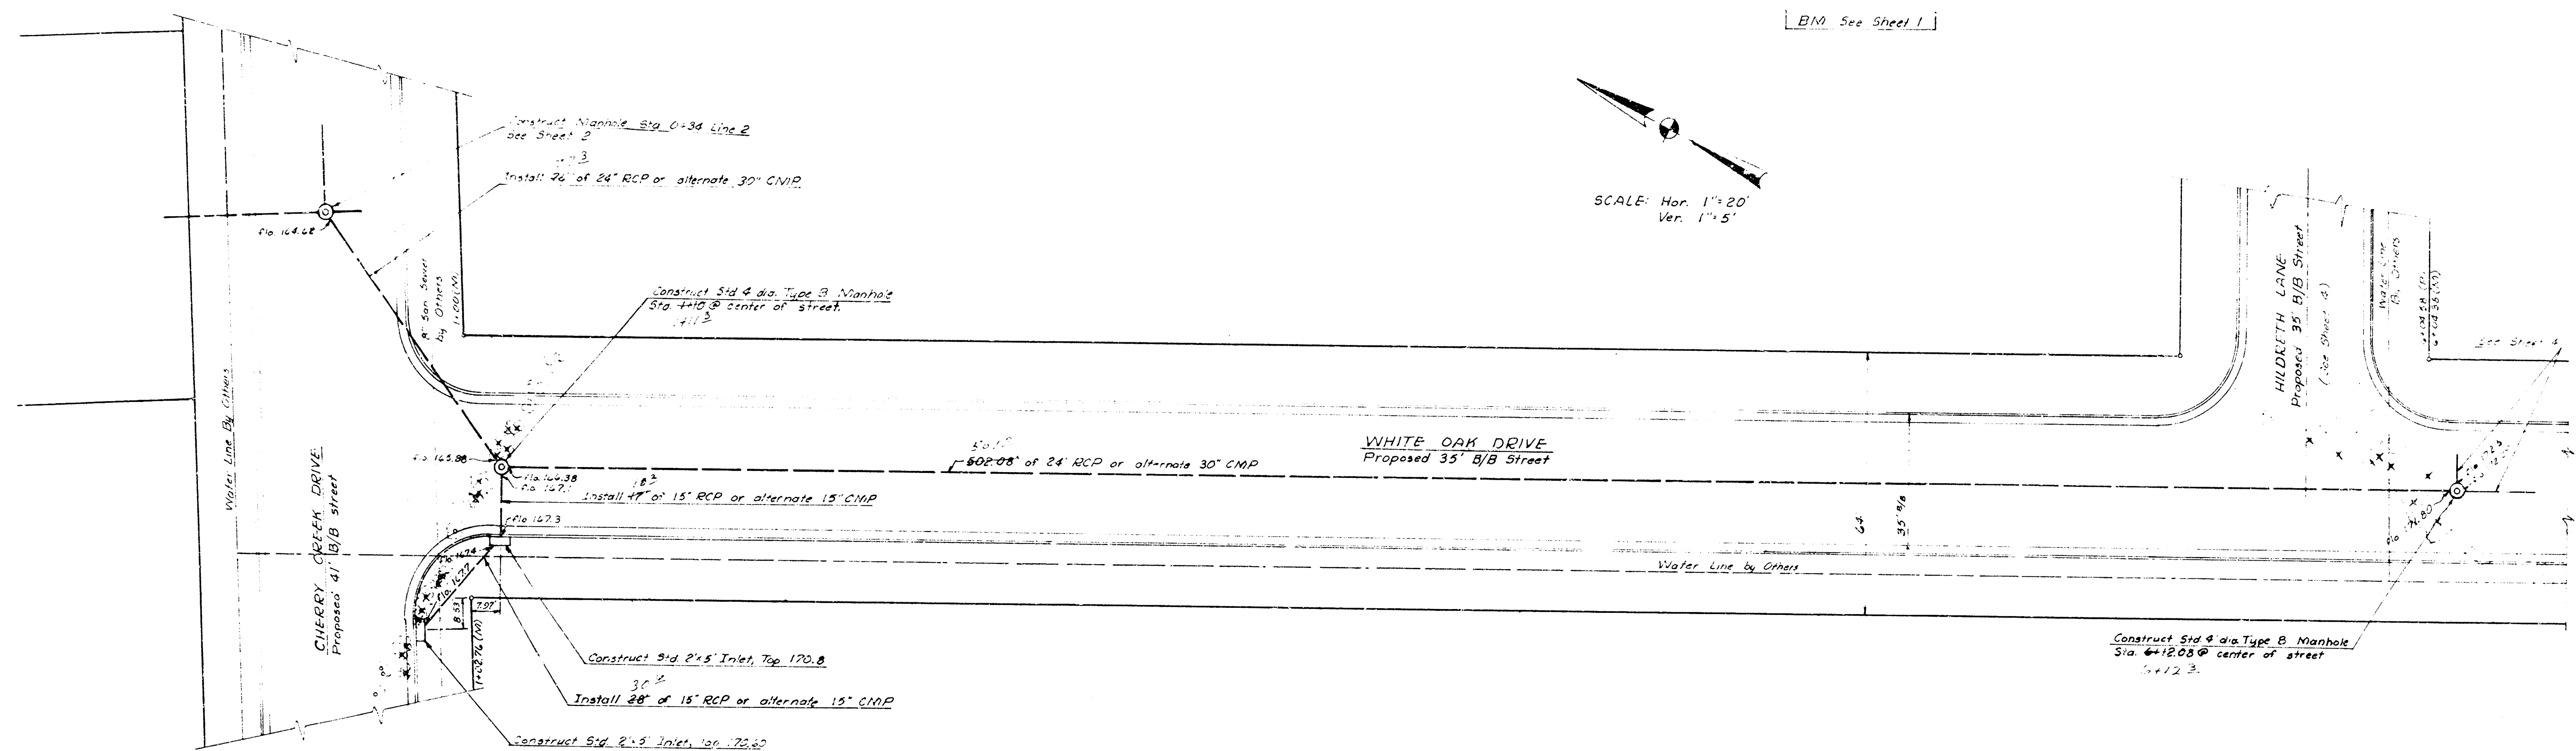

Sewer Sta = Street Plan Sta + 100'

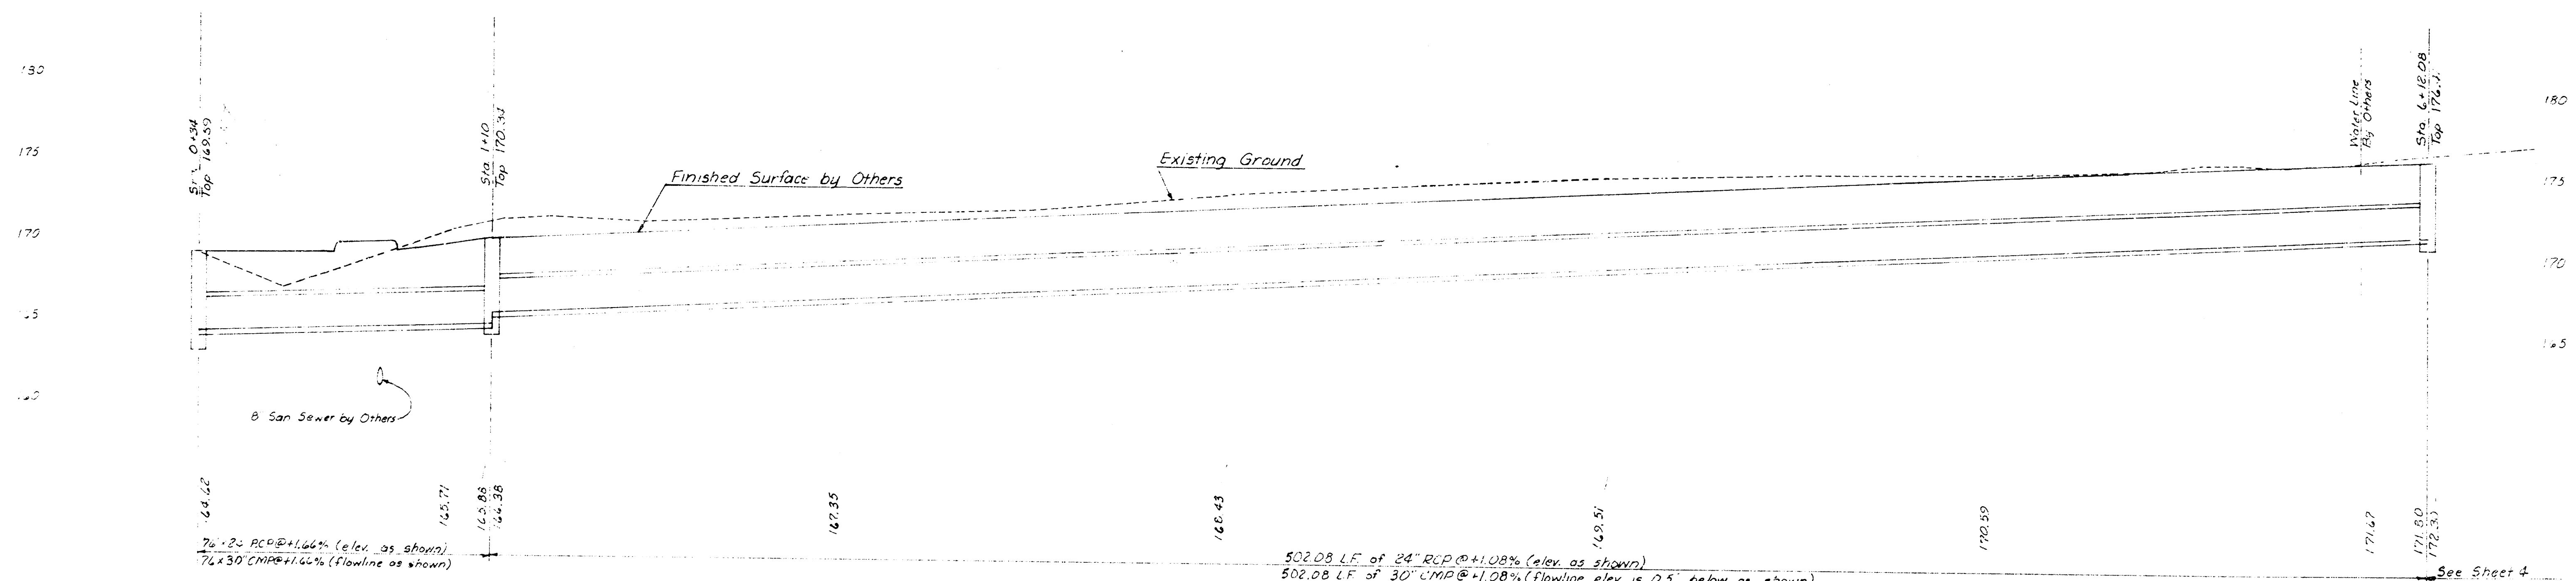

LINE 2

