

CITY OF WICHITA, KANSAS

STORM WATER SEWER NO. 173

PROJECT NO. 468-76-245-80884-000-000-001


SCALE 1"=200'

BENCH MARKS

- BM - City Brass Cap 25' N. & 30' E. of S. 1/4 Cor. Sec. 7, T. 275, R. 1W Elev. = 157.99
- BM - RR Spike in N. Side Hedge Tree 20' S. P.I. Hedge rows S#E. Near Center SW 1/4 Elev. = 160.08
- BM - RR Spike W. Side 16" Hedge Tree in Hedge row 1300± E. of W. 1/4 Cor. Elev. = 163.29
- BM - RR Spike E. Side Hedge Tree in E-W Hedge row 60± E. of W. 1/4 Cor. Elev. = 166.66
- BM - RR Spike NE Side 10" Dia. Elm W. Side 119th 1300± N. of SW Cor. Sec. 7 Elev. = 169.675
- BM - City Brass Cap @ NE Cor. Int. 119th St. and 13th St. Elev. = 162.545
- BM - RR Spike in 1st HLP W. of Jaax Prop. Elev. = 158.76
- BM - RR Spike W. Side Hedge Tree 5± E. of NE Cor. Blk. 3 Echo Hills Elev. = 154.595

LEGEND

- BENEFIT DISTRICT BOUNDARY
- DRAINAGE FLOW DIRECTION
- PROPOSED INLET
- PROPOSED MANHOLE

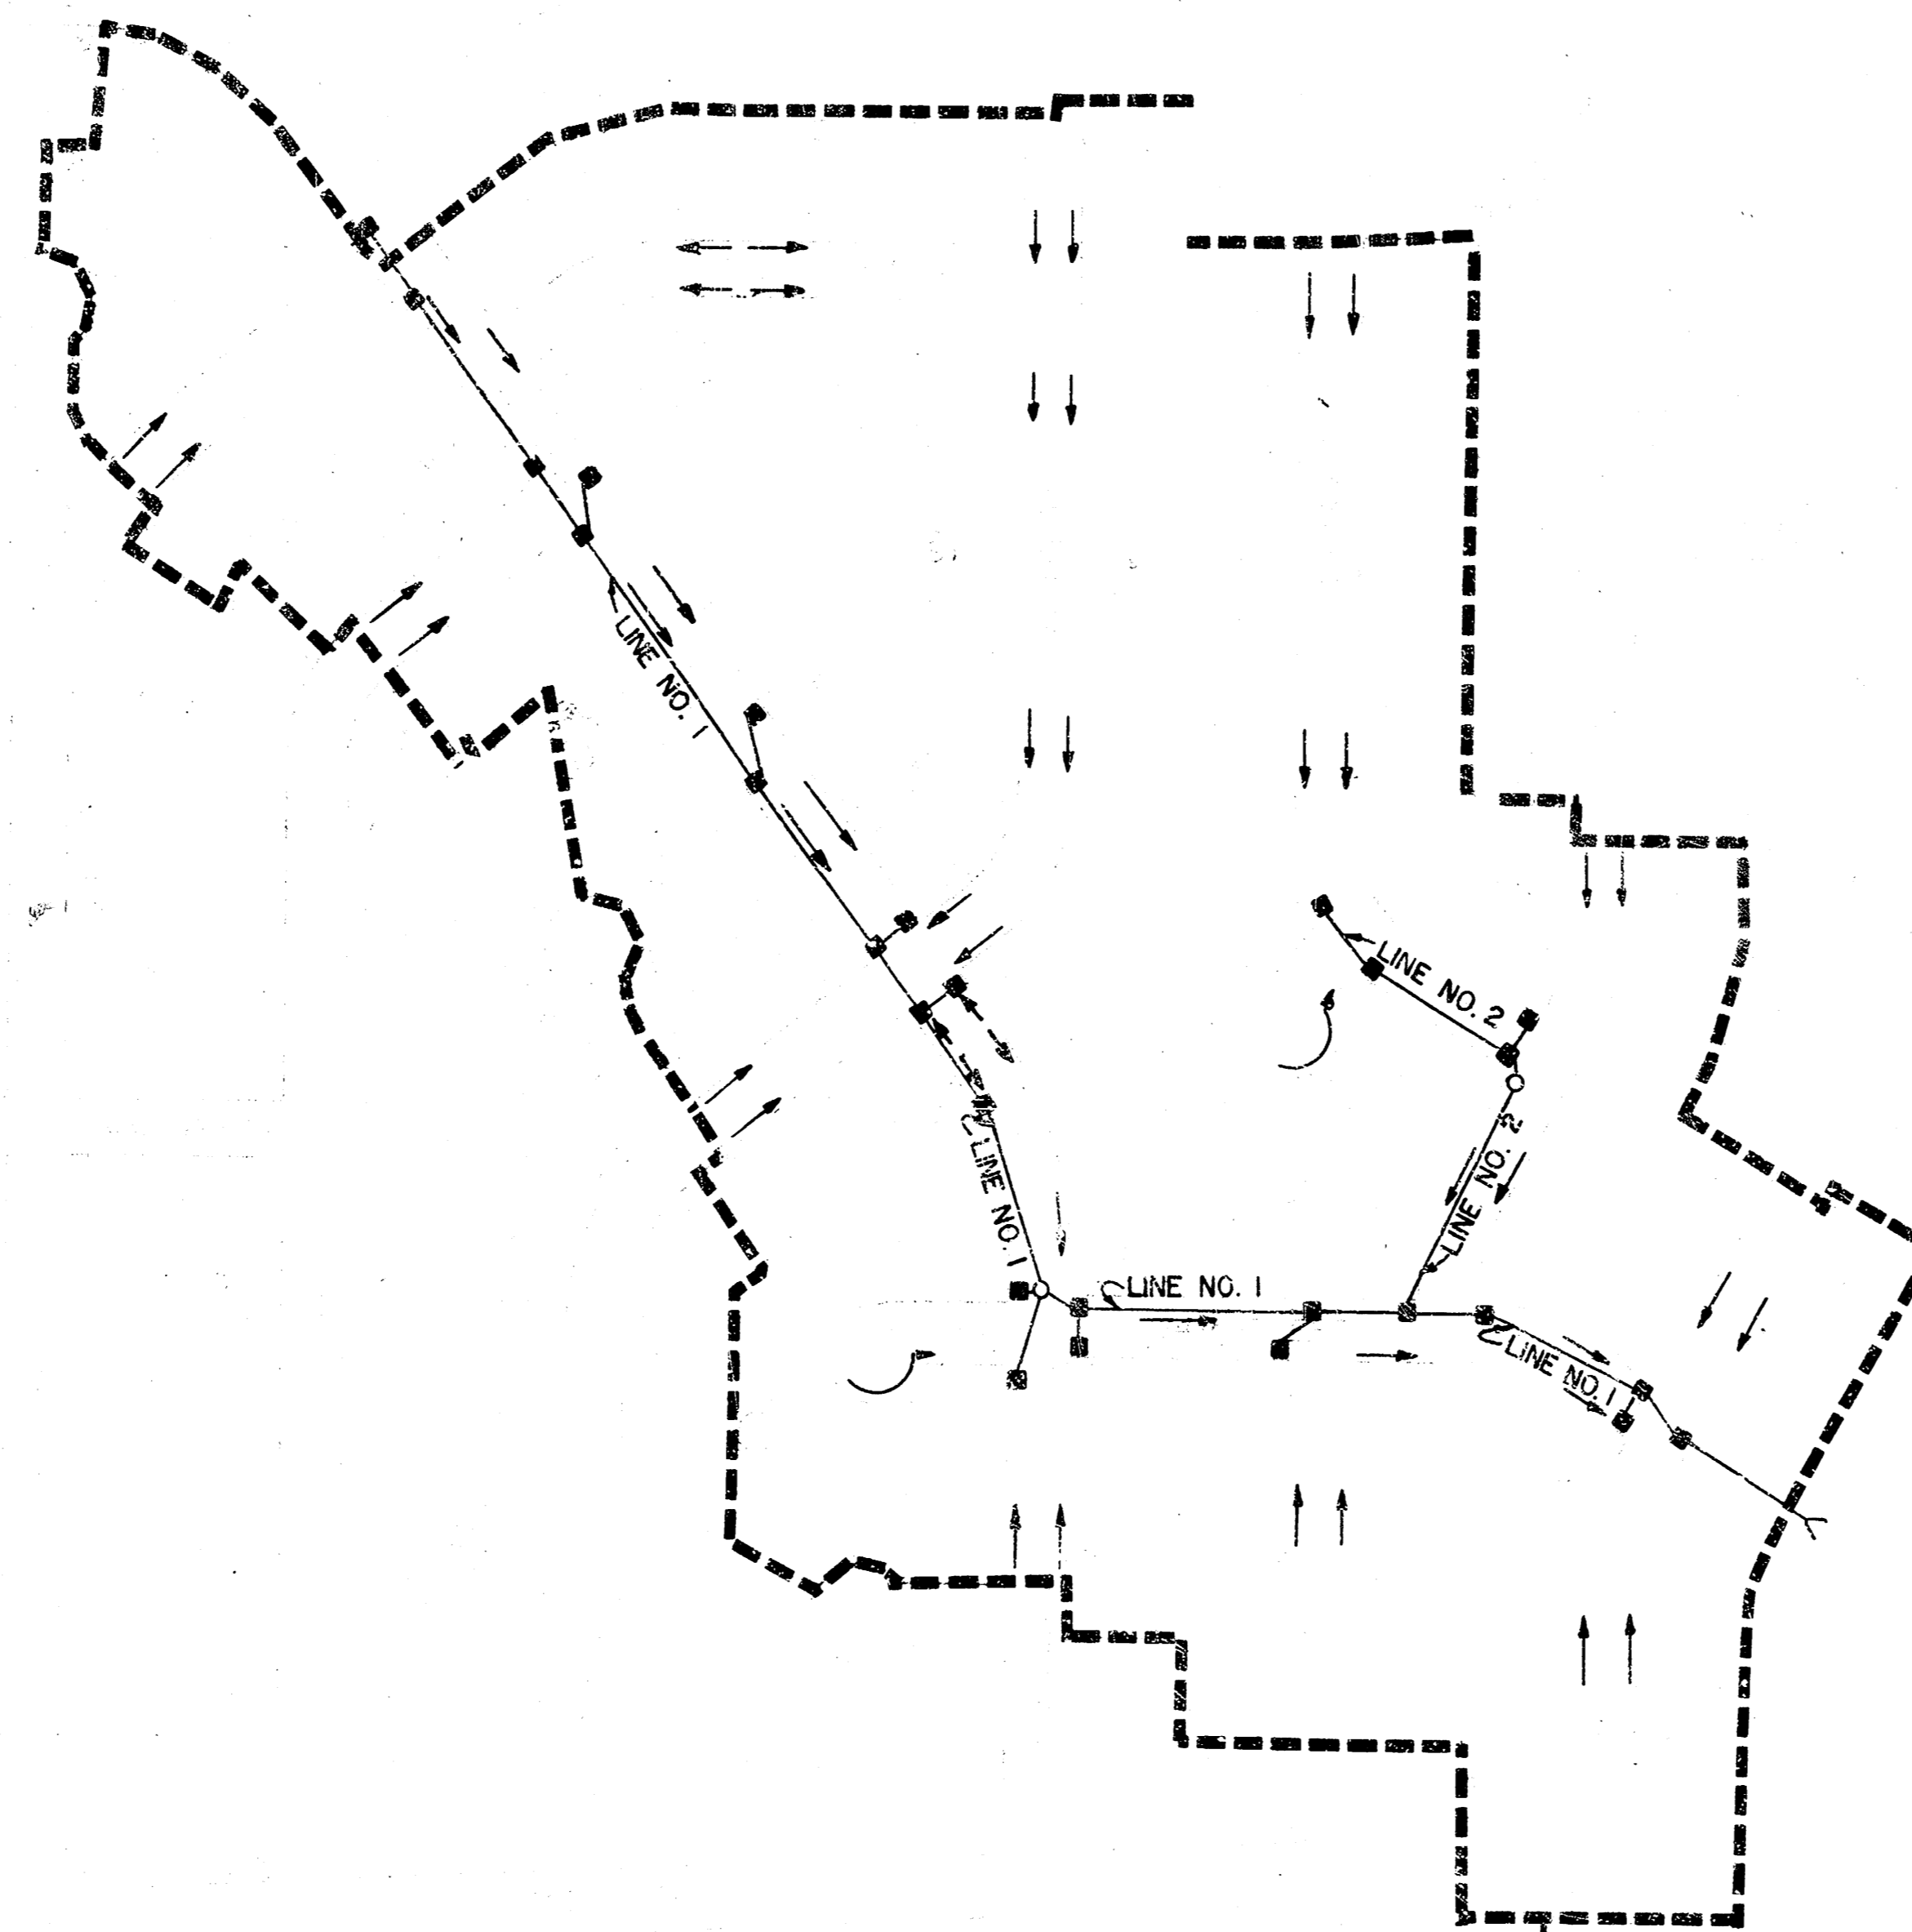

STORM WATER SEWER NO. 173
BENEFIT DISTRICT

MAY, 1980

INDEX OF SHEETS


- 1. TITLE SHEET
- 2-6. PLAN - PROFILE LINE NO. 1
- 7-8. PLAN - PROFILE LINE NO. 2
- 9. DETAIL CONCRETE HEADWALL
- 10. DETAIL STANDARD TYPE 1A CURB INLET
- 11. DETAIL PRECAST TYPE 1A CURB INLET
- 12. DETAIL REINFORCED CONCRETE MANHOLE

GENERAL NOTES

1. CONTRACTOR SHALL COORDINATE WORK WITH PAVING AND SANITARY CONTRACTORS, AND CONTACT RELEVANT UTILITY COMPANIES AND OTHER AGENCIES INVOLVED WITH THIS PROJECT SITE DEVELOPMENT.
2. FIELD ENGINEER SHALL TAKE TIES TO ALL IRONS AND THIMBLES IN THE PROJECT AREA BEFORE CONSTRUCTION BEGINS. FIELD ENGINEER SHALL REPLACE ALL SUCH IRONS AND THIMBLES DISTURBED DURING CONSTRUCTION.
3. THE TOPS OF INLETS AND MANHOLES AS NOTED ON THE PLANS MAY VARY SO AS TO MEET PROPOSED TOP OF CURB ELEVATIONS OR PAVEMENT ELEVATIONS. THE FIELD ENGINEER SHALL LOCATE INLETS AND MANHOLES WITH REFERENCE TO PROPOSED PAVING PLANS OF THE PERTINENT STREETS.
4. ALL METAL PIPES SHALL BE HELICALLY CORRUGATED PIPE, AND SHALL BE SMOOTH FLOW PIPES FOR SIZES 24" DIAMETER OR LARGER. ALL CONNECTIONS FOR THESE PIPES SHALL BE CONSTRUCTED USING HUGGER TYPE COUPLER OR EQUAL.
5. ALL CONCRETE SHALL BE "6-SACK CONCRETE" UNLESS OTHERWISE NOTED.
6. EARTHWORK FOR CHANNEL DOWNSTREAM FROM HEADWALL SHALL BE PAID FOR AS "EXCAVATION".
7. THE RIPRAP FOR THIS PROJECT SHALL BE TYPE 3. THE TYPE 3 RIPRAP SHALL BE 12" RIPRAP ON 6" SAND AND GRAVEL BEDDING. THE ROCK FOR RIPRAP AND GRAVEL PROTECTION SHALL BE HARD, DENSE, DURABLE, AND SHALL BE REASONABLY WELL GRADED. THE SIZE RANGE OF ROCK USED SHALL BE A MAXIMUM OF ONE CUBIC FOOT AND A MINIMUM OF 1 1/2". THE 6 INCH SAND AND GRAVEL BEDDING FOR RIPRAP SHALL BE A CONTINUOUS LAYER OF SAND AND GRAVEL OR SAND AND CRUSHED ROCK, REASONABLY WELL GRADED TO A MAXIMUM OF 1 1/2 INCHES IN SIZE.
8. CONTRACTOR SHALL AVOID UNCOVERING EXISTING WATERLINES UNLESS ABSOLUTELY NECESSARY. UNCOVERING SHALL BE DONE ONLY IN THE PRESENCE OF A WATER DEPT. ENGINEER.
9. FOR TYPE 1A CURB INLETS CONTRACTOR SHALL HAVE THE OPTION TO INSTALL PRE-CAST INLETS IN LIEU OF BRICK CONSTRUCTION FOR TYPE 1A CURB INLETS.
10. EXCESS TRENCH MATERIAL SHALL BE WASTED AS DIRECTED BY CITY ENGINEER. THIS WORK SHALL BE CONSIDERED SUBSIDIARY TO THE PROJECT.



	No.	Revision	By	Date
	CITY OF WICHITA, KANSAS TITLE SHEET PHASE 1 STORM WATER SEWER NO. 173 PROJ. NO. 468-76-245-80884-000-000-001			
	PROFESSIONAL ENGINEERING CONSULTANTS, P.A. ENGINEERS WICHITA, KANSAS			
	Designed by <i>C.S.B.</i>	Job No. <i>80050-21</i>	Sht. 1	
Drawn by <i>G.H.</i>	Date <i>May 7, 1980</i>			

As built 11/22/81


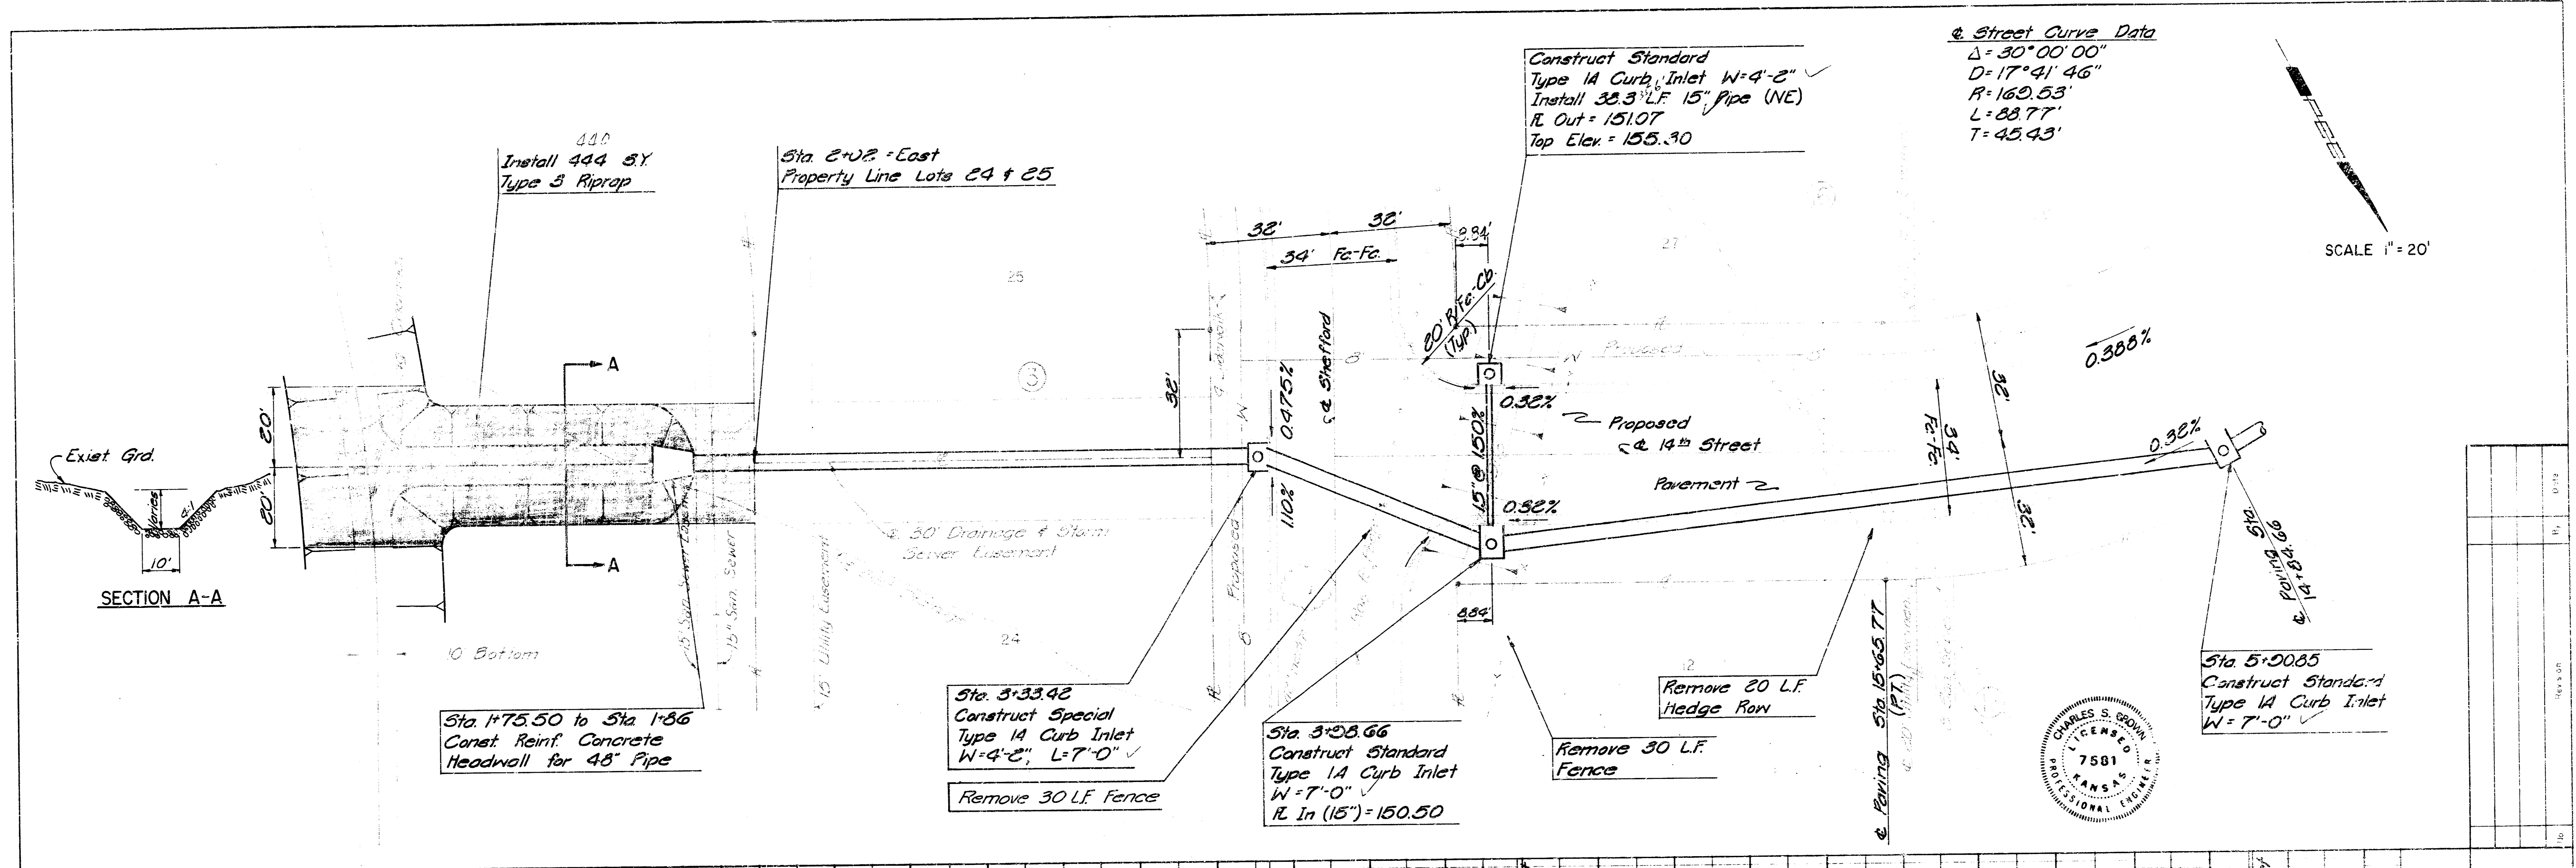


Street Curve Data
 $\Delta = 30^{\circ}00'00''$
 $D = 17^{\circ}41'46''$
 $R = 160.53'$
 $L = 88.77'$
 $T = 45.43'$

SCALE 1" = 20'

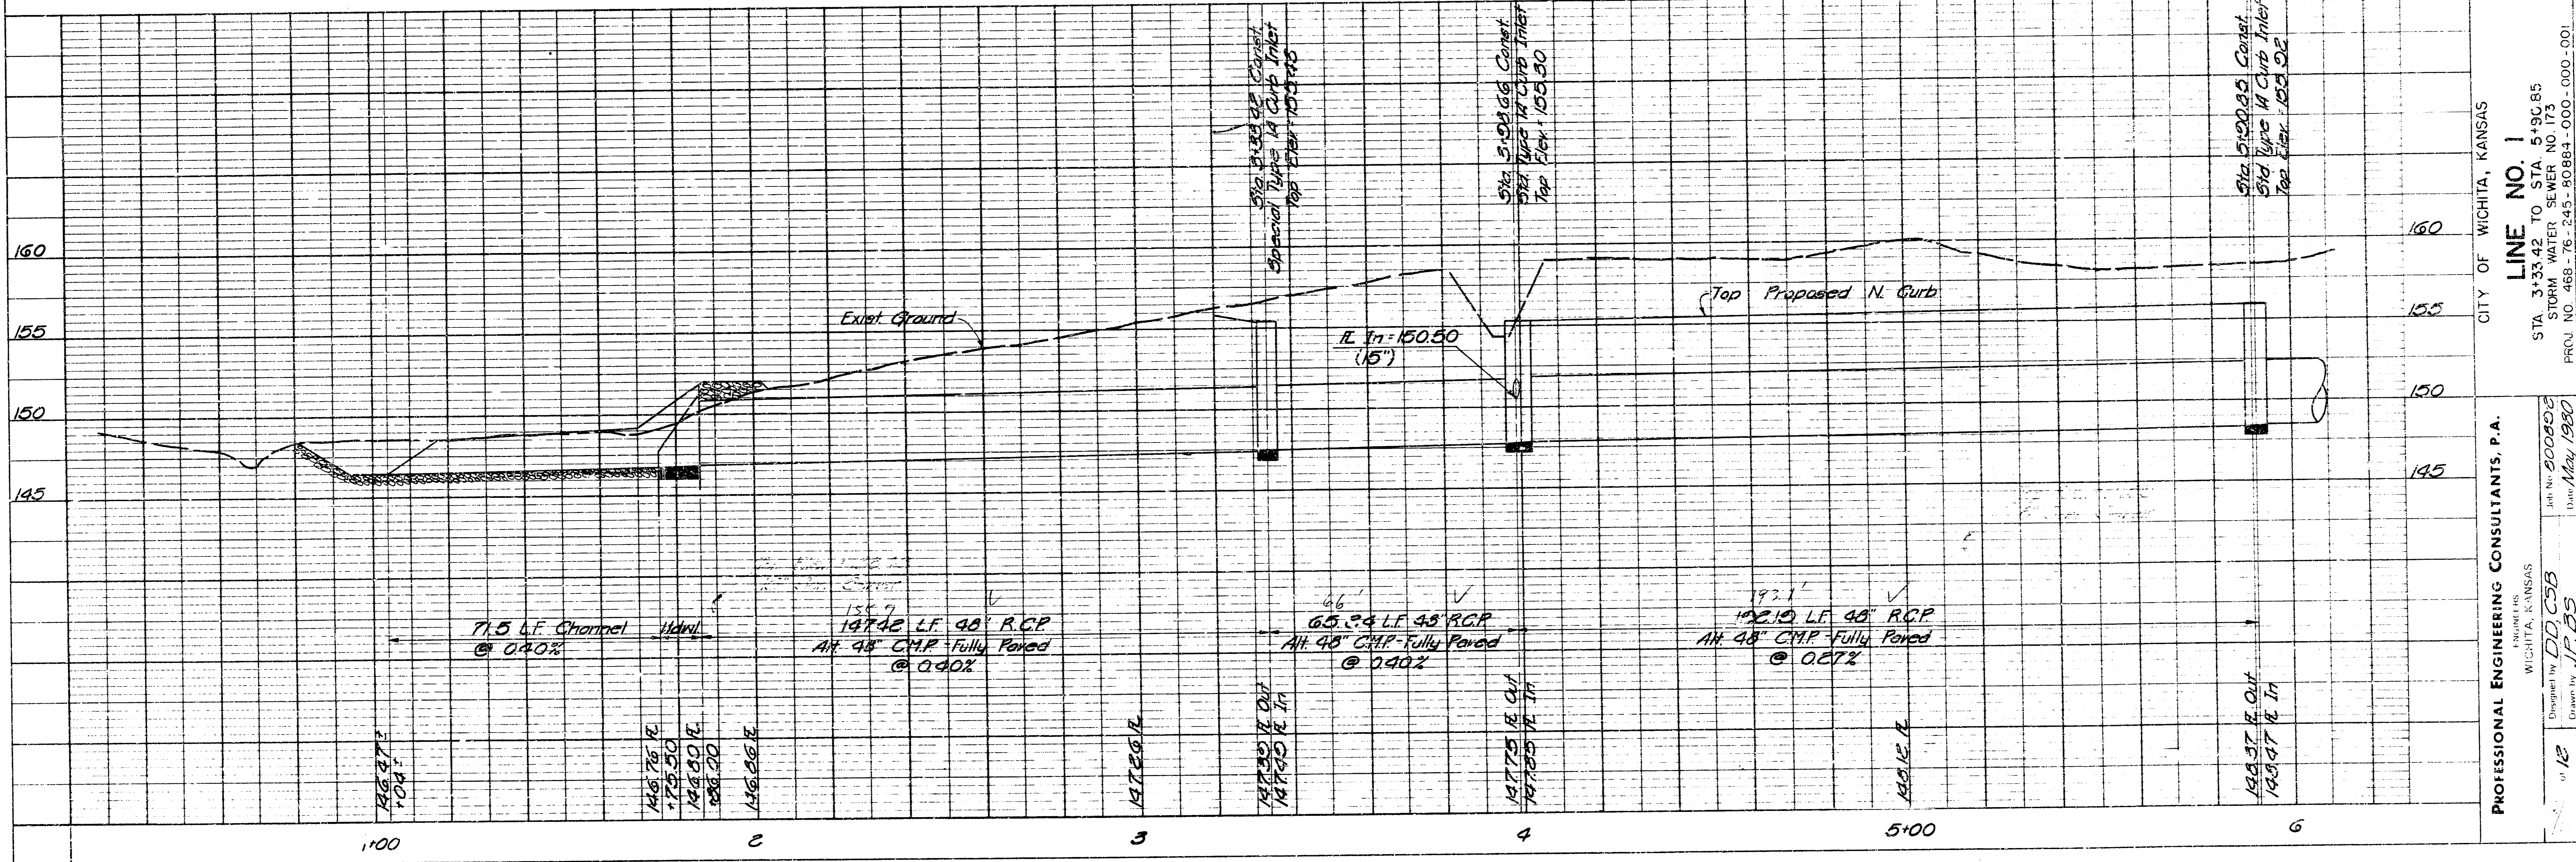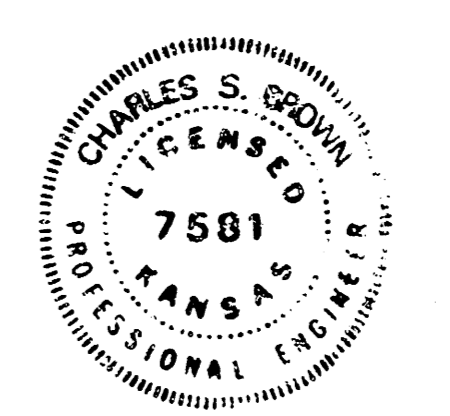

CITY OF WICHITA, KANSAS
LINE NO. 1
 STA 3+33.42 TO STA. 5+90.85
 STORM WATER SEWER NO. 173
 PROJ. NO. 468-76-245-ROBBS-000-000-001
 PROFESSIONAL ENGINEERING CONSULTANTS, P.A.
 WICHITA, KANSAS
 Drawn by **DD, CSB**
 Date: **May 1980**
 of 18

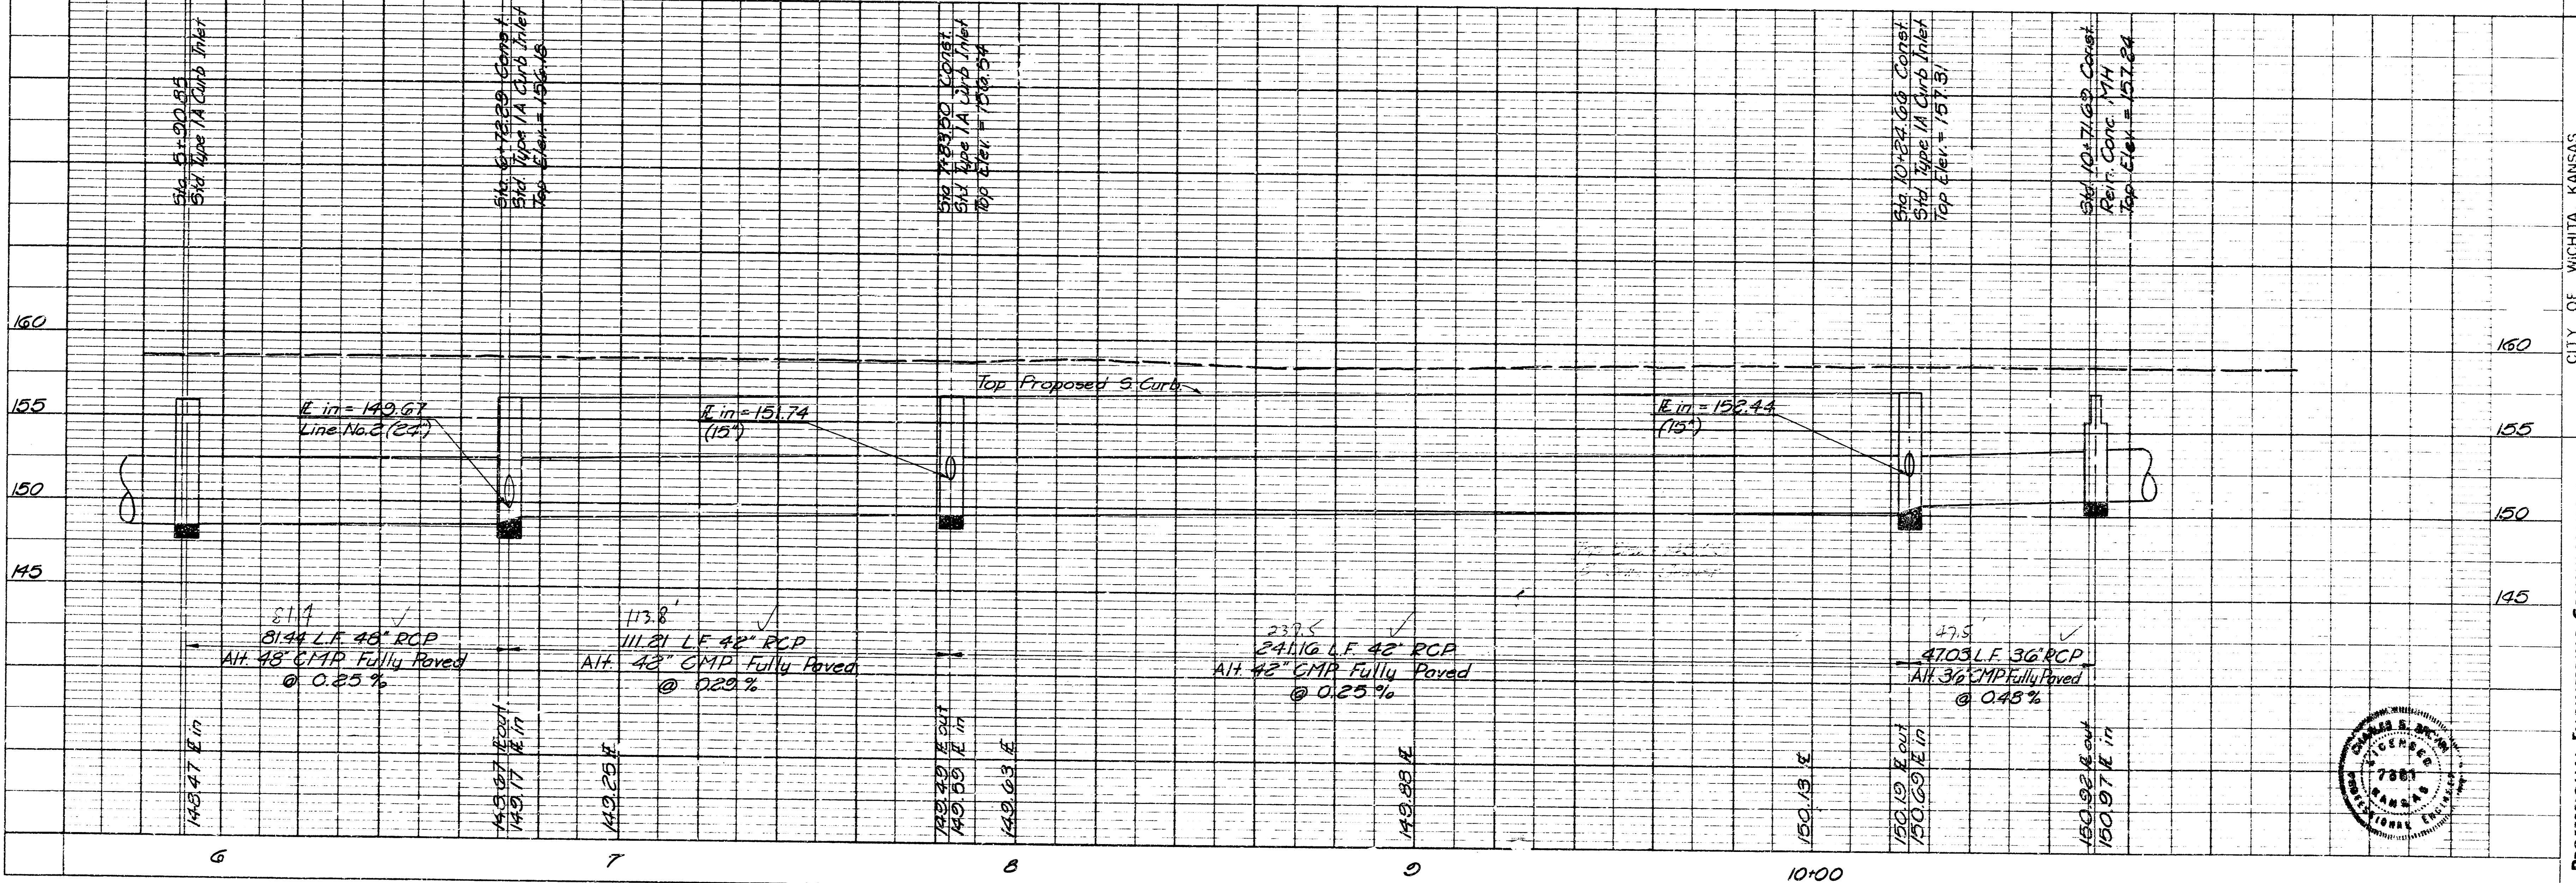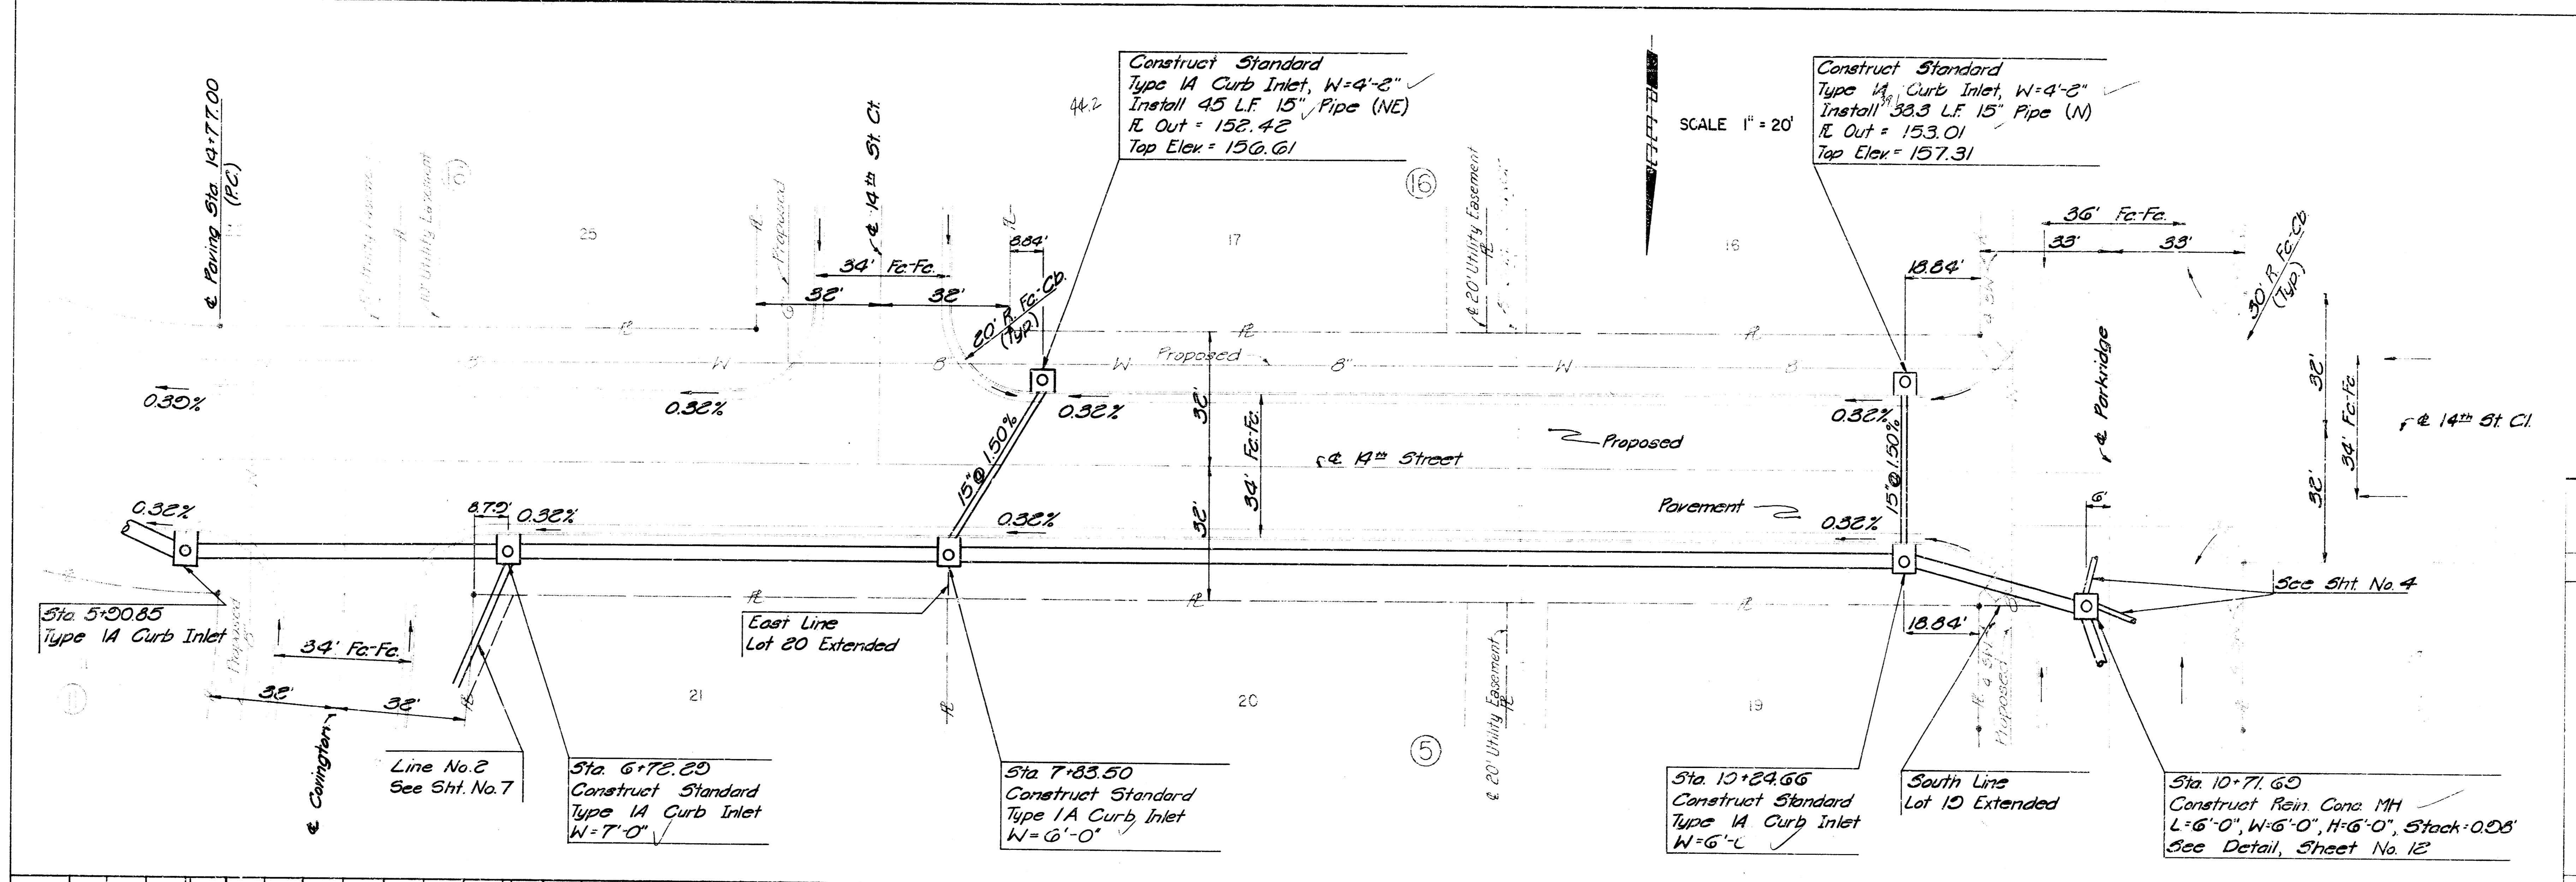

CITY OF WICHITA, KANSAS

LINE NO. 1

STN. 5190.85 TO STA. 1071.69

SIDRM WATER SEWER NO 173

PROJ NO 468-7E-245-90886-000-000-001

PROFESSIONAL ENGINEERING CONSULTANTS, P.A.

WICHITA, KANSAS

Drawn by **DD, CSB**

Checked by **JF, BS, PM**

Date **May 1981**

3 of 12

By **LPH**




788

Construct Standard
Type 1A Curb Inlet, W=4'-2"
Install 23.5 L.F. 15" Pipe (NE)
R. Out = 153.80
Top Elev = 157.67

Construct Standard
Type 1A Curb Inlet, W=4'-2"
Install 25.2 L.F. 15" Pipe (SE)
R. Out = 153.15
Top Elev = 157.50

& Street Curve Data
Δ=37°40'00"
D=2°50'05"
R=303.00'
L=251.70'
T=130.65'


Sta. 12+70.15
Construct Standard
Type 1A Curb Inlet, W=6'-0"

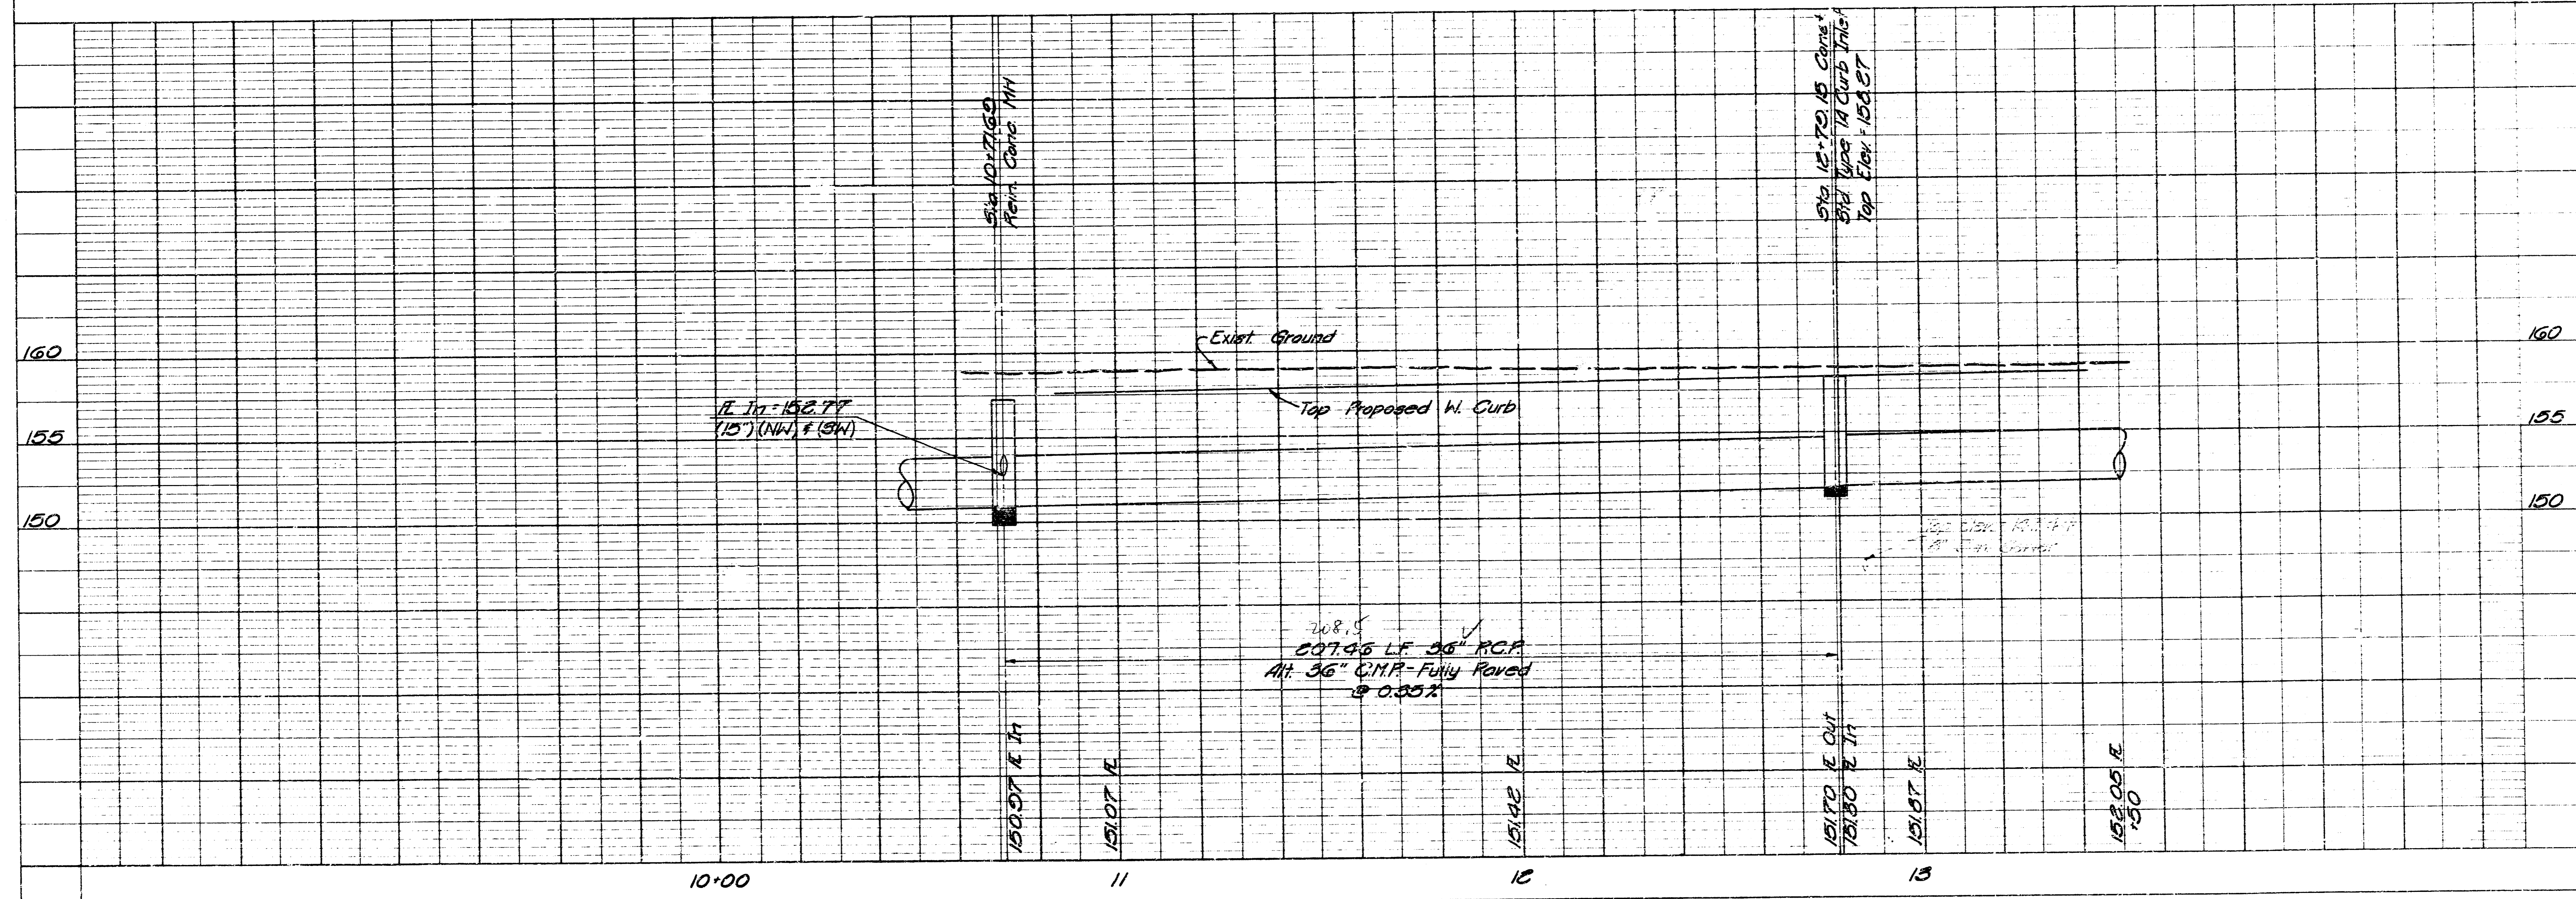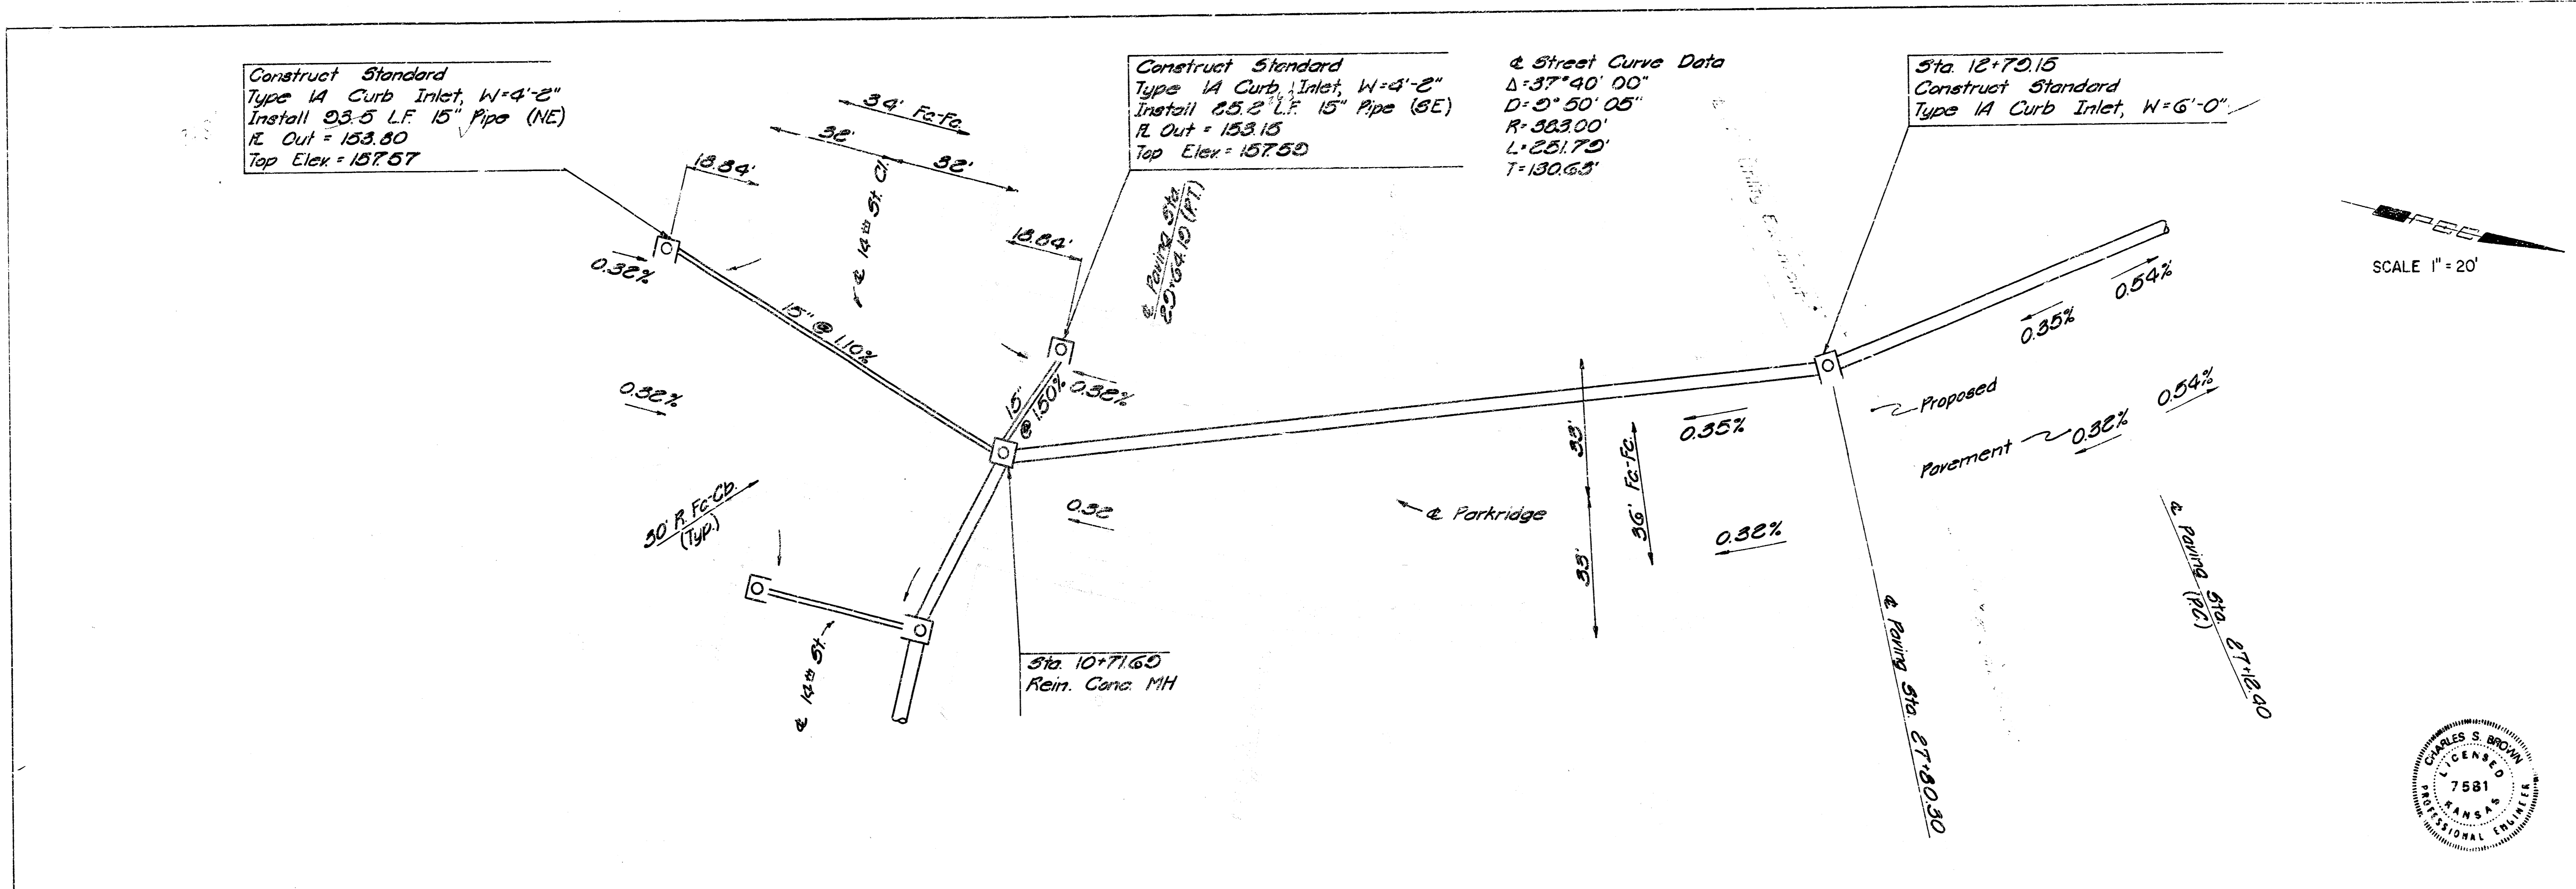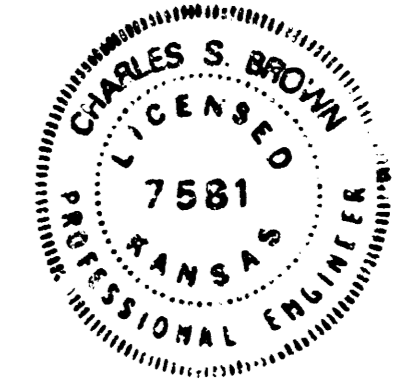

CITY OF WICHITA, KANSAS
LINE NO. 1
 STA. 10+71.69 TO STA. 13+50.00
 STORM WATER SEWER NO. 1173
 PROJ. NO. 488-76-245-80884 - 000-000-001

PROFESSIONAL ENGINEERING CONSULTANTS, P.A.
 WICHITA, KANSAS
 License No. 80088-E
 Designer: D.C. C5B
 Date: May 1980
 Drawn by: J.F. B5

7 of 12

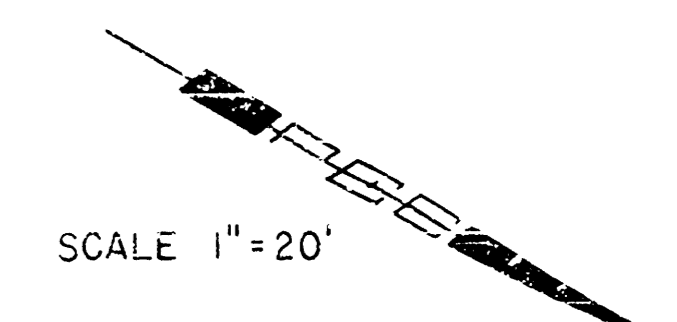

Sta 13+84.99
Construct Standard
Type IA Curb Inlet, W=6'-0" ✓
R In (15") = 153.97



Sta 14+86.67
Construct Standard
Type IA Curb Inlet, W=6'-0" ✓
R In (15") = 153.78

Sta 16+87.83
Construct Standard
Type IA Curb Inlet, W=5'-0" ✓
R In (15") = 154.83




Construct Standard
Type IA Curb Inlet, W=4'-2" ✓
Install 40.3 LF 15" Pipe (SW)
R Out = 154.49
Top Elev = 158.27

Construct Standard
Type IA Curb Inlet, W=4'-2" ✓
Install 40.3 LF 15" Pipe (SW)
R Out = 154.18
Top Elev = 158.22

Construct Standard
Type IA Curb Inlet, W=4'-2" ✓
Install 60.8 LF 15" Pipe (S)
R Out = 155.53
Top Elev = 159.30

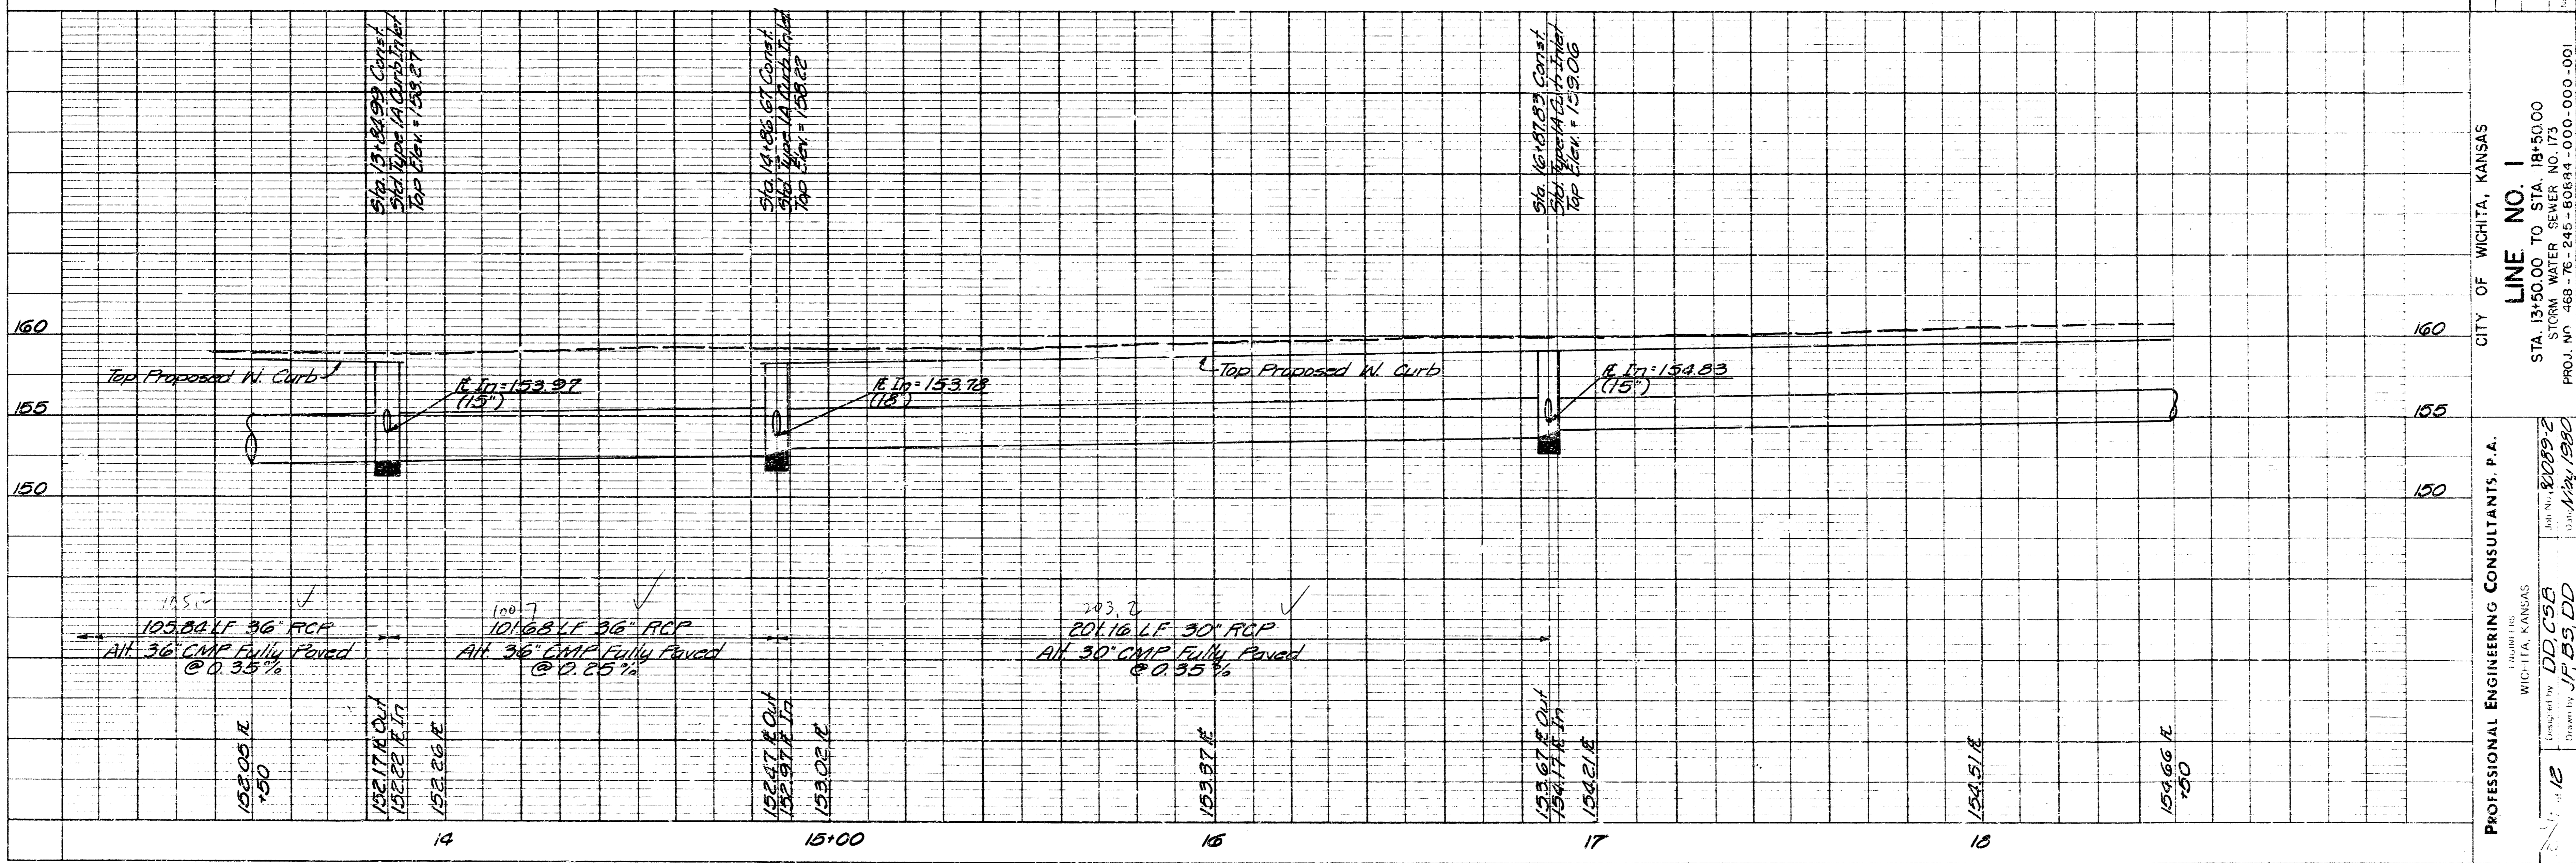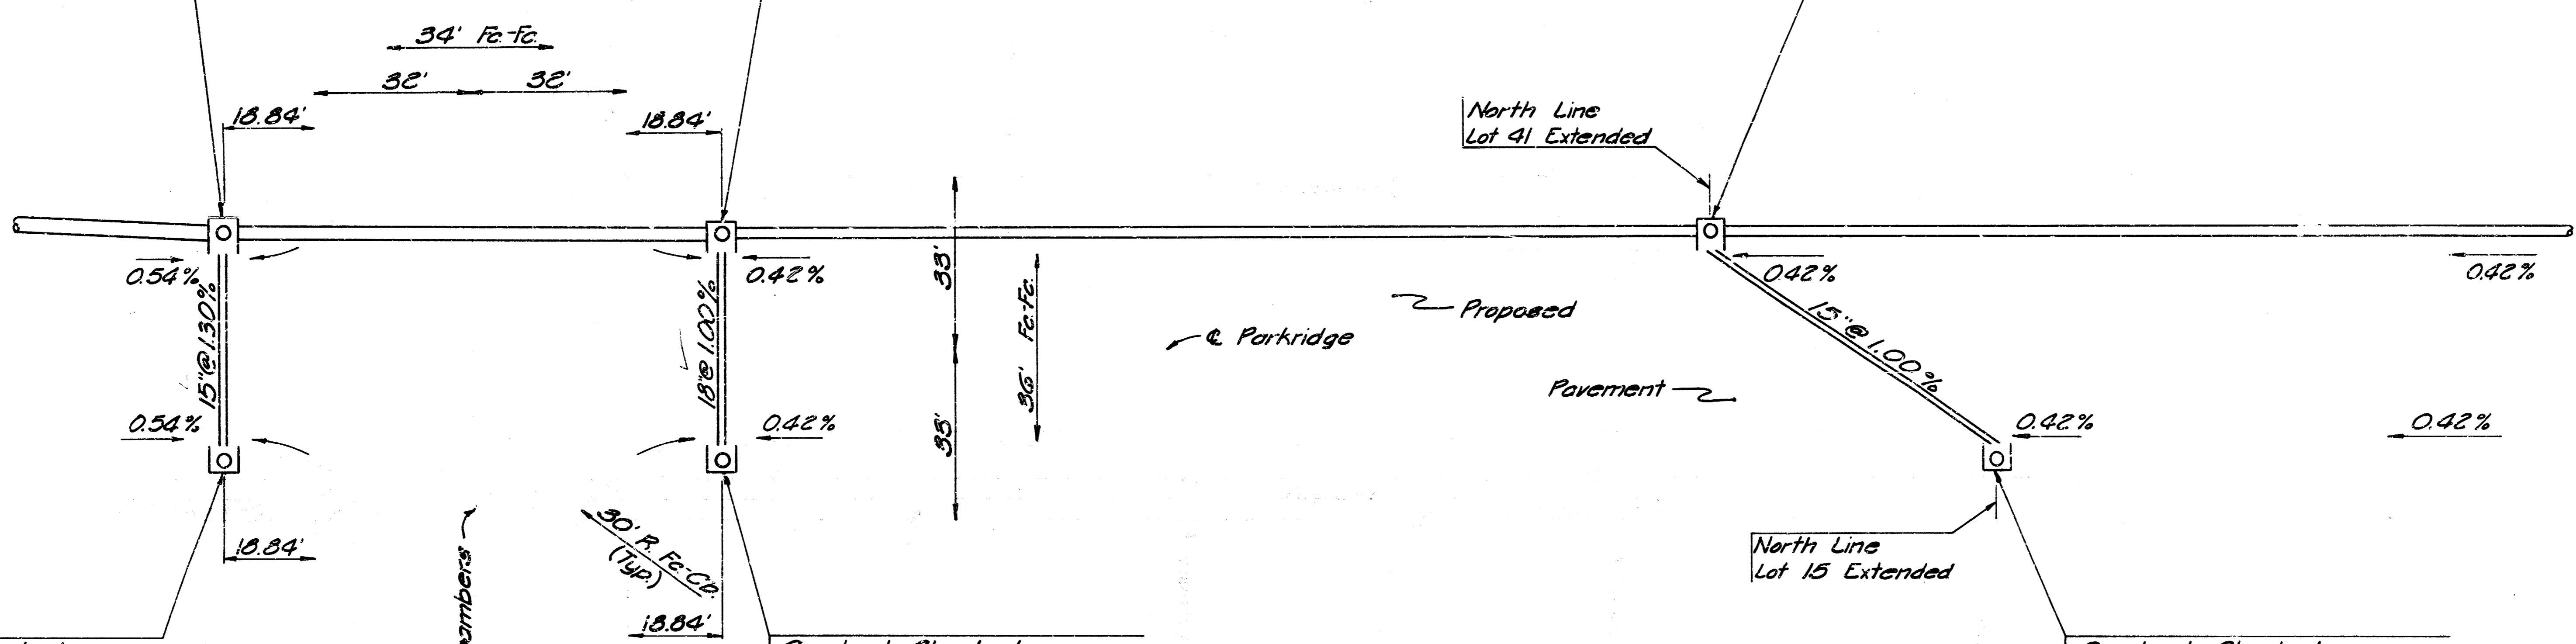




CITY OF WICHITA, KANSAS
LINE NO. 1
 STA. 13+50.00 TO STA. 18+50.00
 STORM WATER SEWER NO. 173
 PROJ. NO. 468-76-245-808R4-000-000-001
 PROFESSIONAL ENGINEERING CONSULTANTS, P.A.
 WICHITA, KANSAS
 DATE: 12/28/92
 DRAWN BY: DD, CSB
 CHECKED BY: JP, BS, DD
 DATE: 1/24/1993

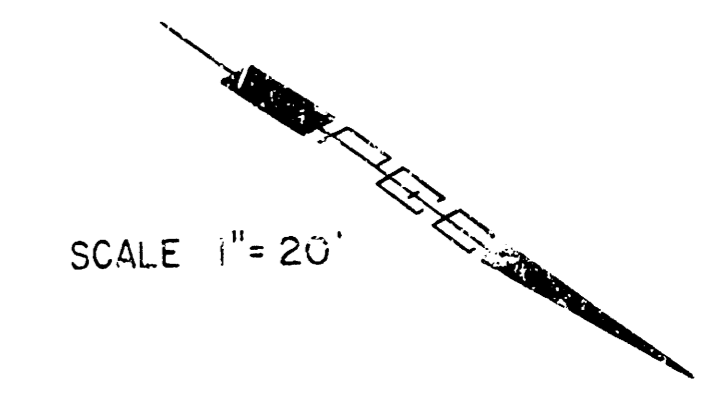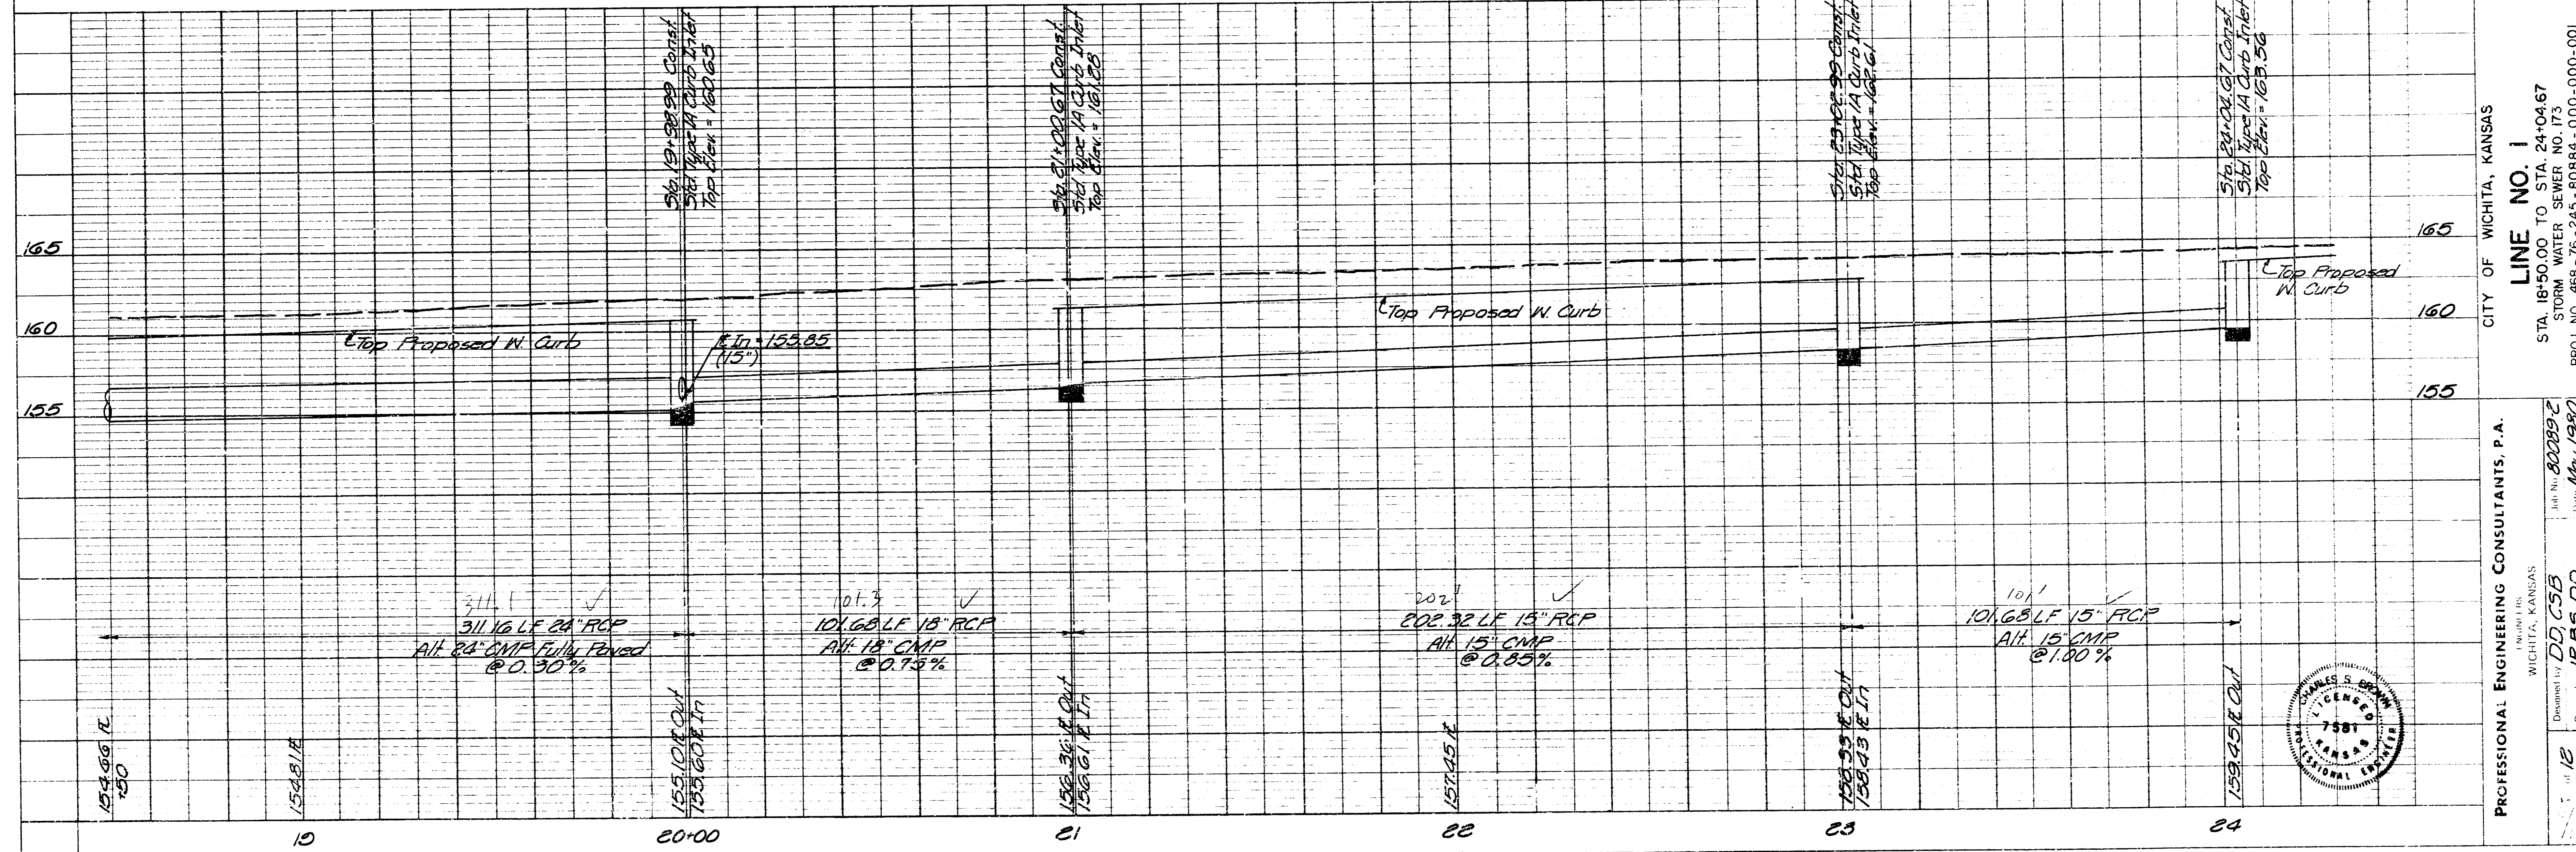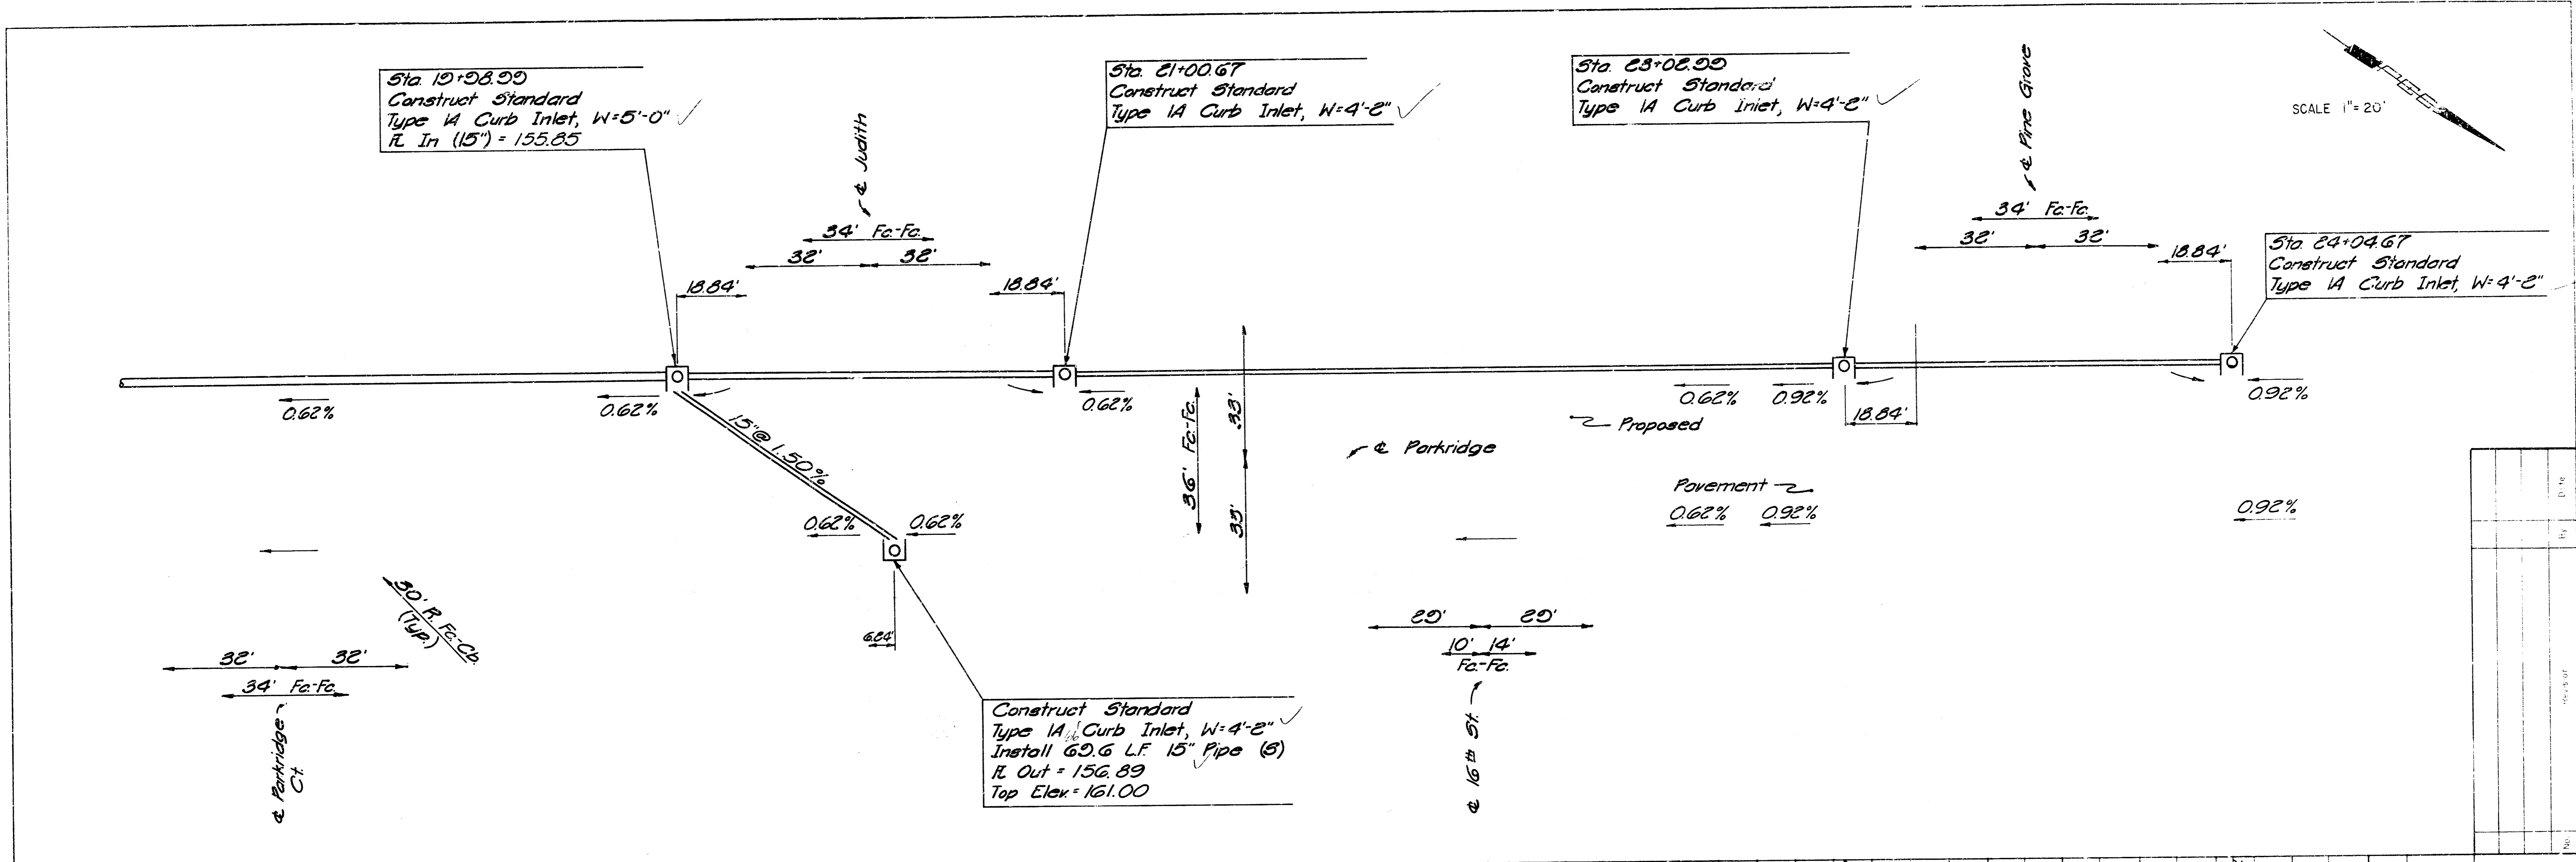


CITY OF WICHITA, KANSAS
LINE NO. 1
 STA. 18+50.00 TO STA. 24+04.67
 STORM WATER SEWER NO. 173
 PROJ. NO. 468-76-245-80884-000-000-001



PROFESSIONAL ENGINEERING CONSULTANTS, P.A.
 WICHITA, KANSAS
 License No. 80289-2
 Drawn by DD GSB
 Date: May 1980
 Checked by JP BS DD

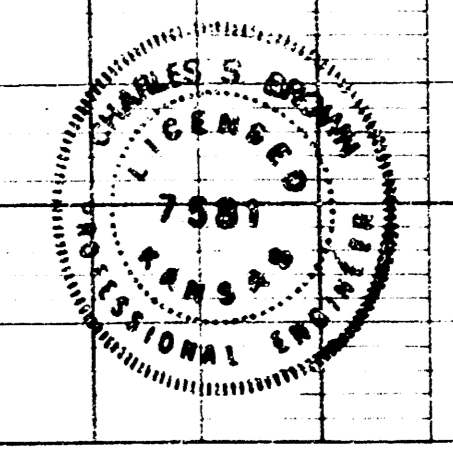

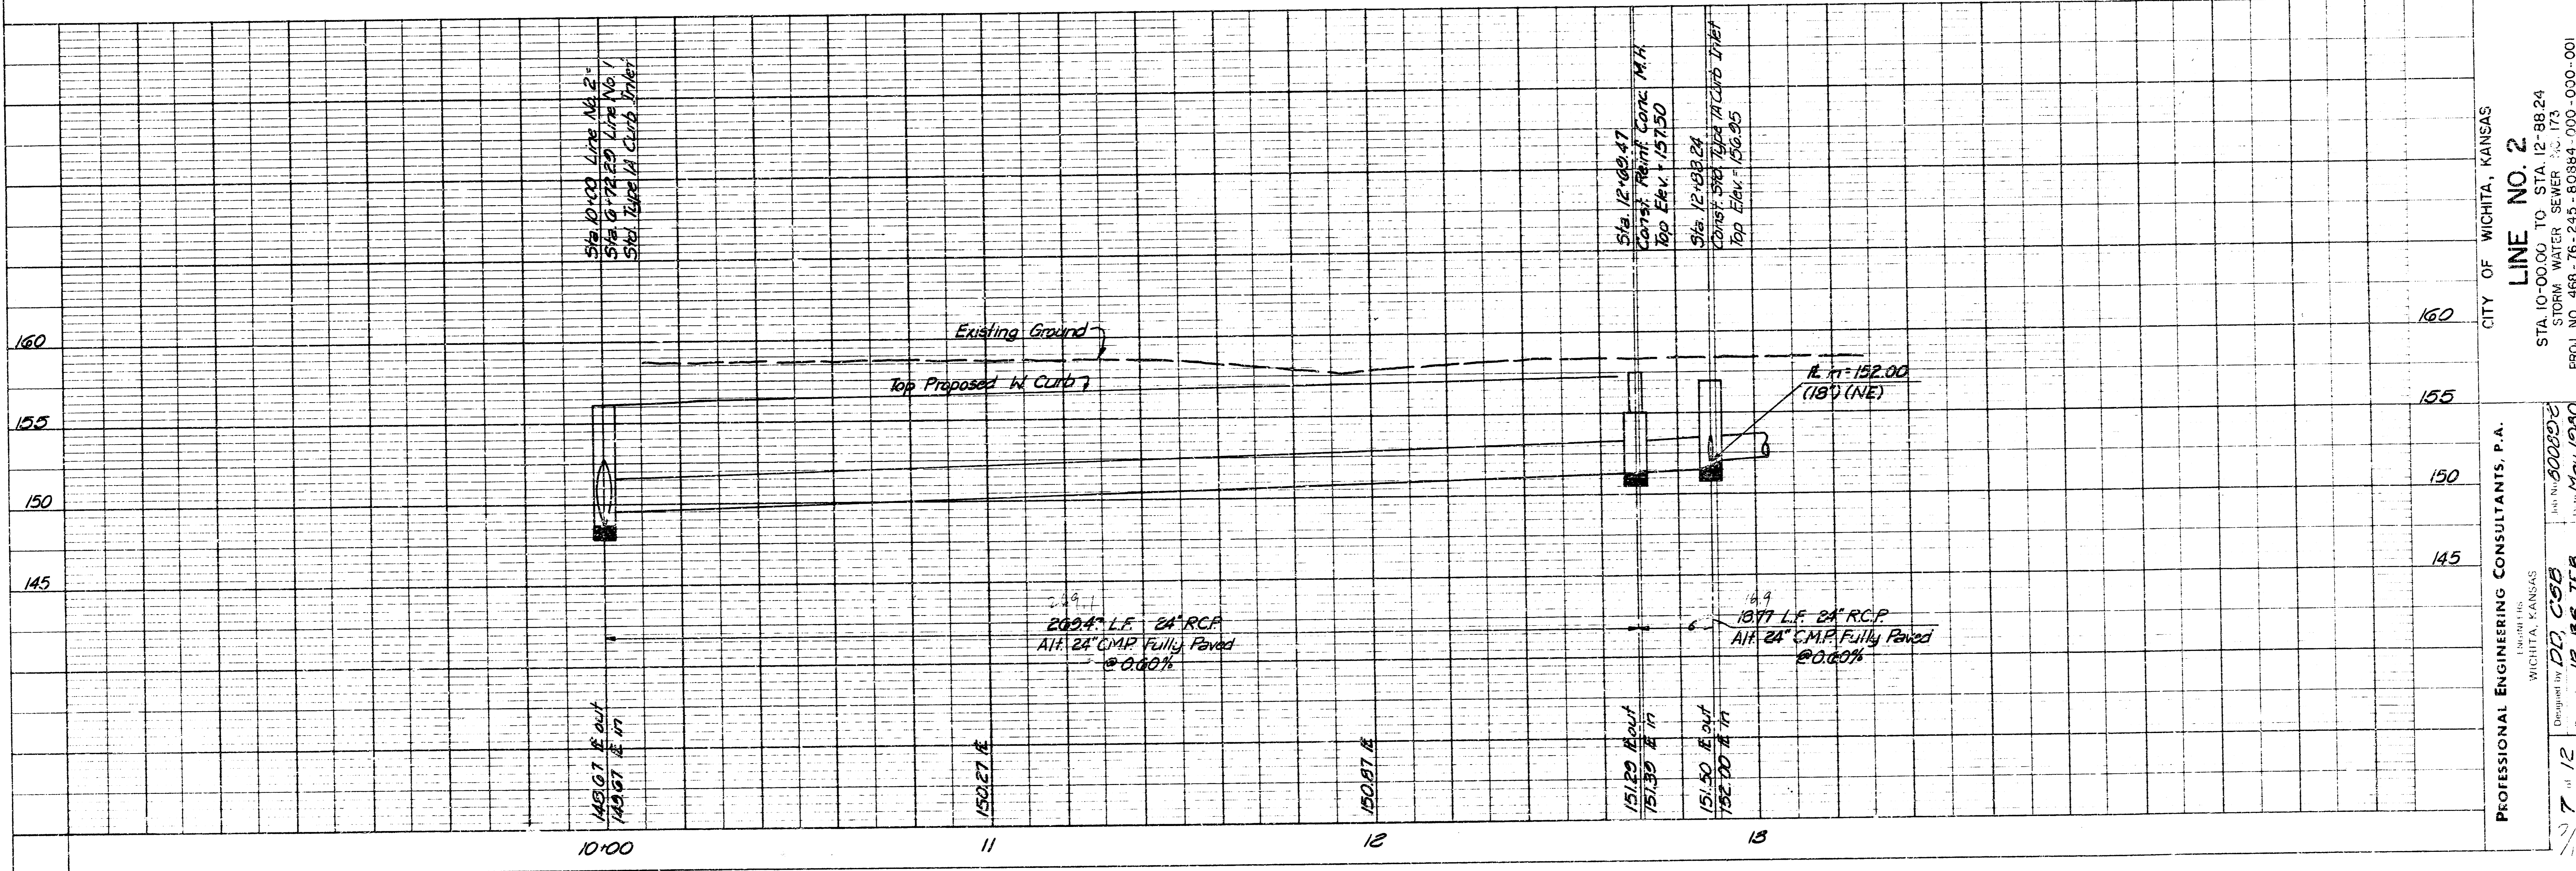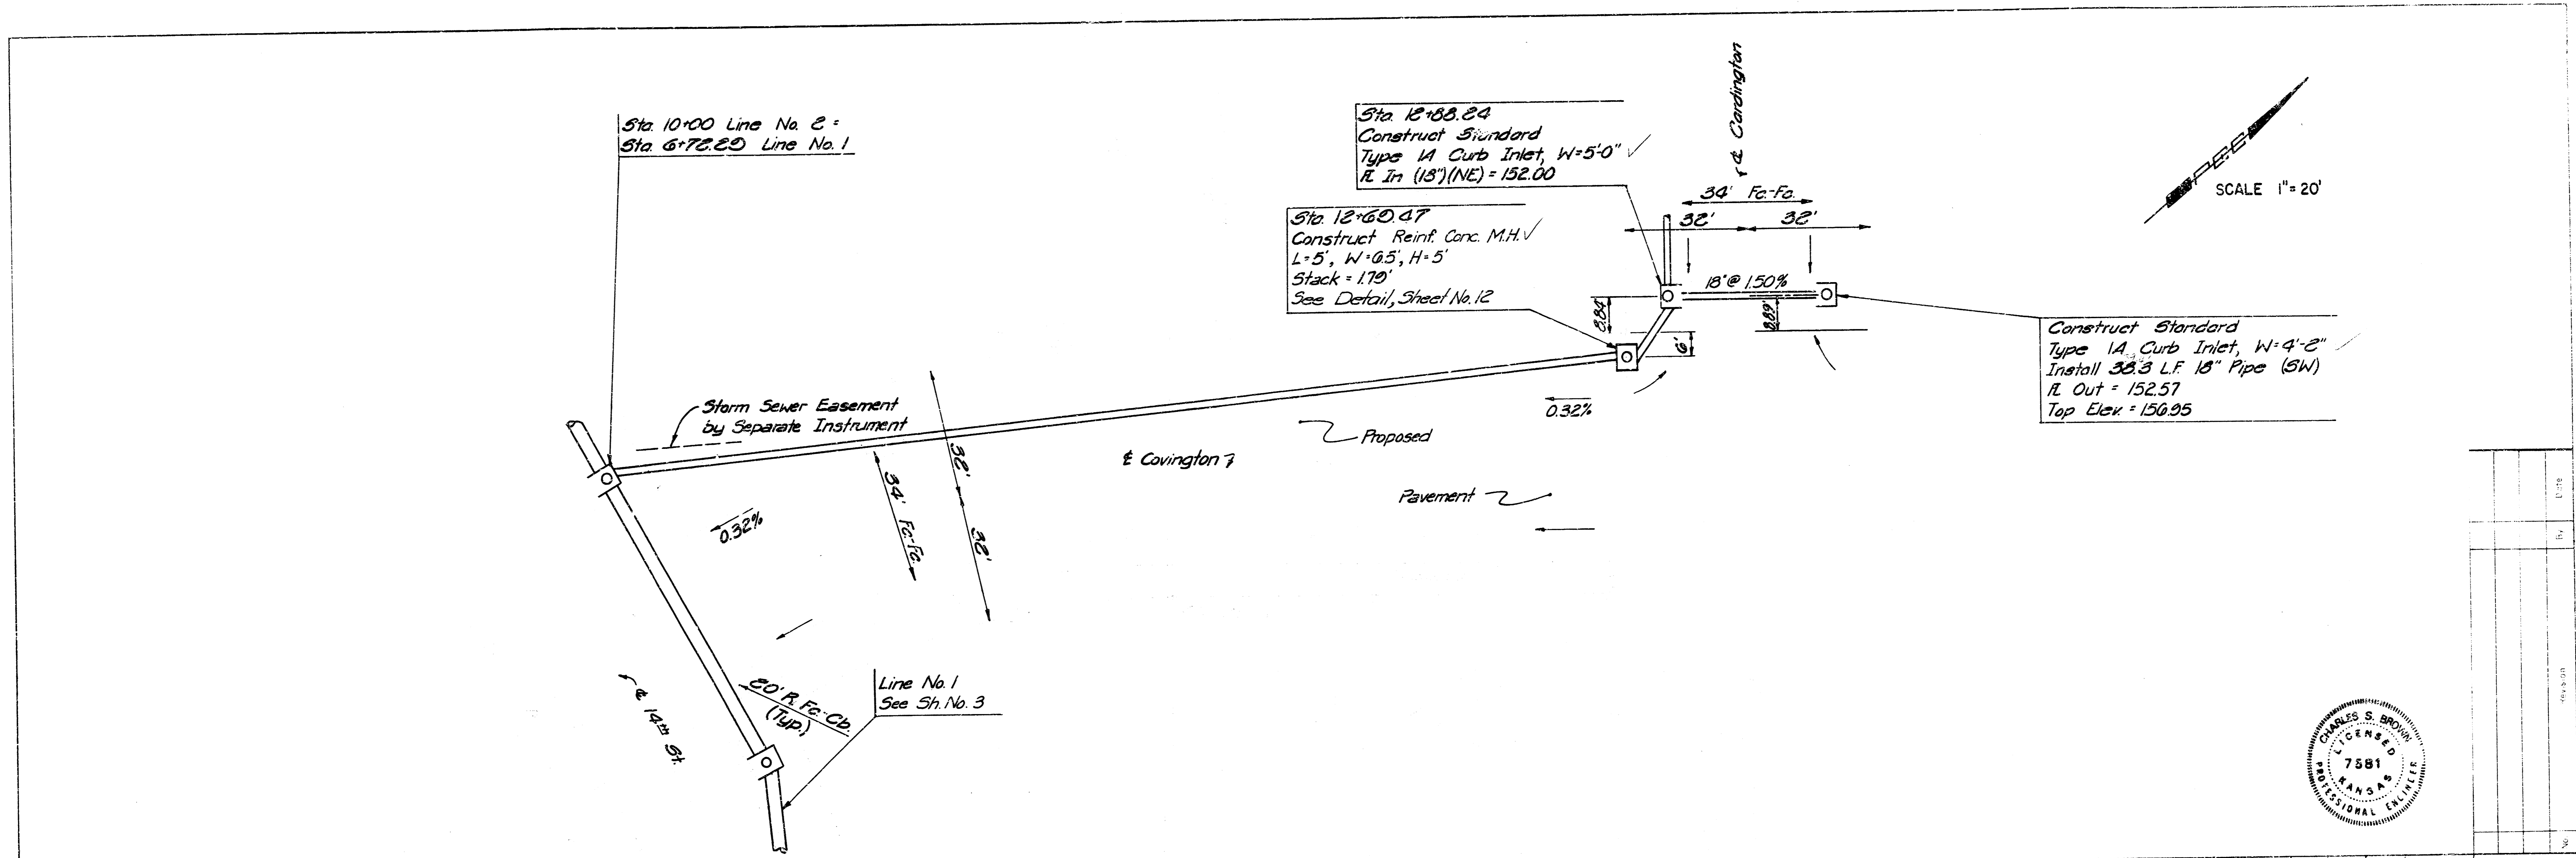

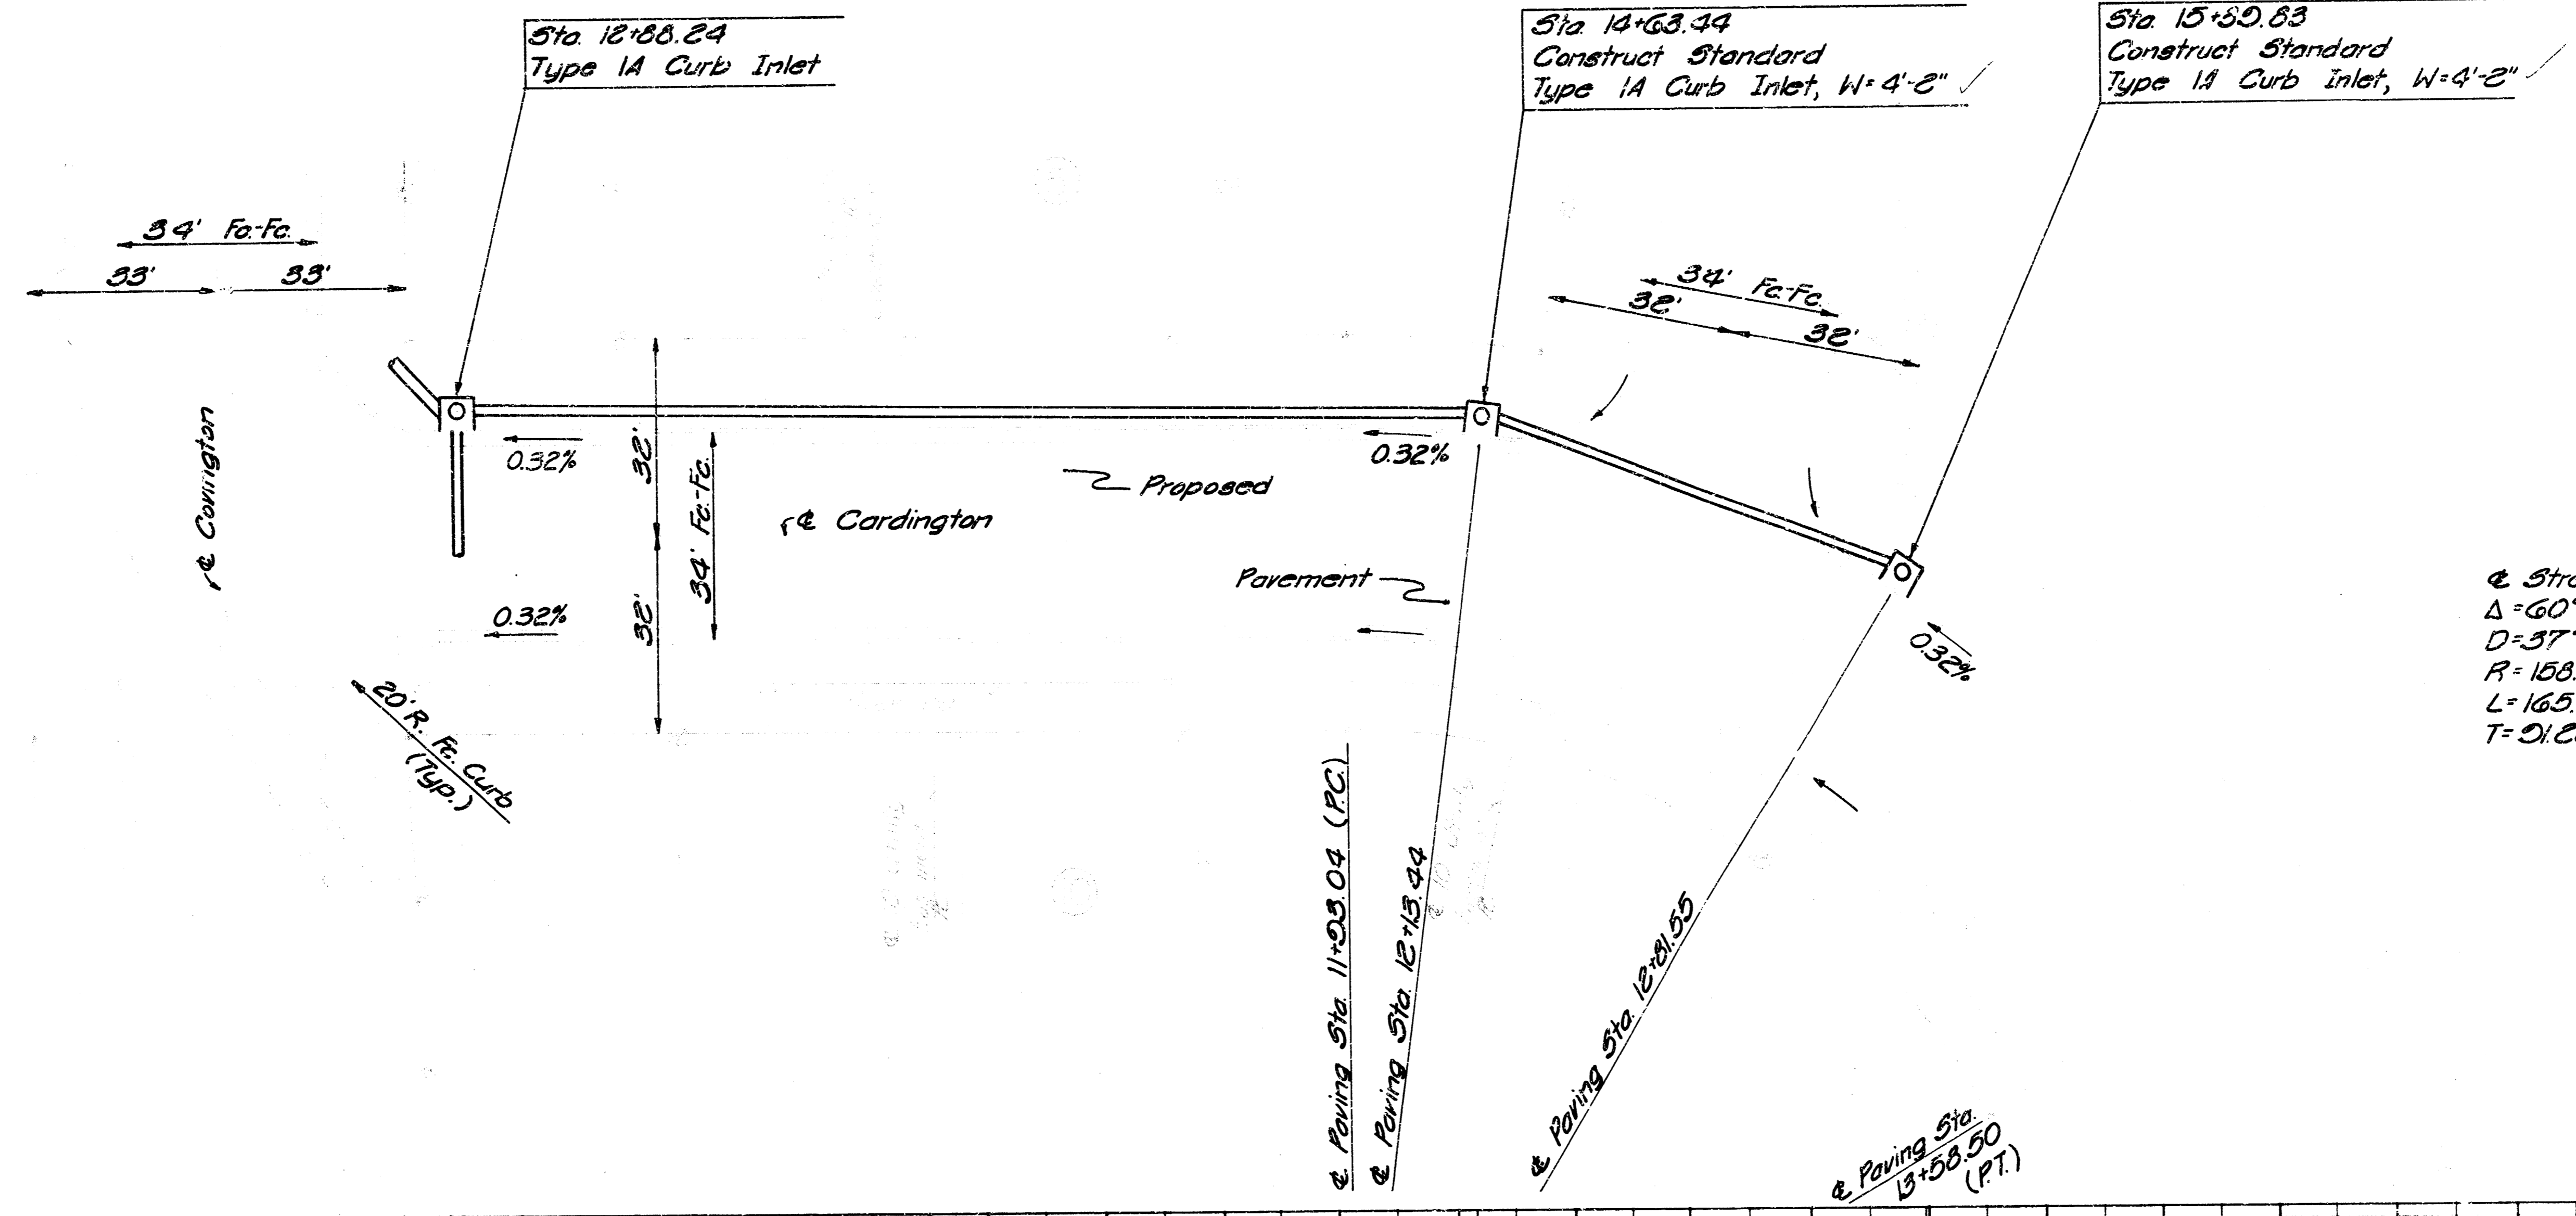

Street Curve Data
 $\Delta = 60^{\circ} 00' 00''$
 $D = 37^{\circ} 58' 20''$
 $R = 158.00'$
 $L = 165.46'$
 $T = 21.22'$

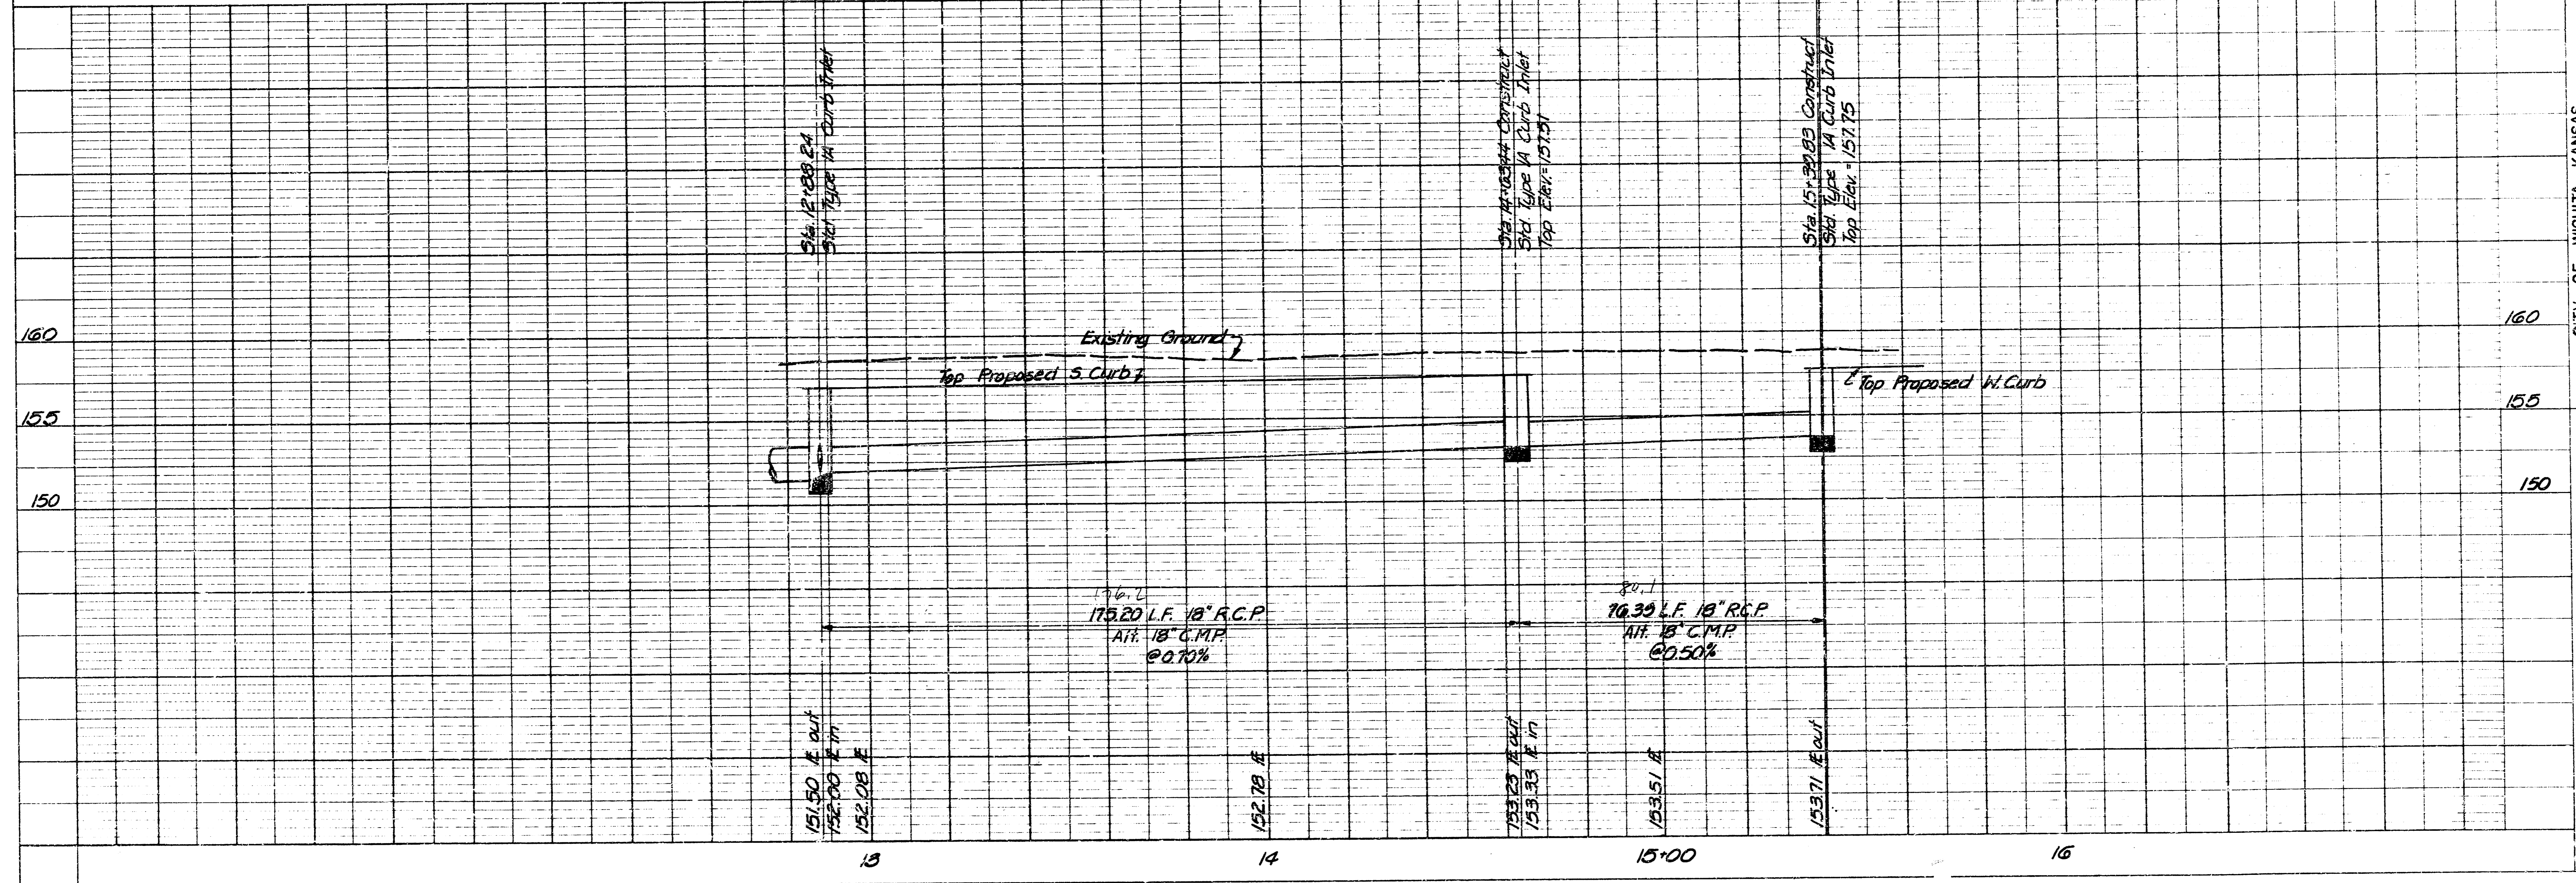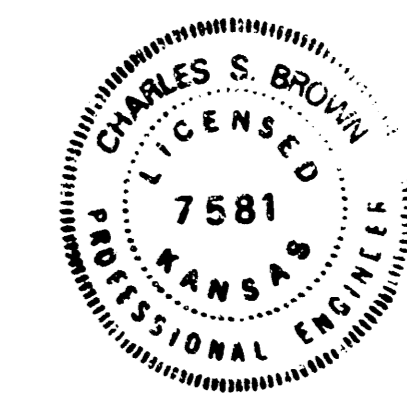


DATE	BY

CITY OF WICHITA, KANSAS
LINE NO. 2
 STA. 12+88.24 TO STA. 15+50.83
 STORM WATER SEWER, NO. 18
 PROJ. NO. 468-76-2-45-33384-0-00-000-001

PROFESSIONAL ENGINEERING CONSULTANTS, P.A.
 WICHITA, KANSAS
 License No. 800292
 Date: Nov, 1980
 Drawn by: DD, CSB
 Checked by: JT, BS, TED

13 of 15

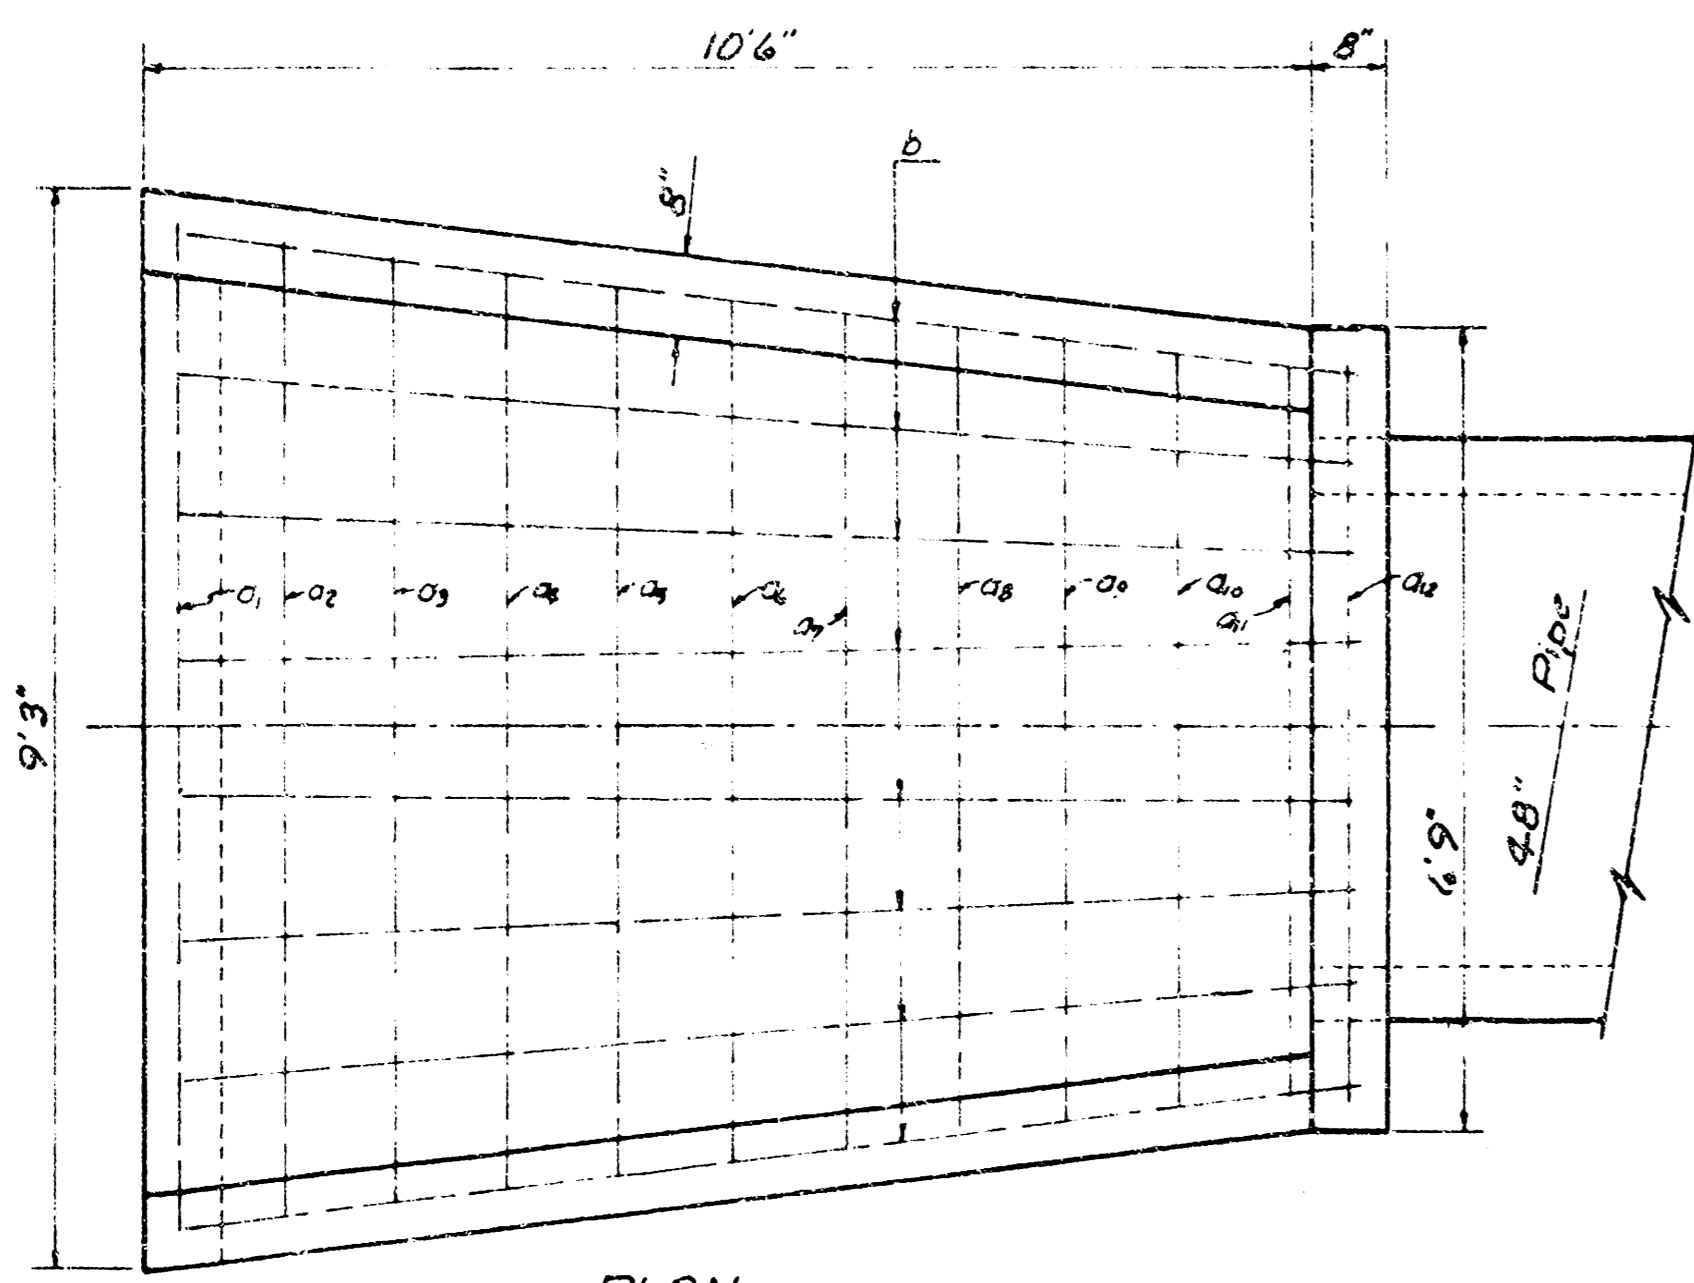


PLAN
Scale: 1/2"=10'


TABLE OF QUANTITIES				
BAR NUMBER	LENGTH	SHAPE	WEIGHT	
a1	10'10"		7.24	
a2	11'3"		7.52	
a3	11'8"		7.79	
a4	12'1"		8.07	
a5	12'6"		8.35	
a6	13'0"		8.64	
a7	13'5"		8.94	
a8	13'10"		9.24	
a9	14'3"		9.52	
a10	14'8"		9.82	
a11	15'2"		10.13	
a12	16'10"		11.24	
b	8		27.23	
c	2		11.36	
d	2		15.36	
e	3		12.91	
f	2		14.36	
g	2		12.02	
h1	4		3.12	
h2	4		1.78	
j	4		8.68	
k	7		11.69	
Rebars (lbs)			243.07	
Concrete (C.Y.)			4.73	

All rebar to be #4

All exposed edges to have 1/8" bevel

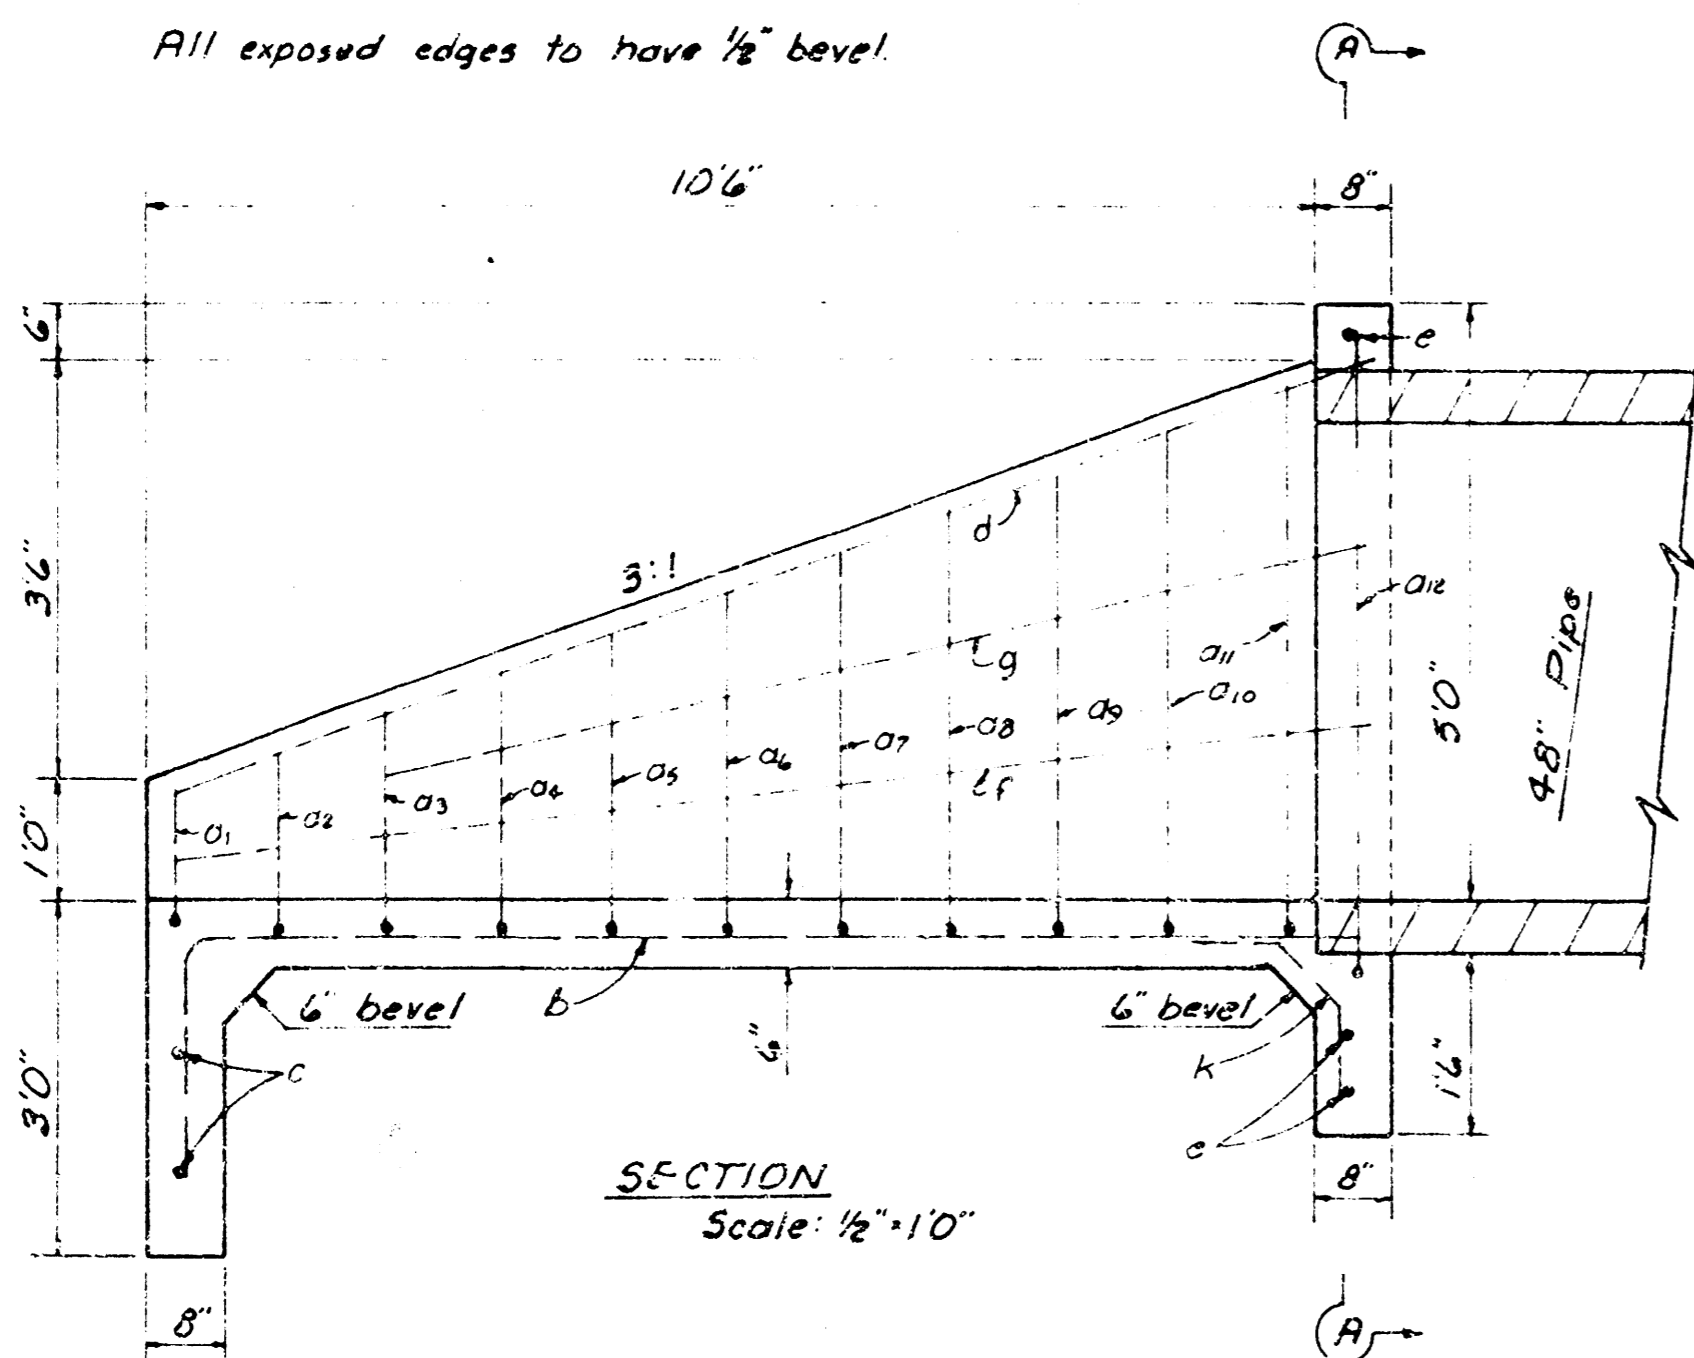

SECTION
Scale: 1/2"=10'

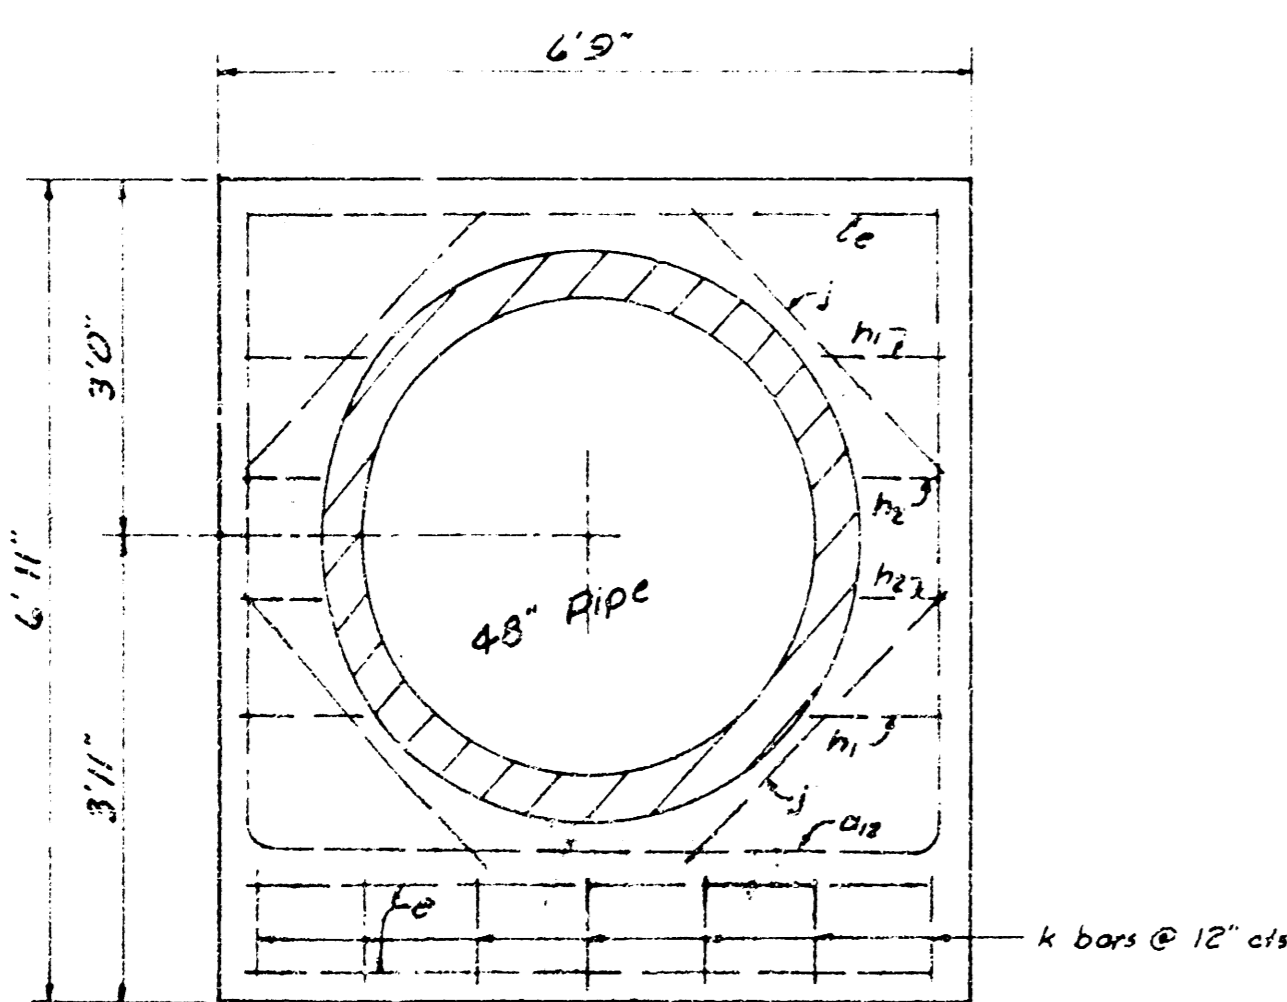


SECTION A-A
Scale: 1/2"=10'


HEADWALL FOR 48" PIPE

a bars	
a1	8'6"
a2	8'3"
a3	8'0"
a4	7'9"
a5	7'6"
a6	7'4"
a7	7'1"
a8	6'10"
a9	6'7"
a10	6'4"
a11	6'2"
a12	6'2"

b bars	
b	10'7"

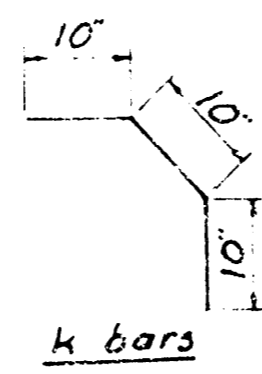


k bars

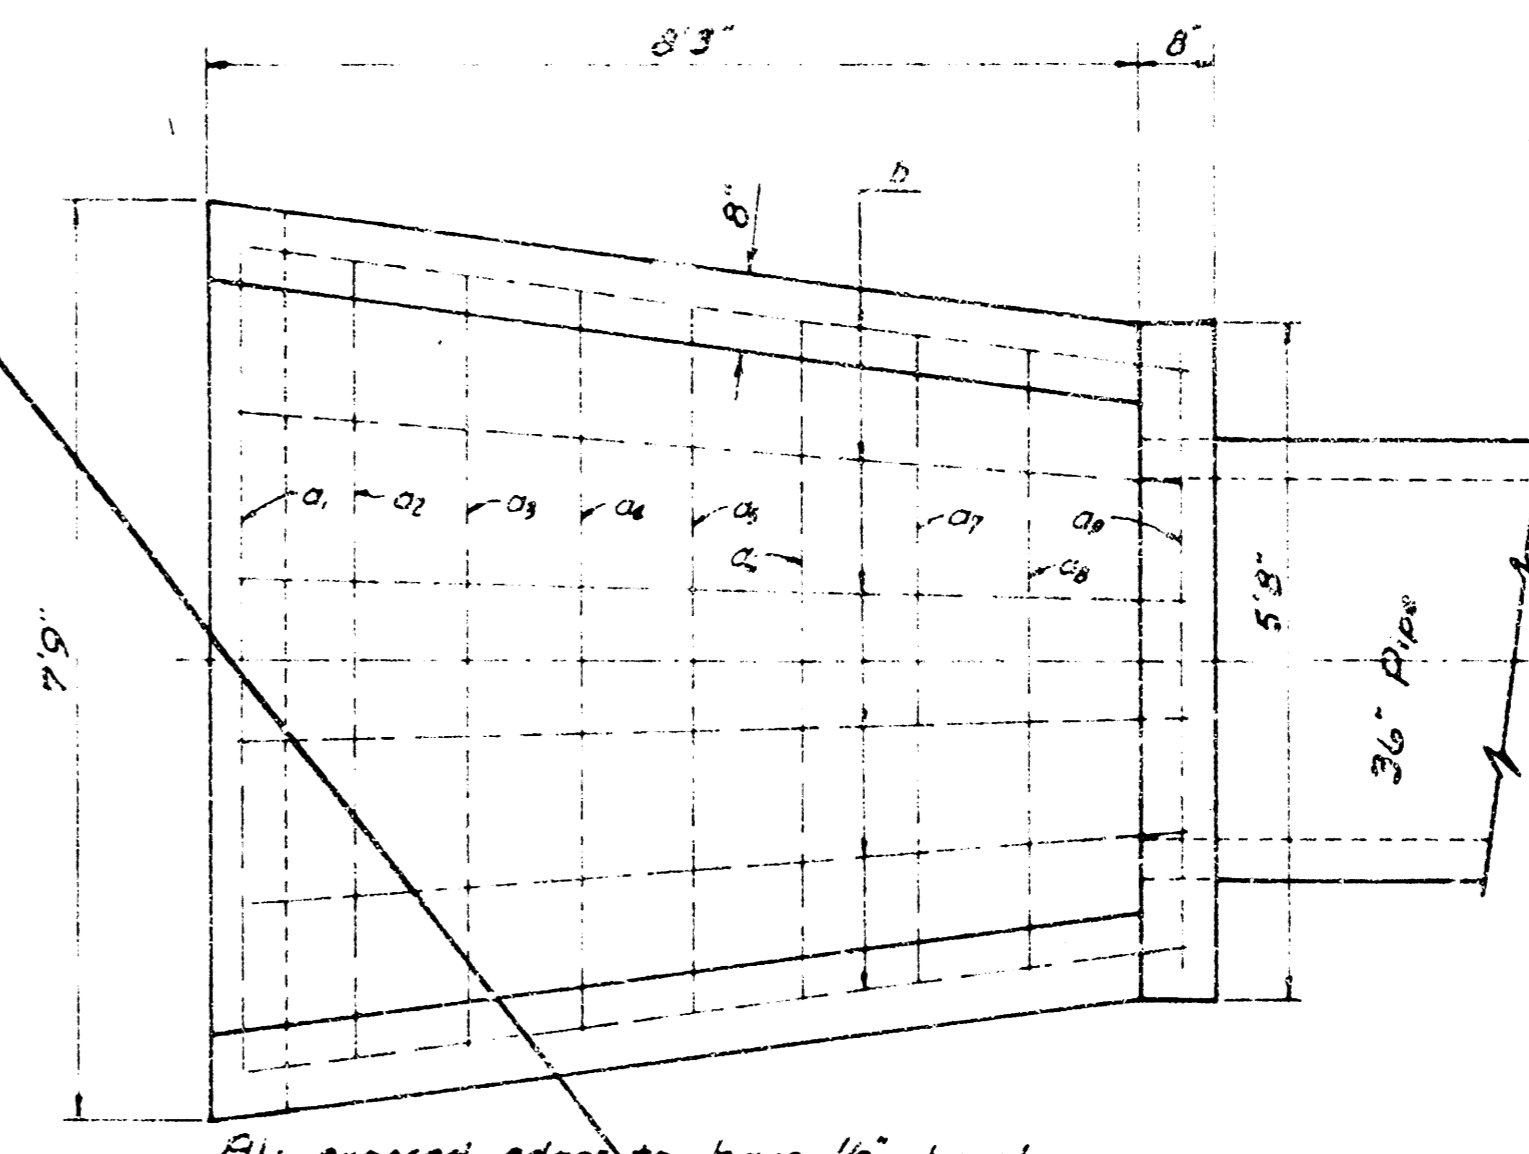


PLAN
Scale: 1/2"=10'

All exposed edges to have 1/8" bevel

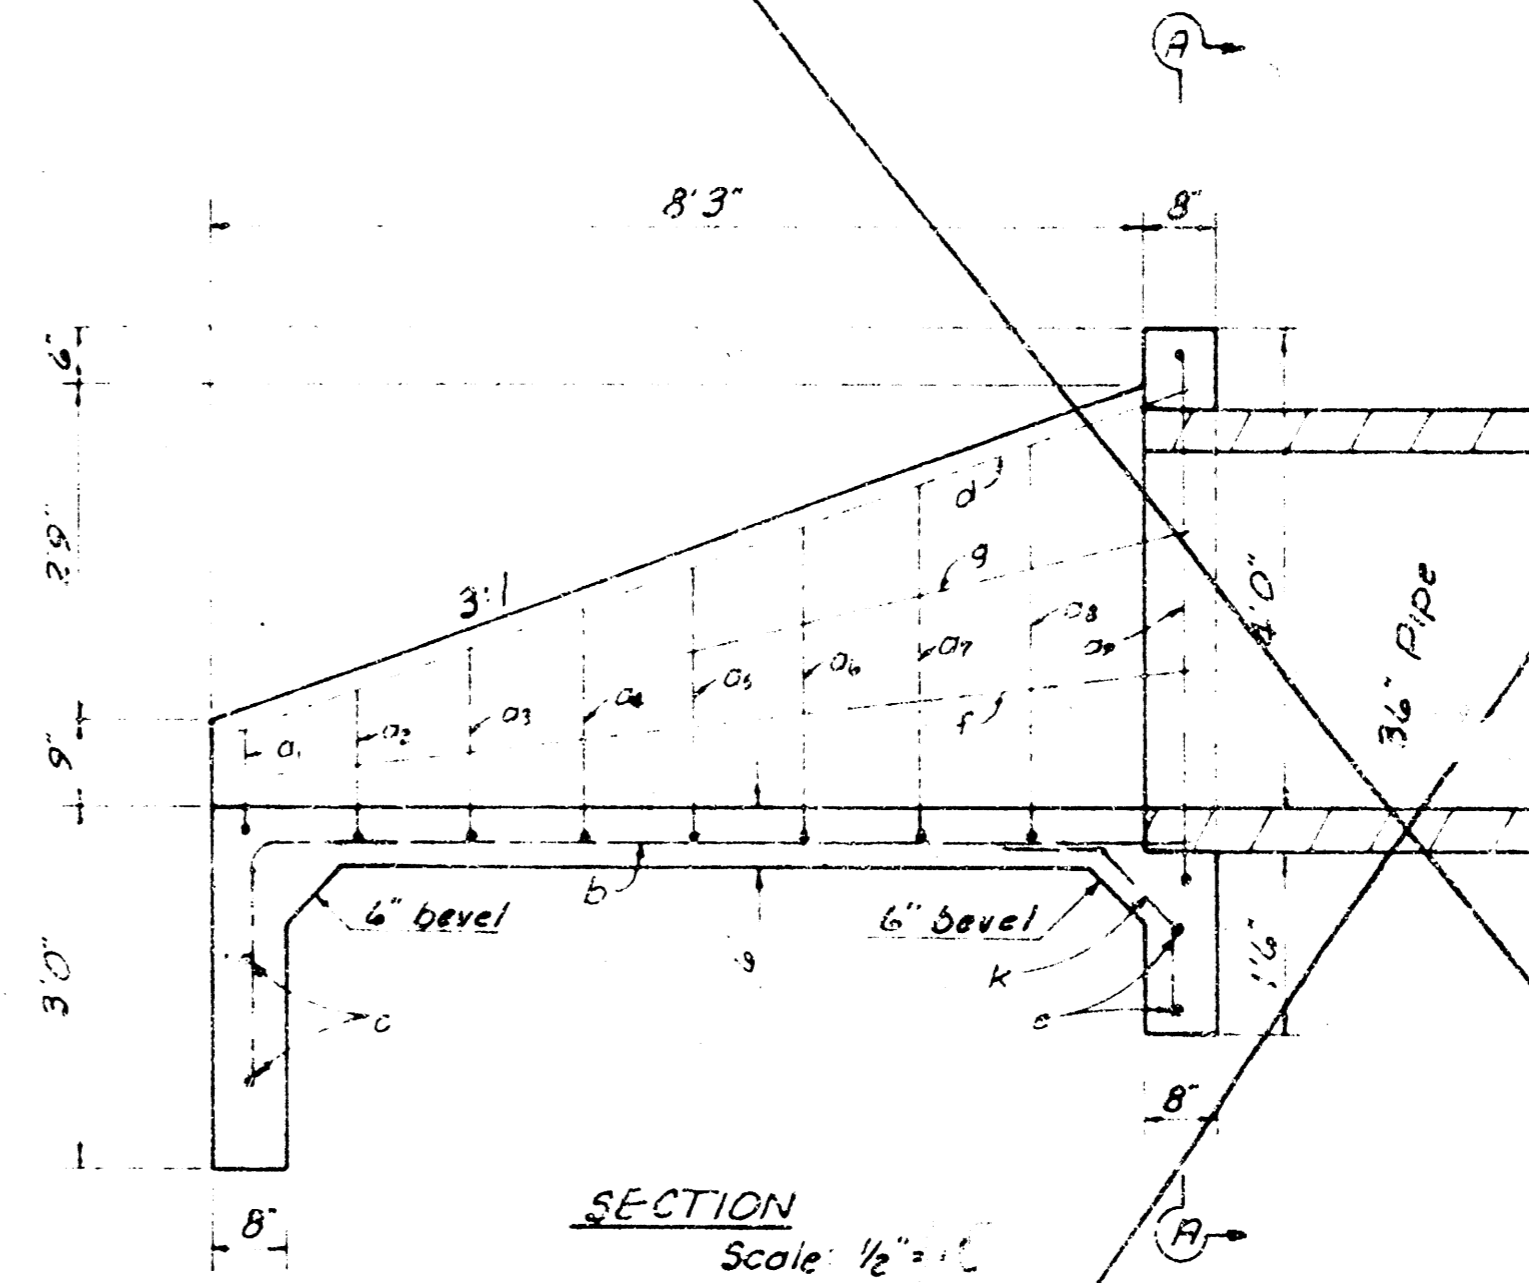

SECTION
Scale: 1/2"=10'

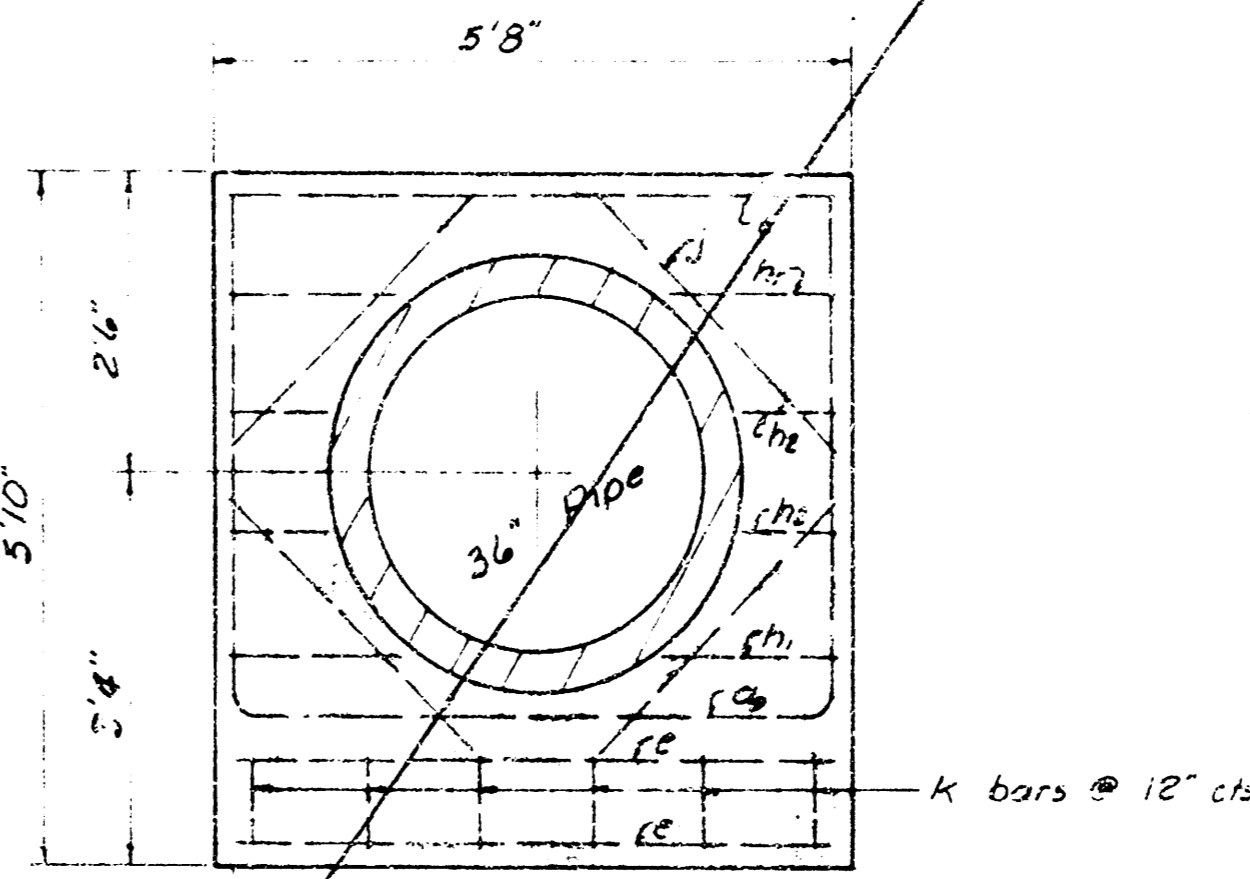

SECTION A-A
Scale: 1/2"=10'


HEADWALL FOR 36" PIPE

TABLE OF QUANTITIES				
BAR NUMBER	LENGTH	SHAPE	WEIGHT	
a1	8'7"		6.73	
a2	9'0"		6.91	
a3	9'7"		7.40	
a4	10'0"		7.68	
a5	10'5"		7.96	
a6	10'10"		8.24	
a7	11'3"		8.52	
a8	11'10"		8.80	
a9	12'0"		9.08	
a10	12'5"		9.36	
a11	13'0"		9.64	
a12	13'5"		9.92	
a13	14'0"		10.20	
a14	14'5"		10.48	
b	6		17.52	
c	2		8.76	
d	2		12.02	
e	3		10.44	
f	2		11.80	
g	2		10.12	
h1	4		3.04	
h2	4		1.68	
j	4		8.08	
k	6		10.02	
Total Rebars, lbs			178.57	
Conc. C.Y.			3.20	


All rebar to be #4

a bars	
a1	6'11"
a2	6'8"
a3	6'5"
a4	6'2"
a5	5'11"
a6	5'8"
a7	5'5"
a8	5'2"
a9	5'2"

b bars	
b	8'4"

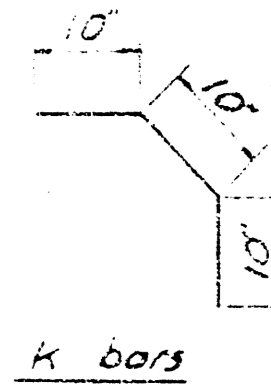

k bars

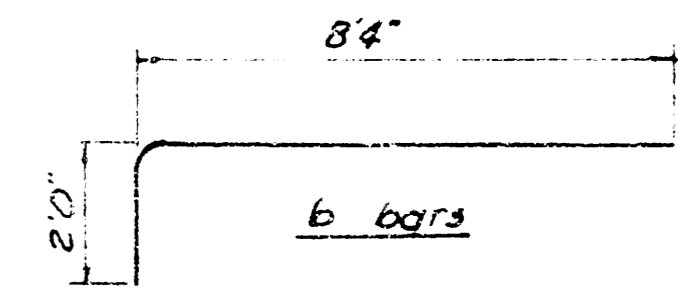


b bars

DETAIL CONCRETE HEADWALL

CITY OF WICHITA, KANSAS

STORM WATER SEWER NO. 173


PROJ. NO. 468-76-245-80884-000-000-001

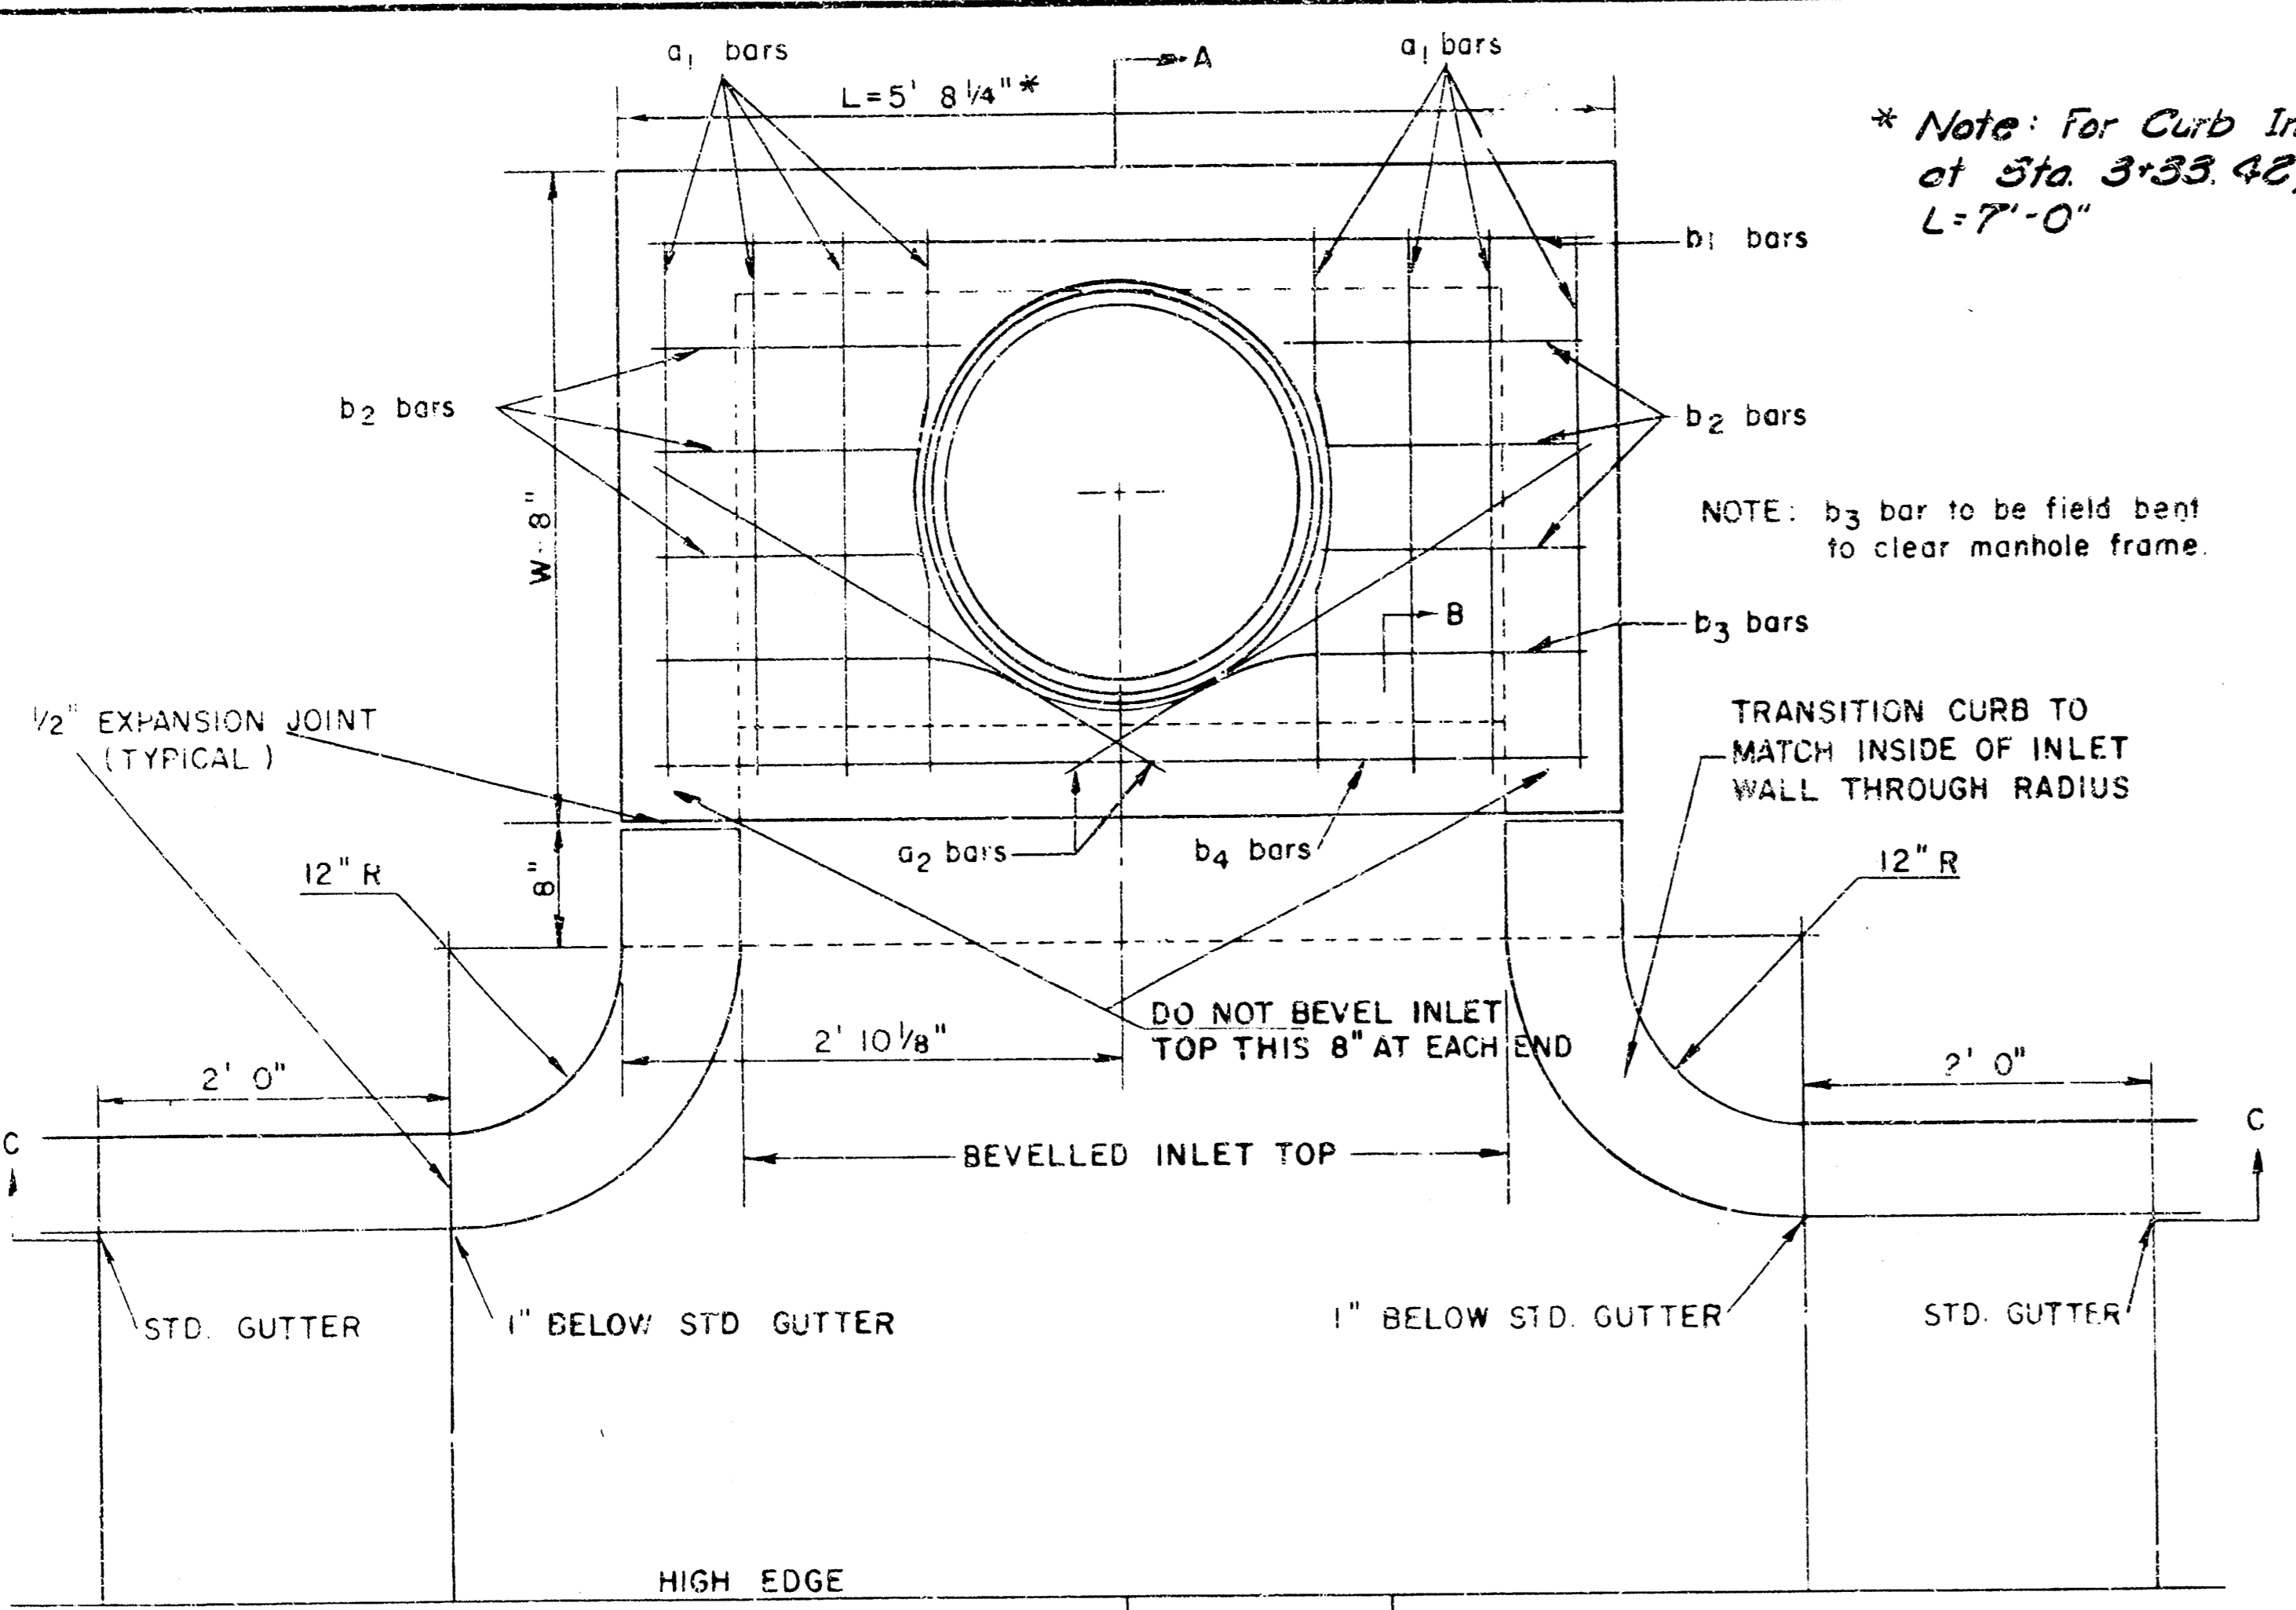

* Note: For Curb Inlet at Sta. 3+33.42, Line No. 1 L=7'-0"

NOTE: b₃ bar to be field bent to clear manhole frame.

TRANSITION CURB TO MATCH INSIDE OF INLET WALL THROUGH RADIUS

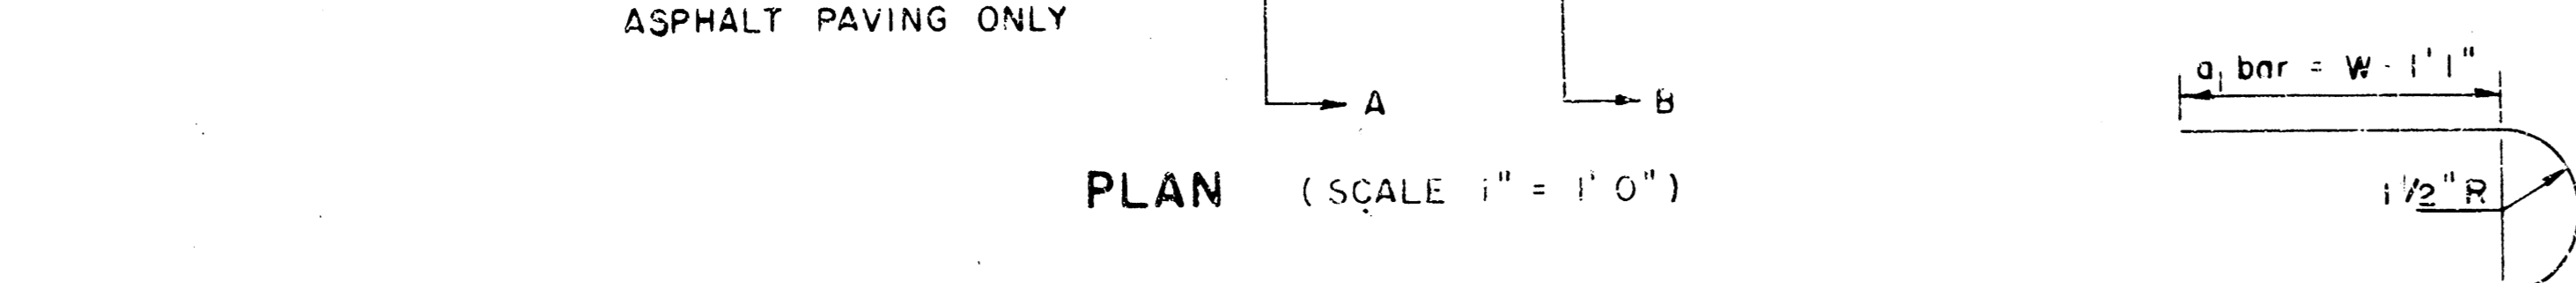

STEEL SCHEDULE


BAR NUMBER	a ₁	a ₂	b ₁				b ₂	b ₃	b ₄	WT. LBS.
SIZE	"4	"4	"4	"4	"4	"4	"4	"4	"6	
W=4'2"	6'5"	5'4"	5'5"	-	-	-	1'5"	5'6"	5'5"	60"
W=5'0"	8'1"	4'4"	5'5"	-	-	-	1'5"	5'6"	5'5"	77"
W=5'0"	10'1"	5'4"	5'5"	-	-	-	1'5"	5'6"	5'5"	97"
W=7'0"	11'1"	6'4"	-	-	5'5"	-	1'5"	5'6"	5'5"	111"
W=8'0"	12'1"	7'4"	-	-	5'5"	1'5"	5'6"	5'5"	124"	

* NOTE: a₂ BARS TO BE PLACED APPROX. 2" BELOW TOP OF INLET COVER


STANDARD CURB INLET PRECAST TOPS

W	PRE-CAST TOP SIZE	PIPE SIZE	CU. YD. CONC.
4' 2"	36" x 5'8 1/4" x 7 1/2"	21" B SMALLER	0.46 *
5' 0"	44" x 5'8 1/4" x 7 1/2"	24" B 30"	0.57 *
6' 0"	54" x 5'8 1/4" x 7 1/2"	36" B 42"	0.71 *
7' 0"	64" x 5'8 1/4" x 7 1/2"	48" B 54"	0.84 *
8' 0"	74" x 5'8 1/4" x 7 1/2"	60" B 66"	0.97 *


* GROSS VOLUME

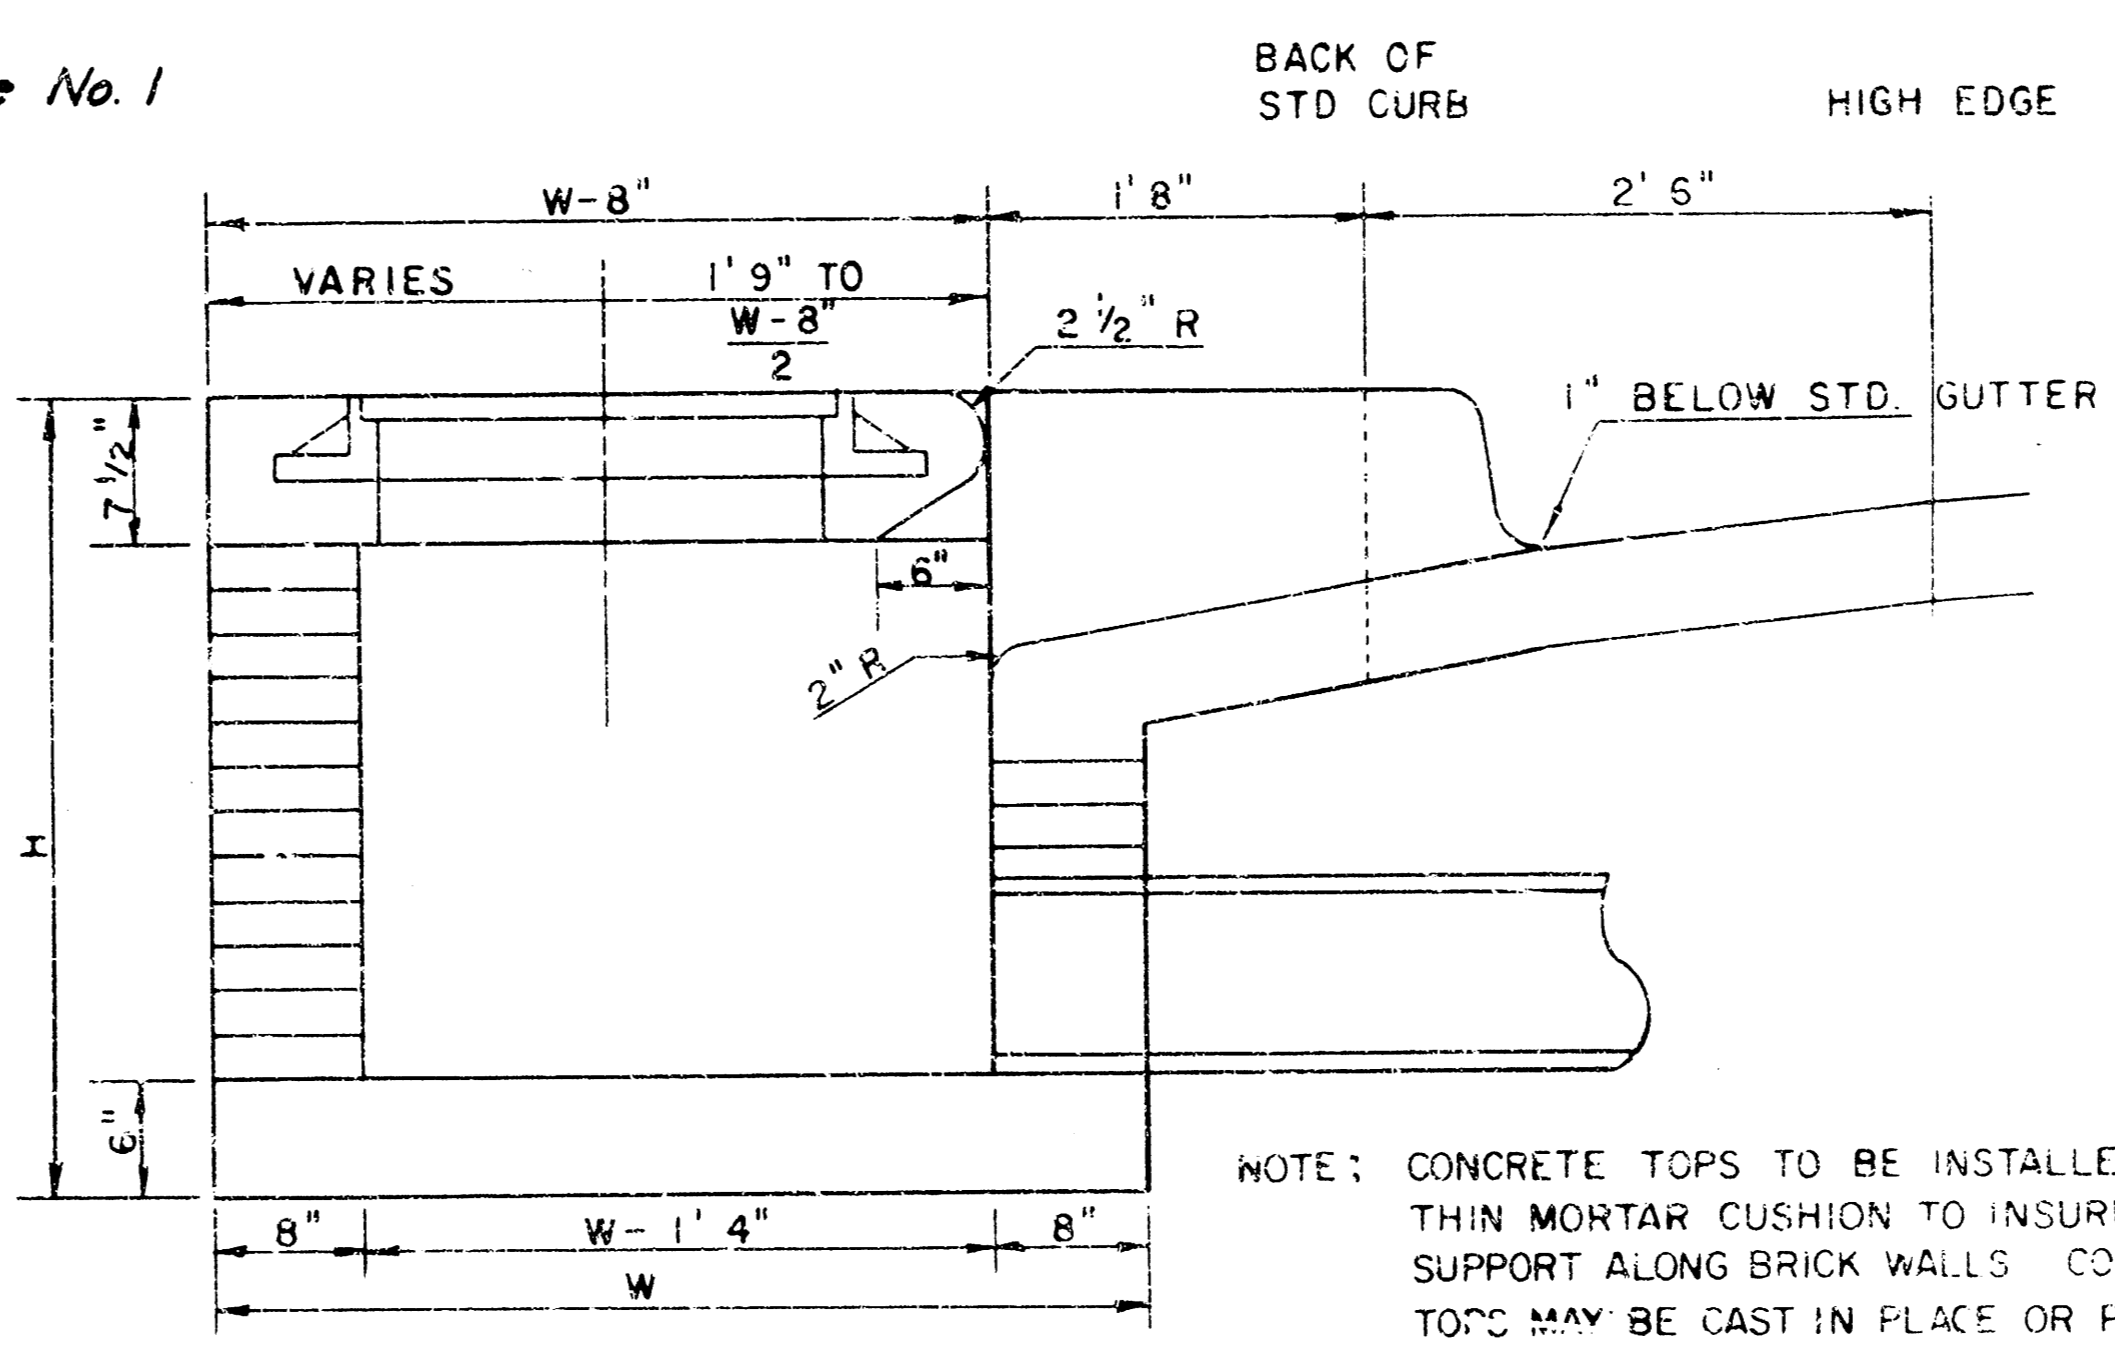



NOTE: CONCRETE TOPS TO BE INSTALLED ON THIN MORTAR CUSHION TO INSURE FULL SUPPORT ALONG BRICK WALLS. CONCRETE TOPS MAY BE CAST IN PLACE OR PRECAST CONCRETE FOR INLET TOPS AND FLOORS SHALL BE 6-SACK PAVING MIX.

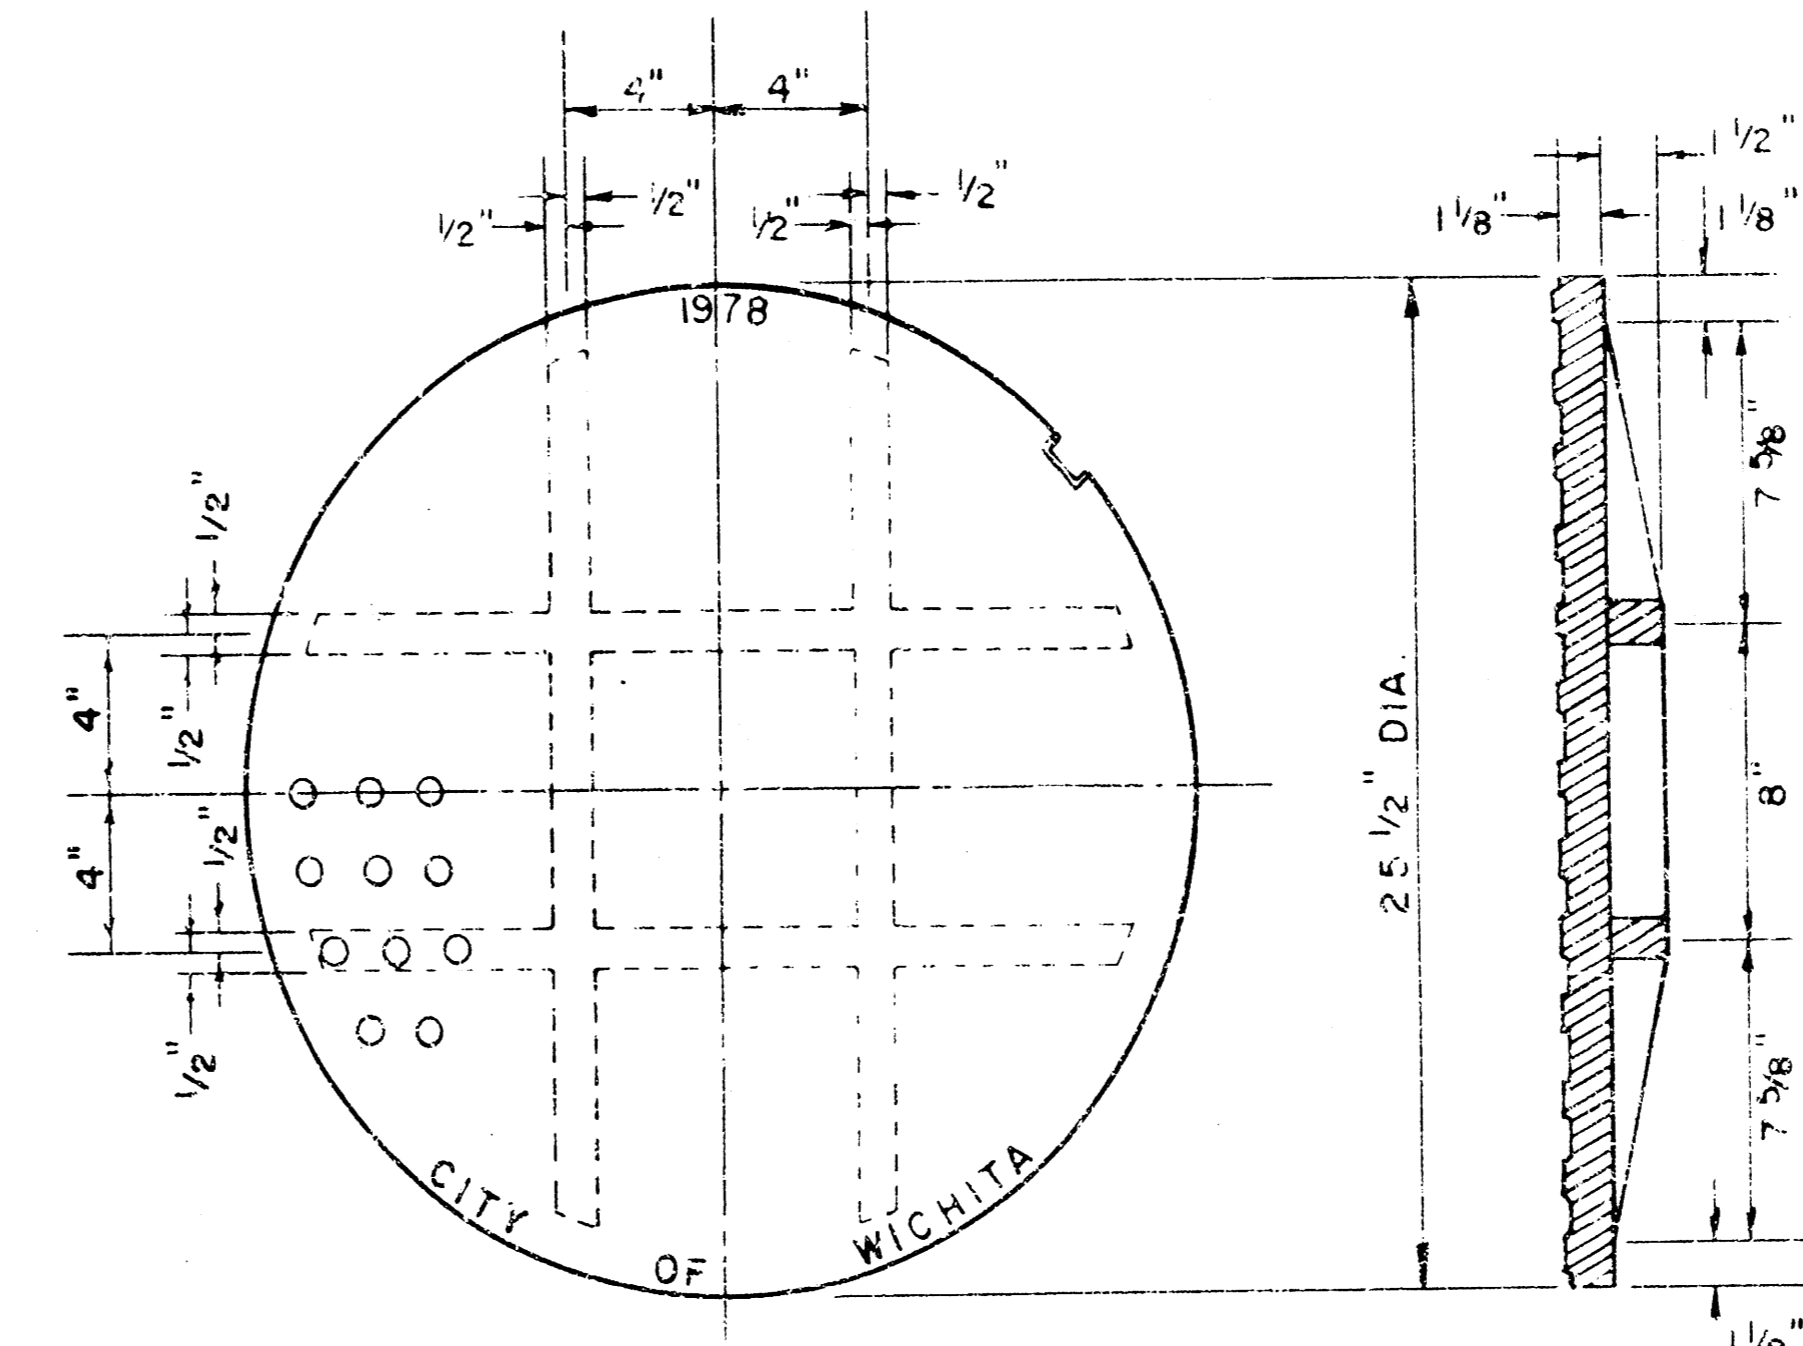


WEIGHT = 170 LBS.

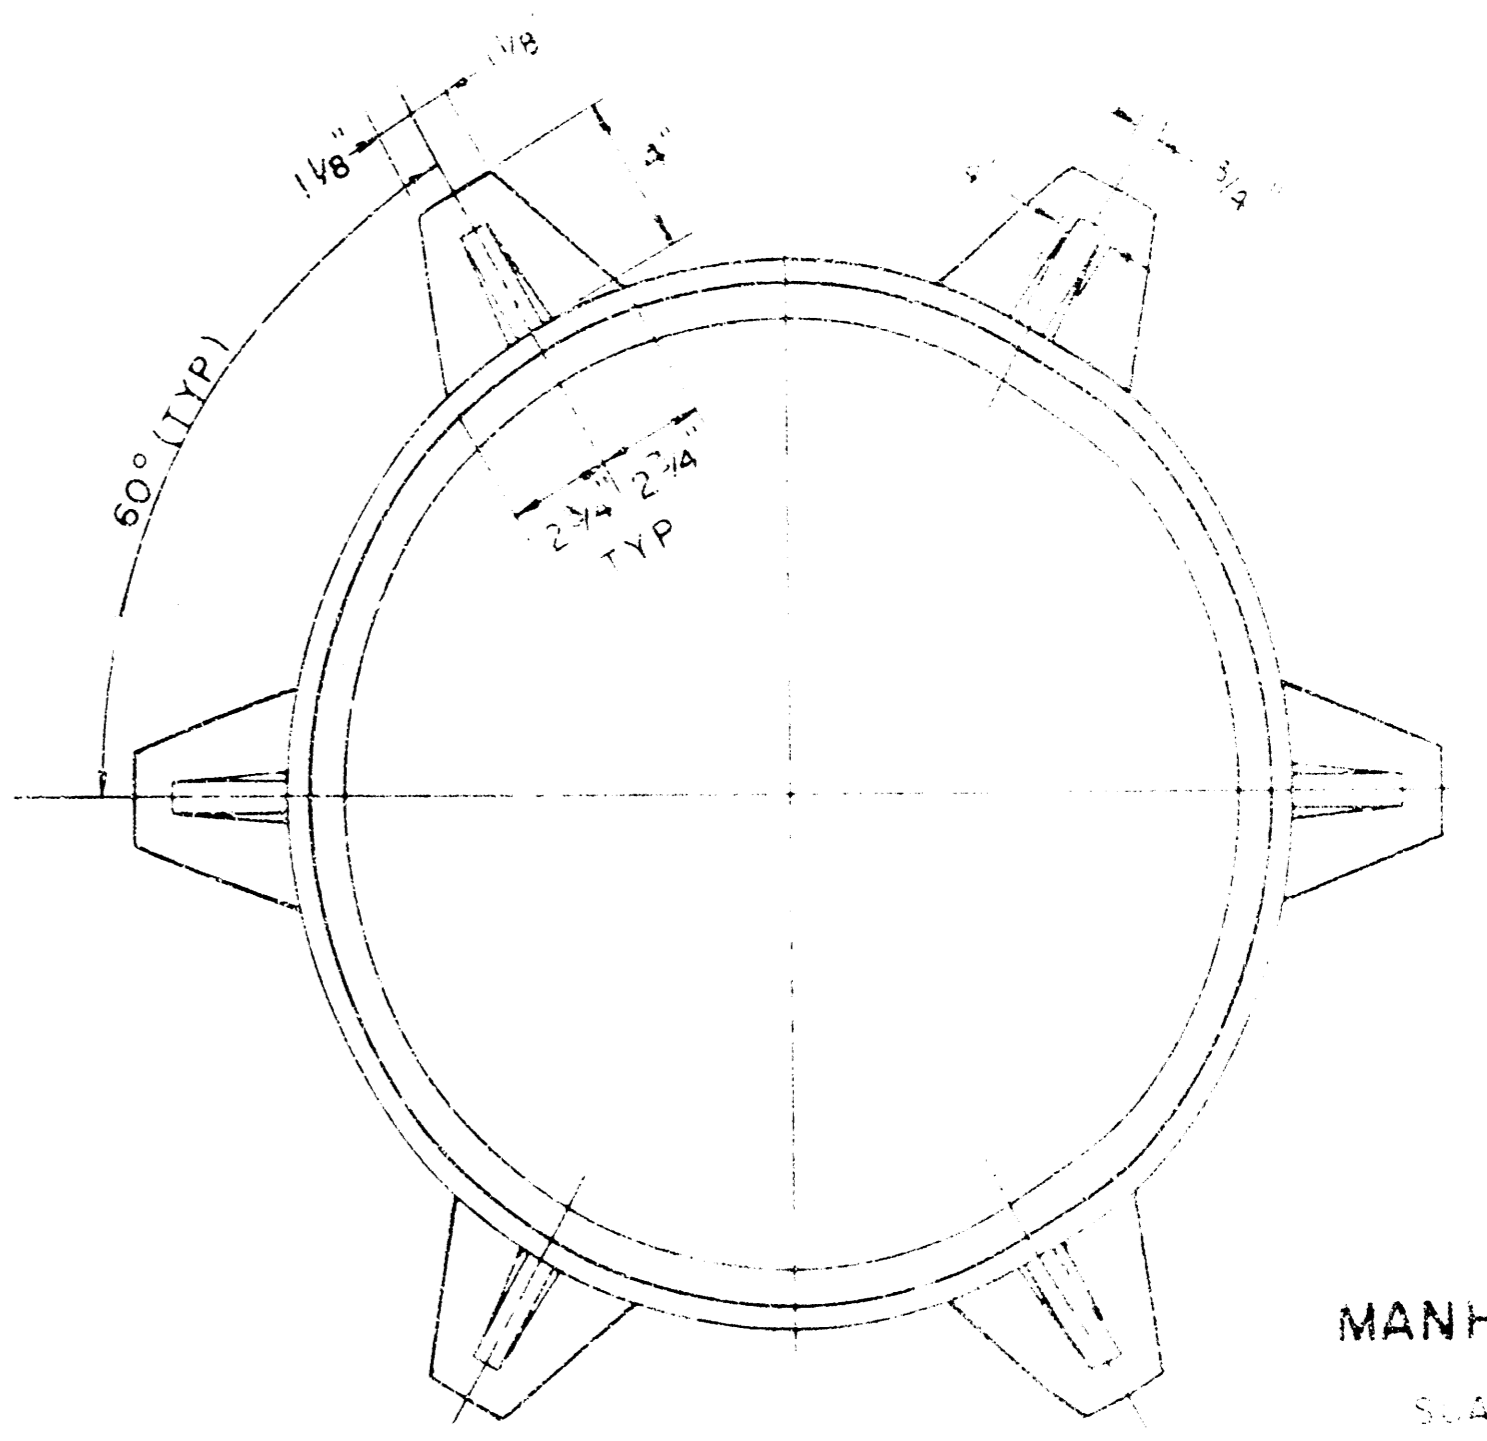


WEIGHT = 180 LBS.

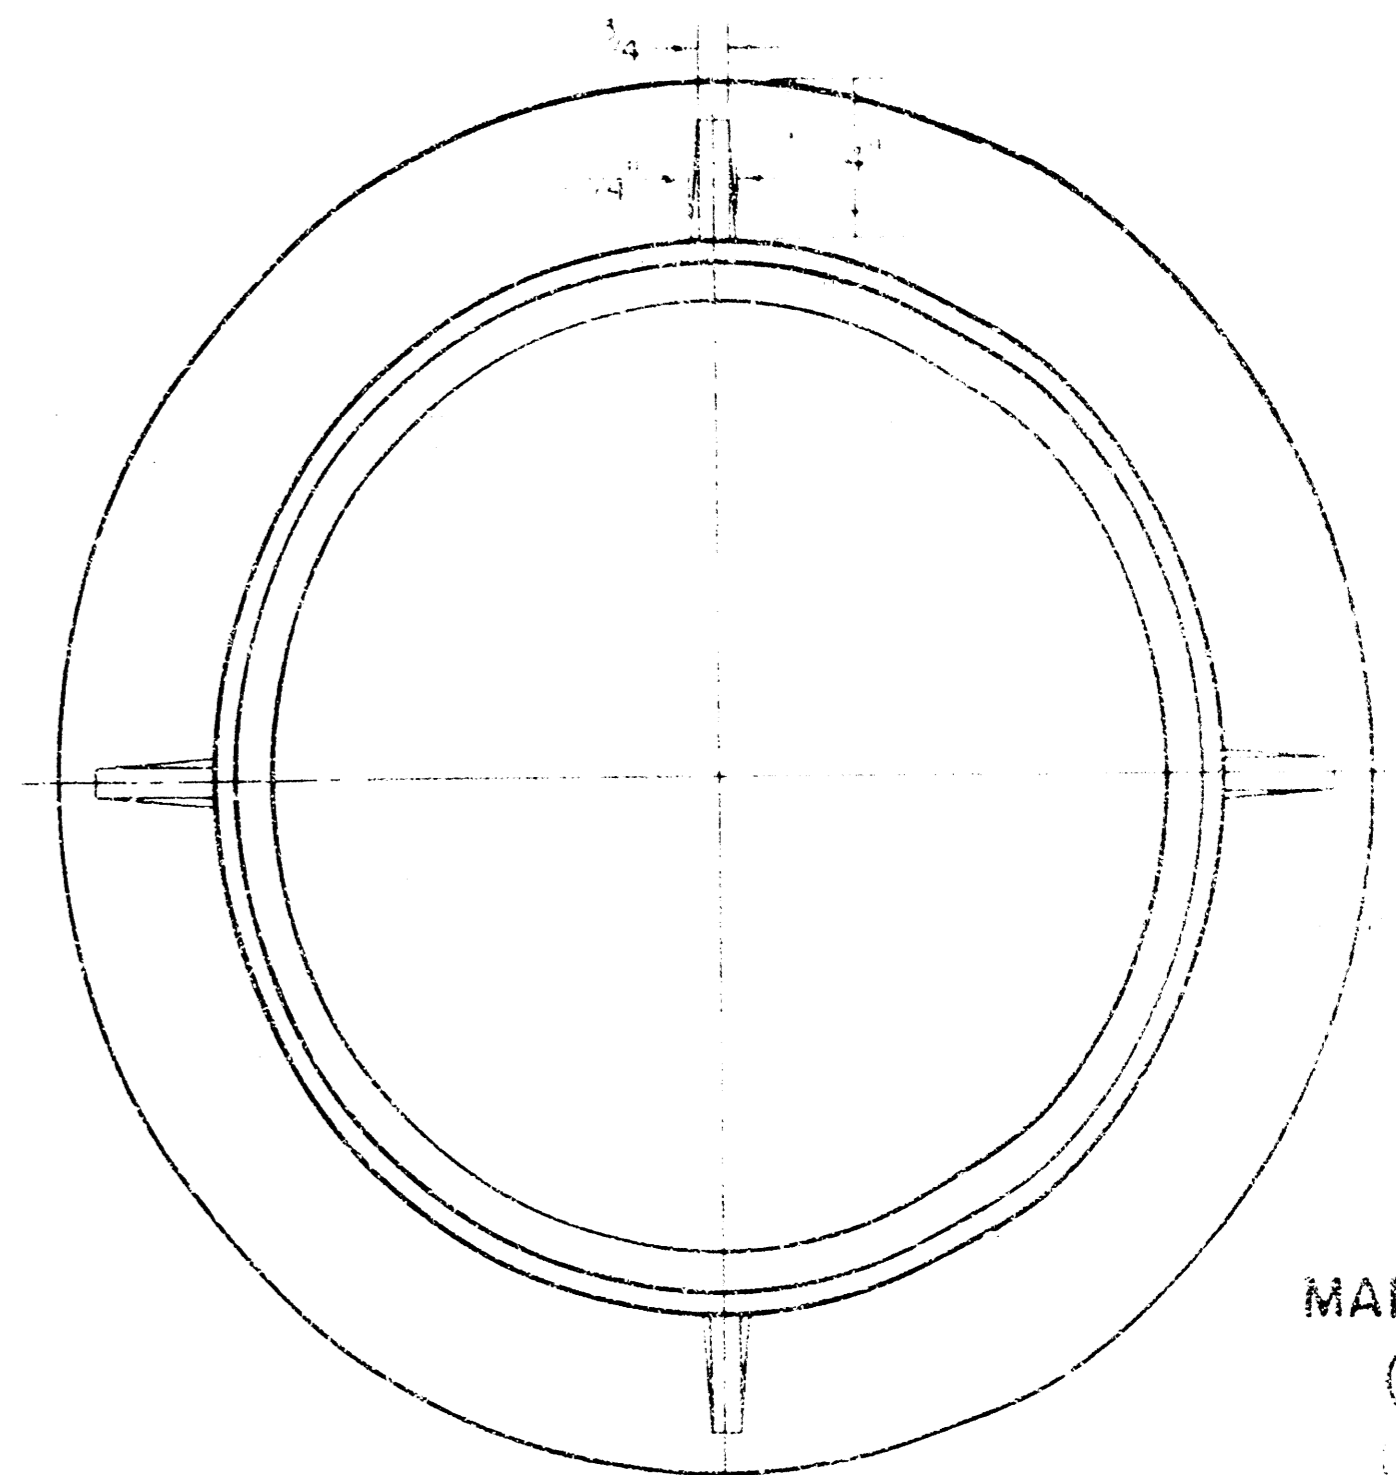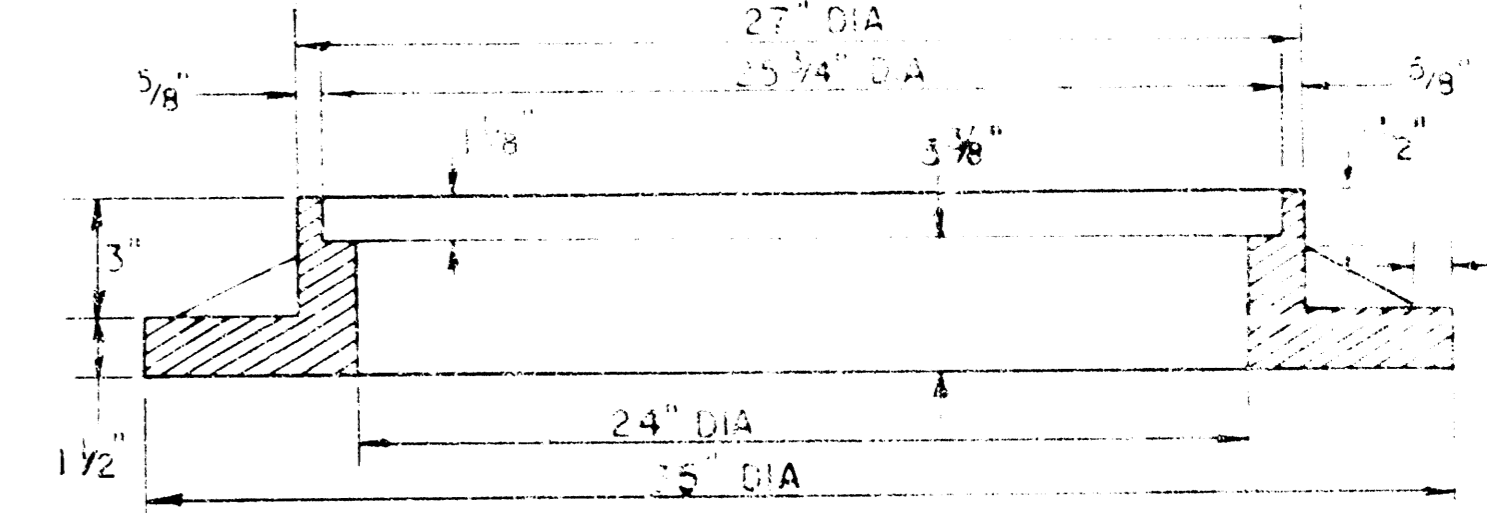

WEIGHT = 180 LBS.

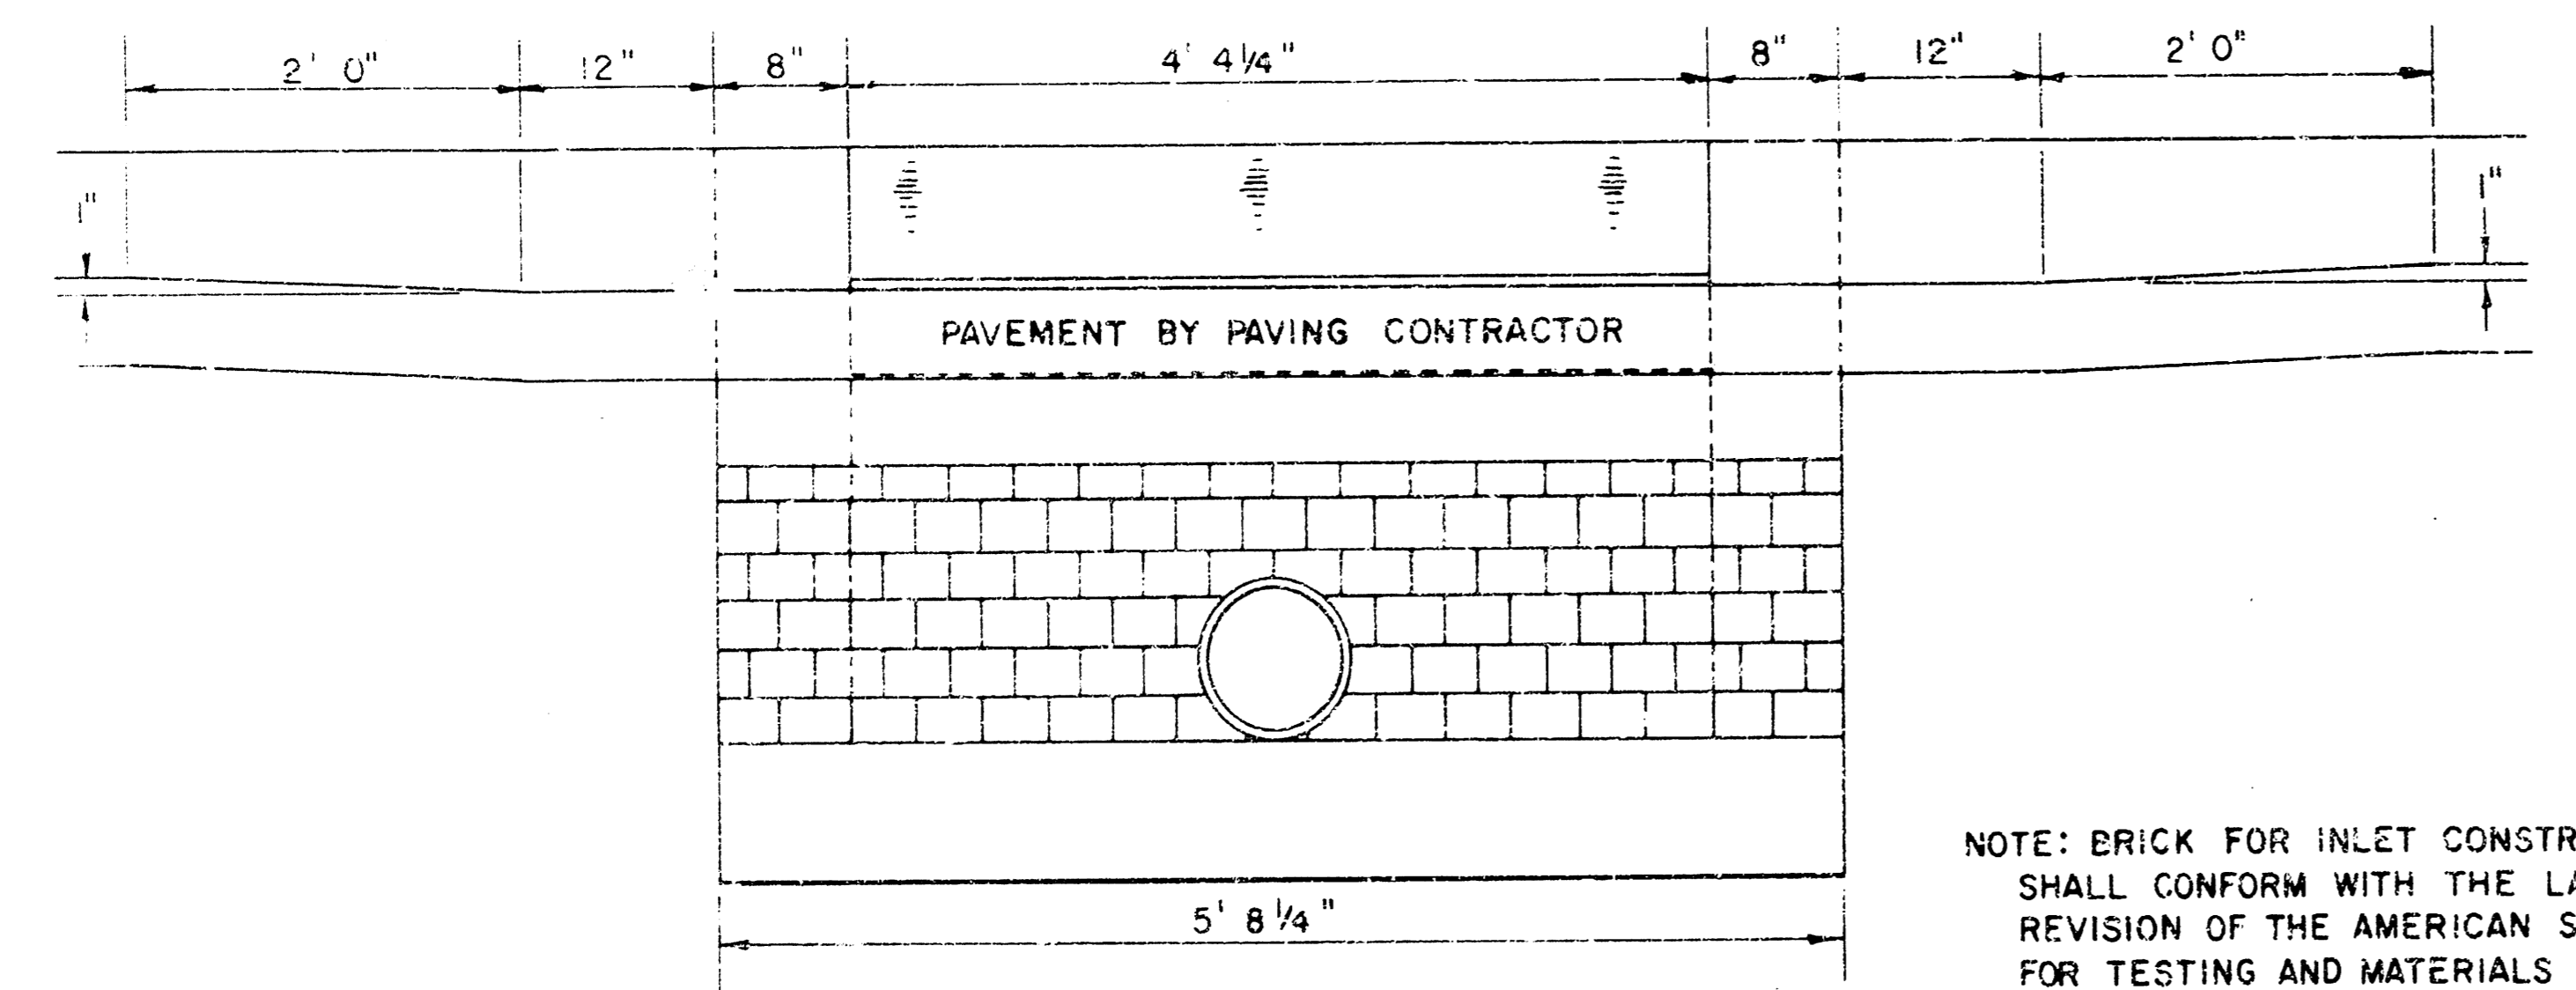


NOTE: BRICK FOR INLET CONSTRUCTION SHALL CONFORM WITH THE LATEST REVISION OF THE AMERICAN SOCIETY FOR TESTING AND MATERIALS DESIGNATION C-32 FOR MANHOLE BRICK GRADE MS.

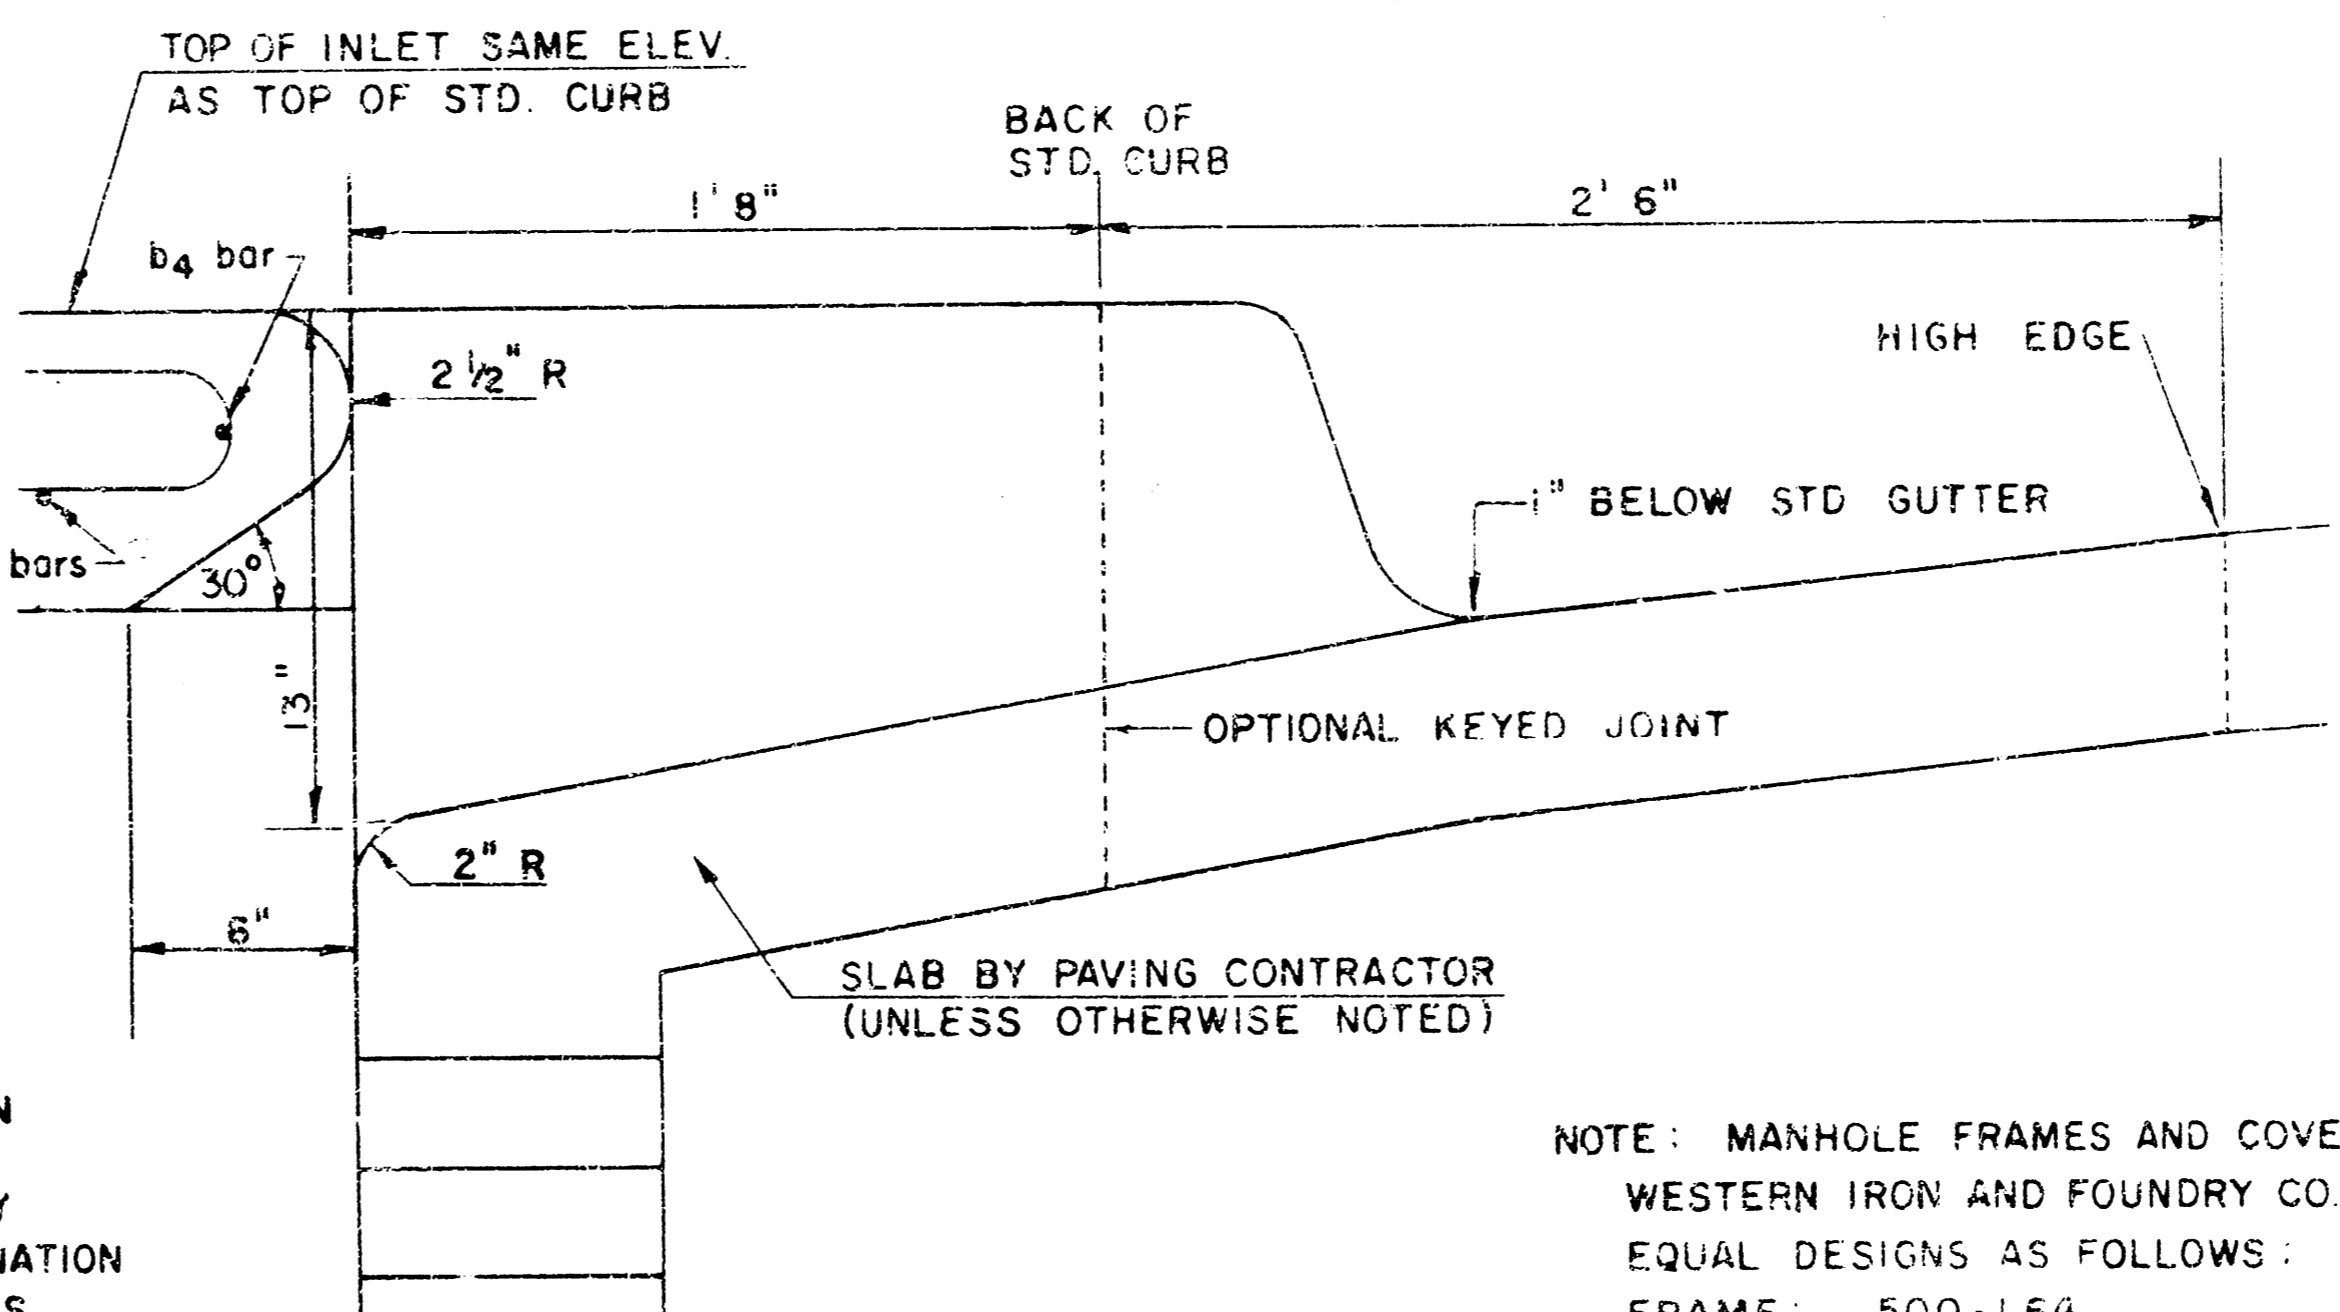


NOTE: MANHOLE FRAMES AND COVER ARE WESTERN IRON AND FOUNDRY CO. INC. OR EQUAL DESIGNS AS FOLLOWS: FRAME: 500-L64 FRAME (ALTERNATE): 500-A4 COVER: 222 S4 "MOBBY"


DETAIL STANDARD TYPE IA CURB INLET
CITY OF WICHITA, KANSAS
DEAN S. SELLERS— CITY ENGINEER
OCTOBER 1978
STORM WATER SEWER NO. 173 PROJ. NO. 468-76-245-80884-C60-C60-00

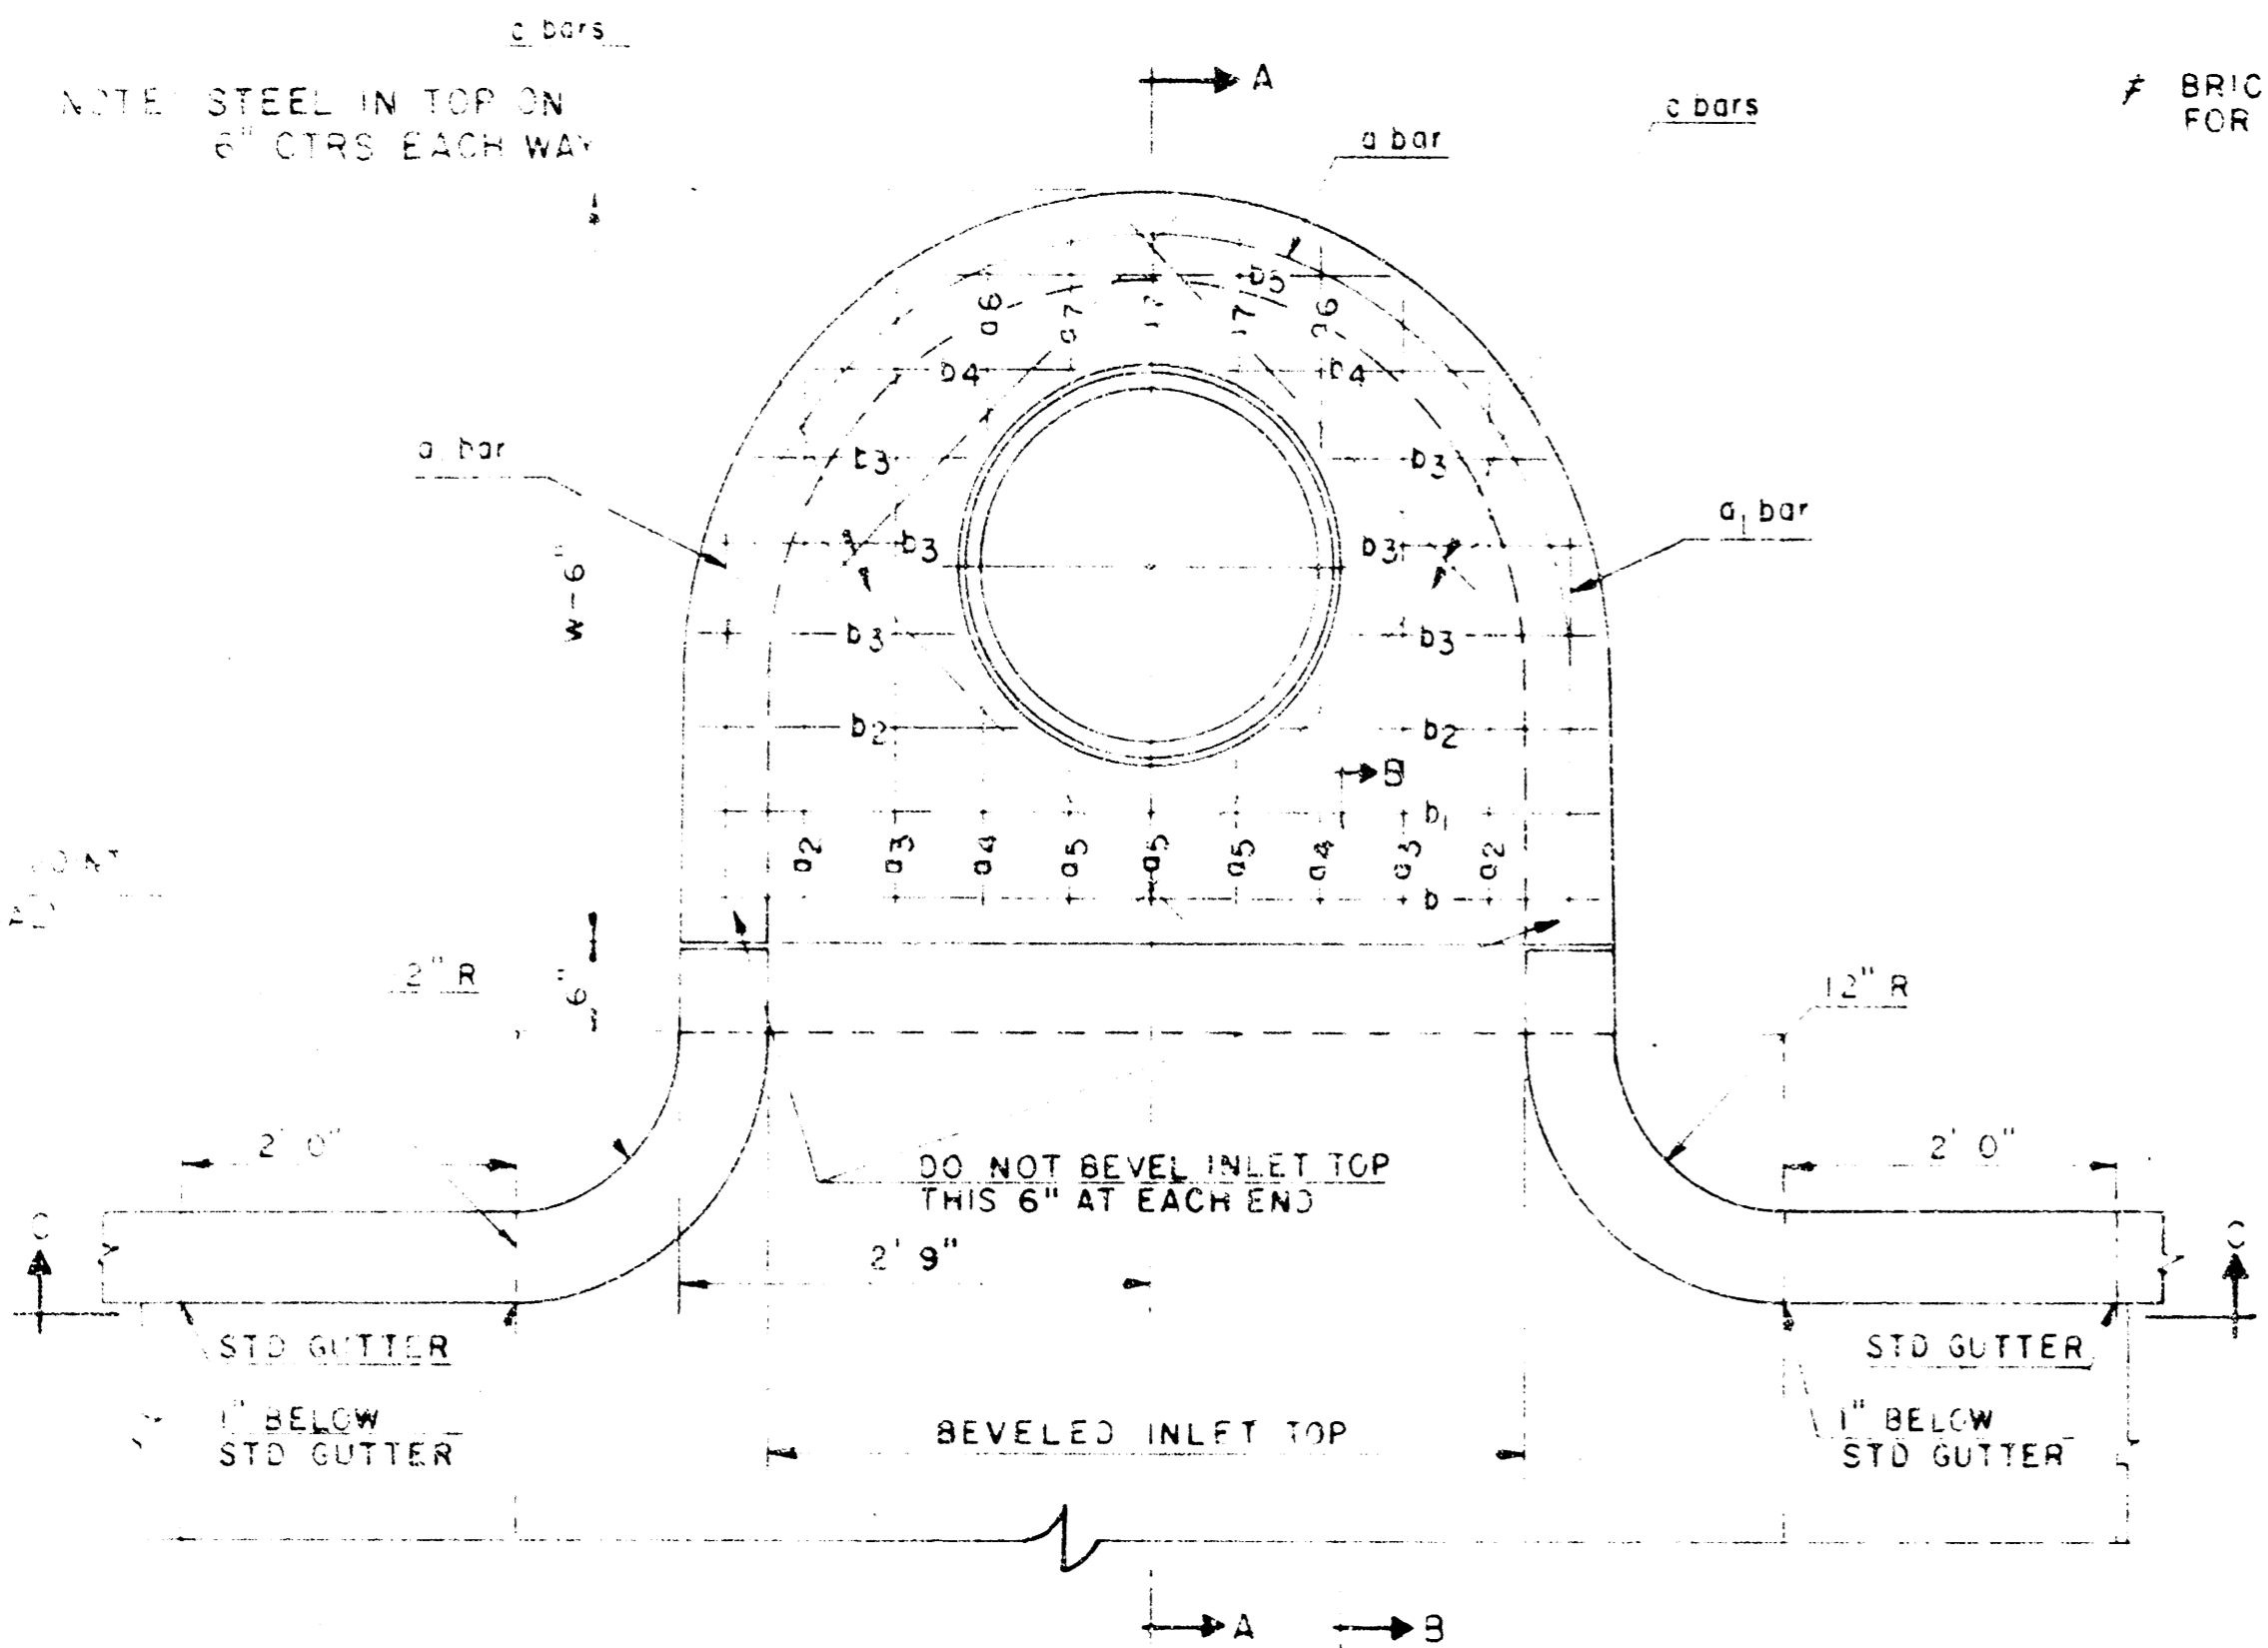

PLAN
SCALE: 3/4" = 1' 0"

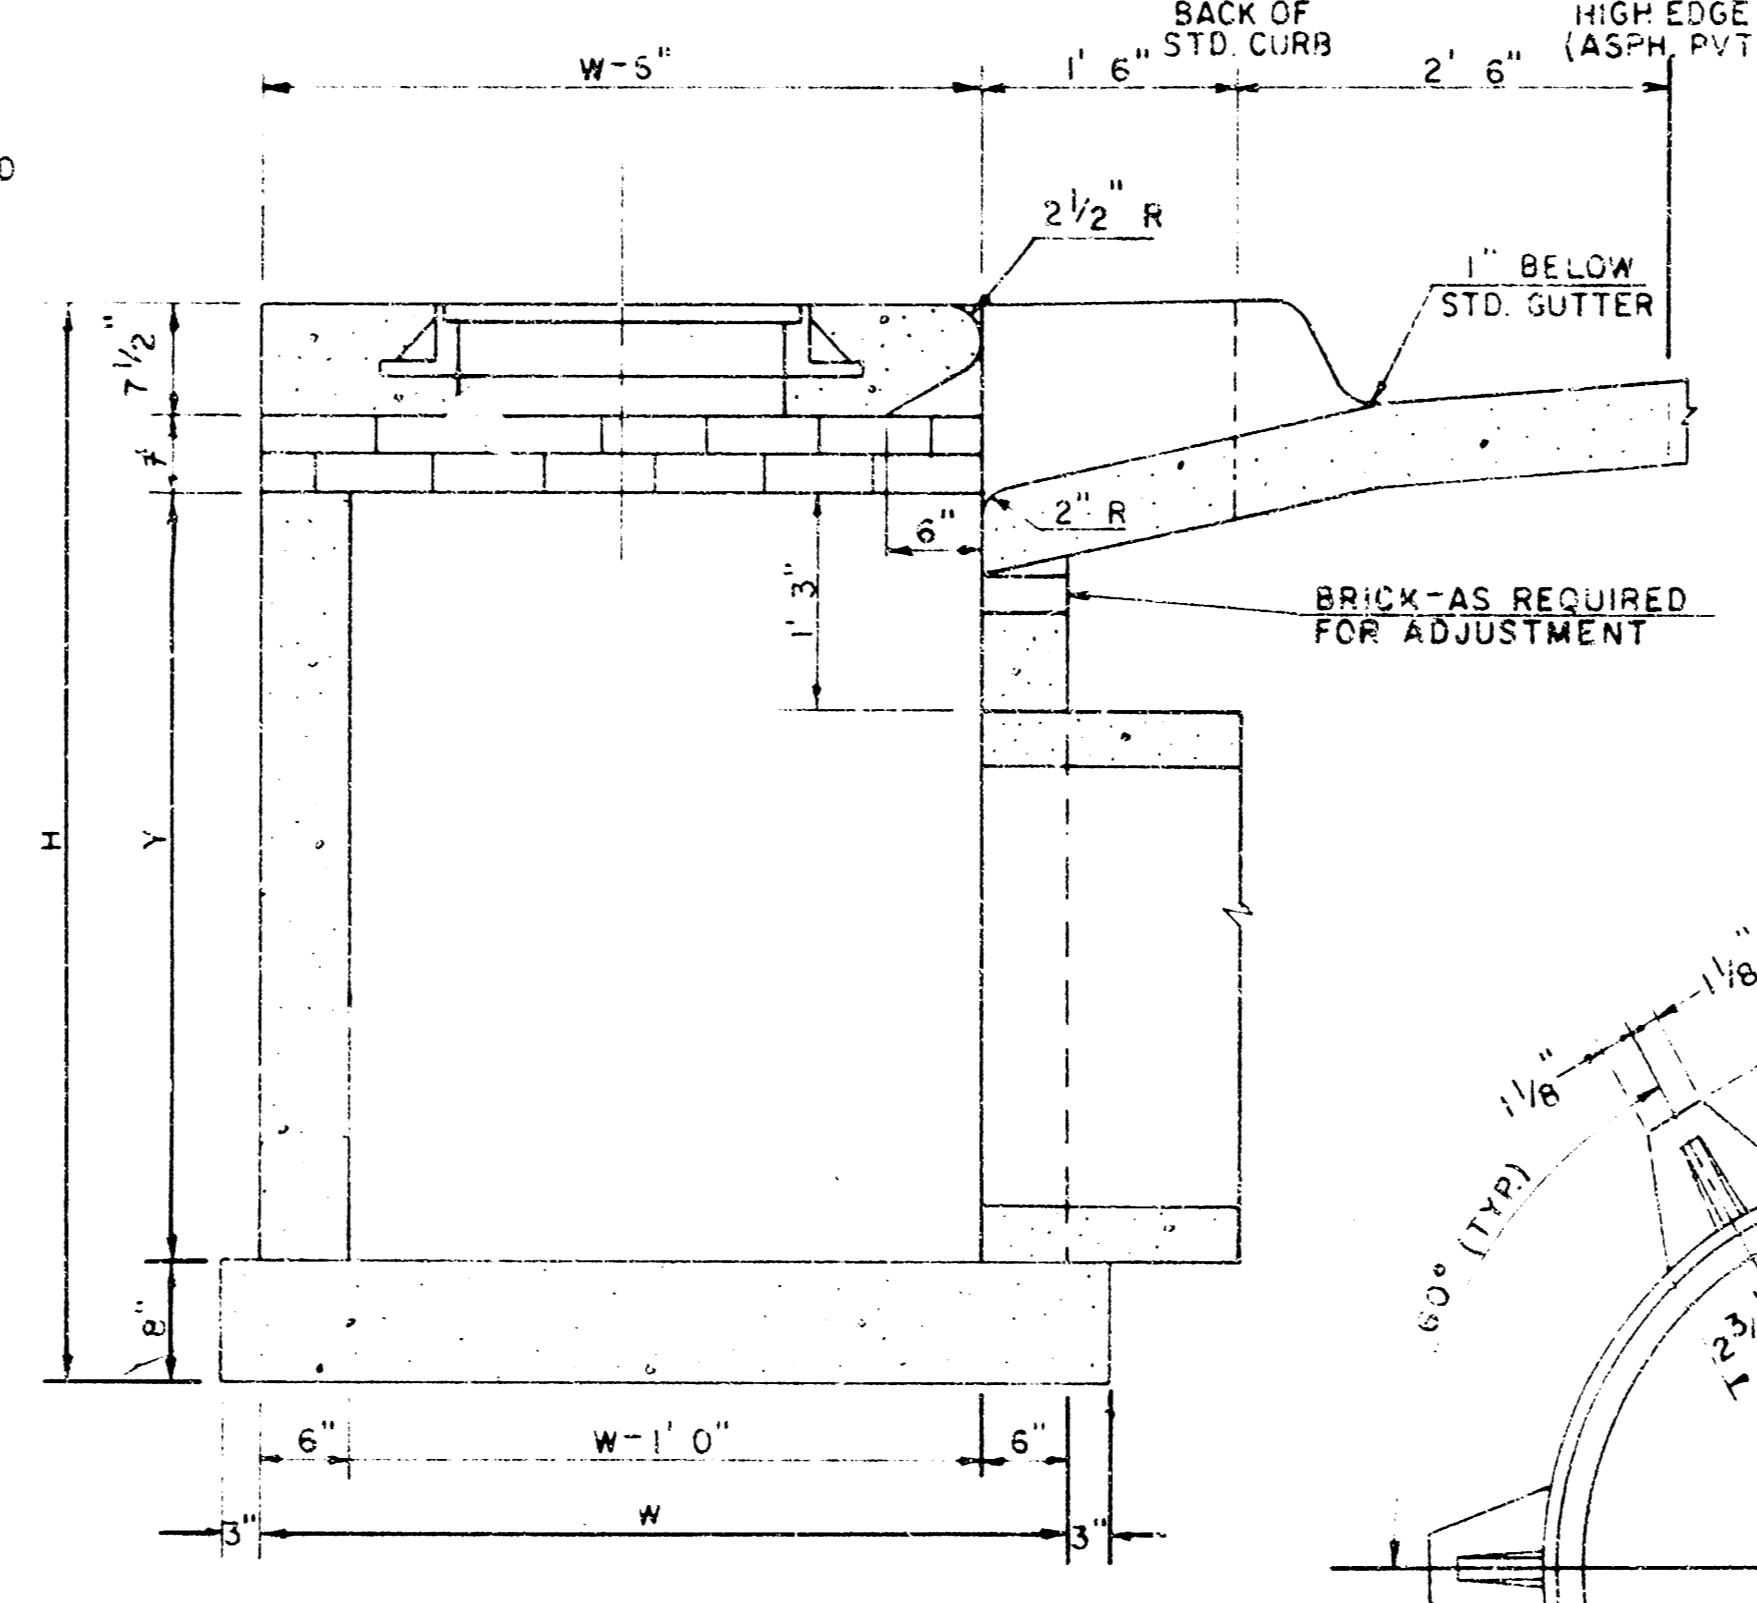


SECTION A-A
SCALE: 3/4" = 1' 0"

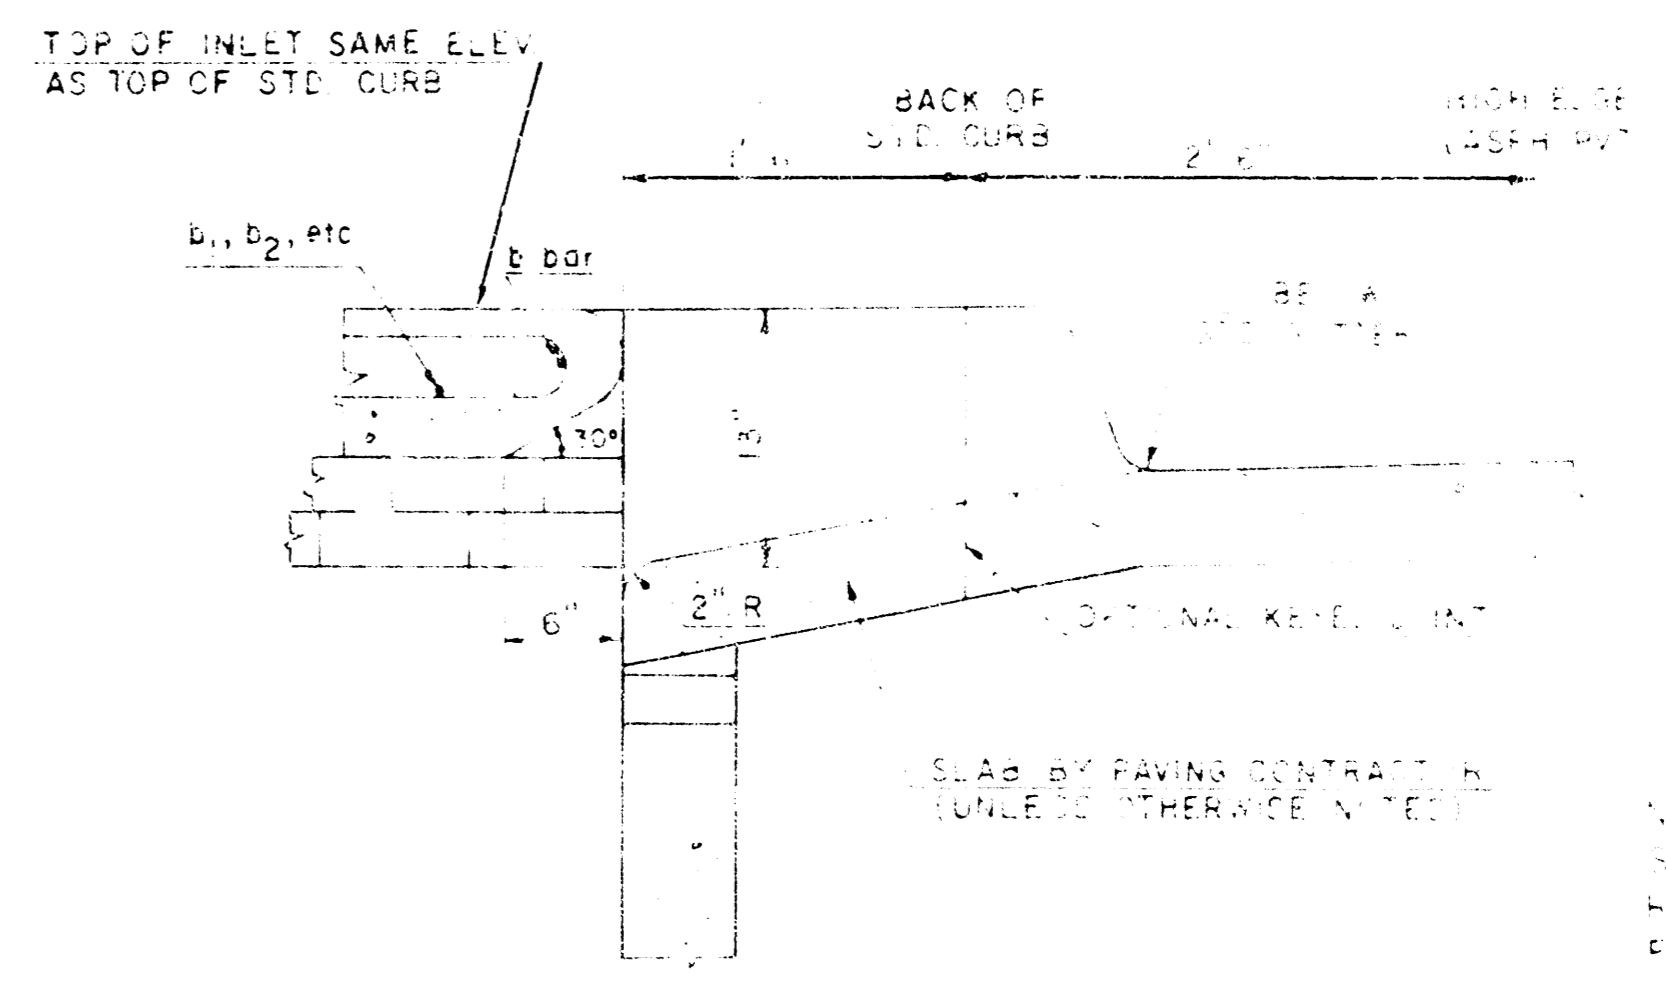


SECTION B-B
SCALE: 1/2" = 1' 0"


NOTE: CONCRETE TOPS TO BE INSTALLED ON THIN MORTAR CUSHION TO INSURE FULL SUPPORT ALONG BRICK WALLS. CONCRETE TOPS MAY BE CAST IN PLACE OR PRECAST. CONCRETE FOR INLET TOPS, FLOORS, AND PRE-CAST BODY SHALL BE 6 SACK PAVING MIX.

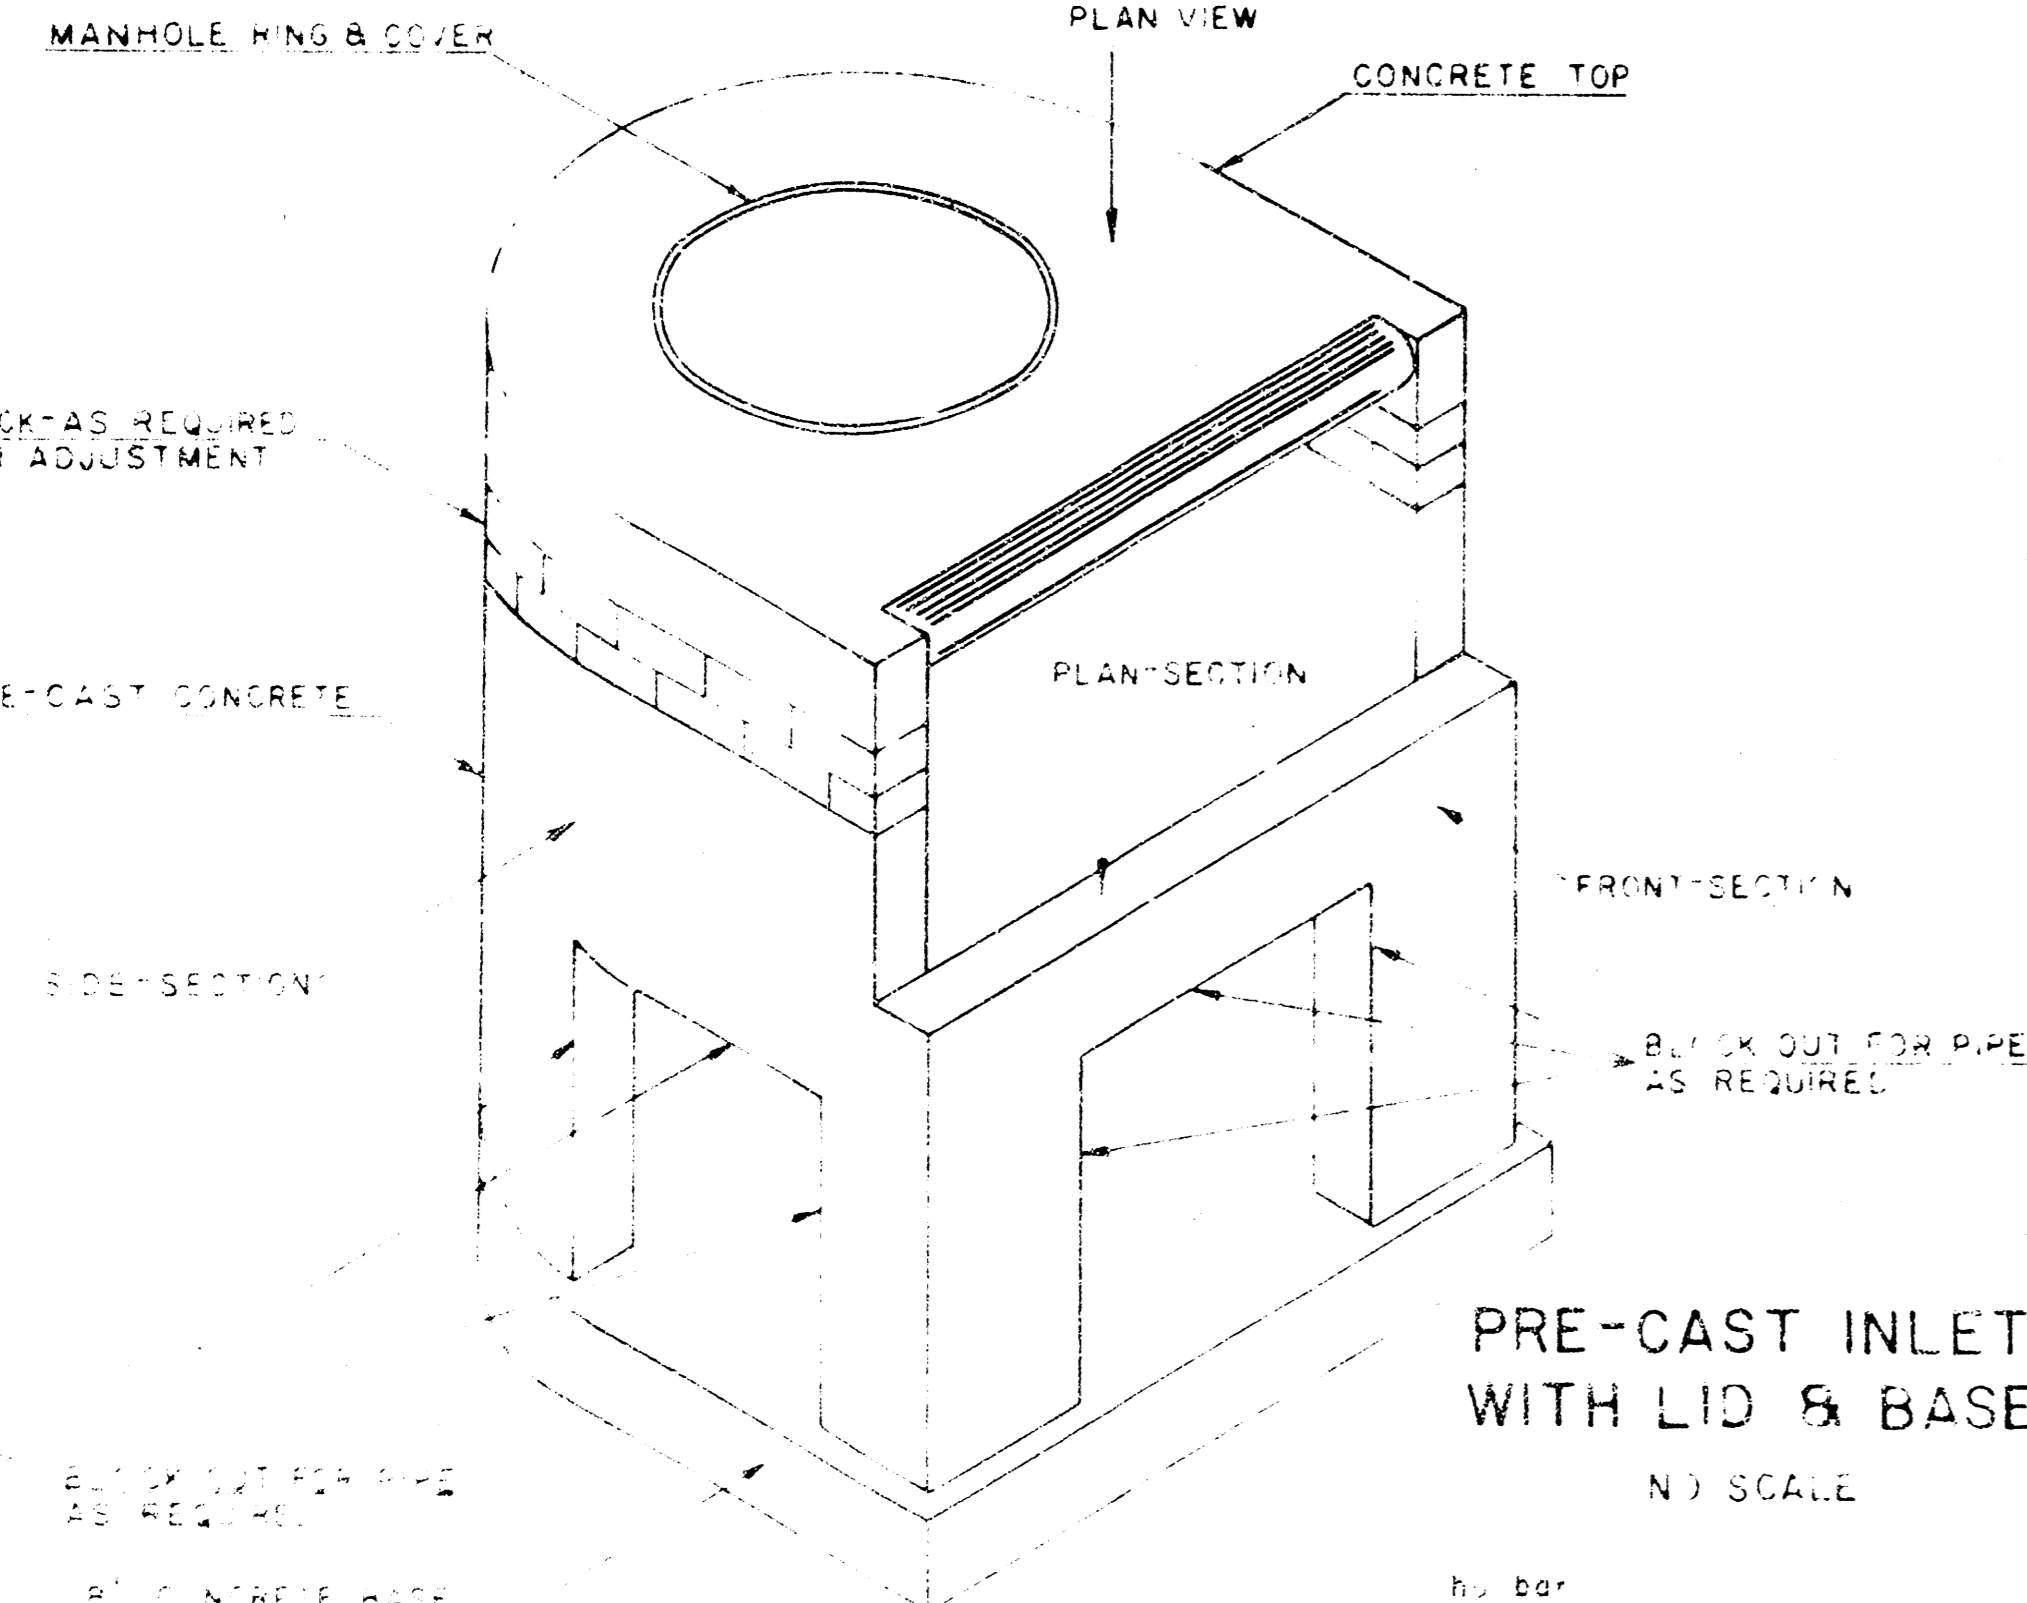


PRE-CAST INLET WITH LID & BASE
N/A SCALE

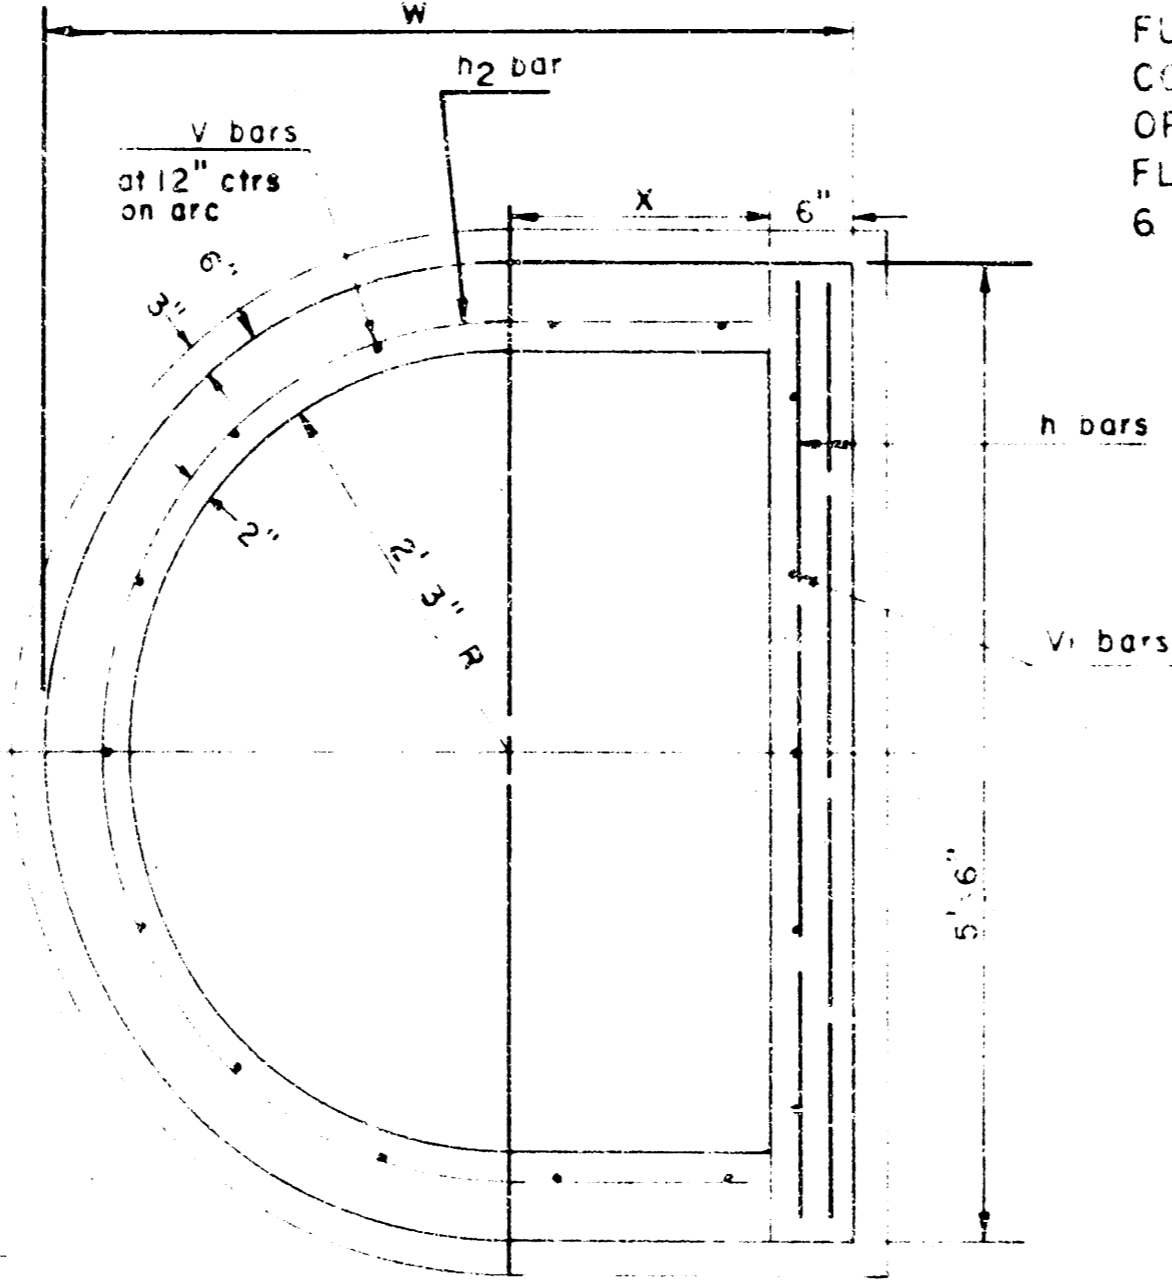

PLAN-SECTION
SCALE: 3/4" = 1' 0"

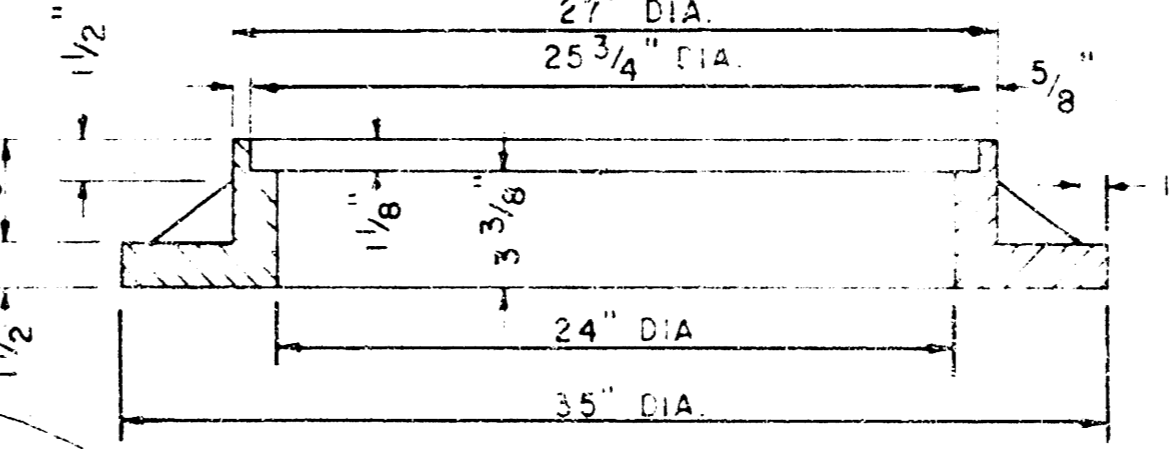

MANHOLE FRAME
SCALE: 1/2" = 1' 0"

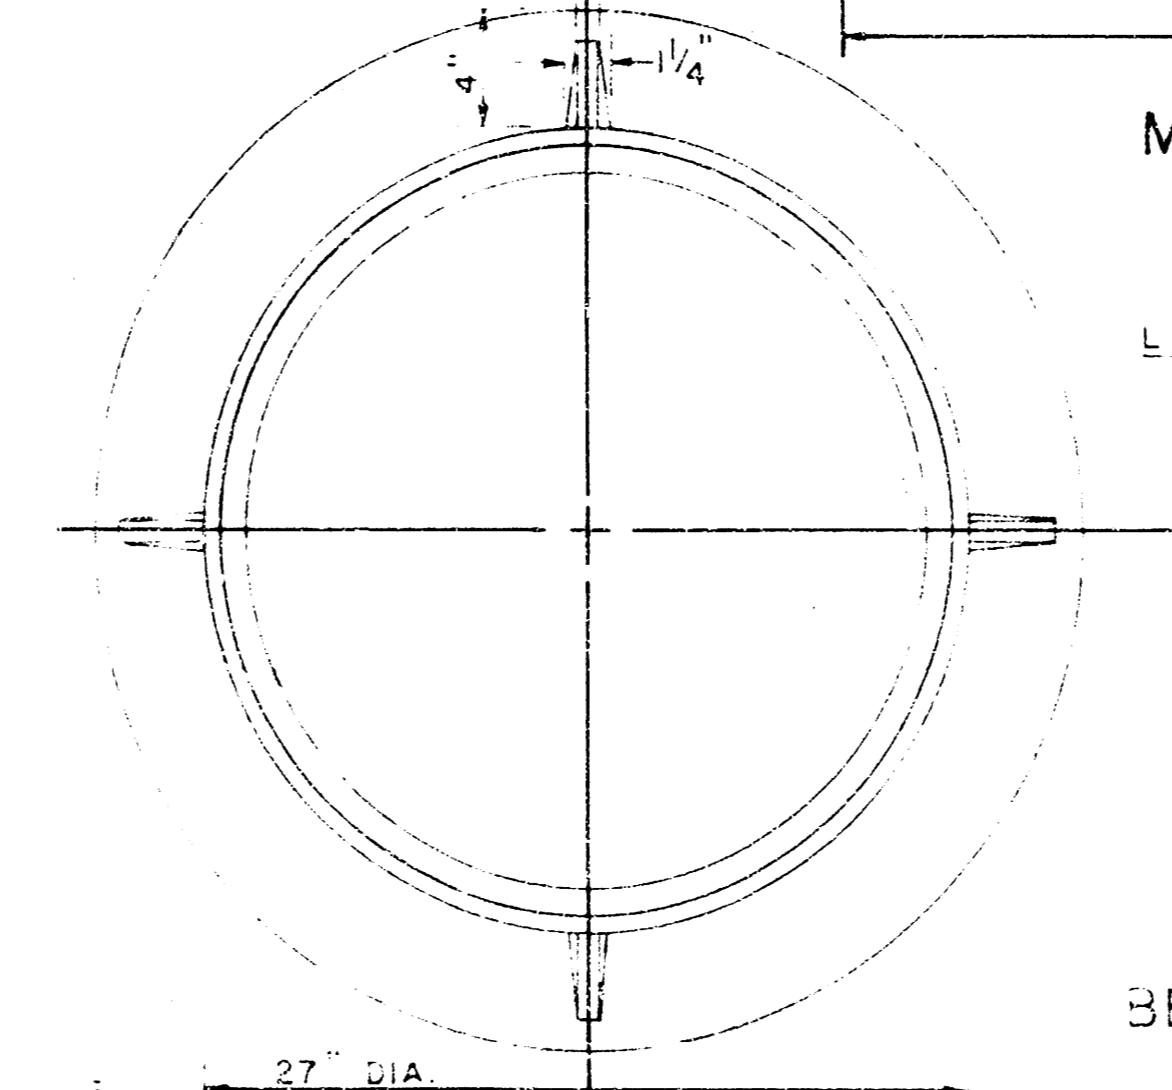


MANHOLE COVER
SCALE: 1/2" = 1' 0"


W	PIPE D.I.A.
W=4' 3"	36" & LESS
W=5' 11"	36" & 42"
W=7' 11"	48" & 54"
W=8' 3"	60" & 66"

SECTION C-C
SCALE: 1/2" = 1' 0"


STEEL SCHEDULE	
BAR	SIZE
W=4' 3"	#4
W=5' 11"	#4
W=7' 11"	#4
W=8' 3"	#4

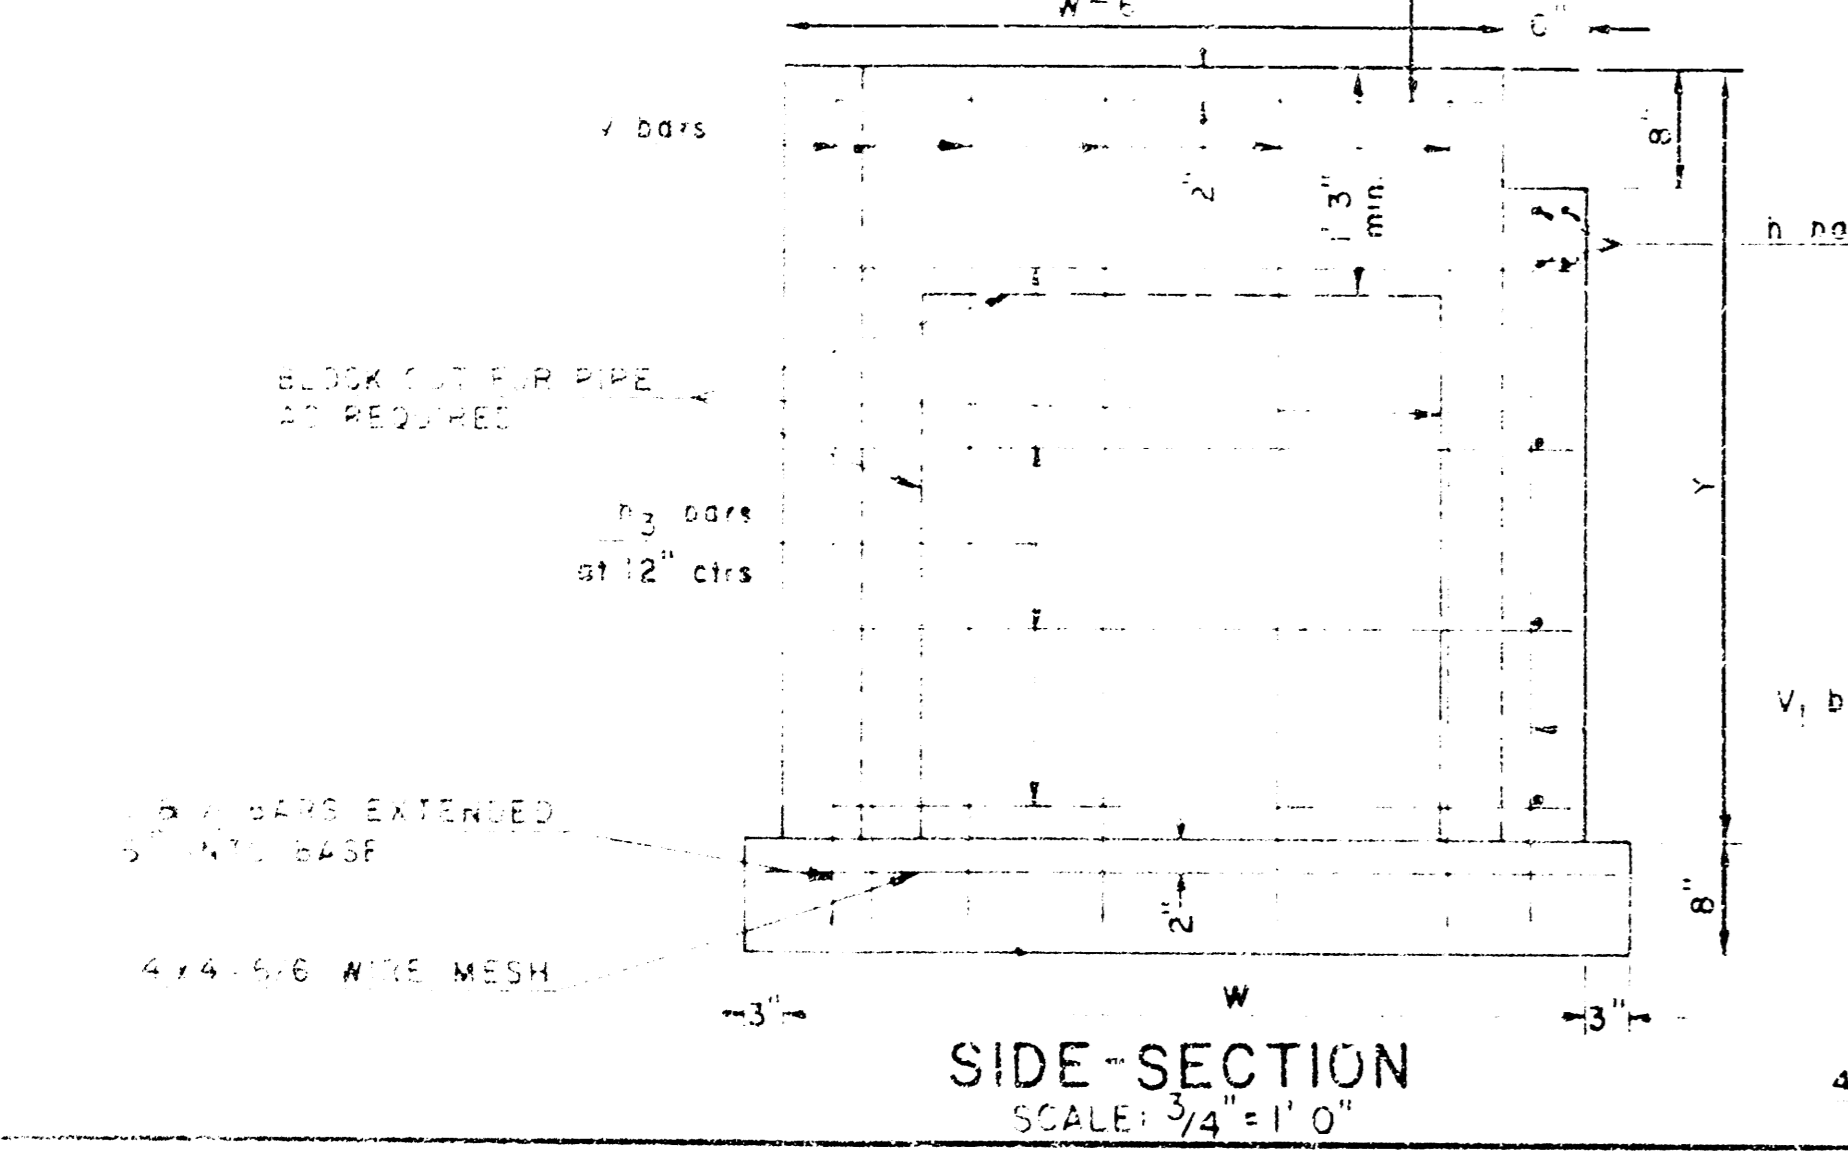

SIDE-SECTION
SCALE: 3/4" = 1' 0"

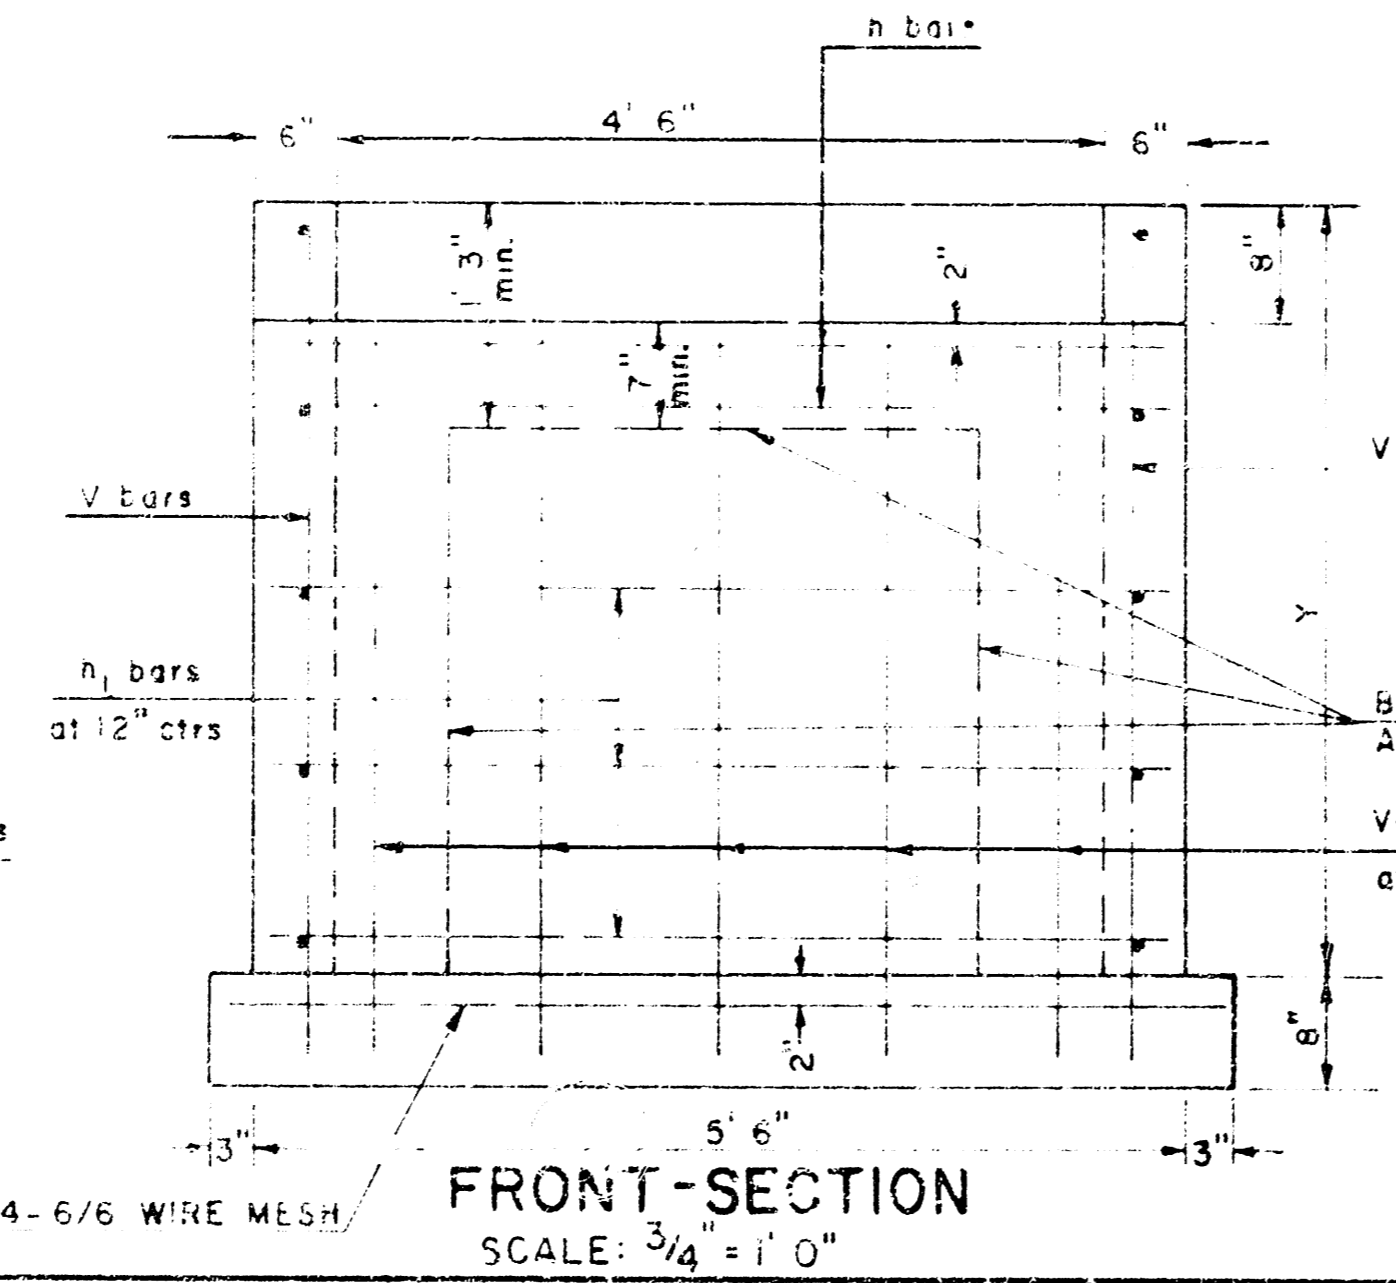


FRONT-SECTION
SCALE: 3/4" = 1' 0"

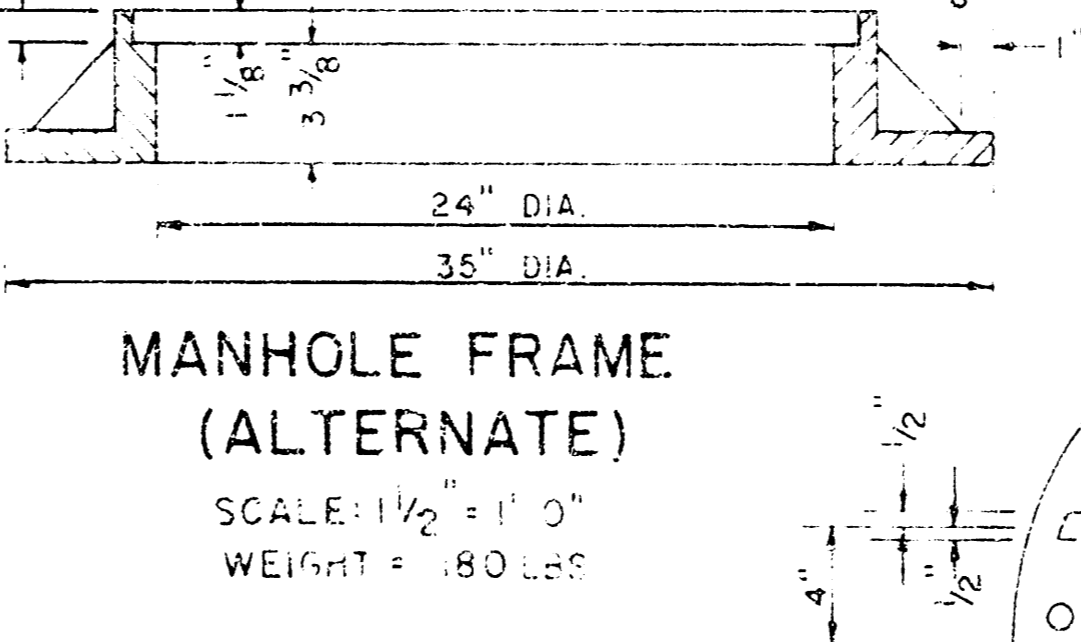

MANHOLE FRAME (ALTERNATE)
SCALE: 1/2" = 1' 0"


NOTE: MANHOLE FRAMES AND COVERS ARE WESTERN IRON AND FOUNDRY CO. INC. OR EQUAL DESIGNS AS FOLLOWS:
FRAME: 524-L6
FRAME (ALTERNATE): 500 A4
COVER: 222 S4 "NOBBY"

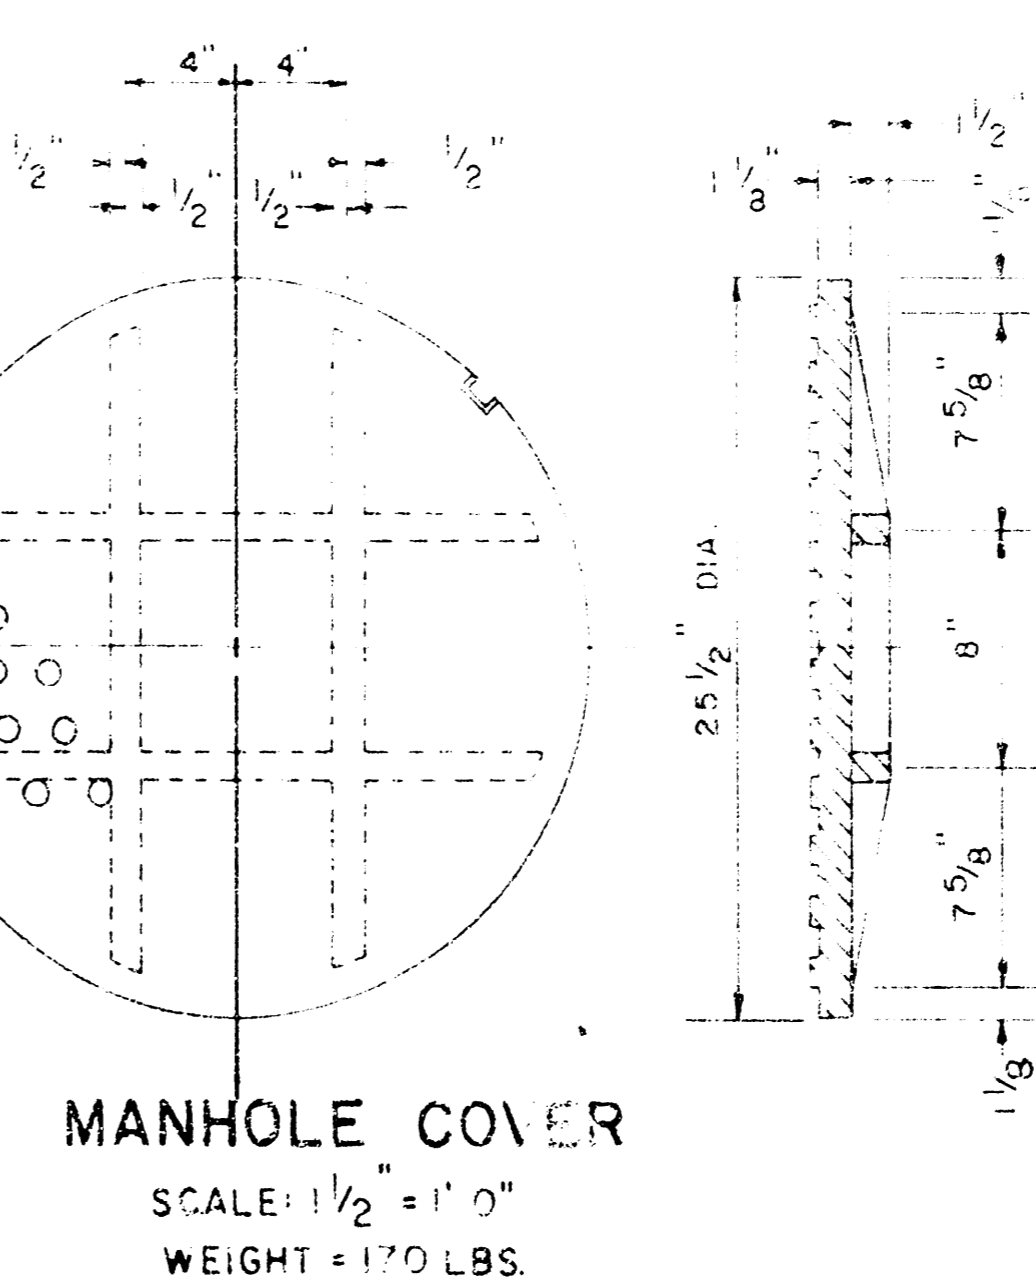


BENDING DIAGRAMS
N/A SCALE

NOTE: DIMENSIONS INDICATED ON PLAN ARE BASED ON CENTER OF INLETS REQUIRED FOR PIPE SIZES SHOWN AND A MINIMUM FOR PIPE CLEARANCE UNDER INLET. CLEARANCE SELECTION WILL HAVE TO BE MADE BY THE CONTRACTOR AND MAY VARY FROM THAT SHOWN.


DETAIL PRE-CAST TYPE IA INLET
CITY OF WICHITA, KANSAS
R. W. LINN—CITY ENGINEER
AUGUST 1979
STORM WATER SEWER NO.173 PROJ. NO.468-76-245-80884-000-000-10

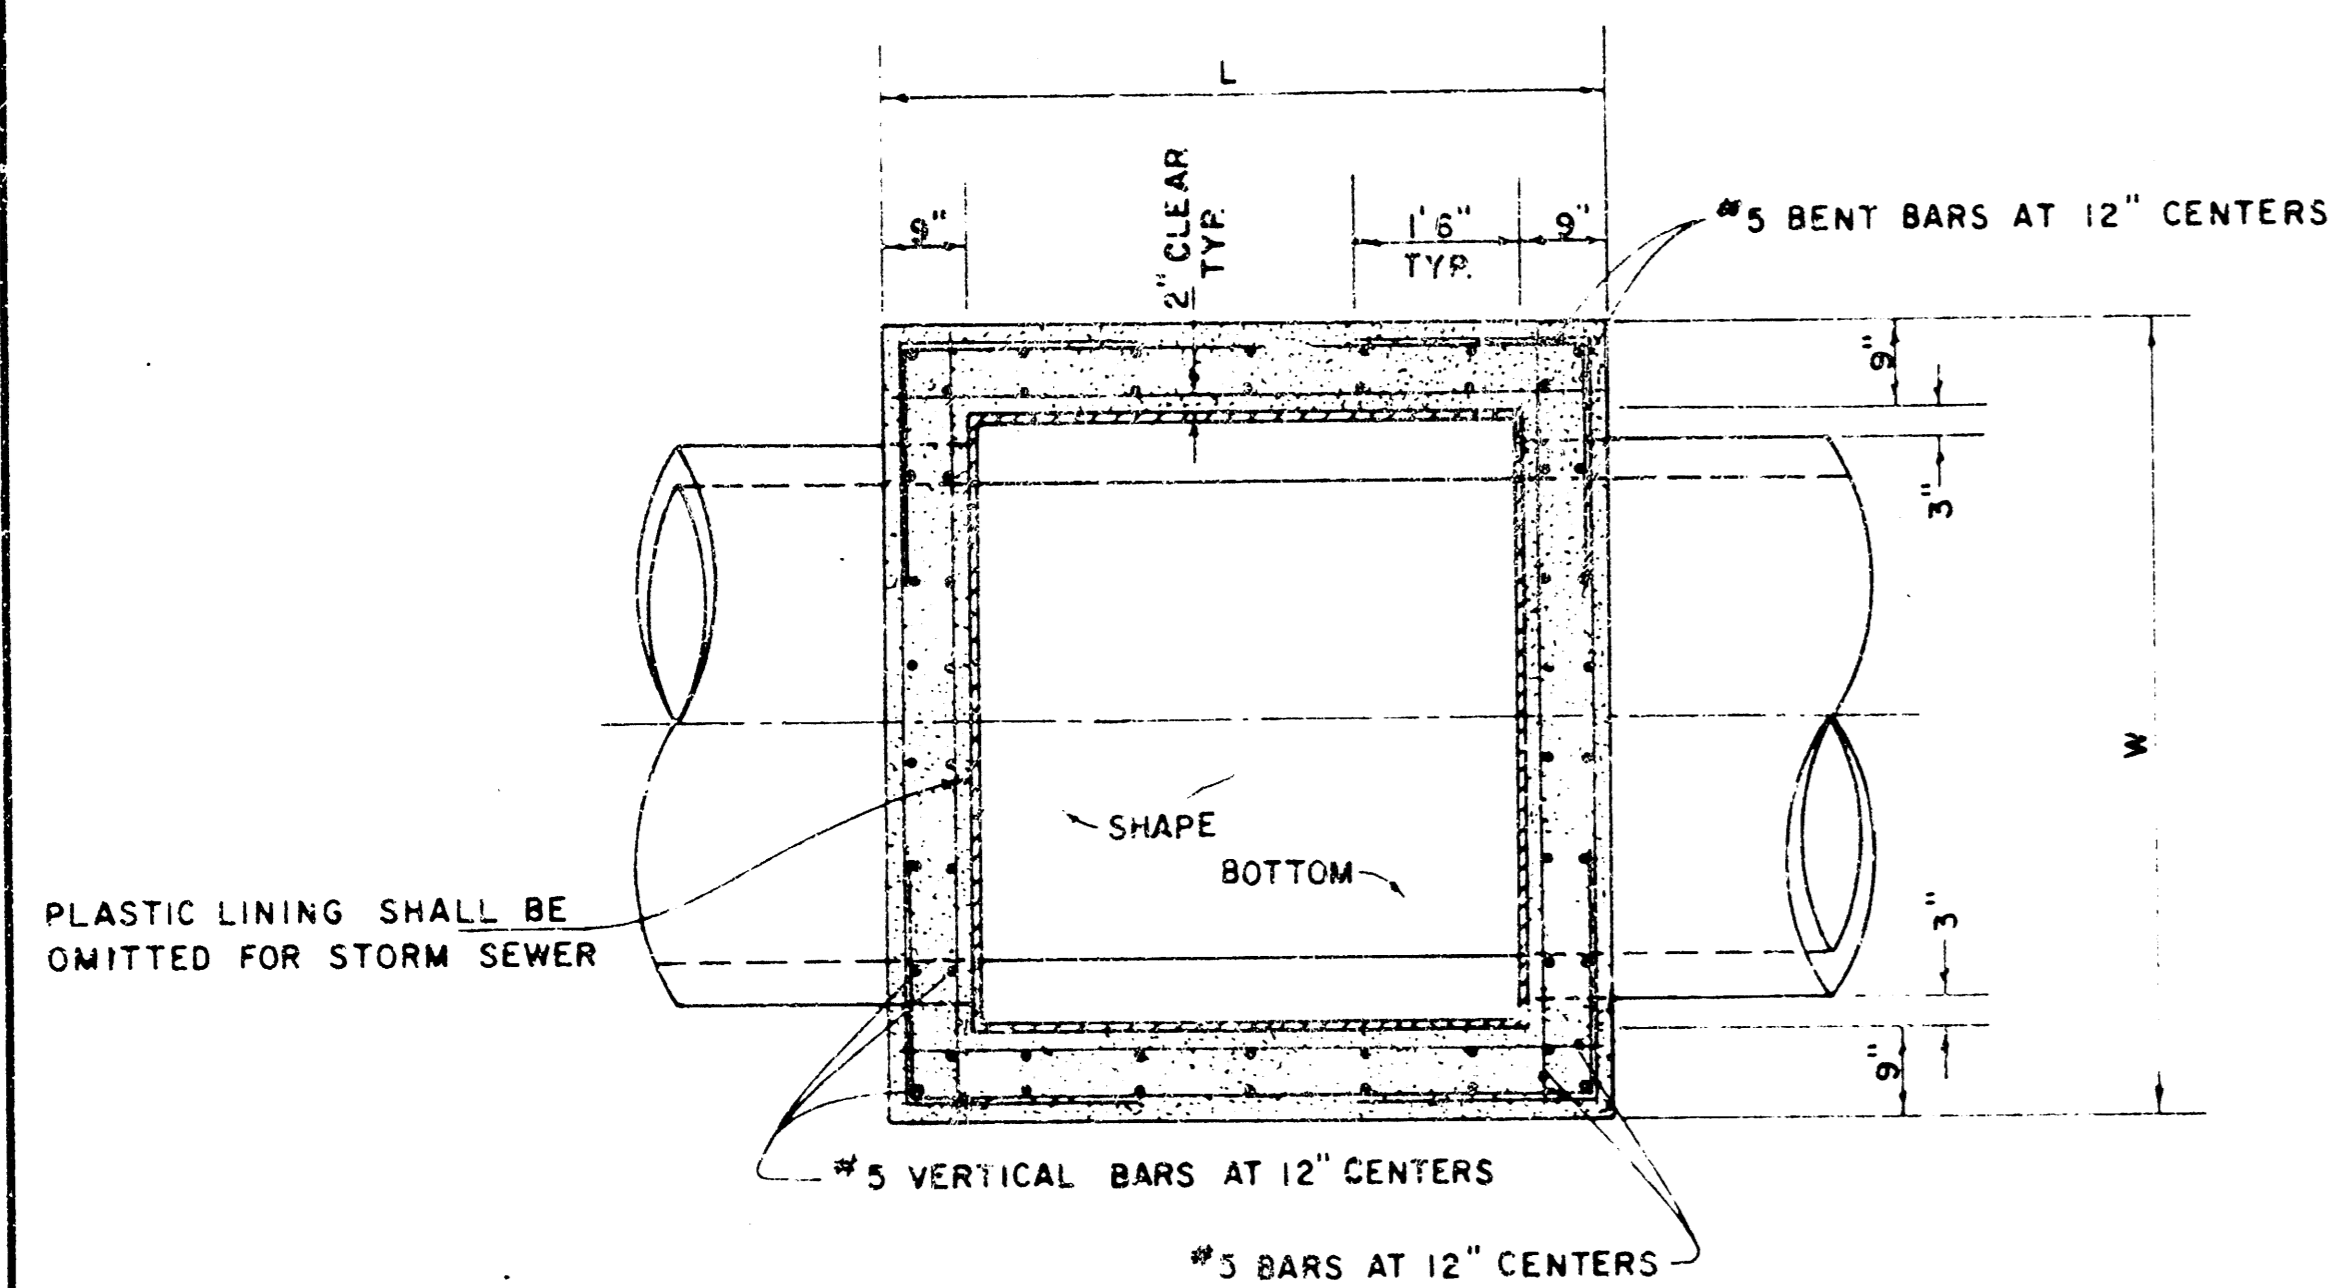


PLASTIC LINING SHALL BE OMITTED FOR STORM SEWER

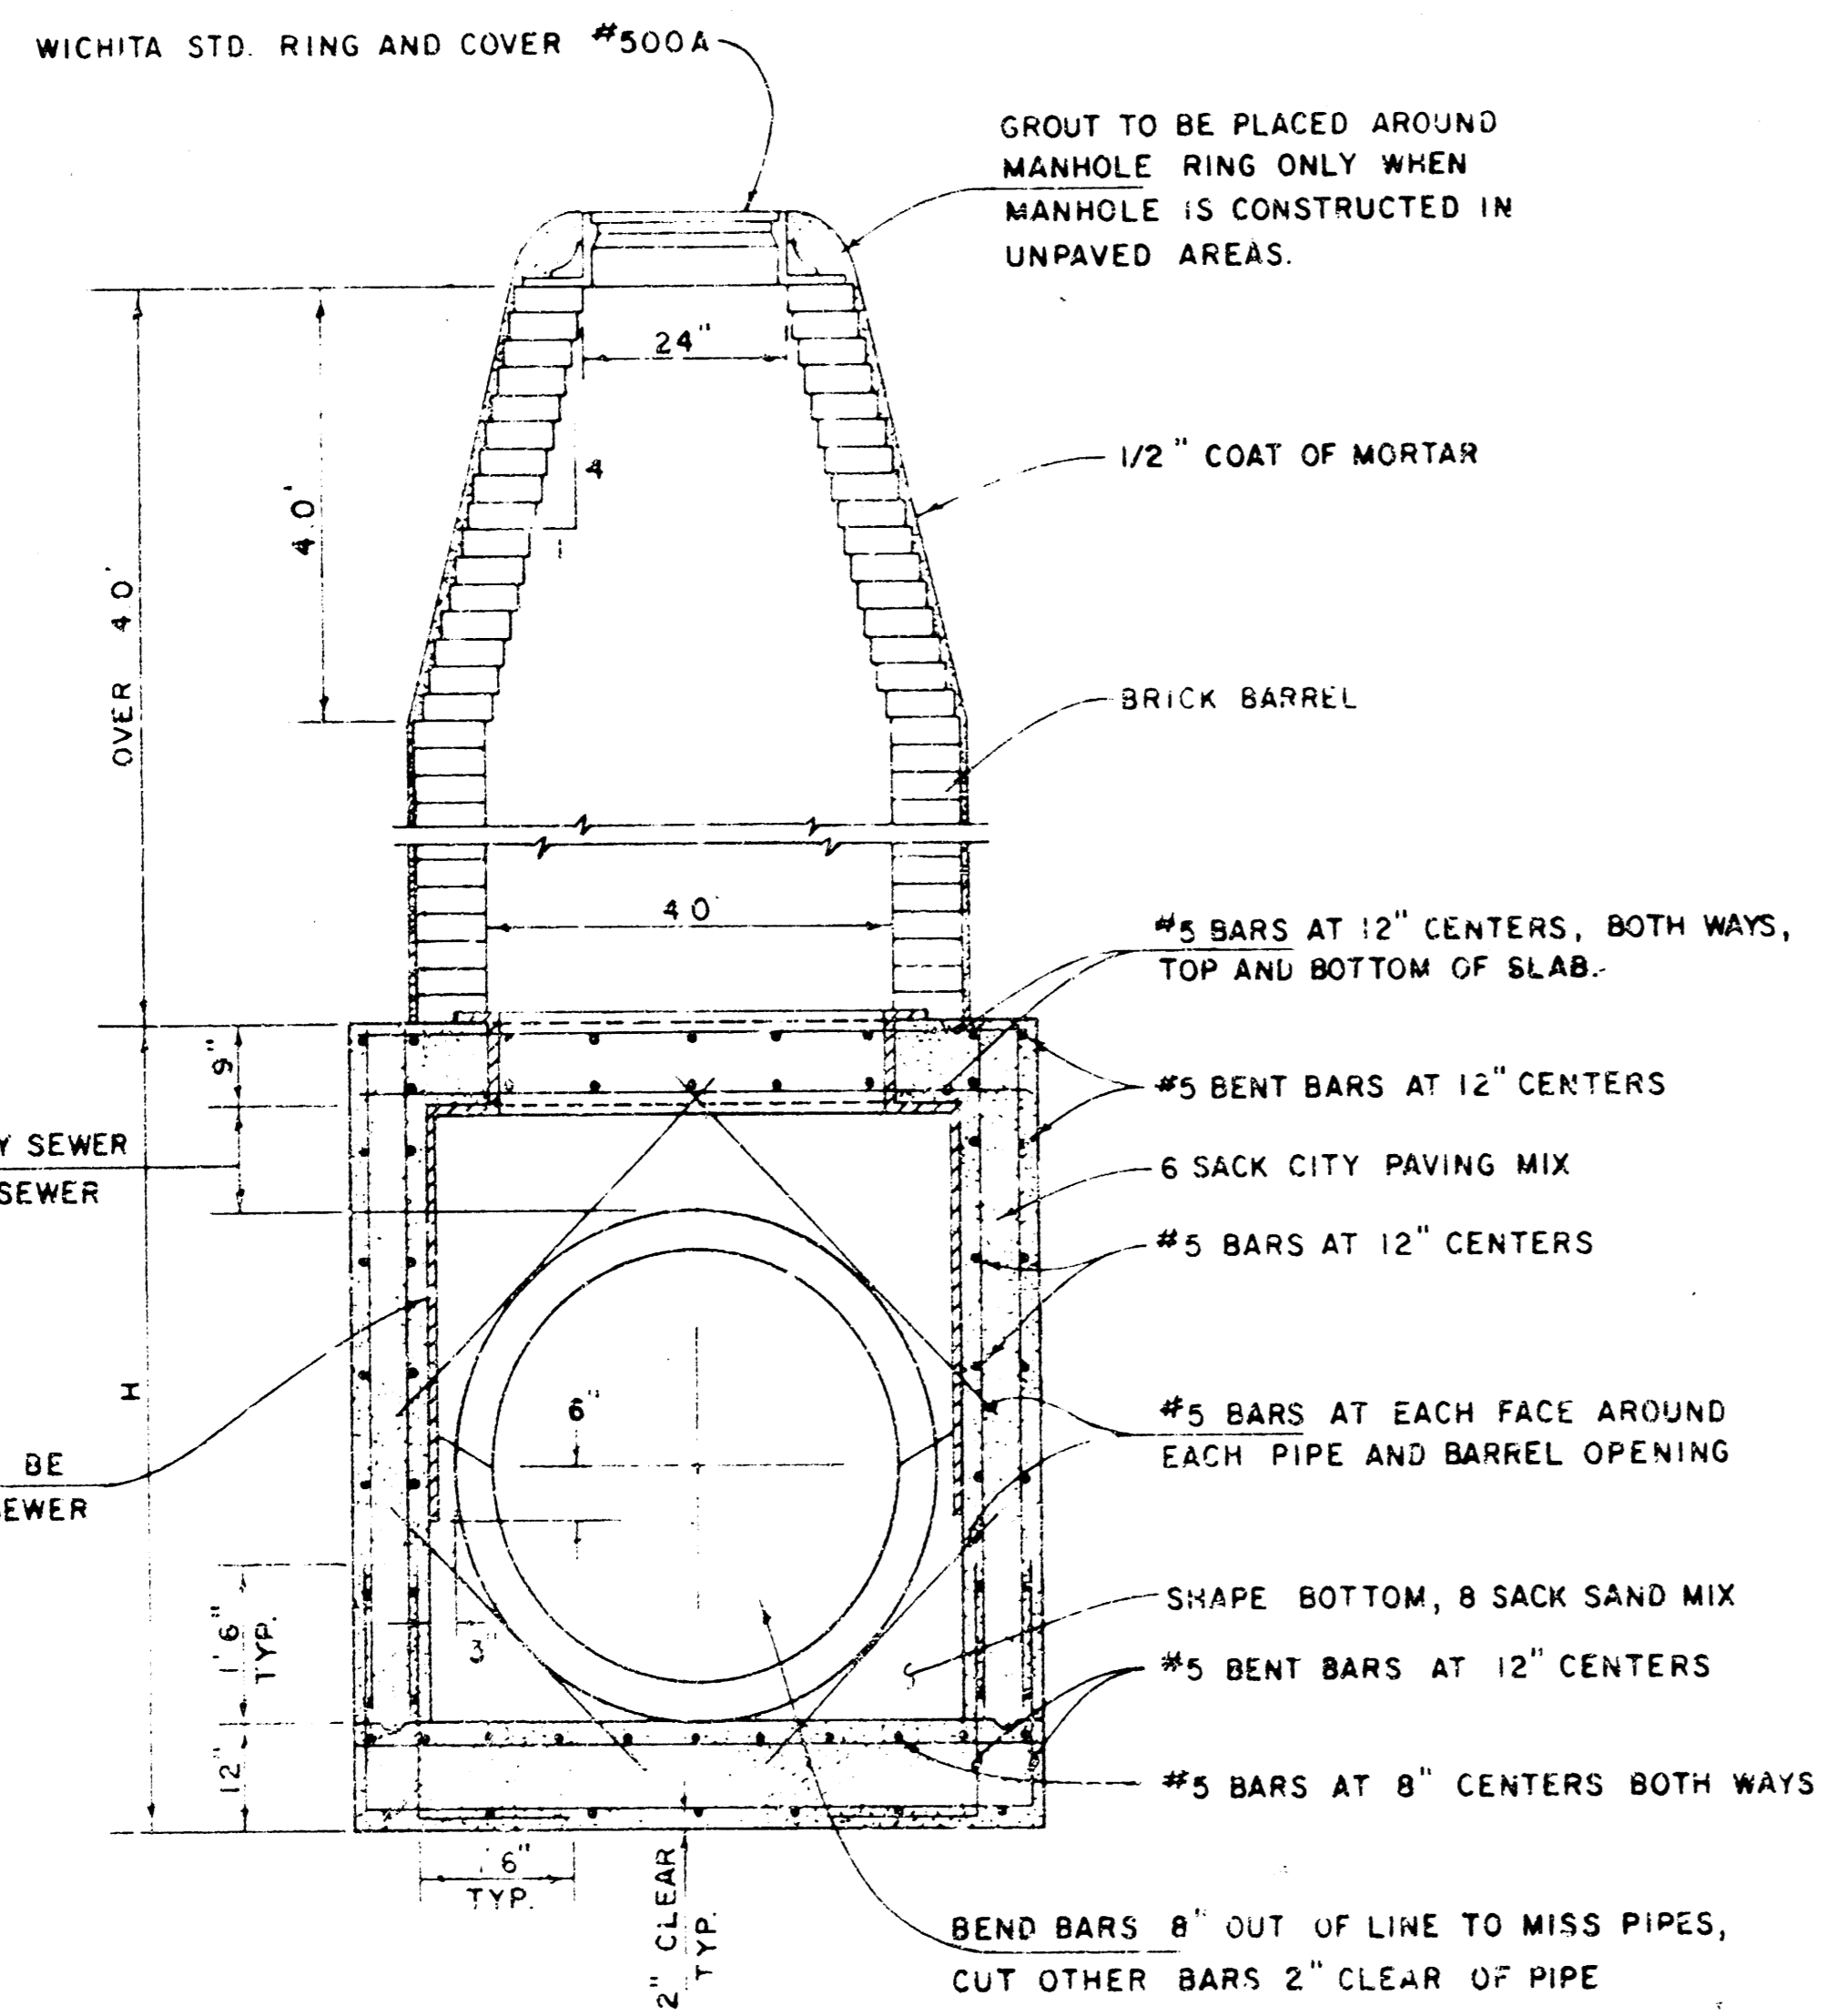

REINFORCED CONCRETE MANHOLE
DEPTH OF STACK: OVER 4.0'
SCALE 1" = 2'

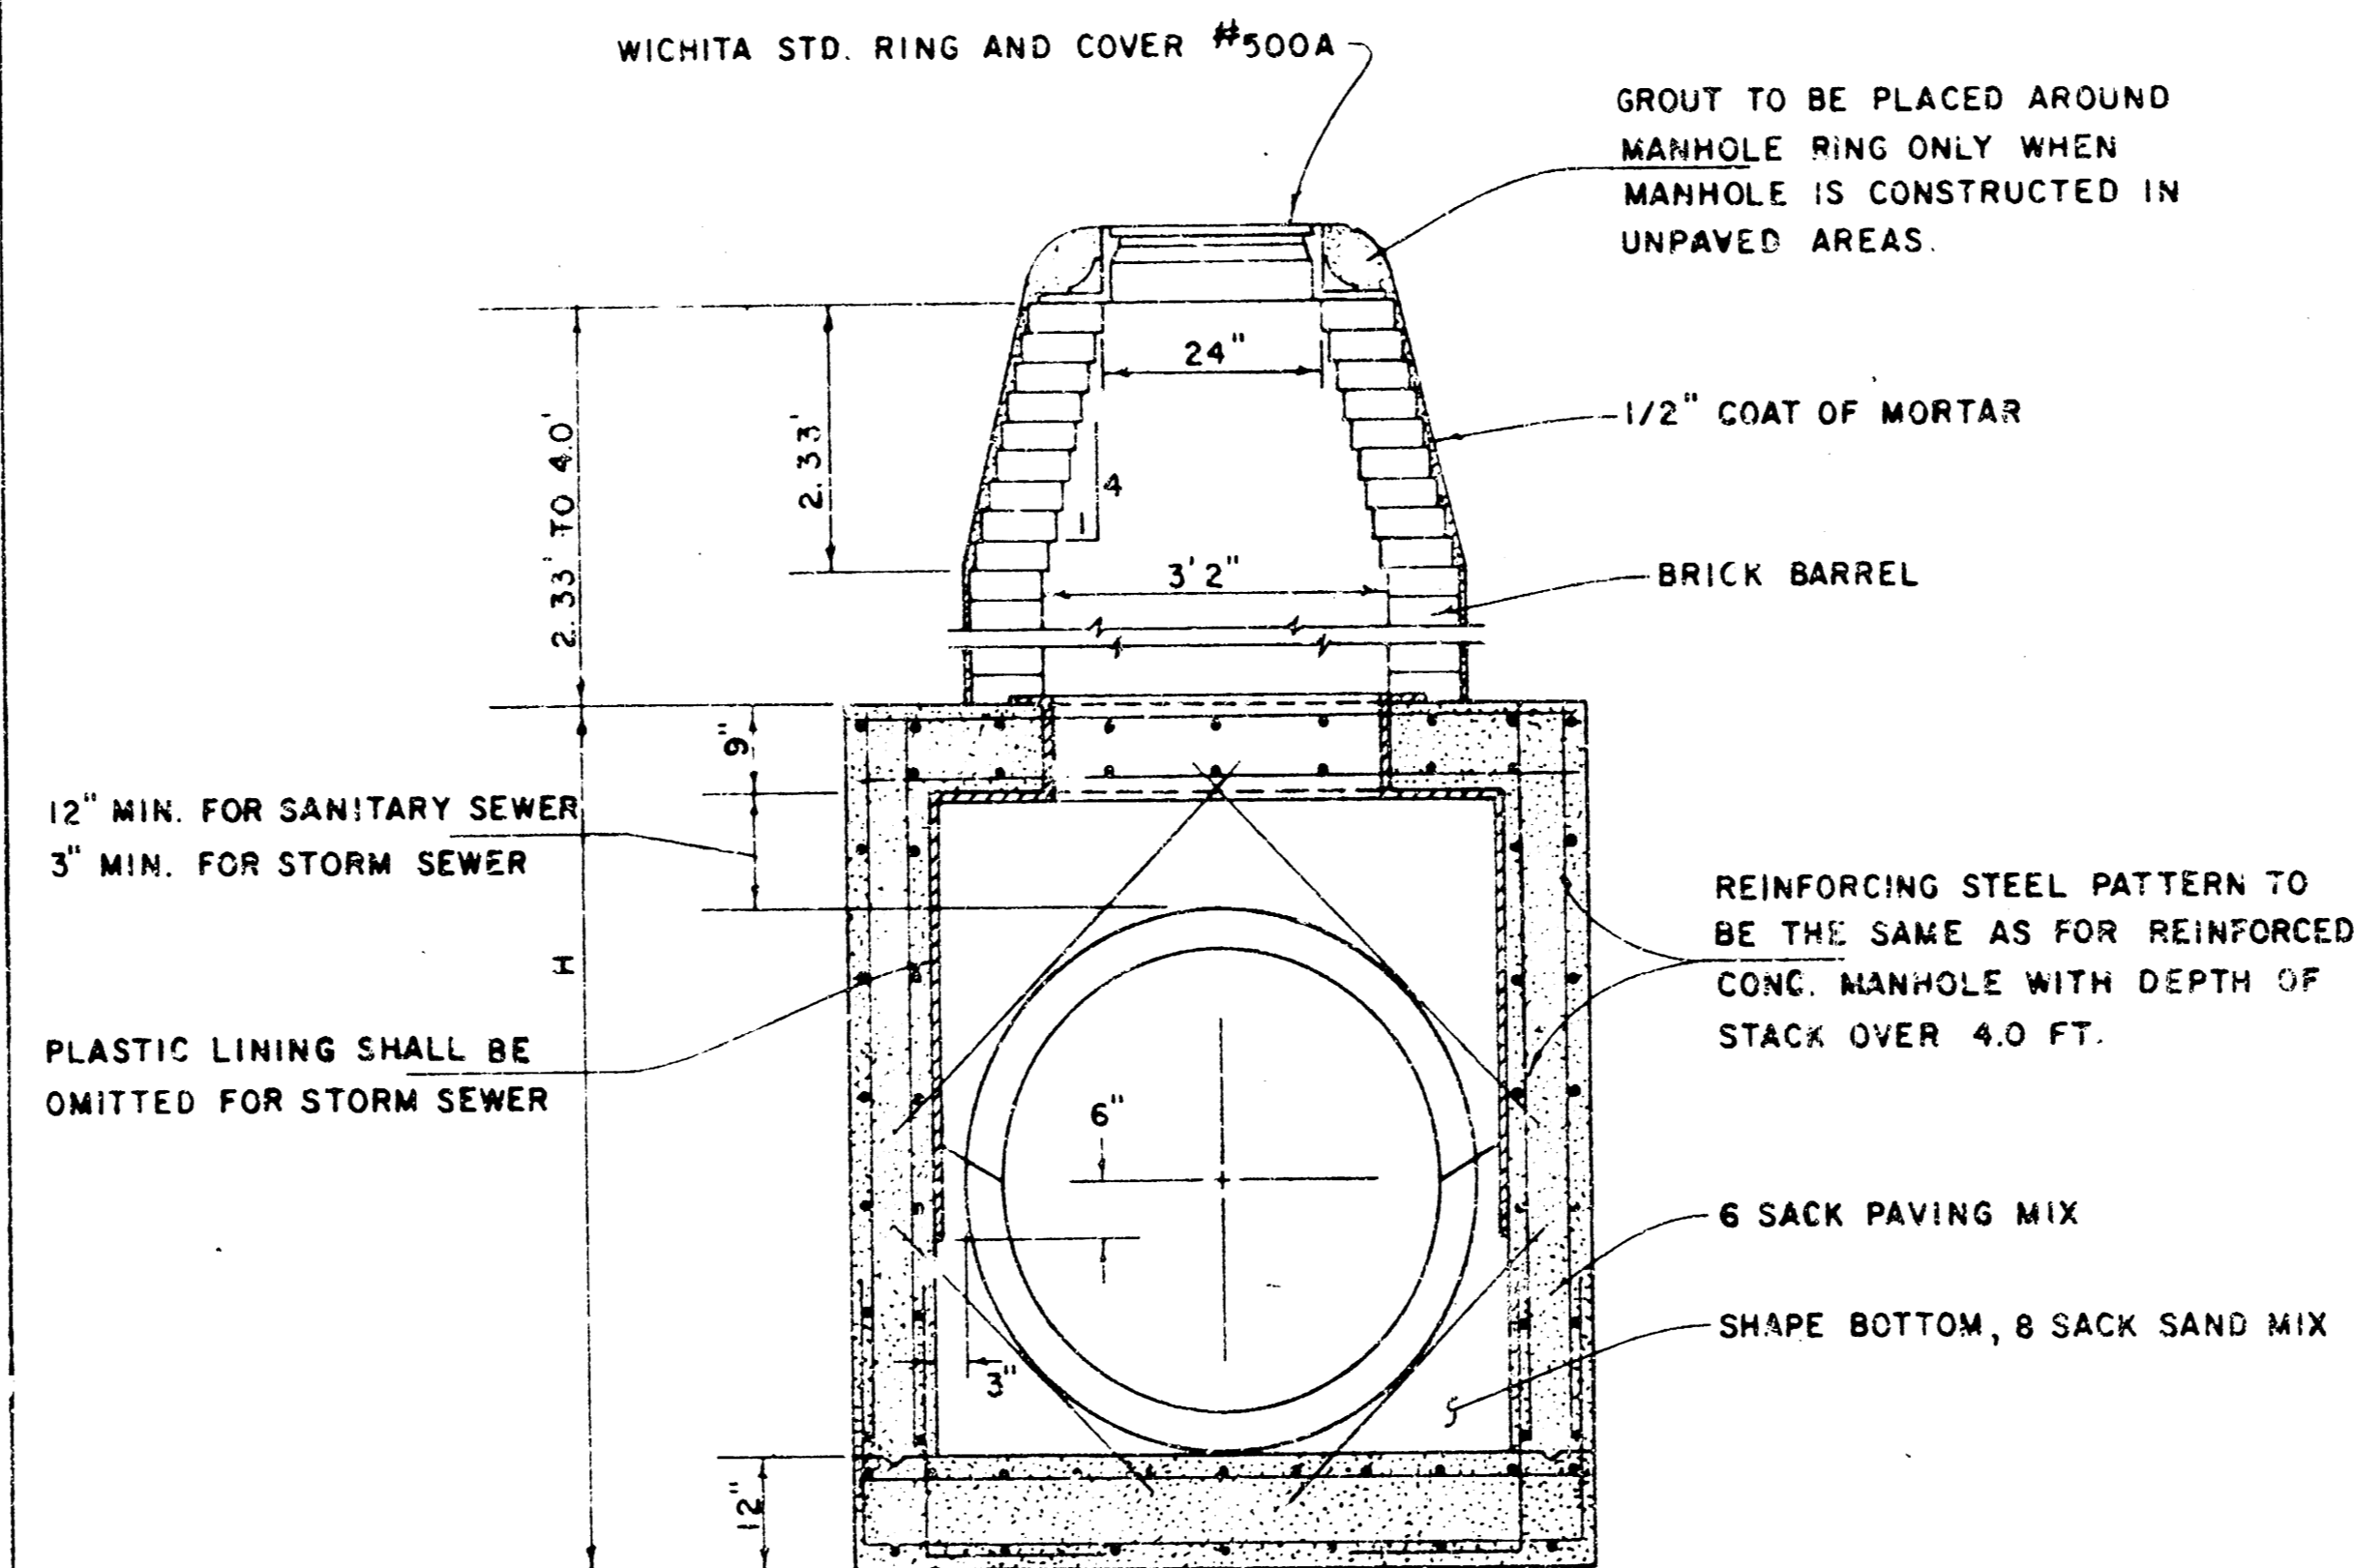

REINFORCED CONCRETE MANHOLE
DEPTH OF STACK: 2.33' TO 4.0'
SCALE 1" = 2'

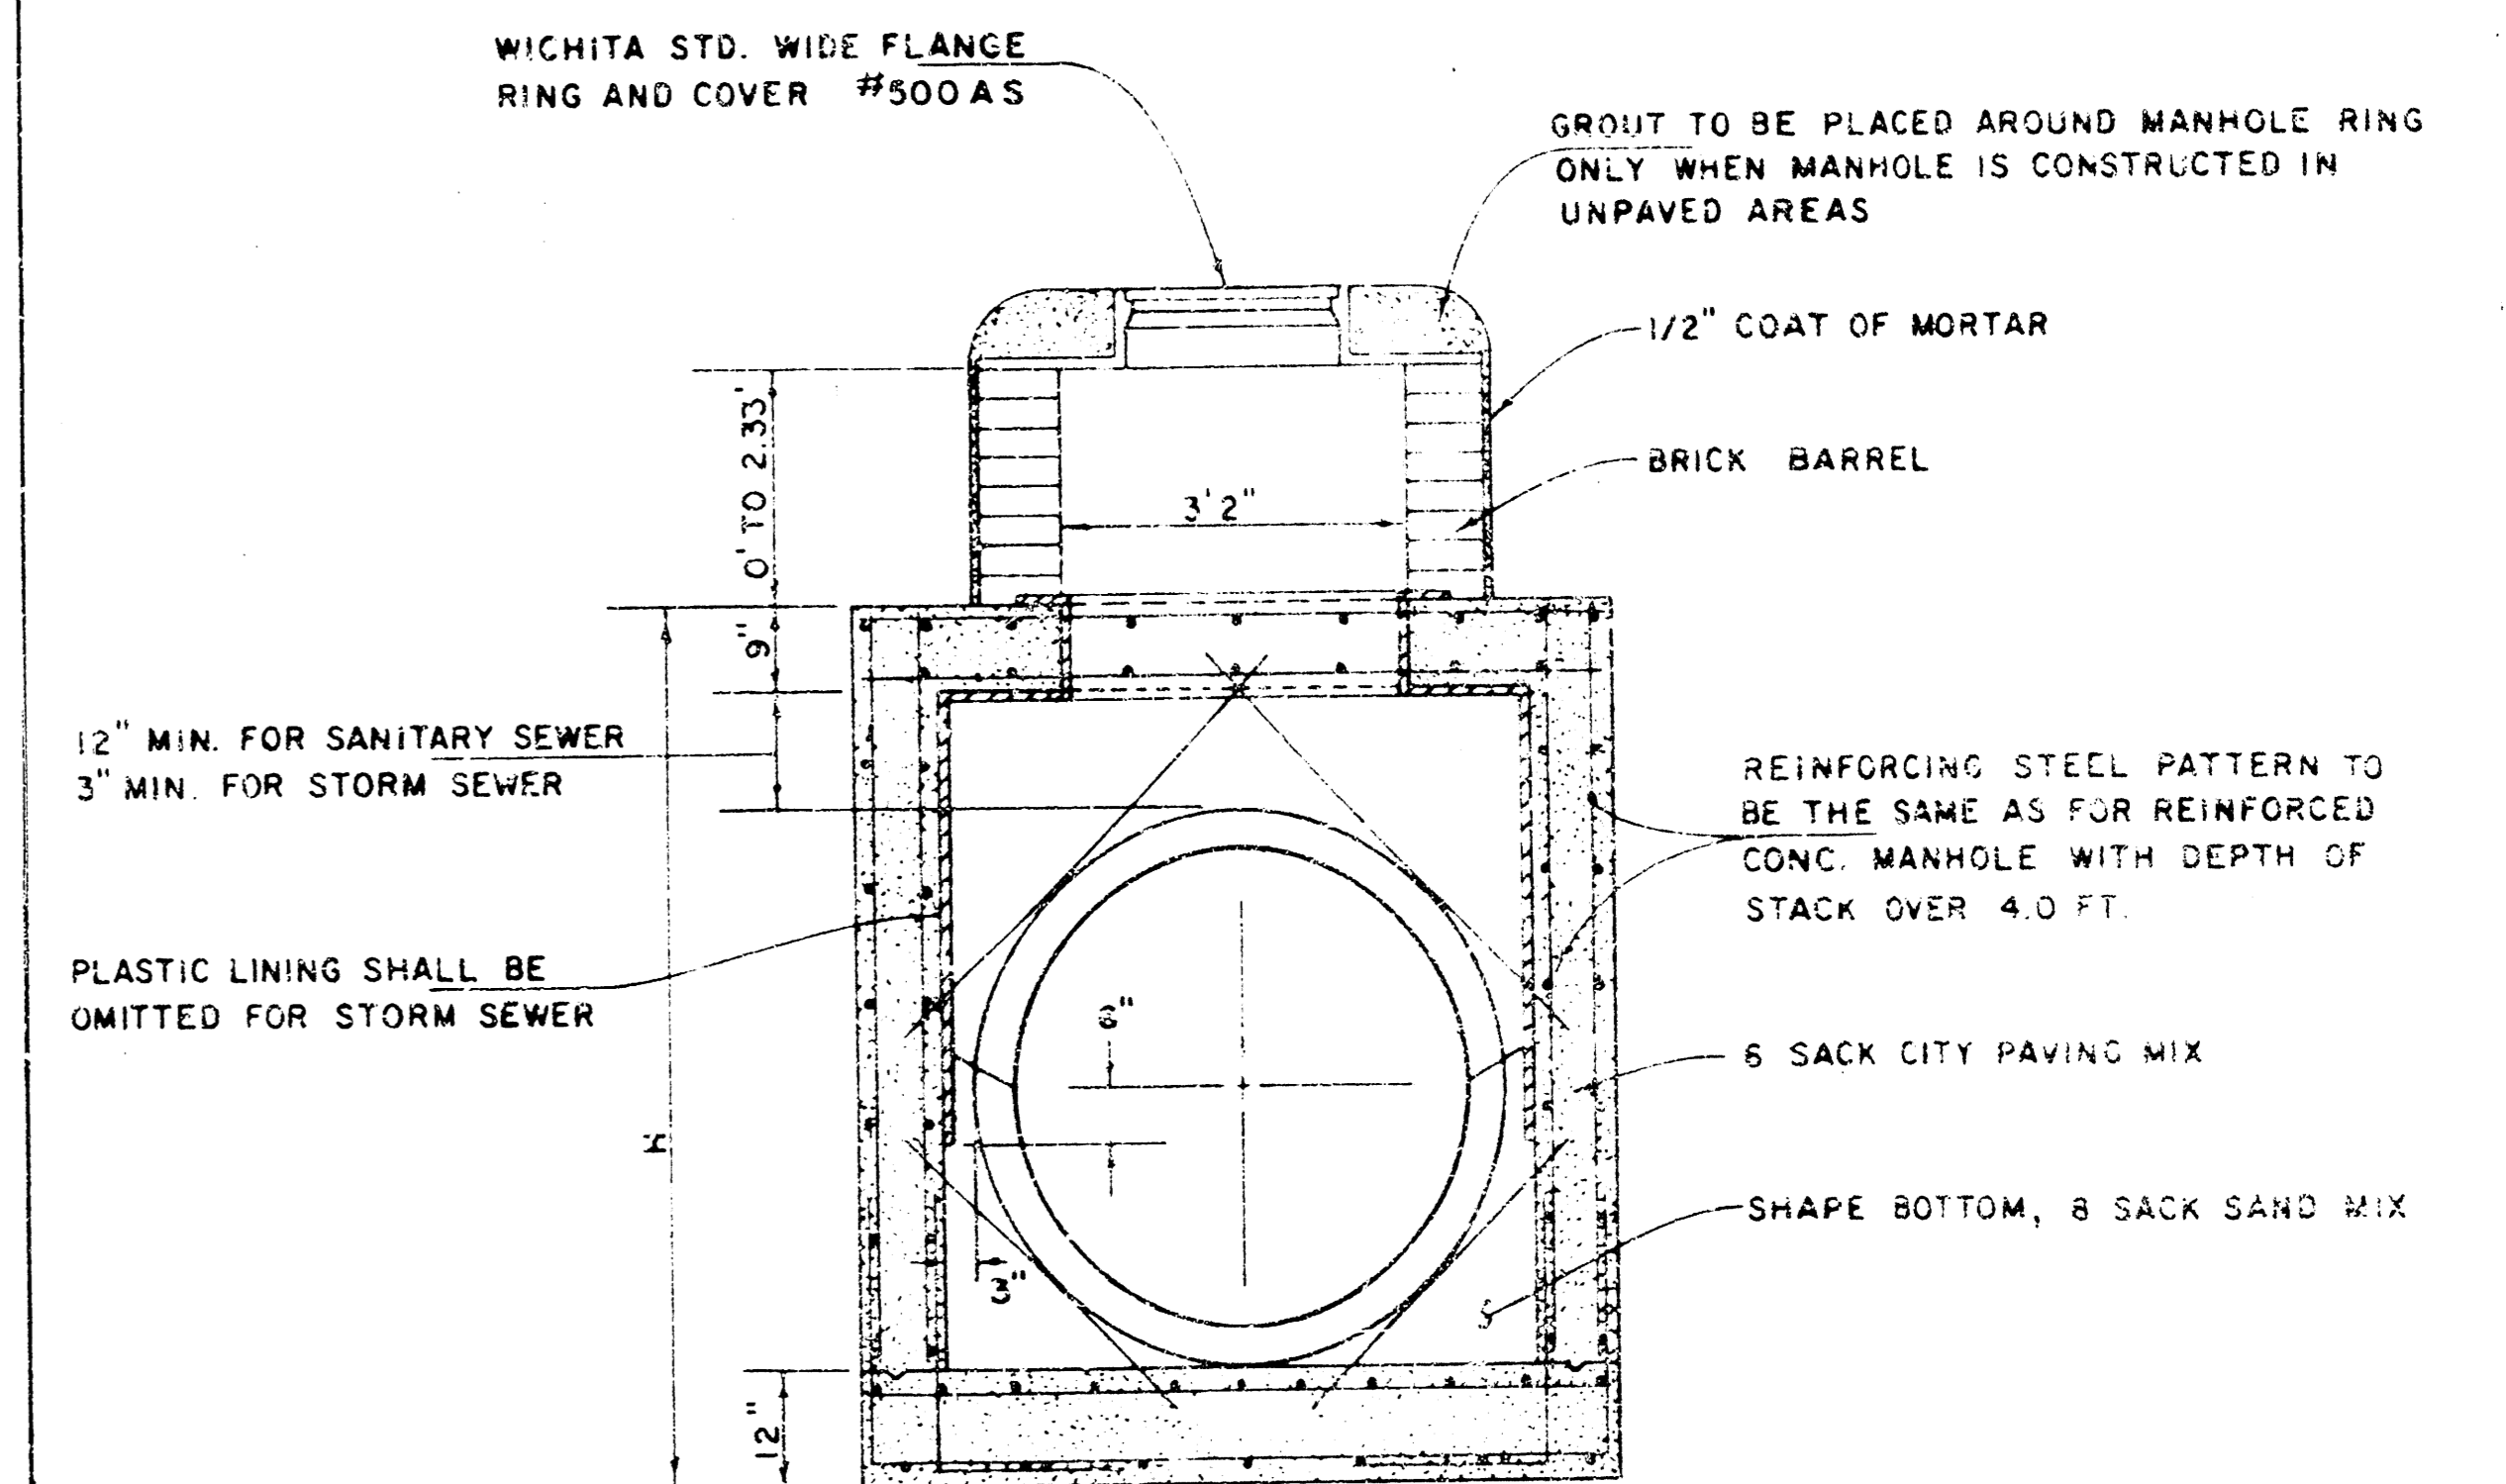

REINFORCED CONCRETE MANHOLE
DEPTH OF STACK: 0' TO 2.33'
SCALE 1" = 2'

STANDARD DETAILS
REINFORCED CONCRETE MANHOLES

CITY OF WICHITA
DEAN S. SELLERS - CITY ENGINEER
APRIL 1978