

Market - S.E. Corner - S.E. English

New Section - Remains Hypothesis

Point A on
Continued Work

Market

New Section

Remains Hypothesis

420

Remains
Hypothesis

Elm
75

50

15' R

50

70

10
11
12

THIRD ST

CENTRAL AVE

600'

New gutter

Downspout removed

25'

80'

Post Street Light

New gutter

downspout removed

Remove

curb

install new

downspout

downspout

70'

Take out

base

SECOND 54.

New letter remove old Stone letter

600

37 - Case 111111
101111

Use G.R.

THIRD ST.

1000
 1000 to 3000
 10000
 100000

Close Drive
North Hotel
Kensington
No. 100

New Search

~~SECRET~~ *SECRET*

About half (100)

James Leonard Brown
and Sumner
Howard Brown.
Part 1.

WILLIAM

130'

36'

120'

DOUGLAS

Hard Rock

Hard Rock


8"


Crown Exposed
Boulder Layer
Pavement

150'

16'

120'

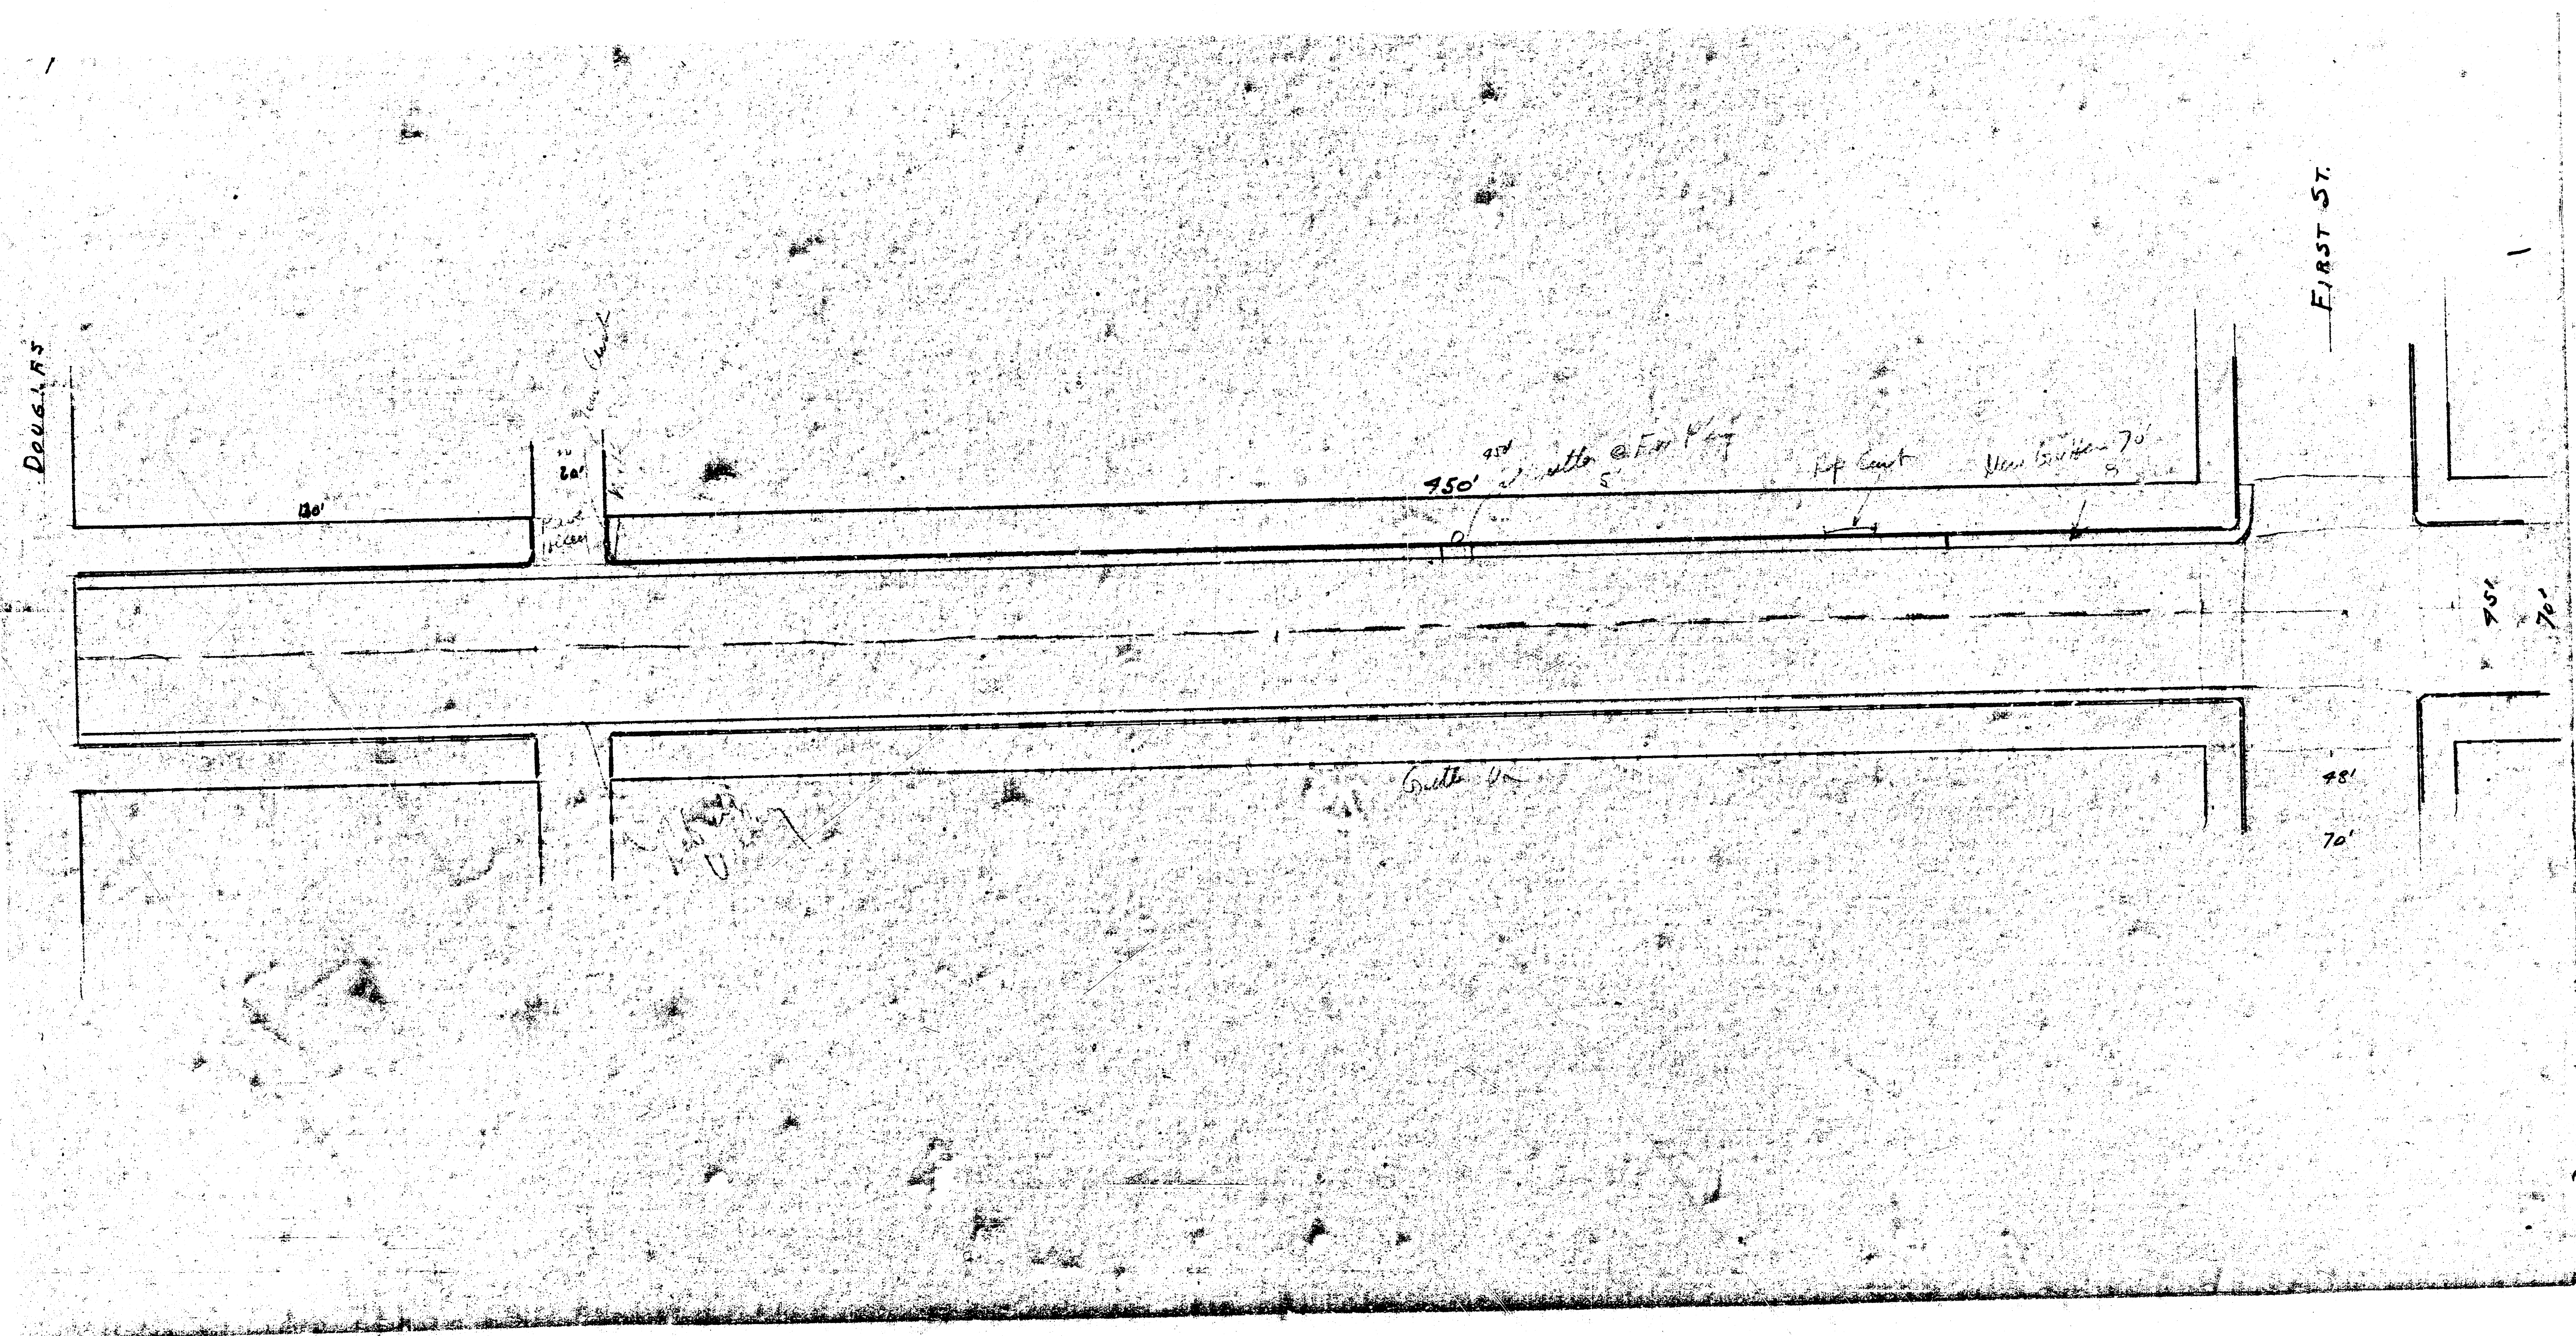

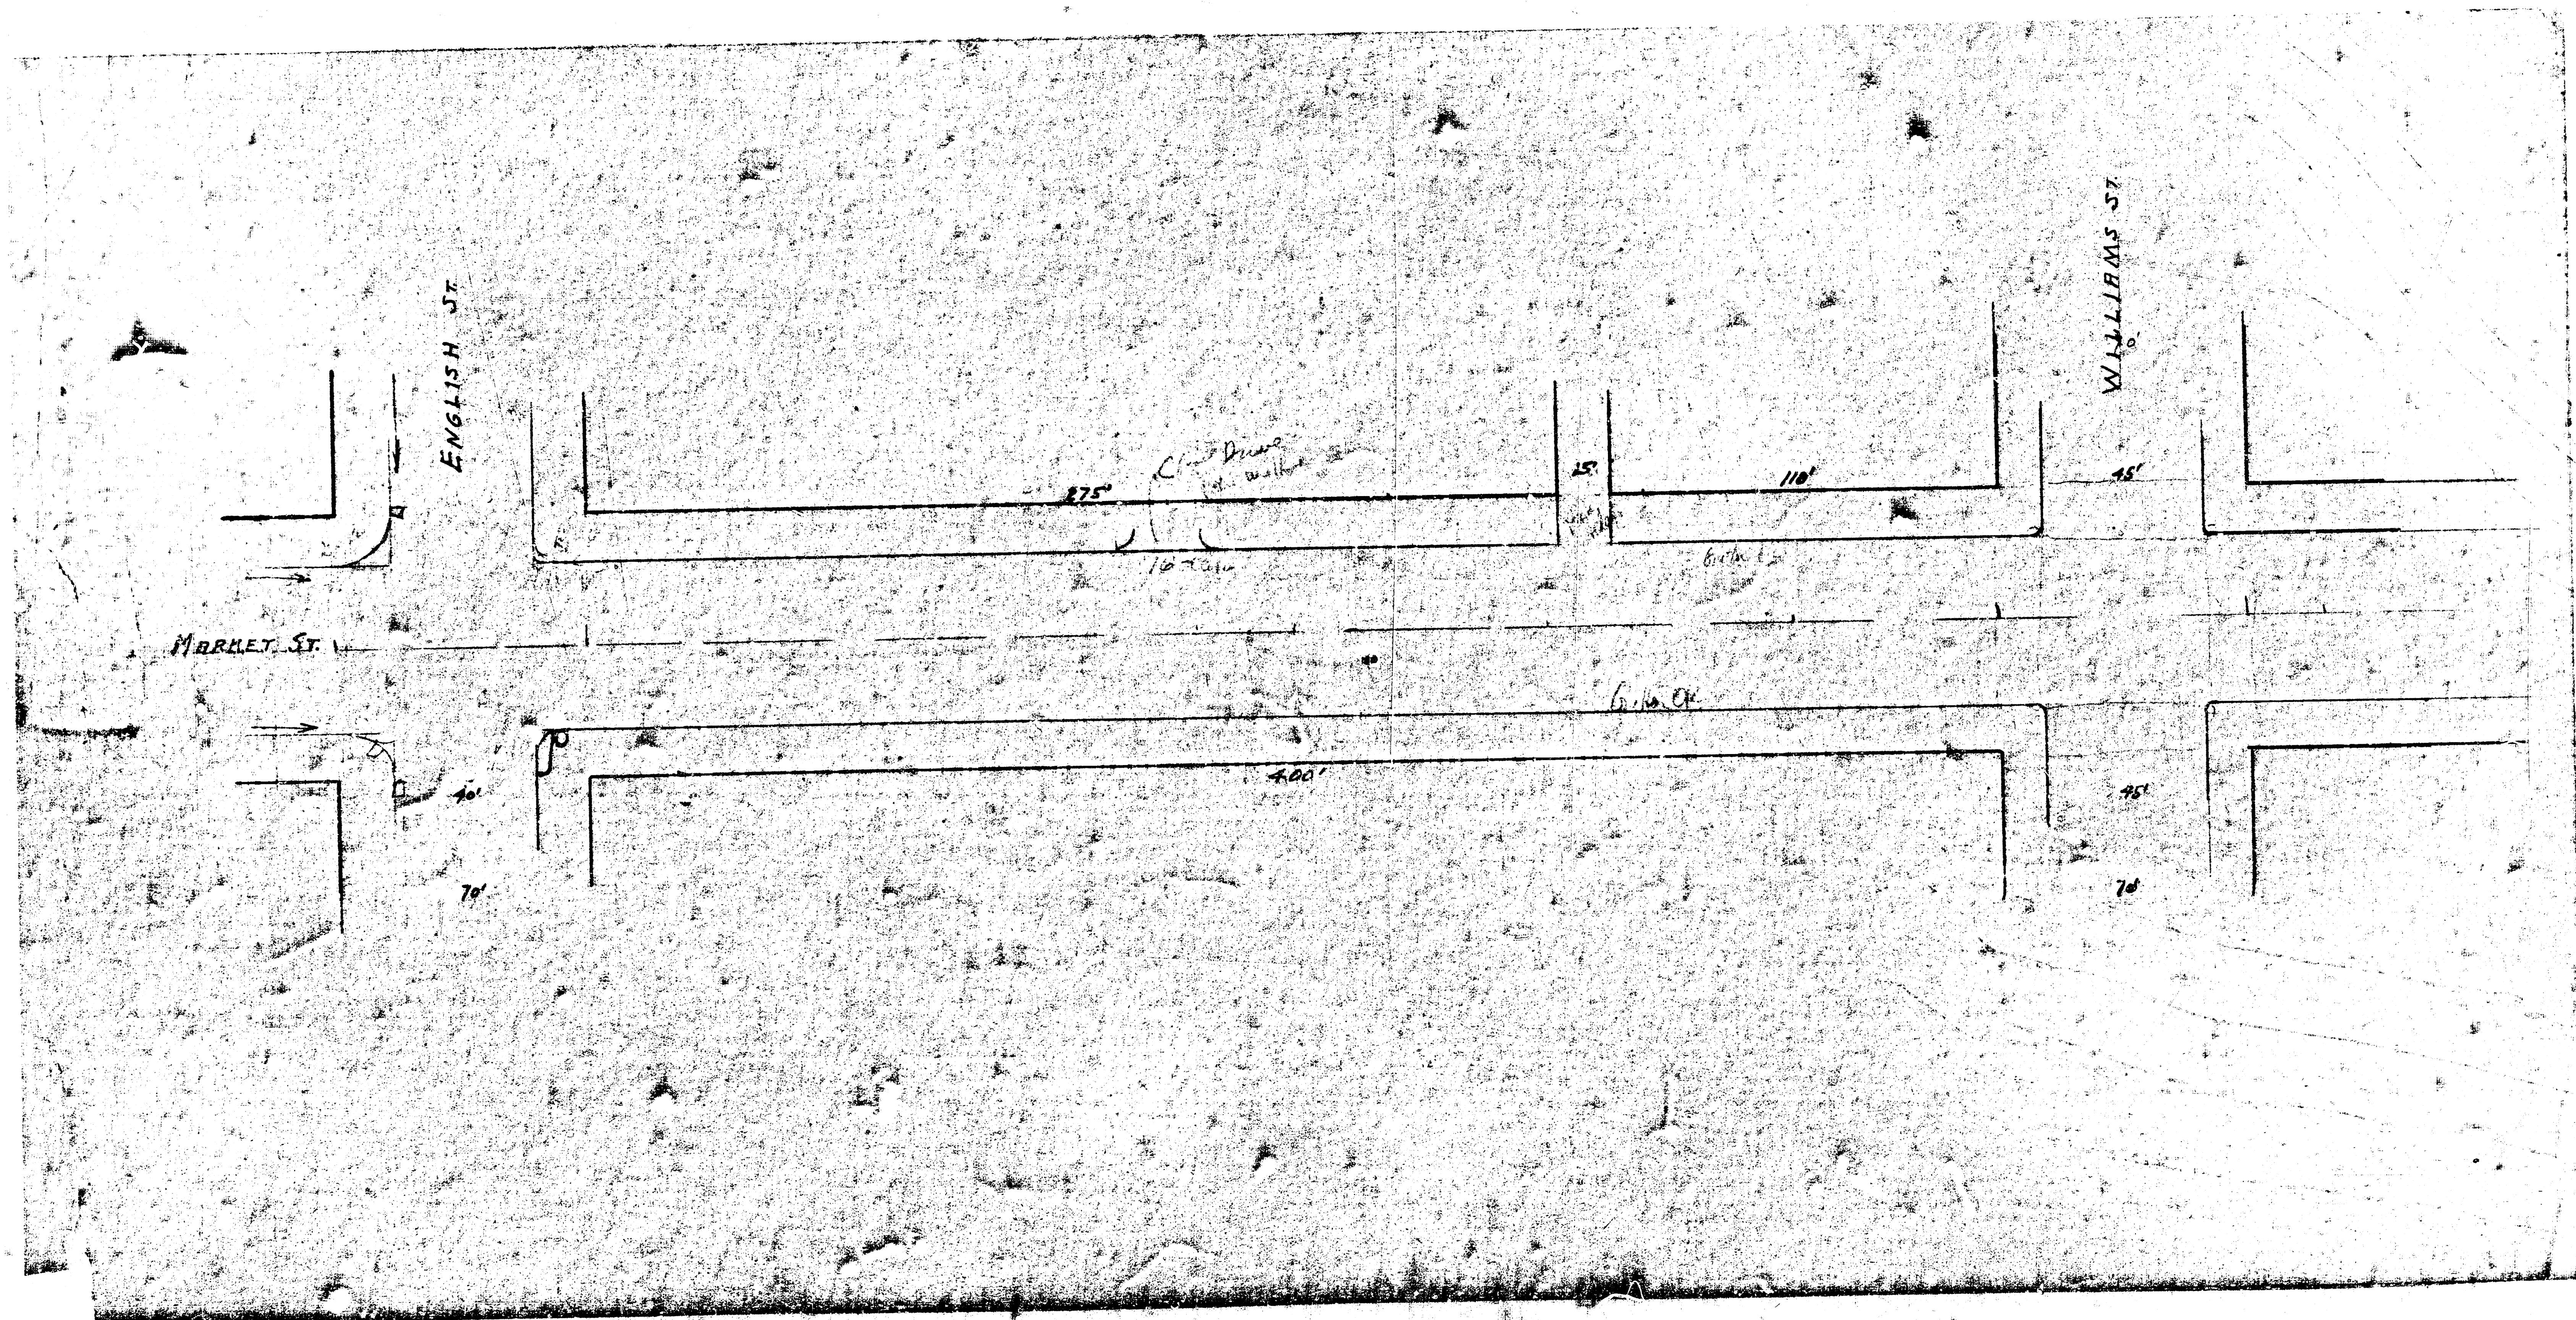

FIRST ST

Grade Road

80' x 6'

600' 600' New curb except 75' in front of Peckham house

Settling tank & oil separator proposed to front of - replace

SECOND ST

New gutter - narrow down Repair
20' curb & lawn with
236

Eliminate raised
crossing in Market
Square of C. & O.