



BM 103.21 "G" 1' W. of E. End N. Curb NE Cor. Millwood & Merton
 BM 104.15 "G" in Globe 1' E of W. End S. Curb SW Cor. Merton & Eligebeth
 BM 108.02 SE Cor. Conc. Patch on NW Cor. Dodge & Merton
 BM 103.27 "G" in Globe 3' E of W. End N. Curb on NW. Radia Dodge & Merton
 Base Line is on Center Line of Merton

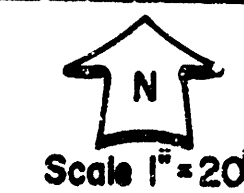

NOTE:
 Contractor to clear right-of-way and grade
 parkings for proposed sidewalk. Sidewalk to
 be constructed by others.

NOTE:
 Sta. 0+49 to 1+40(21) Do not damage fence.
 Const. sidewalk to clear fence and to match
 existing ground elevation.

If property owner desires a driveway,
 it must be located east of the house.

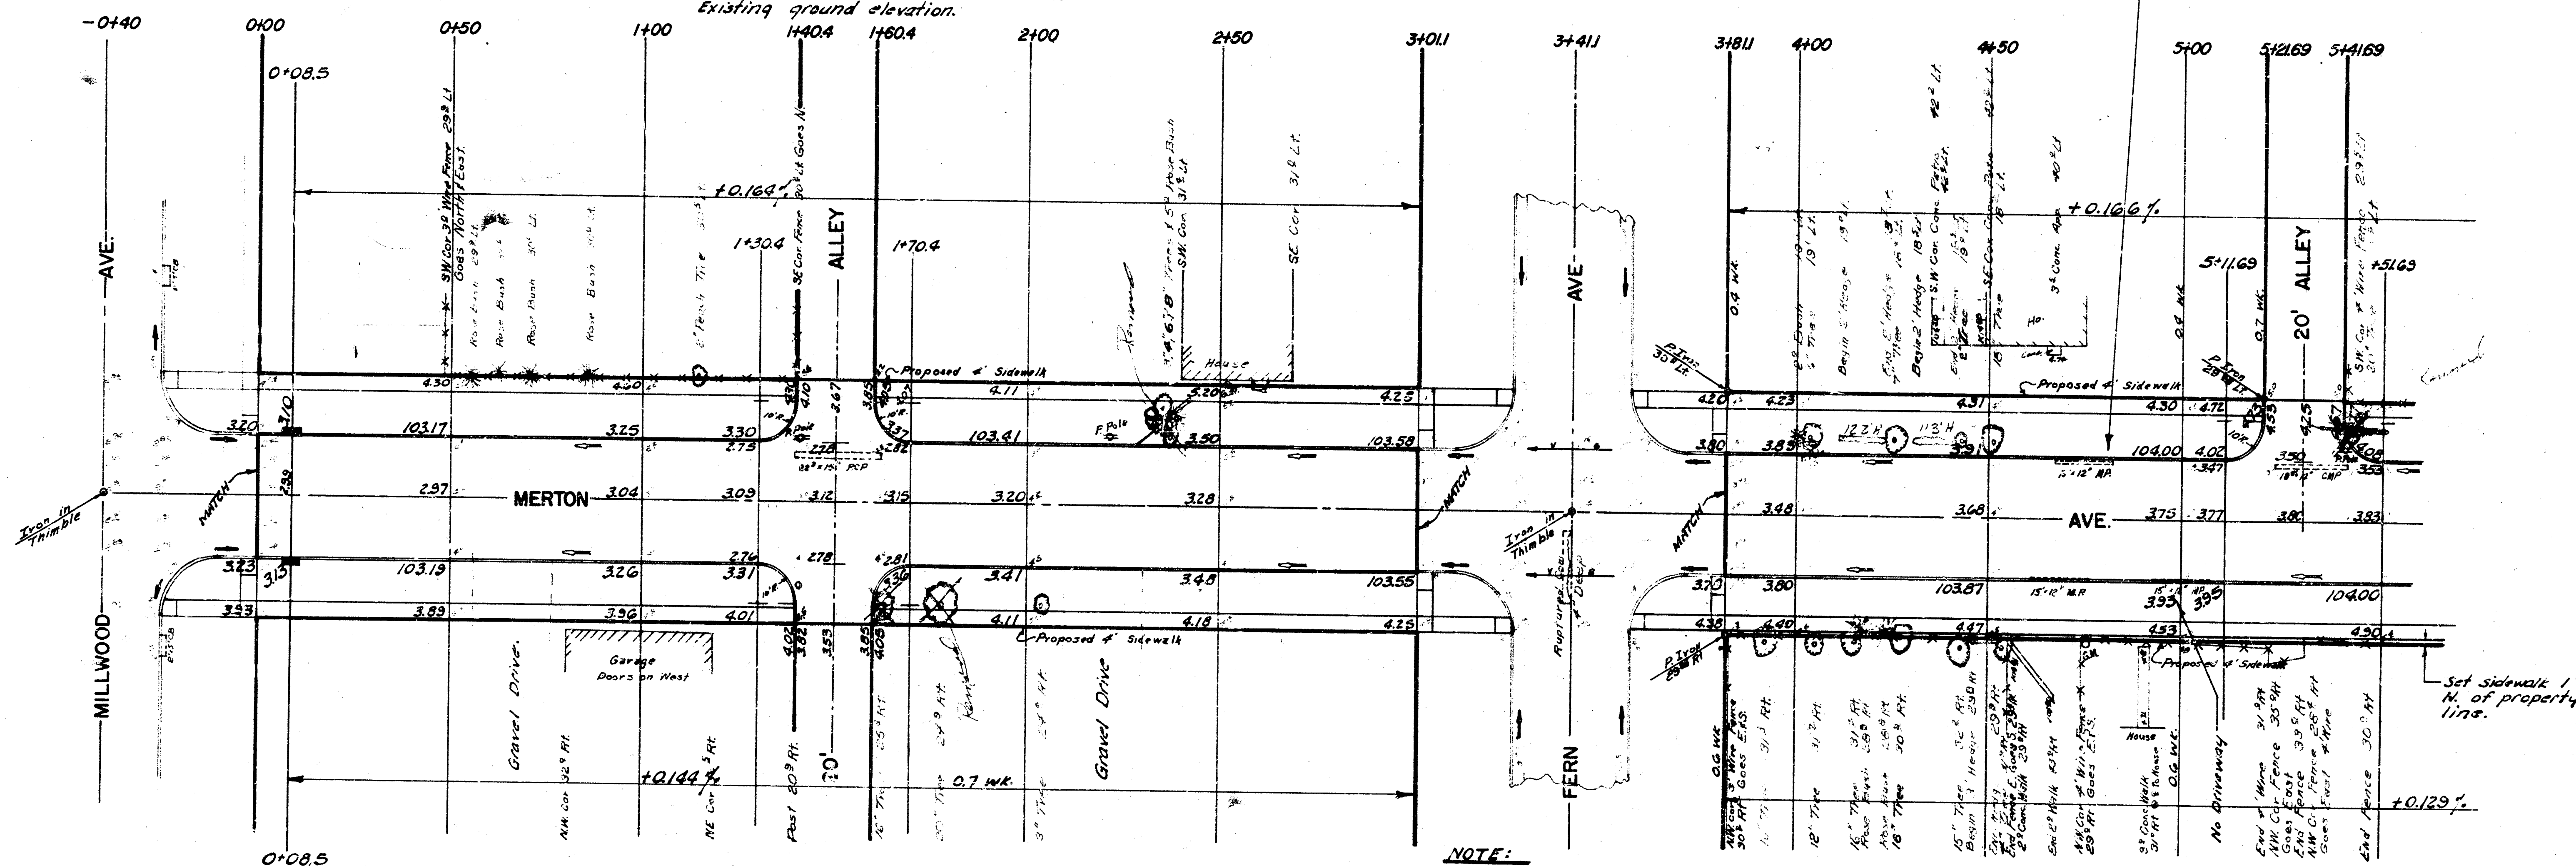


NOTE:
 Repair pavement in intersection
 as needed. Saw and remove and
 replace.

EXCAVATION	
PROPERTY	CITY
2144 Cu Yds.	248 Cu Yds.
214 " "	25 " "
Totals 2358 Cu Yds.	273 Cu Yds.

COMP. FILL	
PROPERTY	CITY
12 Cu Yds.	1 Cu Yds.
1 " "	" "
13 Cu Yds.	1 Cu Yds.
673 " "	150 " "
686 Cu Yds.	151 Cu Yds.


Sub-grade Modification

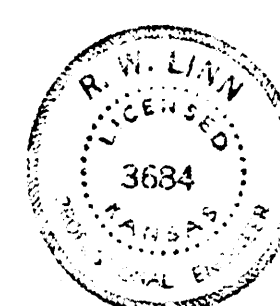

MERTON AVENUE
 EL. MILLWOOD AVE. to WL DODGE AVE.
 30' CONC. and CURB
 City of Wichita, Kansas
 BE. SMITH City Engineer
 Proj. No. C18-121 Date MAY 1949

1/6

Surveyed
 Proposed
 Existing
 Checked

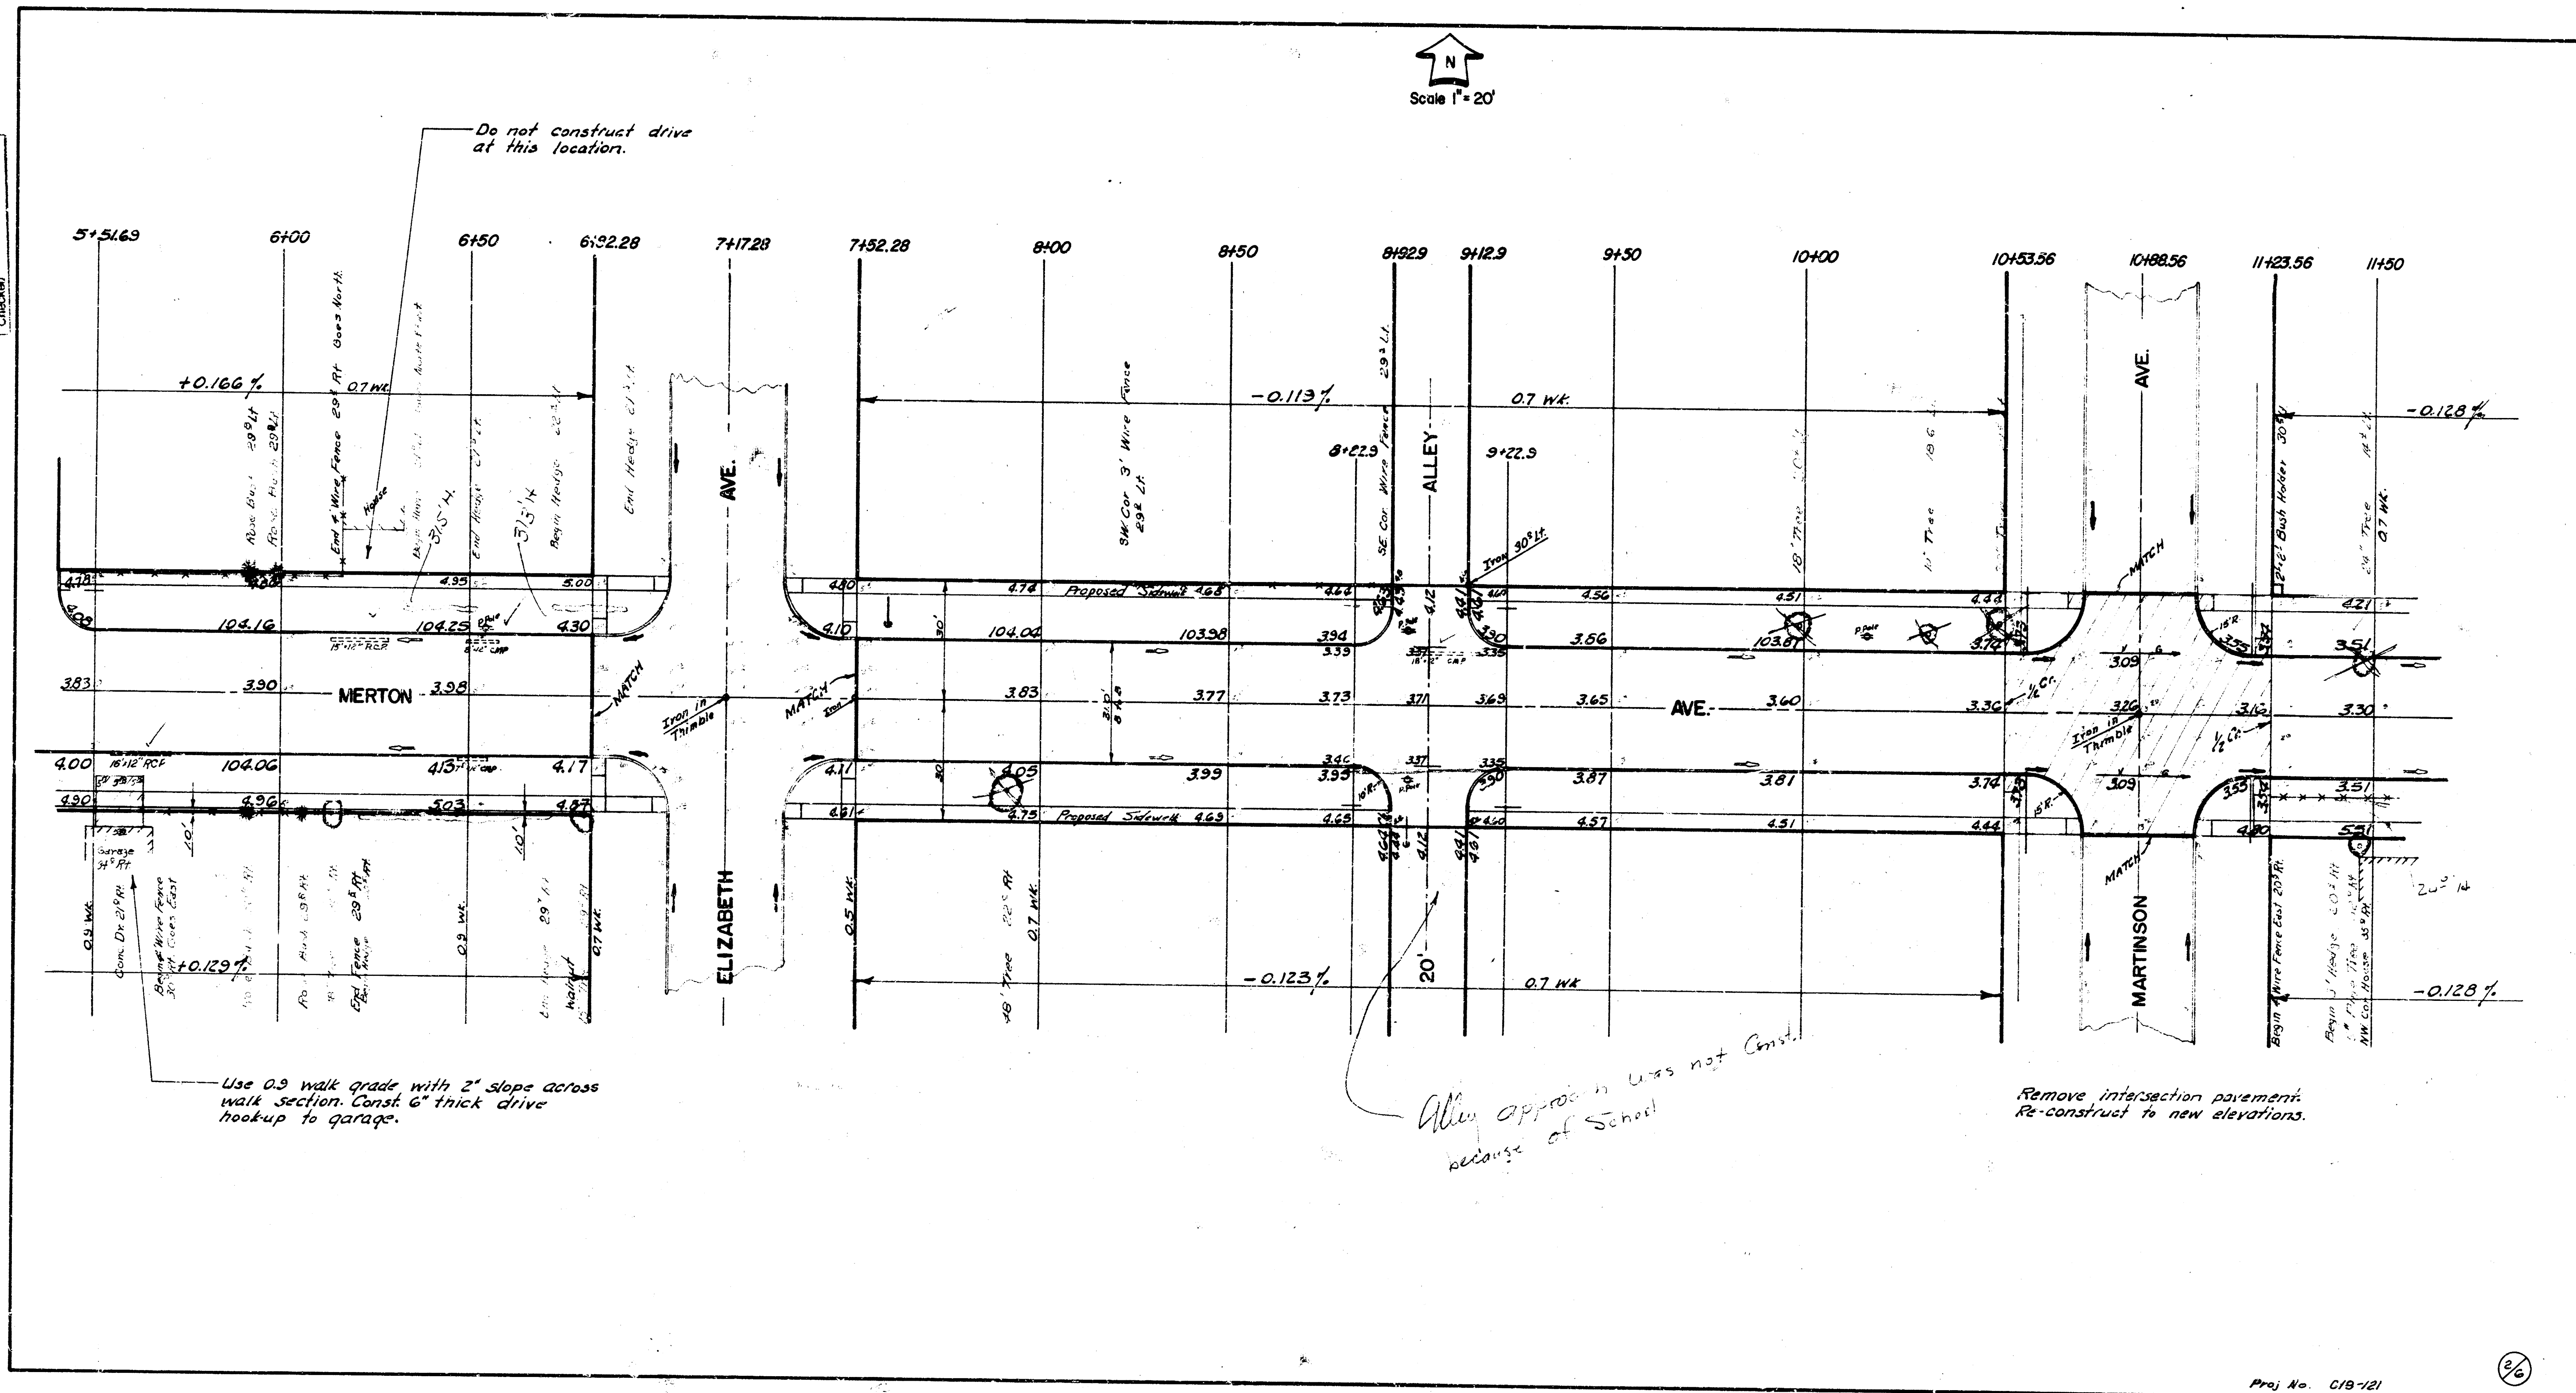

Grade alley approaches to match new pavement. Cost is incidental to paving.



— Remove fence only where necessary. Sidewalk grade to match existing ground except at alley return.

