



PAVING PLAN 1943

~~MINNEAPOLIS~~ LN - SL. LEVY to NL. HODSON

COMB. CB. & GTR. ONLY

Note: This plan is for grades and excavation only. The final alignment has been made in the field by CH. Mills. Stakes and control points have been located in the field.

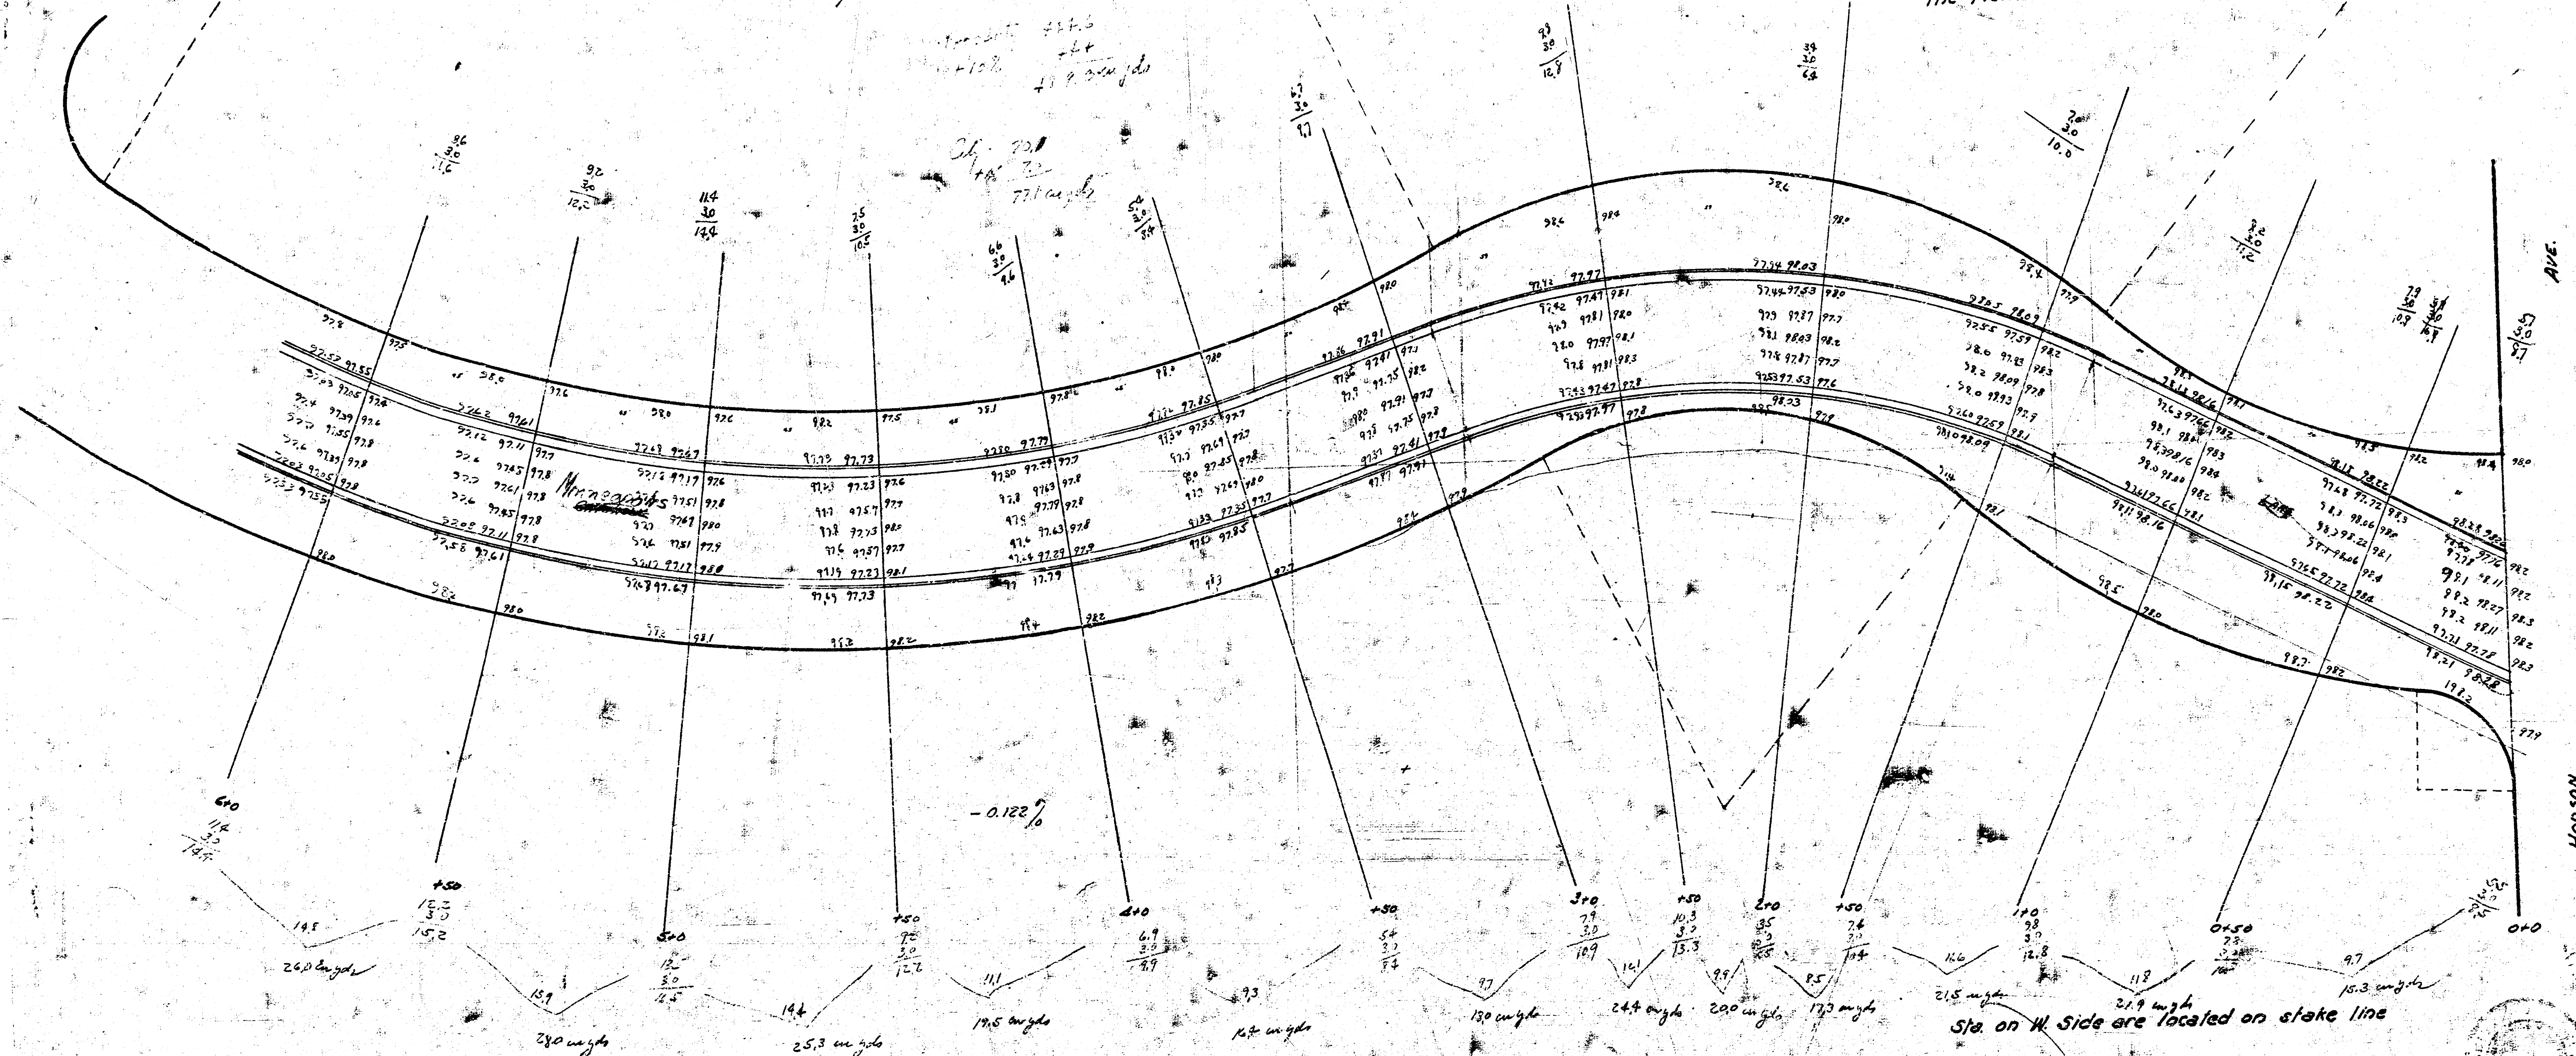

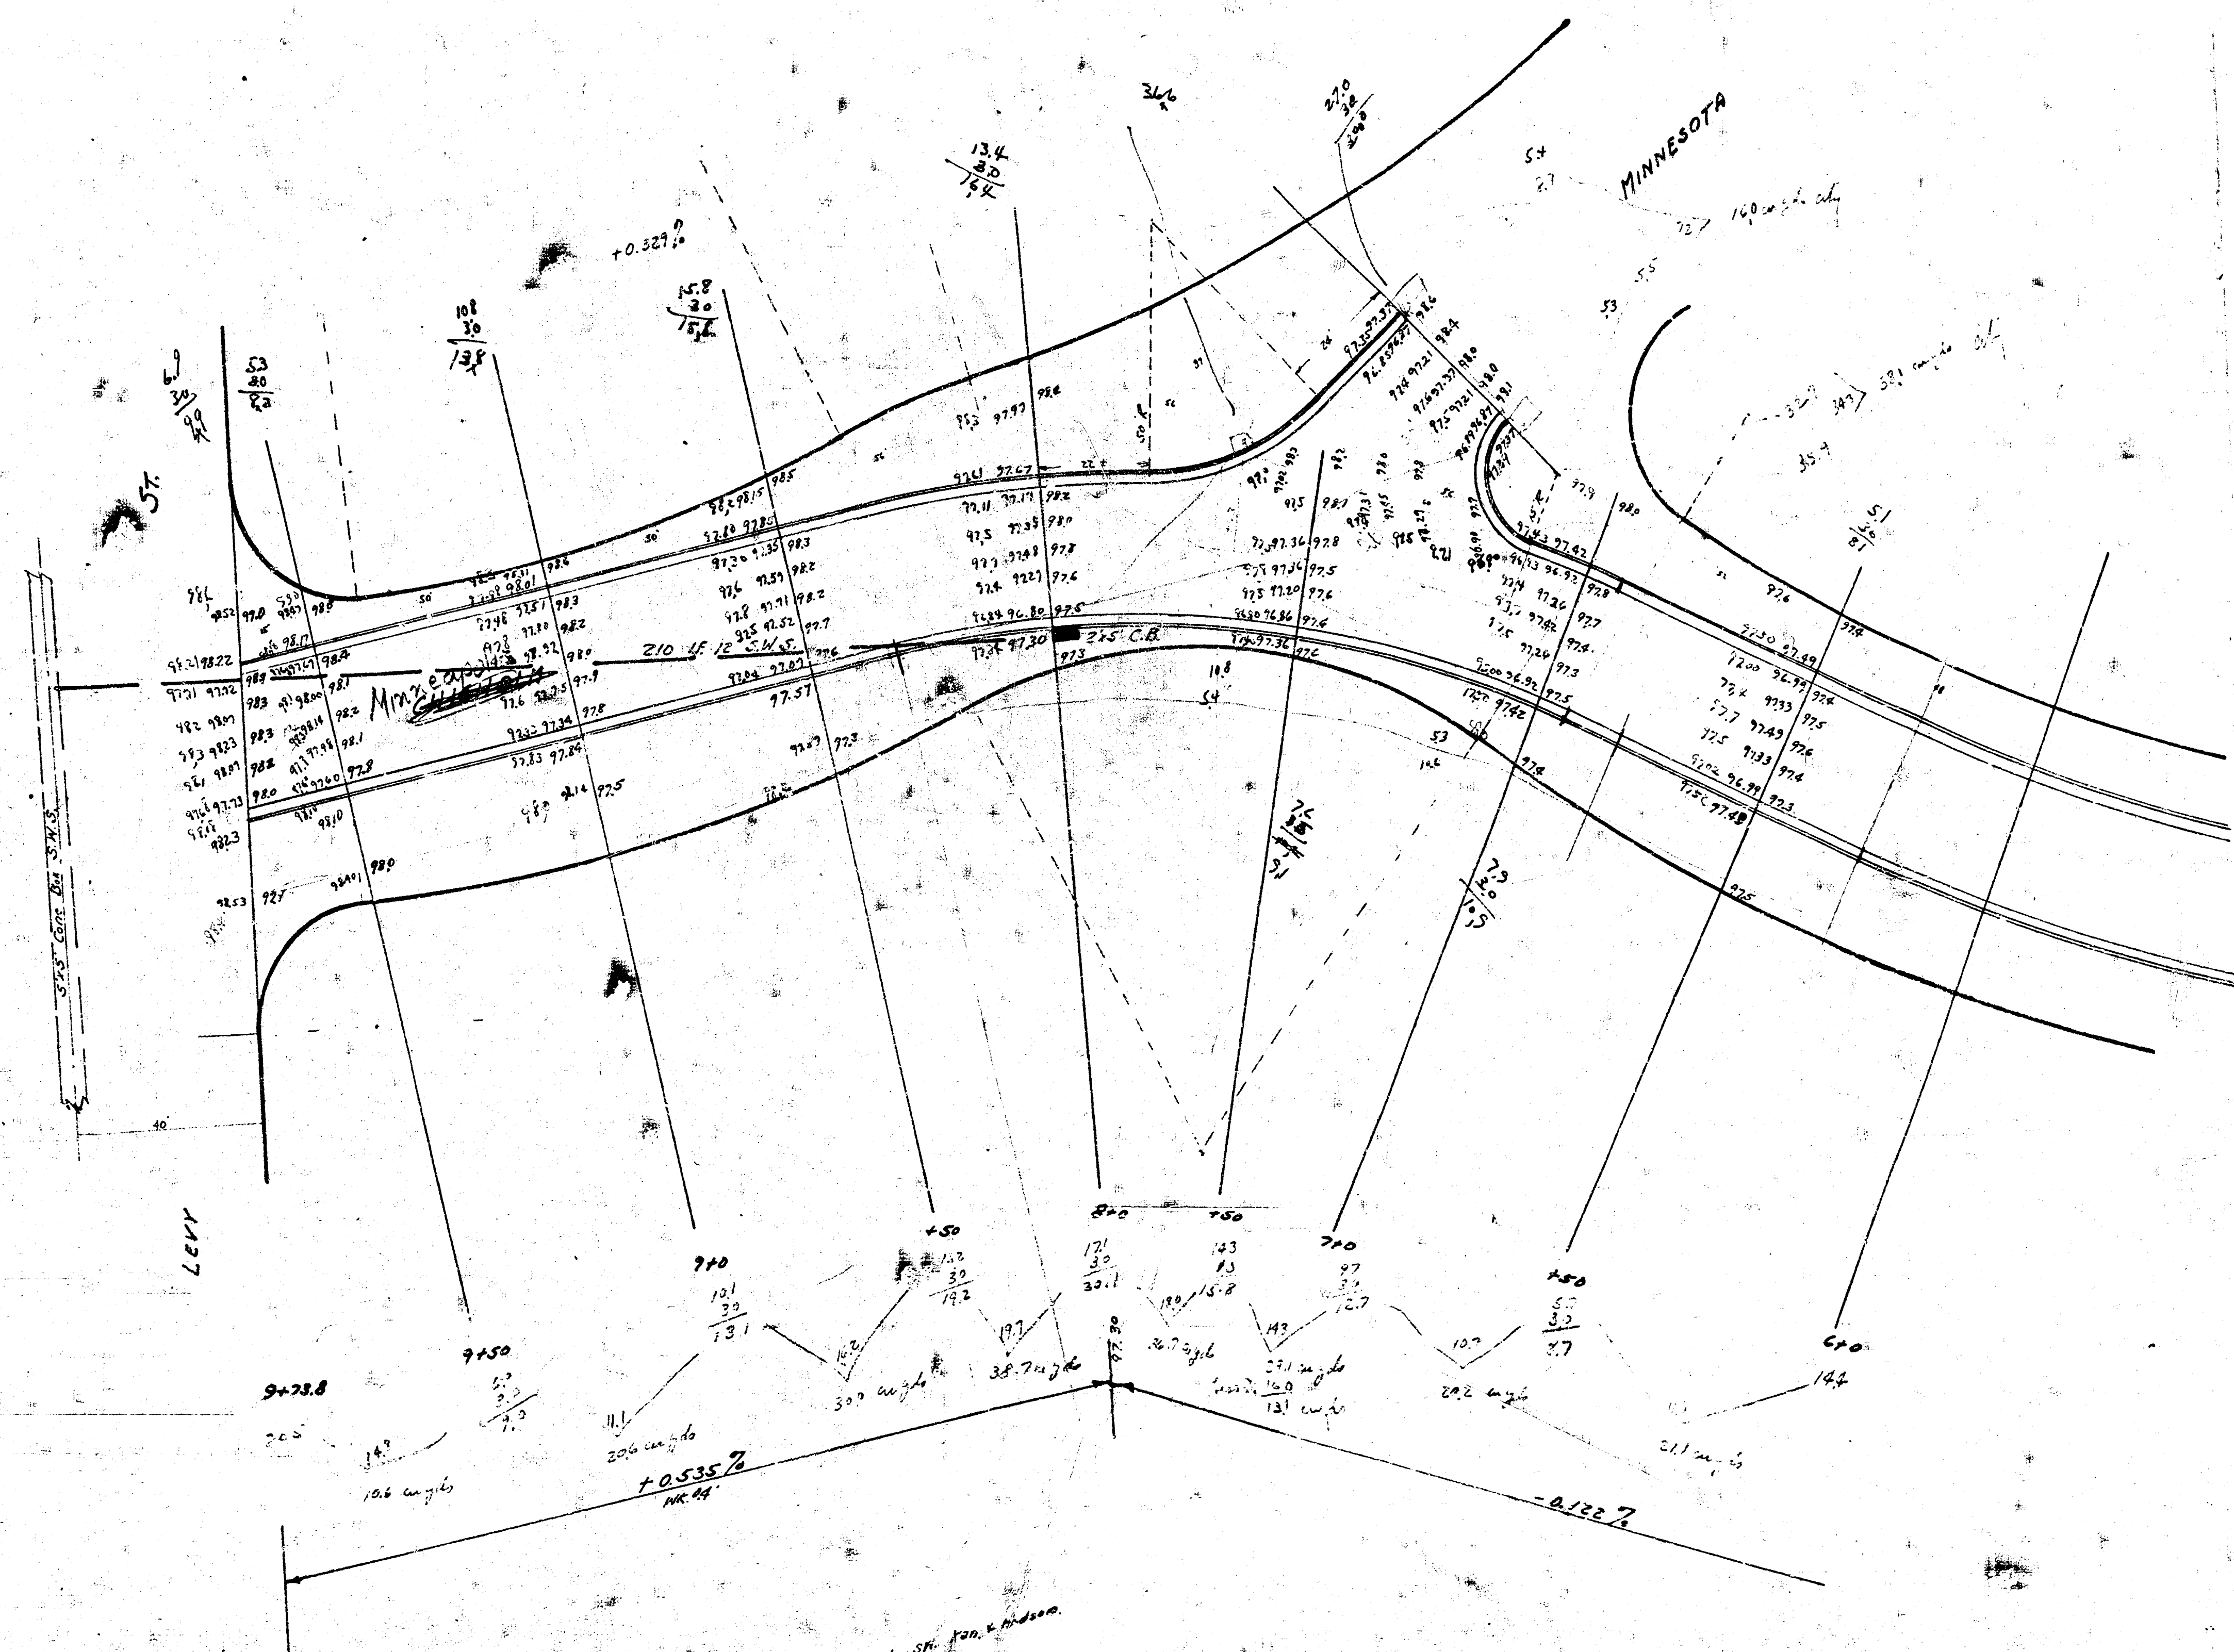

B. 17. 97.45 145. cor conc. parob St. Kar. & Hudson