

GENERAL NOTES:

1. The Contractor shall comply with all applicable safety regulations. All construction shall be completed following current City Standard Specifications and special Provisions.
2. Contractor will be required to provide notice to utility companies a minimum of seventy-two (72) hours prior to any excavation, as follows:

Kansas One-Call 687-2470

The Contractor must notify the following in case of an emergency:

AT&T 1-800-246-6464
Black Hills Energy 1-800-694-9899
City of Wichita Water & Sewer 1-316-219-8921
City of Wichita Stormwater 1-316-268-4090
City of Wichita Traffic 1-316-268-4034
Cox Communications 1-888-249-3530
Kansas Gas Service 1-888-482-4950
Westar Energy 1-800-544-4857

3. Utility service lines, poles, etc. are to be adjusted as necessary by others prior to construction unless the plans specifically call for their adjustment by the Contractor or unless the plans specifically identify a utility to be adjusted by its owner during construction. Existing utilities and their location, as shown on the plans, represent the best information obtainable for design. The Contractor will be required to work around existing utilities within the right-of-way which do not conflict with proposed construction.

4. Rubble from the removal of miscellaneous structures and excess excavation which is to be wasted shall be disposed of on sites to be provided by the Contractor. These sites shall be approved by the Engineer as to suitability, appearance and site location. Locations, in the opinion of the Engineer, that will leave and unsightly appearance will not be approved. All disposal sites must be approved by the Kansas Department of Health and Environment. Material either stockpiled or disposed of in a flood plain would require a Kansas State Board of Agriculture permit. Any material dumped in waters of the United States or wetlands is subject to U.S. Corps. of Engineers permitting regulations. Any material buried or stockpiled beyond approved construction limits will require additional archaeological investigations unless buried in a previously approved borrow location.

5. Trees and shrubs in public right-of-way which are in direct conflict with proposed new construction shall be removed by the Contractor with the City Engineer's approval. Trees and shrubs which are not in direct conflict with proposed new construction shall be saved and protected from damage.

6. The Contractor shall give all property owners and/or tenants of developed property abutting the construction of this project a minimum of ten (10) days notice prior to start of construction.

7. The Contractor shall be responsible for preserving property irons. The Contractor will be required to re-establish any property irons which are damaged or destroyed by his construction operations. Such irons shall be re-established by a licensed land surveyor in accordance with state laws.

8. The Engineering Division shall field locate water valves one time during construction when requested by the Contractor. It shall be the Contractor's responsibility to preserve such field locations during the construction process. Water valves, valve boxes or fire hydrants damaged during construction shall be repaired by Contractor at his own expense. Valve boxes and water meters within the project limits shall be adjusted to match field grades by the contractor.

9. The Contractor shall notify the consultant engineer and Dawnita Reinhardt at 316-650-0740 with the City of Wichita with the anticipated construction start date and notify them of project completion. Staking and inspection for this project will be the responsibility of the Contractor.

10. If traffic will be impacted by construction, a traffic control plan must be submitted and approved by the project engineer before construction can begin. The Contractor shall be responsible for all traffic control measures to facilitate construction. All construction zone markings and signage shall conform to the latest version of the Manual on Uniform Traffic Control Devices(MUTCD) as published by the US Dept. of Transportation, Federal Highway Administration. All costs associated with construction markings and signage shall be the Contractors responsibility.

11. All elevations shown are NAVD 88.
12. All areas disturbed during construction that will not be under proposed pavement shall be restored to match existing conditions.
13. City Maintenance of sanitary sewer mains ends at last structure within the easement or right-of-way.
14. All stubs and capped pipes shall be located with green plastic tape in the same manner as risers. Contractor shall limit the extent of trench open overnight and weekends to less than 50 feet.

15. Connecting to Existing Manholes:
Prior to laying sewer lines using existing stubs in existing manholes, the Contractor shall expose and verify the elevation, grade and alignment of existing stubs and notify the Engineer of any deviation from the plans. Where the stub is unusable due to elevation, grade or alignment, the Contractor shall remove the stub and plug the hole, and reshape the existing manhole invert to provide smooth flow. Where connecting to an existing manhole that does not have an existing stub, the Contractor shall core cut into existing manhole wall to make connection using approved water stop gasket, and reshape the existing manhole invert to provide smooth flow. The cost to connecting to existing manholes is incidental to the project.

16. Contractor shall limit the extent of trench open overnight and weekend to less than 50 feet.

17. Contractor shall provide positive drainage away from all manhole covers.

18. The Contractor shall prevent any construction debris from entering the existing sanitary sewer during construction.

19. Any over excavation from manhole and pipe removal shall be backfilled with AB-3 compacted to 90-95% ASTM D698.

20. The Contractor shall prevent from damage and support existing utilities through construction as approved by the utility owner and the Engineer at the contractors expense.

21. All excess excavation shall remain on-site and shall be stockpiled or spread at a location determined by the engineer.

22. Contractor shall grade around exposed manholes at a 1:1 slope. Manholes set lower than existing grade shall have a 9" berm constructed around manhole to prevent infiltration into sanitary sewer system. Cost of dirt, labor, equipment, etc. to be incidental to cost of manhole.

23. All areas disturbed during construction shall be seeded, mulched, and fertilized as follows (Permanent Seeding):

Seed: Kansas Premium Fescue Blend:8 lbs/1000 sq. ft.
Mulch: Prairie Hay: 2 tons/acre
Fertilizer: 12-24-12: 850 lbs./acre

All costs associated with seeding, mulching, and fertilizing shall be included in bid term "Seeding". All seeding operations shall conform to City of Wichita Standard Specifications.

24. The Contractor shall not begin work on the project until the Project Inspector is assigned and on site. Any work completed without inspection will be required to be uncovered for inspection at the Contractor's expense.

25. All existing and proposed erosion control measures including silt fences, erosion control mat, straw bales, inlet barriers, and const. entrance shall be maintained throughout construction by the contractor and until project is accepted by the City of Wichita. The on-site engineer shall complete weekly reports on the status of erosion control measures. The contractor shall be required to comply with maintenance and/or replacement of erosion control measures as determined by the on-site engineer until project is accepted by City of Wichita. Maintenance and/or replacement of erosion control measures to be paid by L.S. bid item "Site Restoration".

26. See the City of Wichita Construction Specifications for construction, installation requirements for this project.

Benchmarks

Site Benchmark - 1
Rebar #4 at N 1678460.29, E1694305.47
Elevation = 1316.05 (NAVD 88)

Site Benchmark - 2
"X" chiseled on top of culvert pipe at N 1678481.08, E1695285.83
Elevation = 1315.04 (NAVD 88)

Control Points used for GPS As-Built Survey Shots.

AS-BUILT PLANS

SANITARY SEWER

to serve 13800 E Harry

TGC Addition


Wichita, KS

Paul Gunzelman, P.E. City Engineer

2025-008226PPS

(53030982)

BAUGHMAN JOB #: 25-06-E154

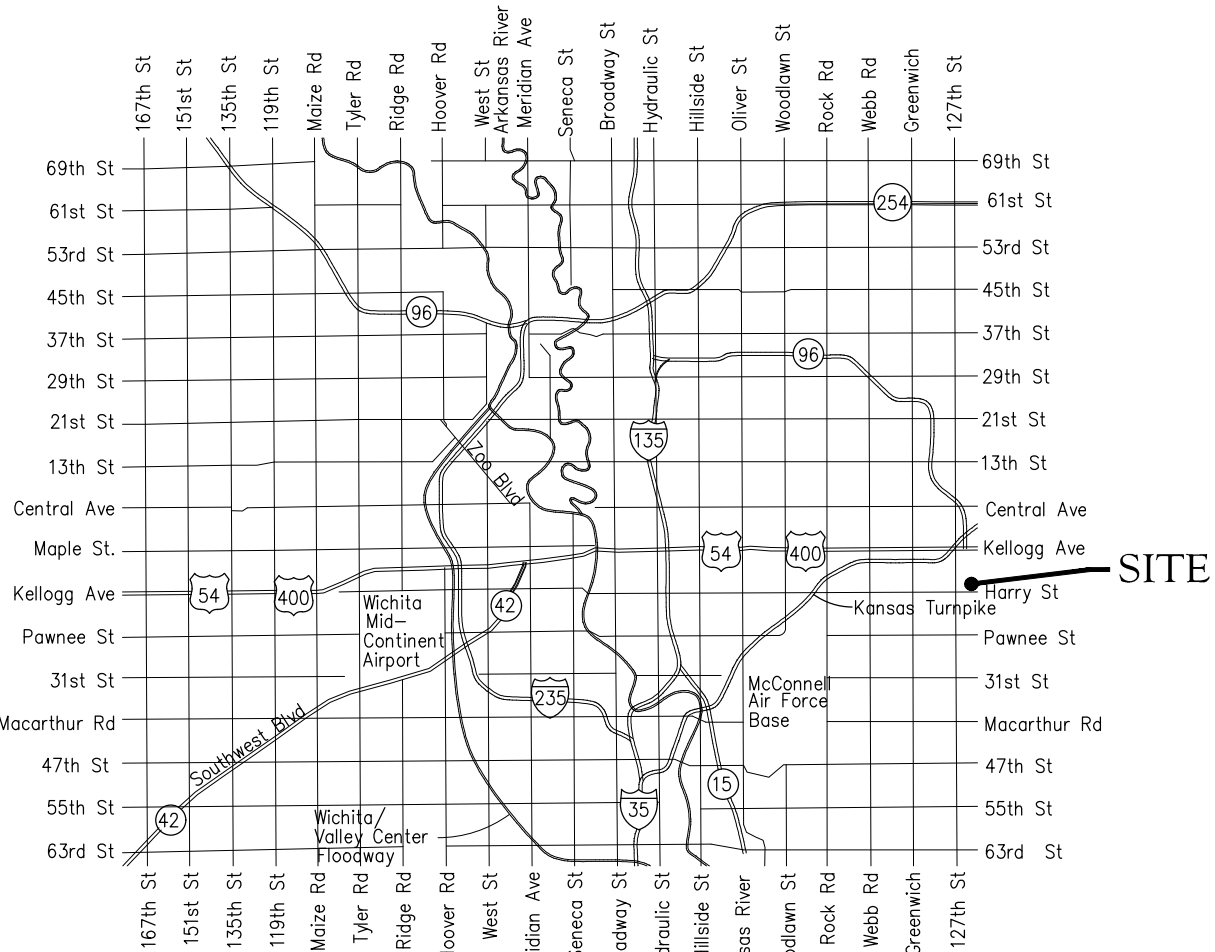

Vicinity Map

Sheet Index

Title Sheet	1
Line 1	2
Erosion Control Plan	3
Manhole Detail	4
Manhole Lid Detail	5
Erosion Details	6-10
Copy of Plat	11

Begin Construction = 8-25-2025
End Construction = 9-12-2025

Accepted & Released: October 17, 2025

APPROVED AS NOTED
BY WICHITA PUBLIC WORKS
ENGINEERING DIVISION

Engineering approved by Shawn Mellies on 04/21/2025

Utilities approved by Scott Macey on 04/21/2025


NOTE TO CONTRACTORS

Inspection and testing for this project is to be provided by a Licensed Consulting Engineering Firm under contract with the Owner/Developer. Said Inspection to be in accordance with the City of Wichita standard construction engineering practices and certified by a Licensed Professional Engineer in the state of Kansas. No work shall be performed by the Contractor without such inspection nor shall any work be commenced without written authorization by City Engineering. All Construction and Materials shall comply with the current City of Wichita Specifications and Standards and Special Provisions (on file and available at Wichita.gov).

An approved copy of these plans signed by City staff are required on-site.

Utility Contractor = Fremar Corporation.
Construction Staking = Baughman Company.
Inspection = Baughman Company.
Inspector = Fred Smith.
As-Built Plans by: Larry Powell
10-13-2025

Structures = Wichita Concrete Pipe.
Frame + Lid = Deeter.
8" PVC Pipe = Westlake.

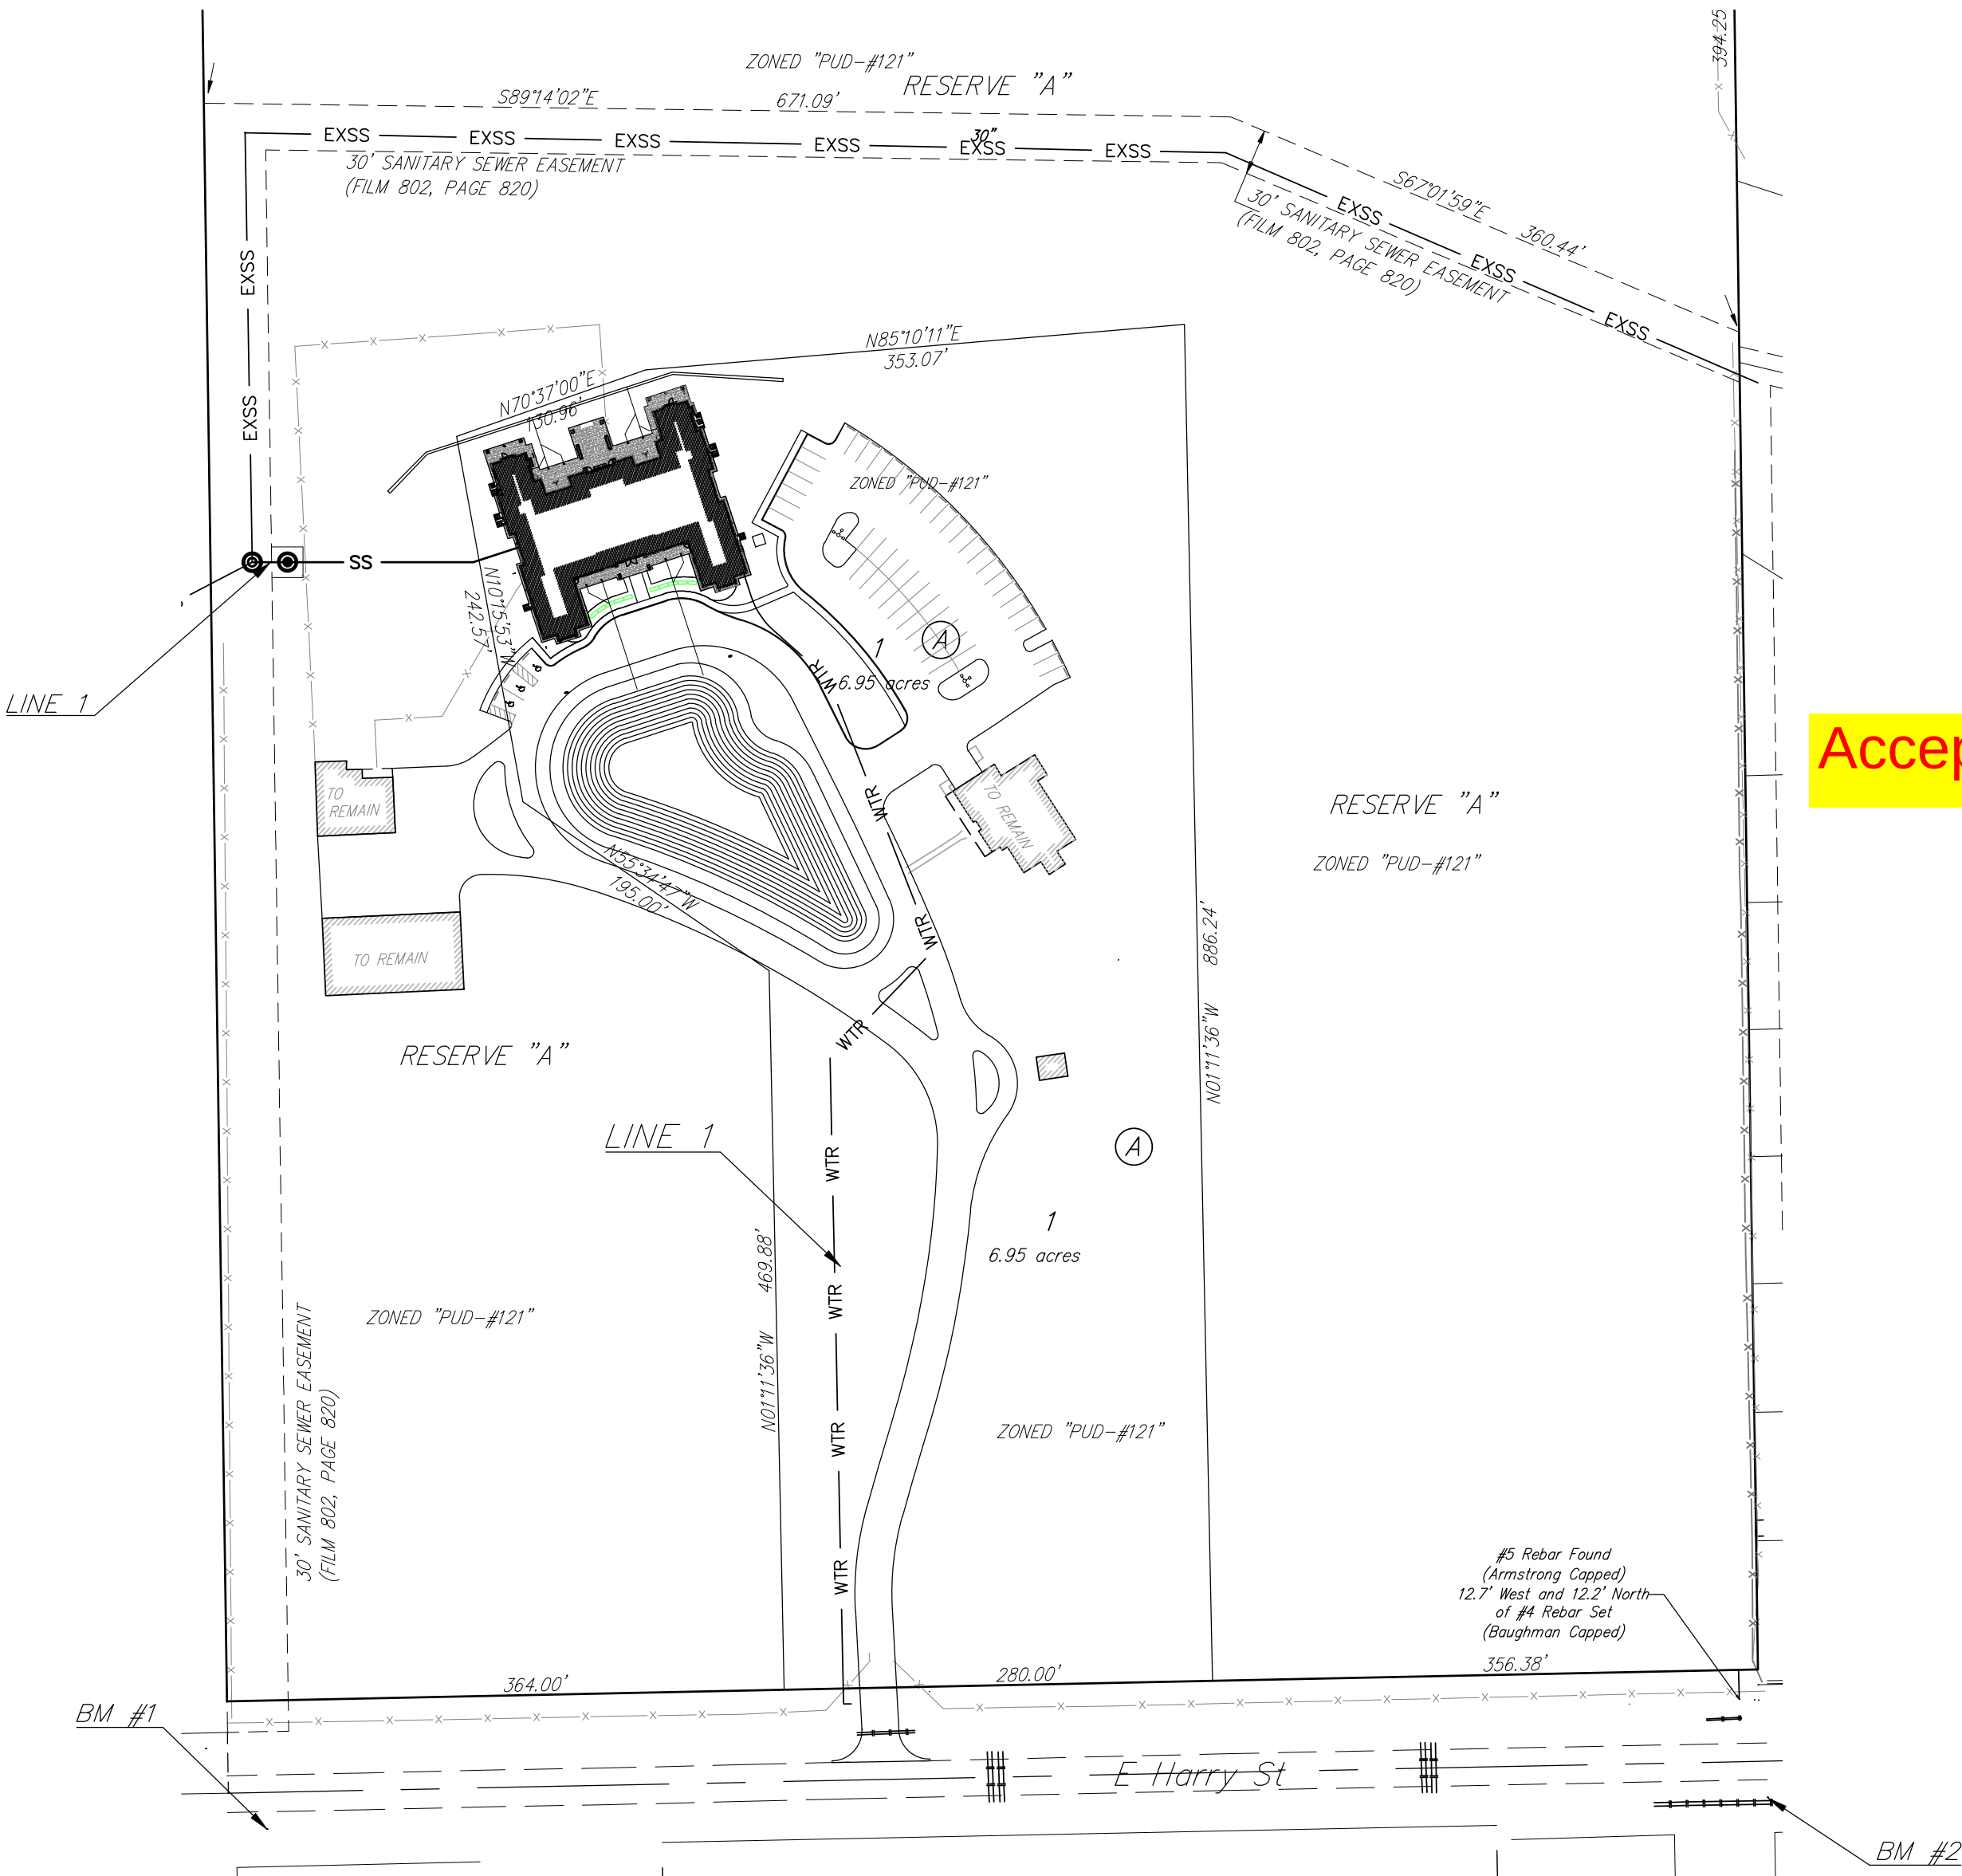

BAUGHMAN COMPANY
315 Ellis St. Wichita, KS 67211 316-262-7271
BaughmanCo.com

Apr. 21, 2025

BENCHMARKS:
Site Benchmark - 1
Rebar #4 at N 1678460.29, E1694305.47
Elevation = 1316.05 (NAVD 88)


Site Benchmark - 2
"X" chiseled on top of culvert pipe at N
1678481.08, E1695285.83
Elevation = 1315.04 (NAVD 88)

NOTE:
Existing Sanitary Sewer Manhole is
actually 14' North of location initially
shown on these plans.


Sta. 0+00.0, Line 1
Core into existing
manhole (6346-010)
and extend pipe east.
Seal and grout around new
pipe using non-shrink grout.
Reshape invert as necessary.
Cost of coring, sealing,
grouting and reshaping to be
incidental to cost of pipe.
If lined, repair MH liner
as necessary.
Top Elev. = ~~1305.30~~ **1305.66**
~~N: 1,679,287.89~~
~~E: 1,694,295.82~~
N=1,679,301.8
E=1,694,293.1

COW ID# 6346-451
Sta. 0+23.1, Line 1
Const. Standard Manhole
Top Elev. = ~~1306.90~~ **1306.98**
~~N: 1,679,287.95~~
~~E: 1,694,318.96~~ **N=1,679,301.5 E=1,694,319.1**

NOTE:
Service Line NOT
Part of PPS.

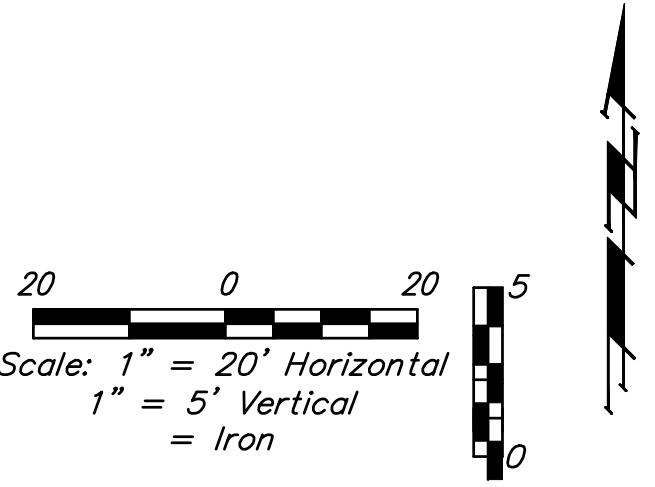

Northings (N) & Eastings (E): State Plane Coordinates - Kansas Grid South - NAD83 (2011), EPOCH 2023.
Elevations: NAVD88 (Geoid 18).
As-Built Survey Shots By: Baughman Company, P.A.

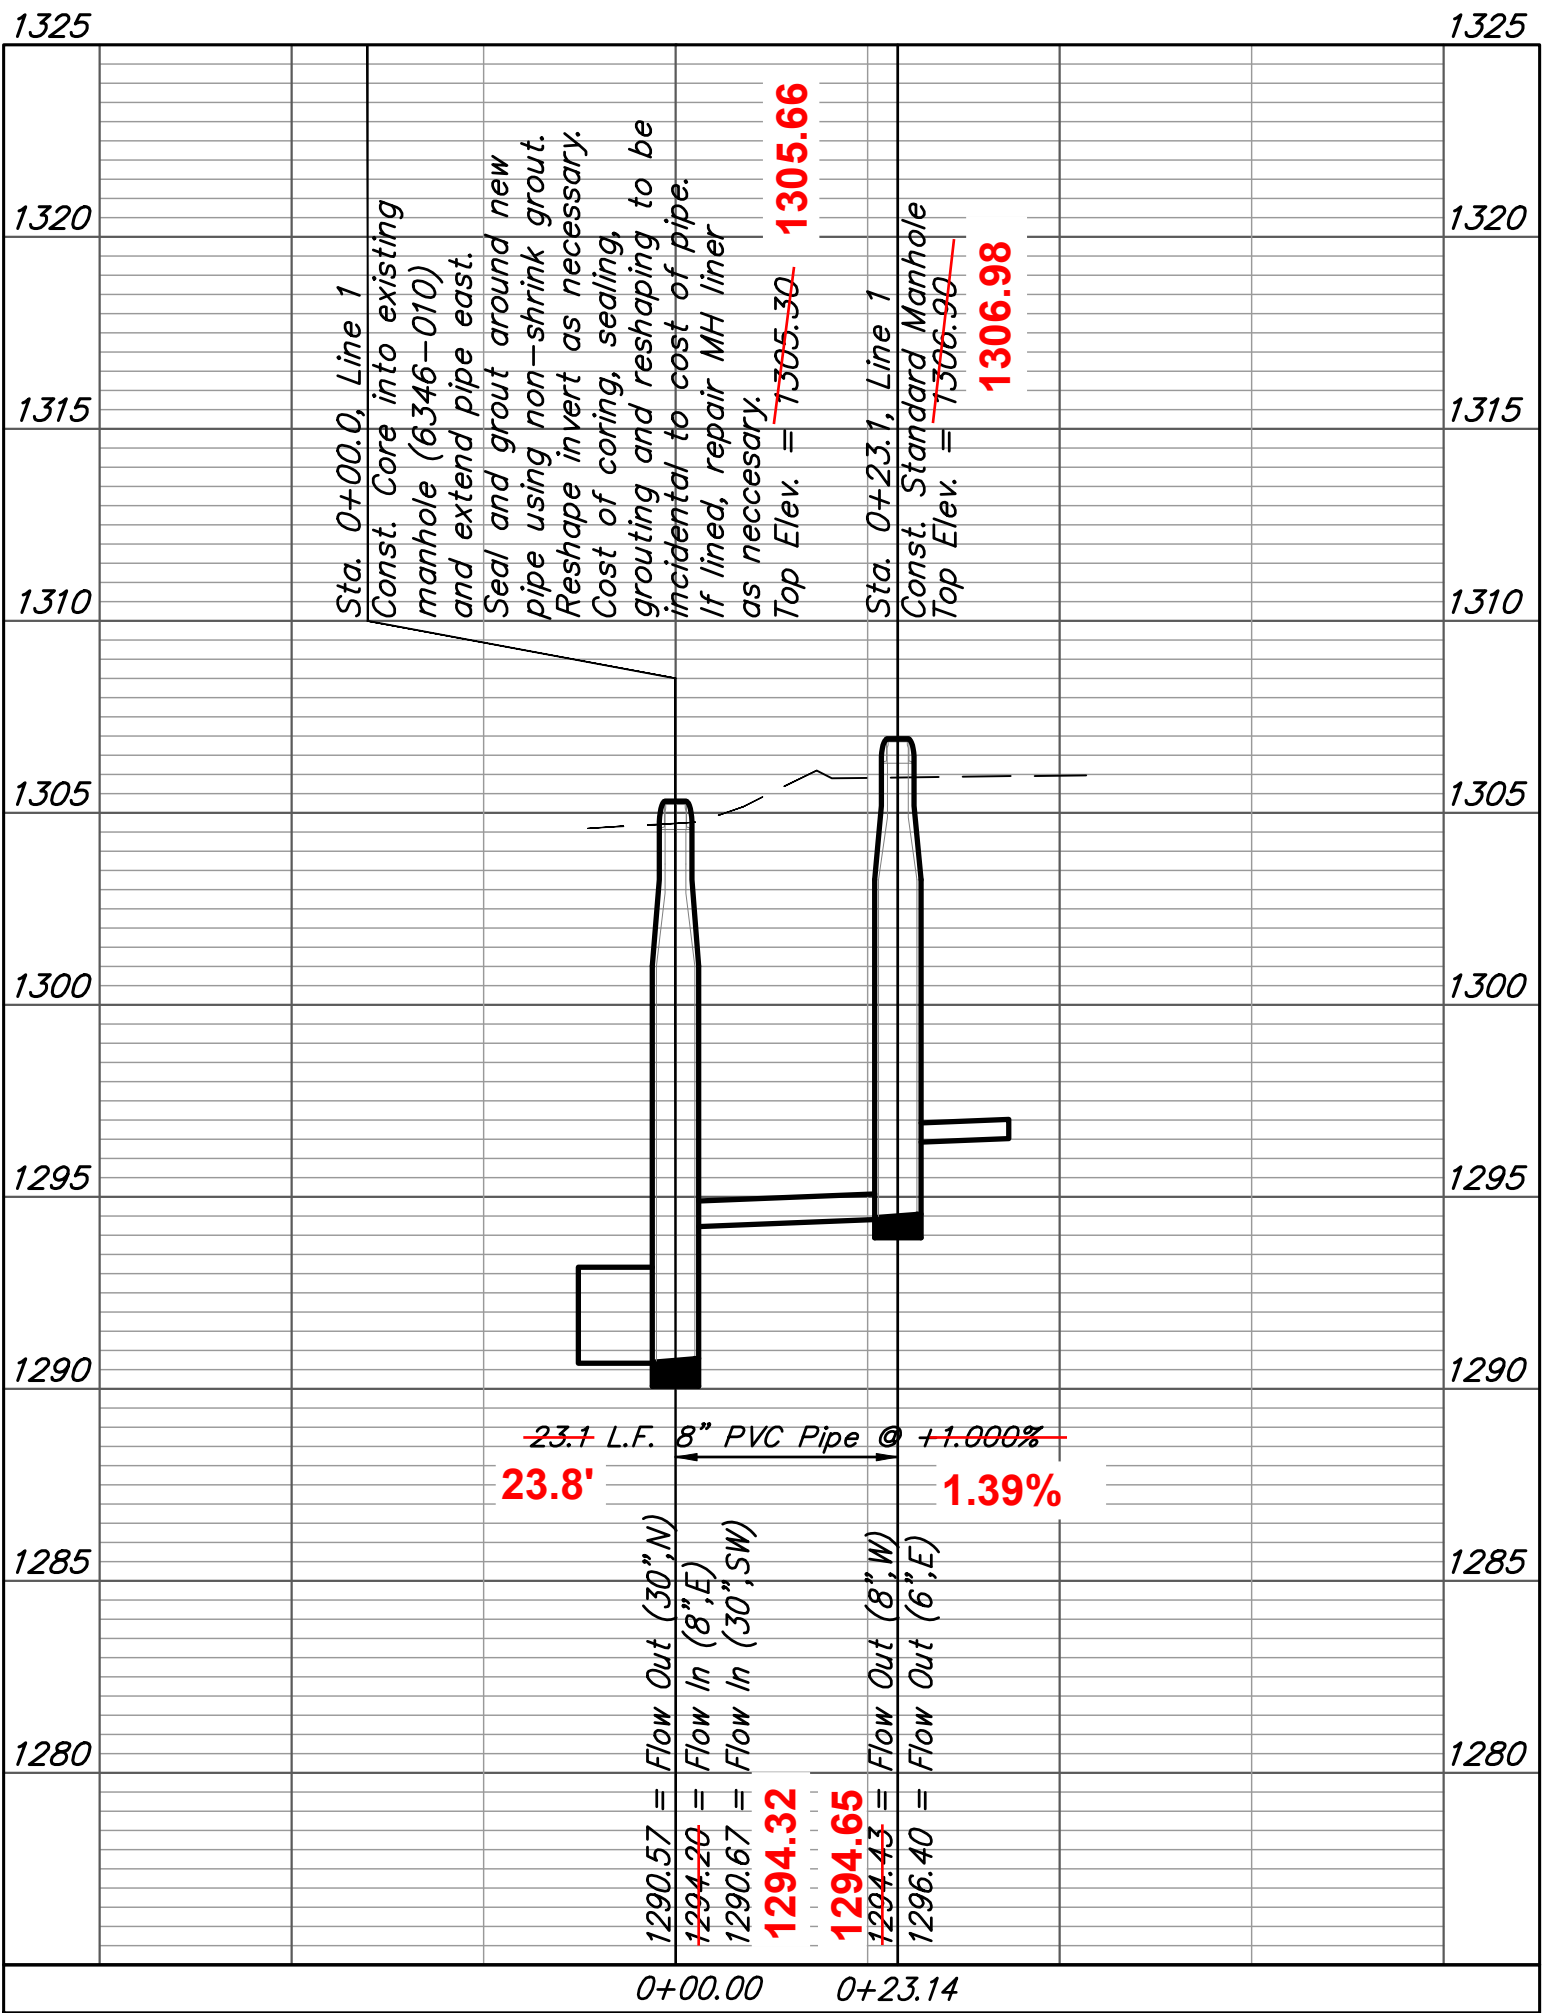

**BAUGHMAN
COMPANY**

315 Ellis St.
Wichita, KS 67211
316-262-7271
BaughmanCo.com

TGC Addition

Line 1

Sanitary Sewer
Improvements

PROJECT NUMBER:
24-12-E986


DESIGN: PDM DRAWN: PDM

DATE: Apr. 21, 2025

SHEET **2** OF **11**

File: E:\Projects\TGC Plat 143RD & Harry_23-1-Pg50\Engineering\Phase 1\PPS\PPS.dwg

TGC ADDITION
SEDGWICK COUNTY, KANSAS

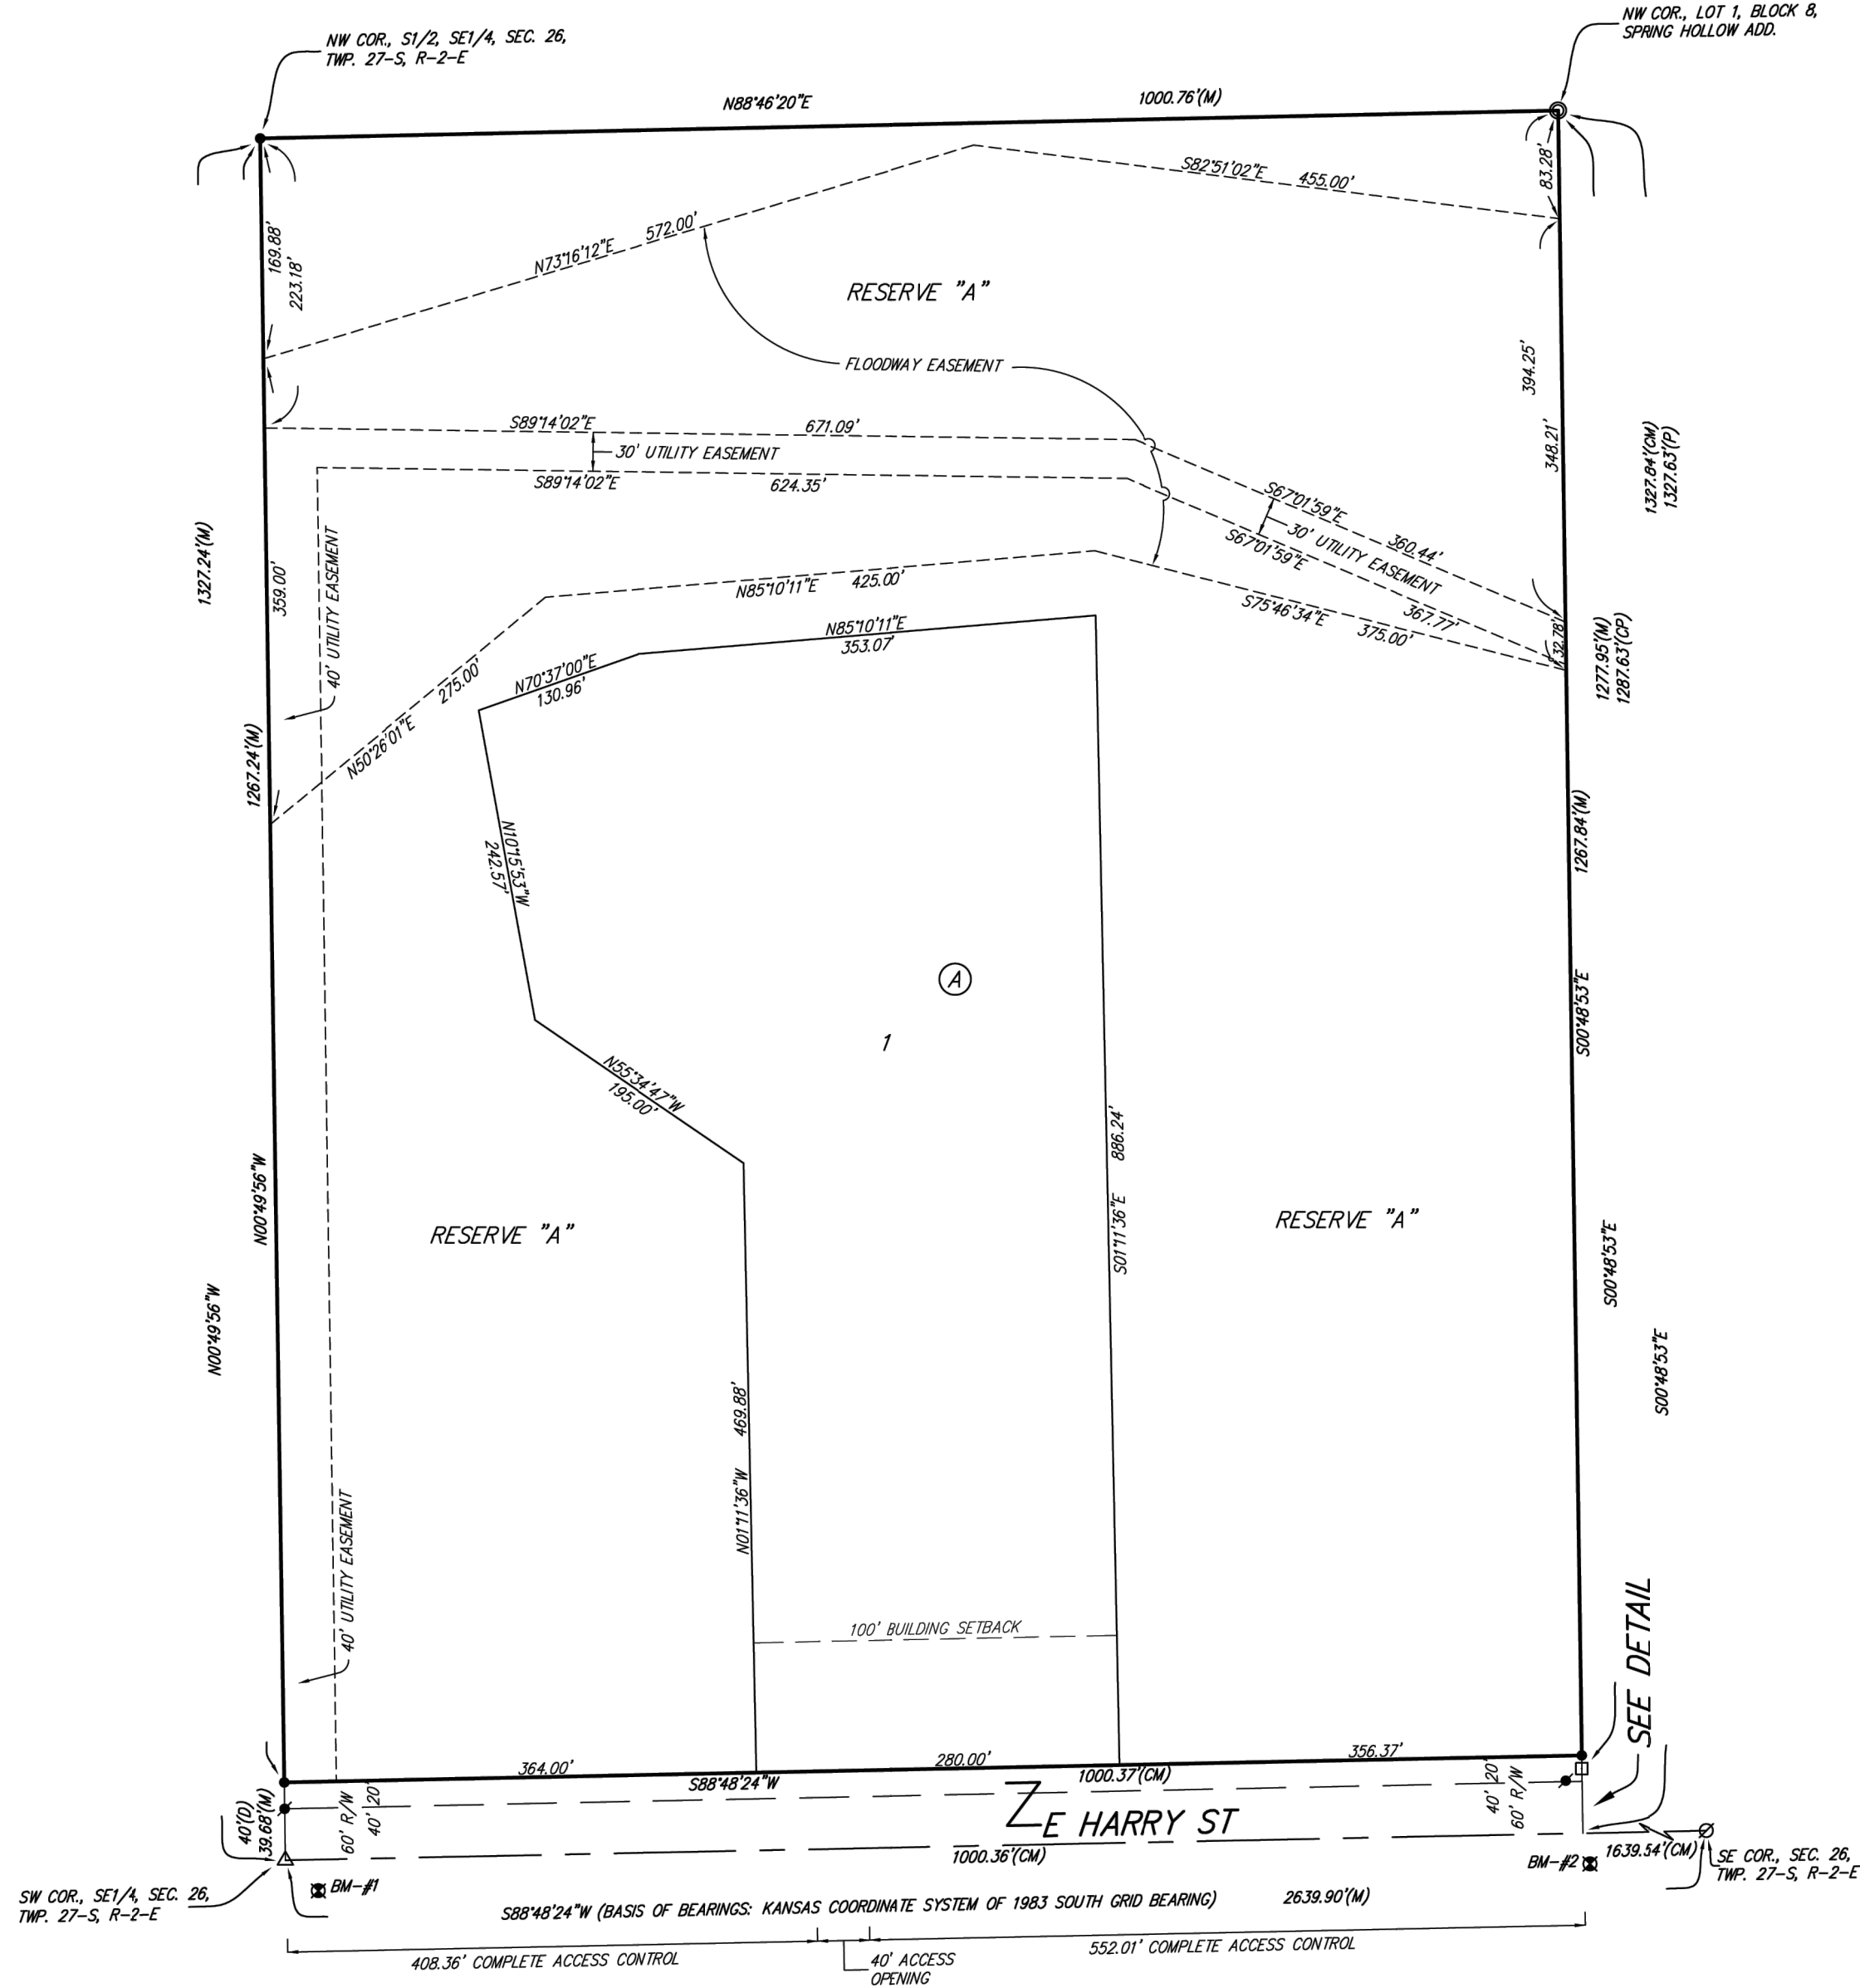


- = #4 REBAR W/ "BAUGHMAN" CAP (SET)
- = #4 REBAR W/ "SAVOY" CAP (FOUND)
- = #5 REBAR W/ "ARMSTRONG" CAP (FOUND)
- = 1/2" IRON PIPE (FOUND) (ORIGIN UNKNOWN)
- △ = 3/4" IRON PIPE (FOUND) (ORIGIN UNKNOWN)
- ⊙ = 3/4" IRON PIPE IN THIMBLE (FOUND) (ORIGIN UNKNOWN)

(M) = MEASURED
(P) = PLATTED
(D) = DESCRIBED
(CM) = CALCULATED FROM MEASURED INFO.
(CP) = CALCULATED FROM PLATTED INFO.

BENCHMARK:
BM-R: #4 REBAR, SOUTH SIDE OF E HARRY ST, 24.8± EAST AND
24.1± SOUTH OF SW COR., SE1/4, SEC. 26, TWP. 27-S, R-2-E.
ELEV. = 1316.05 NAVD88

BM-R2: "X" SET, SOUTH SIDE OF E HARRY ST, 5.2± EAST AND
73.5± SOUTH OF SW COR., LOT 1, BLOCK 1, SPRING HOLLOW 3RD
ADDITION.
ELEV. = 1315.04 NAVD88

MINIMUM BUILDING PAD ELEVATIONS FOR LOWEST OPENING TO THE STRUCTURES		
LOT	BLOCK	ELEVATION NAVD88
1	A	1310.1

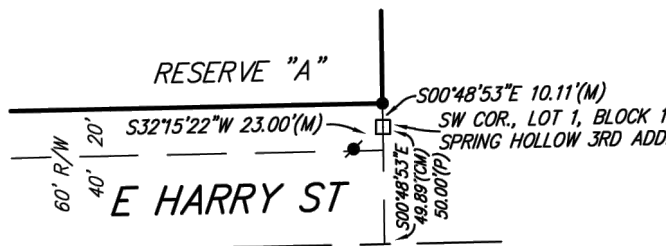

DETAIL
(NO SCALE)

State of Kansas) SS The foregoing instrument acknowledged be-
fore me, this _____ day of _____, _____, by _____
(Title) _____ of Central National Bank, on behalf of the bank.

_____, Notary Public


My App't. Exp. _____

DRAINAGE PLAN NOTE:
A master drainage plan has been developed for this plat. All drainage easements, rights-of-way, and reserves
shall remain at established grades (unless modified with the approval of the applicable City or County Engineer)
and shall be undisturbed to allow for the conveyance of stormwater in accordance with the Stormwater Manual.

State of Kansas) SS We, Baughman Company, P.A., Surveyors in
Sedgwick County) aforesaid county and state do hereby certify that we have surveyed and
platted "TGC ADDITION", Sedgwick County, Kansas and that the accompanying
plat is a true and correct exhibit of the property surveyed, described as the
South Half of the West 60 acres of the Southeast Quarter of Section 26,
Township 27 South, Range 2 East of the Sixth Principal Meridian, Sedgwick
County, Kansas, except the South 40 feet thereof for road TOGETHER WITH that
part of the Southeast Quarter of Section 26, Township 27 South, Range 2 East
of the Sixth Principal Meridian, Sedgwick County, Kansas, described as:
Beginning at the Southwest corner of the East 50 acres of the South Half of
said Southeast Quarter; thence North 1327.63 feet to the Northwest corner of
said East 50 acres; thence West 16.05 feet to the Northeast corner of the
South Half of the West 60 acres of said Southeast Quarter; thence South
along the East line of said South Half of the West 60 acres 1327.59 feet to
the South line of said Southeast Quarter; thence East along the South line of
said Southeast Quarter to the point of beginning.

Existing public easements, building setbacks,
access controls, and dedications, if any, being
vacated by virtue of K.S.A. 12-512b, as amended.

Baughman Company, P.A.

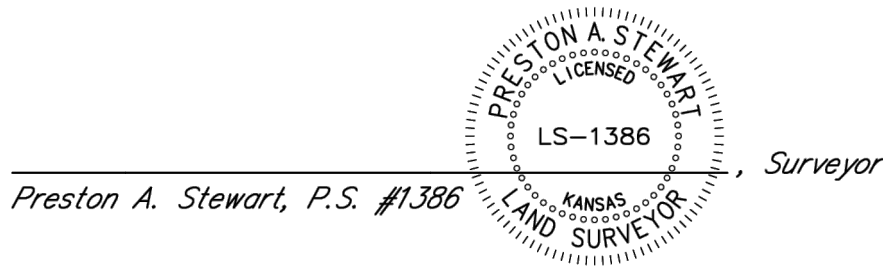

Know all men by these presents that we, the
undersigned, have caused the land in the surveyors certificate to be platted into
a Lot, a Block, a Street, and a Reserve to be known as "TGC ADDITION",
Sedgwick County, Kansas. No signs, light poles, private drainage systems,
masonry fences, masonry trash enclosures or other structures shall be located
within public utility easements unless a Use of Easement Permit is obtained from
the City of Wichita Public Works & Utilities Department. The floodway easement
is hereby granted to the public as indicated for flood protection purposes and
preserving the natural drainage. No buildings shall be constructed or placed on
or within said floodway, nor shall any fill, change of grade, creation of channel,
or any other work be carried on without the permission of the Engineer for the
appropriate governing body. The street is hereby dedicated to and for the use of
the public. Reserve "A" is hereby reserved for open space, landscaping, drainage
purposes, lakes, agricultural uses and agricultural structures, berms, floodplain
and floodway, walking paths, and utilities as confined to easement. Reserve "A"
shall be owned and maintained by the owner of Lot 1, Block A. Compliance with
any platted restrictions and applicable restrictive covenants affecting said Reserve
shall be binding on any owners, successors, heirs, or assigns. No regrading within
abutting rights-of-way shall be allowed with the construction of the berms
allowed within Reserve "A". The berms cannot impact access to or bury
manholes, water valves, and/or water meters. FEMA floodplain and regulatory
floodway boundaries are subject to periodic change and such change may affect
the intended land use within the subdivision. The Minimum Building Pad Elevations
for the lowest opening to the structures shall be as indicated on the face of the
plat. Access controls shall be as depicted on the face of the plat and are
hereby granted to the appropriate governing body.

13800 LLC, a Kansas limited liability company

_____, Managing
Member
Nicholas James Esterline

State of Kansas) SS The foregoing instrument acknowledged before me,
Sedgwick County) this _____ day of _____, 2024, by Nicholas James Esterline, Managing
Member of 13800 LLC, a Kansas limited liability company, on behalf of the
limited liability company.

_____, Notary Public

My App't. Exp. _____

We the undersigned holders of a mortgage on the
above described property, do hereby consent to this plat of "Tgc
ADDITION", Sedgwick County, Kansas.

Central National Bank

_____, (Title)

This plat of "TGC ADDITION", Sedgwick
County, Kansas has been submitted to and approved by the
Wichita-Sedgwick County Metropolitan Area Planning Commission,
Wichita, Kansas.

Dated this _____ day of _____, 2024.
Wichita-Sedgwick County Metropolitan Area Planning Commission

_____, Chairman
Bryan K. Frye

_____, Secretary
Scott A. Wadle

This _____
shown hereon accepted by the City of
Kansas, this _____ day of _____

Lily

_____, City Clerk
Jamie Buster

This plat approved and all dedications
shown hereon accepted by the Board of Commissioners of Sedgwick
County, Kansas, this _____ day of _____, _____

_____, Chairman
Ryan Baty, Fourth District

ATTEST: _____, County Clerk
Kelly B. Arnold

Reviewed in accordance with K.S.A. 58-2005
on this _____ day of _____, _____.

_____,
Tricia L. Robello, P.S. #1246
Deputy County Surveyor
Sedgwick County, Kansas

Entered on transfer record this _____ day
of _____, _____.


_____, County Clerk
Kelly B. Arnold

State of Kansas) SS This is to certify that this plat has been
Sedgwick County) filed for record in the office of the Register of Deeds, this _____ day
of _____, _____ at _____ o'clock _____ M.; and is duly recorded.

_____, Register of Deeds
Tonya Buckingham

_____, Deputy
Kenly Zehring

TGC ADDITION
BAUGHMAN COMPANY
315 Ellis St. Wichita, KS 67211 316-262-7271
BaughmanCo.com

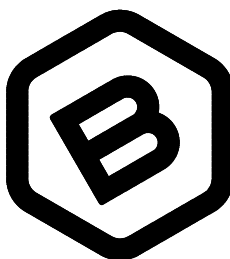

**BAUGHMAN
COMPANY**

315 Ellis St.
Wichita, KS 67211
316-262-7271
BaughmanCo.com

TGC Addition

**Erosion
Control Details**

Sanitary Sewer
Improvements

PROJECT NUMBER:
24-12-E986

DESIGN: PDM DRAWN: PDM

DATE: February 24, 2025

SHEET OF
11 11