



BK 38 Y
285. 32-43



Post Returns
5-3

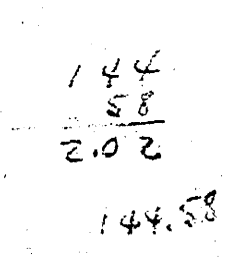

B.M. 144.31 Box N.S. Elm Tree 100' W. & 50' N. of N.W. Cor. ELPICO & LARRY LANE
 B.M. 139.87 STANDARD N.W. Cor. EDGEWOOD & MT. VERNON


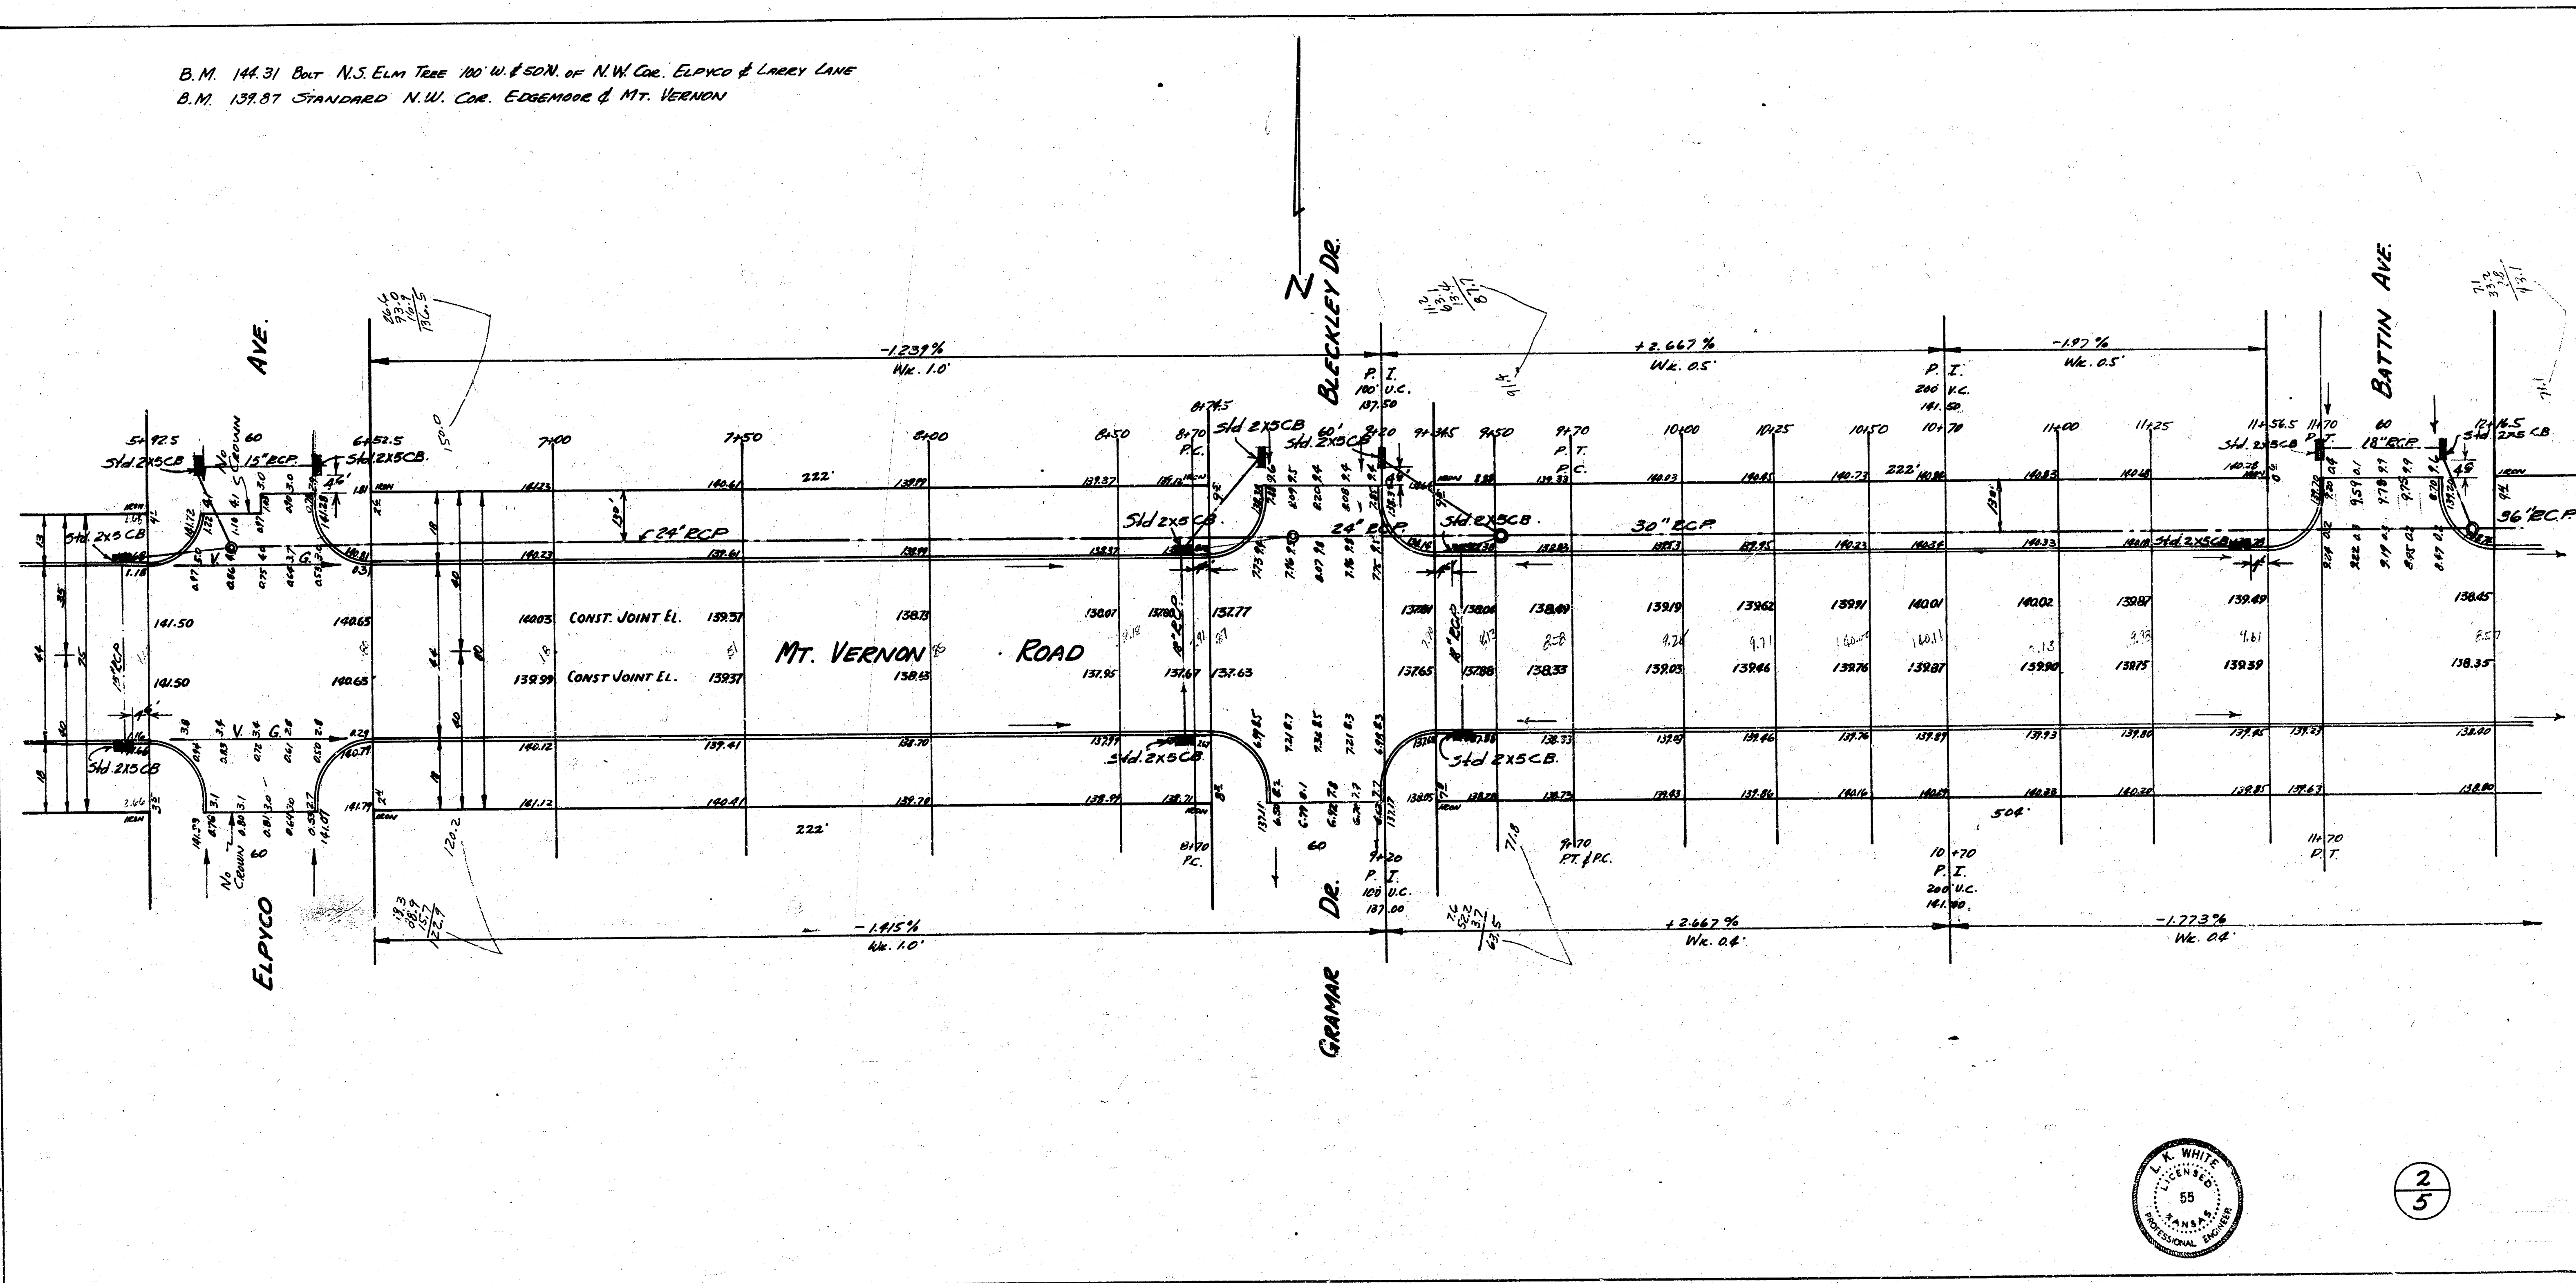


B.M. 144.31 Bolt N.S. Elm Tree 100' W. & 50' N. of N.W. Cor. ELPYCO & LARRY LANE
 B.M. 139.87 STANDARD N.W. COR. EDGEWOOD & MT. VERNON

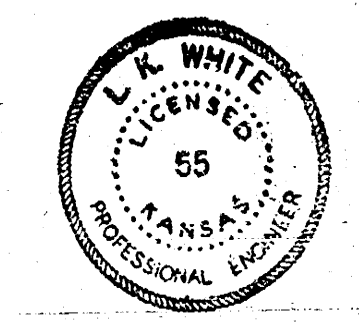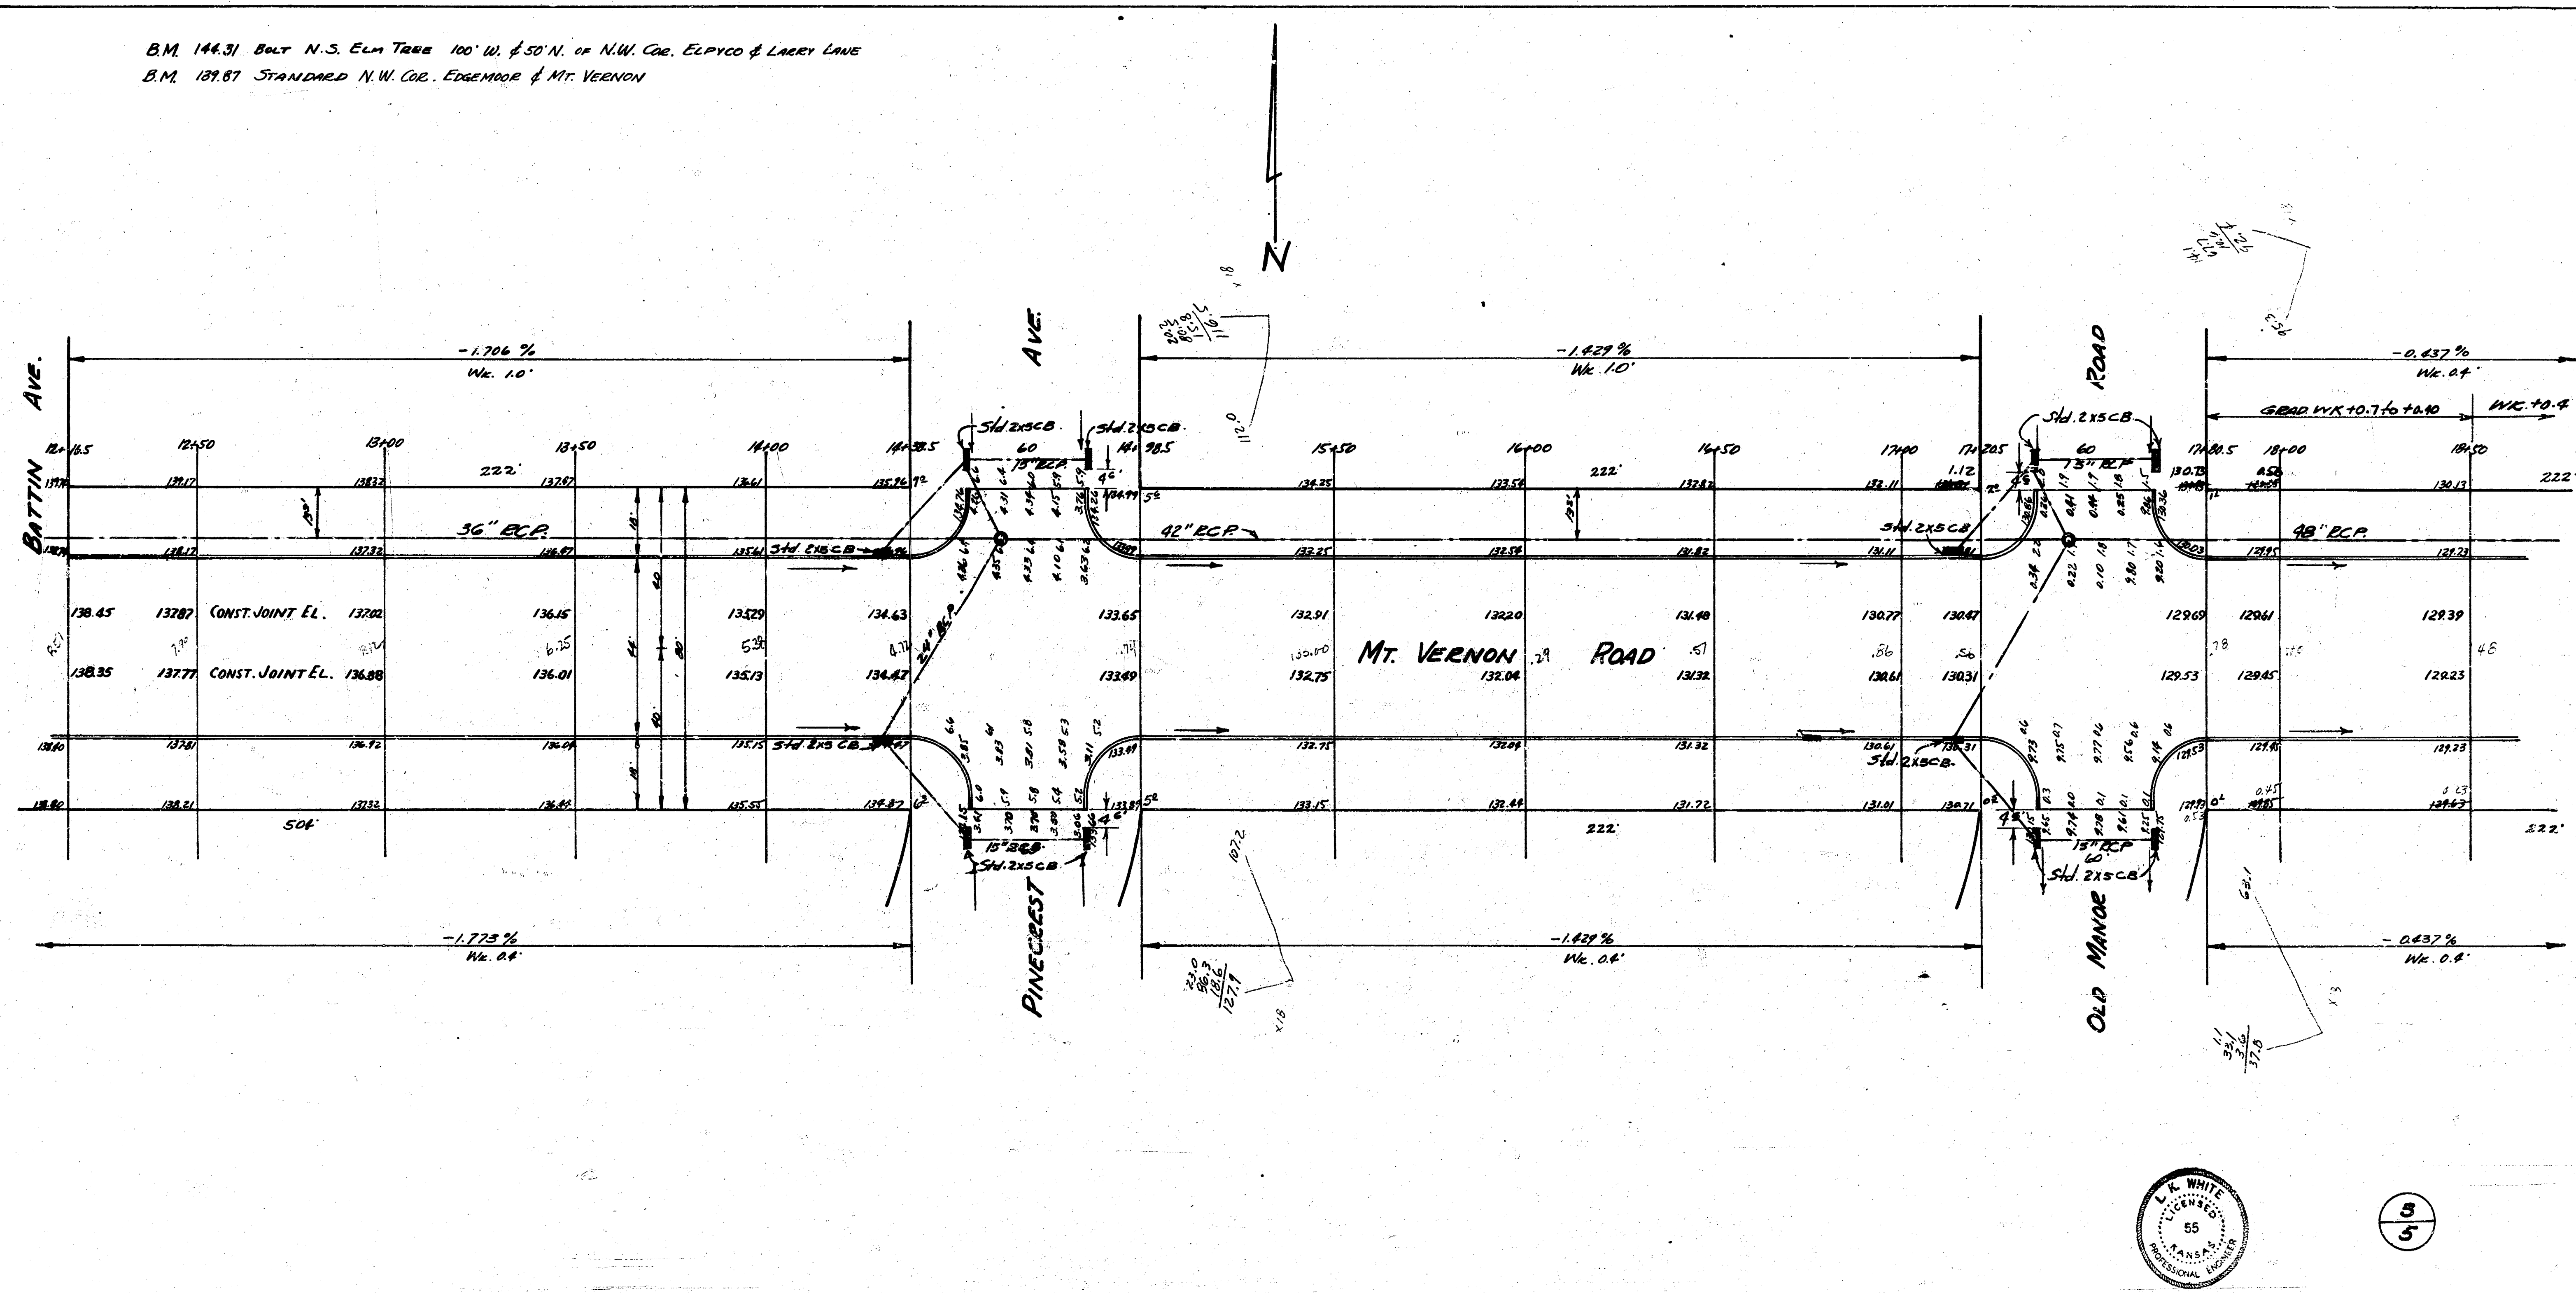


5
5

B.M. 144.31 Bolt N.S. Elm Tree 100' W. & 50' N. of N.W. Cor. Elyco & Larry Lane
 B.M. 139.67 Standard N.W. Cor. Edgemoor & Mt. Vernon

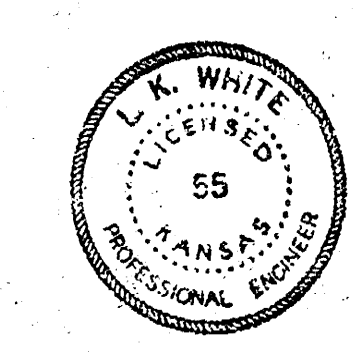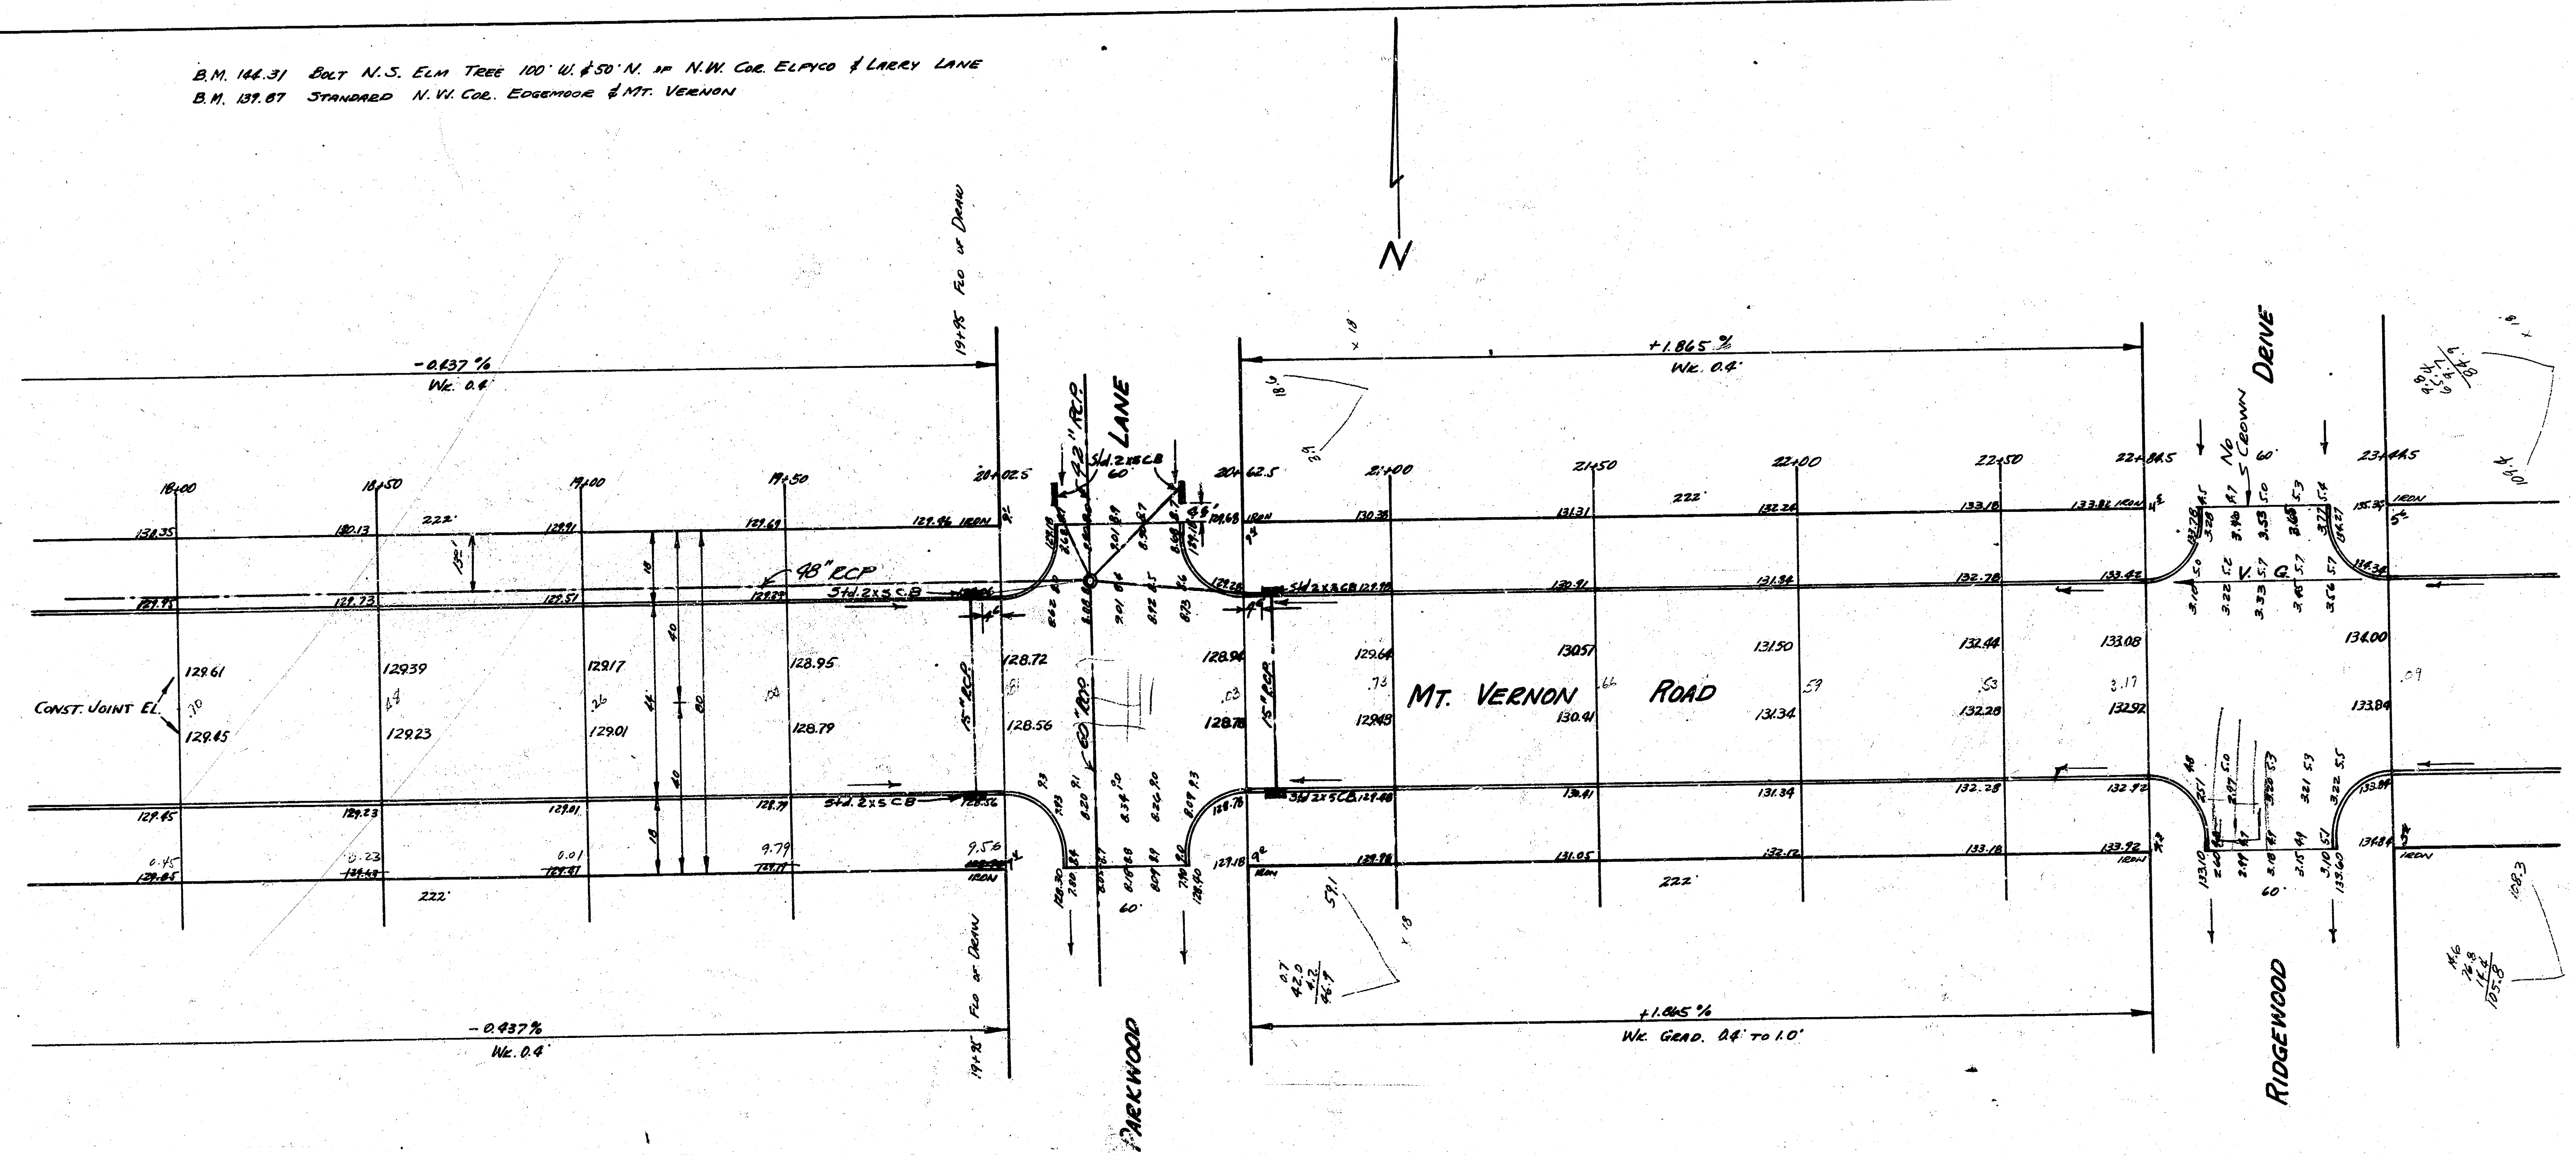

4
5

B.M. 144.31 Bolt N.S. Elm Tree 100' W. & 50' N. of N.W. Cor. ELYCO & LARRY LANE
 B.M. 139.87 STANDARD N.W. Cor. EDGEWOOD & MT. VERNON

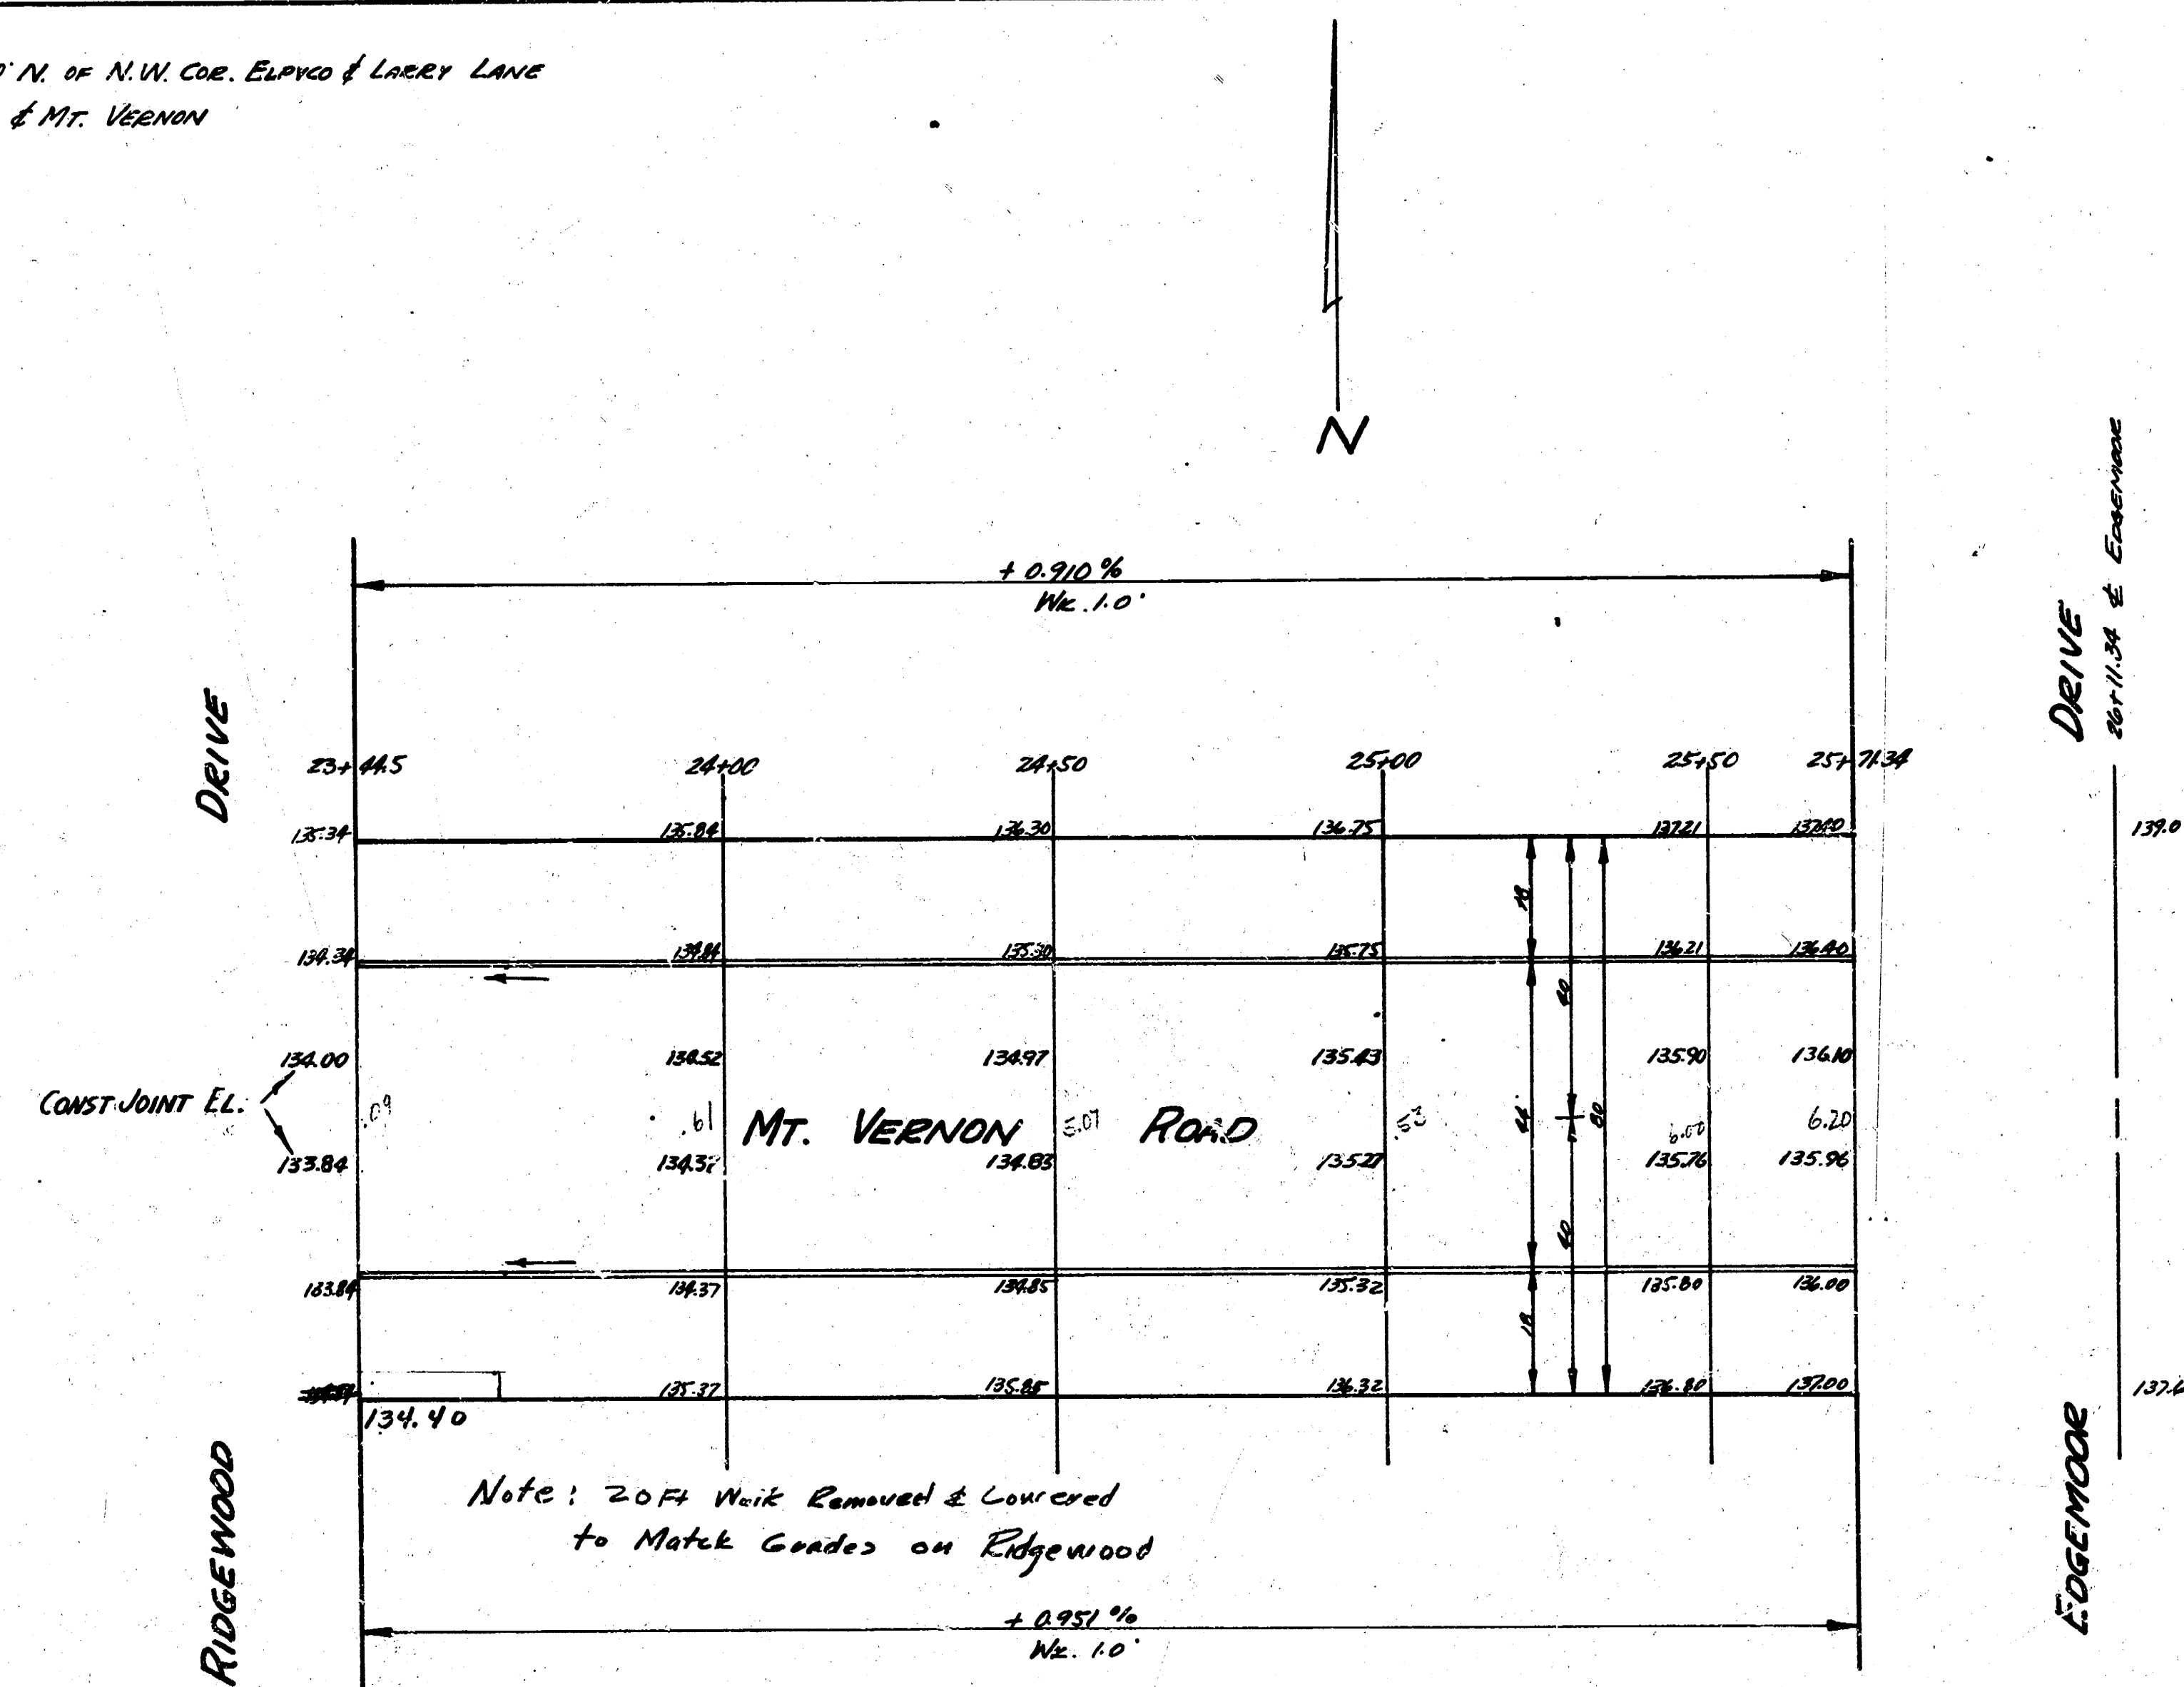

5/5