


S.E. 1/4 SEC. I, TWP. 28-S, R. 1-W.

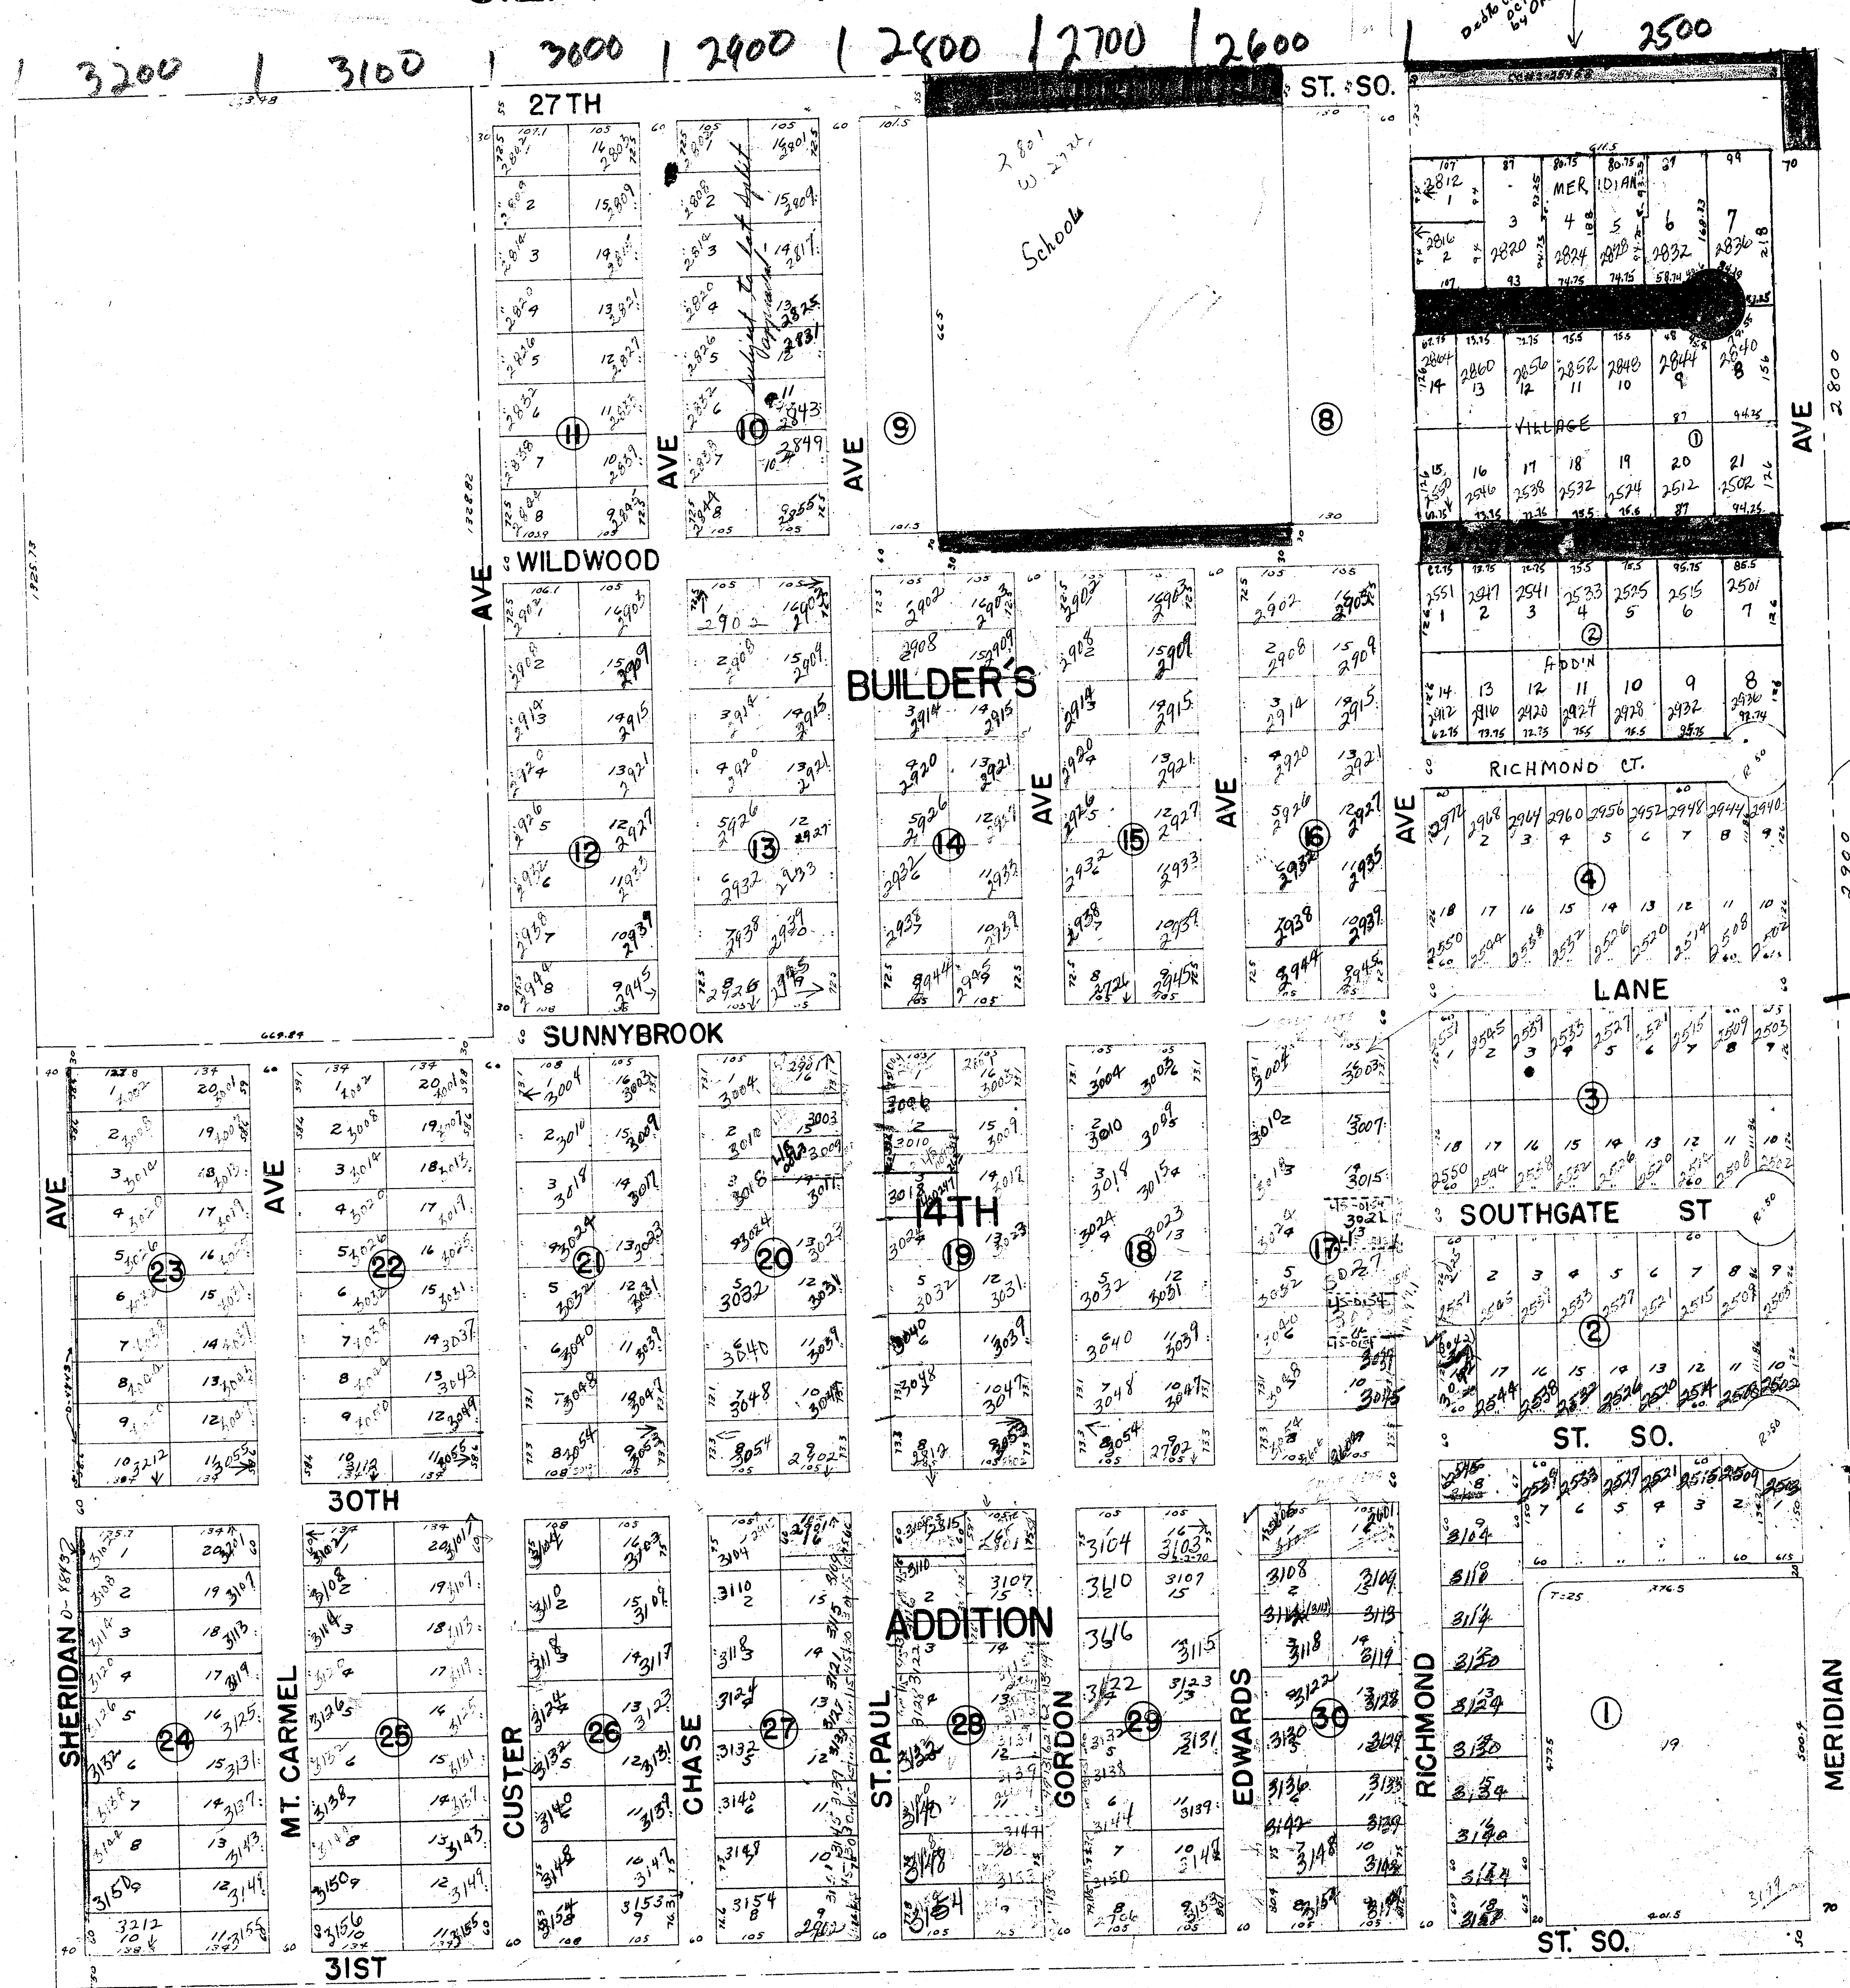

0.46 Cont'd of 1st ST.
by One of the Survey

7-72

SEE LIST ATTACHED
TO BUILDERS 14TH IN
FILES FOR CHANGING
OF CHART LOTS.