



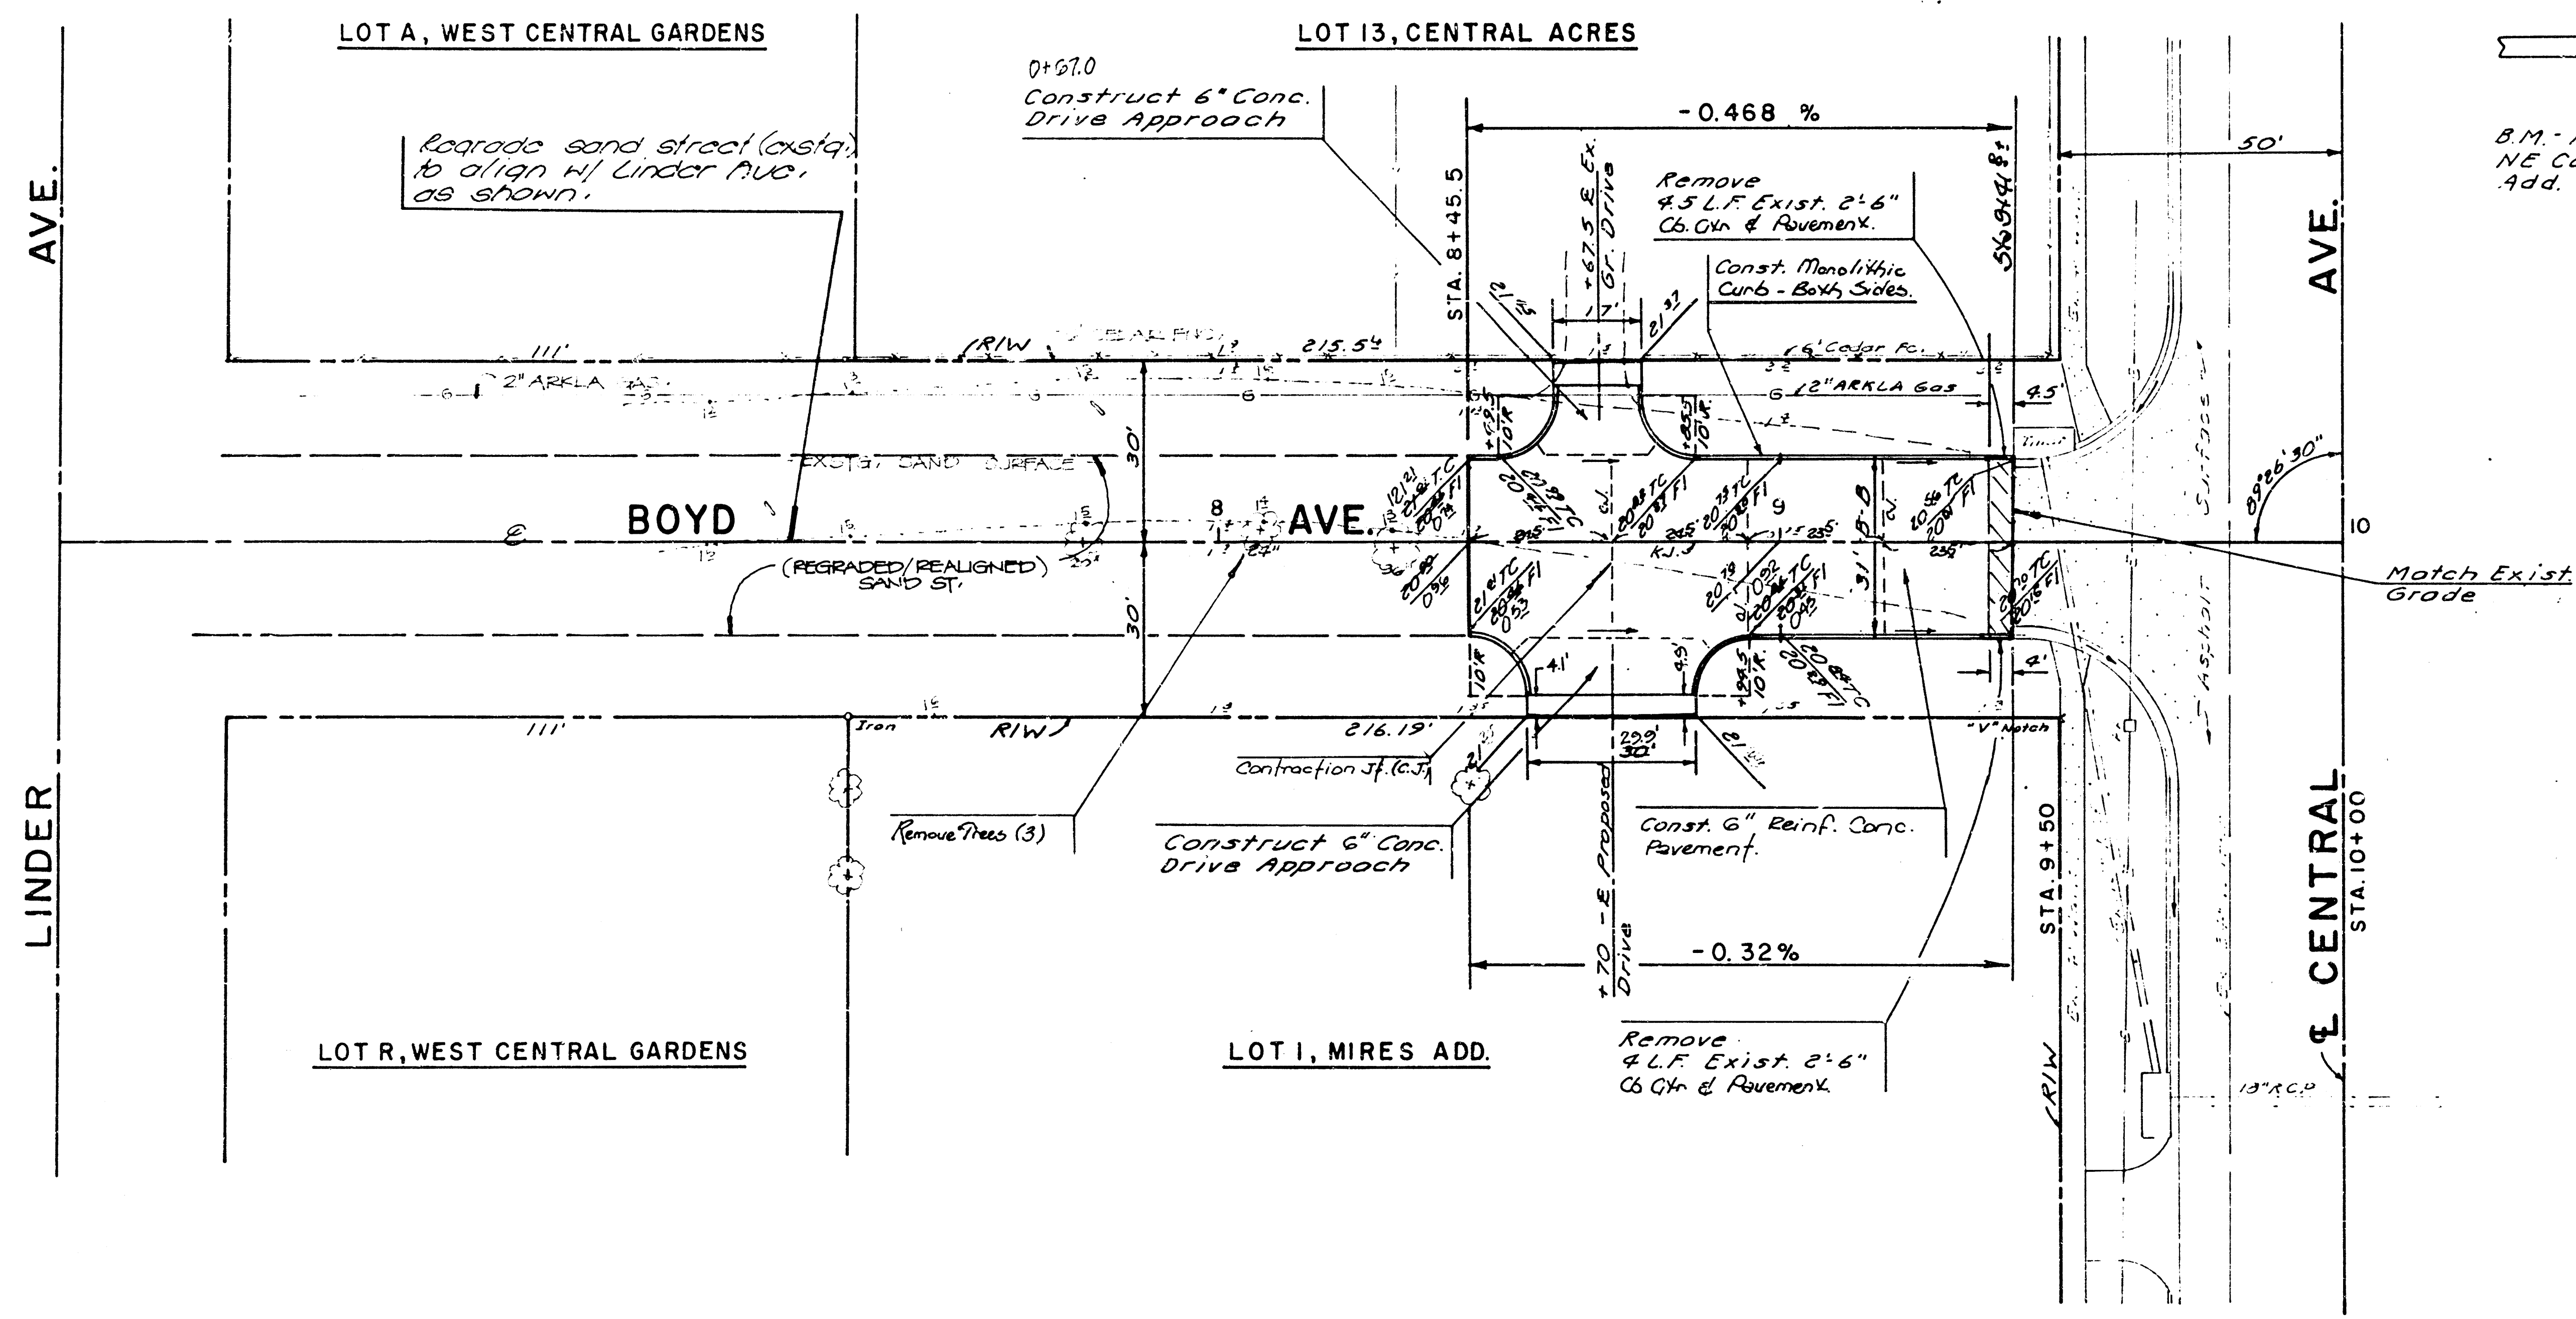

Scale: 1" = 20'
B.M. - RR Spk. in P.P. @
NE Cor. of Lot 1, Mires
Add. Elev. 122.89

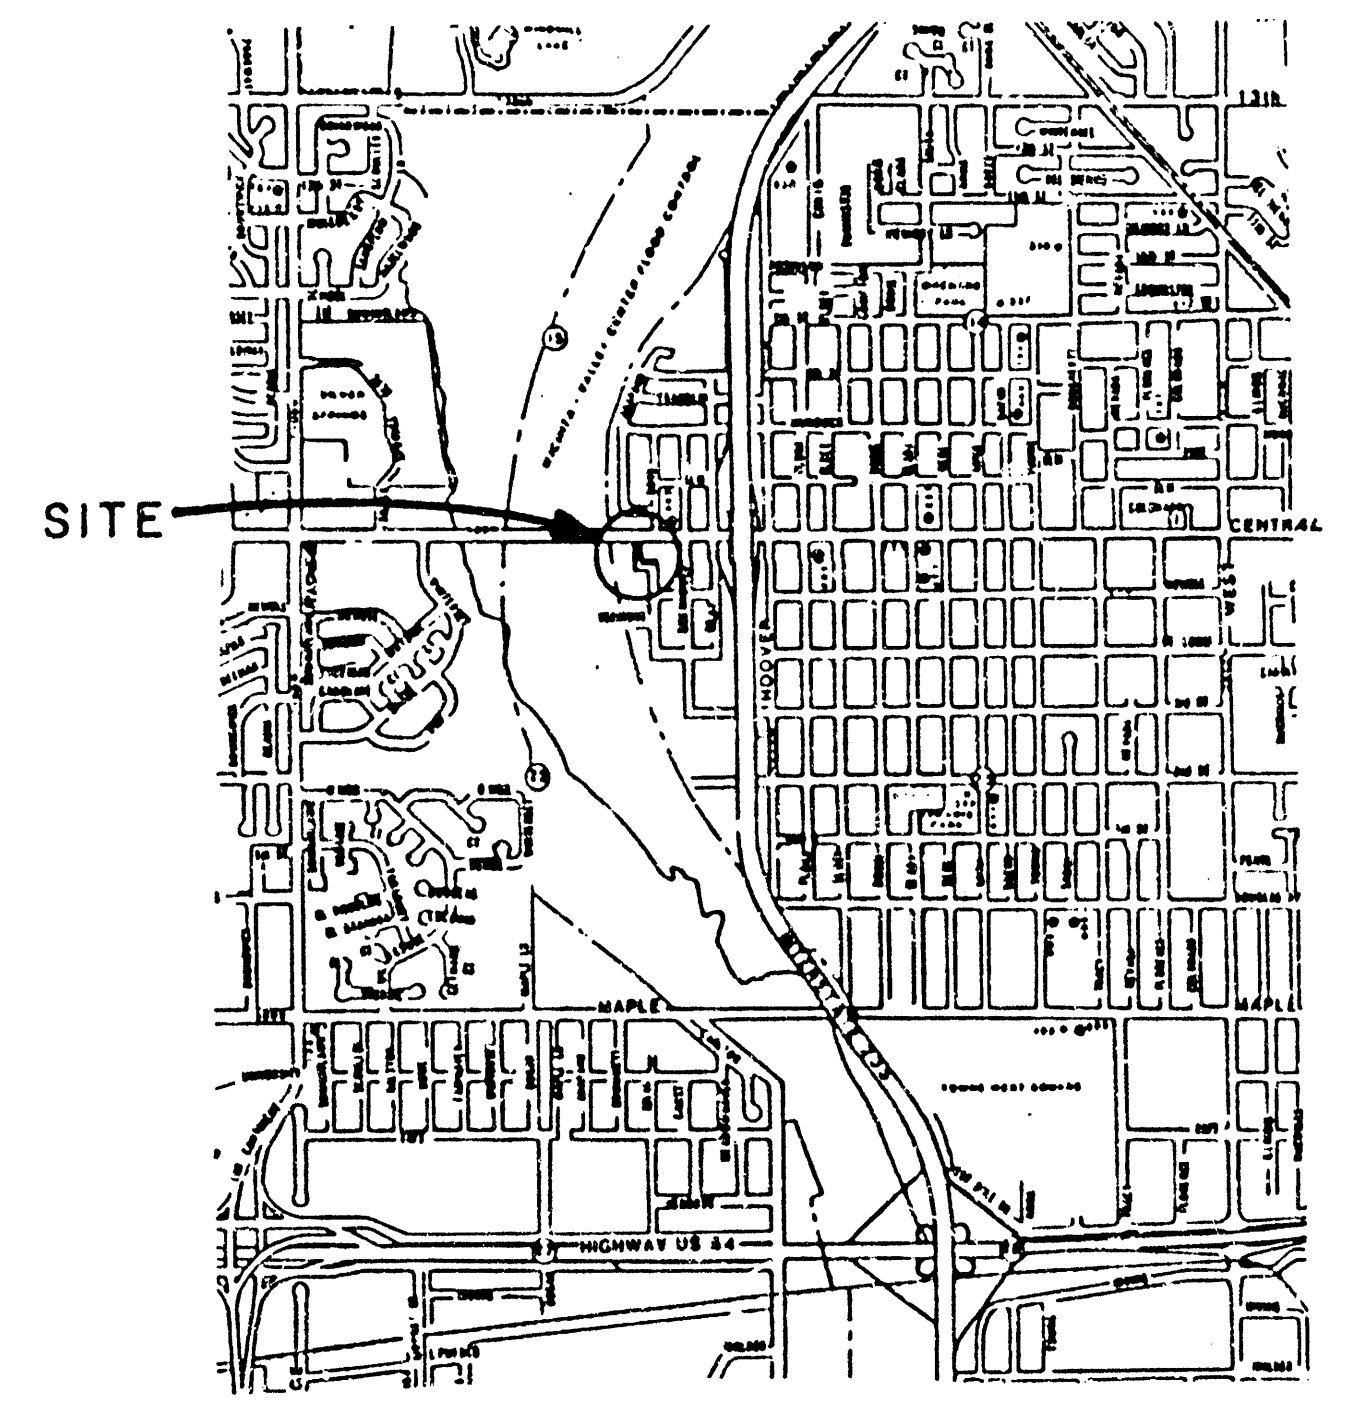

VICINITY MAP

APPROVED AS NOTED
By CITY ENGINEER OF WICHITA

Sanitary Sewers	_____
Storm Sewers	_____
Driveway Approaches	_____
Water Mains	_____
Paving	VR 4 1/31/90

NOTE TO CONTRACTOR


INSPECTION AND TESTING FOR THIS PROJECT IS TO BE PROVIDED BY A LICENSED CONSULTING ENGINEERING FIRM UNDER CONTRACT WITH THE OWNER/DEVELOPER. SAID INSPECTION TO BE IN ACCORDANCE WITH THE CITY OF WICHITA STANDARD CONSTRUCTION ENGINEERING PRACTICES AND CERTIFIED BY A LICENSED PROFESSIONAL ENGINEER. NO WORK SHALL BE PERFORMED IN DEDICATED EASEMENTS OR PUBLIC RIGHT-OF-WAY BY THE CONTRACTOR WITHOUT SUCH INSPECTION NOR SHALL ANY WORK BE COMMENCED WITHOUT WRITTEN AUTHORIZATION BY THE CITY ENGINEER.



Revised as built 3-15-90
Revised 1/31/90

PRIVATE STREET IMPROVEMENT PROJECT
FOR BOYD AVE. FROM S.L. CENTRAL TO A
POINT 105 FEET SOUTH

BOYD AVE. - CENTRAL SOUTH
055 PFP 607879

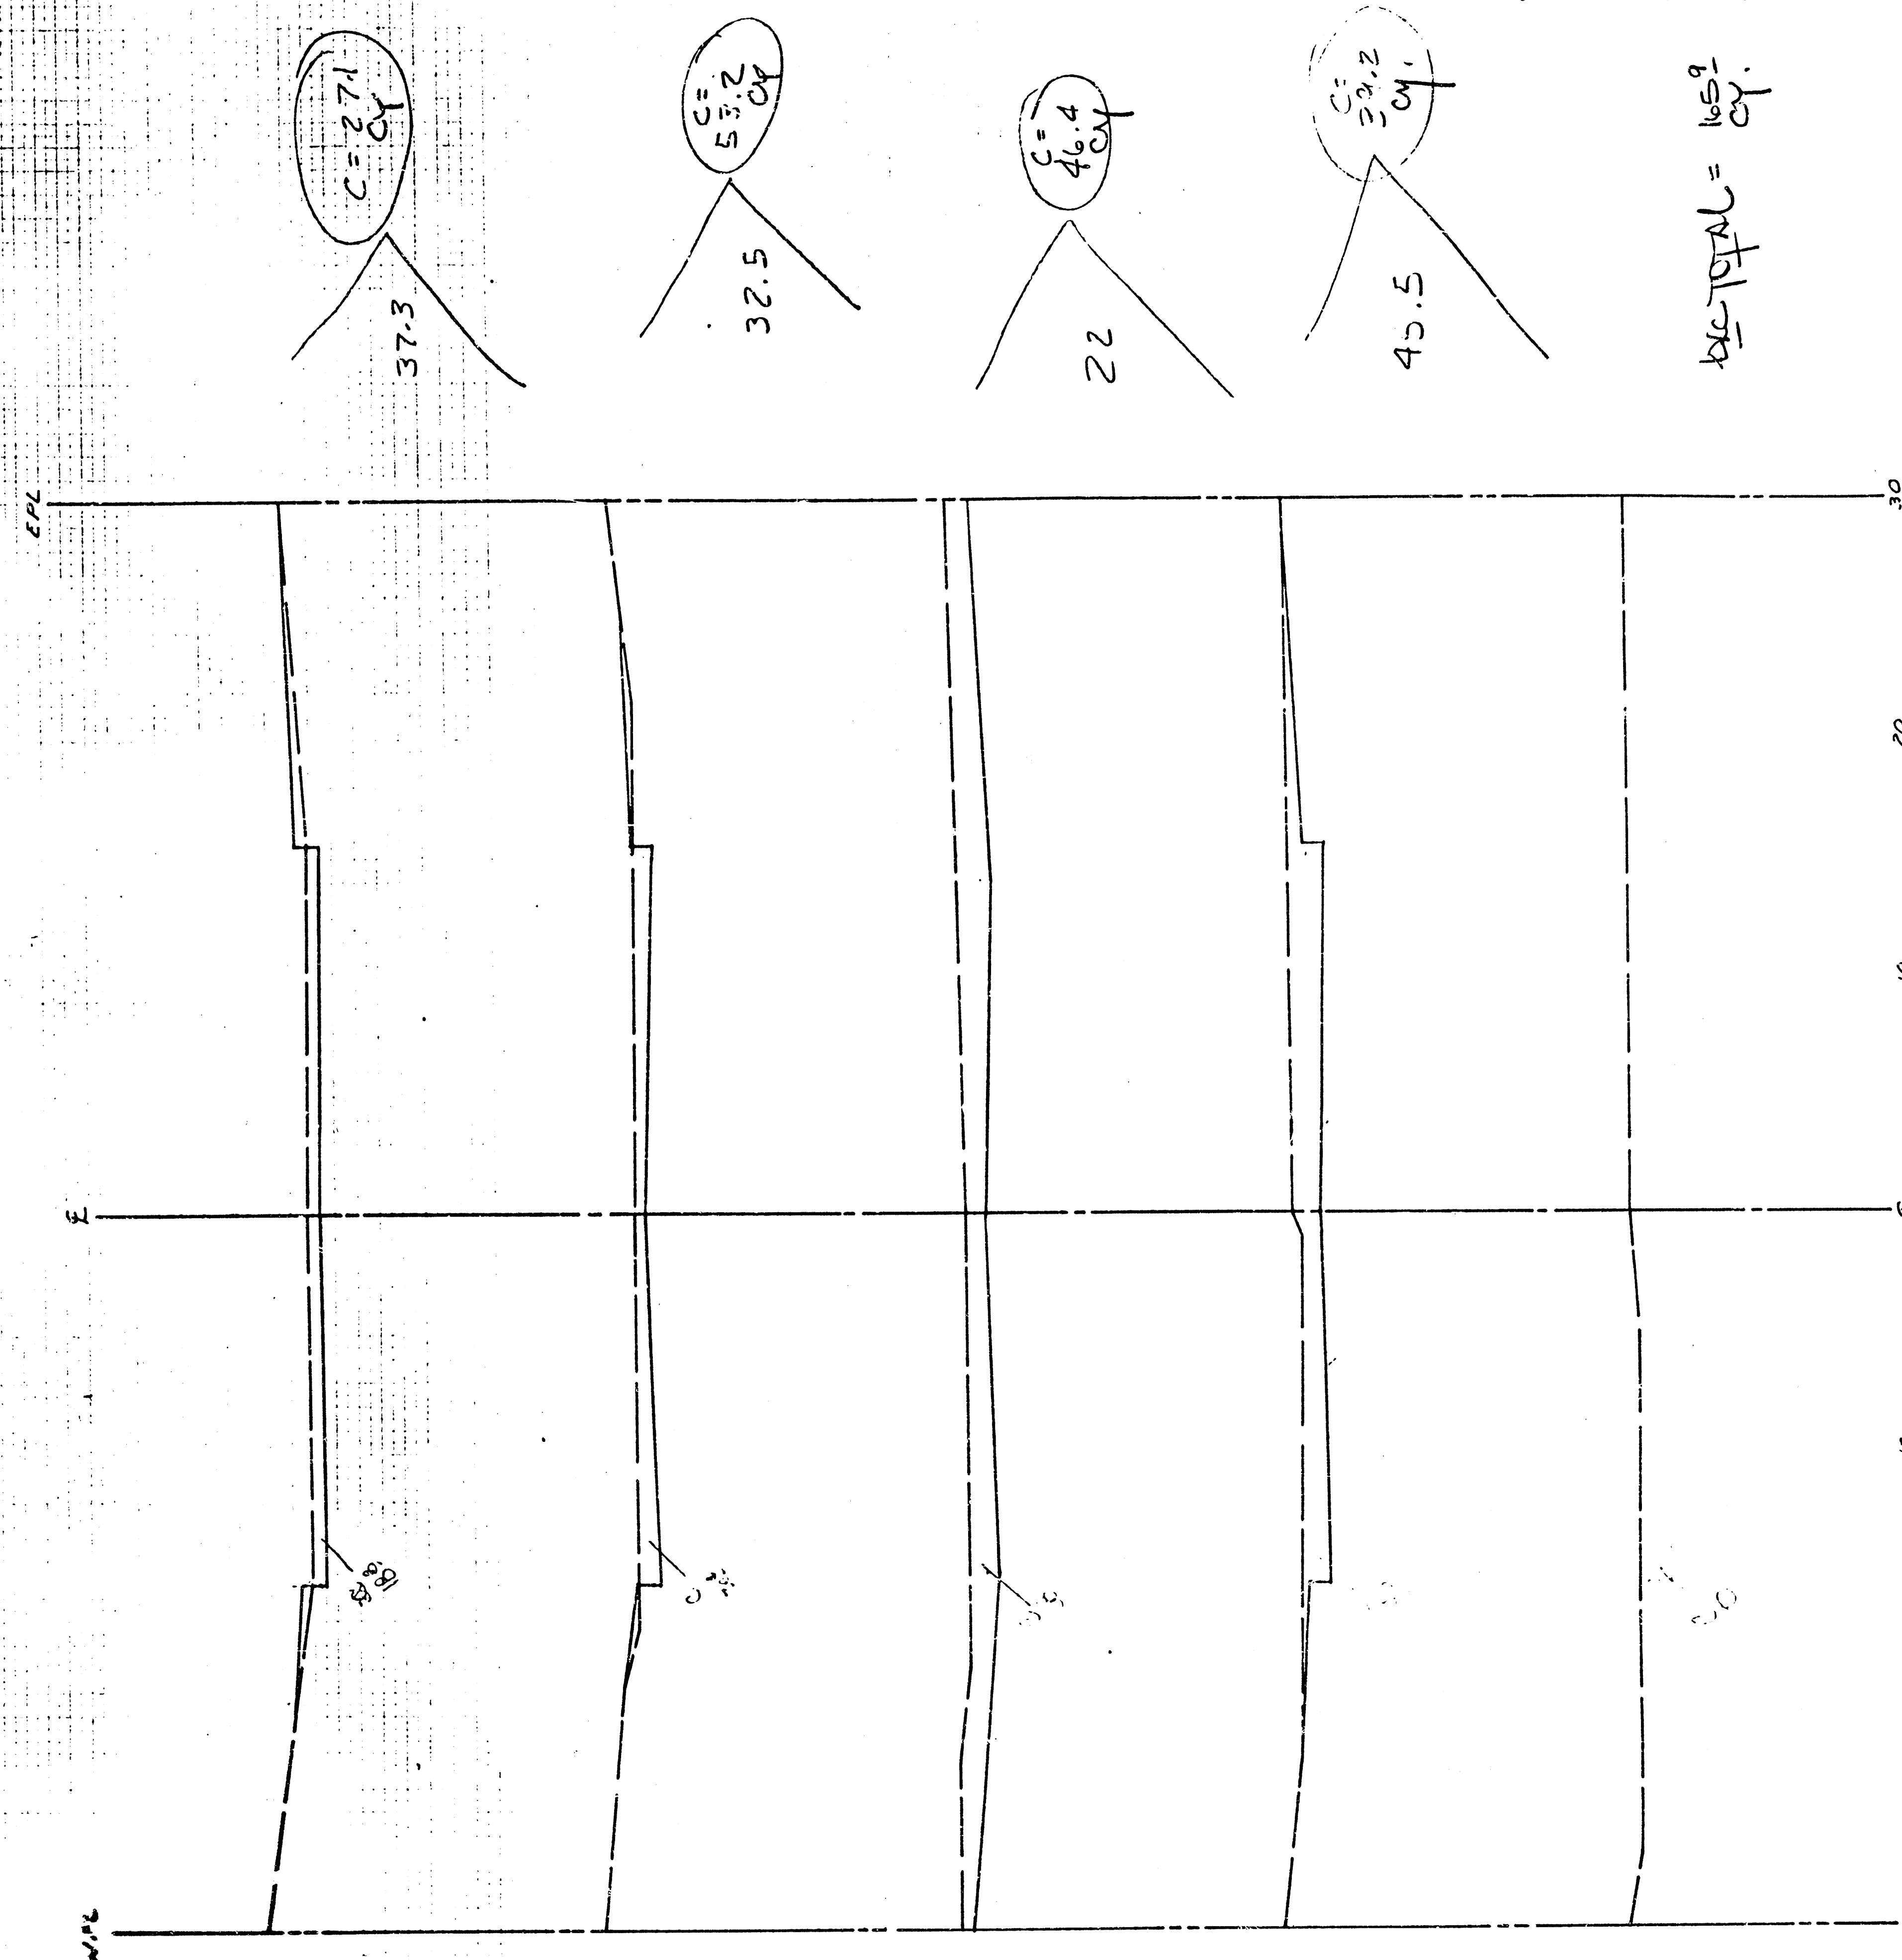

C=271
CY

C=53.2
CY

C=46.4
CY

C=33.2
CY

165.9
CY

125
9+37.3
120

125
9+00
120

125
8+67.5
120

125
8+45.5
120

125
8+00
120

SH. 3 OF 3

FILMED FROM THE BEST
AVAILABLE COPY.....