

PAVING PLANS FOR

WILLOWBEND FIFTH ADDITION

CHAMPIONS CIRCLE: FROM THE WEST LINE OF ROCK ROAD TO THE WEST LINE OF CHAMPIONS CIR. AS PLATTED IN WILLOWBEND FIFTH ADD.
CHAMPIONS COURT: SERVING LOTS 9 THROUGH 13 INCLUSIVE BLK.1 WILLOWBEND FIFTH ADD. FROM THE N. LINE OF CHAMPIONS CIR. TO THE N. LINE OF CHAMPIONS CIR.
CHAMPIONS COURT: SERVING LOTS 1 THROUGH 4 INCLUSIVE BLK.2 WILLOWBEND FIFTH ADD. FROM THE S. LINE OF CHAMPIONS CIR. TO THE S. LINE OF CHAMPIONS CIR.
CHAMPIONS COURT: SERVING LOTS 10 THROUGH 12 INCLUSIVE BLK.2 WILLOWBEND FIFTH ADD. FROM THE S. LINE OF CHAMPIONS CIR. TO THE S. LINE OF CHAMPIONS CIR.
CHAMPIONS COURT: SERVING LOTS 14 THROUGH 17 INCLUSIVE BLK.2 WILLOWBEND FIFTH ADD. FROM THE S. LINE OF CHAMPIONS CIR. TO THE S. LINE OF CHAMPIONS CIR.

PROJECT NO.

472-76-245-80001-000-000-030

CITY OF WICHITA, KANSAS

MICHAEL E. LINDEBAK CITY ENGINEER


GENERAL NOTES

1. CURB AND GUTTER WITH WIDENED GUTTER TO BE PAID AS COMBINED CURB AND GUTTER.
2. ALL DRAINAGE STRUCTURES "BY OTHERS".
3. THE CONTRACTOR SHALL BE RESPONSIBLE FOR PRESERVING PROPERTY IRONS. THE CONTRACTOR SHALL BE REQUIRED TO RE-ESTABLISH ANY PROPERTY IRONS WHICH ARE DAMAGED OR DESTROYED BY HIS CONSTRUCTION OPERATIONS. SUCH IRONS SHALL BE RE-ESTABLISHED BY A LICENSED LAND SURVEYOR OR A LICENSED PROFESSIONAL ENGINEER IN ACCORDANCE WITH STATE LAWS.
4. TRANSITION CURB FROM FULL HEIGHT COMBINATION CURB AND GUTTER TO ROLL TYPE COMBINATION CURB AND GUTTER IS TO BE PAID AS BID FOR LINEAR FEET COMBINED CURB AND GUTTER. (3 5/8" ROLL).
5. I-A INLET HOOKUPS TO BE BID EACH. SIZE VARIES.
6. NO MORE THAN 5-20' DRIVEWAY APPROACHES OR THE EQUIVALENT TO BE CONSTRUCTED.
7. ALL CONCRETE SHALL BE STANDARD PAVING MIX UNLESS OTHERWISE NOTED.
8. EXISTING UTILITIES AND THEIR LOCATIONS, AS SHOWN ON THE PLANS, REPRESENT THE BEST INFORMATION OBTAINABLE FOR DESIGN. LOCATION INFORMATION HAS BEEN OBTAINED FROM THE VARIOUS UTILITY COMPANIES AND IS EITHER FROM COMPANY RECORD DRAWINGS OR COMPANY PROVIDED FIELD LOCATIONS. THE PLAN LOCATIONS SHOWN ARE NOT GUARANTEED. ADDITIONAL EXISTING UTILITIES MAY ALSO BE ENCOUNTERED.
9. CONTRACTOR WILL BE REQUIRED TO PROVIDE A MINIMUM ADVANCE NOTICE OF TWENTY-FOUR (24) HOURS TO UTILITY COMPANIES PRIOR TO STARTING ANY EXCAVATION AS FOLLOWS:

SOUTHWESTERN BELL TELEPHONE COMPANY 1-316-571-2611
CABLEVISION 262-4270 or 263-2061
KPL GAS SERVICE 263-7511
KANSAS GAS & ELECTRIC 264-1141
CITY OF WICHITA WATER DEPARTMENT 268-4908
CITY OF WICHITA SEWER DEPARTMENT 268-4071
ARKLA GAS COMPANY 942-8350 or 263-8161

BENCH MARKS

- B.M. 1 R.R. Spike in W. Face Power Pole at S.E. Corner 45th St. N. & Rock Rd. Elev. 197.93
- B.M. 2 Top of Bolt in Corner Fence Post at S.E. Corner R.R. ROW and Rock Rd. Elev. 196.16
- B.M. #3 = cut on NE corner of Big RC2 under Rock Road + 900' E of E Quarter corner section 30, Township 28 South, Range 2 East. Elev. = 186.99

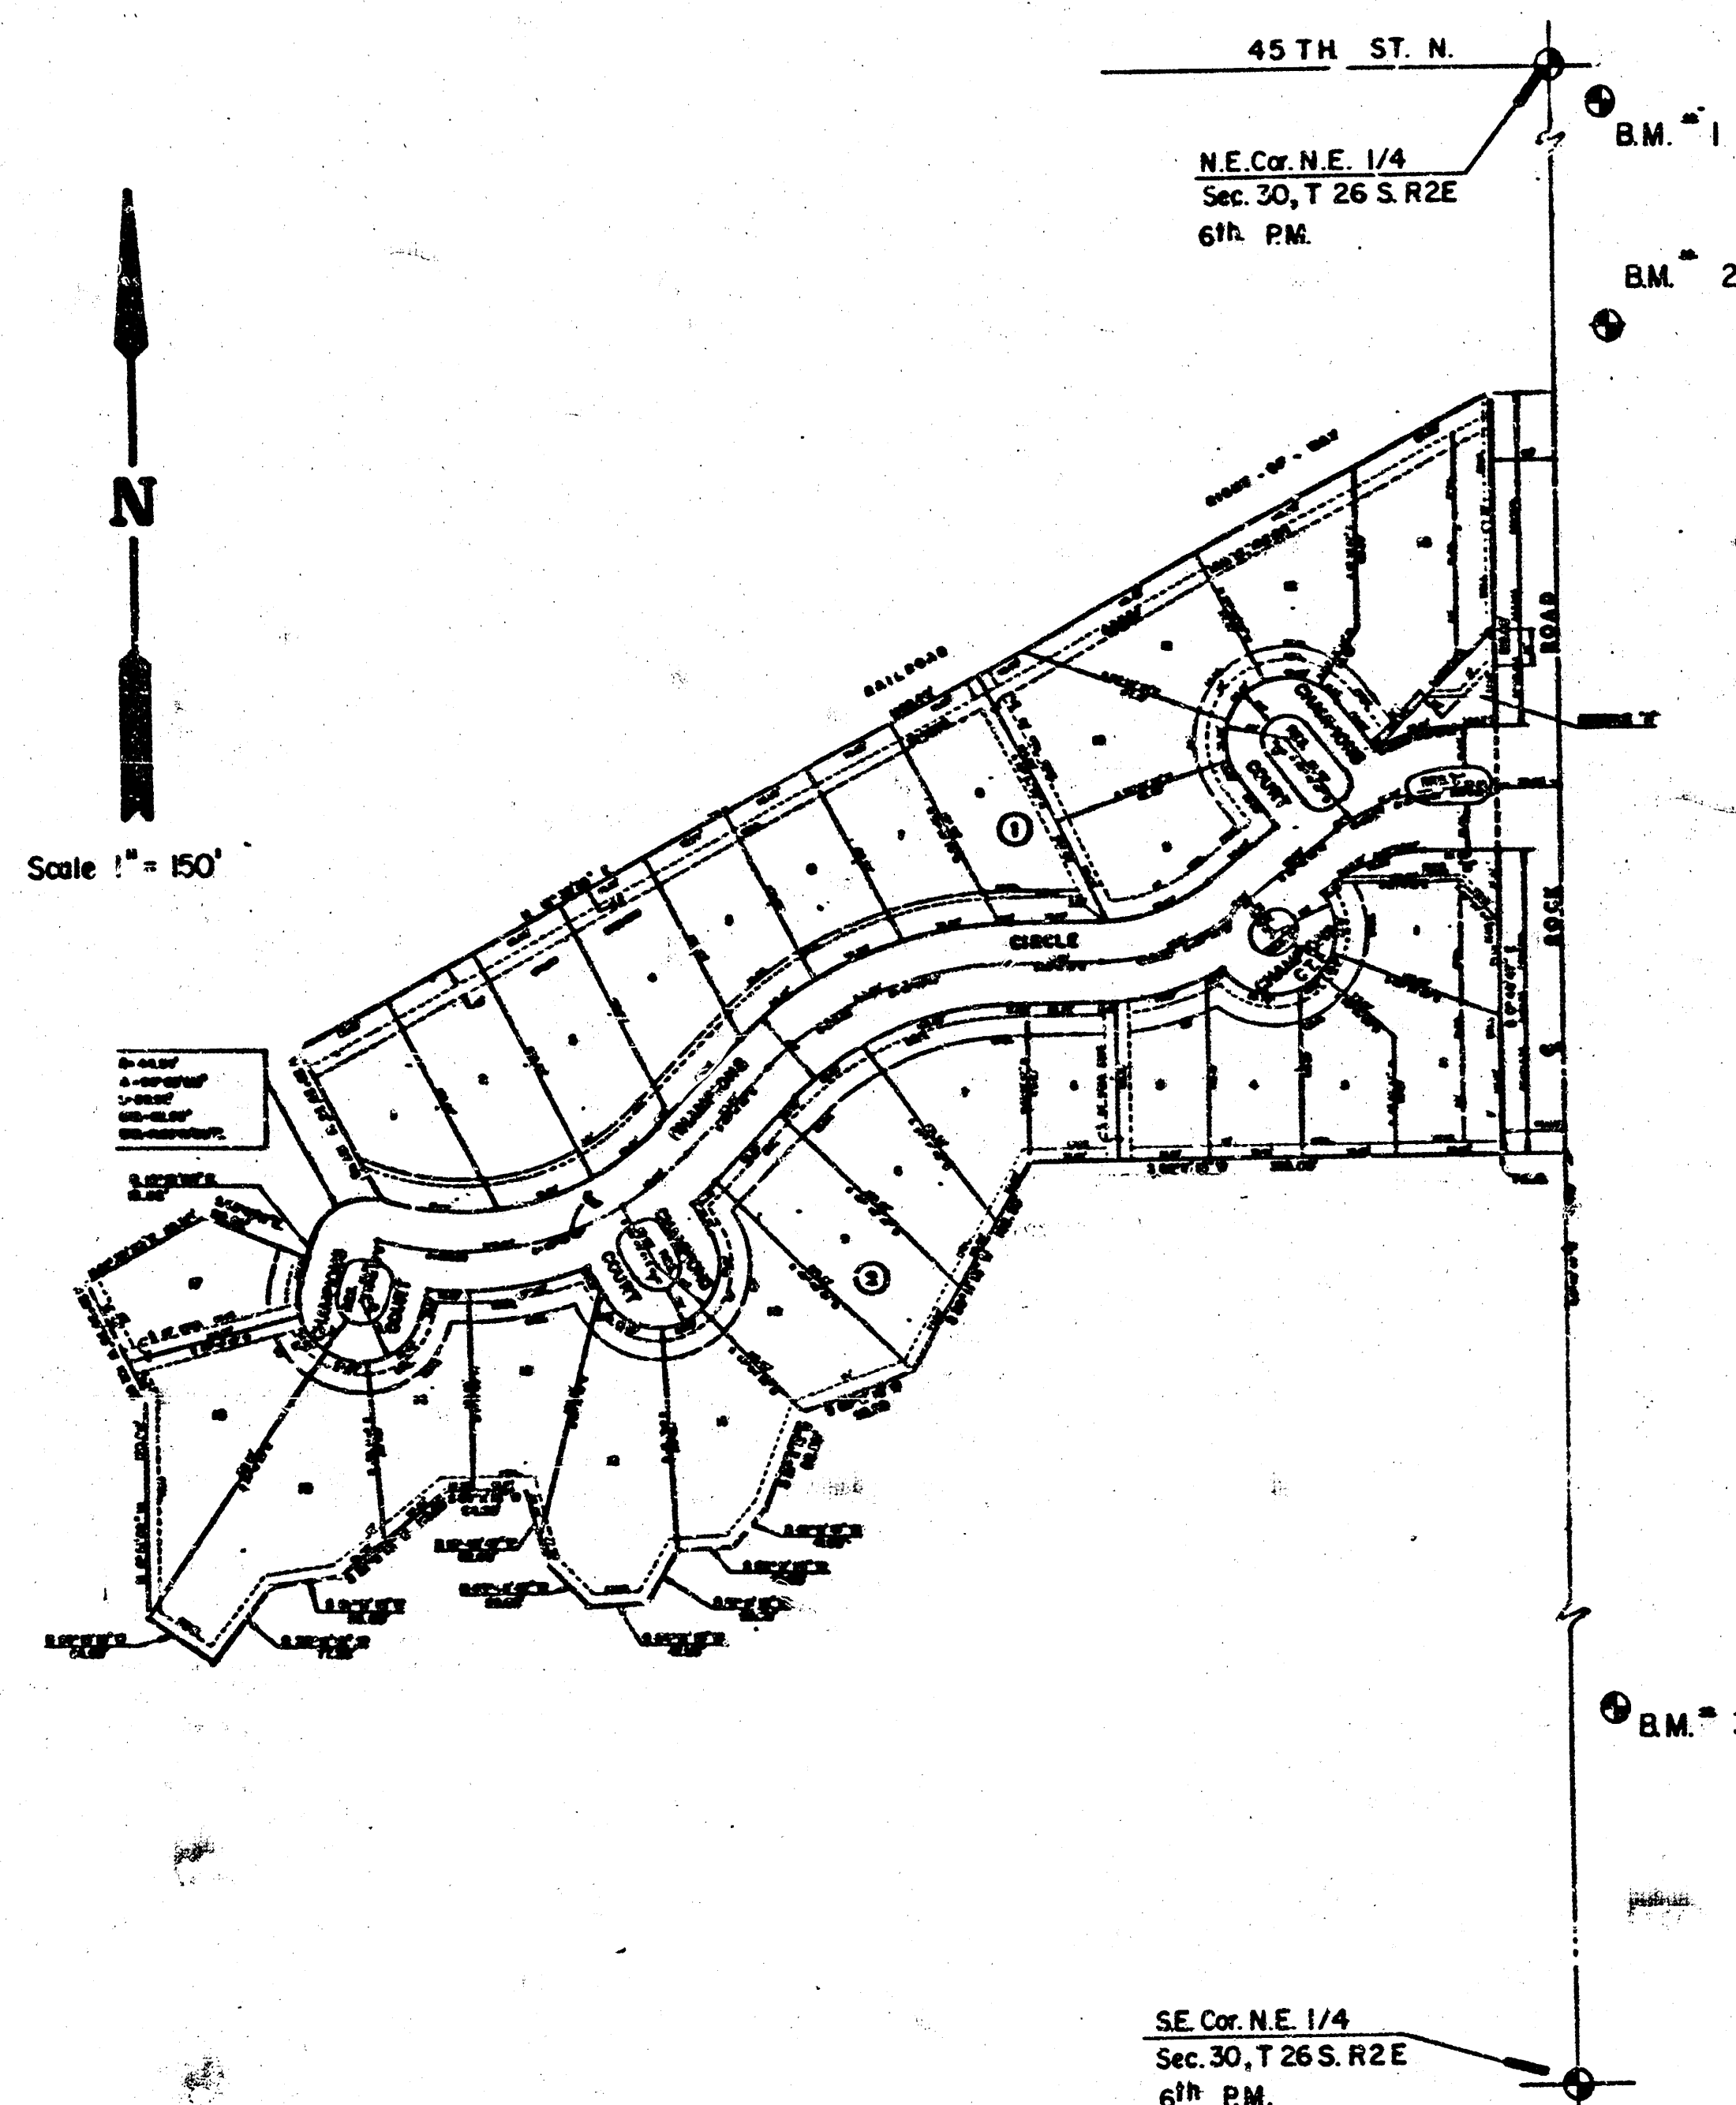


INDEX TO DRAWINGS

SHEET NO.	DESCRIPTION
1	TITLE SHEET
2-3	PAVING DETAILS
4-5	CHAMPIONS CIRCLE
6	FINAL PLAT


AS BUILT - OCT 1988

	WILLOWBEND FIFTH	Design
	PAVING PLANS	Drawn by
		Checked by
		Date Aug. 1987
MID-KANSAS ENGINEERING CONSULTANTS PA 3500 NORTH ROCK ROAD BUILDING 1800 WICHITA, KANSAS 67226		Sheet 1 of 6 1/5
682-6561		


FILMED FROM THE BEST AVAILABLE COPY

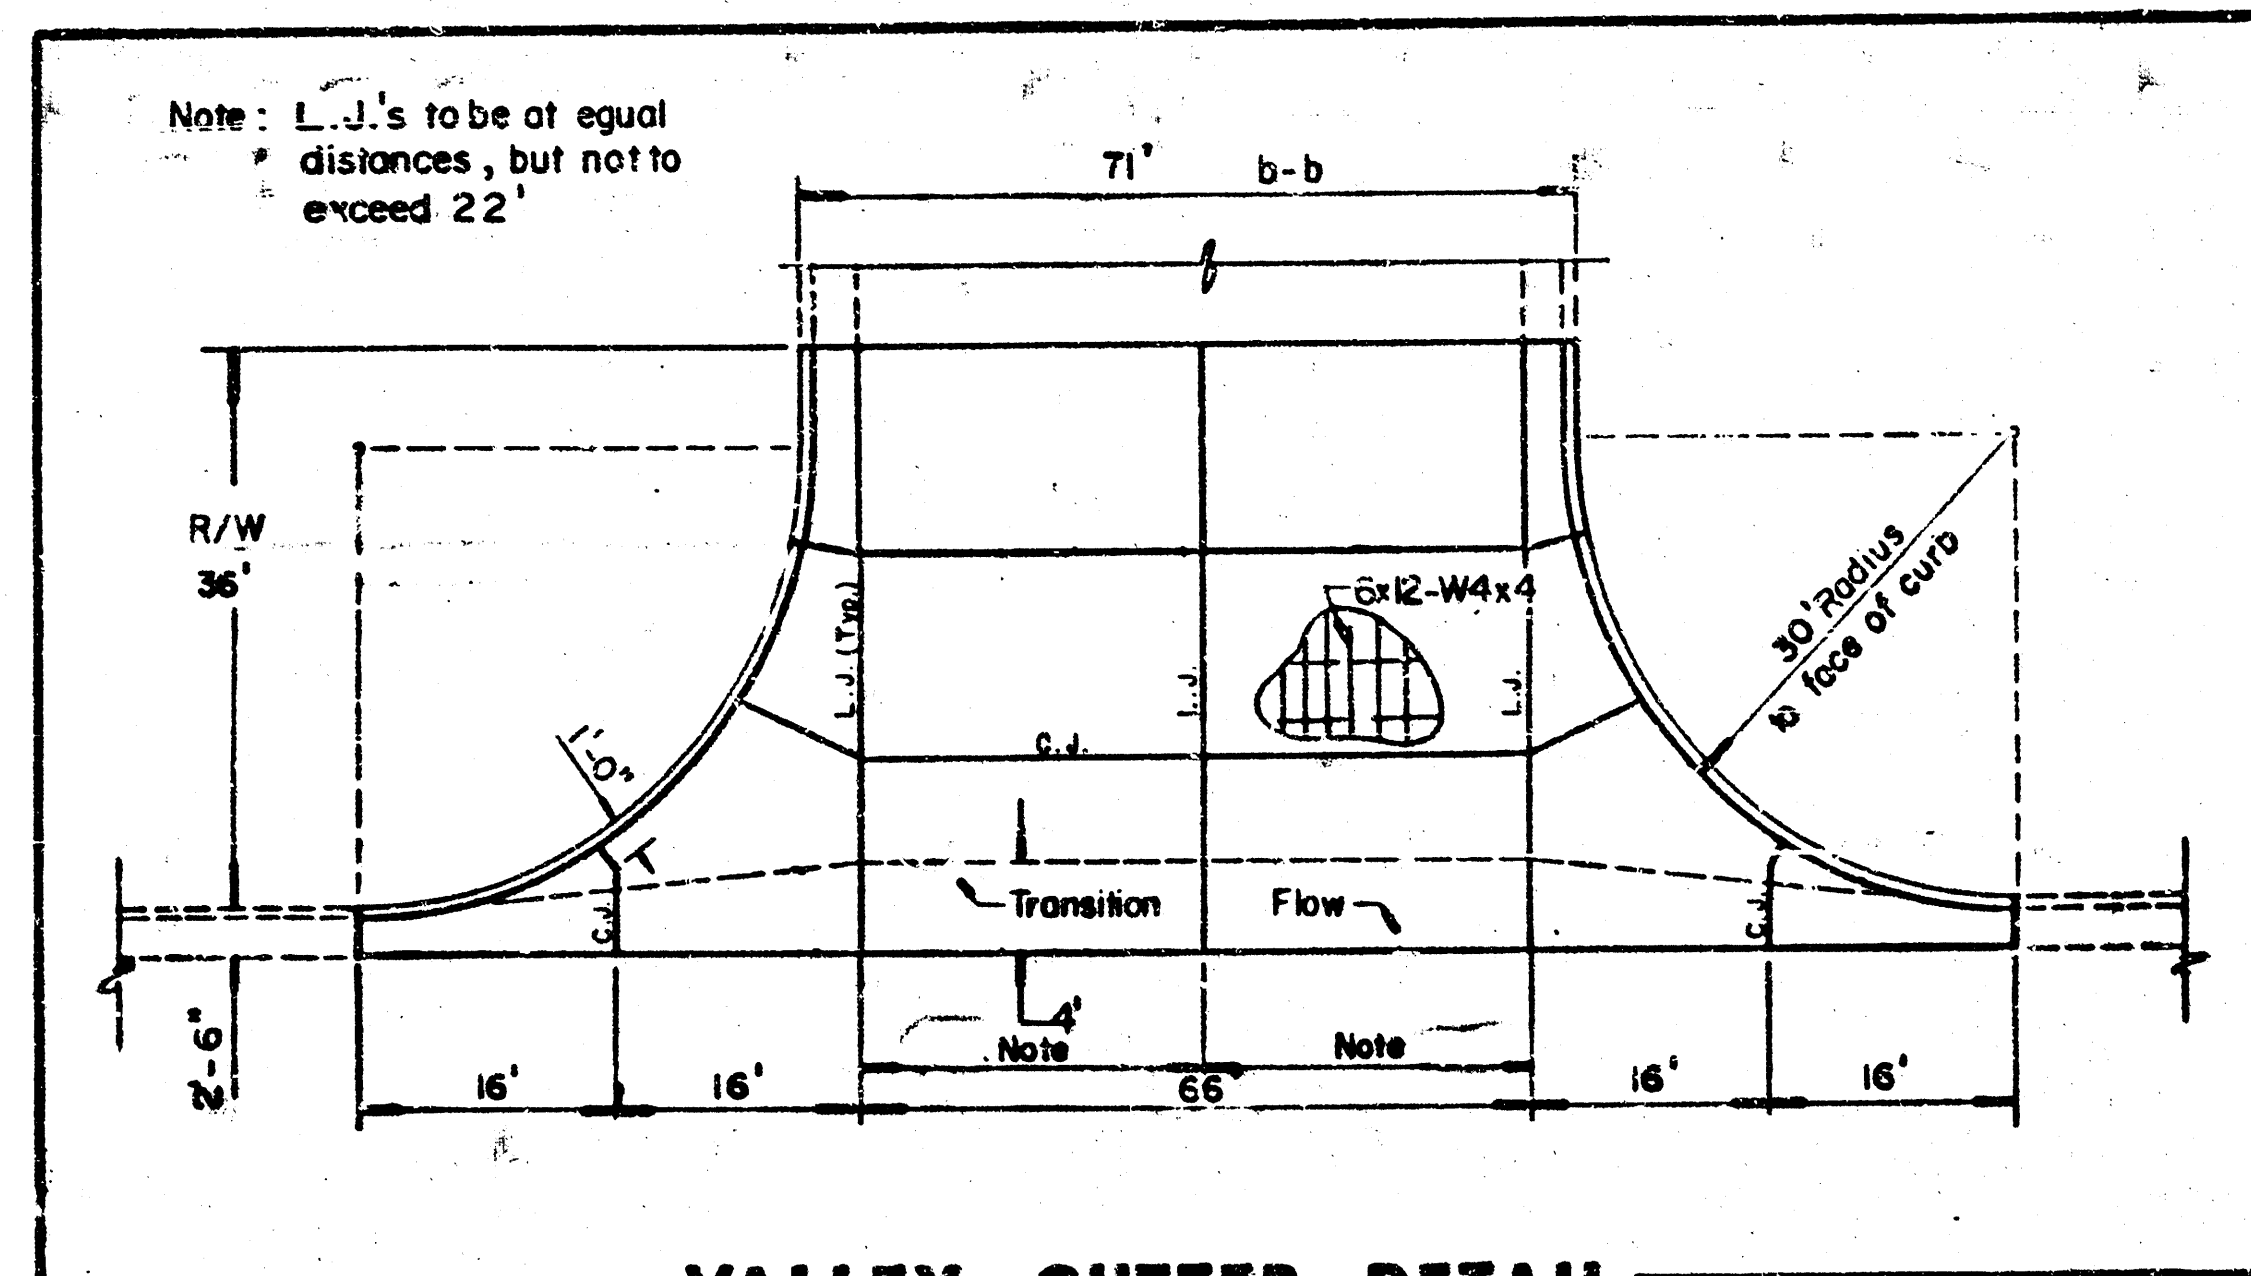


VALLEY GUTTER DETAIL
Champions Circle & Rock Road Intersection

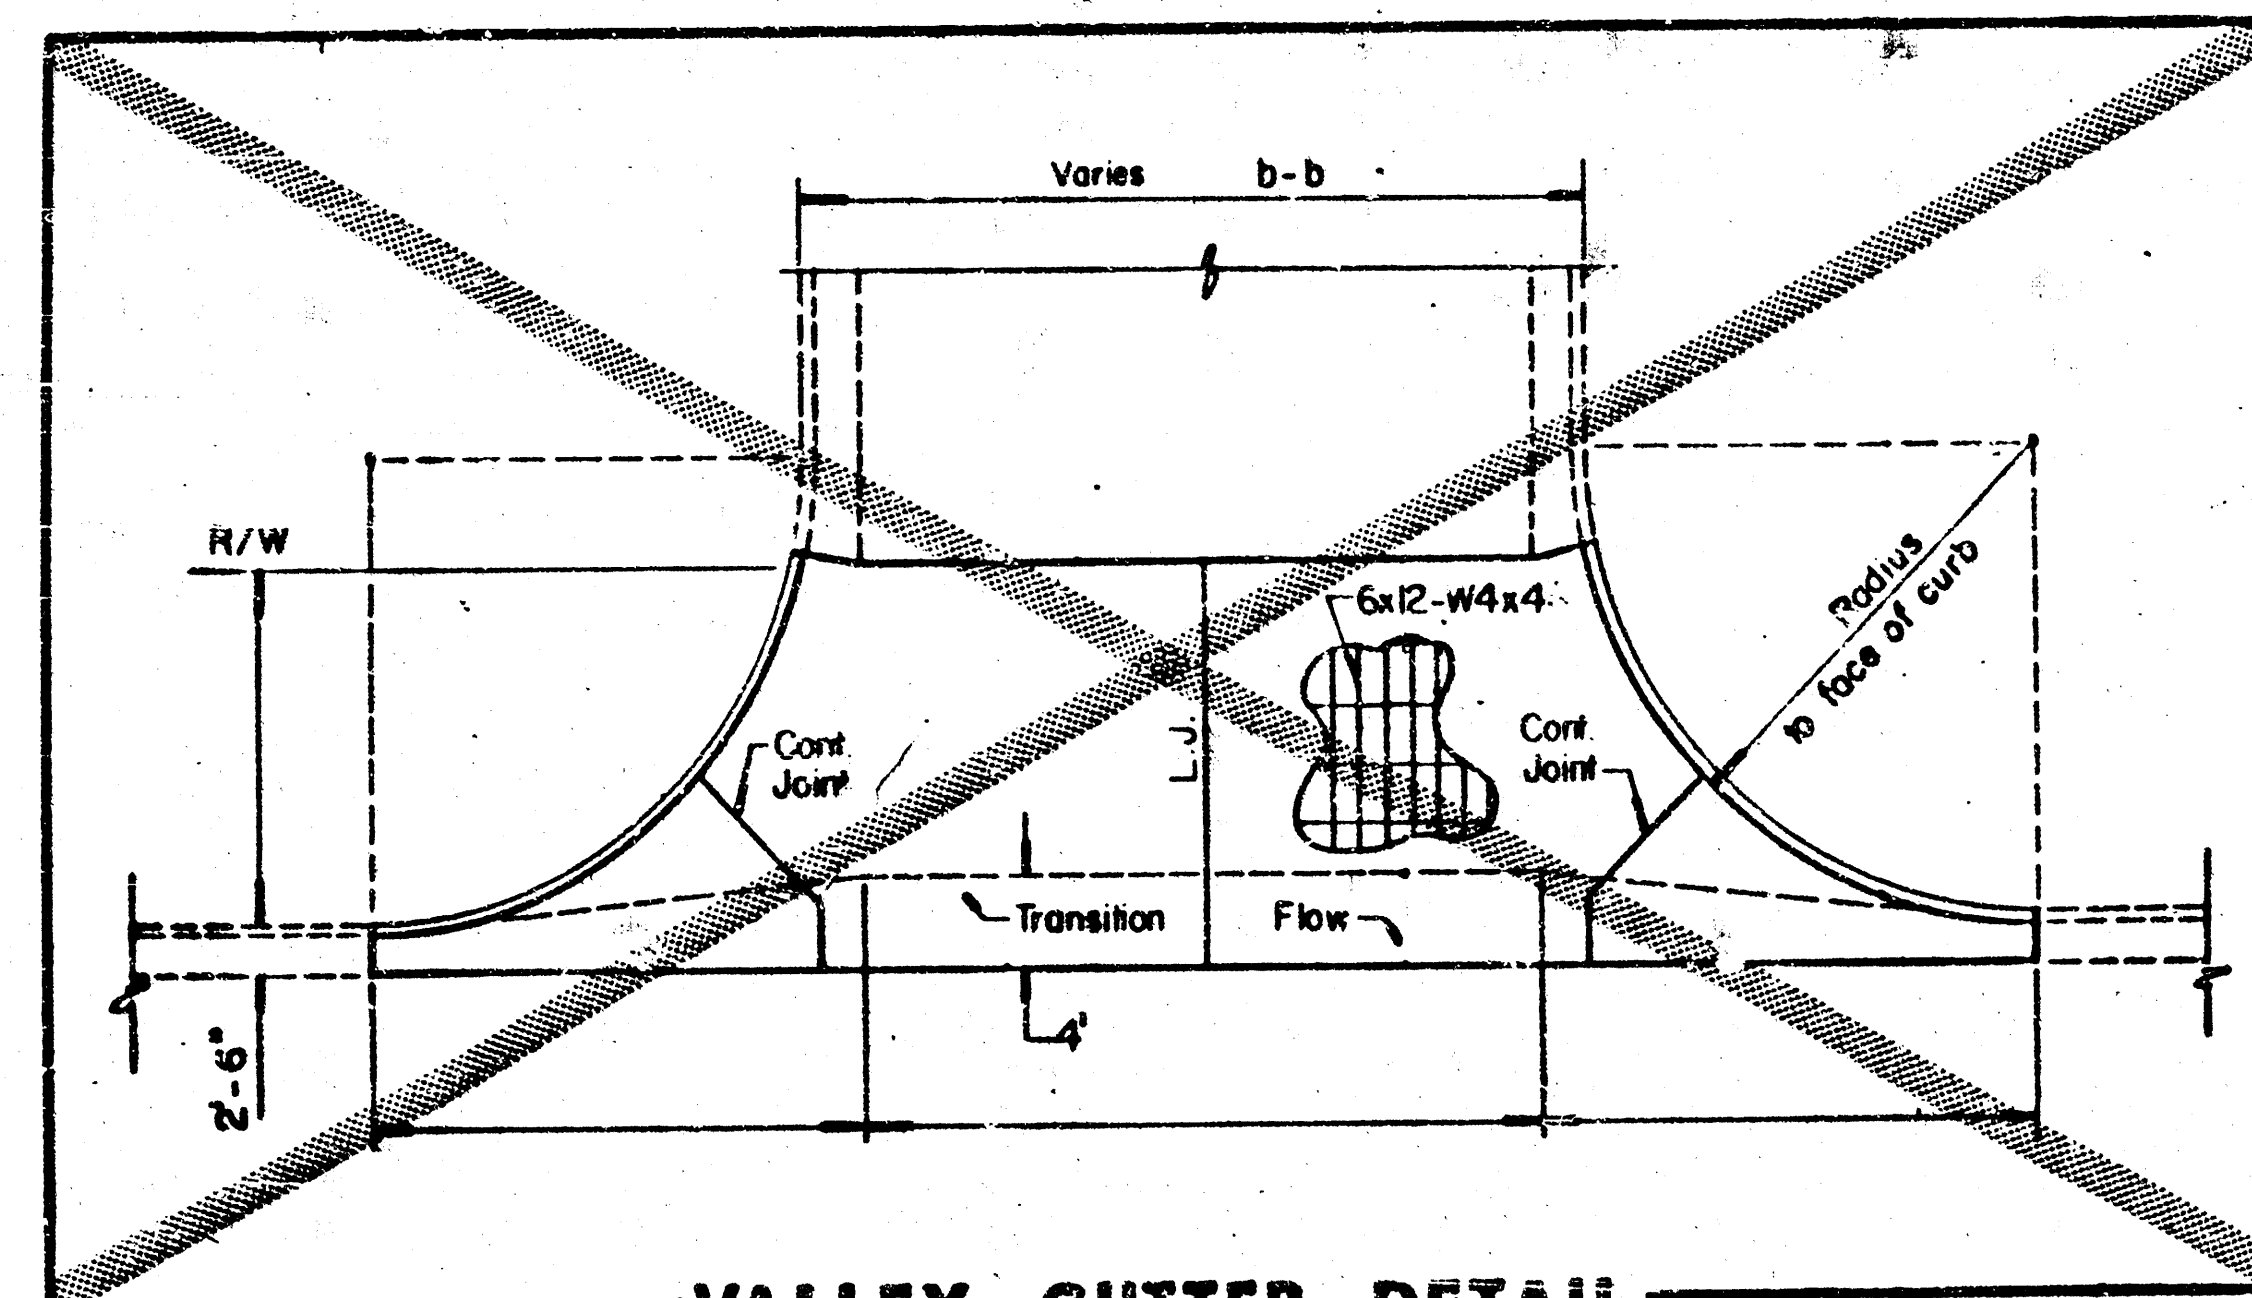


VALLEY GUTTER DETAIL

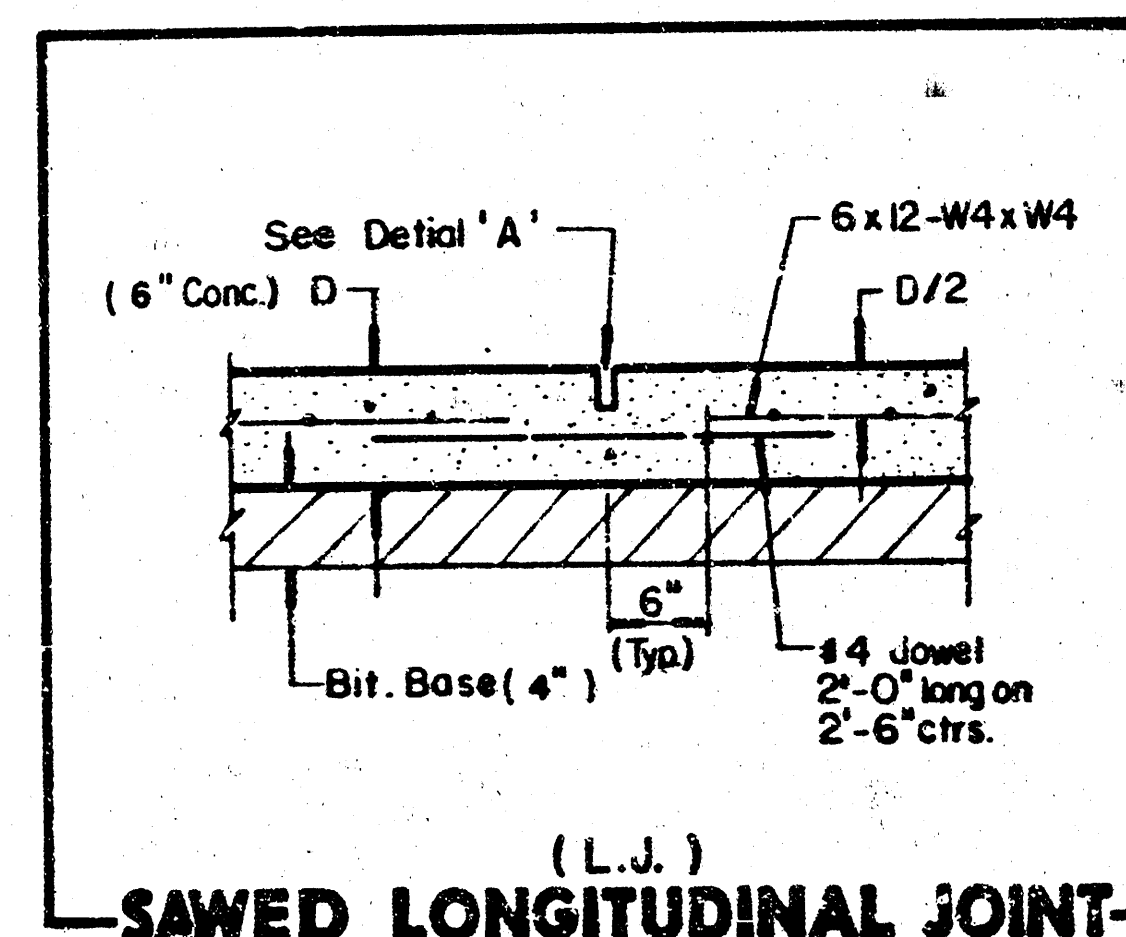


SAWED LONGITUDINAL JOINT

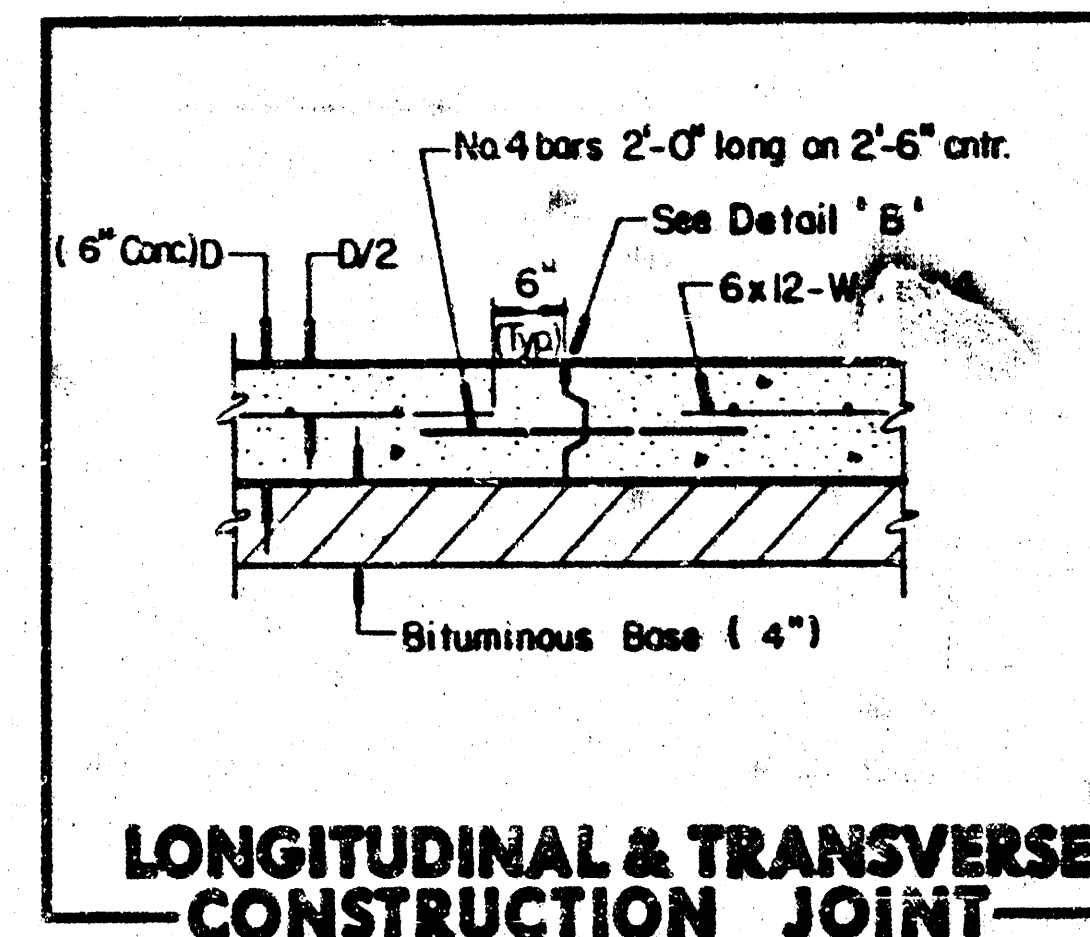


LONGITUDINAL & TRANSVERSE CONSTRUCTION JOINT

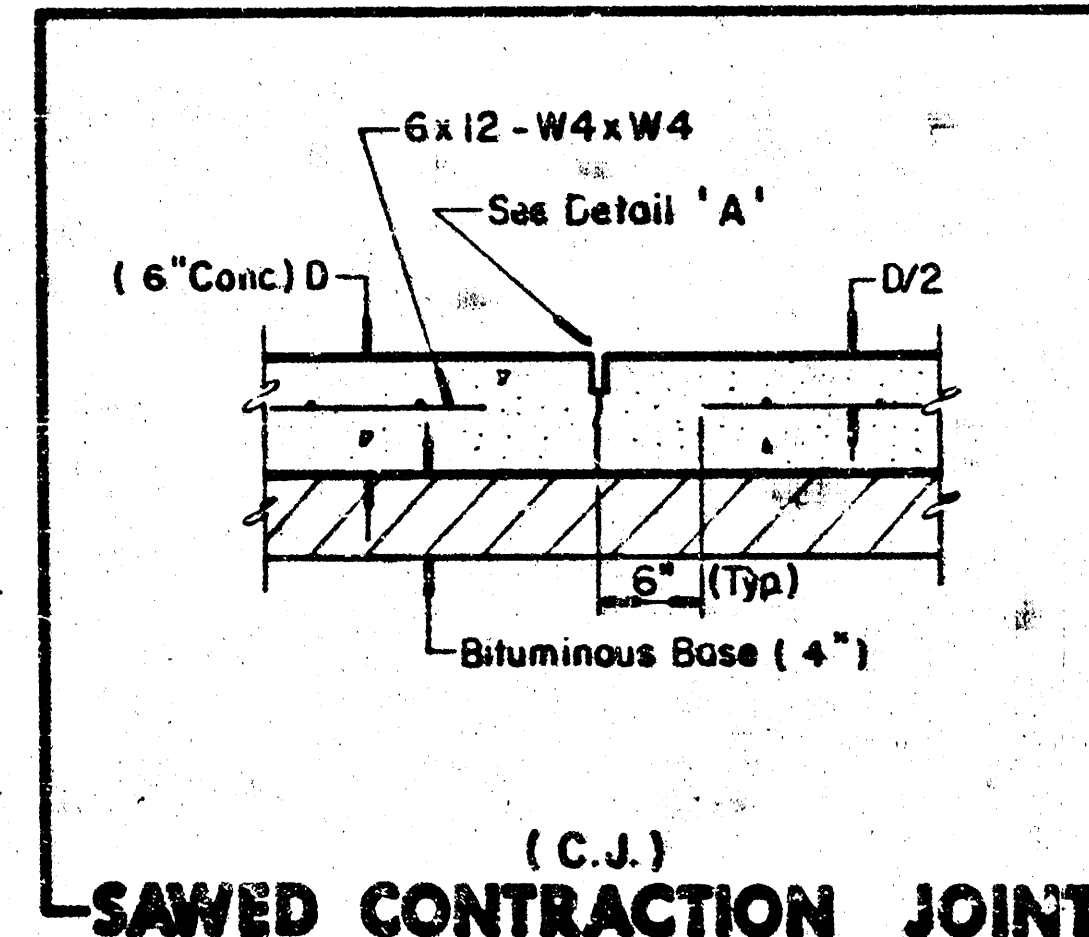

SAWED CONTRACTION JOINT

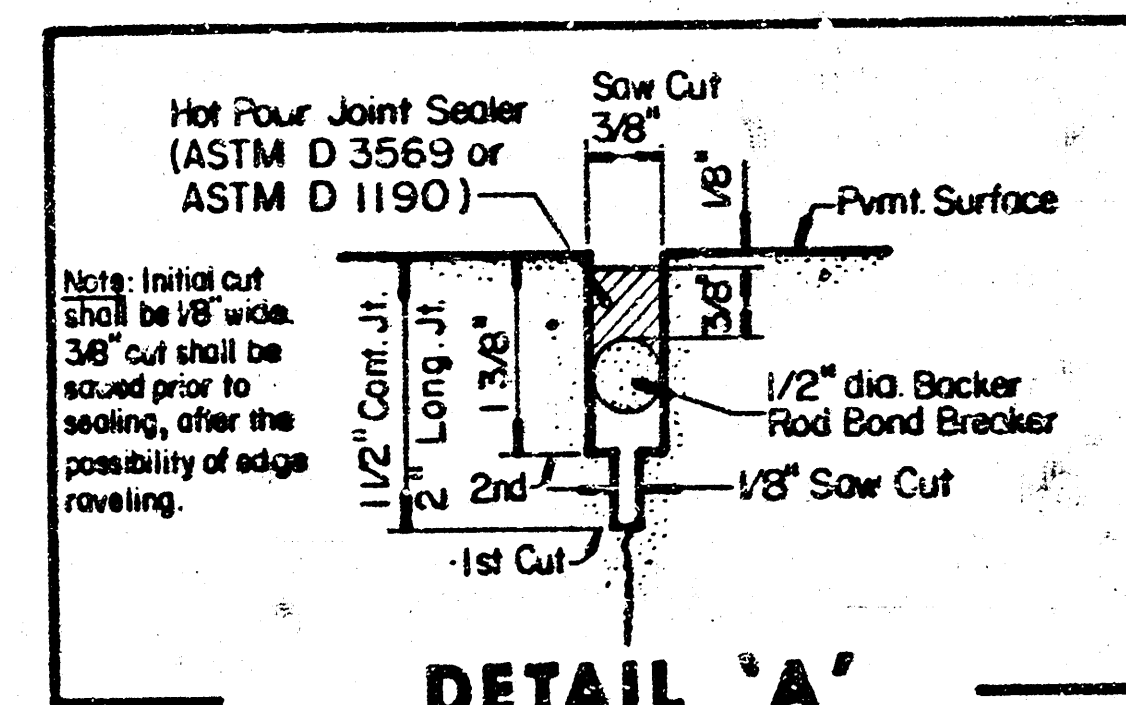

DETAIL 'A'

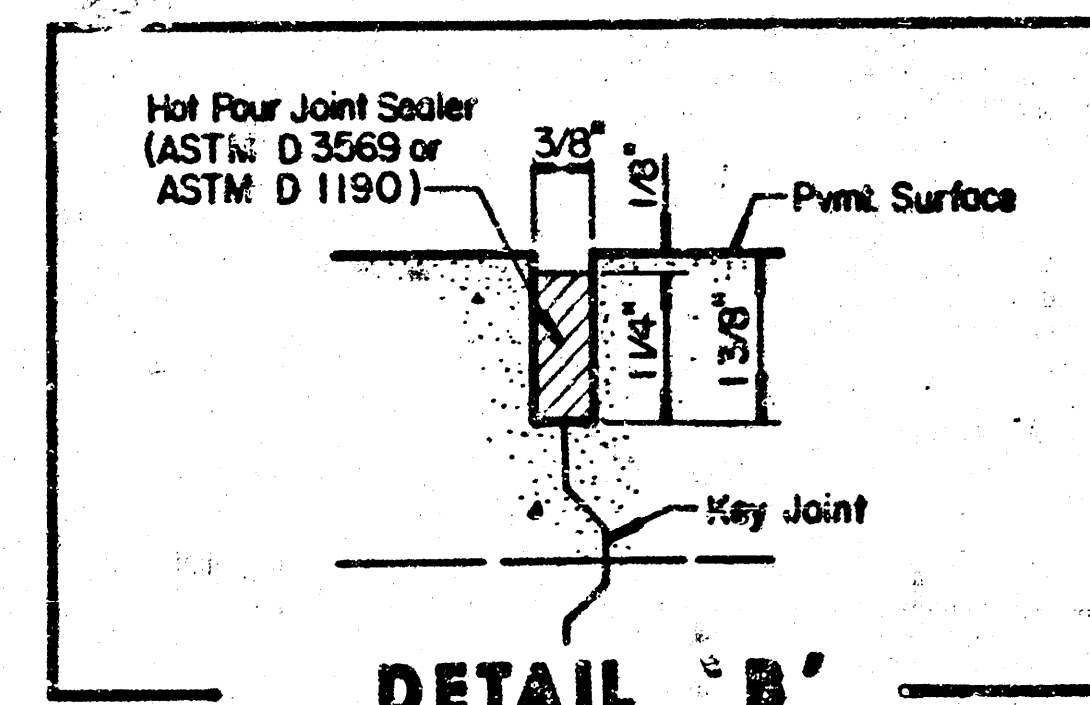

DETAIL 'B'



DETAILS

MID-KANSAS ENGINEERING CONSULTANTS PA
3500 NORTH ROCK ROAD
BUILDING #600
WICHITA, KANSAS 67226


682-6561

Design	
Drawn by	
Checked by	
Date	
Job no.	
Sheet	3
of	6

FILMED FROM THE BEST
AVAILABLE COPY

NOTE:
Top Of Curb Elevations Shown For
Full Curb, Construct Combined Curb
& Gutter (Roll Type):

WILLOWBEND
FIFTH
ADDITION

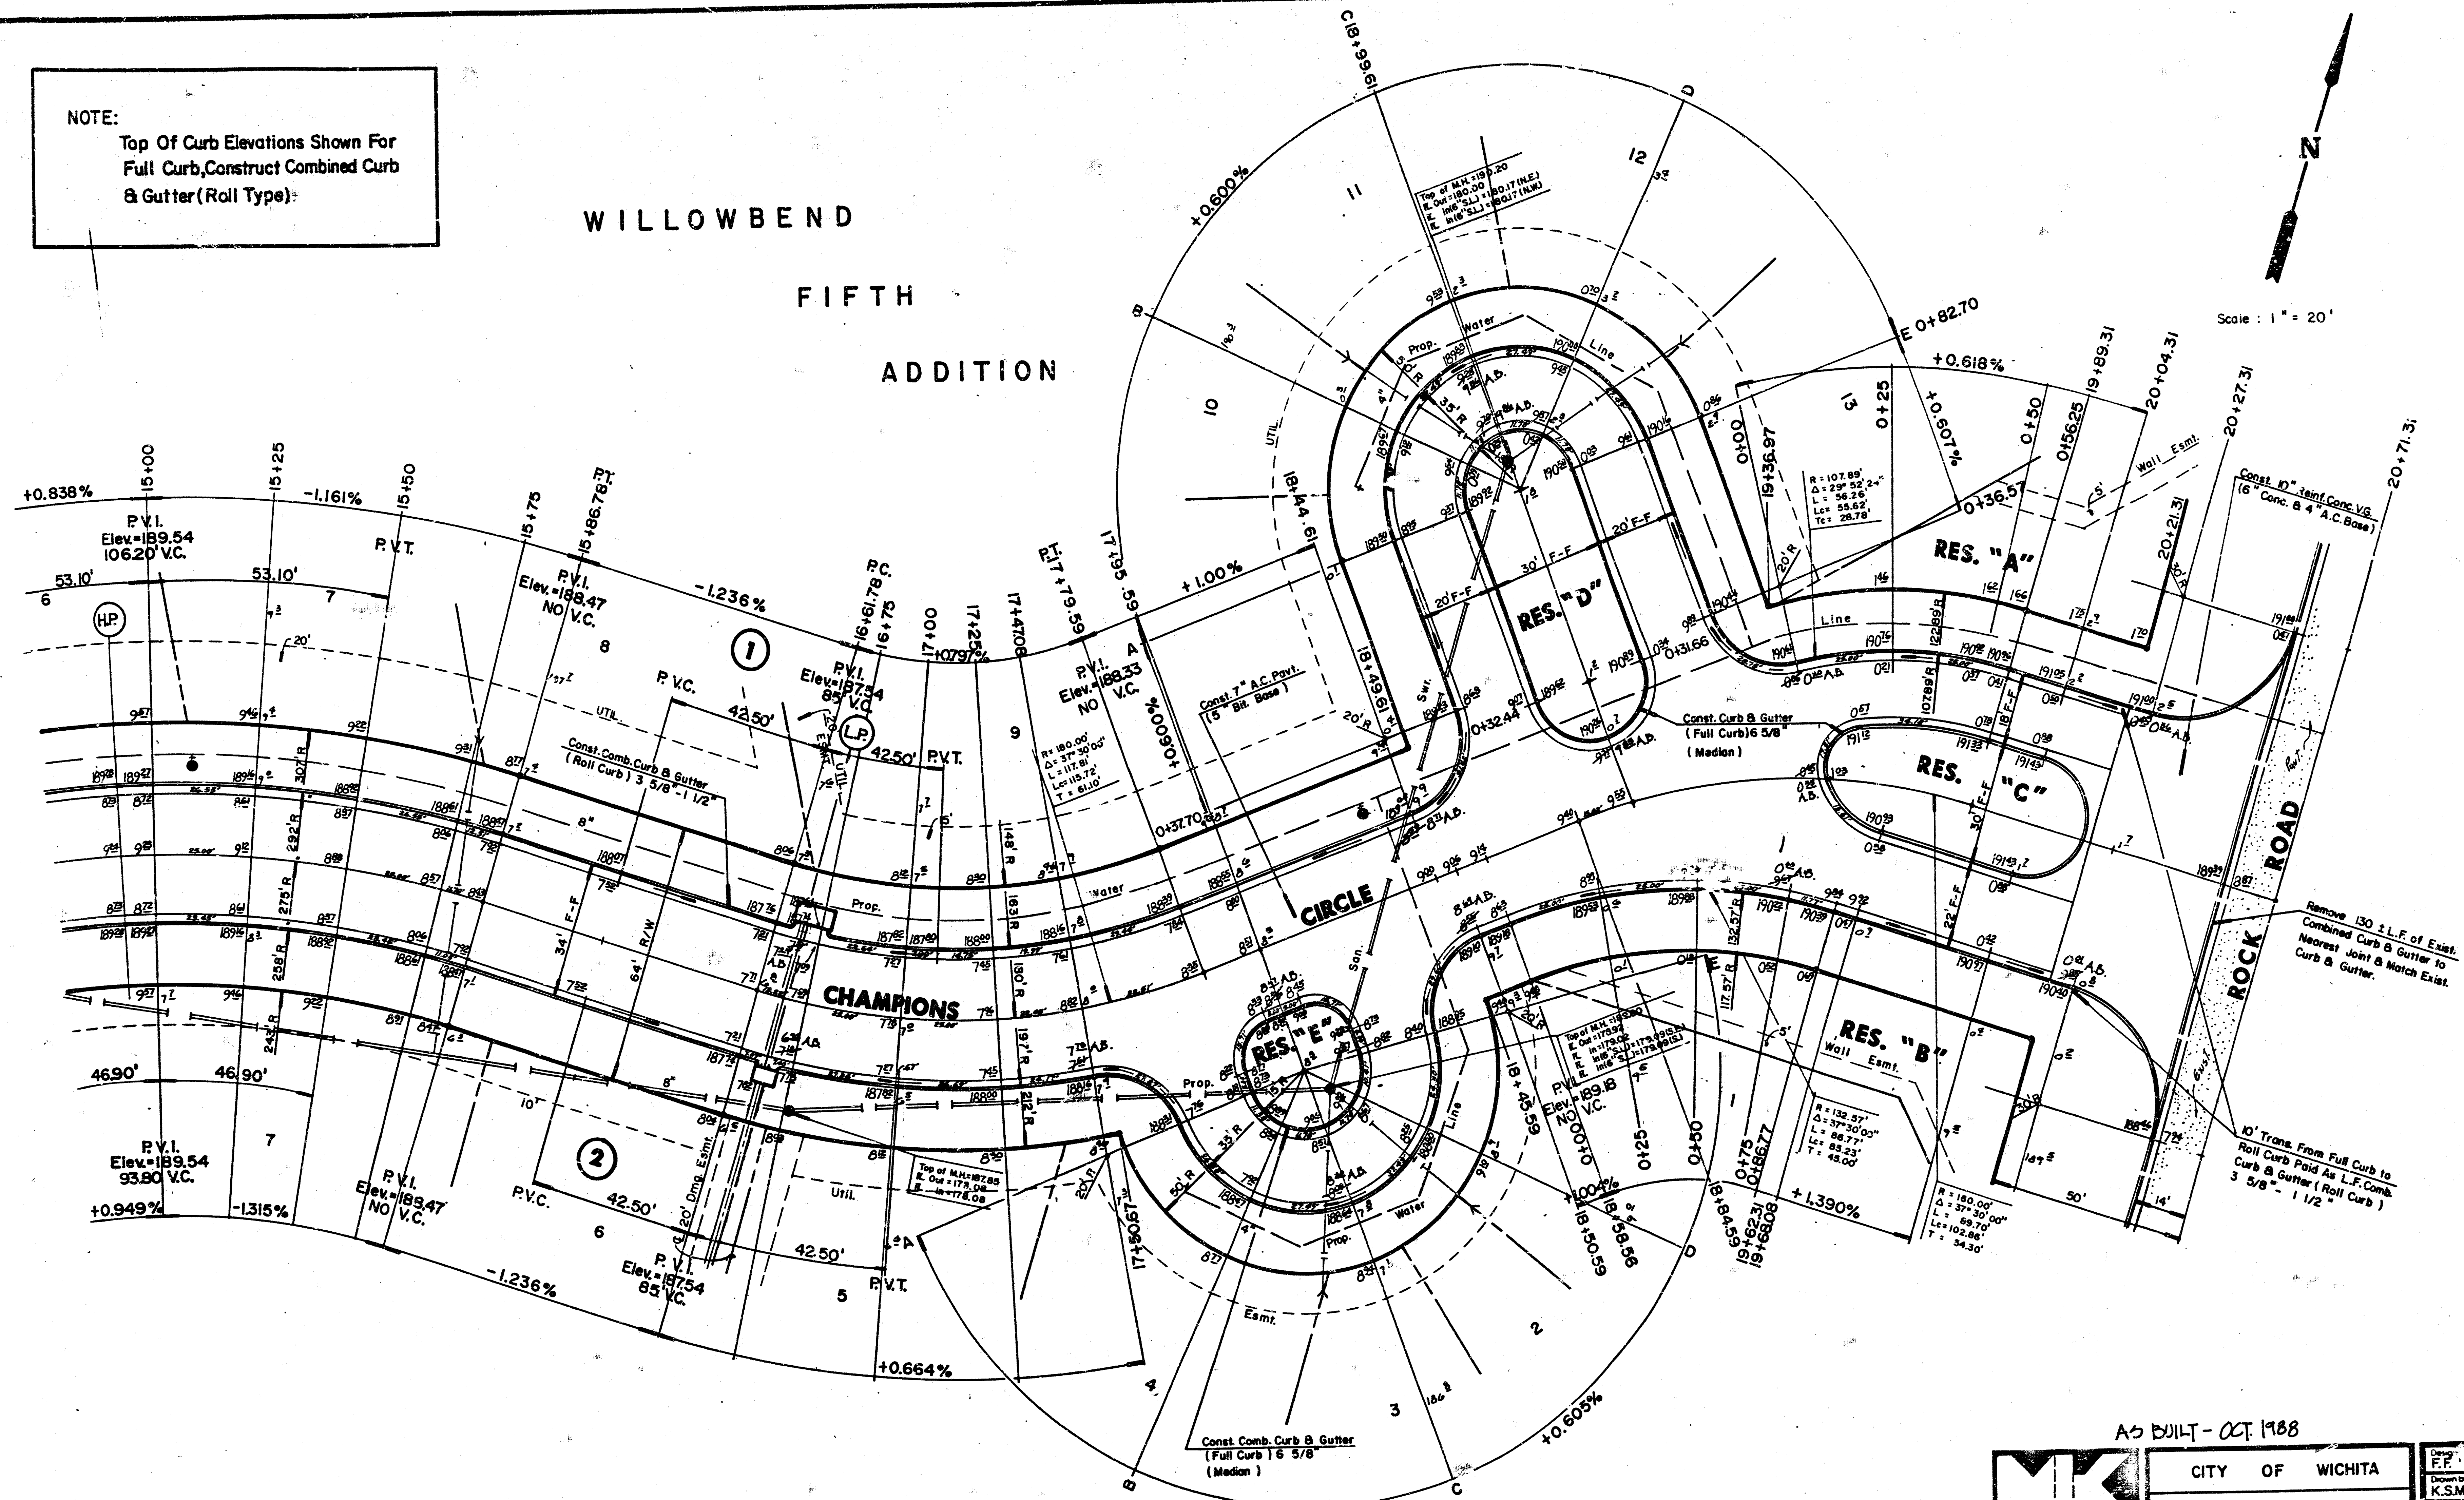

Scale: 1" = 20'


AS BUILT - OCT. 1988

	CITY OF WICHITA		Drawn by K.S.M., E.C.G.
	CHAMPIONS CIRCLE		Checked by Date AUG. 1987
	PROJECT NO. 472-76-245-80001-000-000-030		Job no.
	MID-KANSAS ENGINEERING CONSULTANTS PA 3500 NORTH ROCK ROAD BUILDING 1600 WICHITA, KANSAS 67226		Sheet 4 of 6

FILMED FROM THE BEST
AVAILABLE COPY

WILLOWBEND FIFTH ADDITION

Scale: 1" = 20'

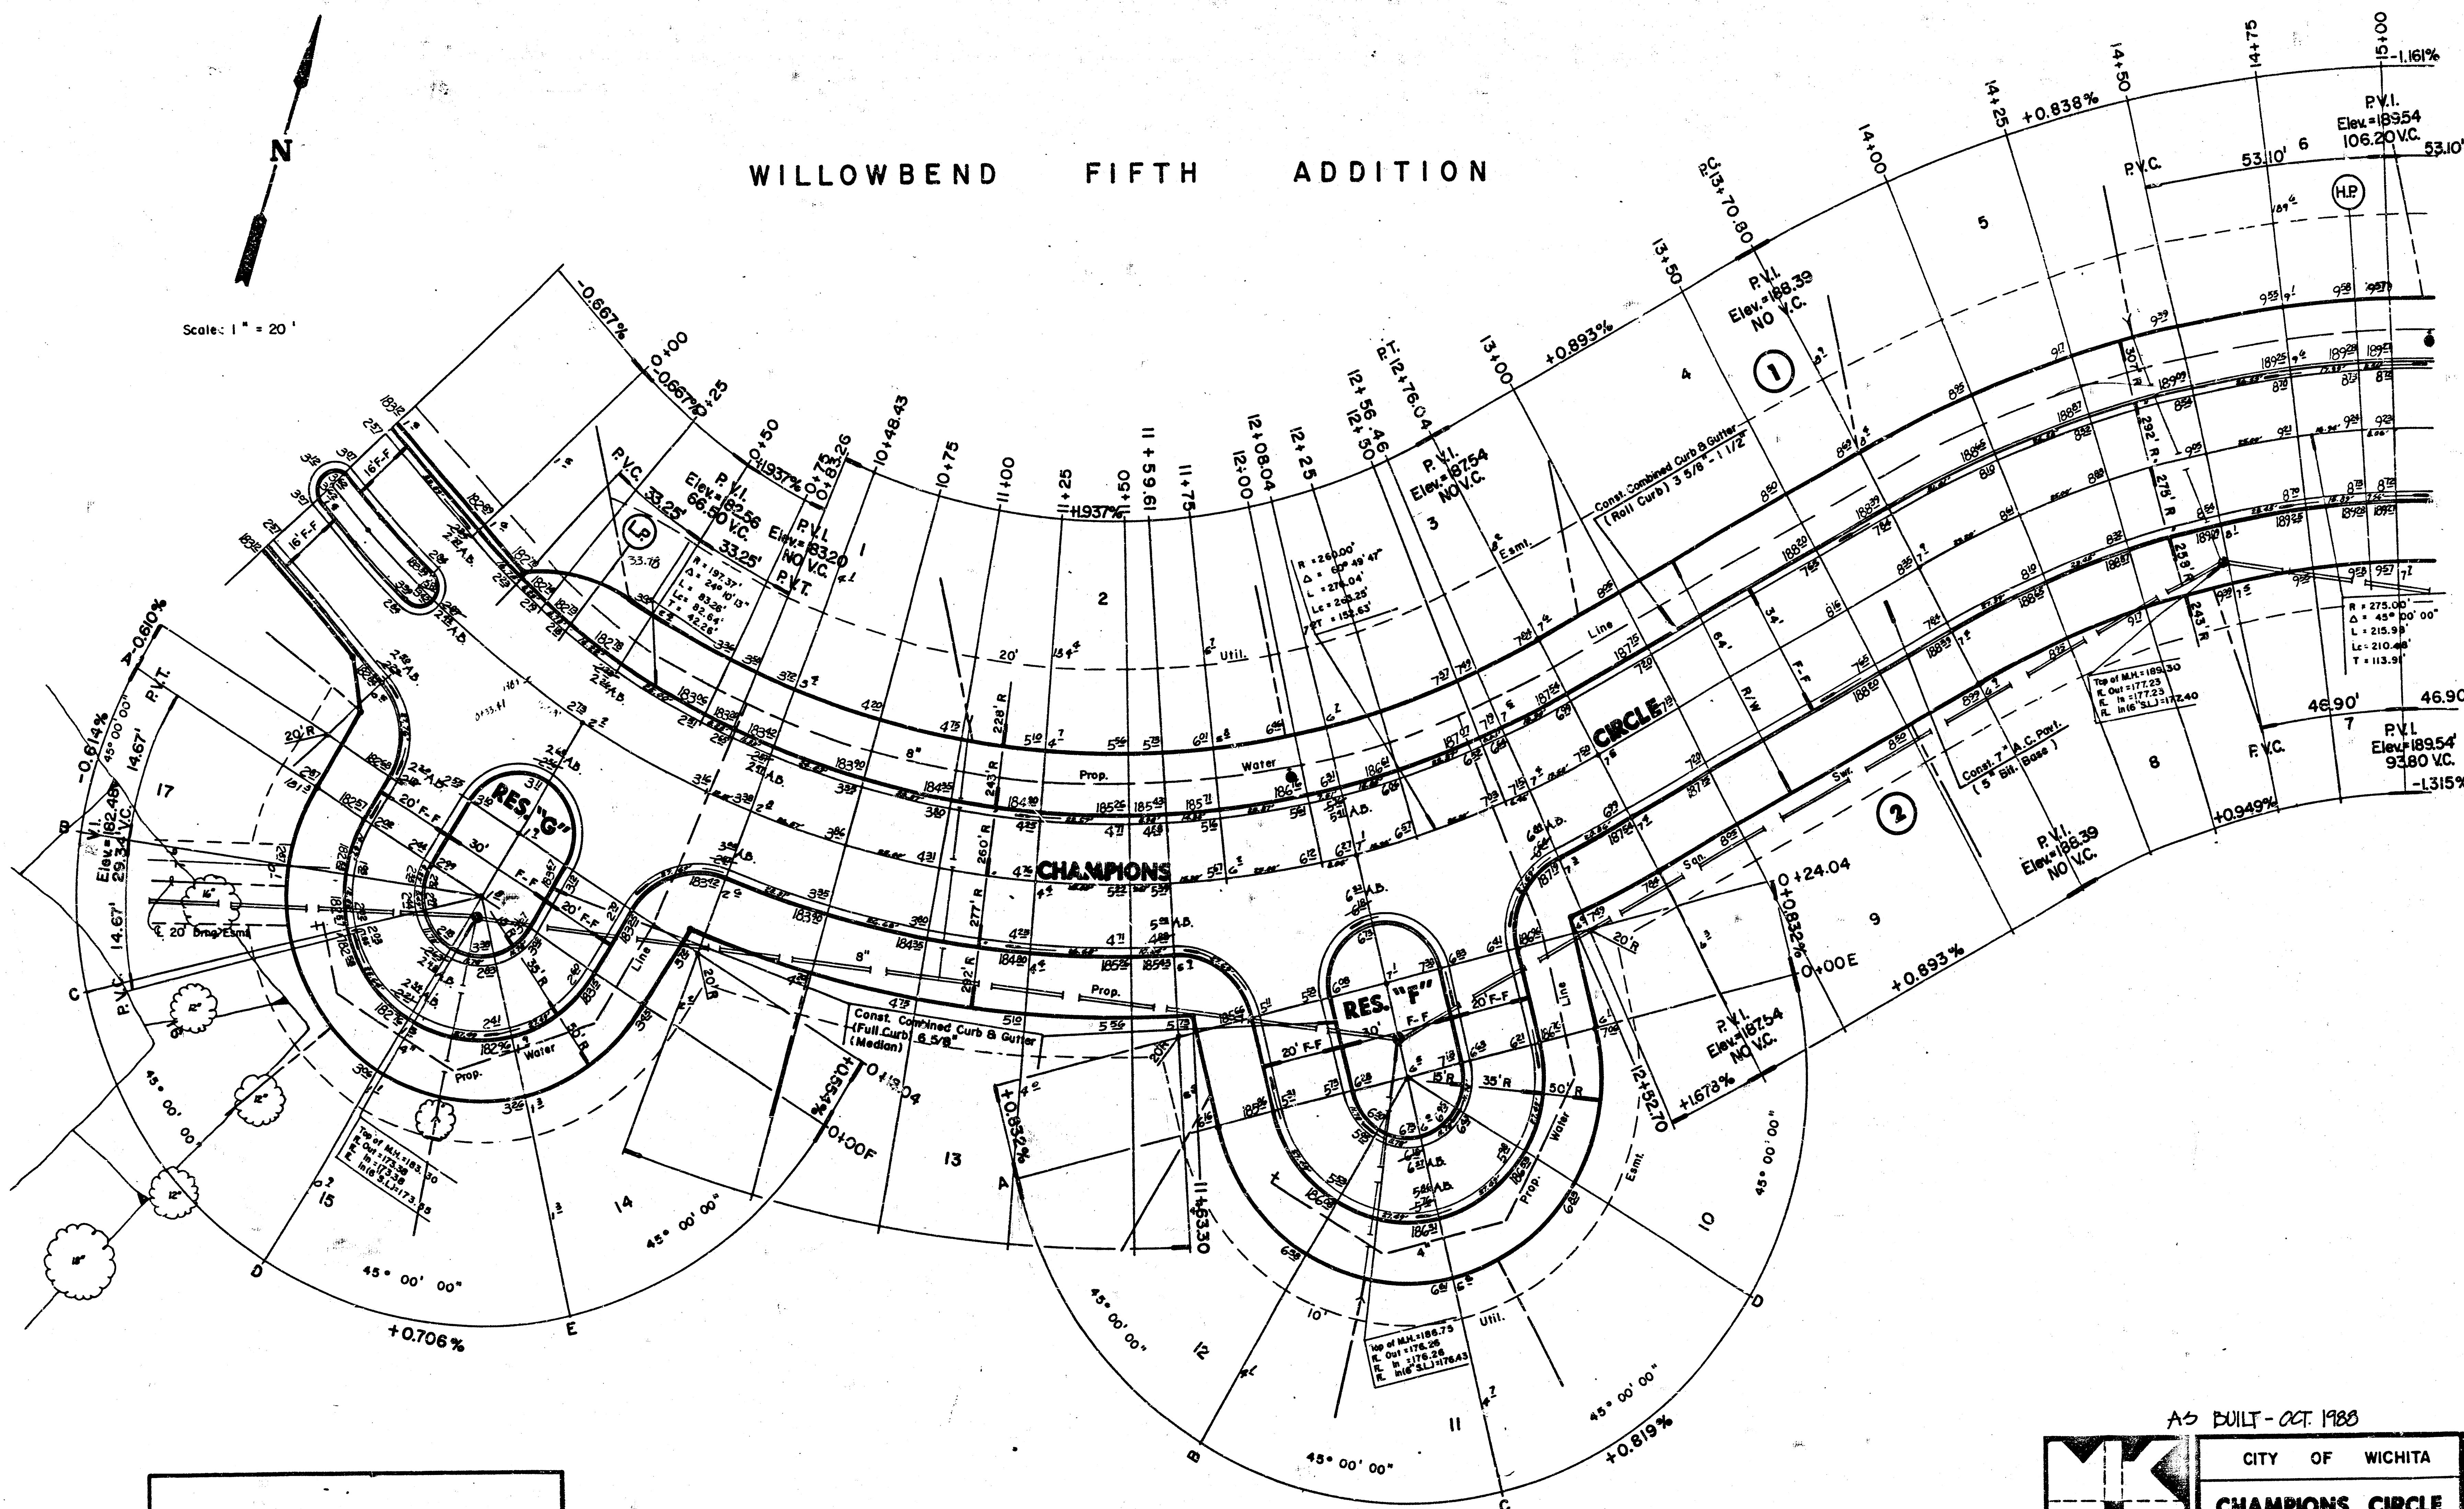

NOTE:
Top Of Curb Elevations Shown For
Full Curb, Construct Combined Curb
& Gutter (Roll Type).

AS BUILT - OCT. 1988

	CITY OF WICHITA	Design F.F.
	CHAMPIONS CIRCLE	Drawn by K.S.M.E.C.G.
	PROJECT NO. 472-76-245-80001-000-000-030	Checked by
	MID-KANSAS ENGINEERING CONSULTANTS PA 3500 NORTH ROCK ROAD BUILDING 1800 WICHITA, KANSAS 67226	Date AUG. 1987

Sheet
5
of 6

FILMED FROM THE BEST
AVAILABLE COPY