


H-7 Seal

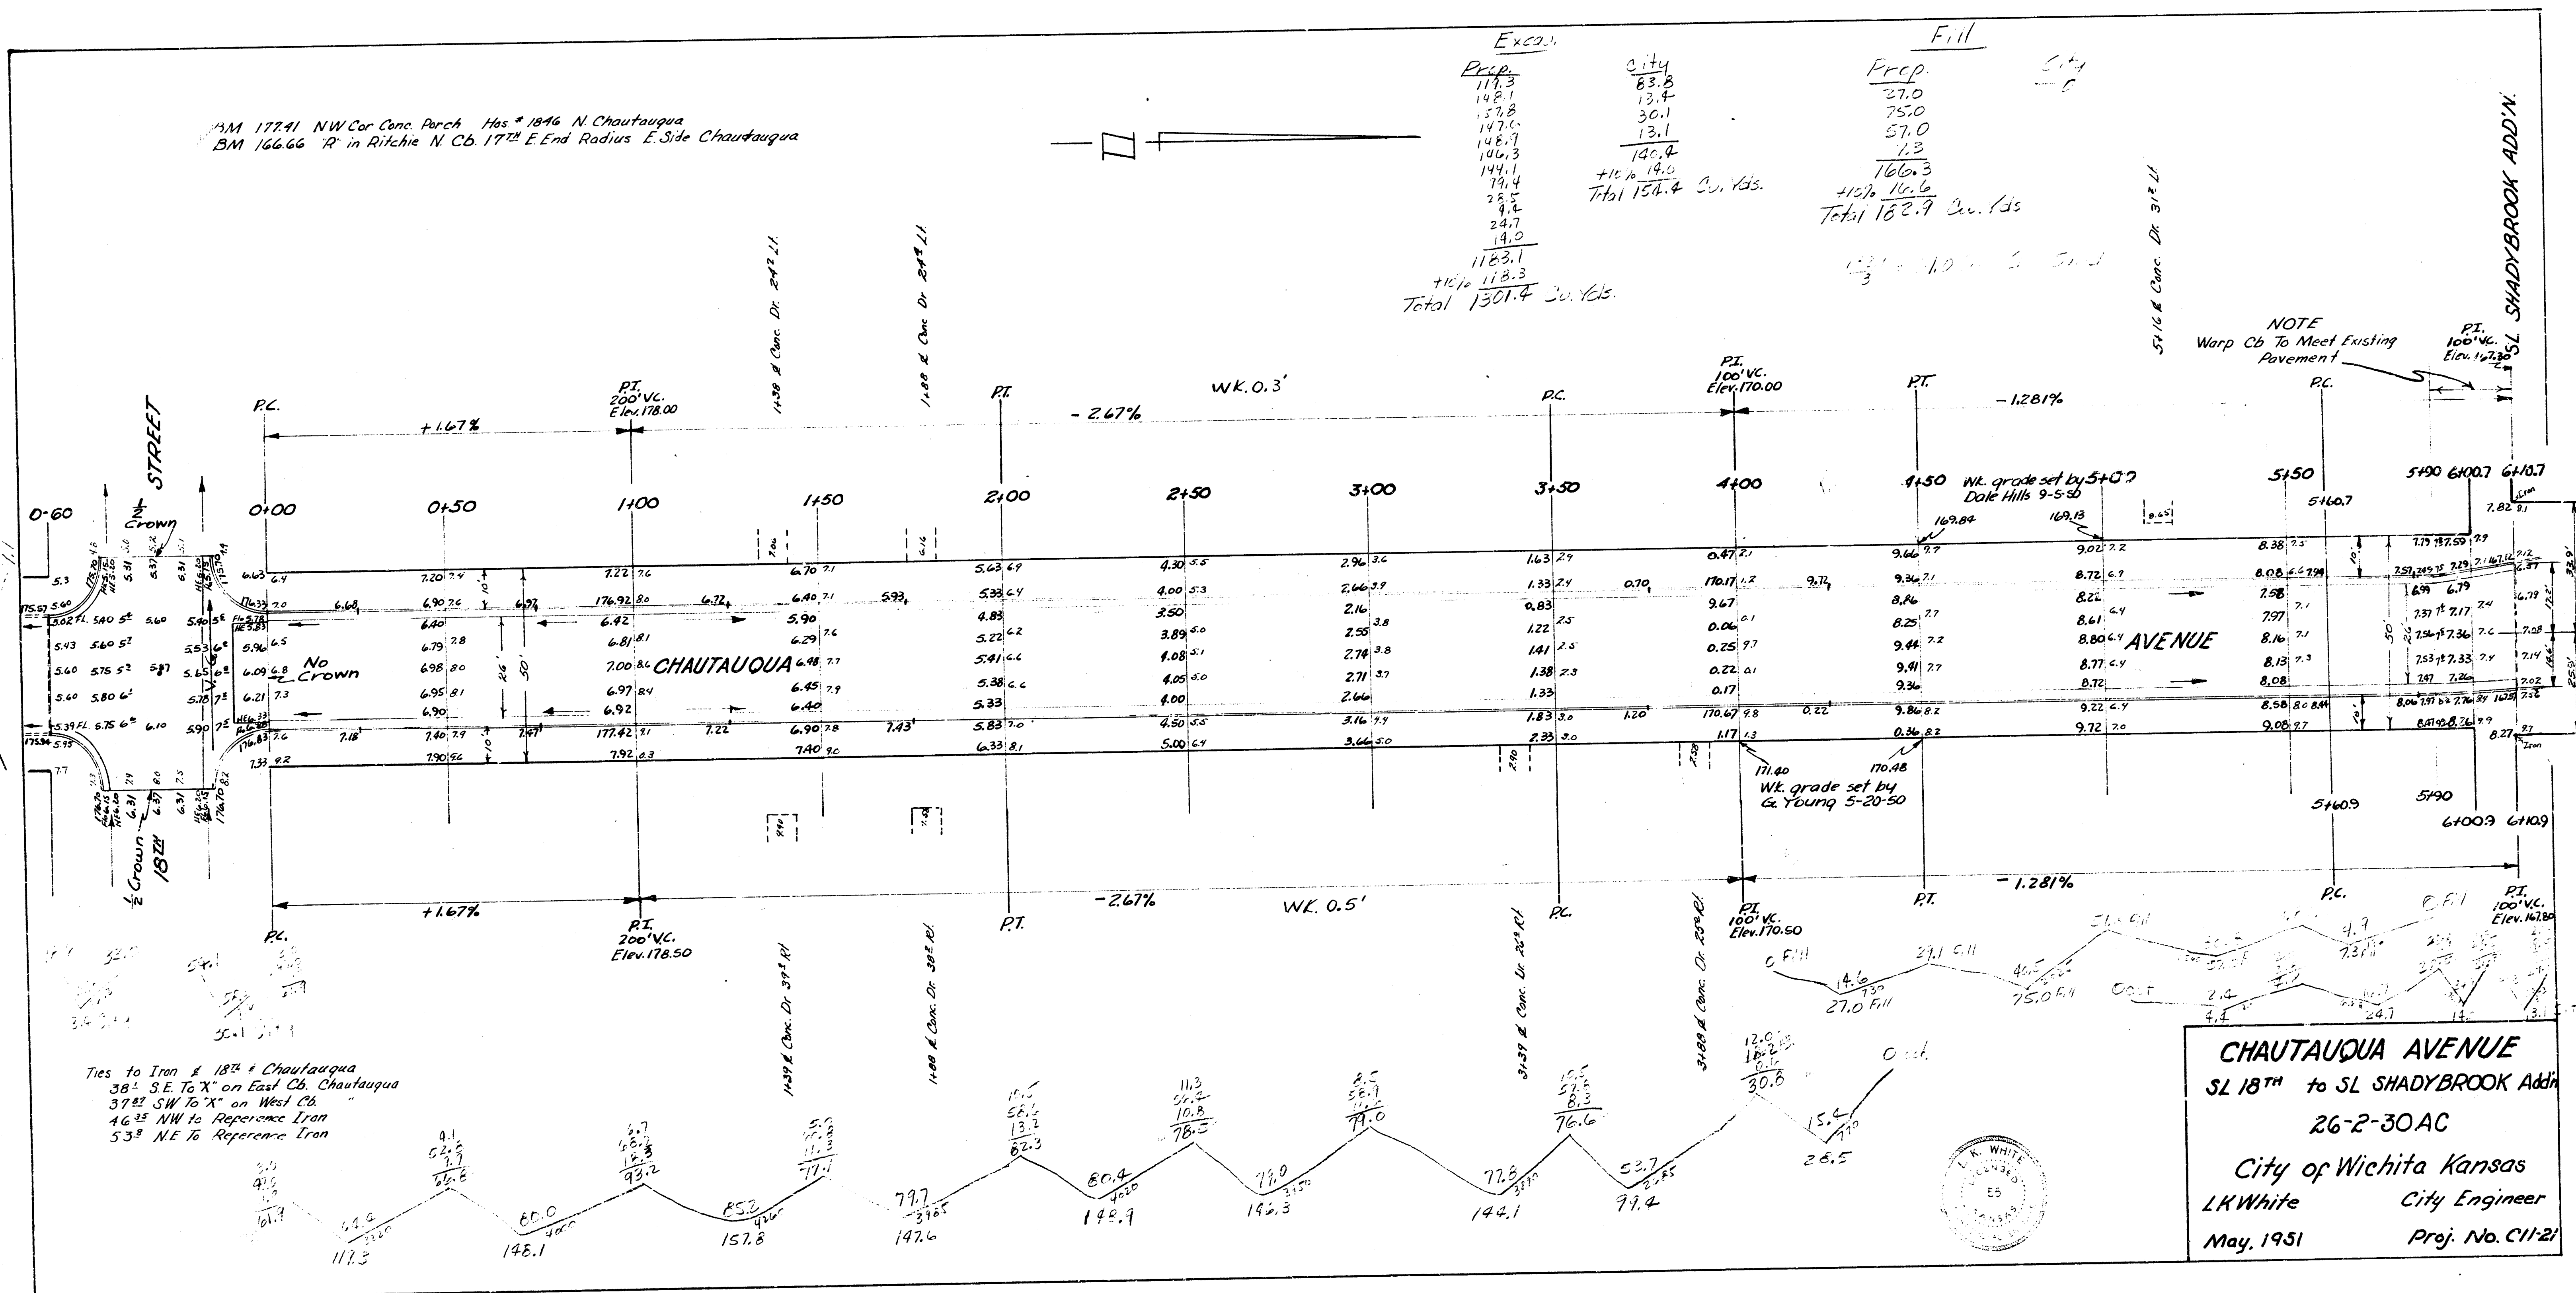

1942
 Chautauqua - SL Shadybrook Add - SL Stadium
 30' Conc - Int Curb

Note: E of 30' pavement doesn't coincide with E of R/W. Distances are shown on plan. Pavement shifted to match E of Chautauqua South.

Stations measured with 50' chords on E of R/W. X sections taken radially.

