


B.M. 9841 'G' in Globe Top cb. E.S. Ellis - S.L. Blake.



Ellis Ave.
S.L. King Michaelson 3rd Add'n - S.L. Blake
26'-2'-30" AC.
City of Wichita, Kansas
L.H. White City Engineer
February 1998 Project 019-4

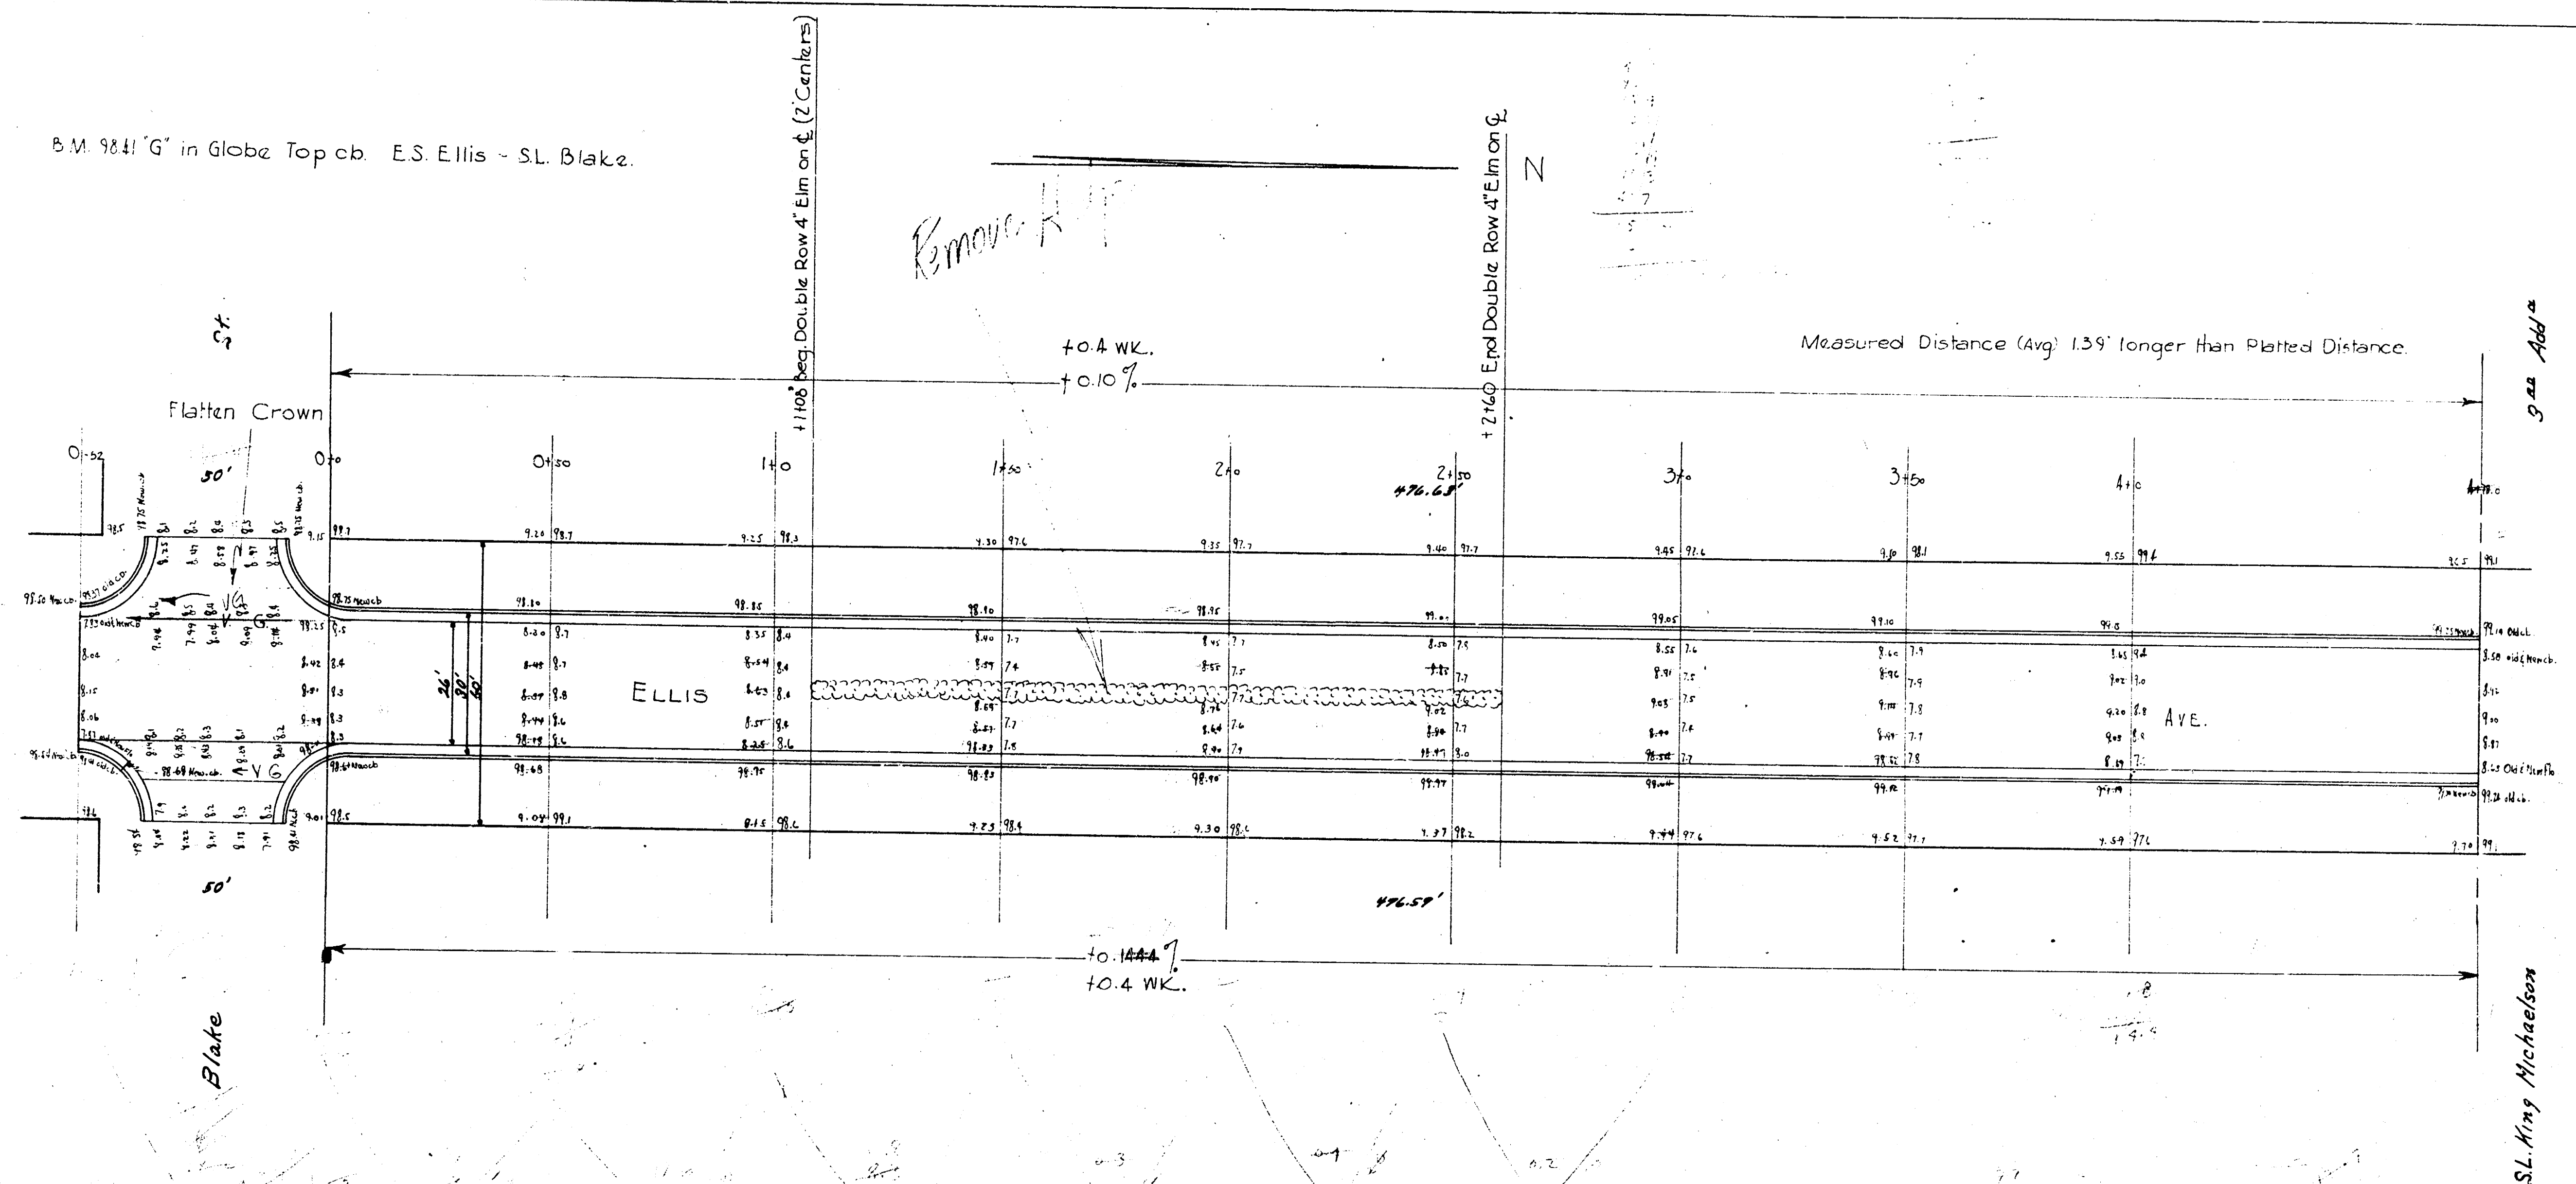