


1941  
ELM ST-E.L. ASH ST-W.L. MADISON AVE.  
30' conc.-int.cb.



EXISTING V.63  
RUNNING EXH.

BM 11722 H in Hurst. CTR. W. E. - N.E. COR. MADISON + CENTRAL

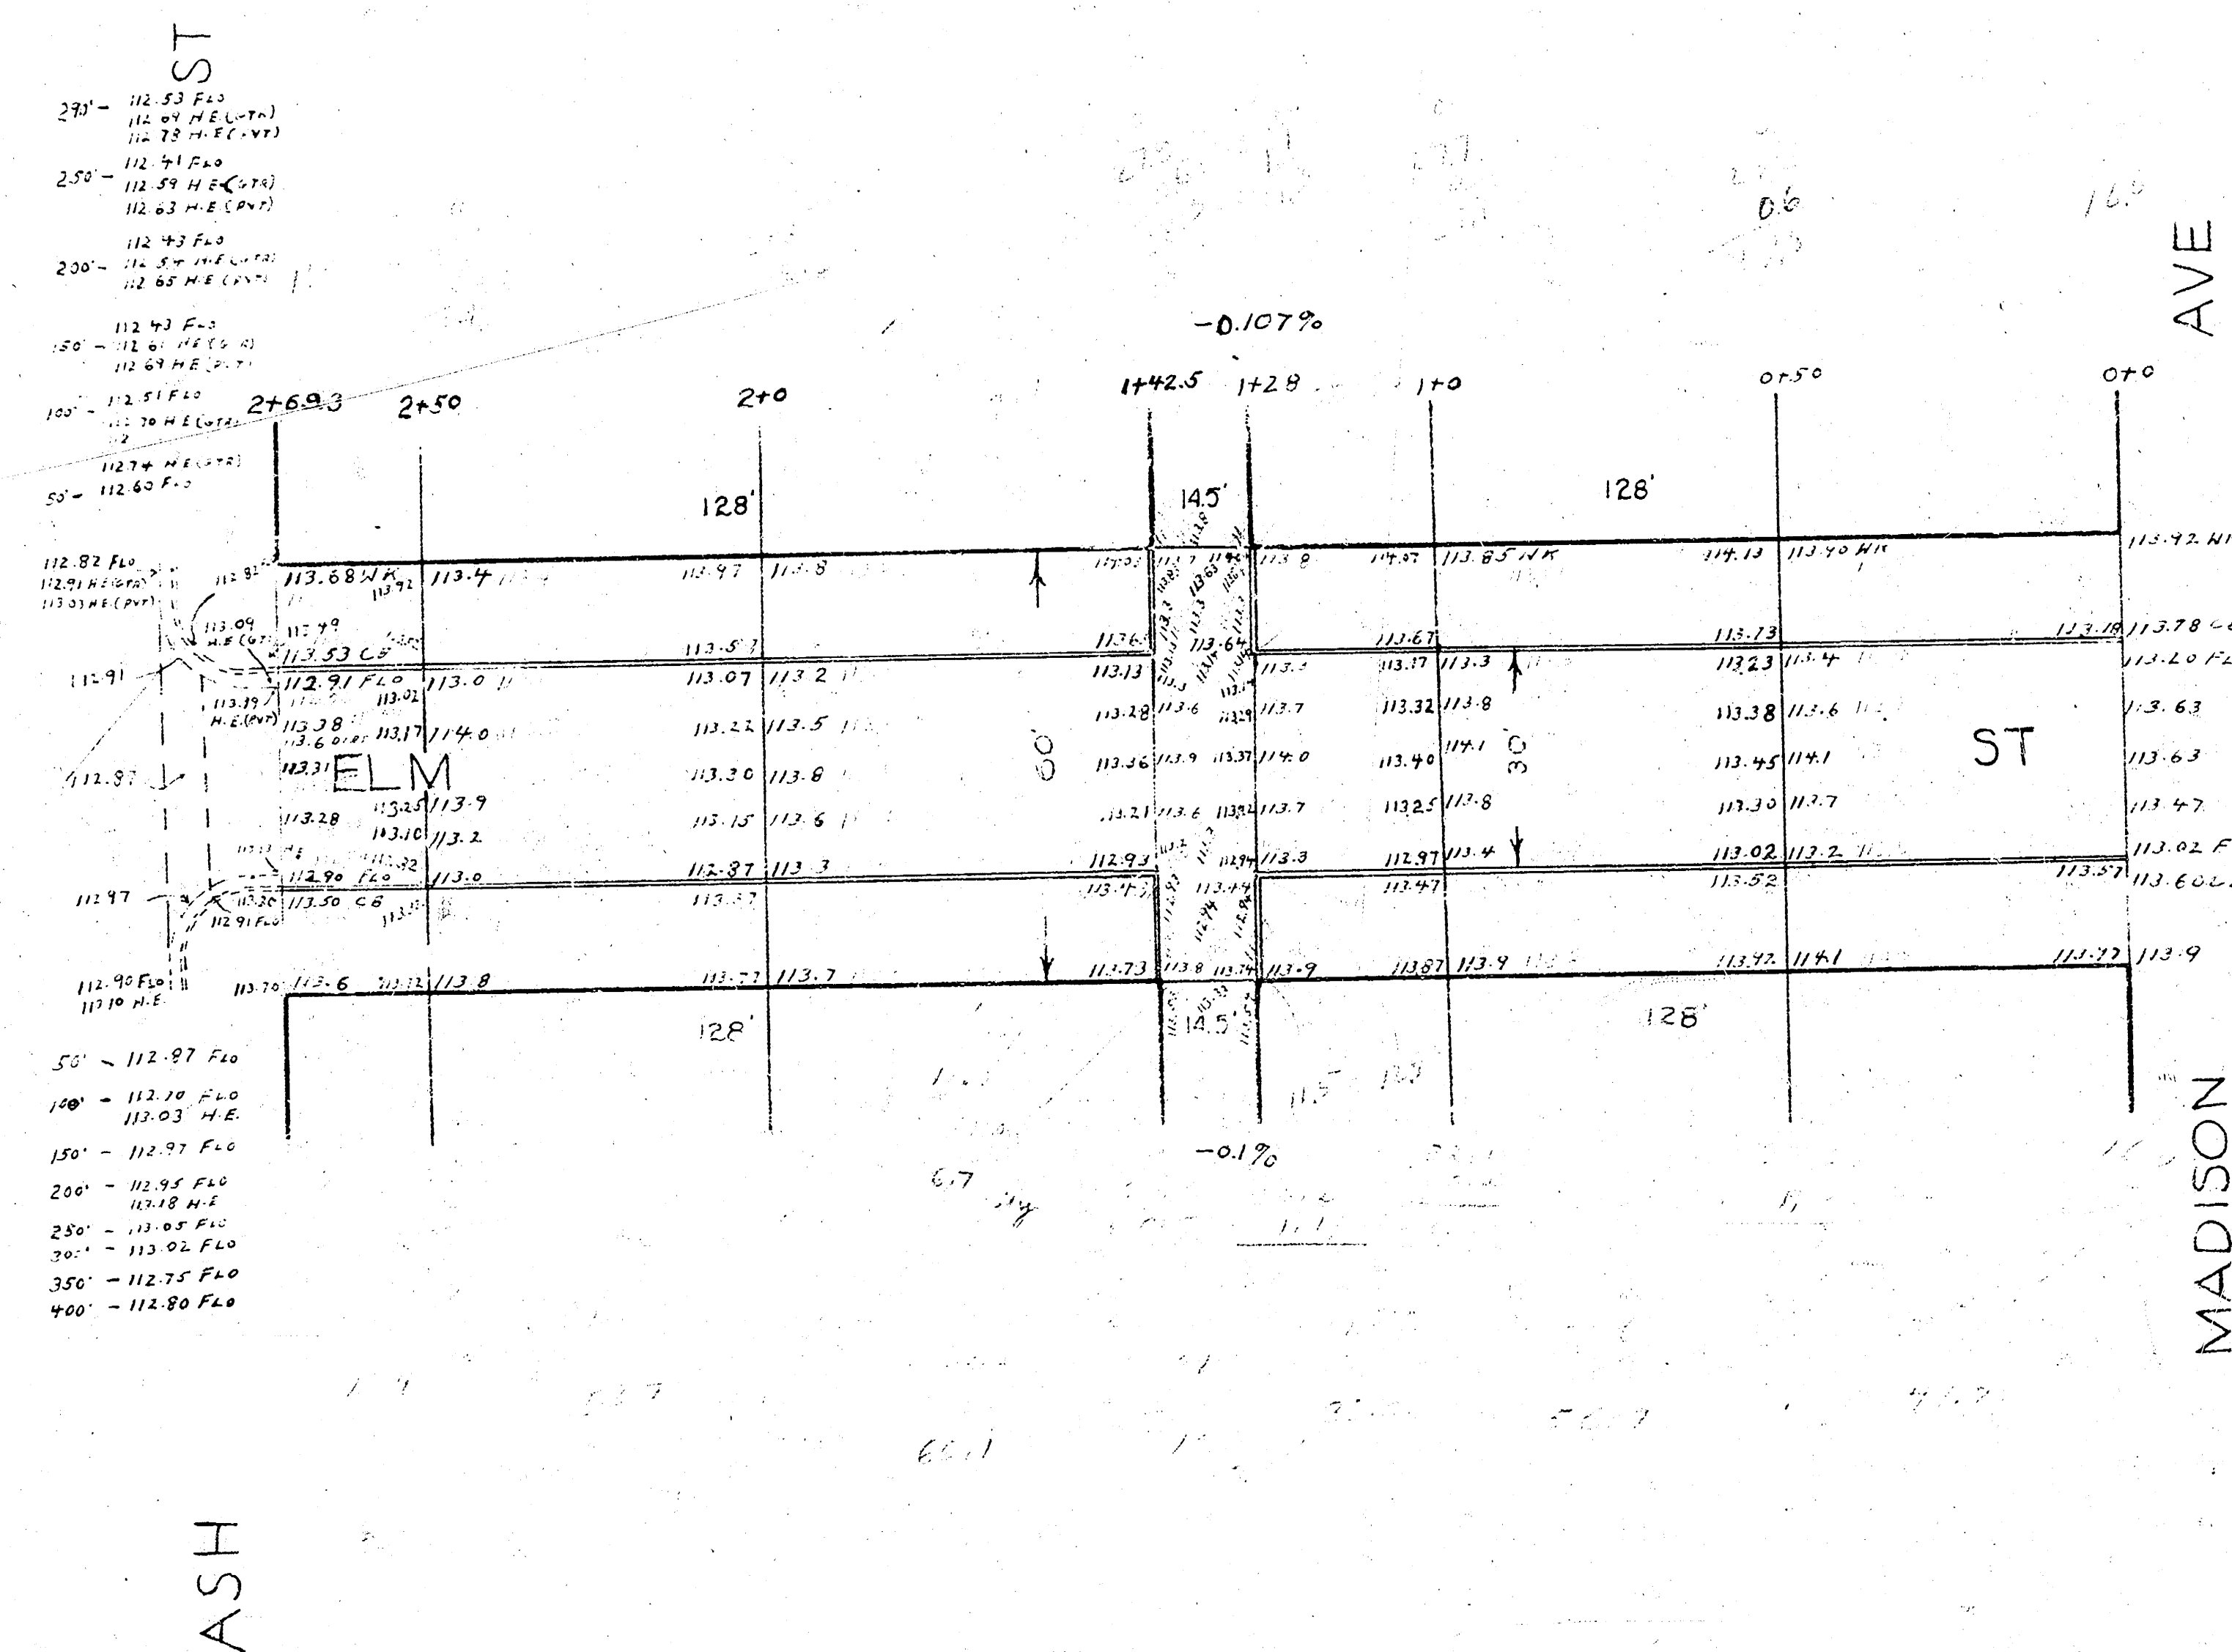