



0+00 WL EUCLID N&S
TIES TO IRON & BOTH STREETS, IRON 12" DEEP
30.0' NE TO TACKED STAKE 30.0' N.W. TO TACKED STAKE

0+30 E EUCLID N & S. TIES TO IRON.
72.4' NE TO SW COR HO.
49.0' NW TO S.E. COR. HO.

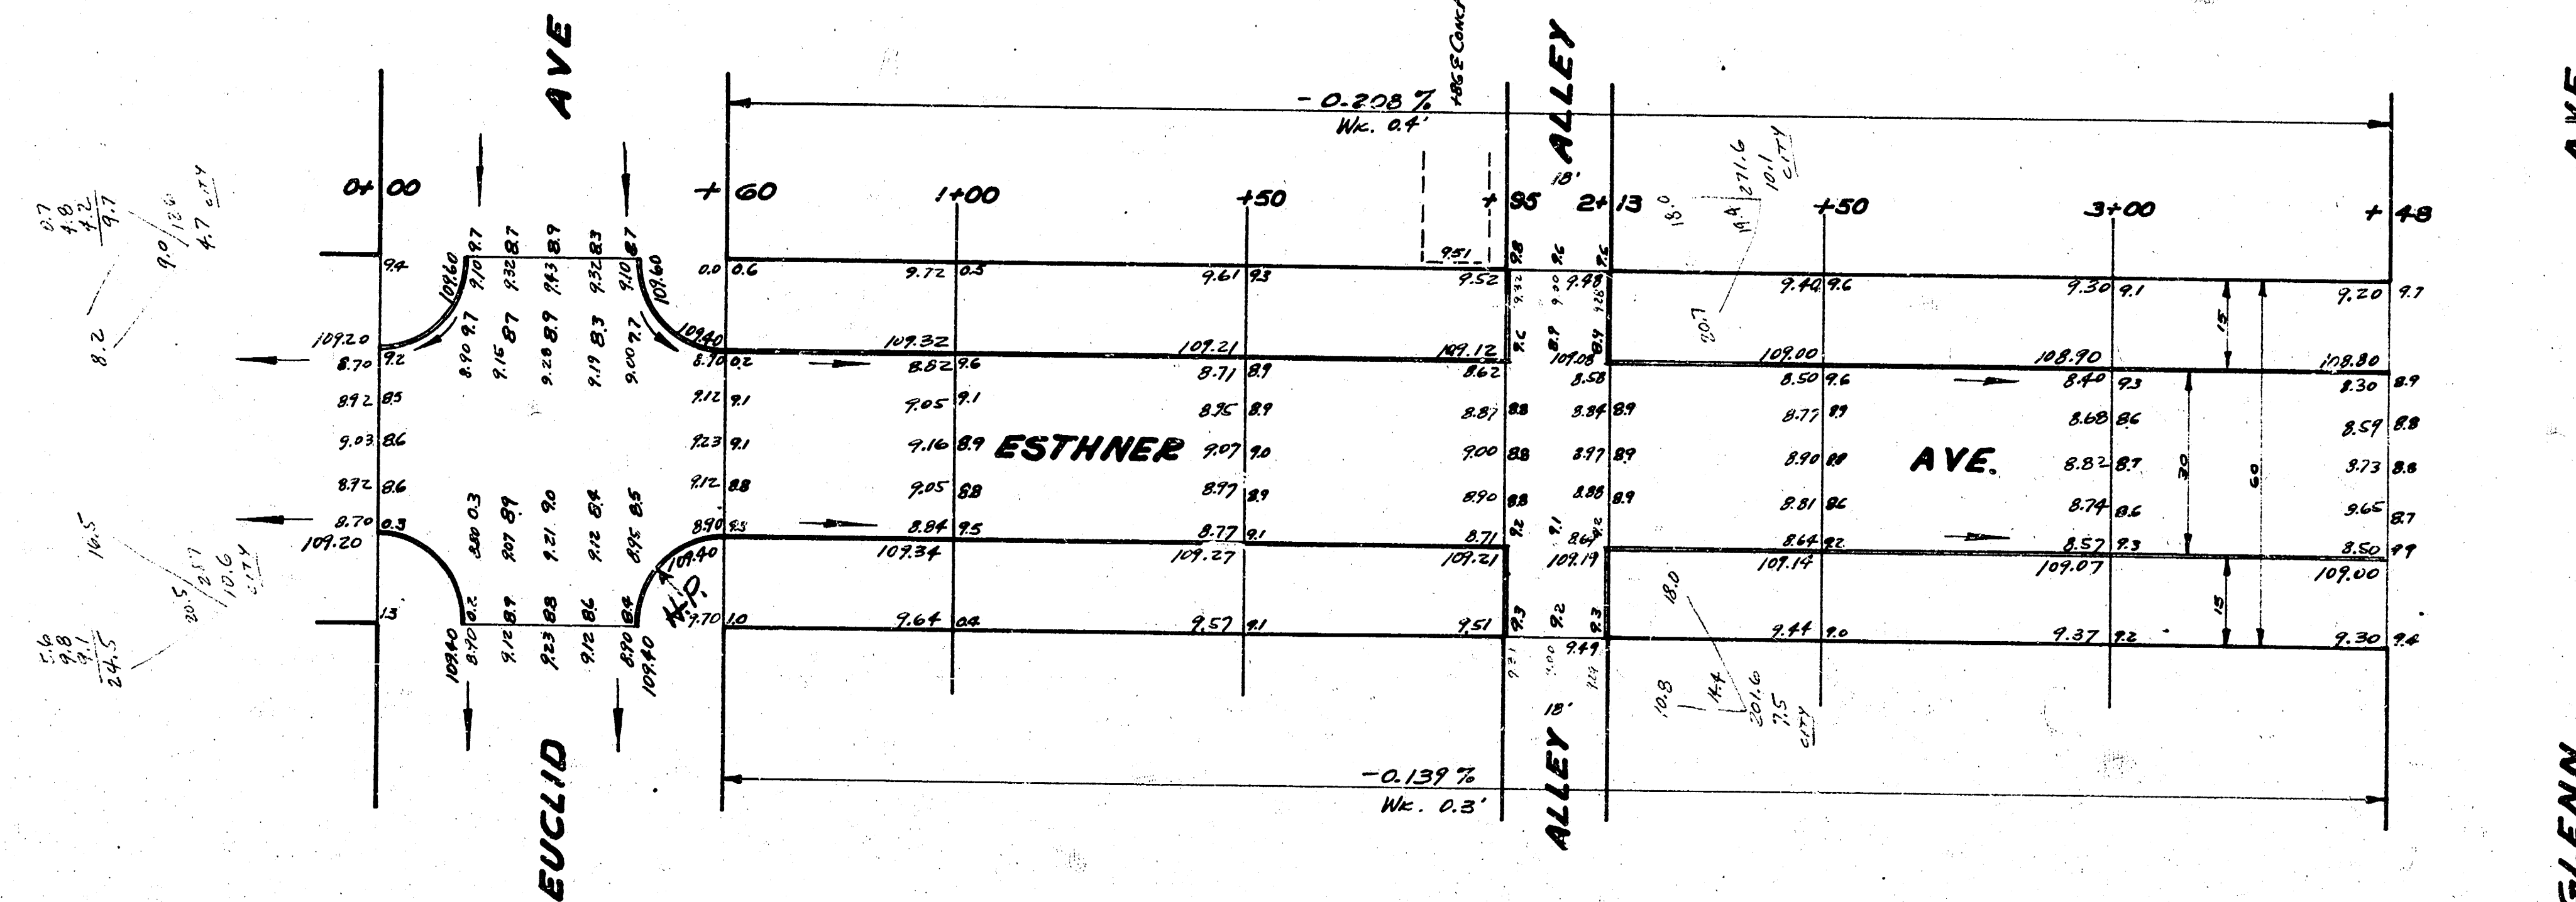

<u>2400.</u>	<u>5.74</u>
266.1	63.5
<u>400.1</u>	<u>136.4</u>
672.2	219.9
<u>+10%</u>	<u>+10%</u>
739.4 cal. 425.	241.9 cal. 425.

AUG. 1952 Prov. No. C11-329

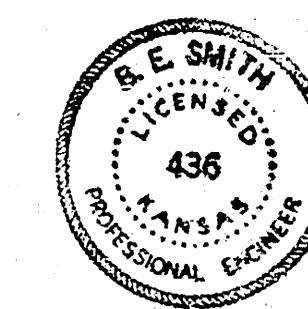

3+78 E GLENN N. & S. & E. & W.
IRON 3/4" PIPE 12" DEEP
57.1' NE TO FACE 14" ELM, 47.8' N. BY NW TO FACE 18" ELM

NOTE: R/W Joas 1.32' So.
 @ STA. 5+53.
 IRONS ON @ 1.32' APART.
 CENTER PVT. ON R/W EAST
 OF ALLEY, E.L. GLENN TO W.L. VINE.

