

CHAINING E. ON £

0-21.5 Feet E. Co. Hillside

0100 END RET, 6"x18" RET WALL JO.


0415 Brg. Bldg. E of W. 103' Lf.

0161 C78 DENV. N.3 LT.


1400 STE DWY 10.3' Lr.

1+10 Cre. Gar. Door. 10.3' Lr.

1411 W.L. ALLEY N., END BUDG. 10.3 LT.

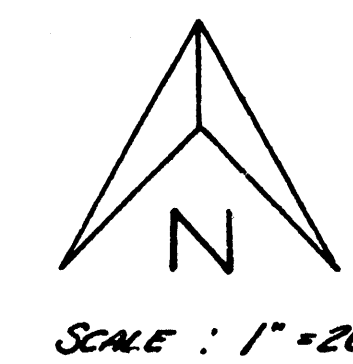

Exc
Rep. City
 12.4 0
 1080 W. T. S.

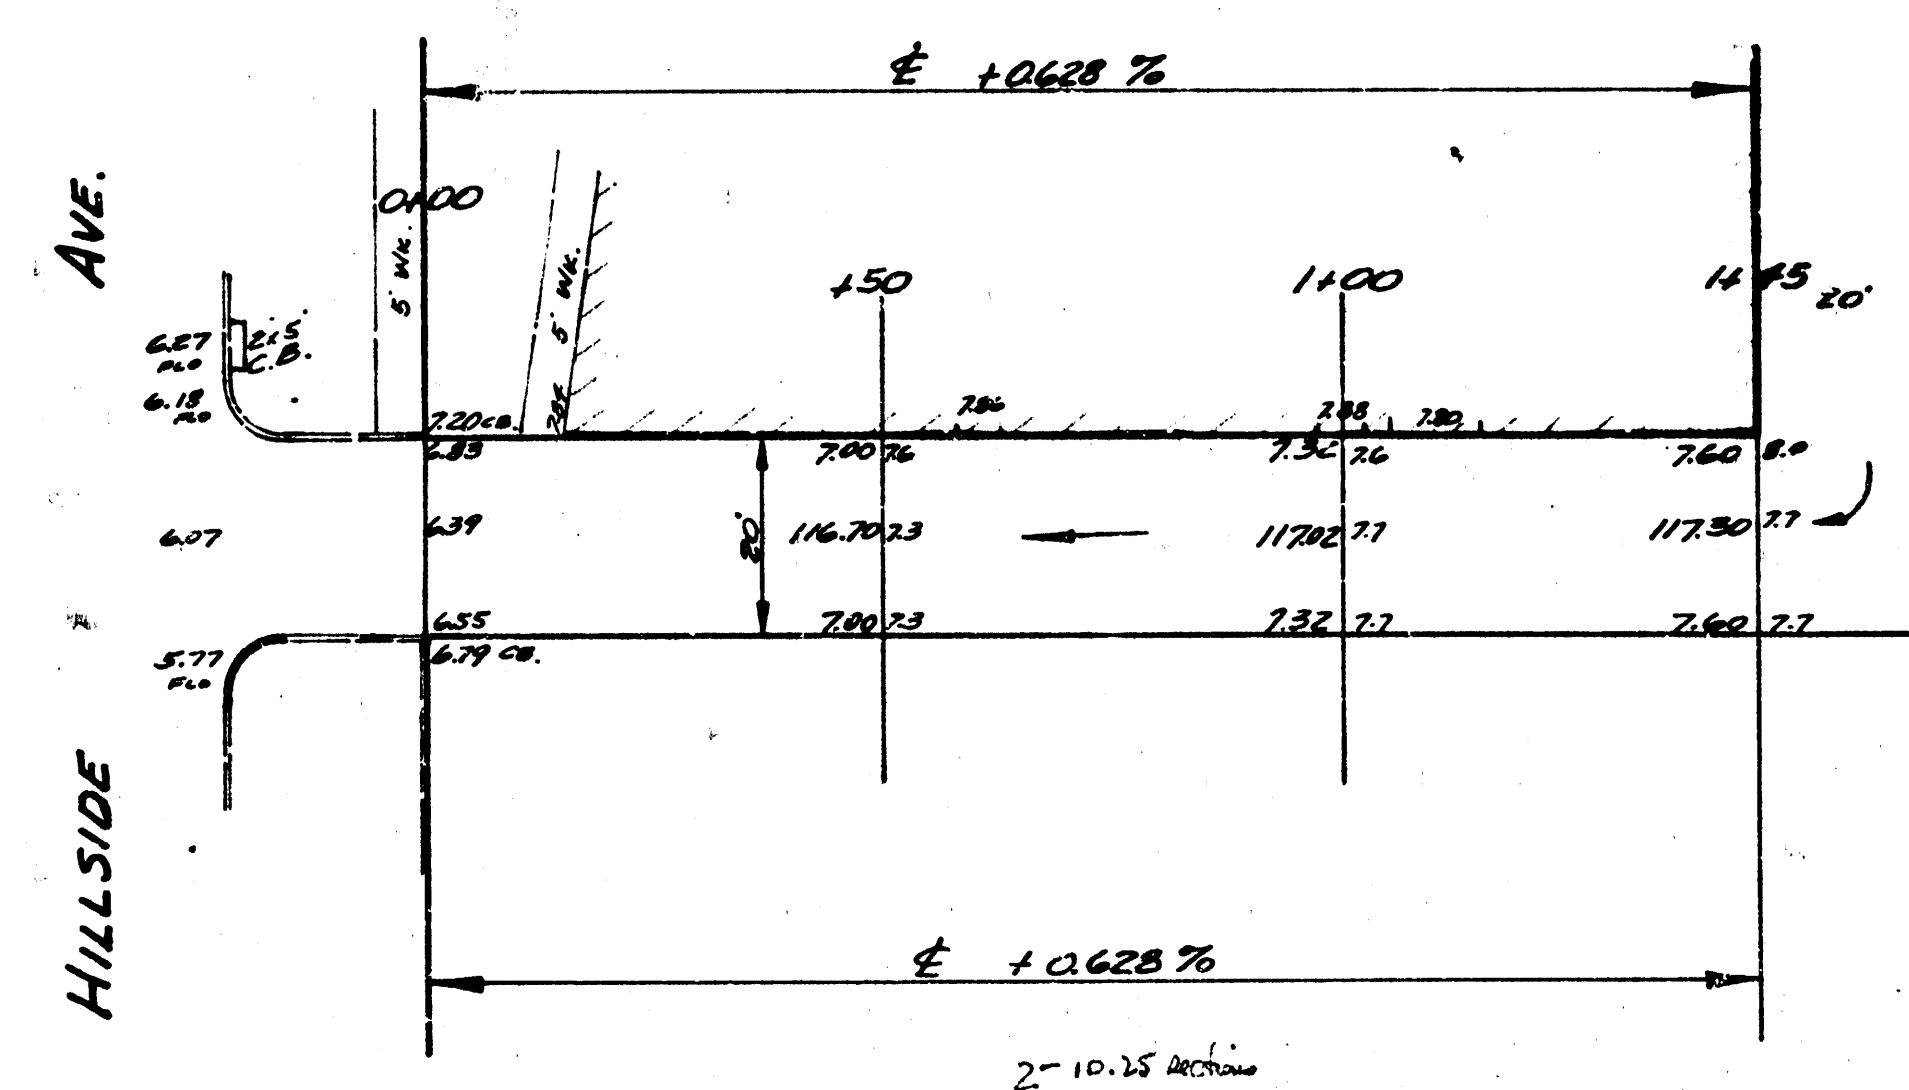

10.7
~~50.0~~

21.0
~~20.5~~ ✓

20.6
2004

16.9
~~16.5~~

15.3
- 765
28.3

20.3
1015
37.6

$$\begin{array}{r} 183 \\ \times 20 \\ \hline 3660 \end{array}$$

ALLEY S. OF OSIE
E.L. HILLSIDE TO W.L. ALLEY E. HILLSIDE
6" CONC. - 20'
CITY OF WICHITA, KANSAS
B.E. SMITH - CITY ENGINEER
JUNE, 1953 PROJ. C12-284