


EVERGREEN PARK STREET IMPROVEMENTS CITY OF WICHITA

THE URBAN RENEWAL AGENCY
OF THE
WICHITA, KANSAS, METROPOLITAN AREA

KENNETH H. KITCHEN
EXECUTIVE DIRECTOR




R. S. DELAMATER & ASSOCIATES
CONSULTING ENGINEERS
WICHITA, KANSAS

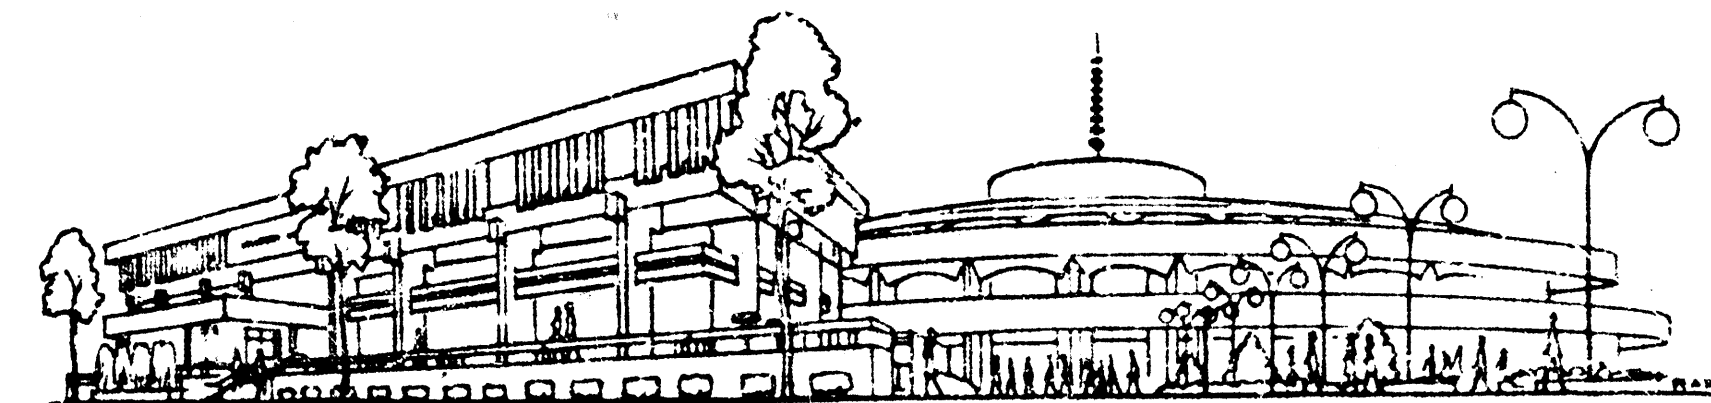

INDEX OF SHEETS



1. Title Sheet
2. Storm Sewer Plan I
3. Storm Sewer Plan II
4. Sewer Appurtenances
5. Curb Inlet Details
6. Pavement Plan I
7. Pavement Plan II
8. Pavement Plan III
9. Pavement Plan IV
10. Pavement Plan V
11. Pavement Plan VI
12. Pavement Plan VII
13. Pavement Details
14. Auxiliary Details


PROJECT NO.
KANS. A-5-2
FEBRUARY, 1972

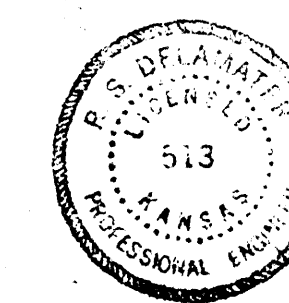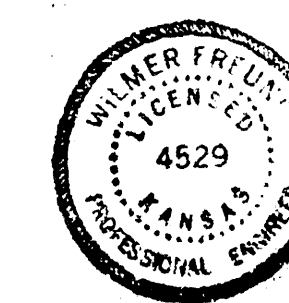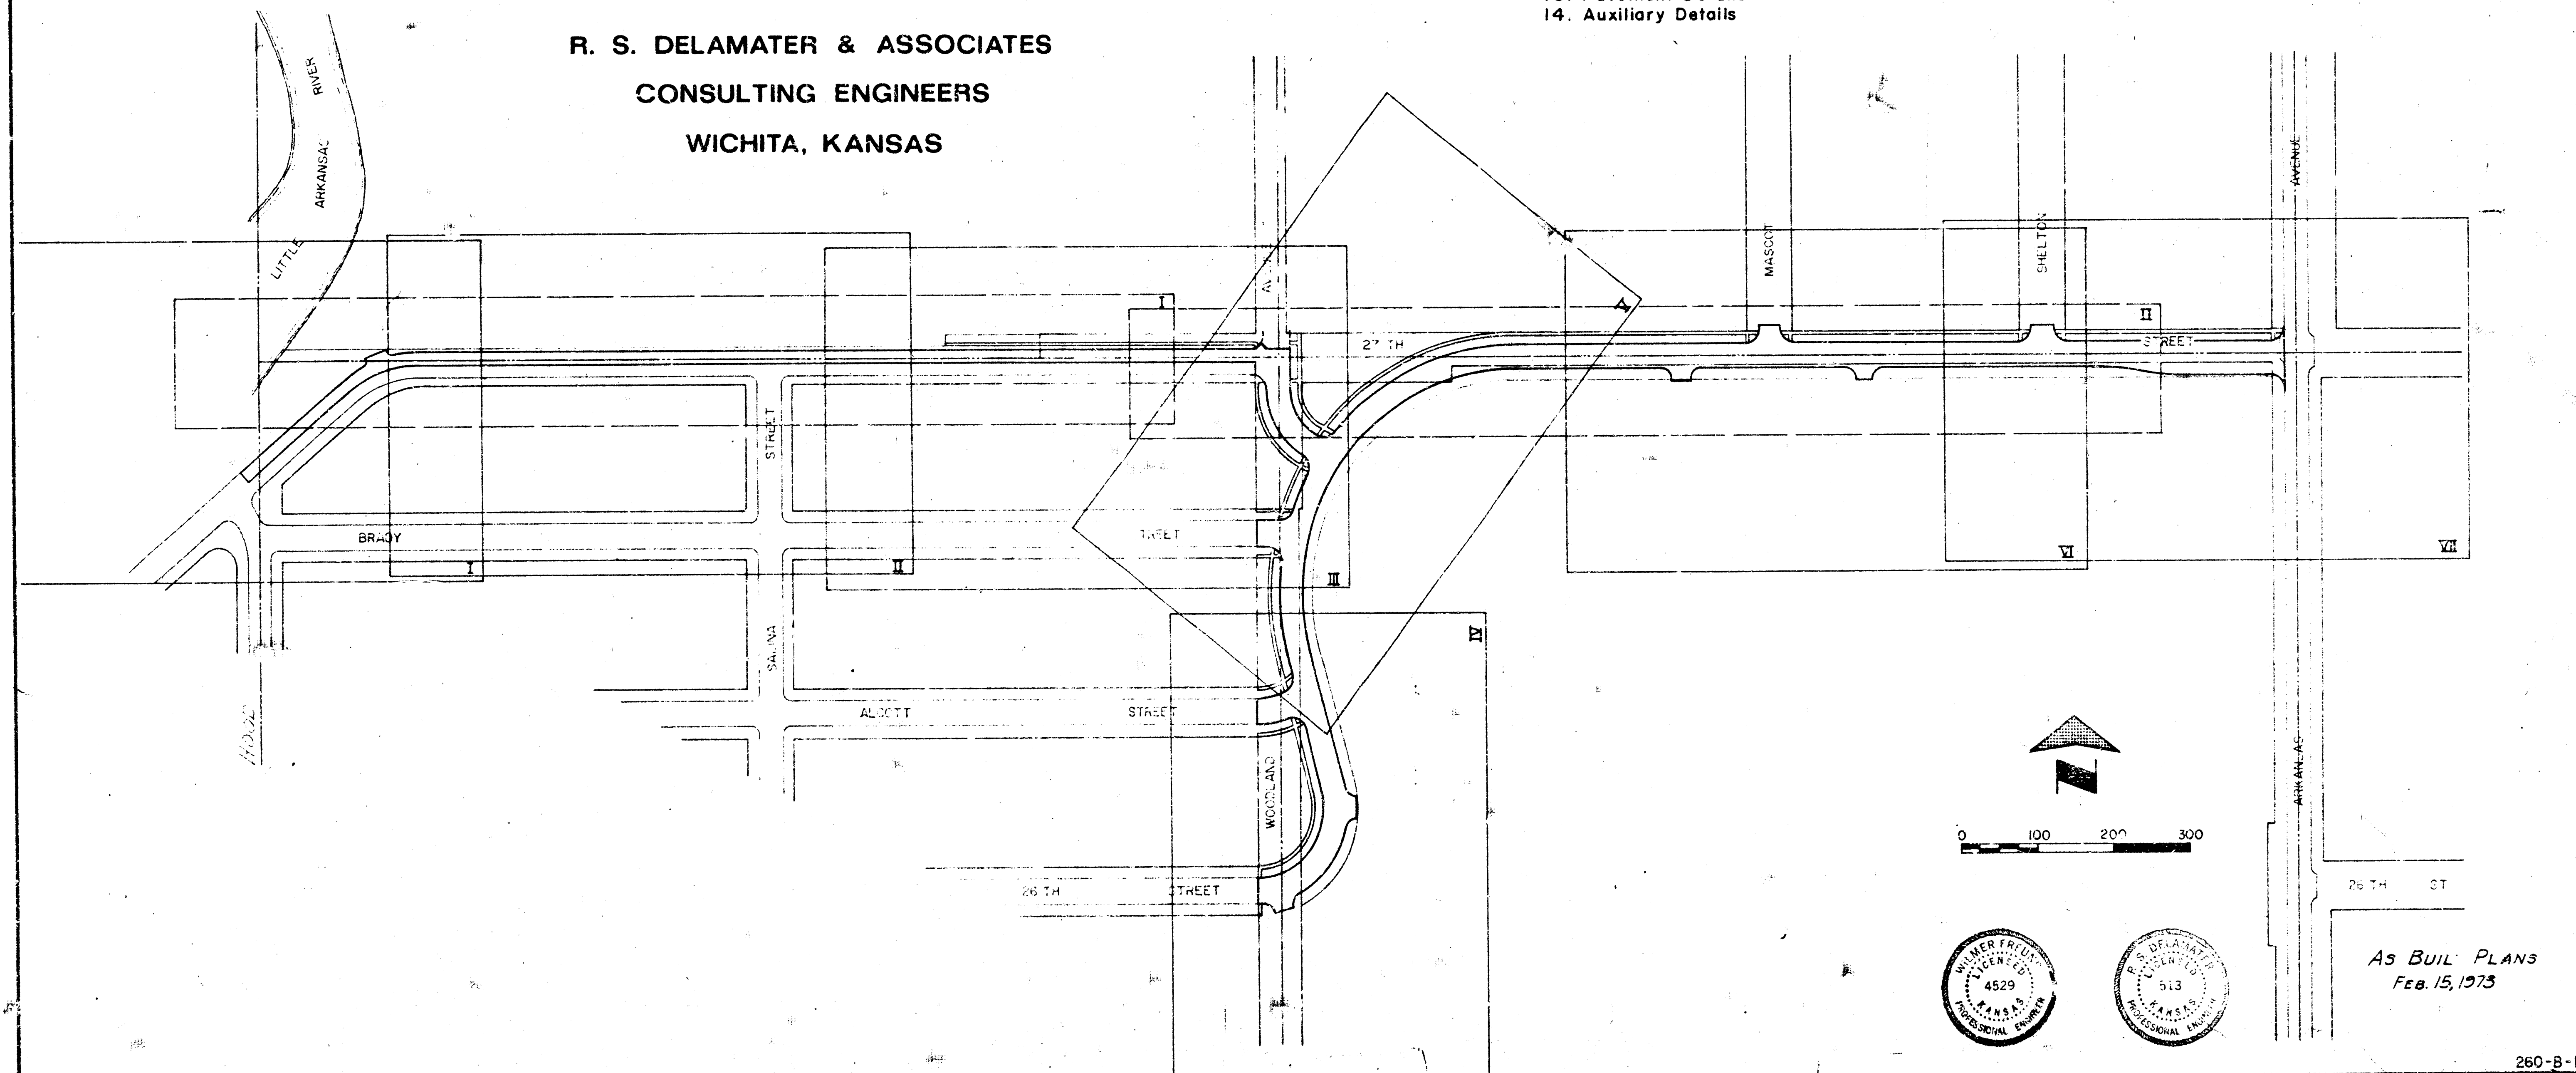


AS BUILT PLANS
Feb. 15, 1973


260-B-1

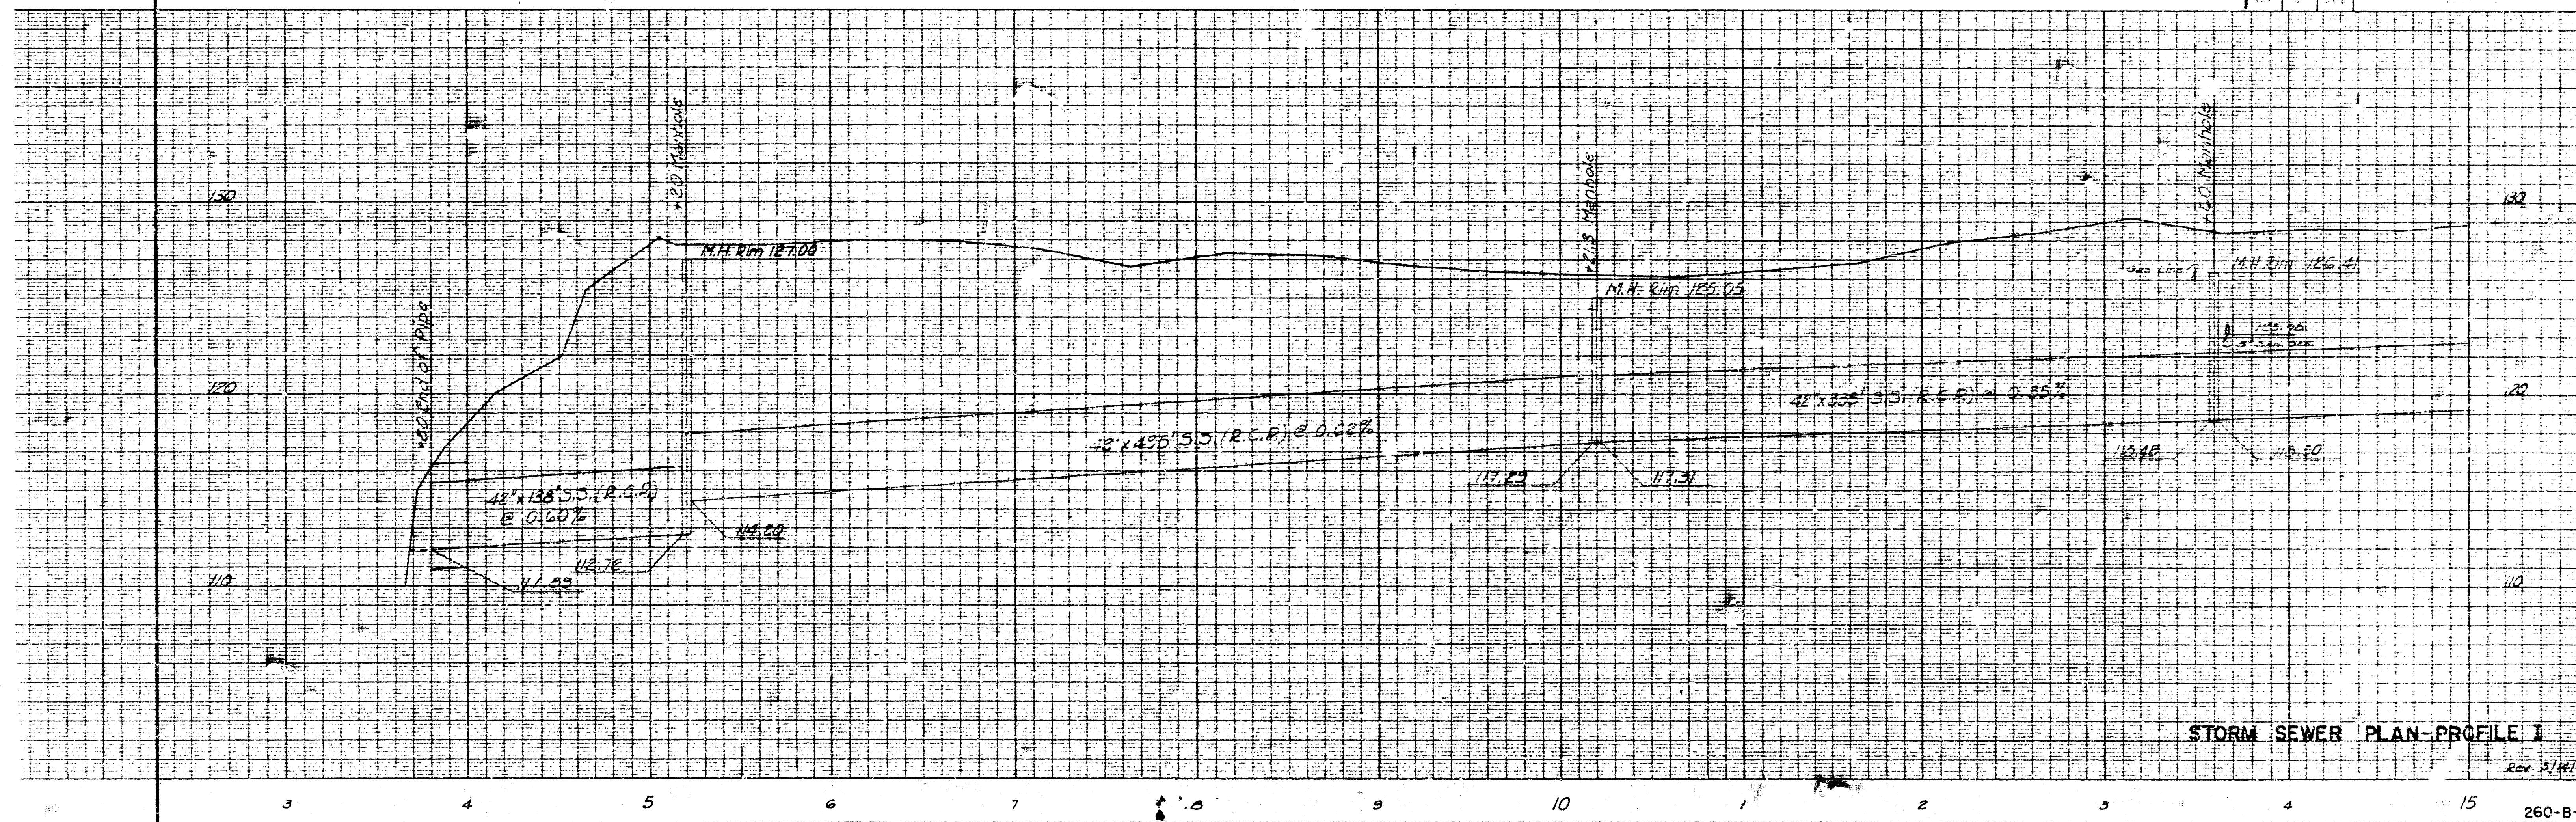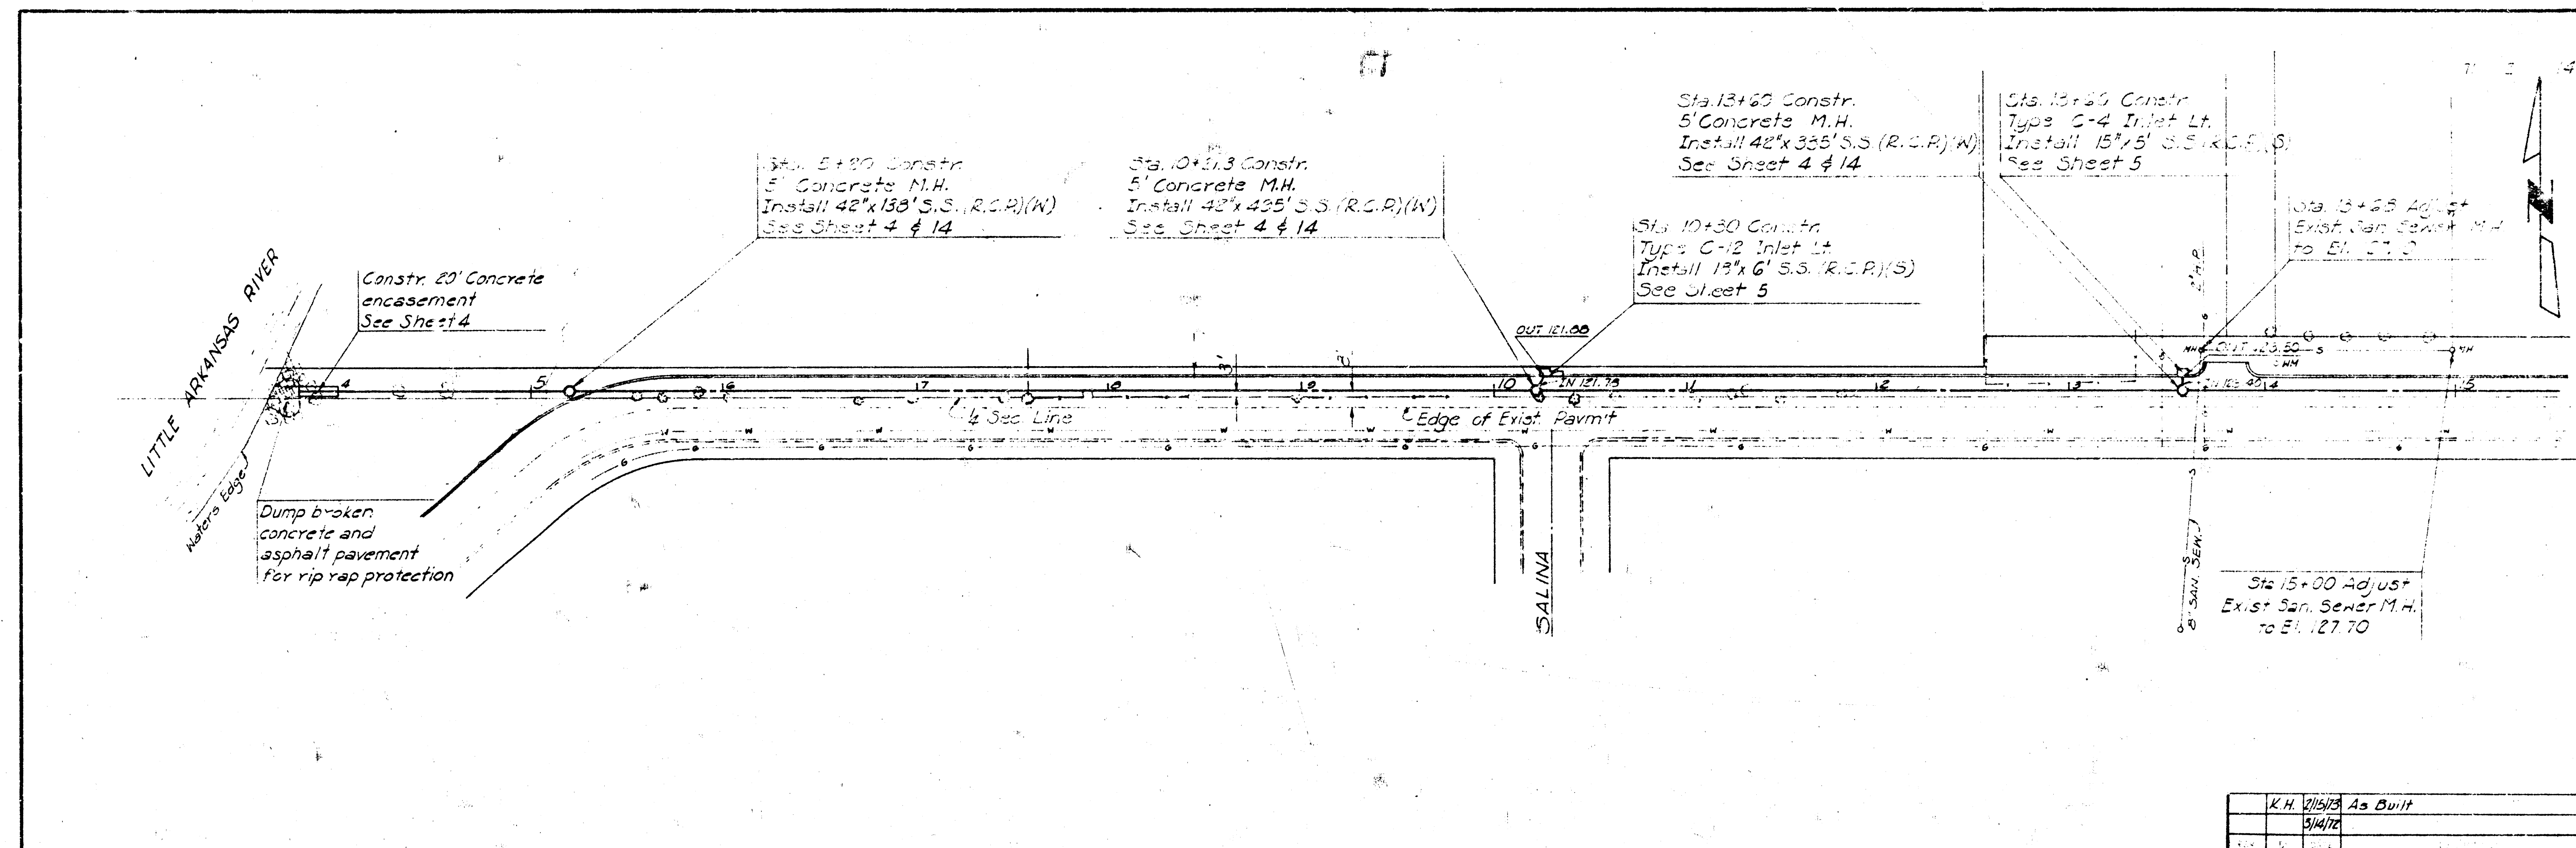

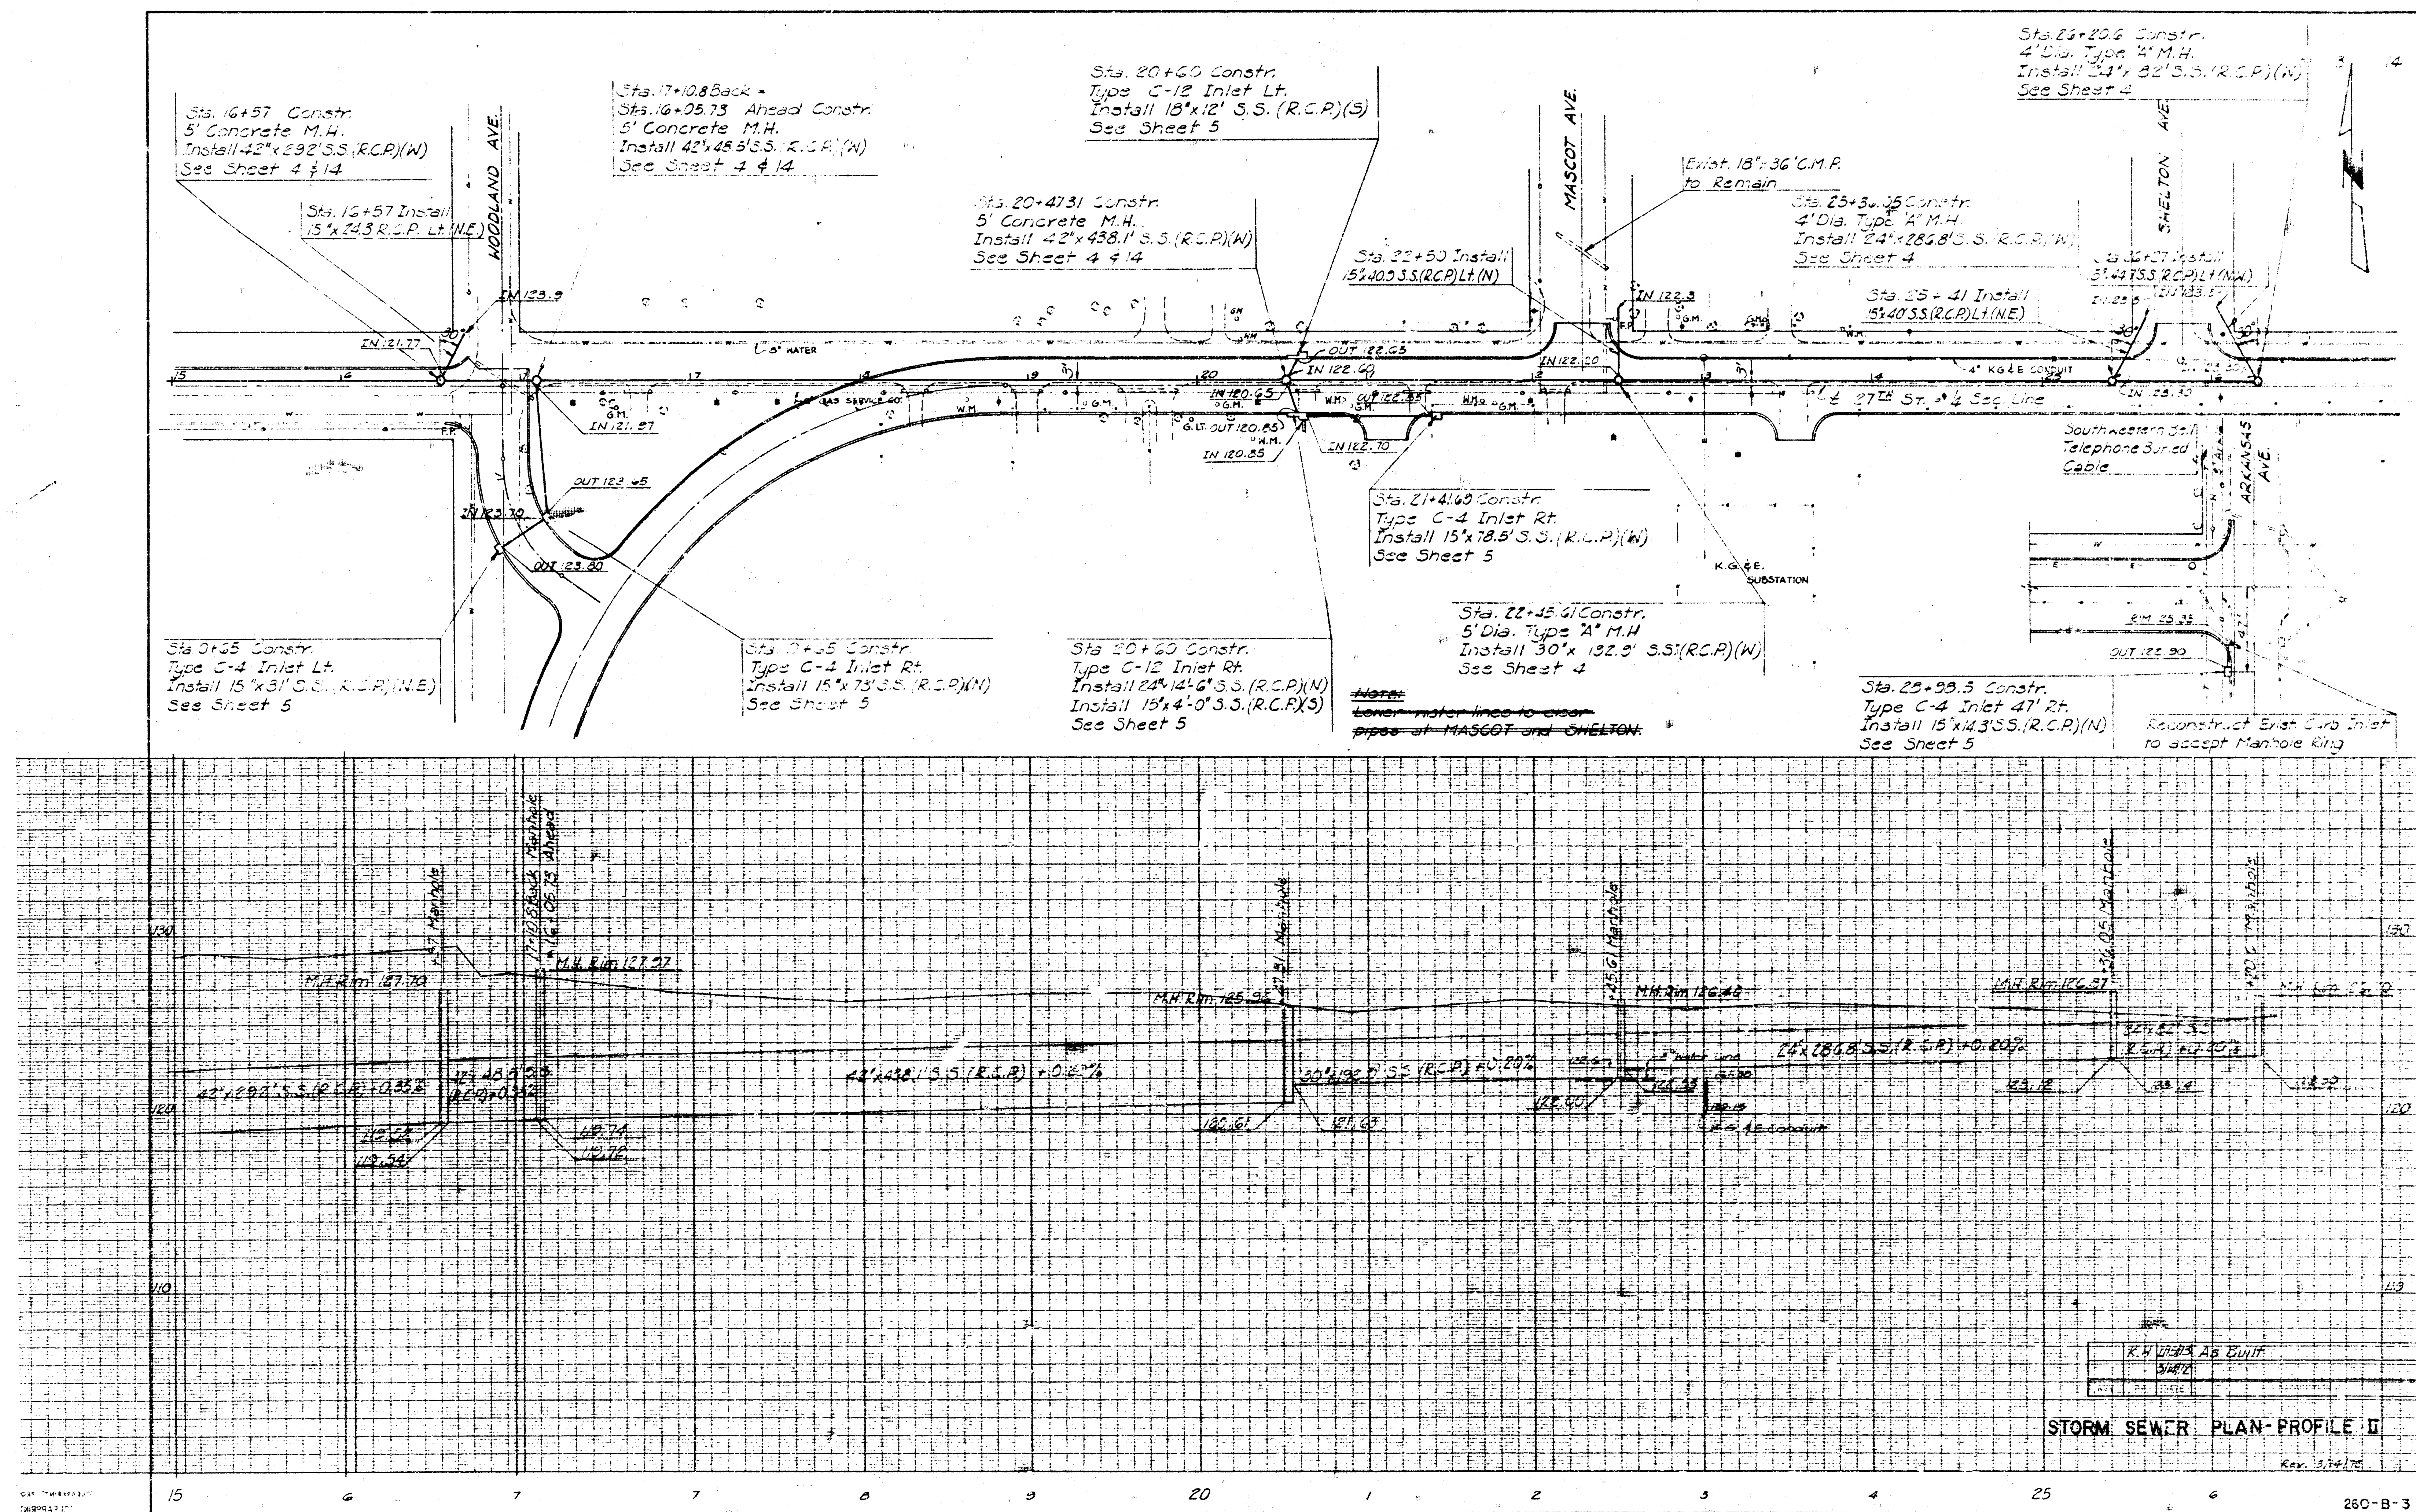


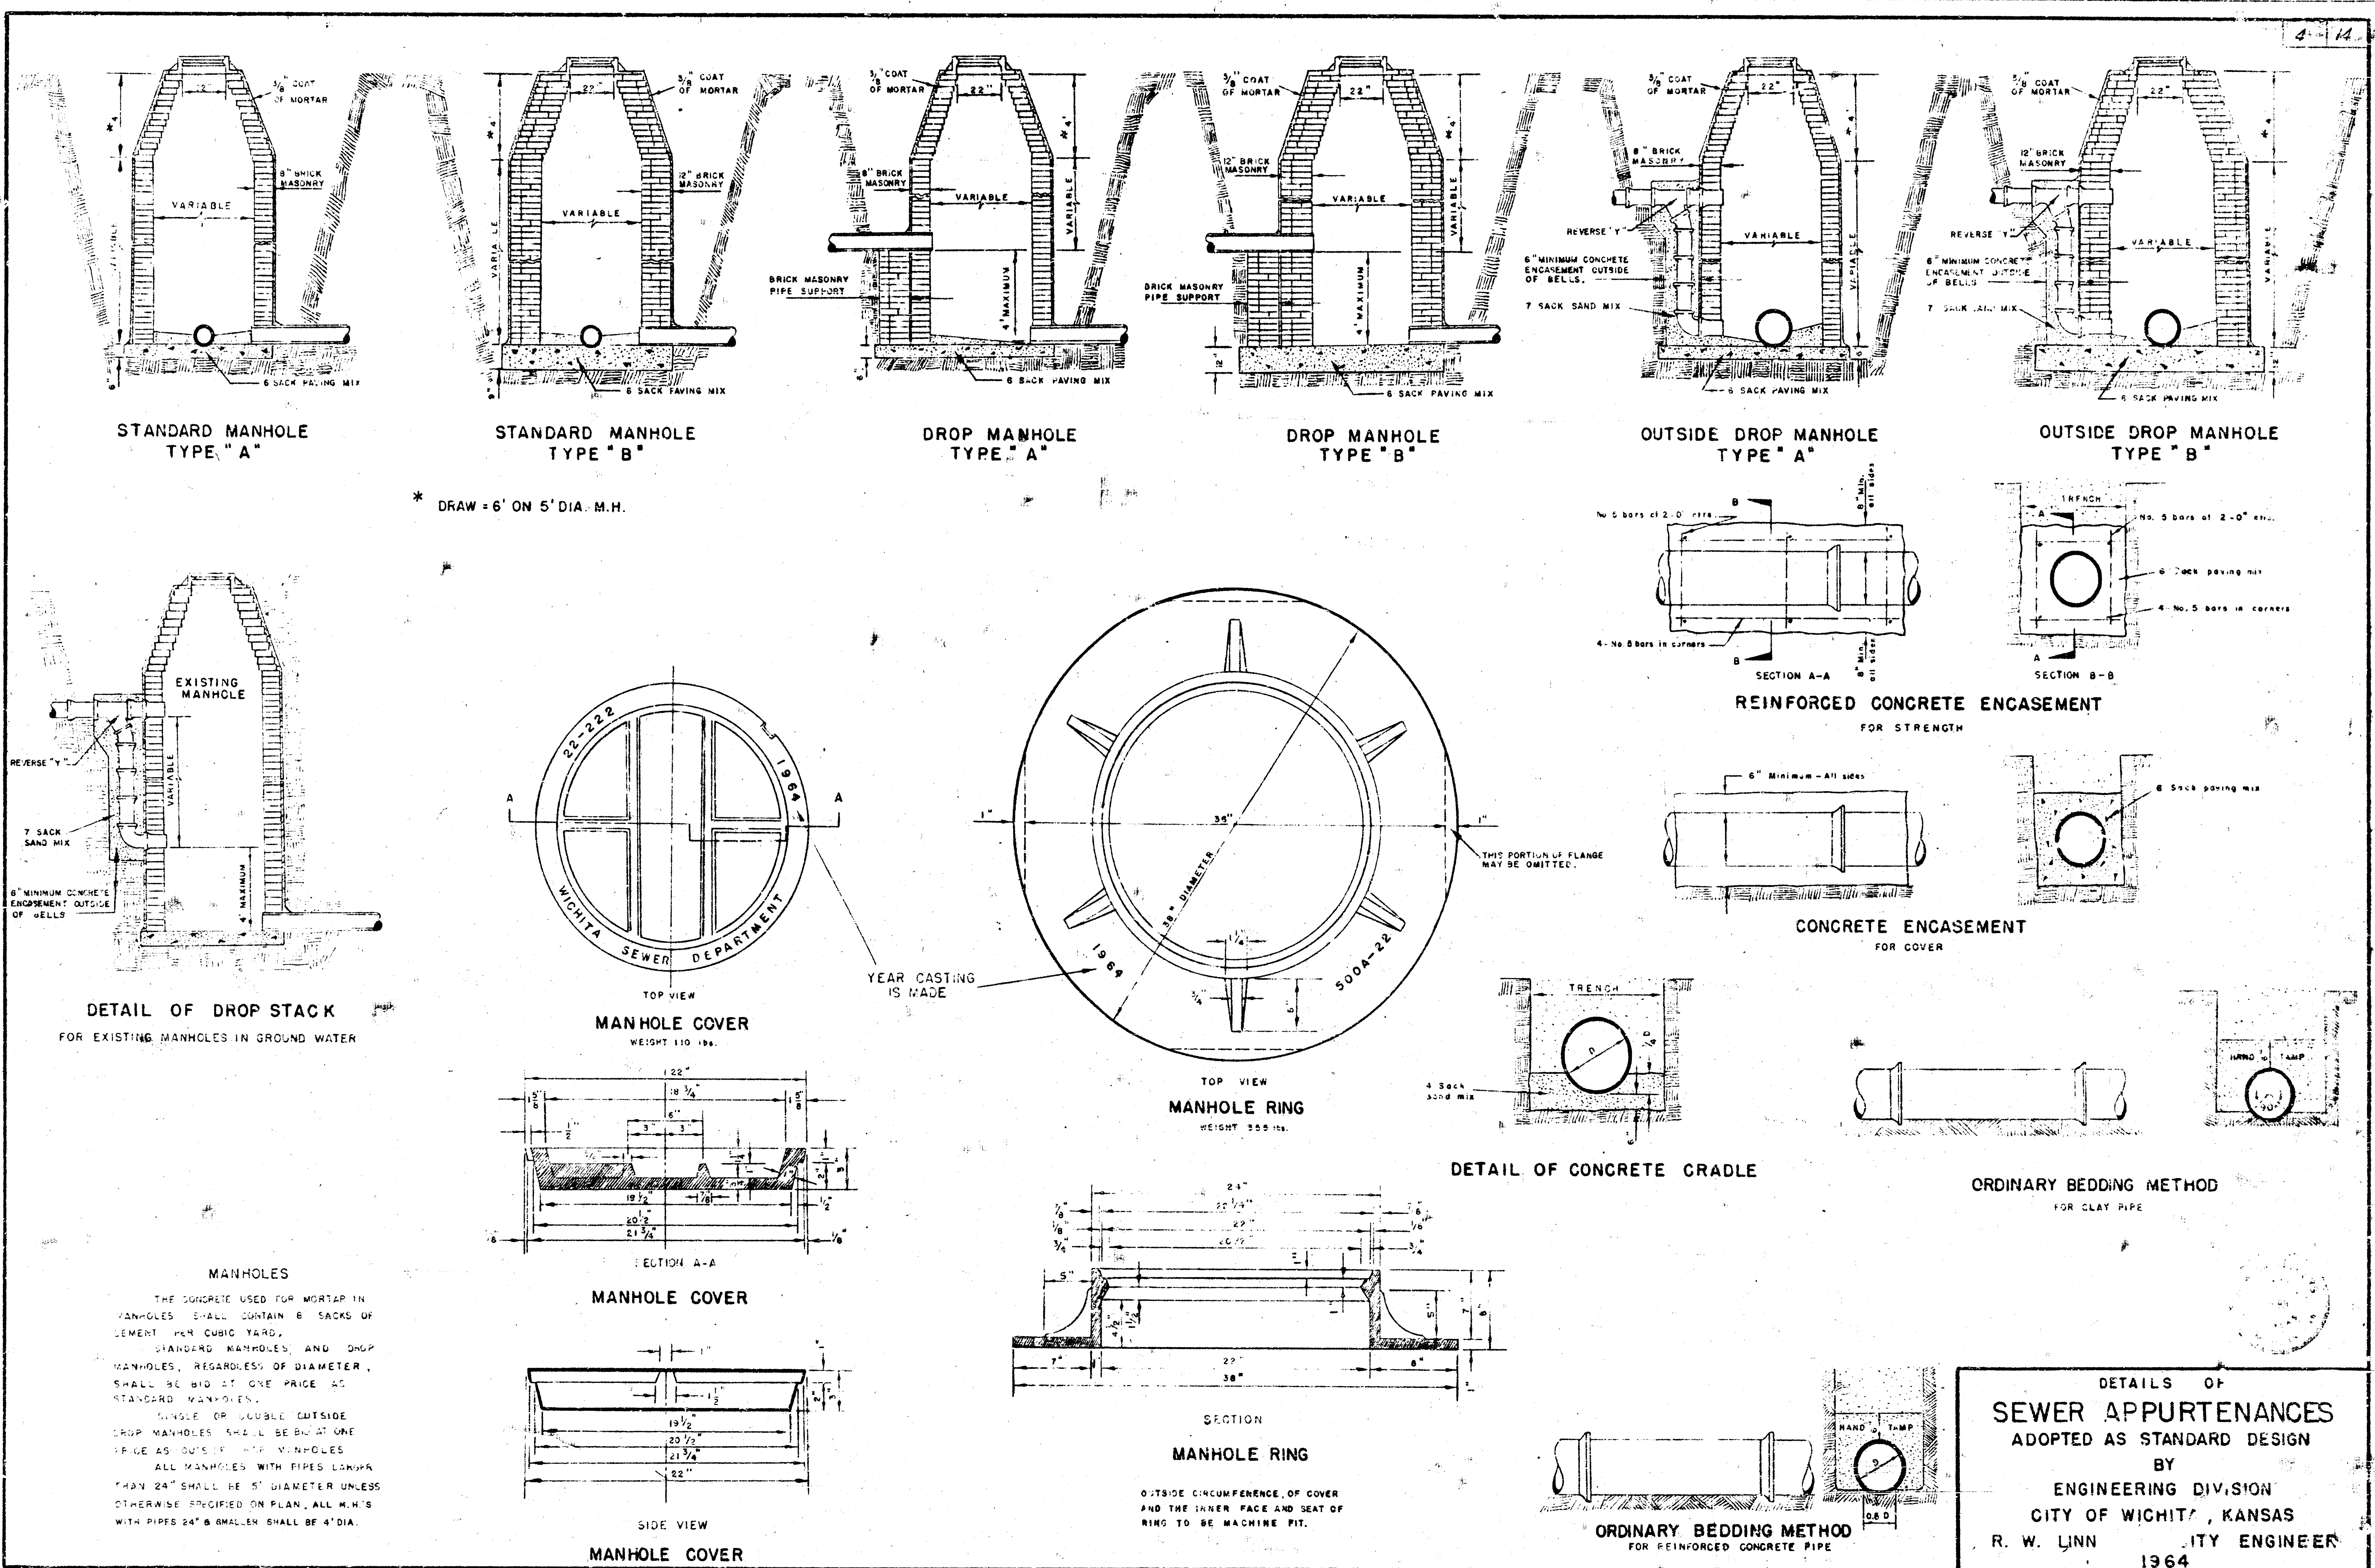


PUB. ROAD DW. NO.	STATE	PROJECT NO.	FISCAL YEAR	SHEET NO.	TOTAL SHEETS
5	KANSAS			30	

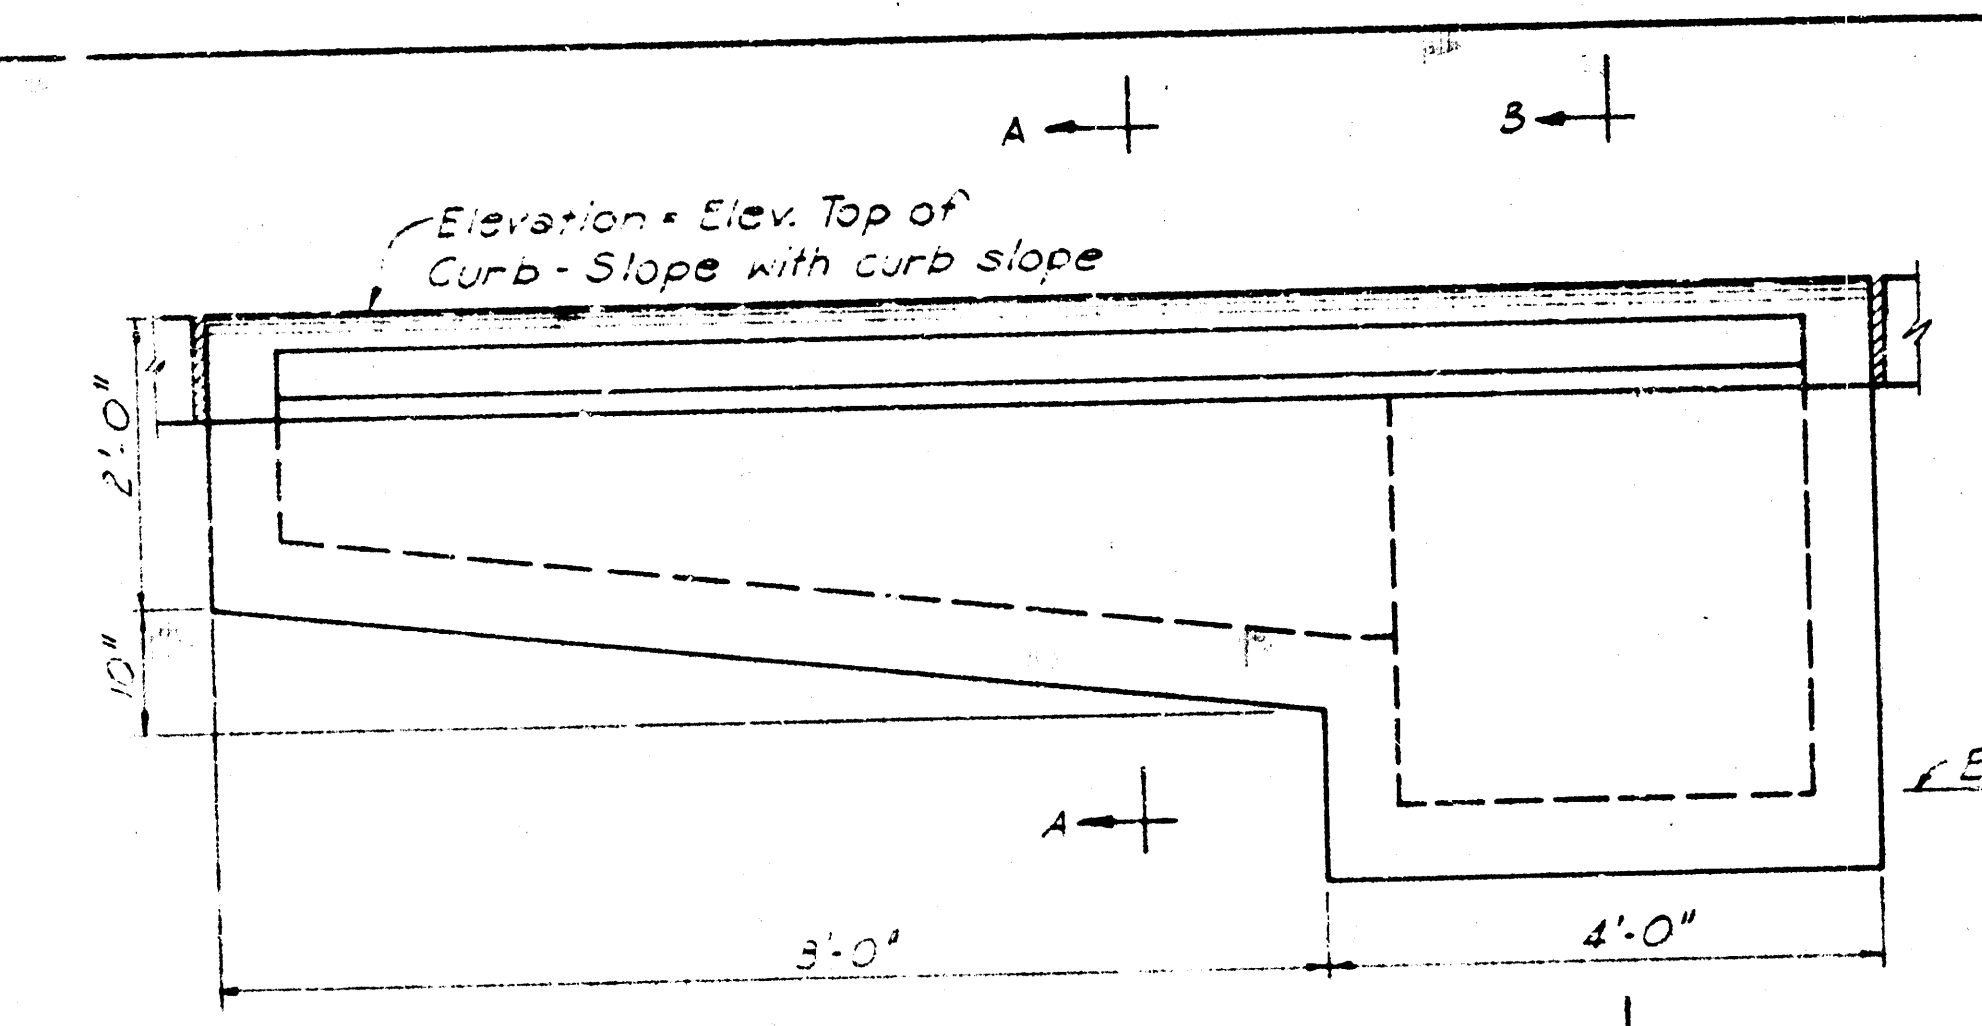



FRONT VIEW

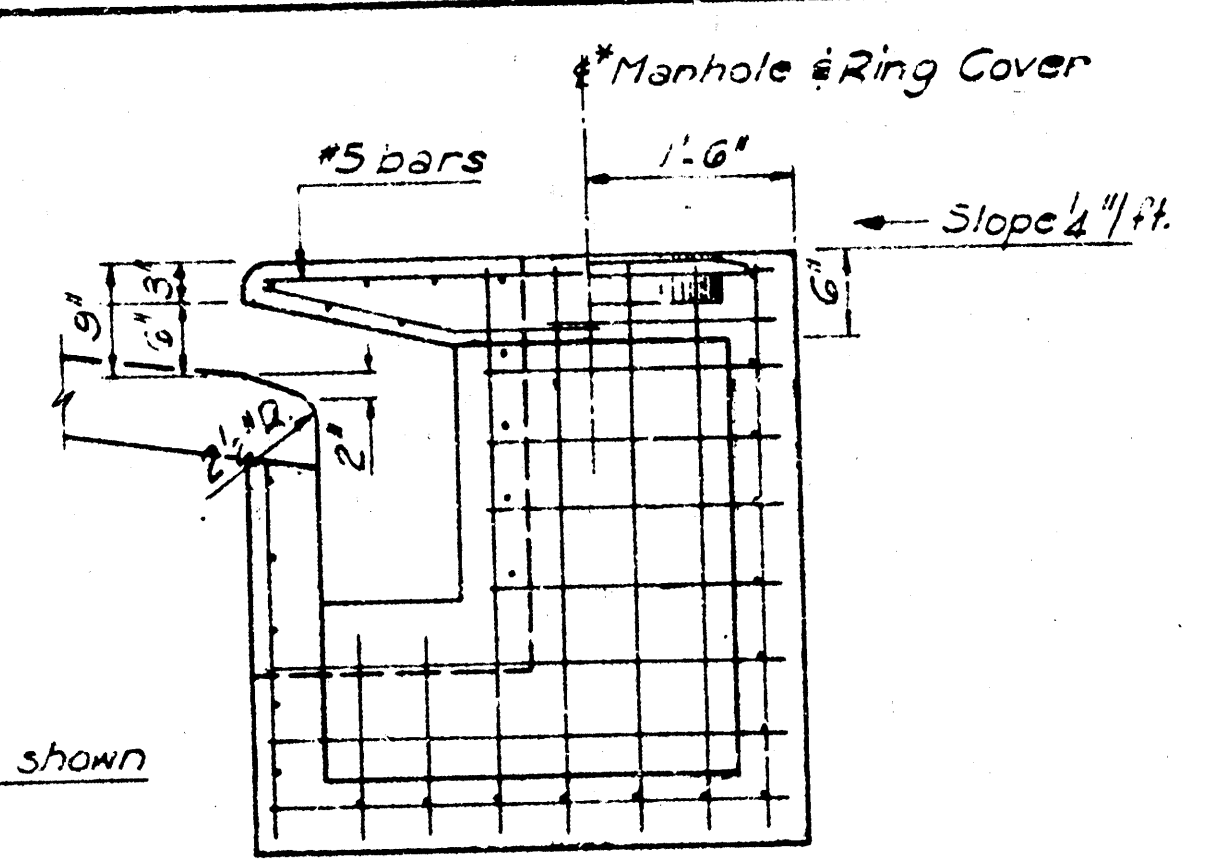


SECTION B-B

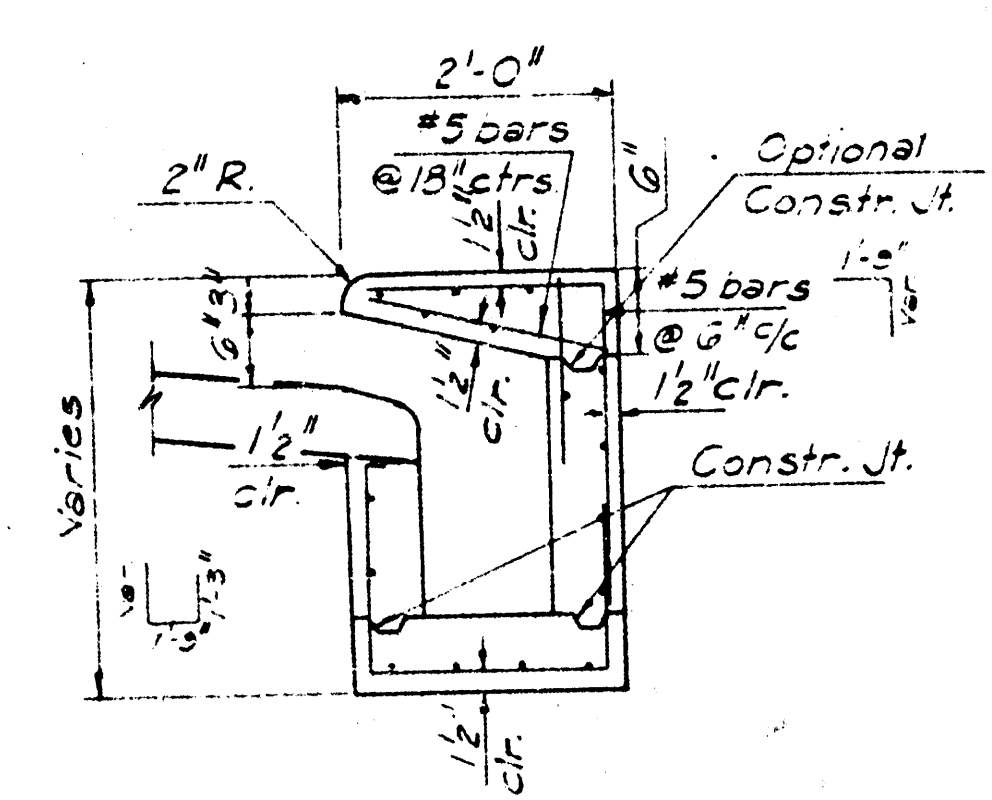


SECTION A-A

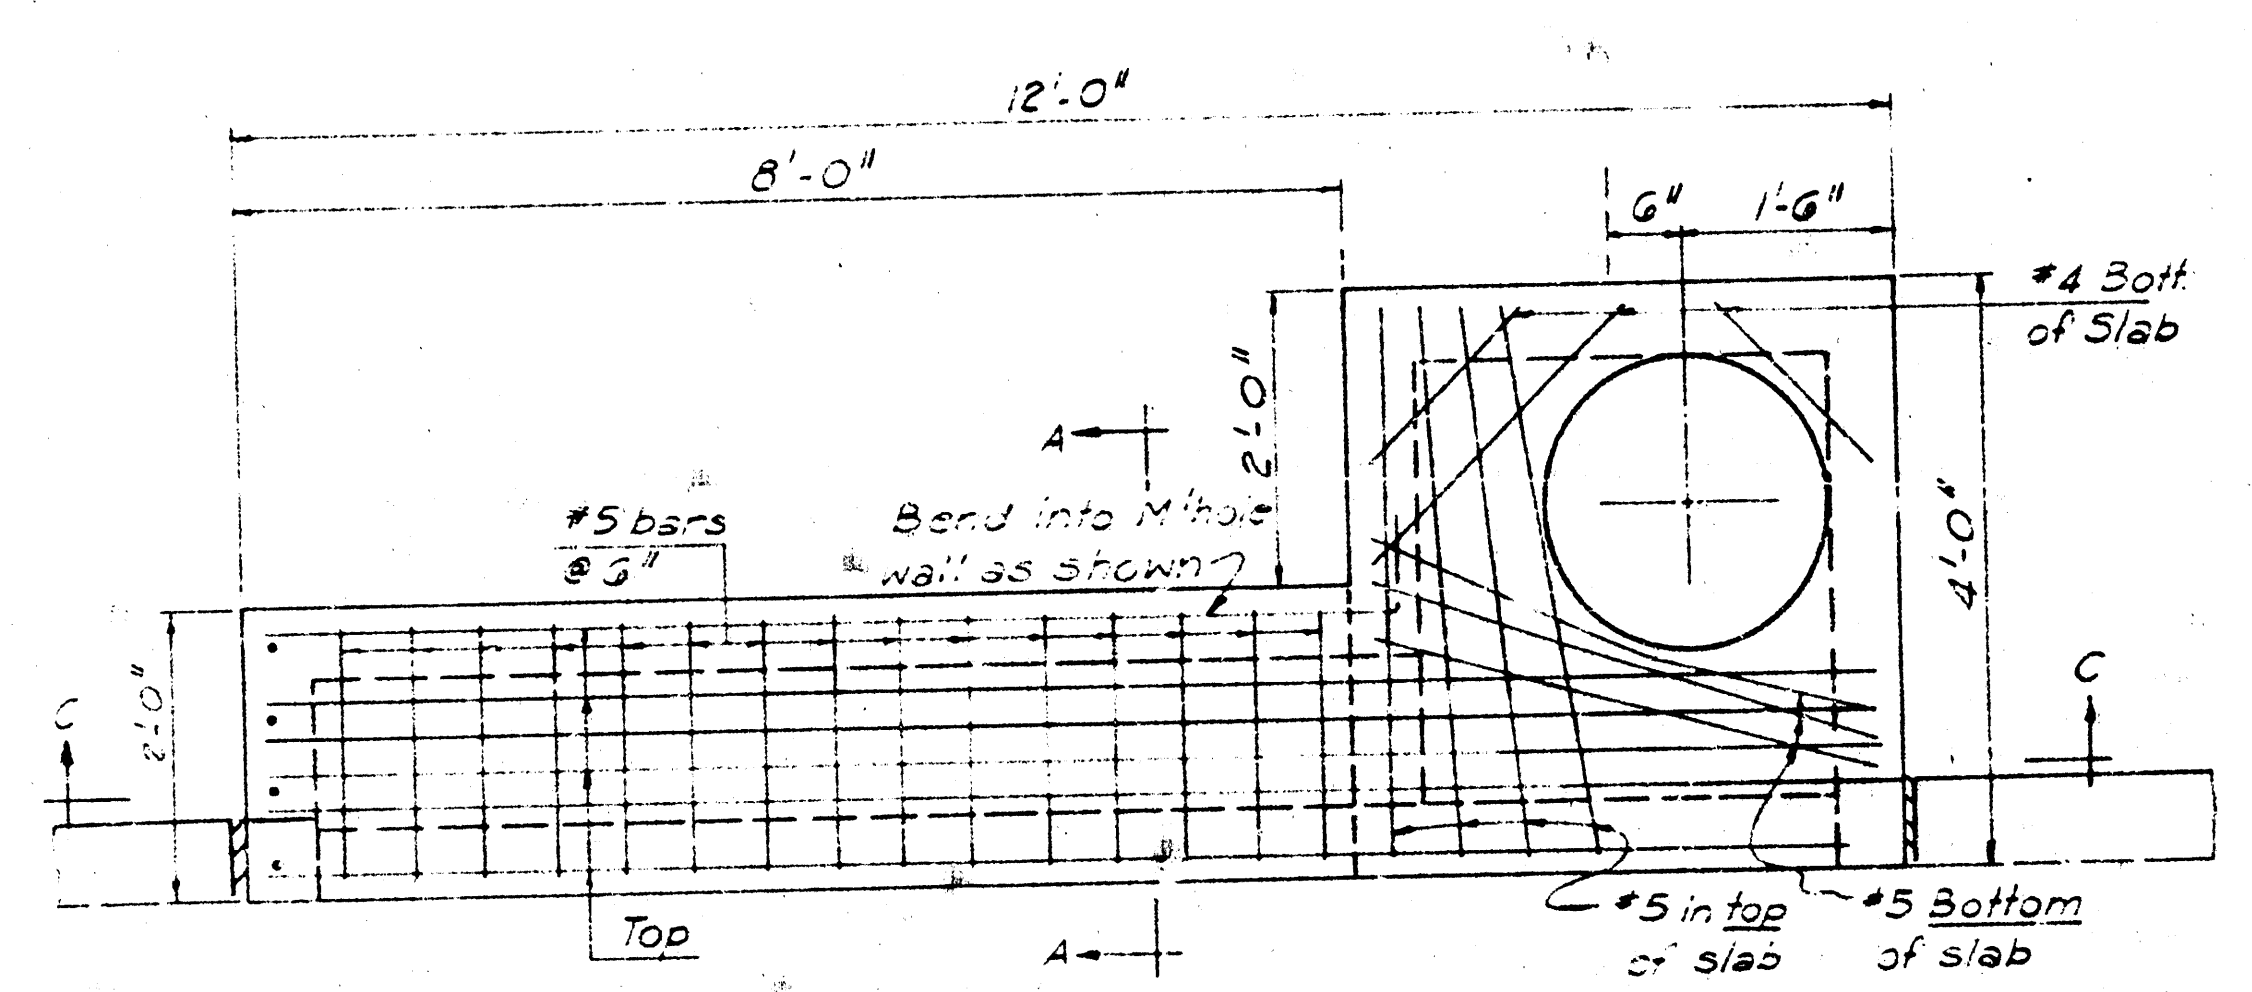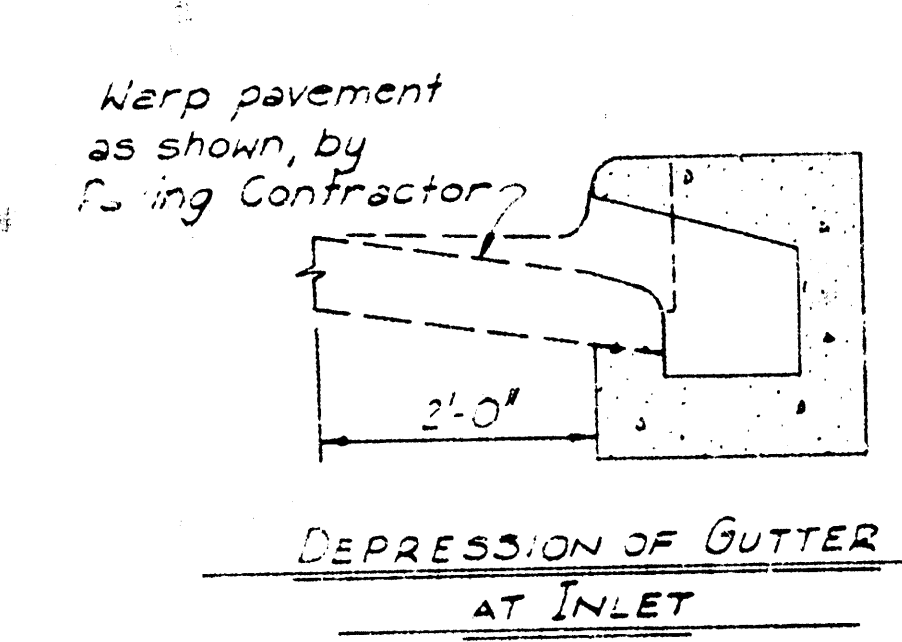


PLAN

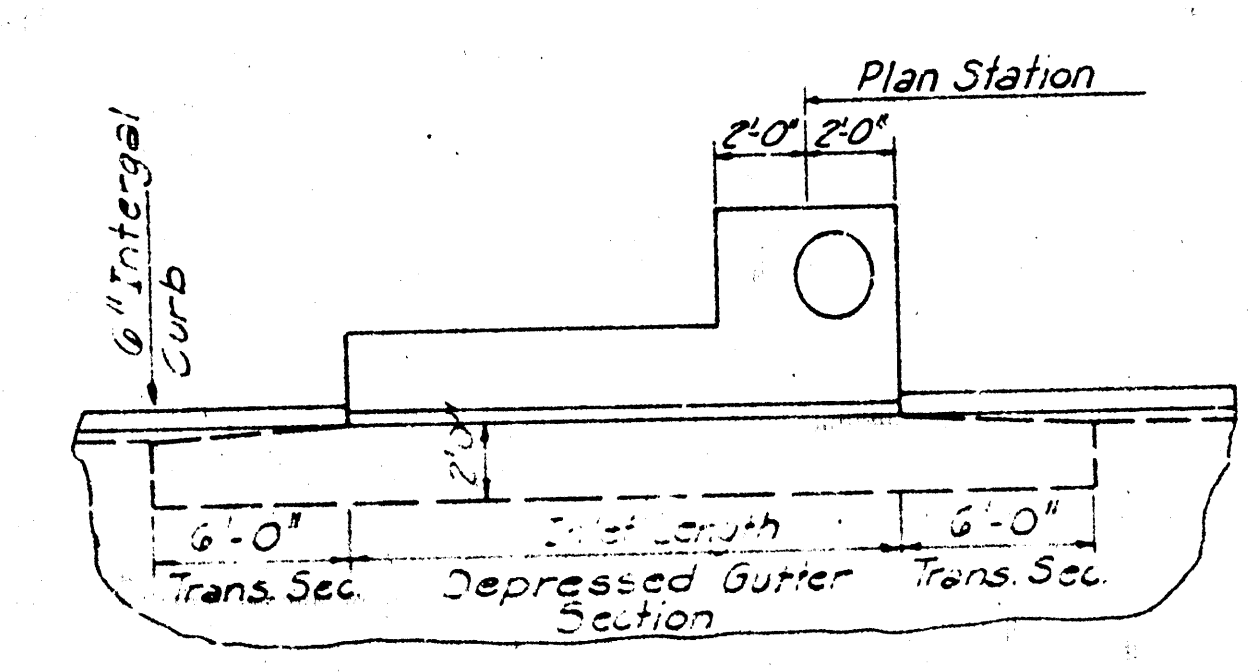


TYPICAL PLAN LAYOUT

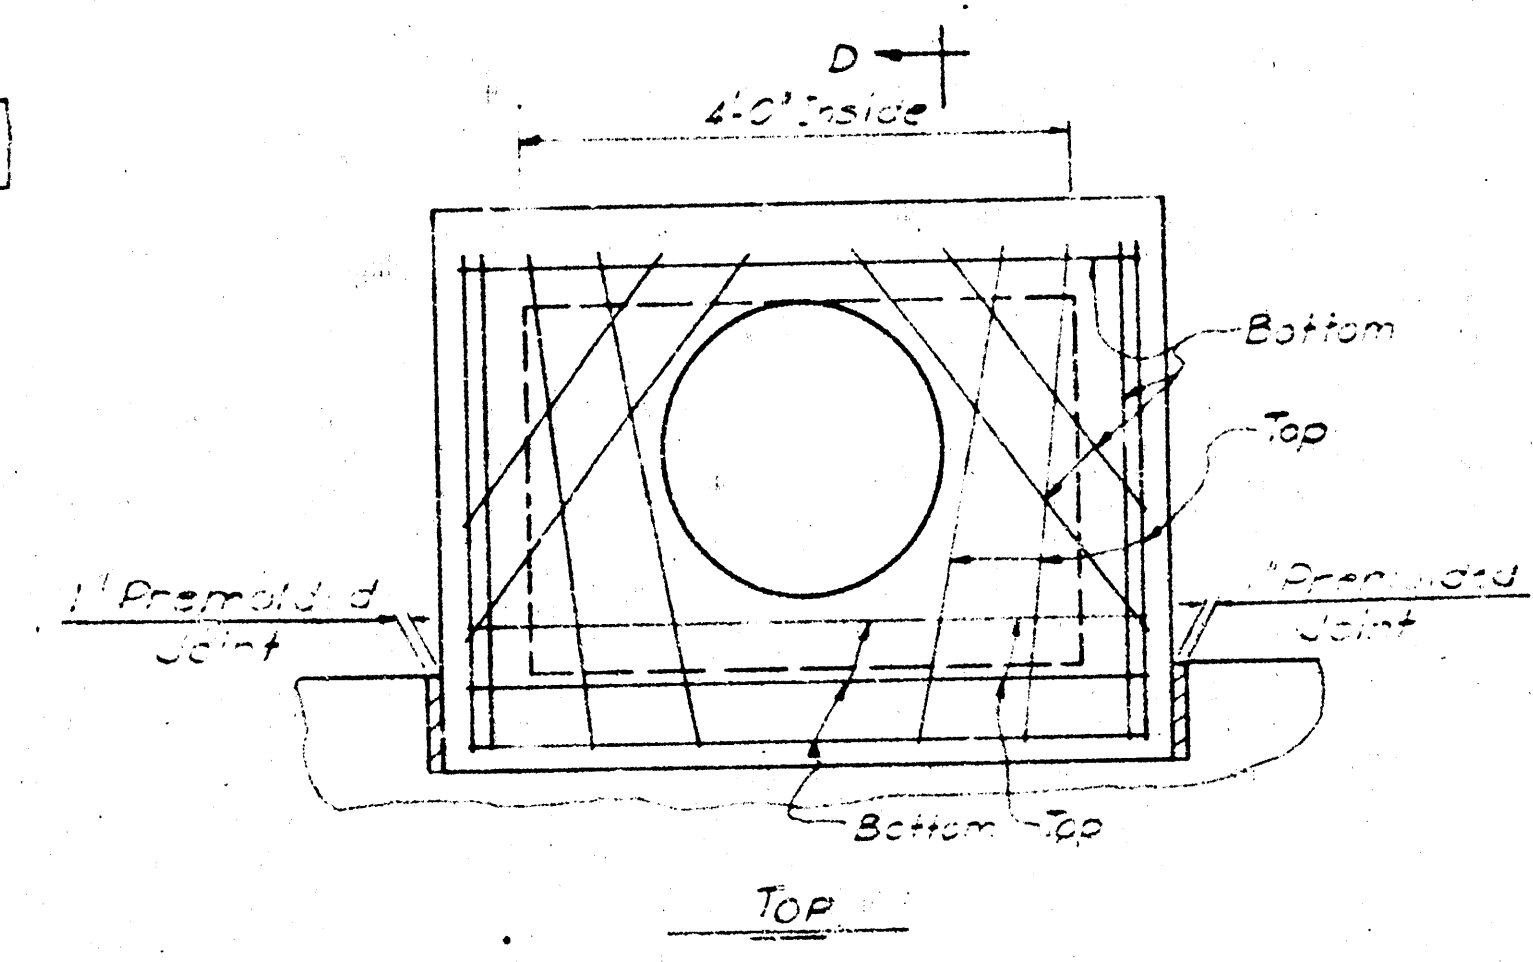

TOP

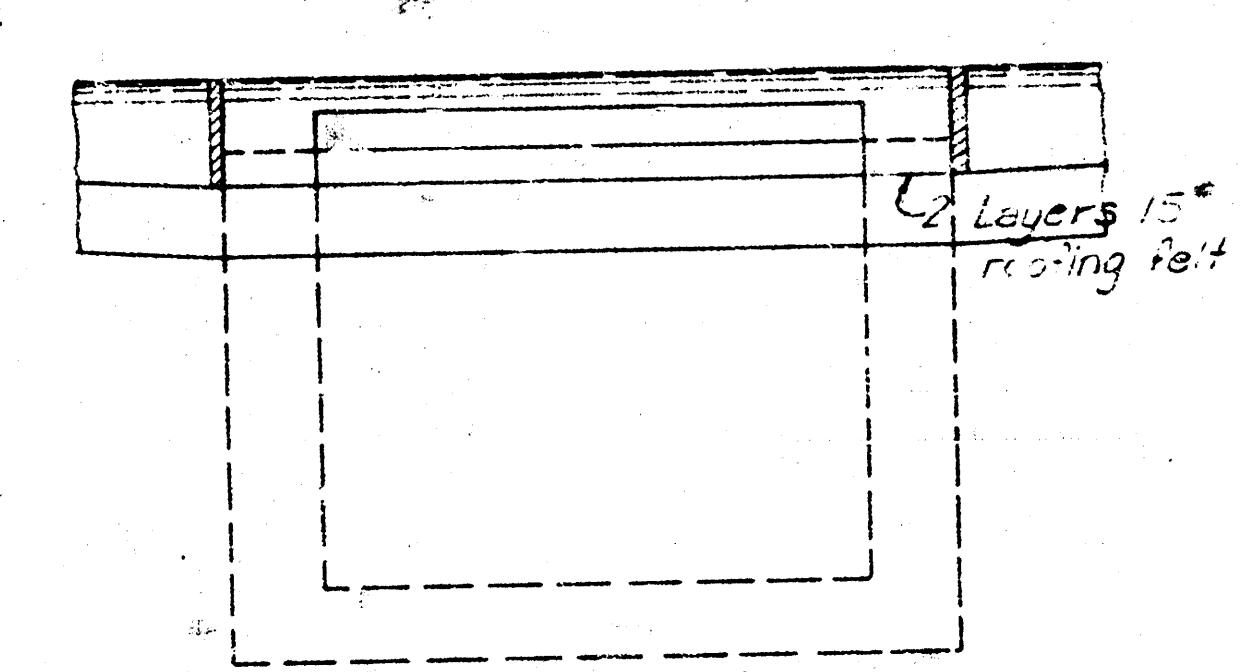


FRONT

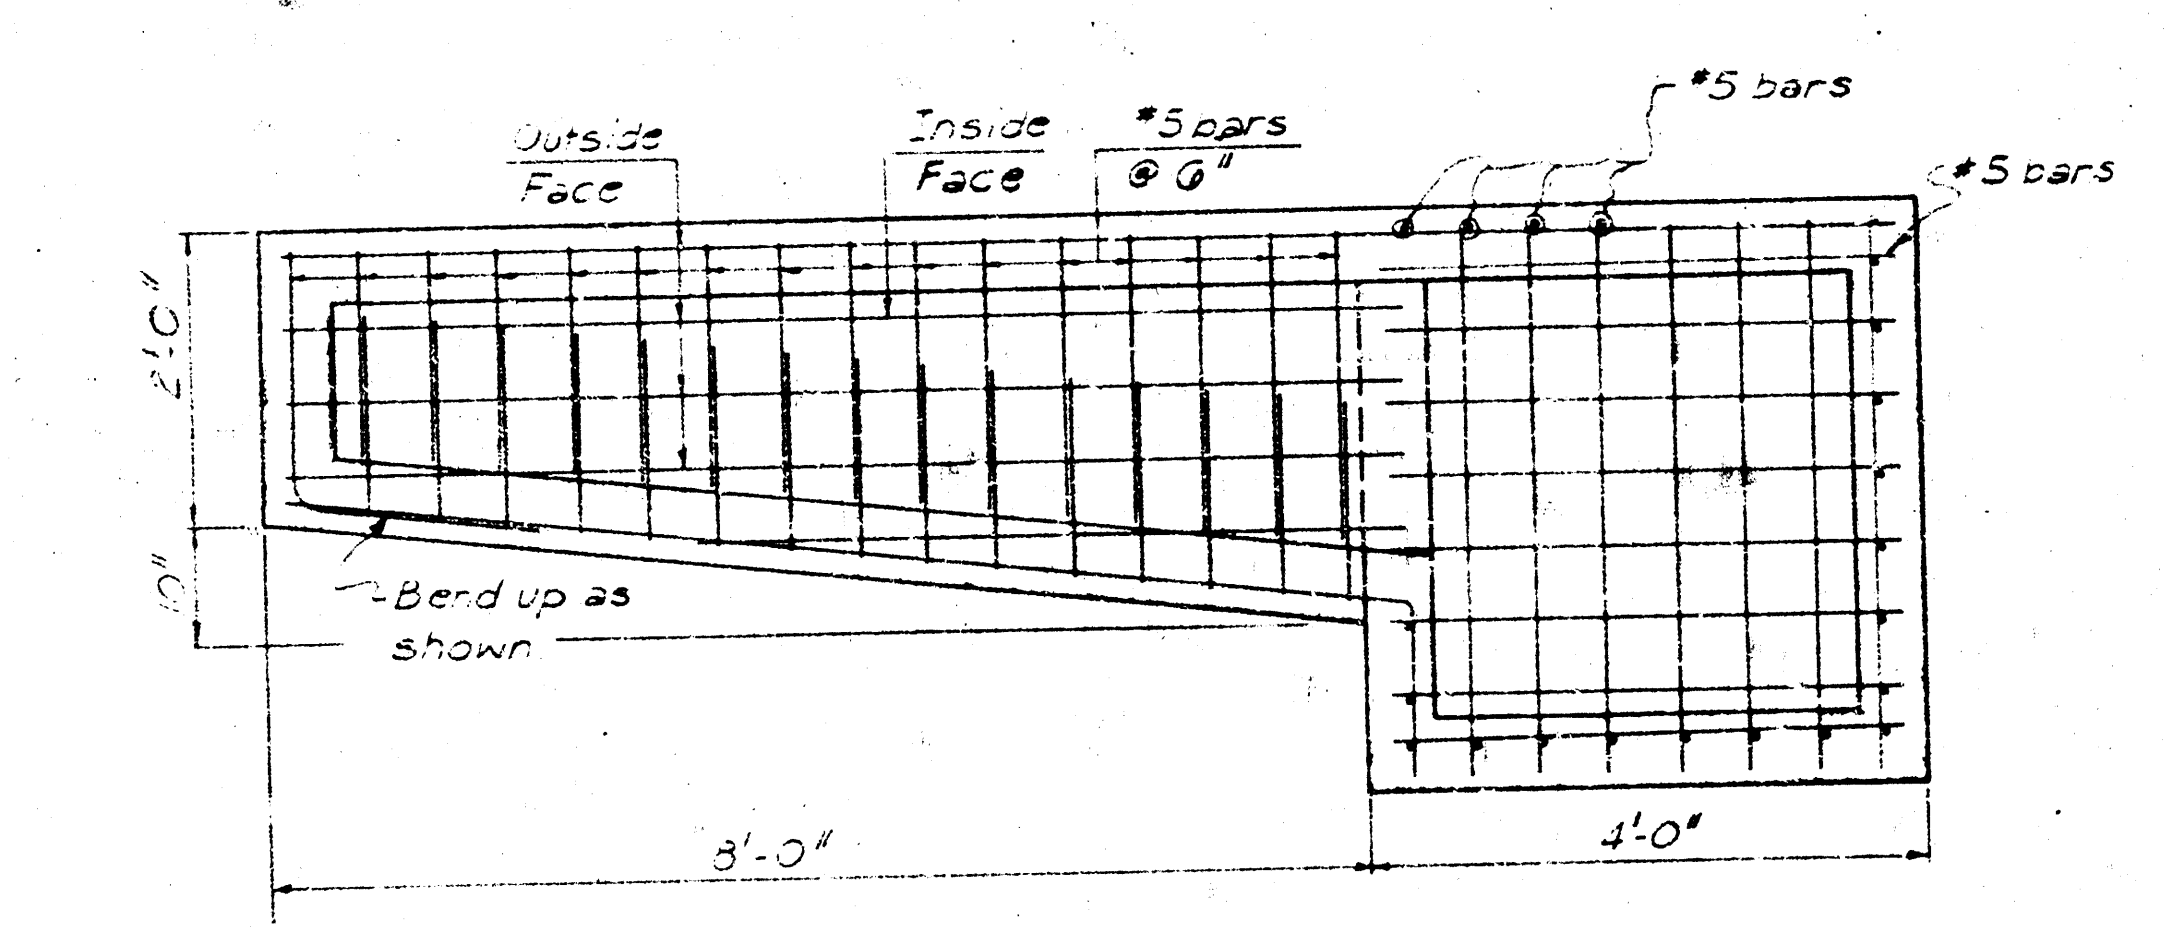

SECTION C-C

TYPE 'C-12' INLET

NOTE:
Use Class A or A(AE) concrete thru-out. Chamfer all exposed edges with a 1/4" radius edge.
All walls, slabs and floors are 6" thick unless otherwise noted.
Use #4 bars @ 6" c/c, unless otherwise noted.
Pour manhole section monolithically with Inlet-Flume Section.

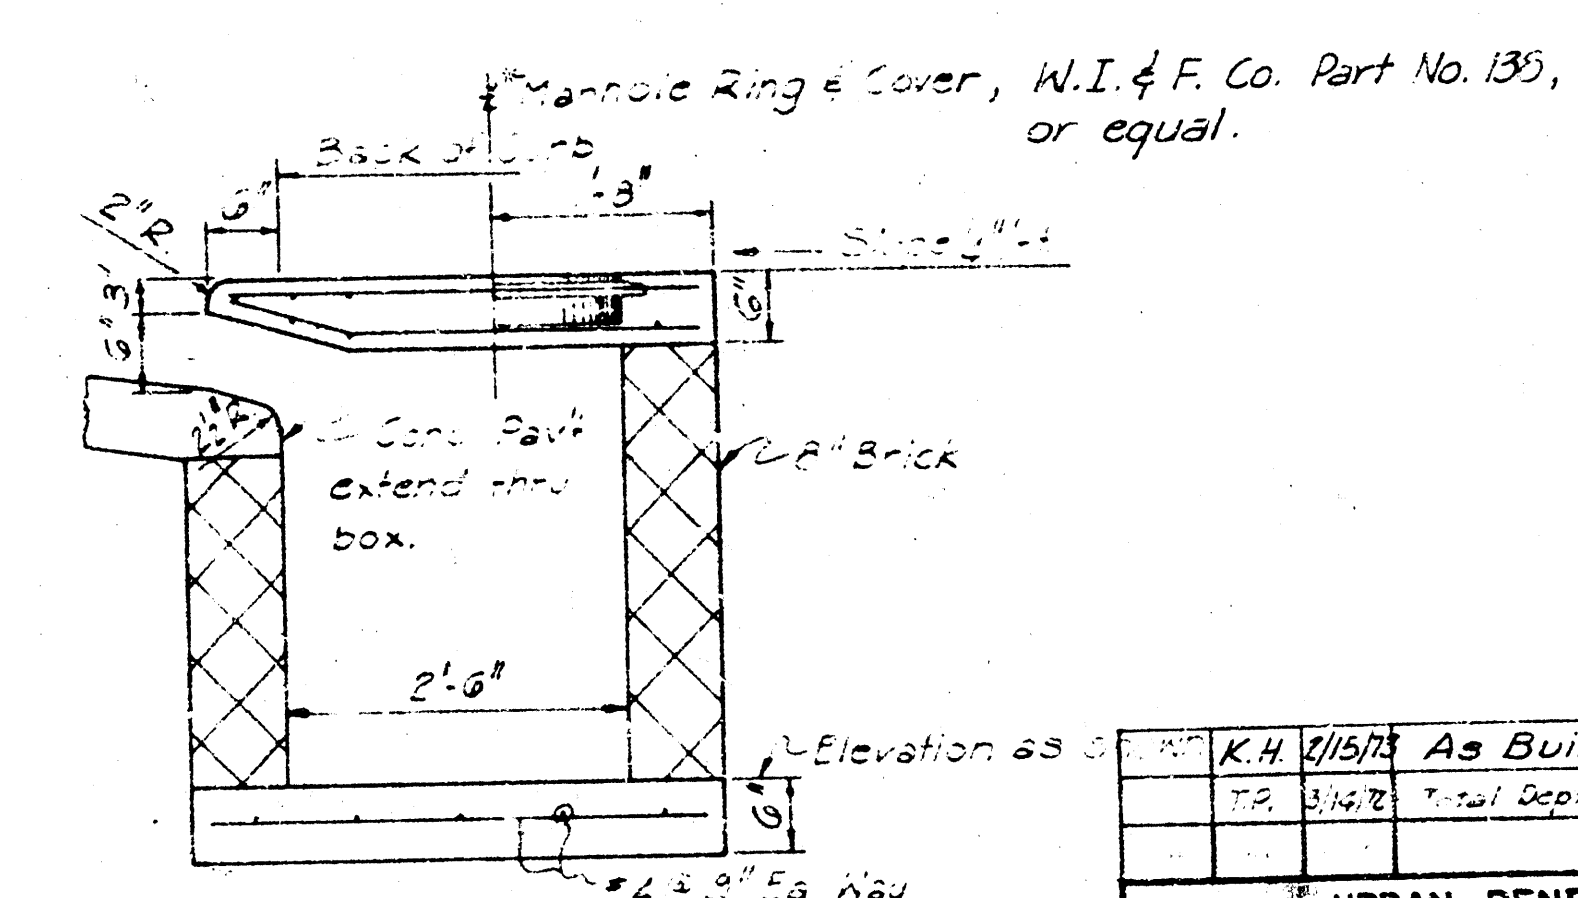



SECTION D-D


TYPE 'C-4' INLET


NOTE:
Use Class A or A(AE) concrete.
All bars #5 in top, #4 in base.
Top may be cast in place or precast.
Finish all exposed edges with a 1/4" radius edge.


K.H. 12/5/72 As Built	
DATE	12/5/72
URBAN RENEWAL AGENCY	
KENNETH H. KITCHEN, EXECUTIVE DIRECTOR	
STREET IMPROVEMENTS	
EVERGREEN PARK	
CURB INLET DETAILS	
R. S. DELAMATER	DATE February 1, 1972
CONSULTING ENGINEER	SCALE
WICHITA, KANSAS	DWG. NO. 260-B-5

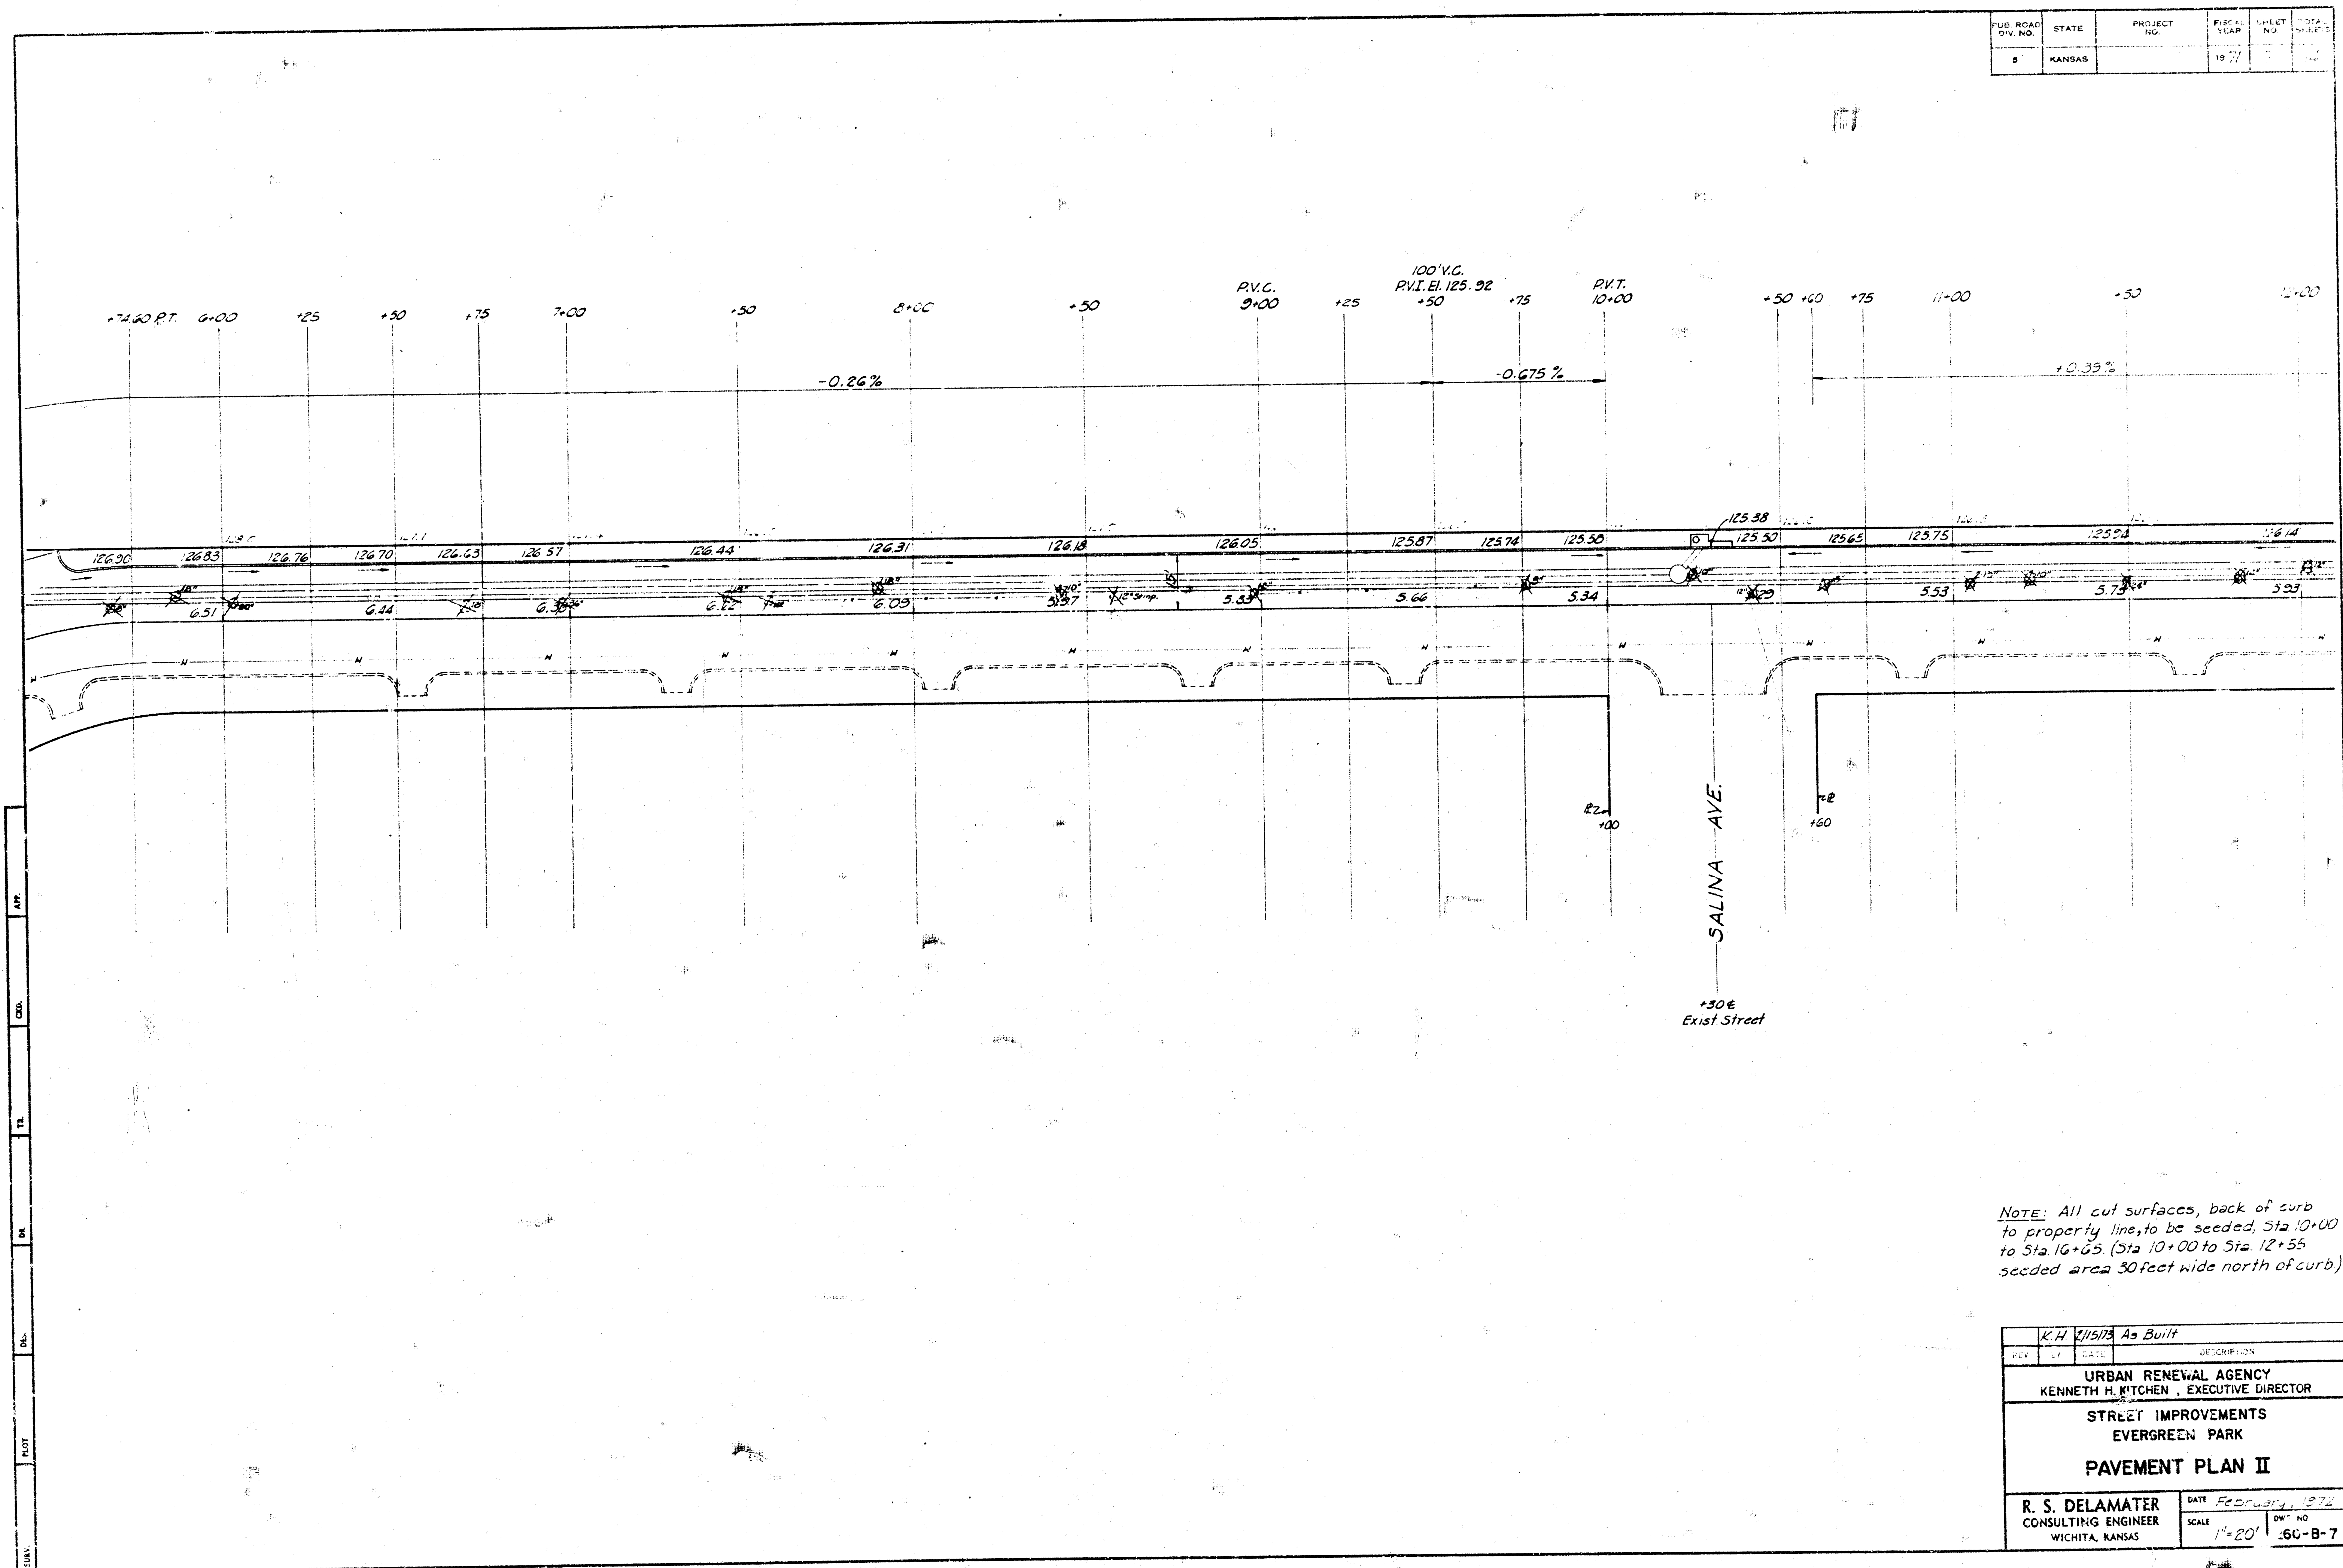

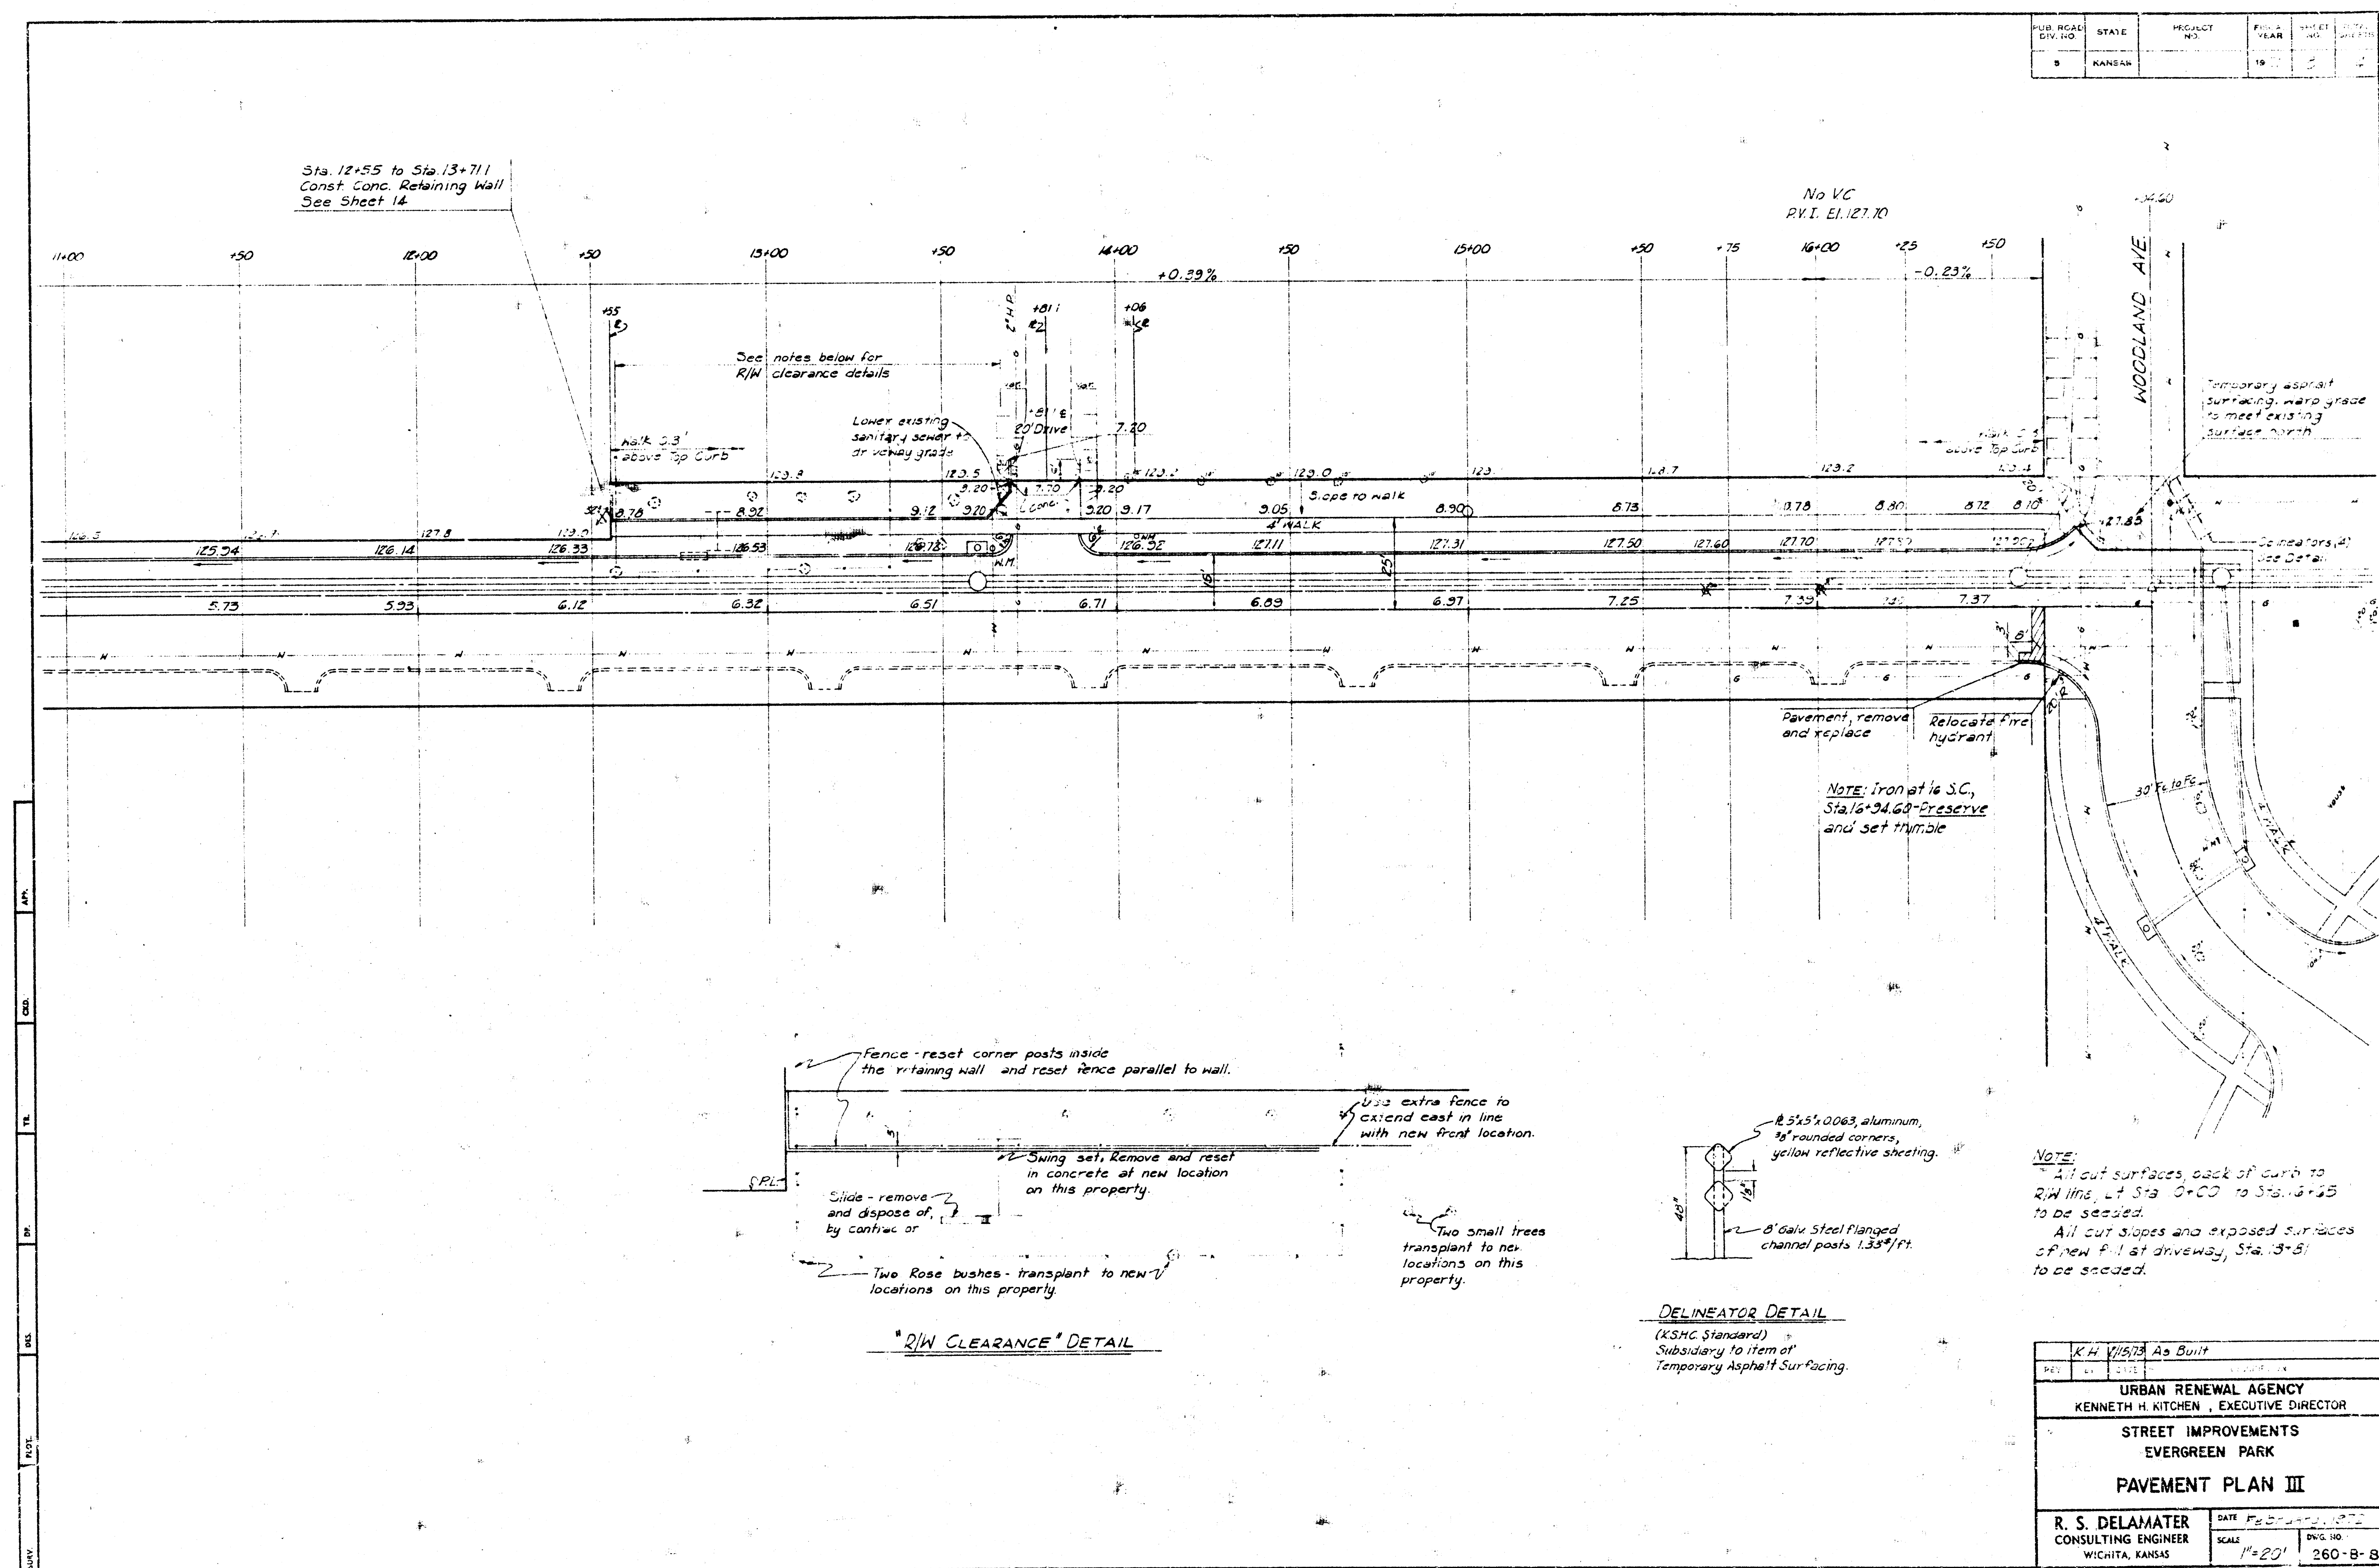

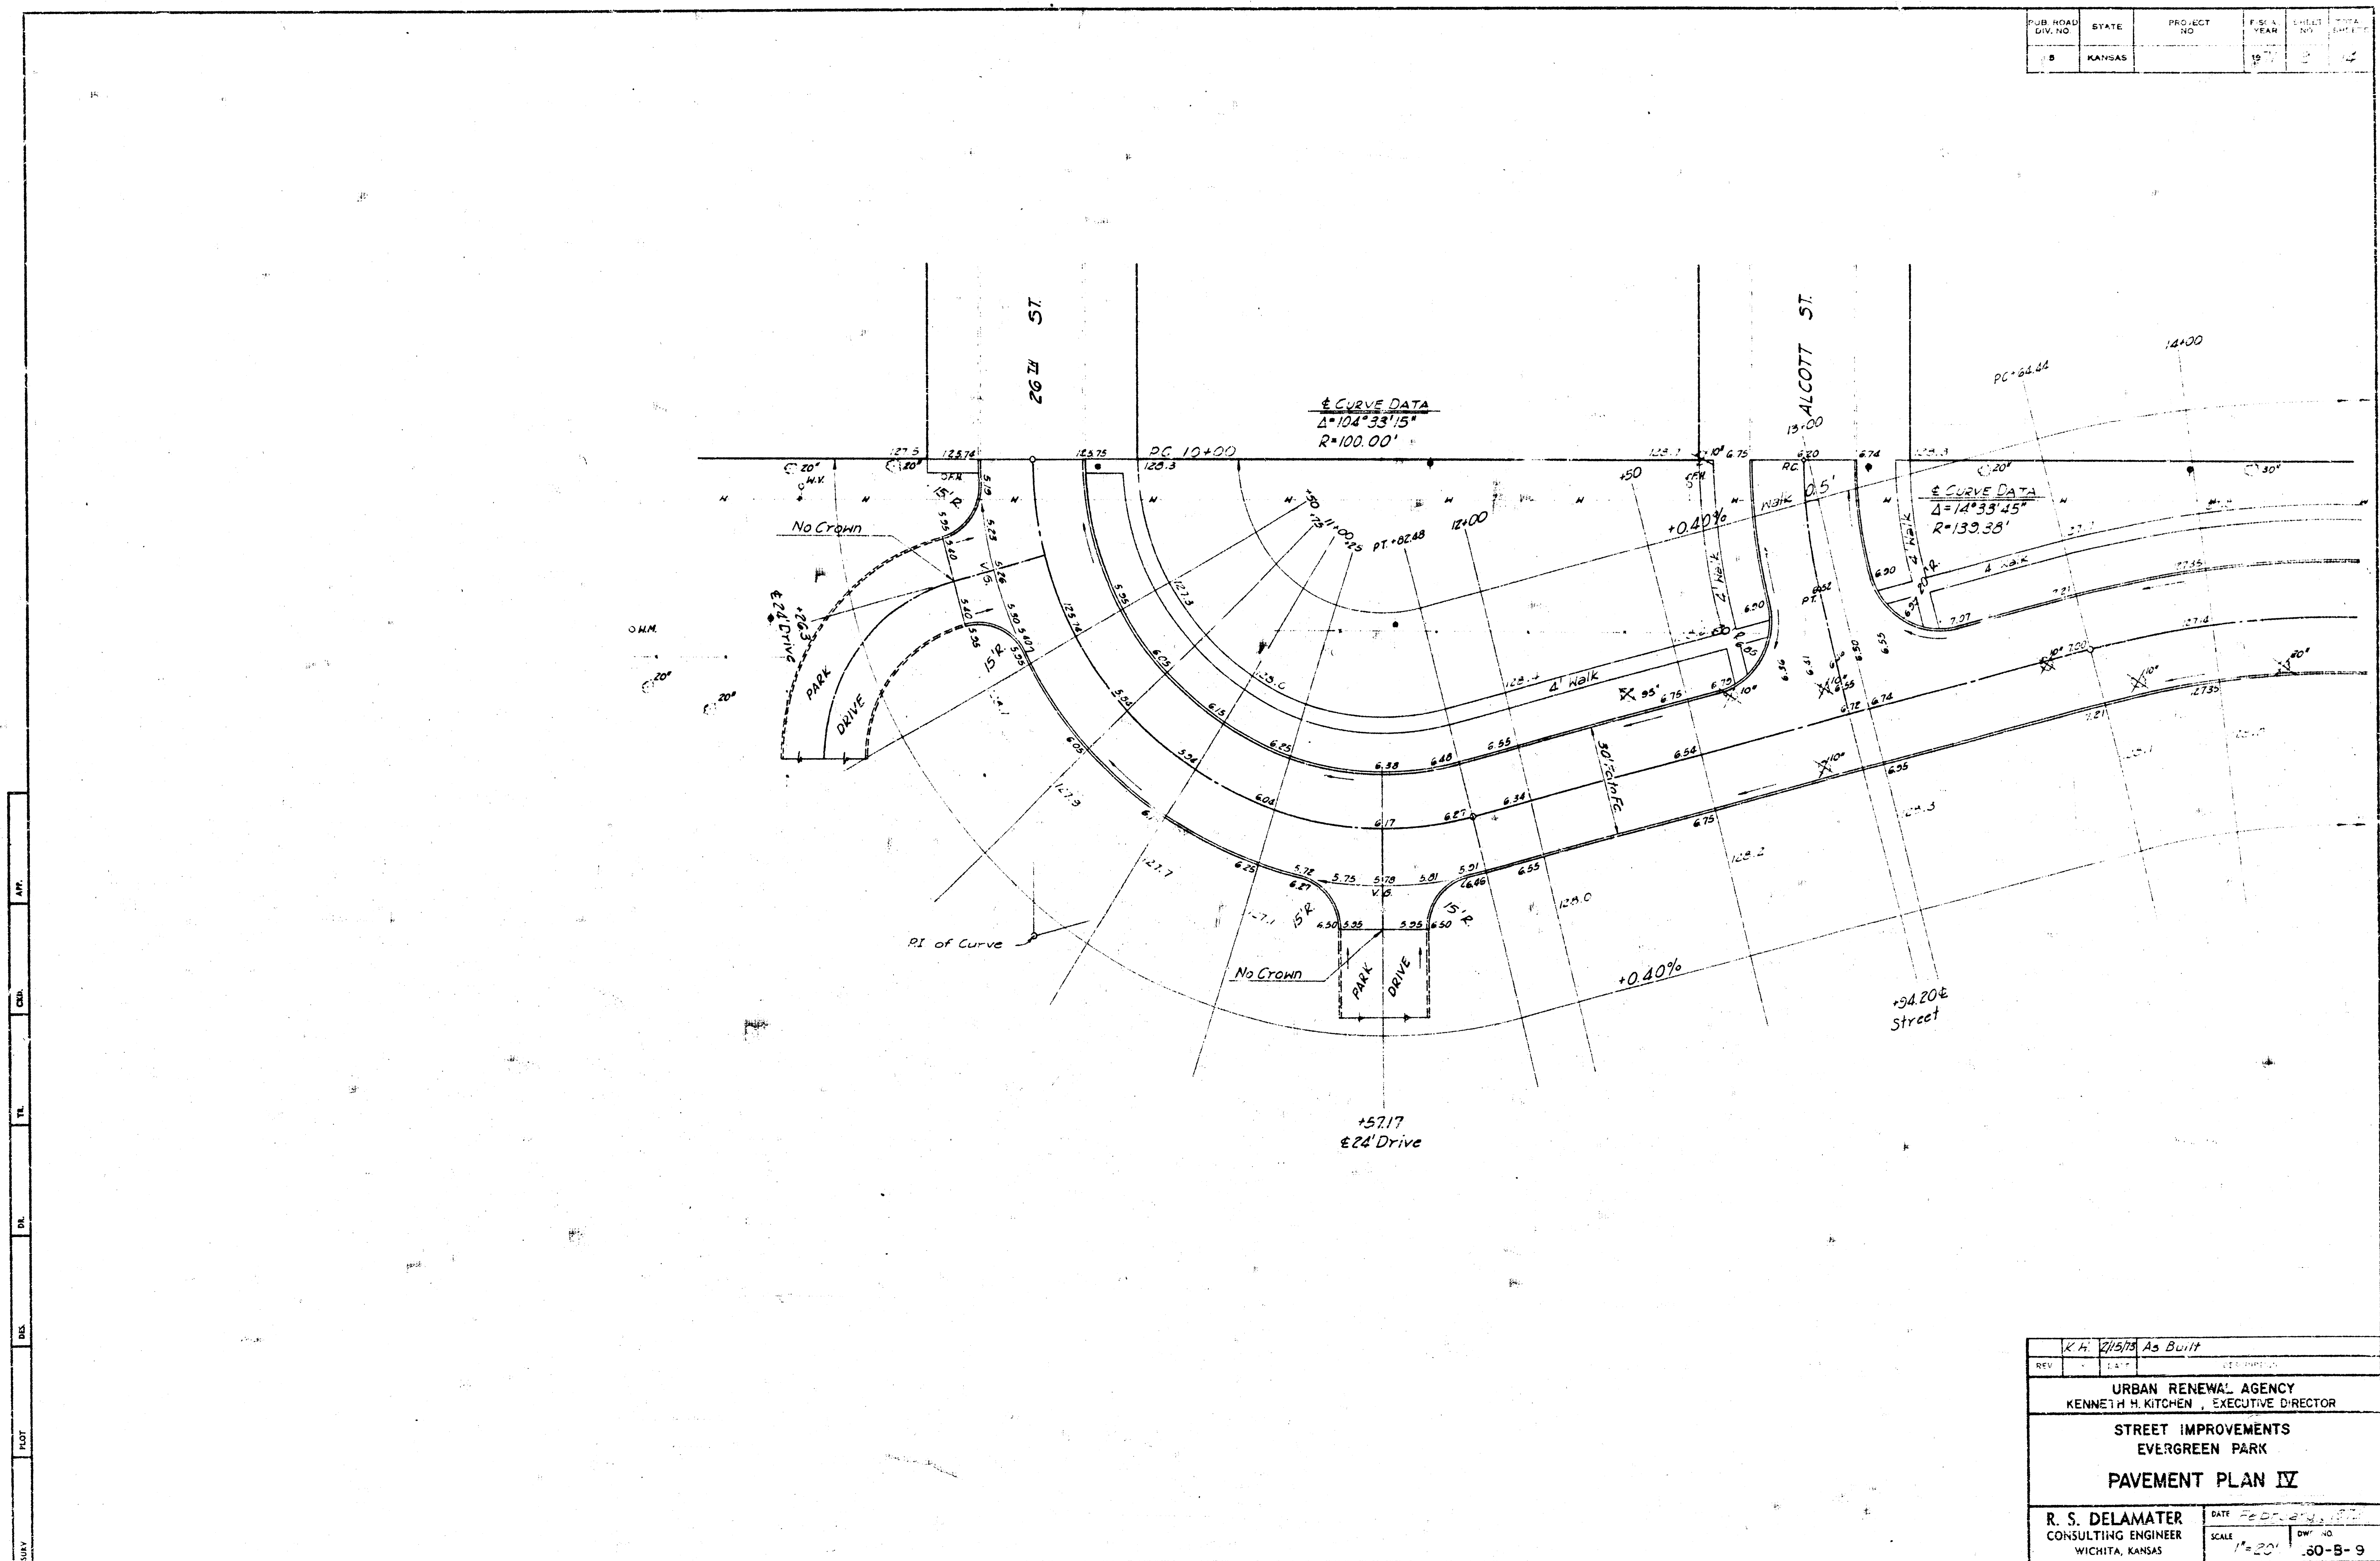


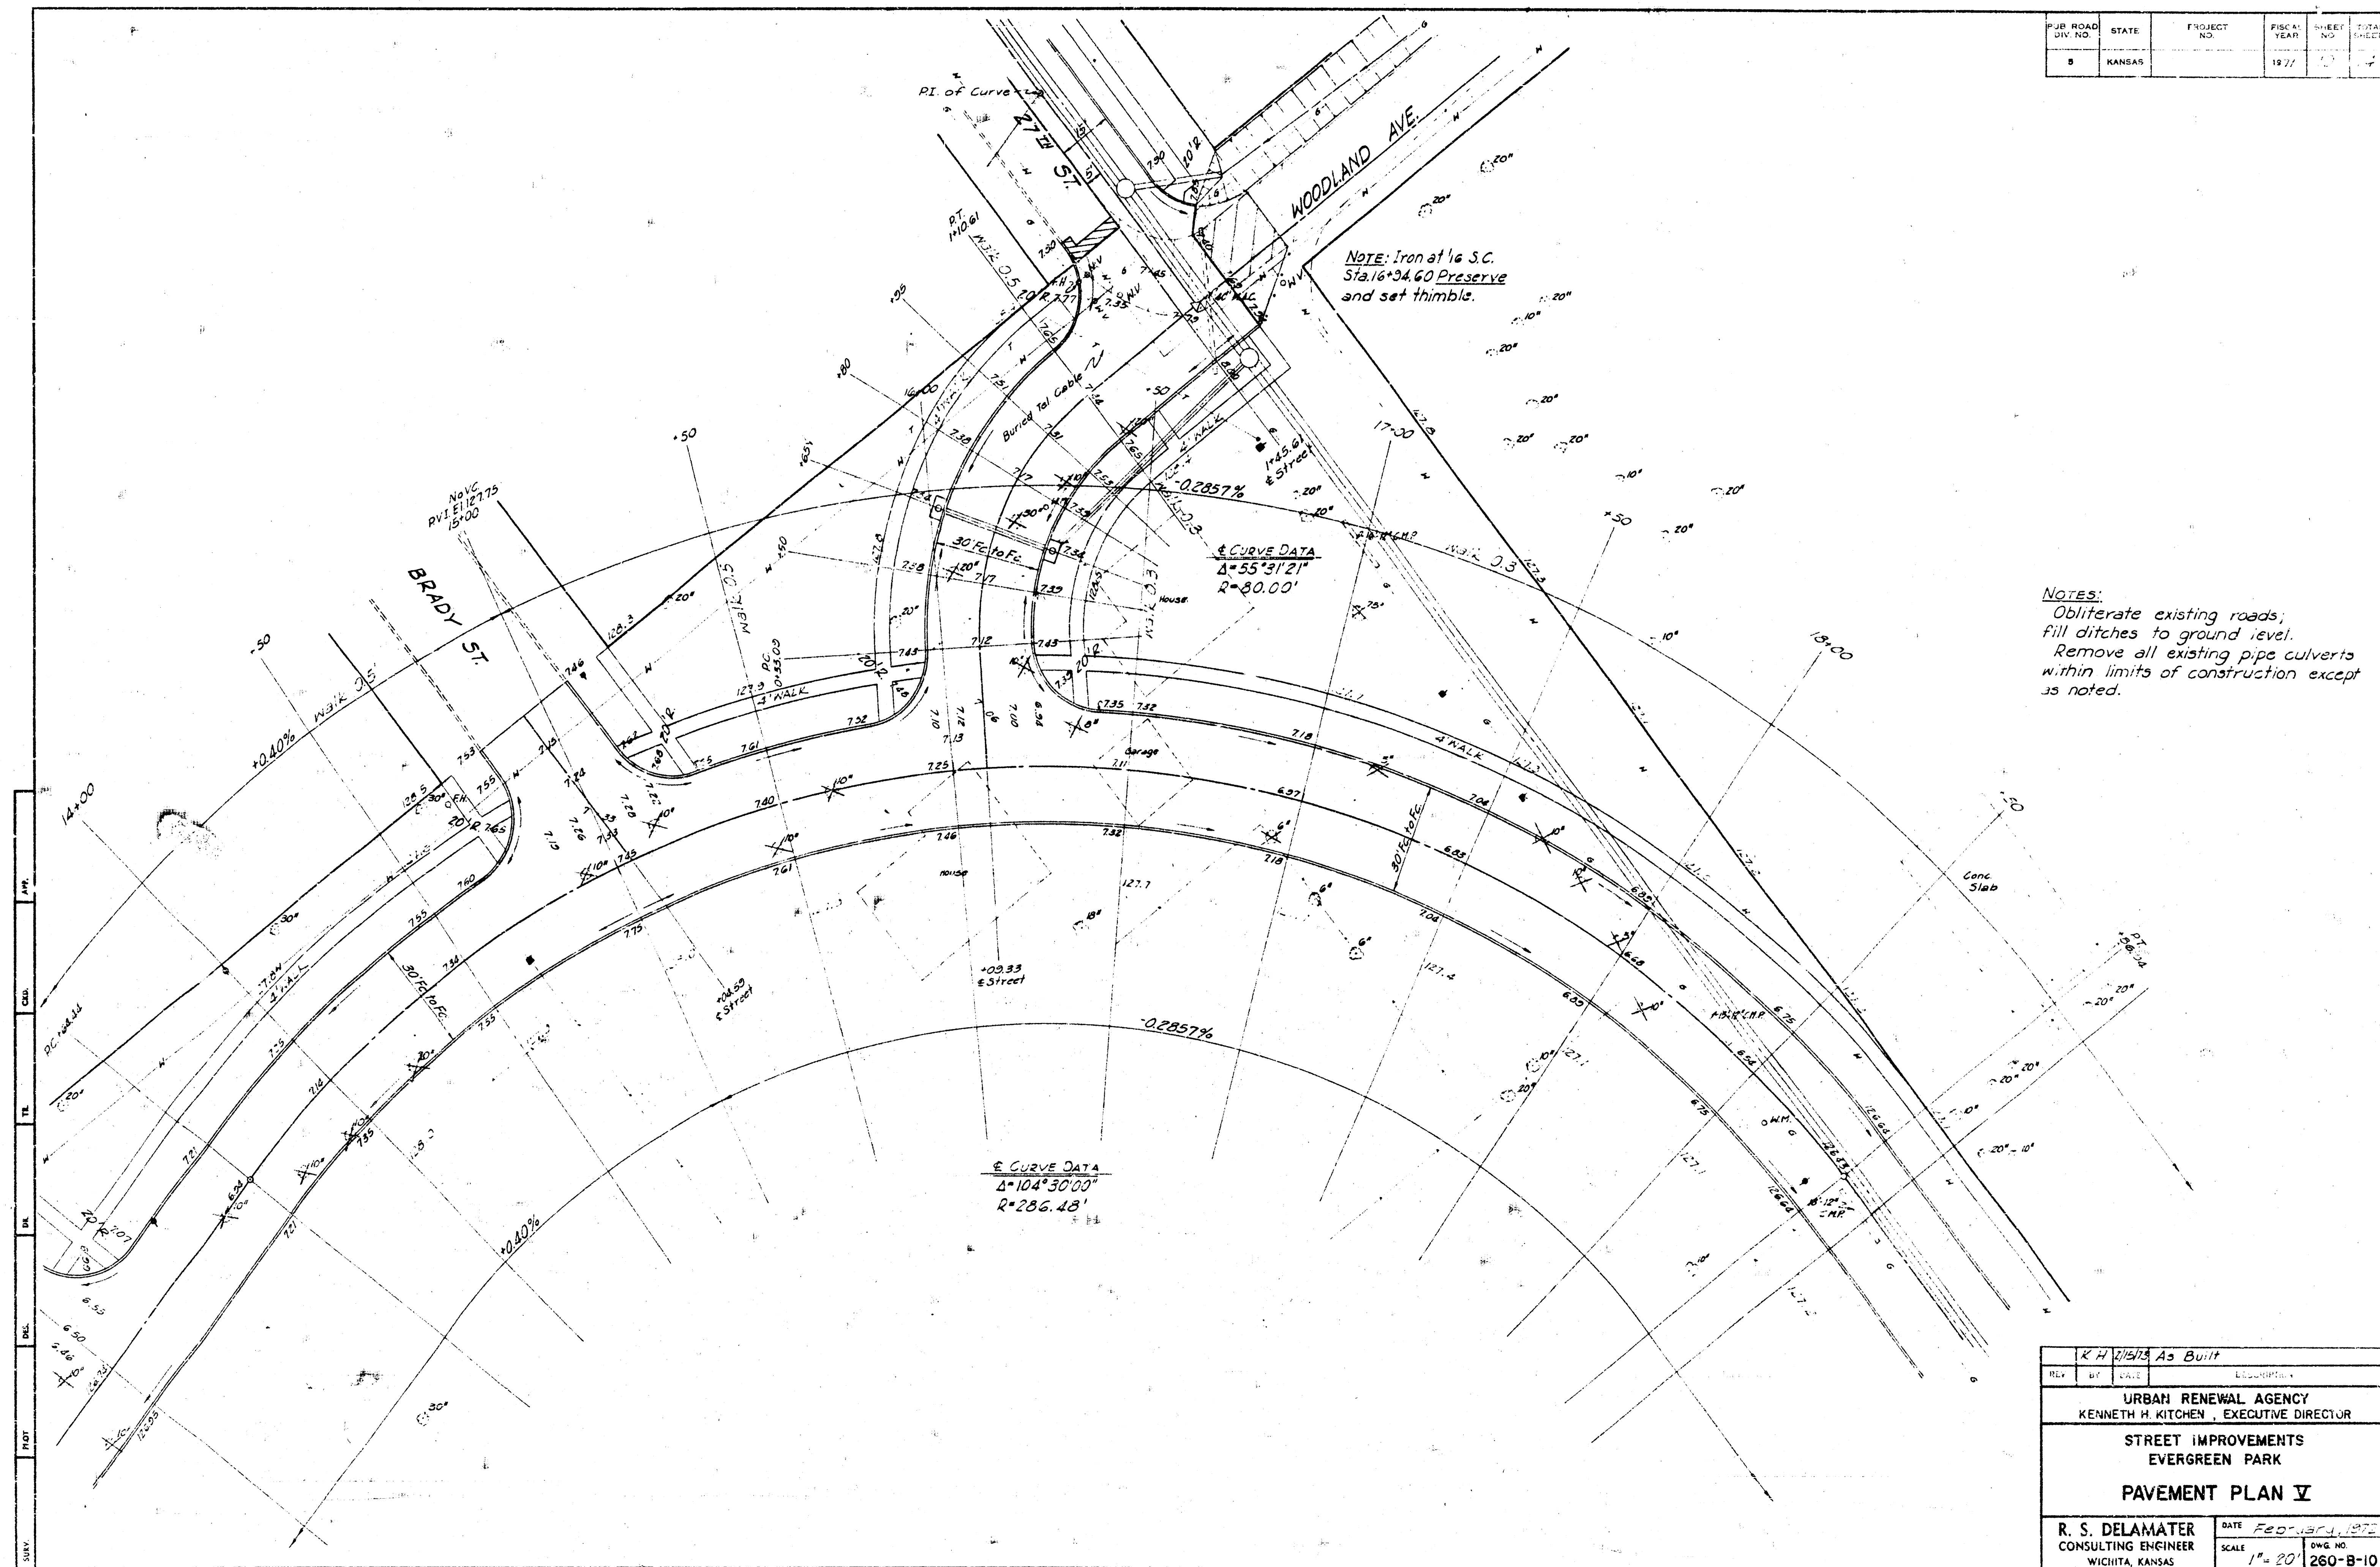

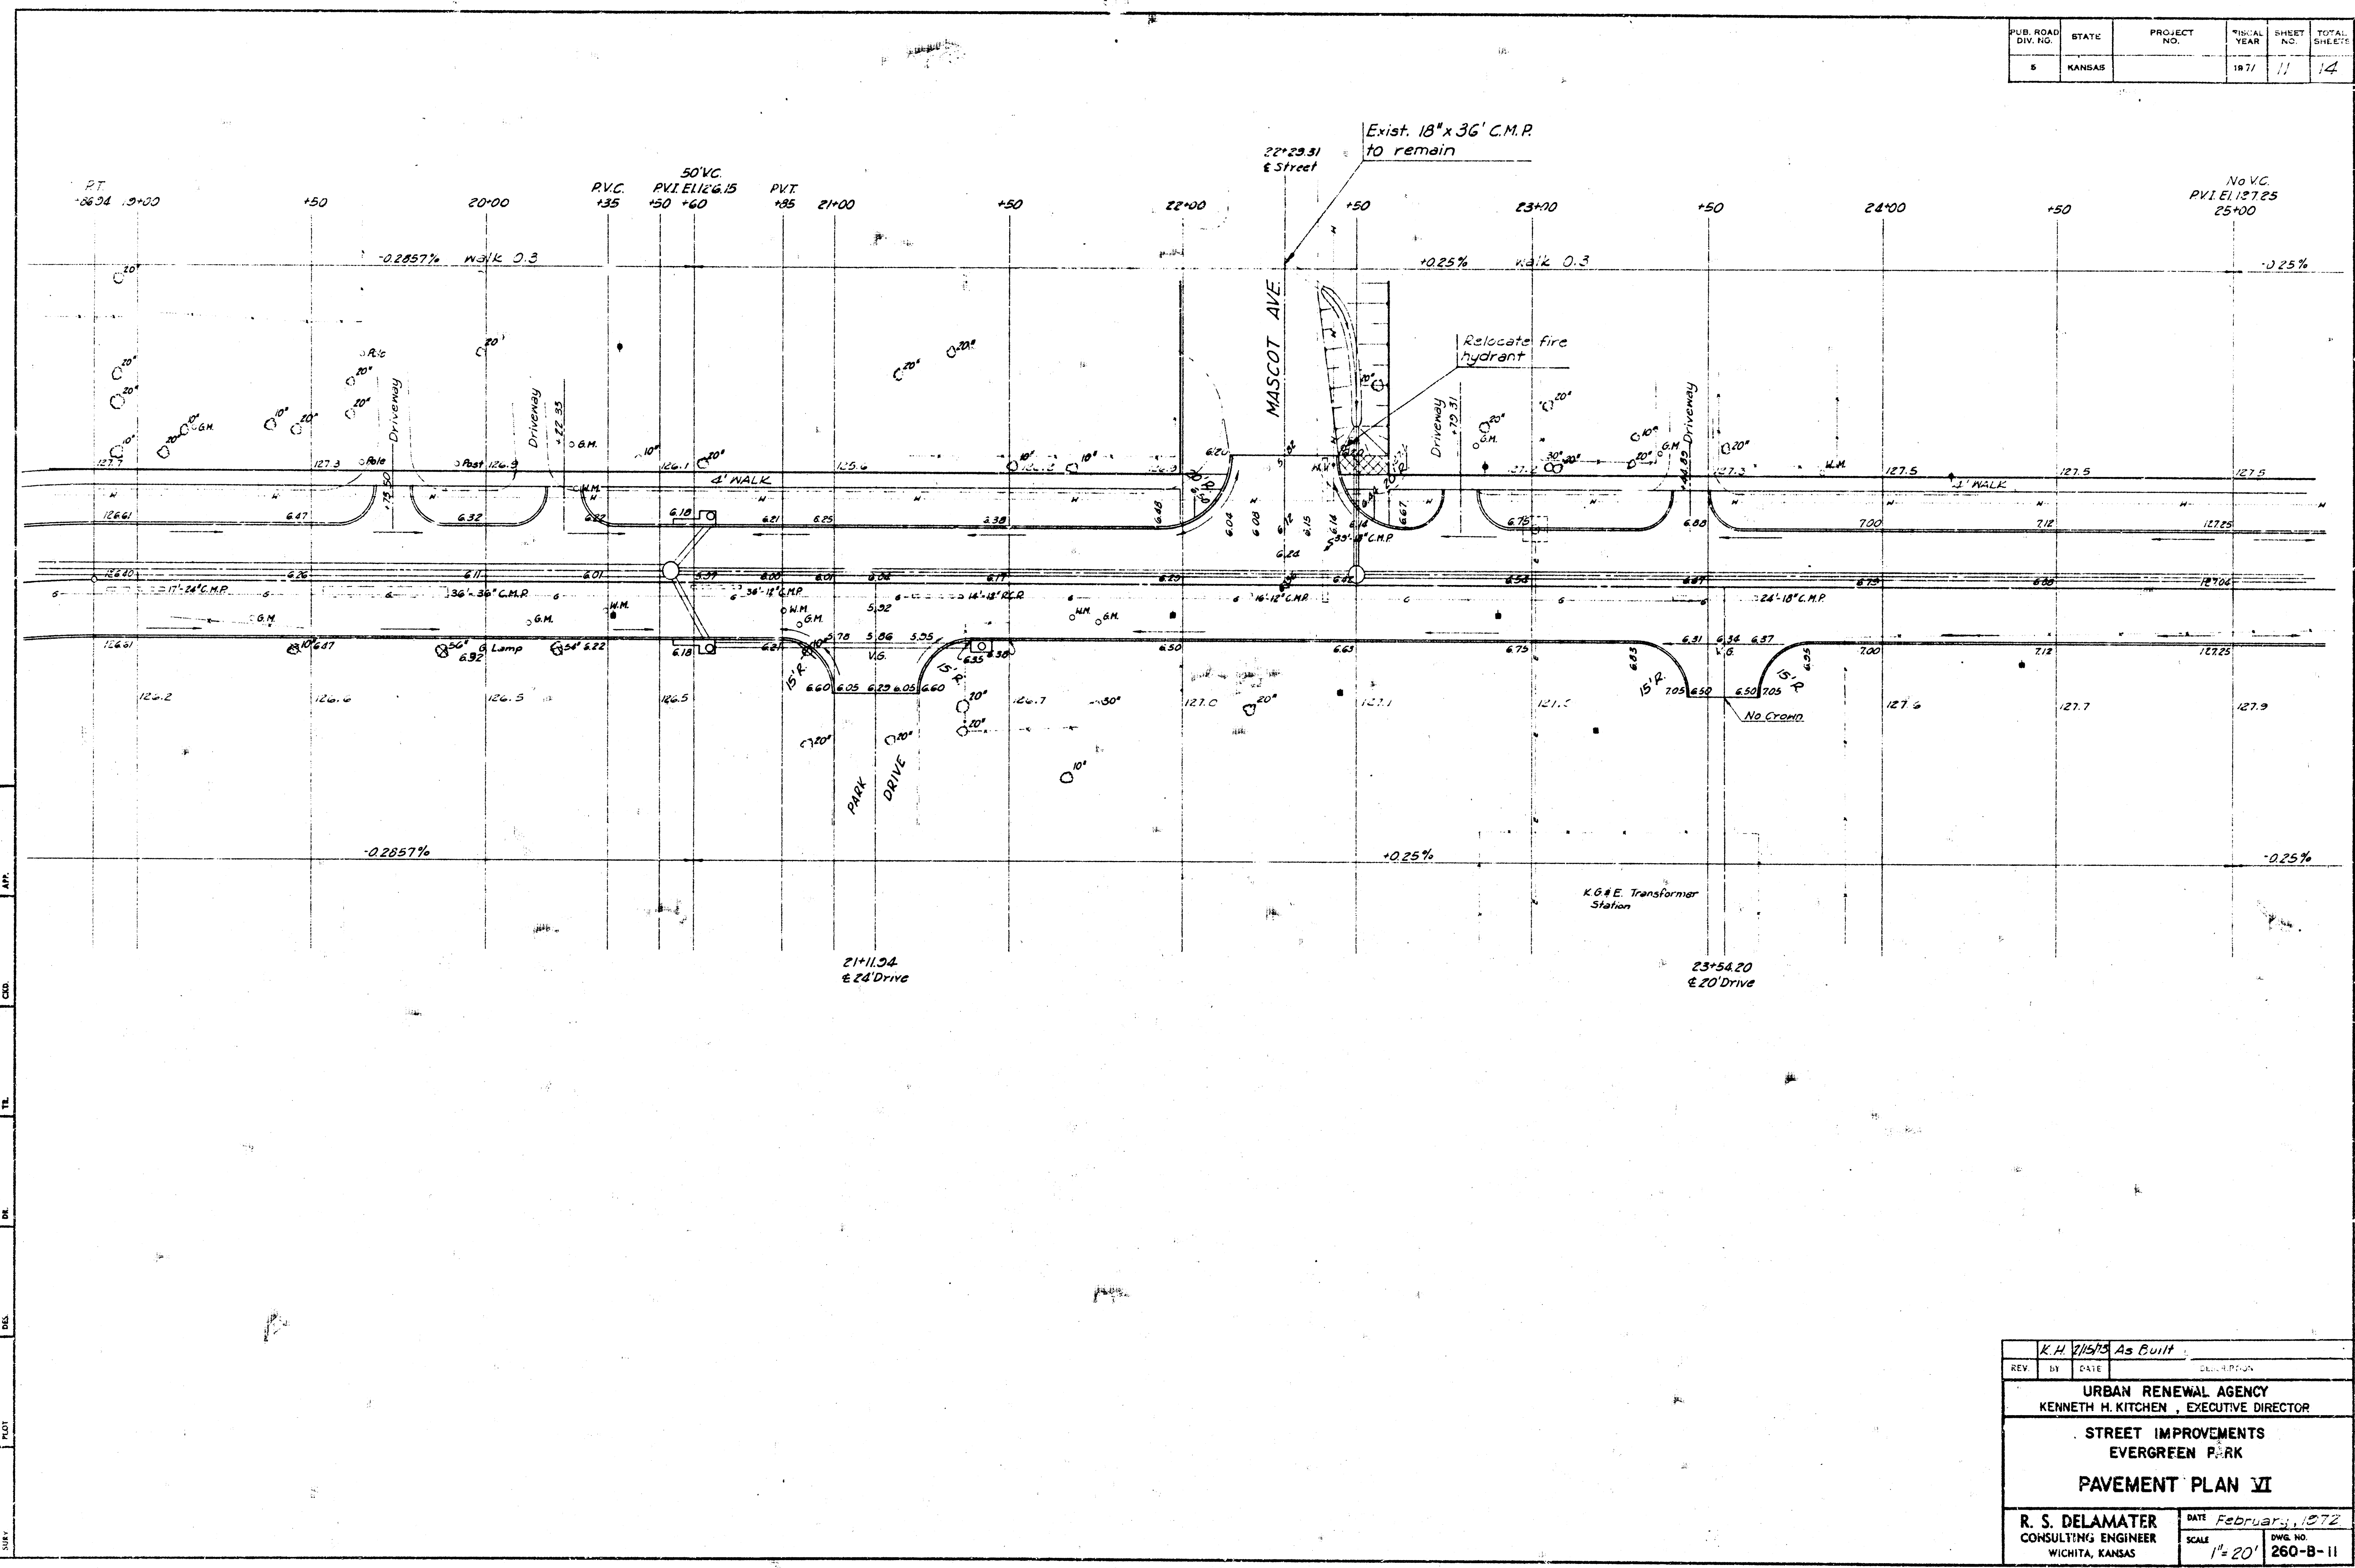

PUB. ROAD	STATE	PROJECT NO.	YEAR	SHEET NO.	TOTAL SHEETS
8	KANSAS		1971	11	14


K.H. 10/5/79 As Built	
REV	DATE
URBAN RENEWAL AGENCY KENNETH H. KITCHEN, EXECUTIVE DIRECTOR	
STREET IMPROVEMENTS EVERGREEN PARK	
PAVEMENT PLAN VI	
R. S. DELAMATER CONSULTING ENGINEER WICHITA, KANSAS	
DATE	February, 1972
SCALE	1"=20'
SHEET NO.	260-B-11

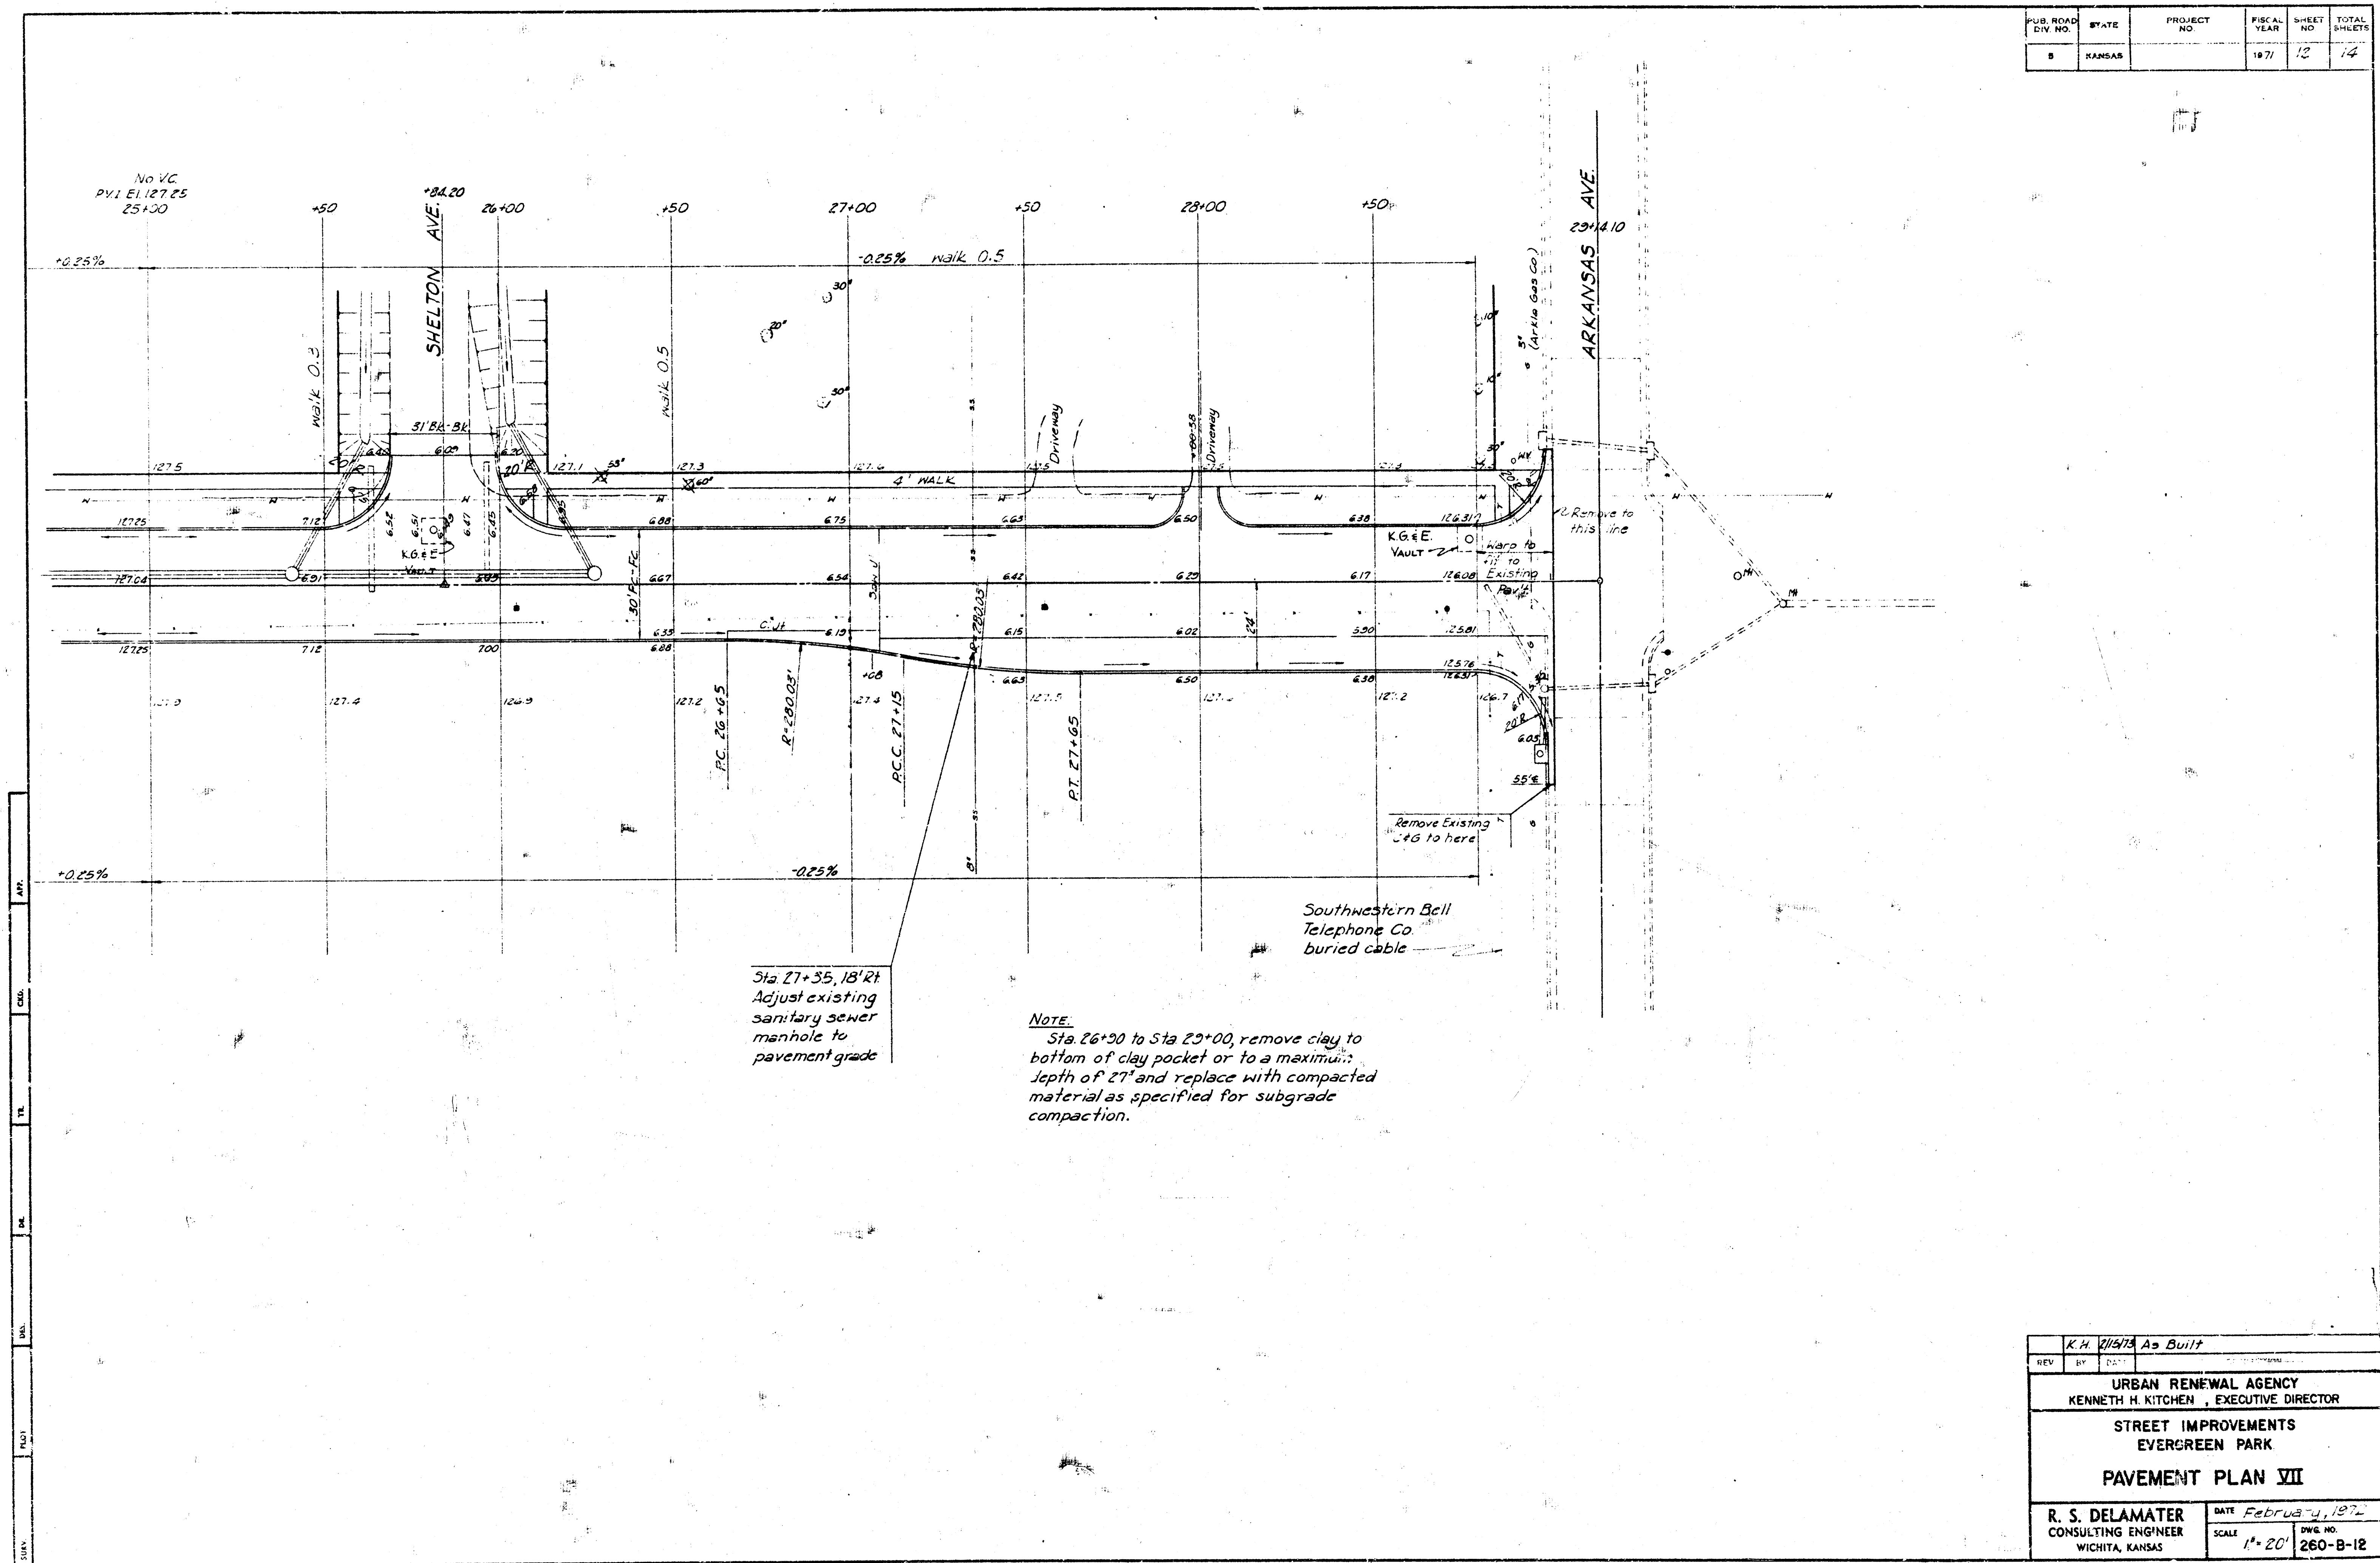


PUB. ROAD DIV. NO.	STATE	PROJECT NO.	FISCAL YEAR	SHEET NO.	TOTAL SHEETS
8	KANSAS		1971	12	14

K. H. DELAMATER As Built	
REV.	BY
URBAN RENEWAL AGENCY KENNETH H. KITCHEN, EXECUTIVE DIRECTOR	
STREET IMPROVEMENTS EVERGREEN PARK	
PAVEMENT PLAN VII	
R. S. DELAMATER CONSULTING ENGINEER WICHITA, KANSAS	
DATE	February 1, 1971
SCALE	1" = 20'
DWG. NO.	260-B-12


PUB. ROAD	STATE	PROJECT	FILE	SHEET
DIV. NO.	KANSAS	NO.	YEAR	NO.
5			19	

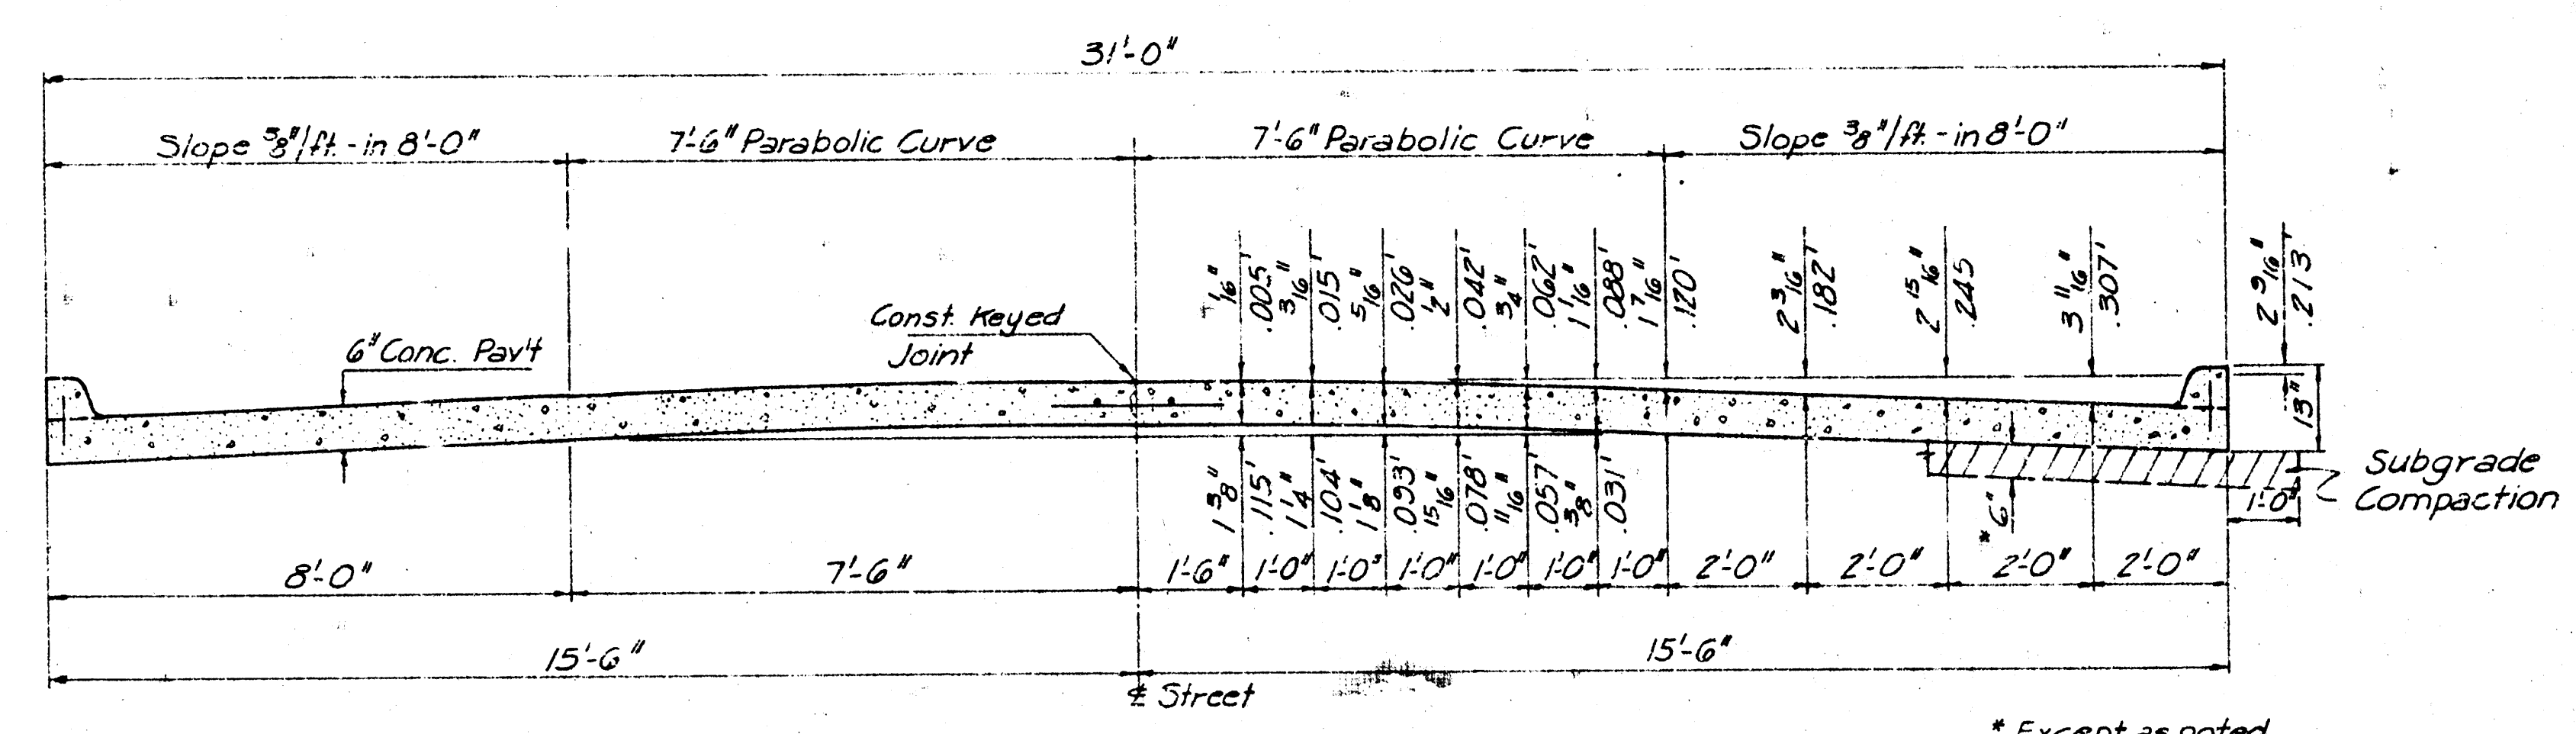


TYPICAL SECTION 31'-0" CONCRETE PAVEMENT

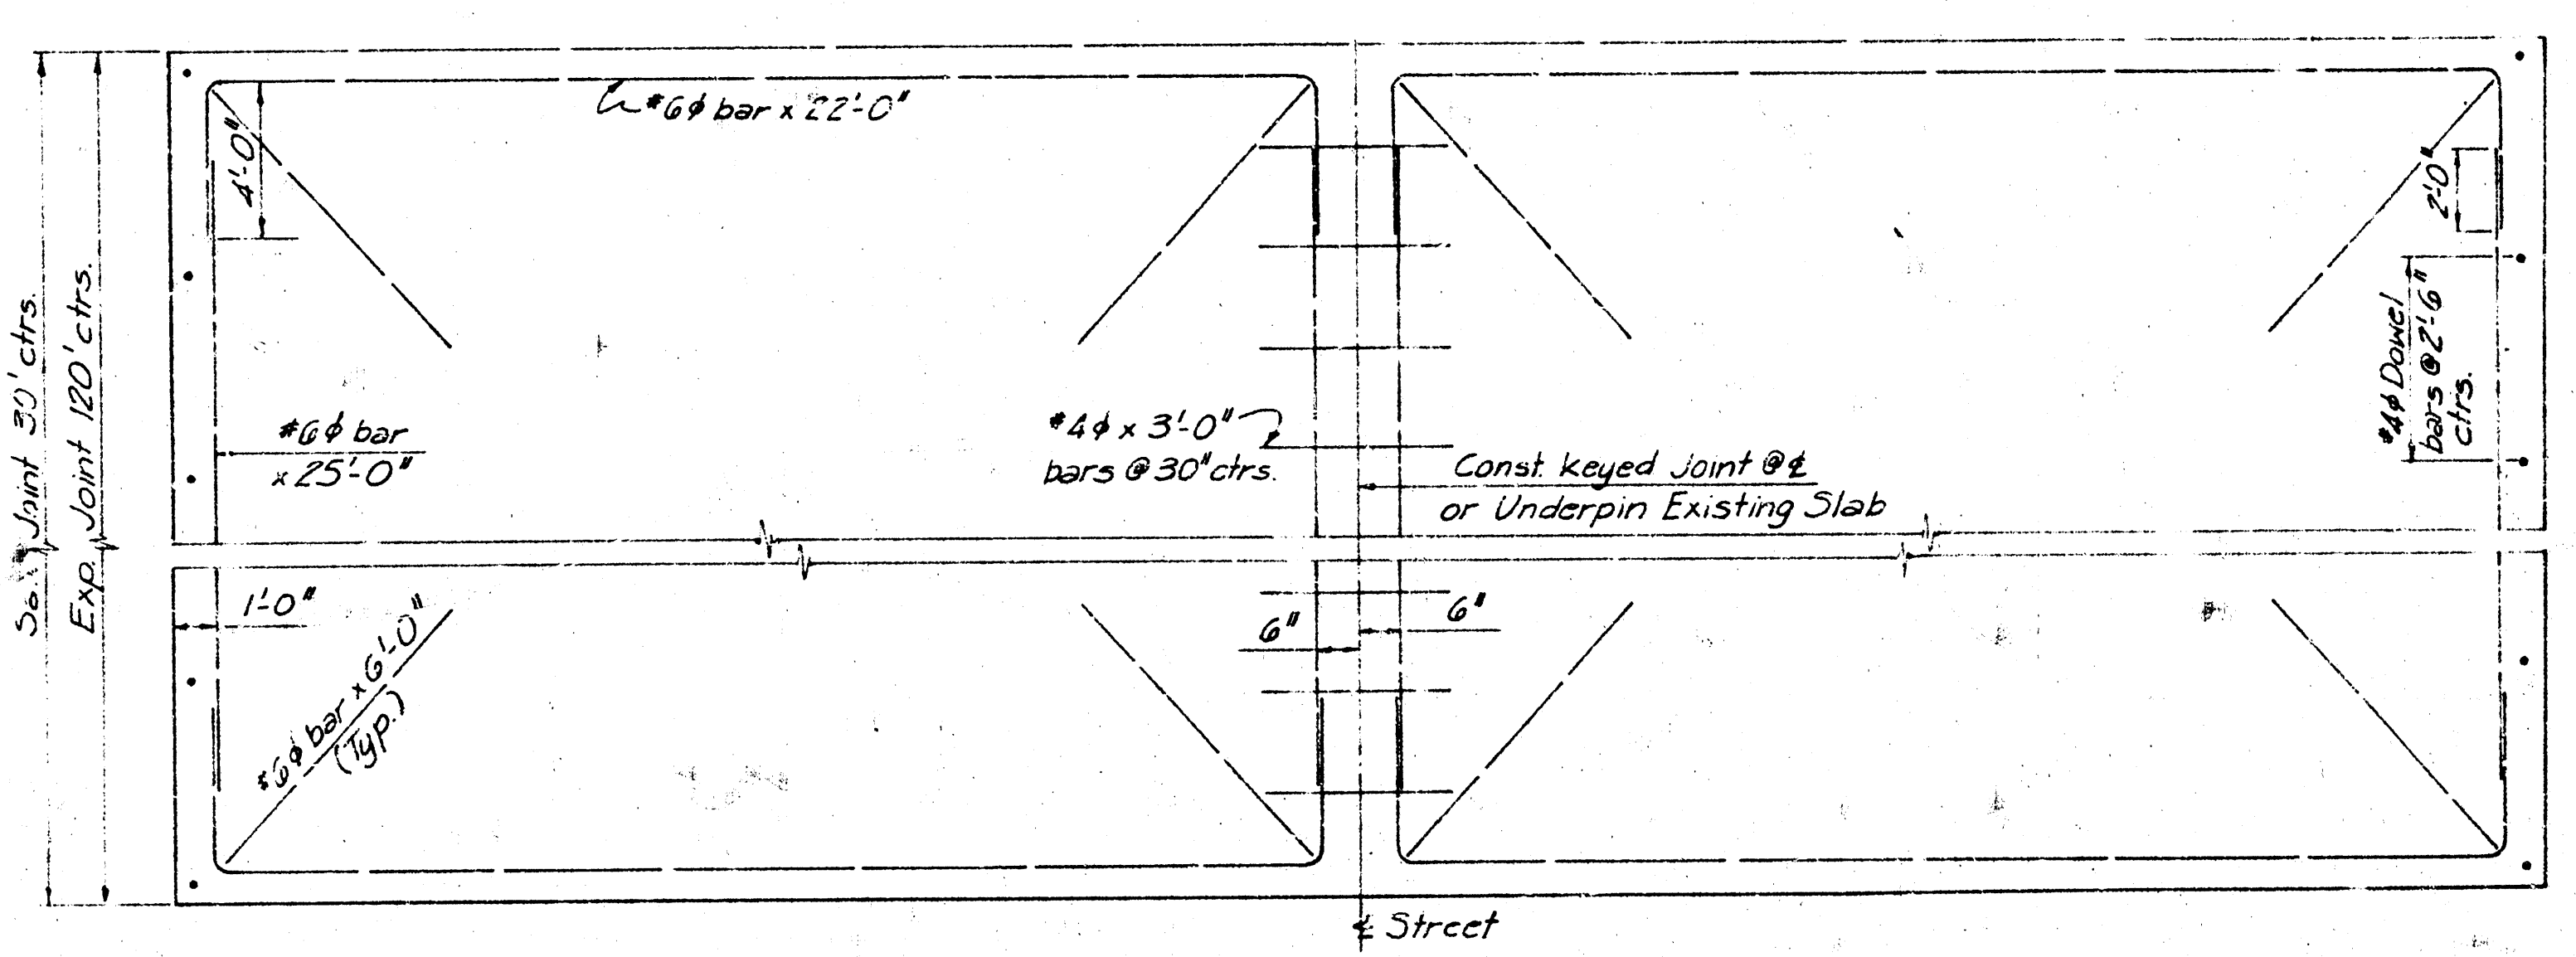


STEEL PATTERN

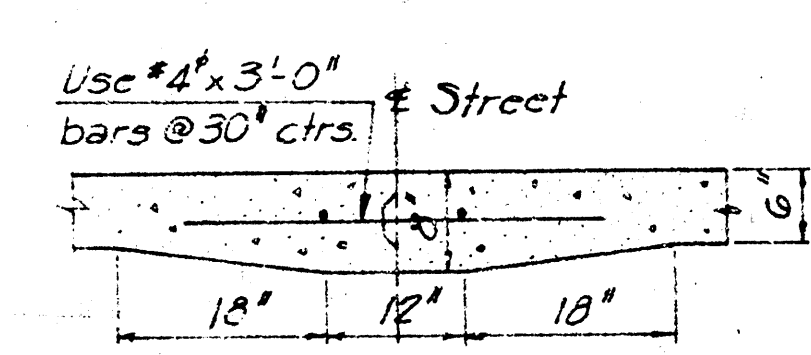


KEY JOINT DETAIL

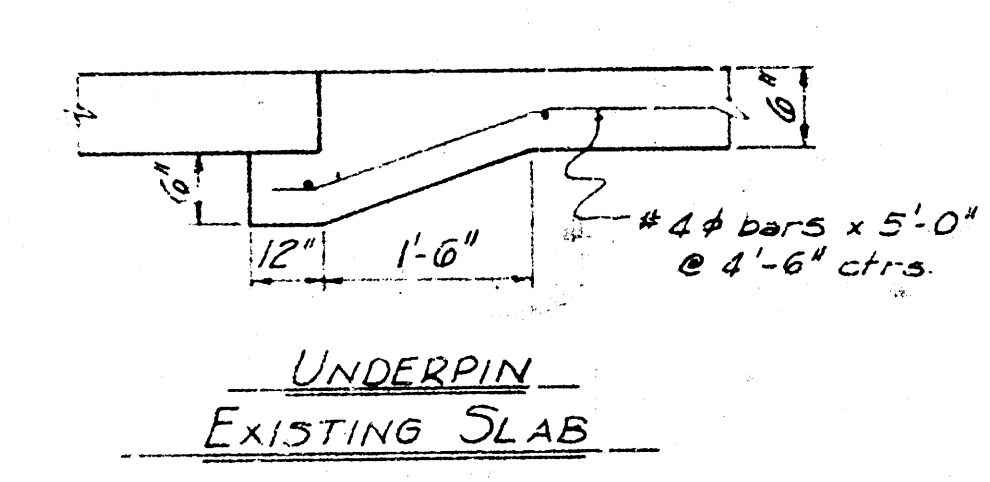


UNDERPIN EXISTING SLAB

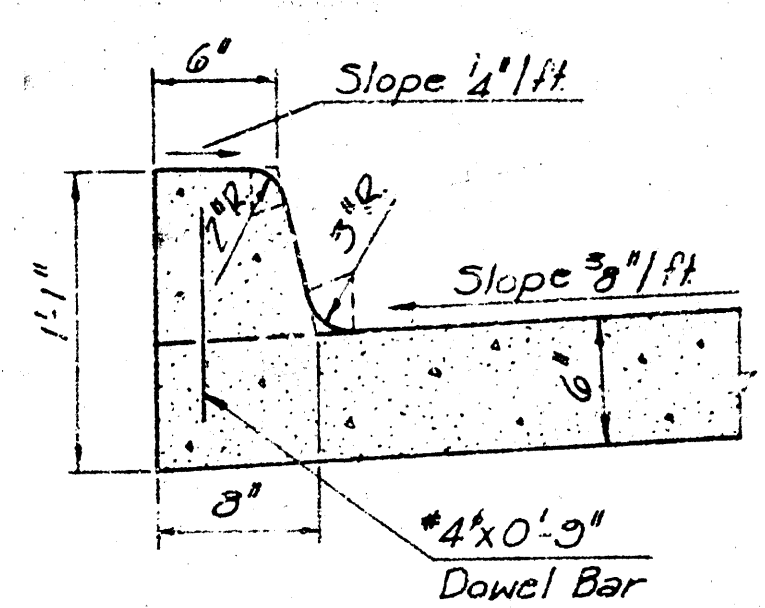


TYPICAL SECTION INTEGRAL CURB

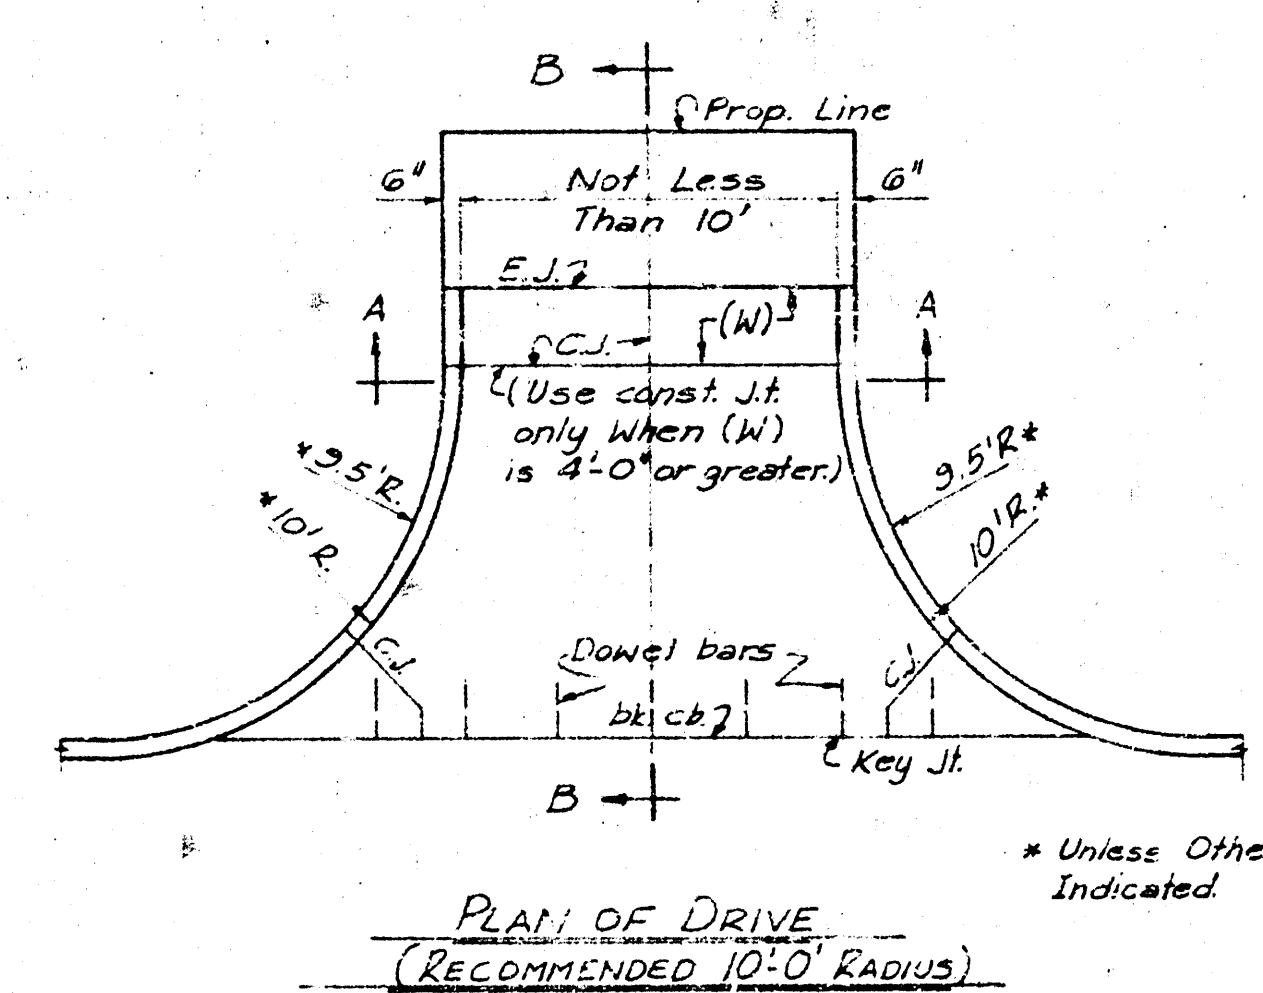


PLAN OF DRIVE (RECOMMENDED 10'-0" RADIUS)

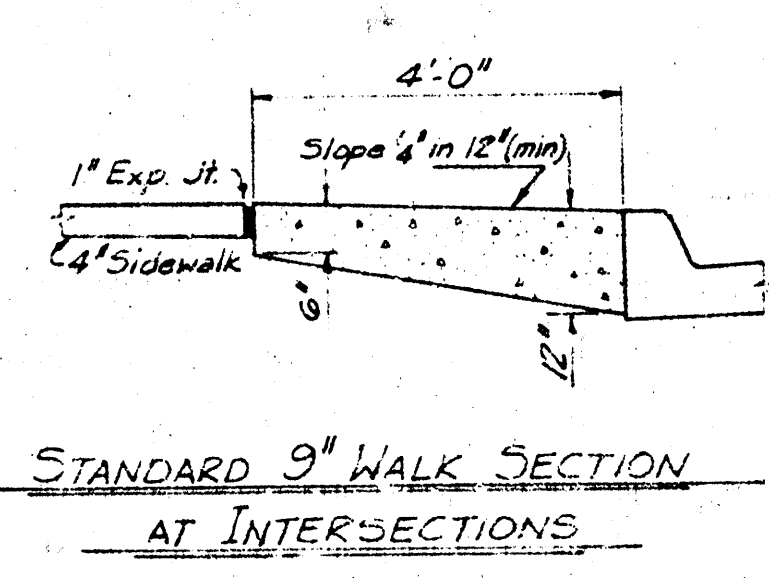


STANDARD 9" WALK SECTION AT INTERSECTIONS

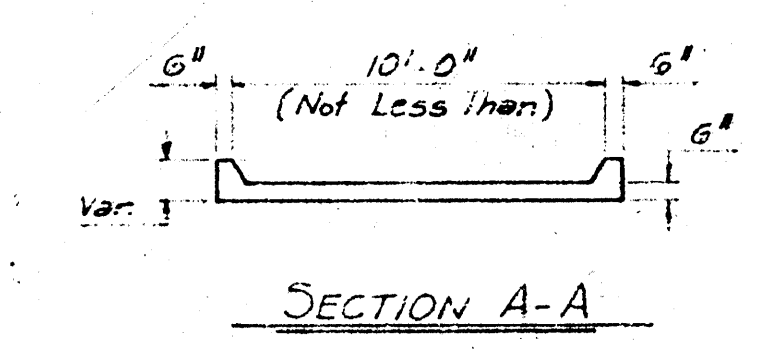

SECTION A-A

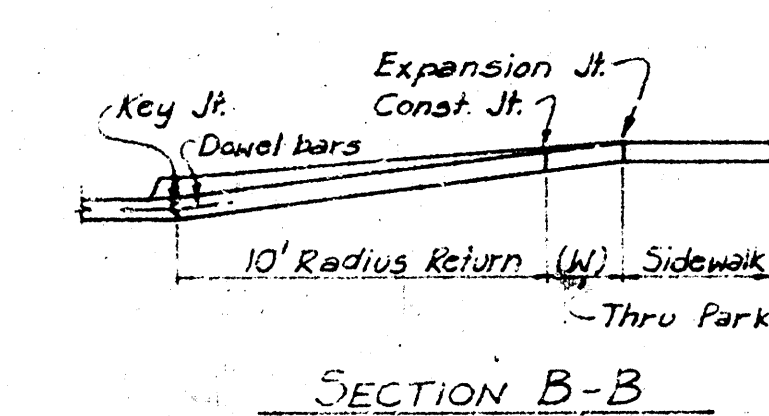


SECTION B-B

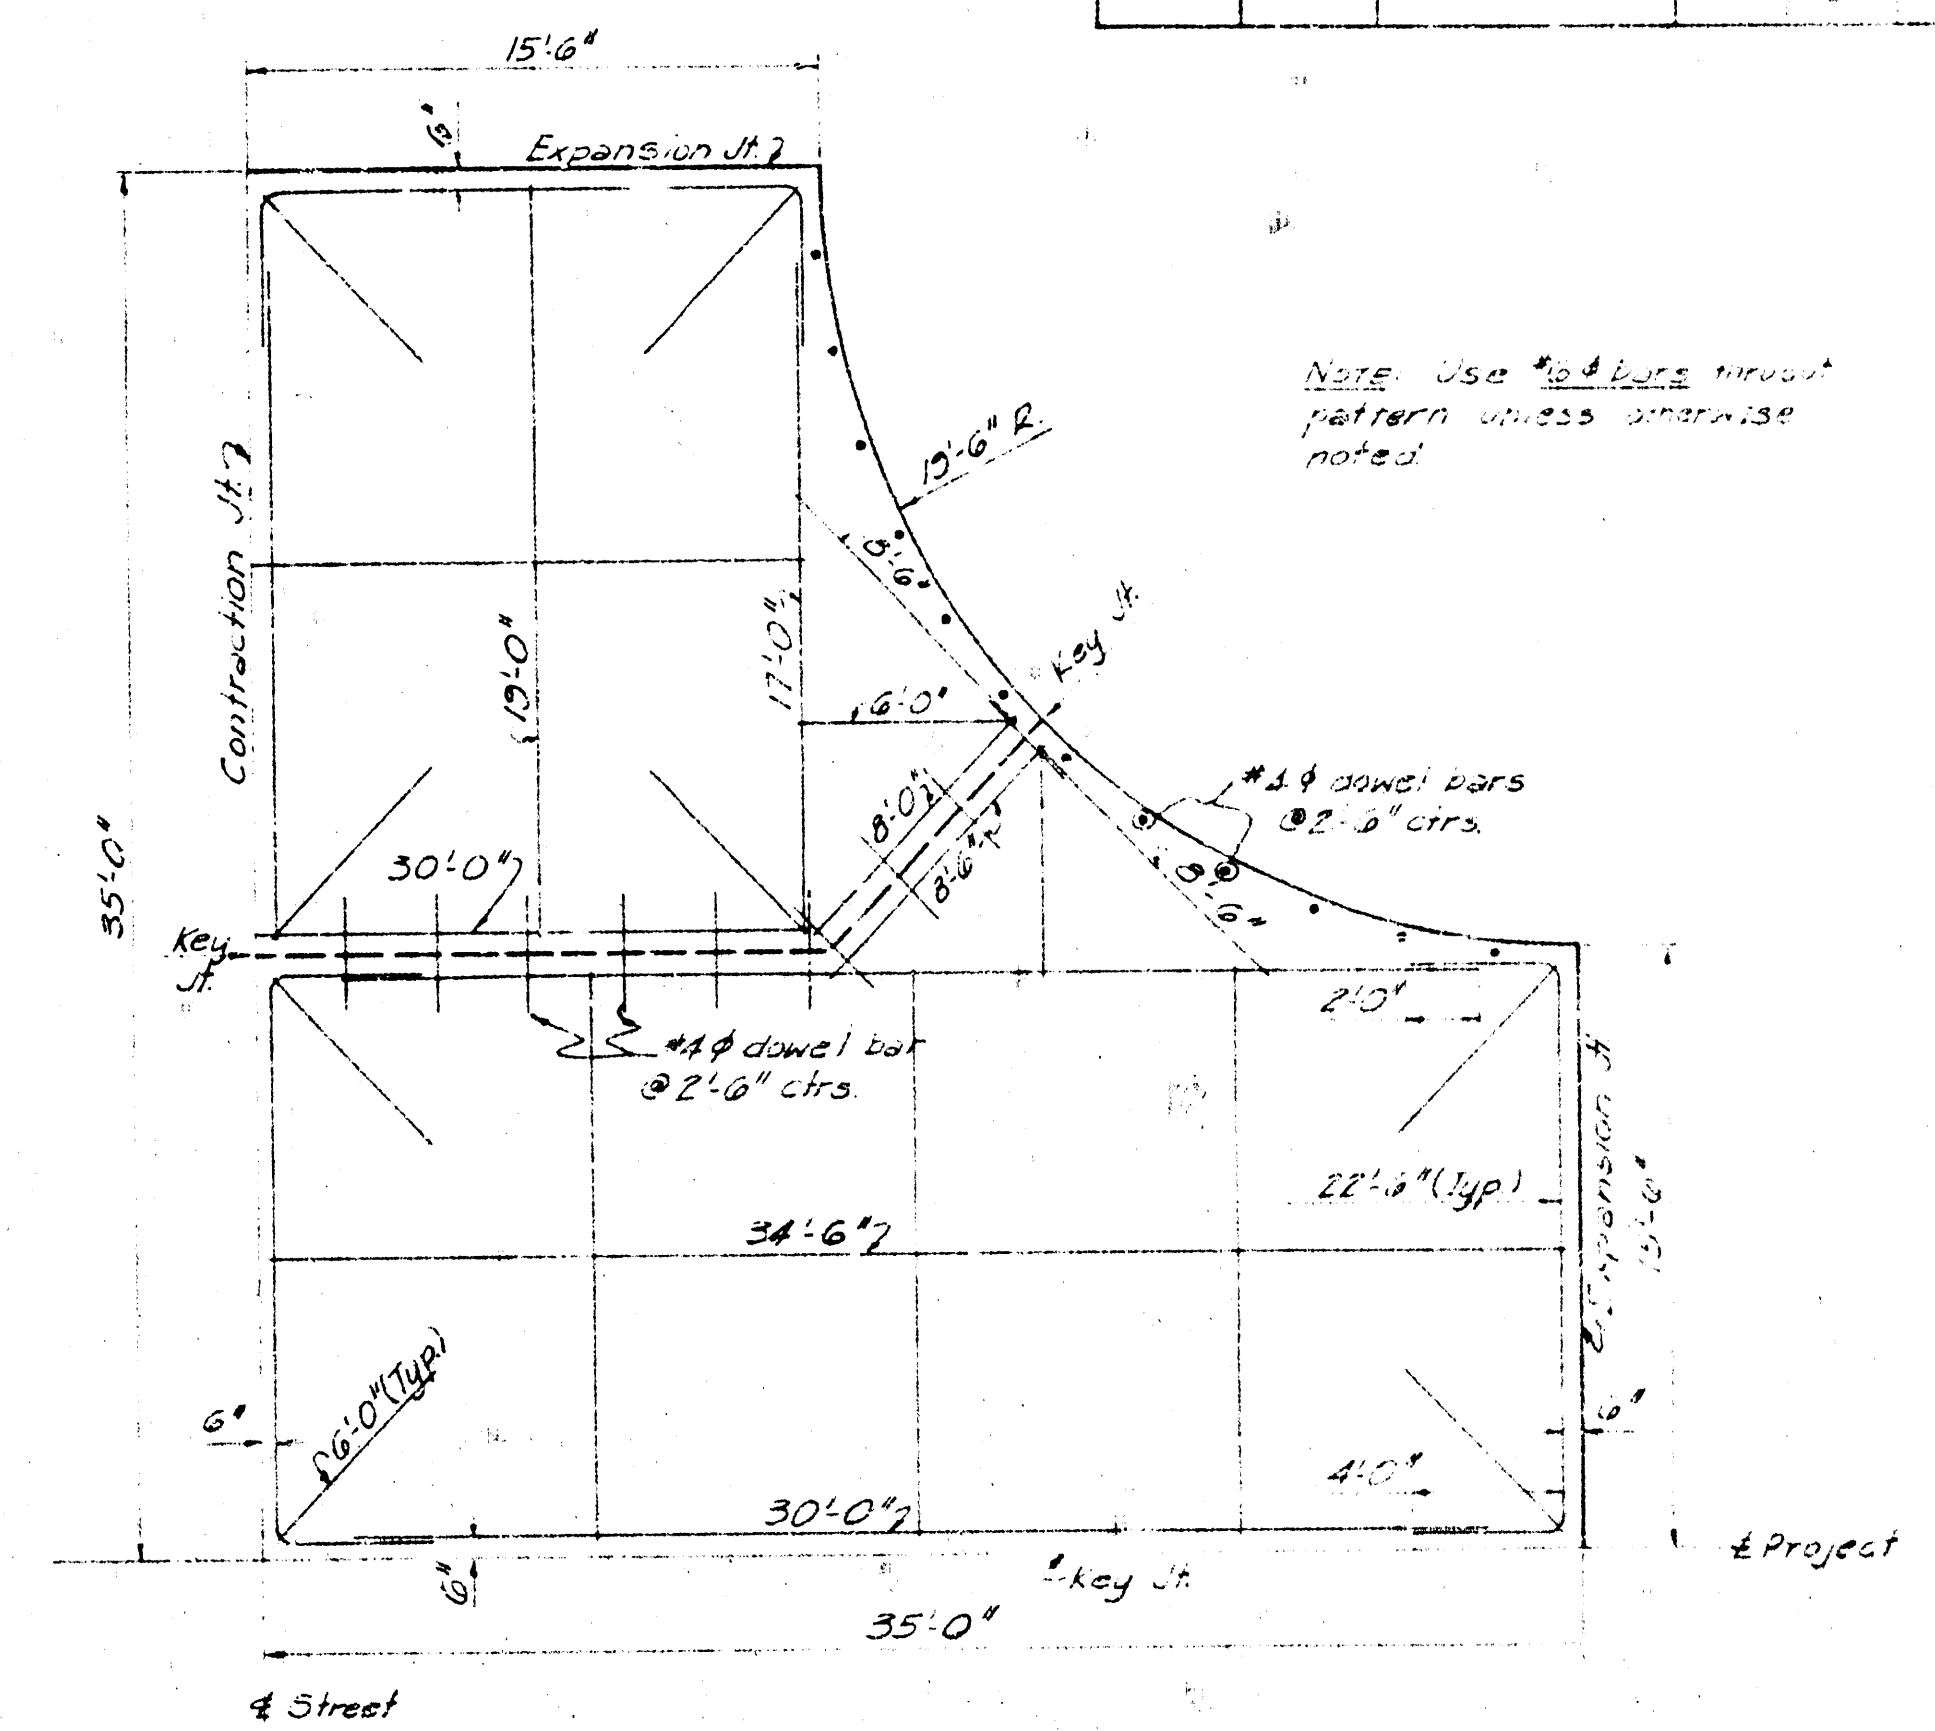

TYPICAL INTERSECTION DETAIL

TYP Sta 10+00 to 16+10

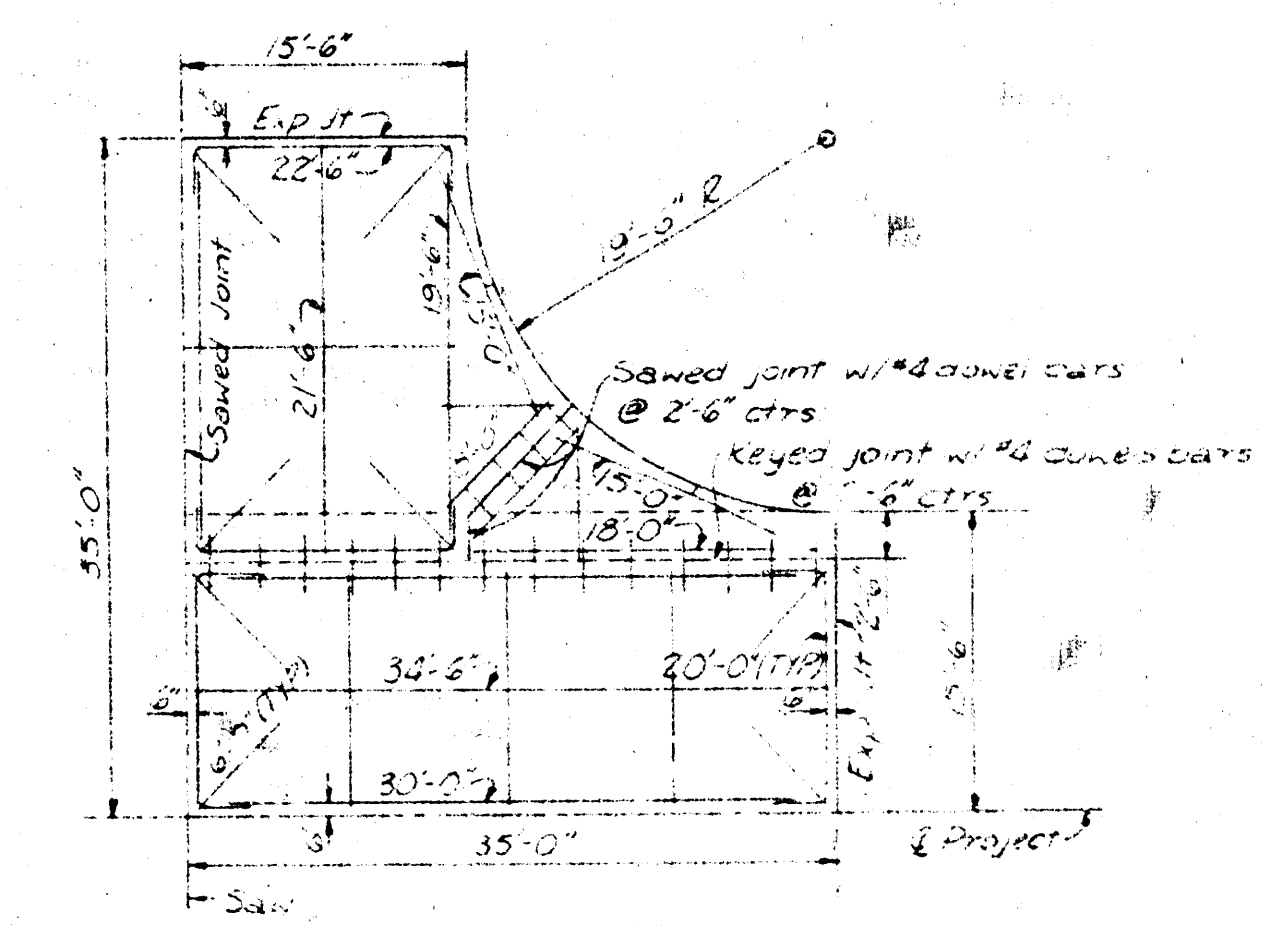


MODIFIED INTERSECTION DETAIL


TYP Lt Sta 22+29.31 & Sta 25+84.20 (As Built)

K.H. GALT As Built	
REV	BY
URBAN RENEWAL AGENCY	
KENNETH H. KITCHEN, EXECUTIVE DIRECTOR	
STREET IMPROVEMENTS	
EVERGREEN PARK	
PAVEMENT DETAILS	
R. S. DELAMATER	DATE FEBRUARY 1962
CONSULTING ENGINEER	SCALE
WICHITA, KANSAS	260-B-13

FED. ROAD DIV. NO.	STATE	PROJECT NO.	FISCAL YEAR	SHEET NO.
5	KANSAS		1971	4

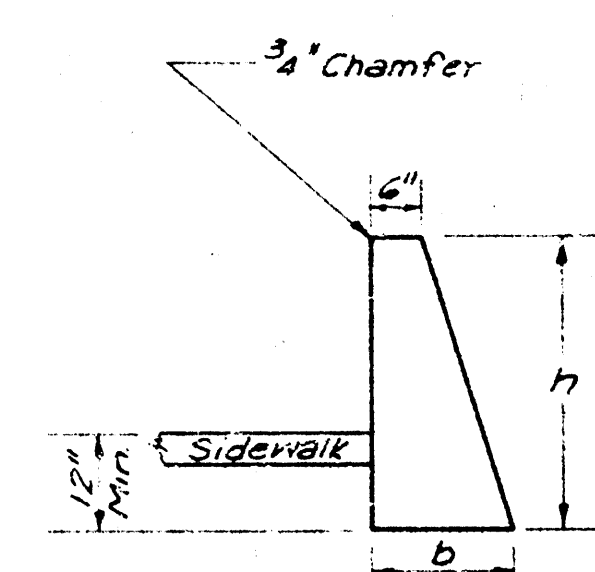

DIMENSIONS		Con./Ft. C.u. Yds.
h	b	
1'-9"	11"	.046
2'-0"	13"	.059
2'-3"	15"	.073
2'-6"	17"	.089
2'-9"	18½"	.104
3'-0"	20"	.120

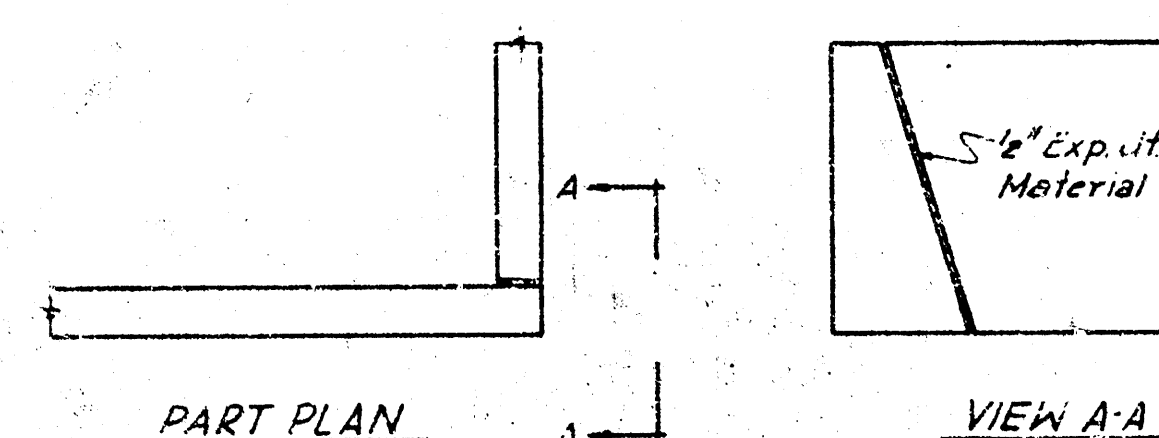


RETAINING WALL DETAILS
(Concrete)


CORNER DETAIL

NOTE Space cut joints thru wall at approximately 20', and as indicated at right.


Chamfer all exposed edges and corners with 3/4" triangular molding

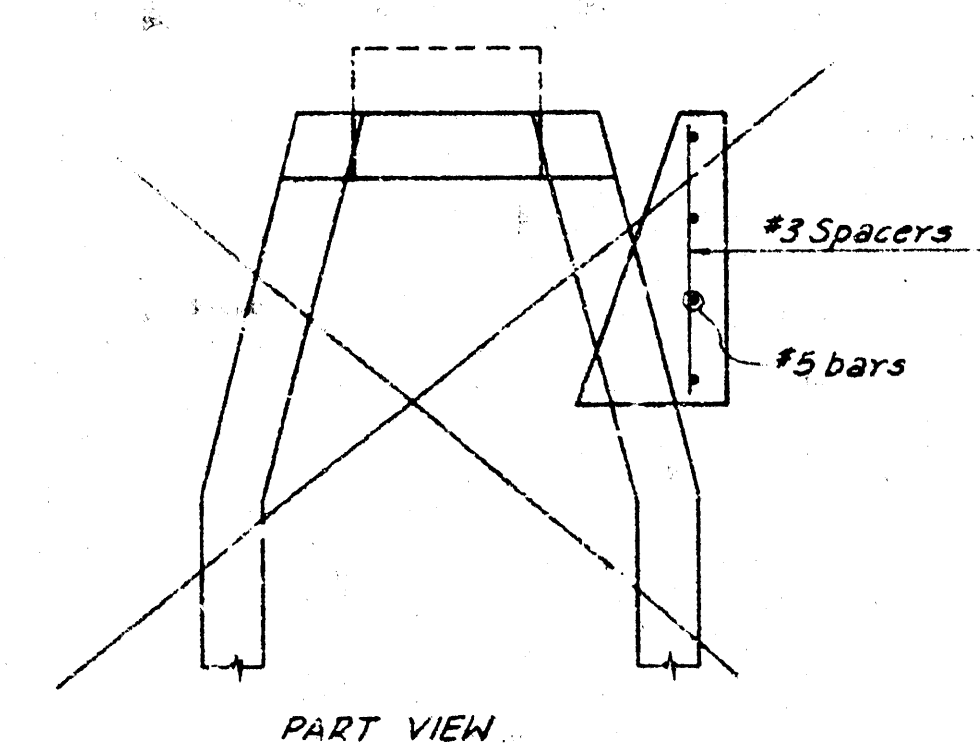


PART VIEW

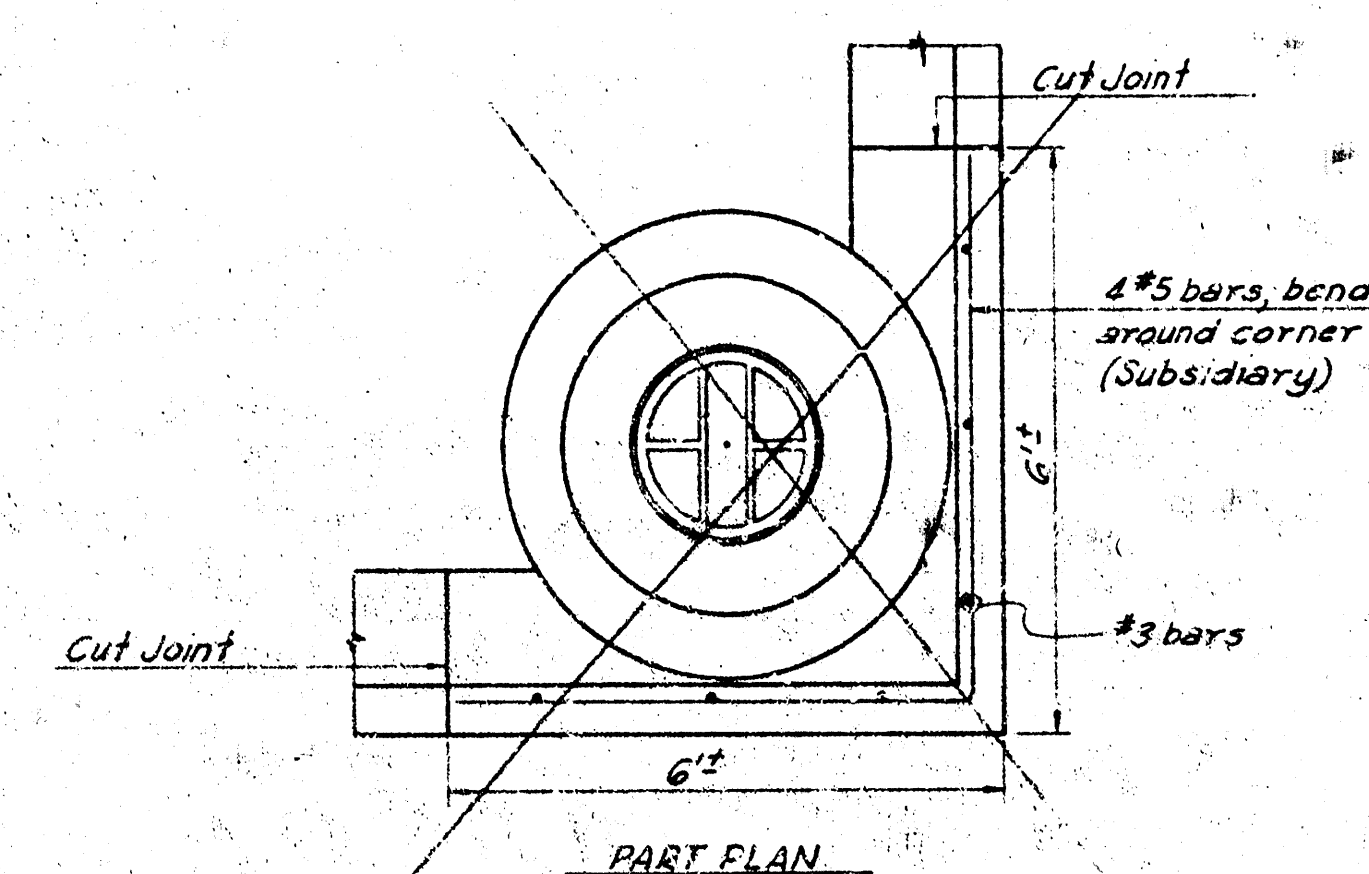


SPECIAL DETAIL AT MANHOLE
STA 13+68

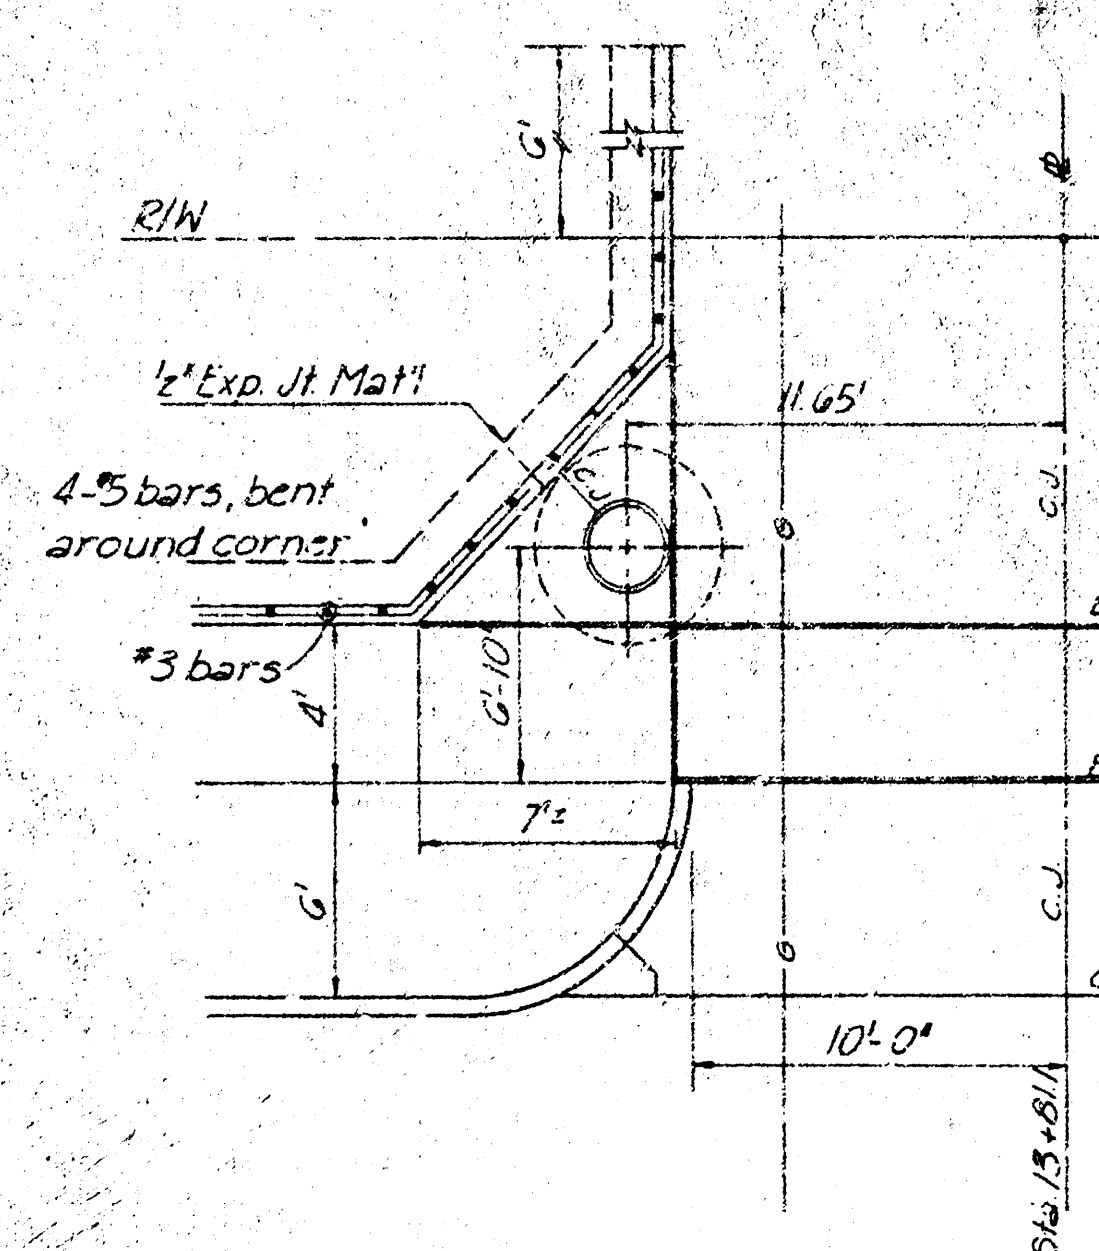

SPECIAL DETAIL AT
MANHOLE STA 13+60.45
(As Built)

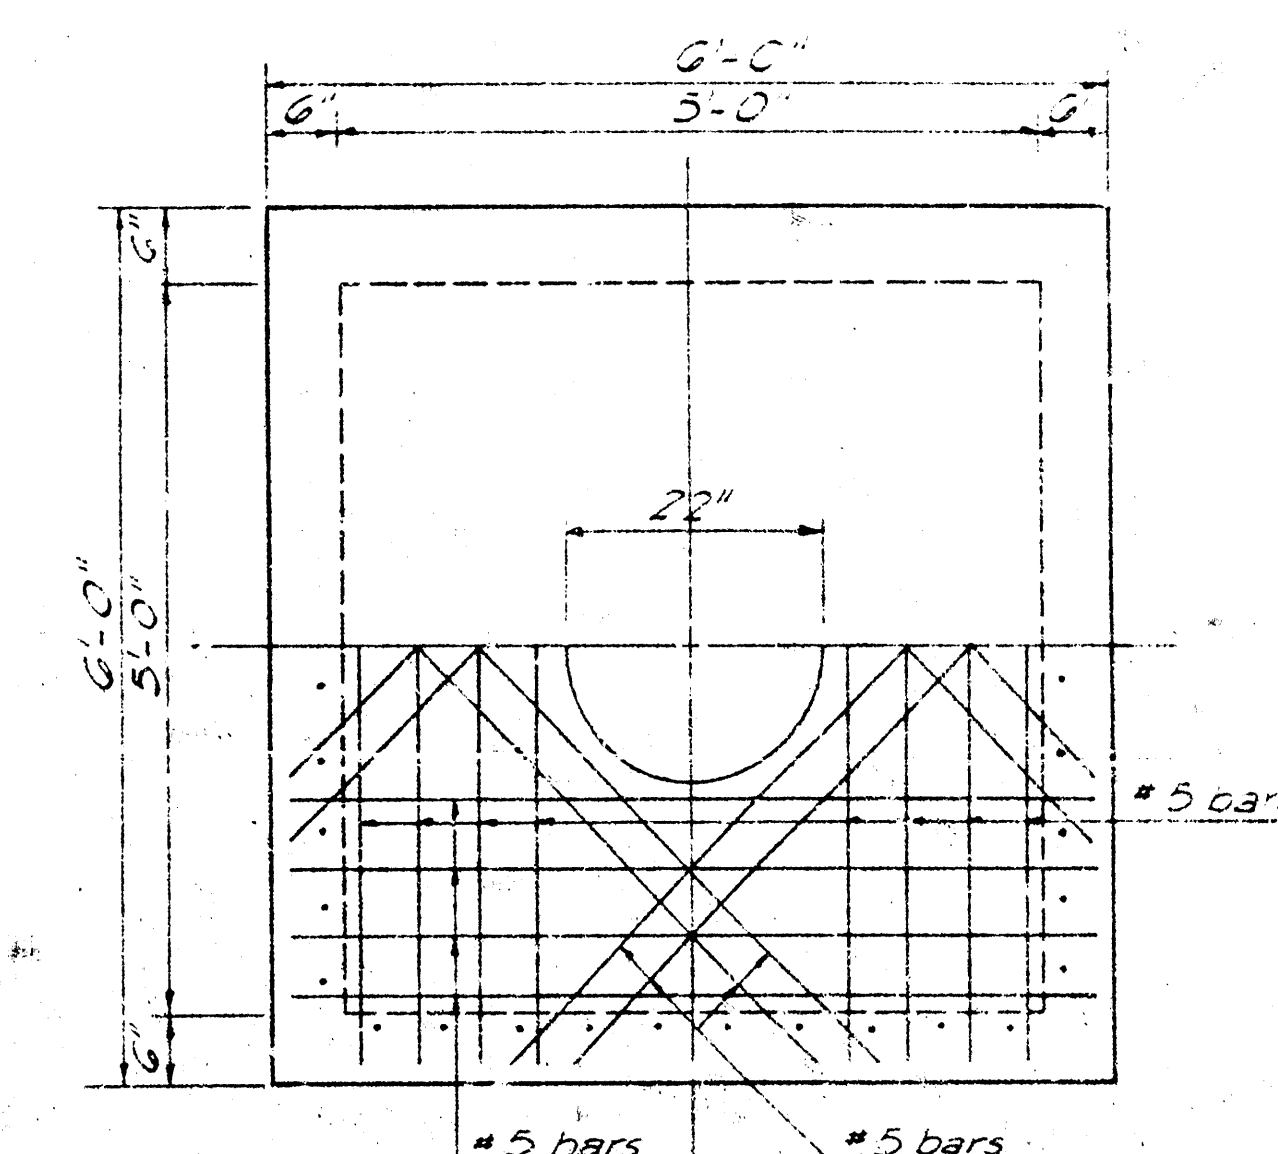


DIANA

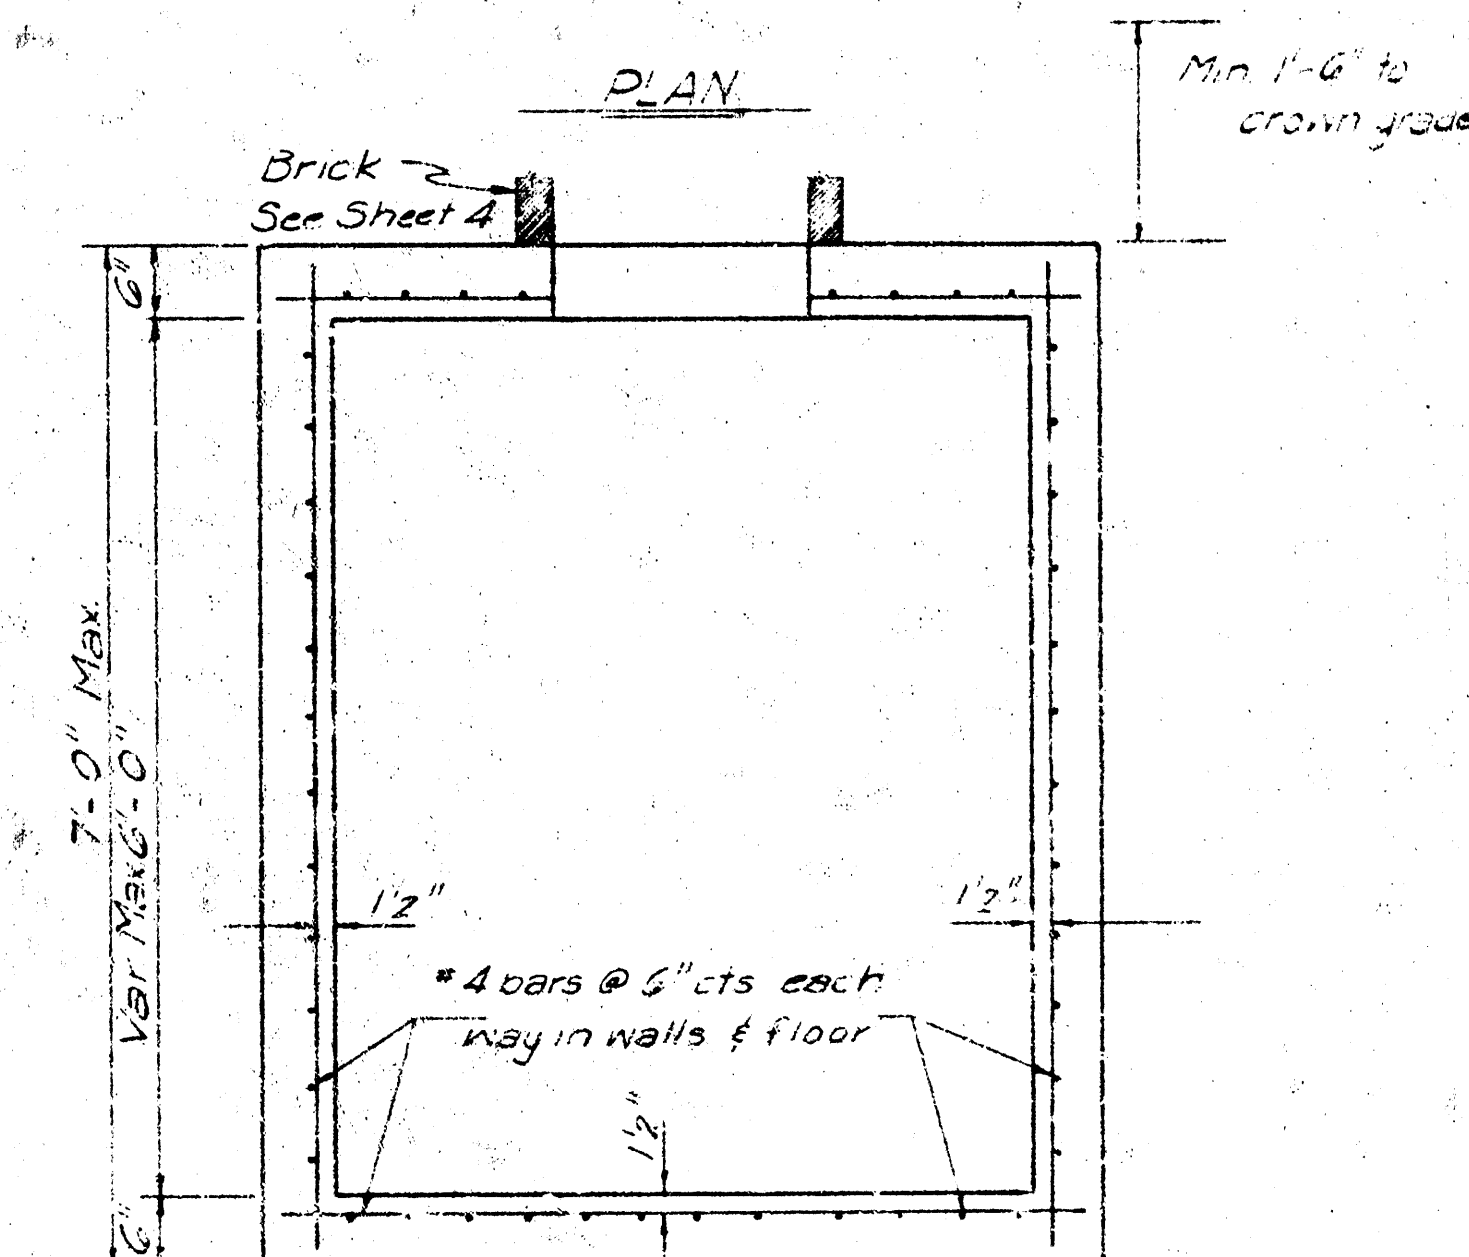


SECTION


5' CONCRETE MANHOLE

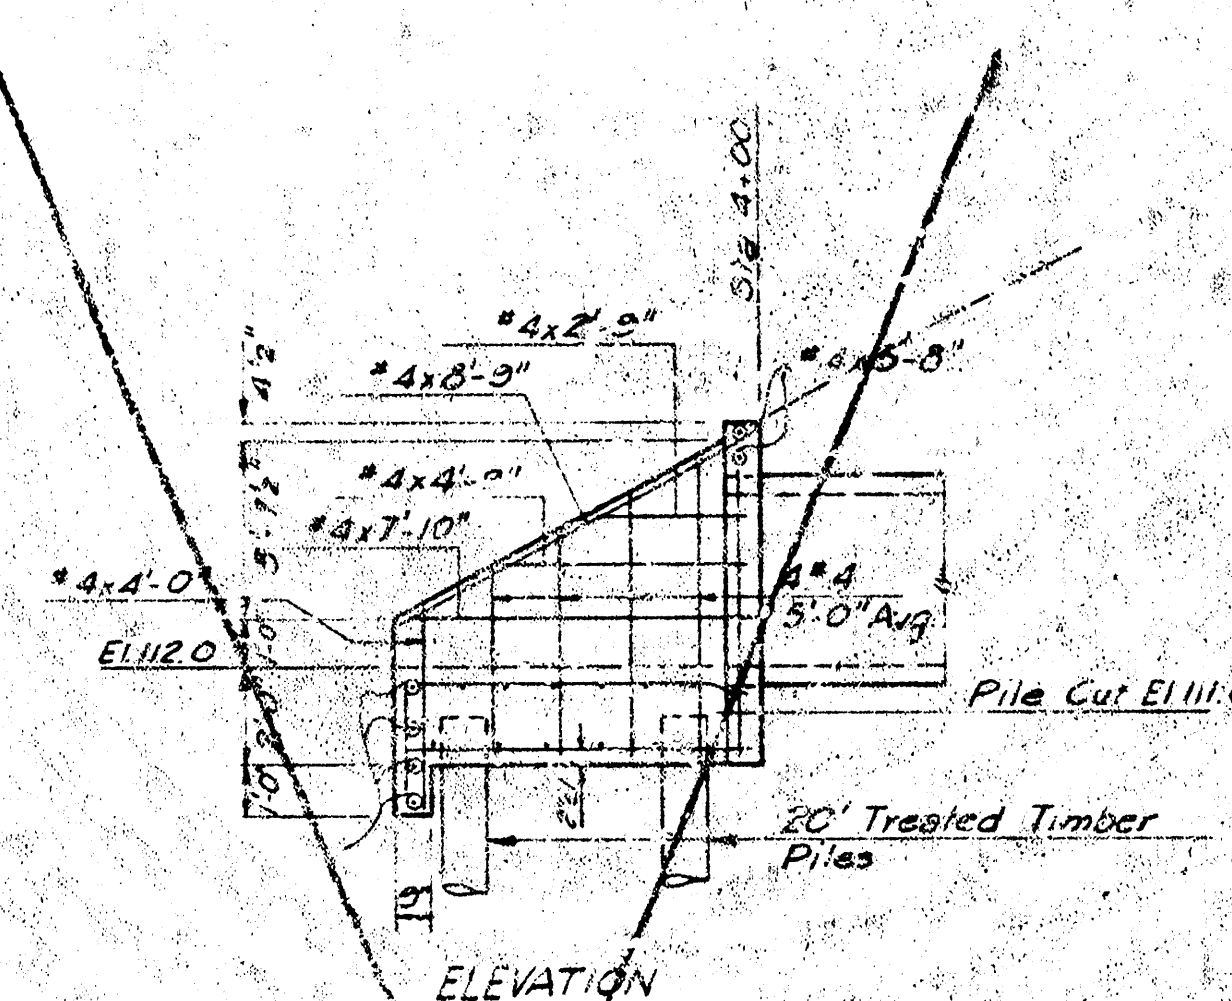

ELEVATION

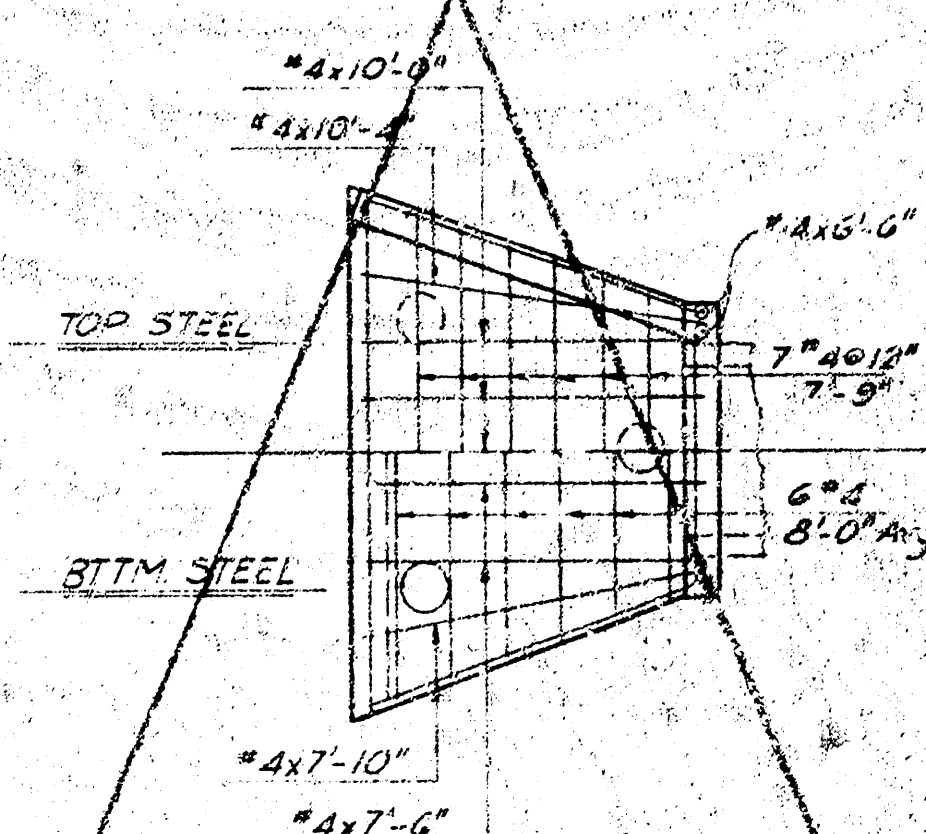

PLAN SHOWING REINFORCING

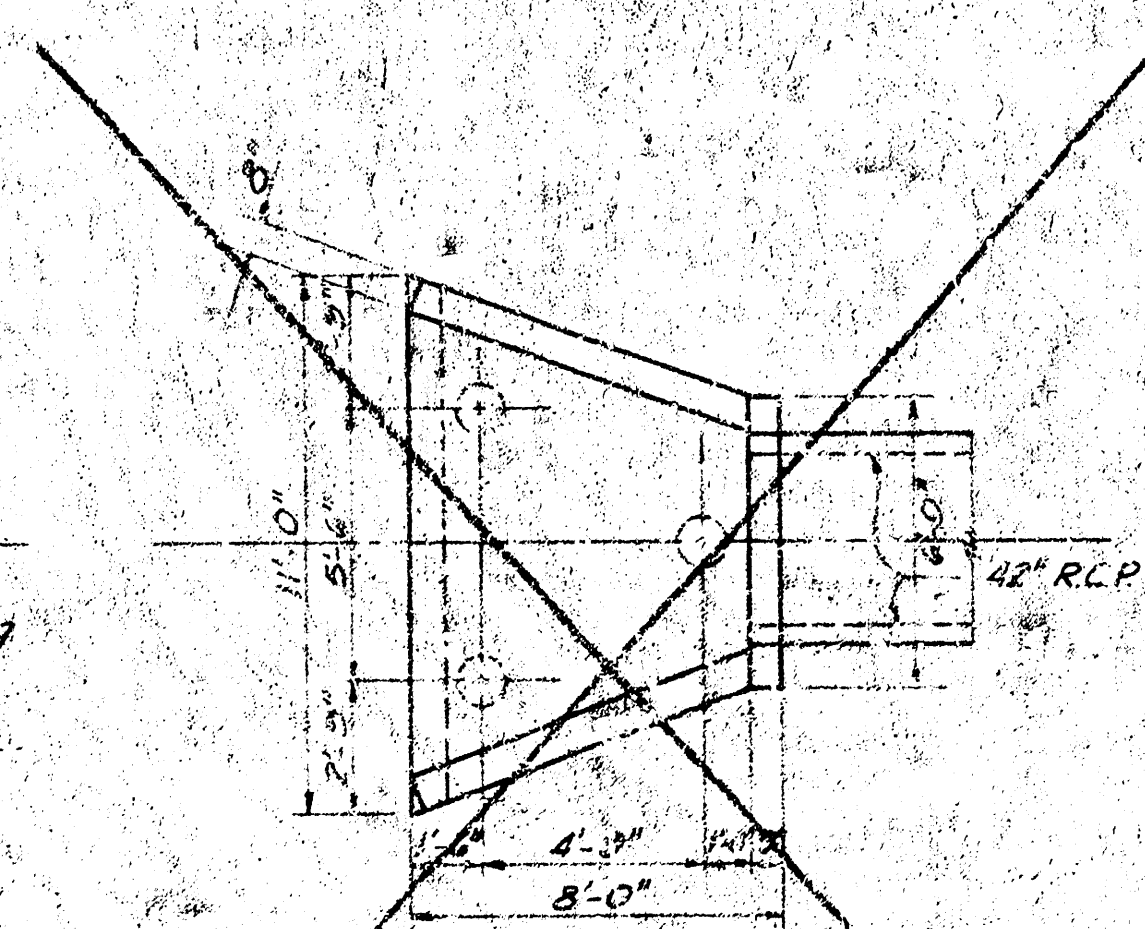

PLAN

Note: Chamfer all exposed edges with a $\frac{3}{4}$ " triangular molding.

K H 17473 As Built	
K H	17473
DATE	Aug 1966 N.Y.C.
BY	DESCRIPTION
URBAN RENEWAL AGENCY	
KENNETH H. KITCHEN , EXECUTIVE DIRECTOR	
STREET IMPROVEMENTS	
EVERGREEN PARK	
AUXILIARY DETAILS	
R. S. DELAMATER	
CONSULTING ENGINEER	
WICHITA, KANSAS	
DATE	February 1967
SCALE	ONE IN. = 260'-0"