


B.M. 12478 R.P. Spike N.E. Side H.L.P. S.W. 17th & Edwards
 B.M. 12711 S.E. Cor. Conc. Porch Ho. # 1851 N. Edwards

Scale: 1" = 20'

MEADOWVALE

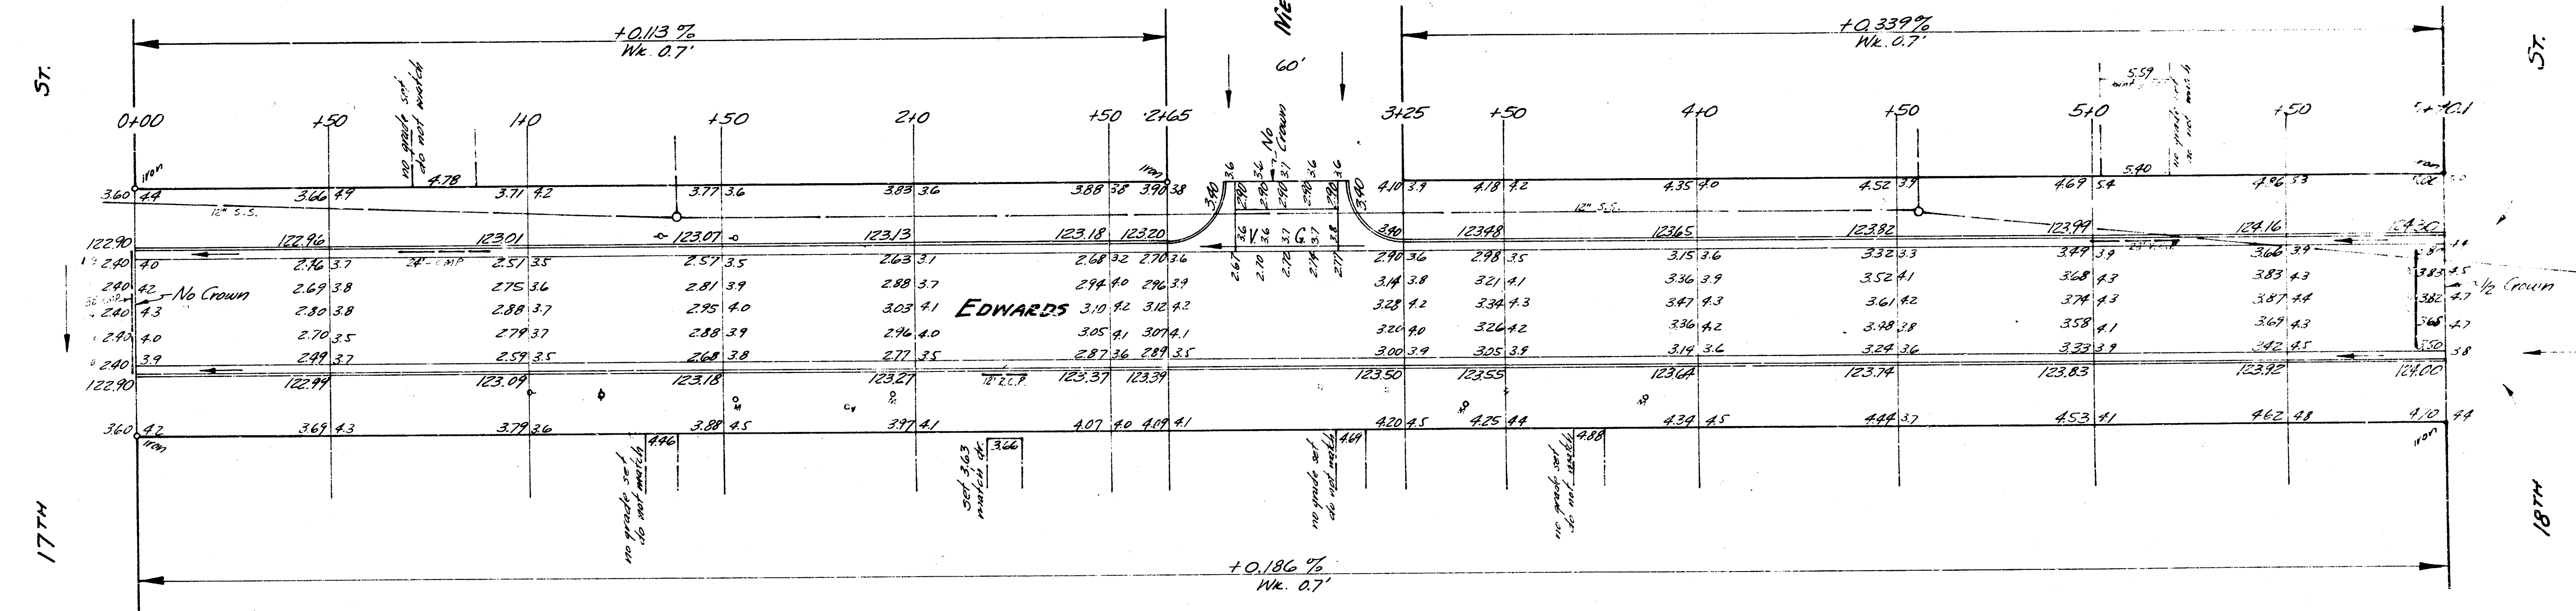

EDWARDS