


PAWNEE AVENUE BRIDGE

OVER

GYPSUM CREEK

WICHITA, KANSAS

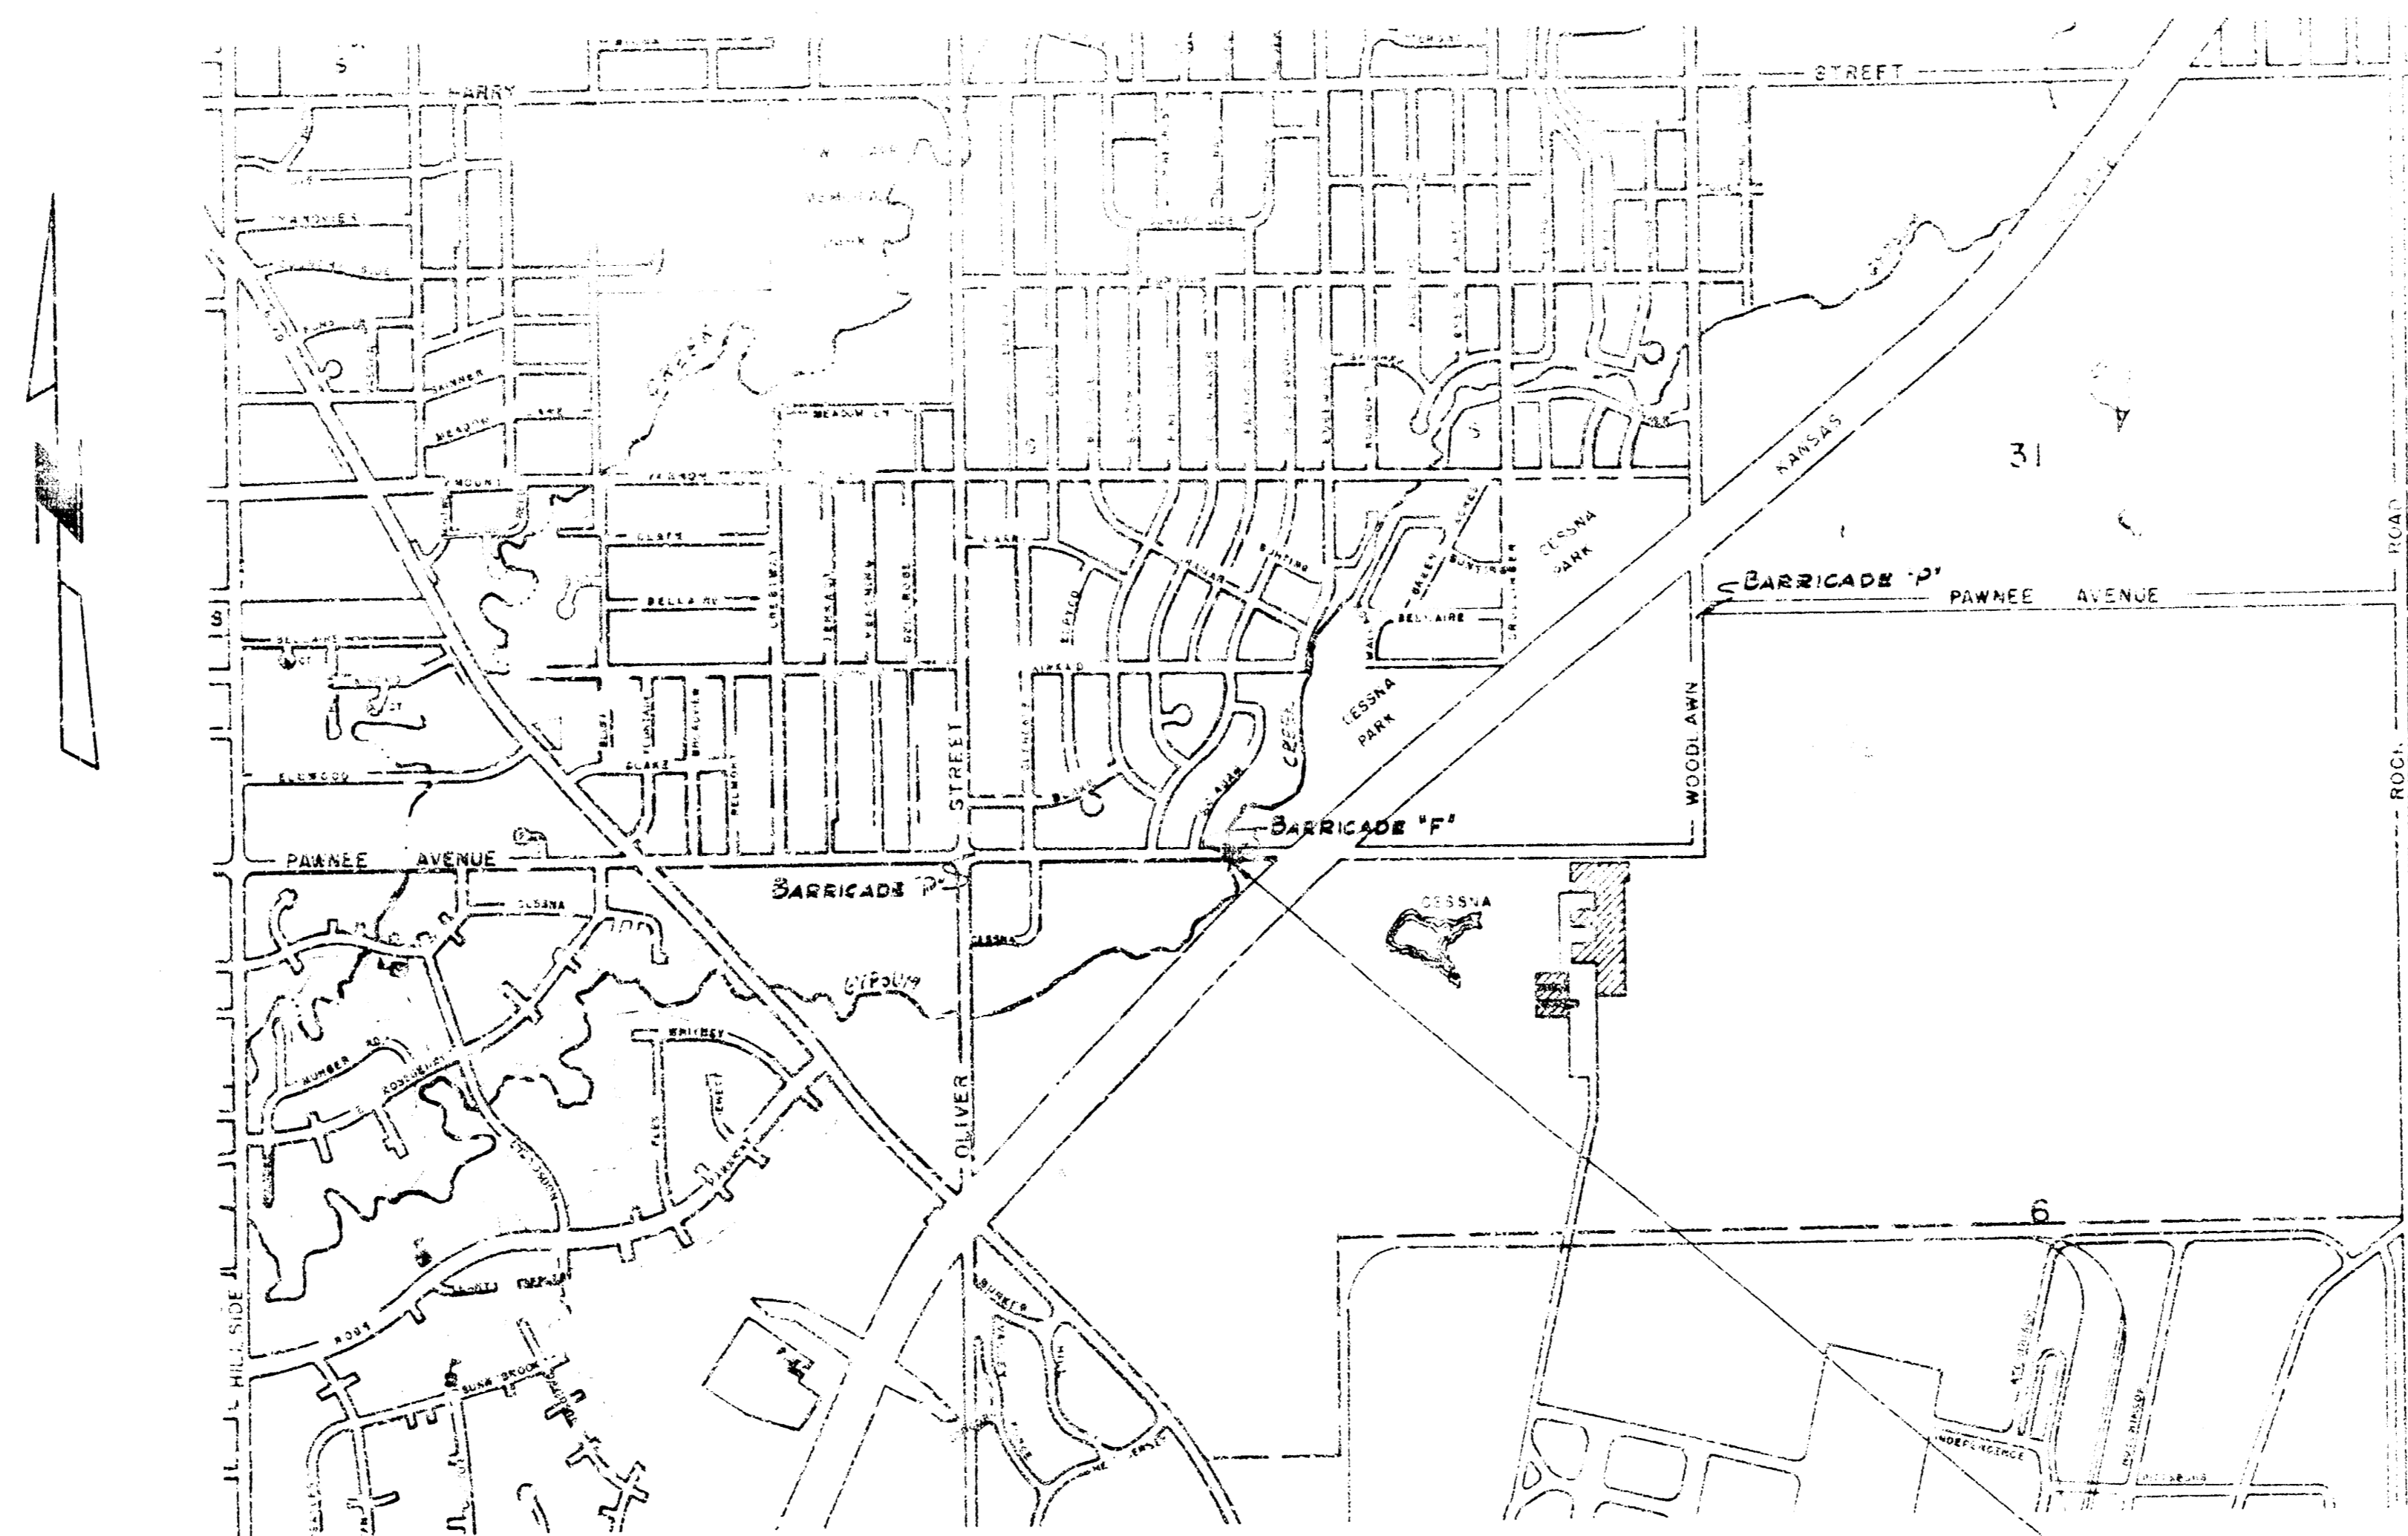

INDEX OF SHEETS.

- Sheet No. 1. Title Sheet
- " 2. Contour Map
- " 3. Construction Layout
- " 4. Abutment Details
- " 5. Pier Details
- " 6. Prestressed Beam Details
- " 7. Superstructure Details
- " 8. Standard File Details
- " 9. Box Supports, Bridge Excavation, Handrail Details & Summary of Quantities

DEPARTMENT OF PUBLIC WORKS


CITY OF WICHITA

B. E. SMITH, CITY ENGINEER

PROJECT C15-47

PLANS PREPARED BY
N. S. DELAMATER, CONSULTING ENGINEER
WICHITA, KANSAS
AUGUST, 1969

PROJECT LOCATION

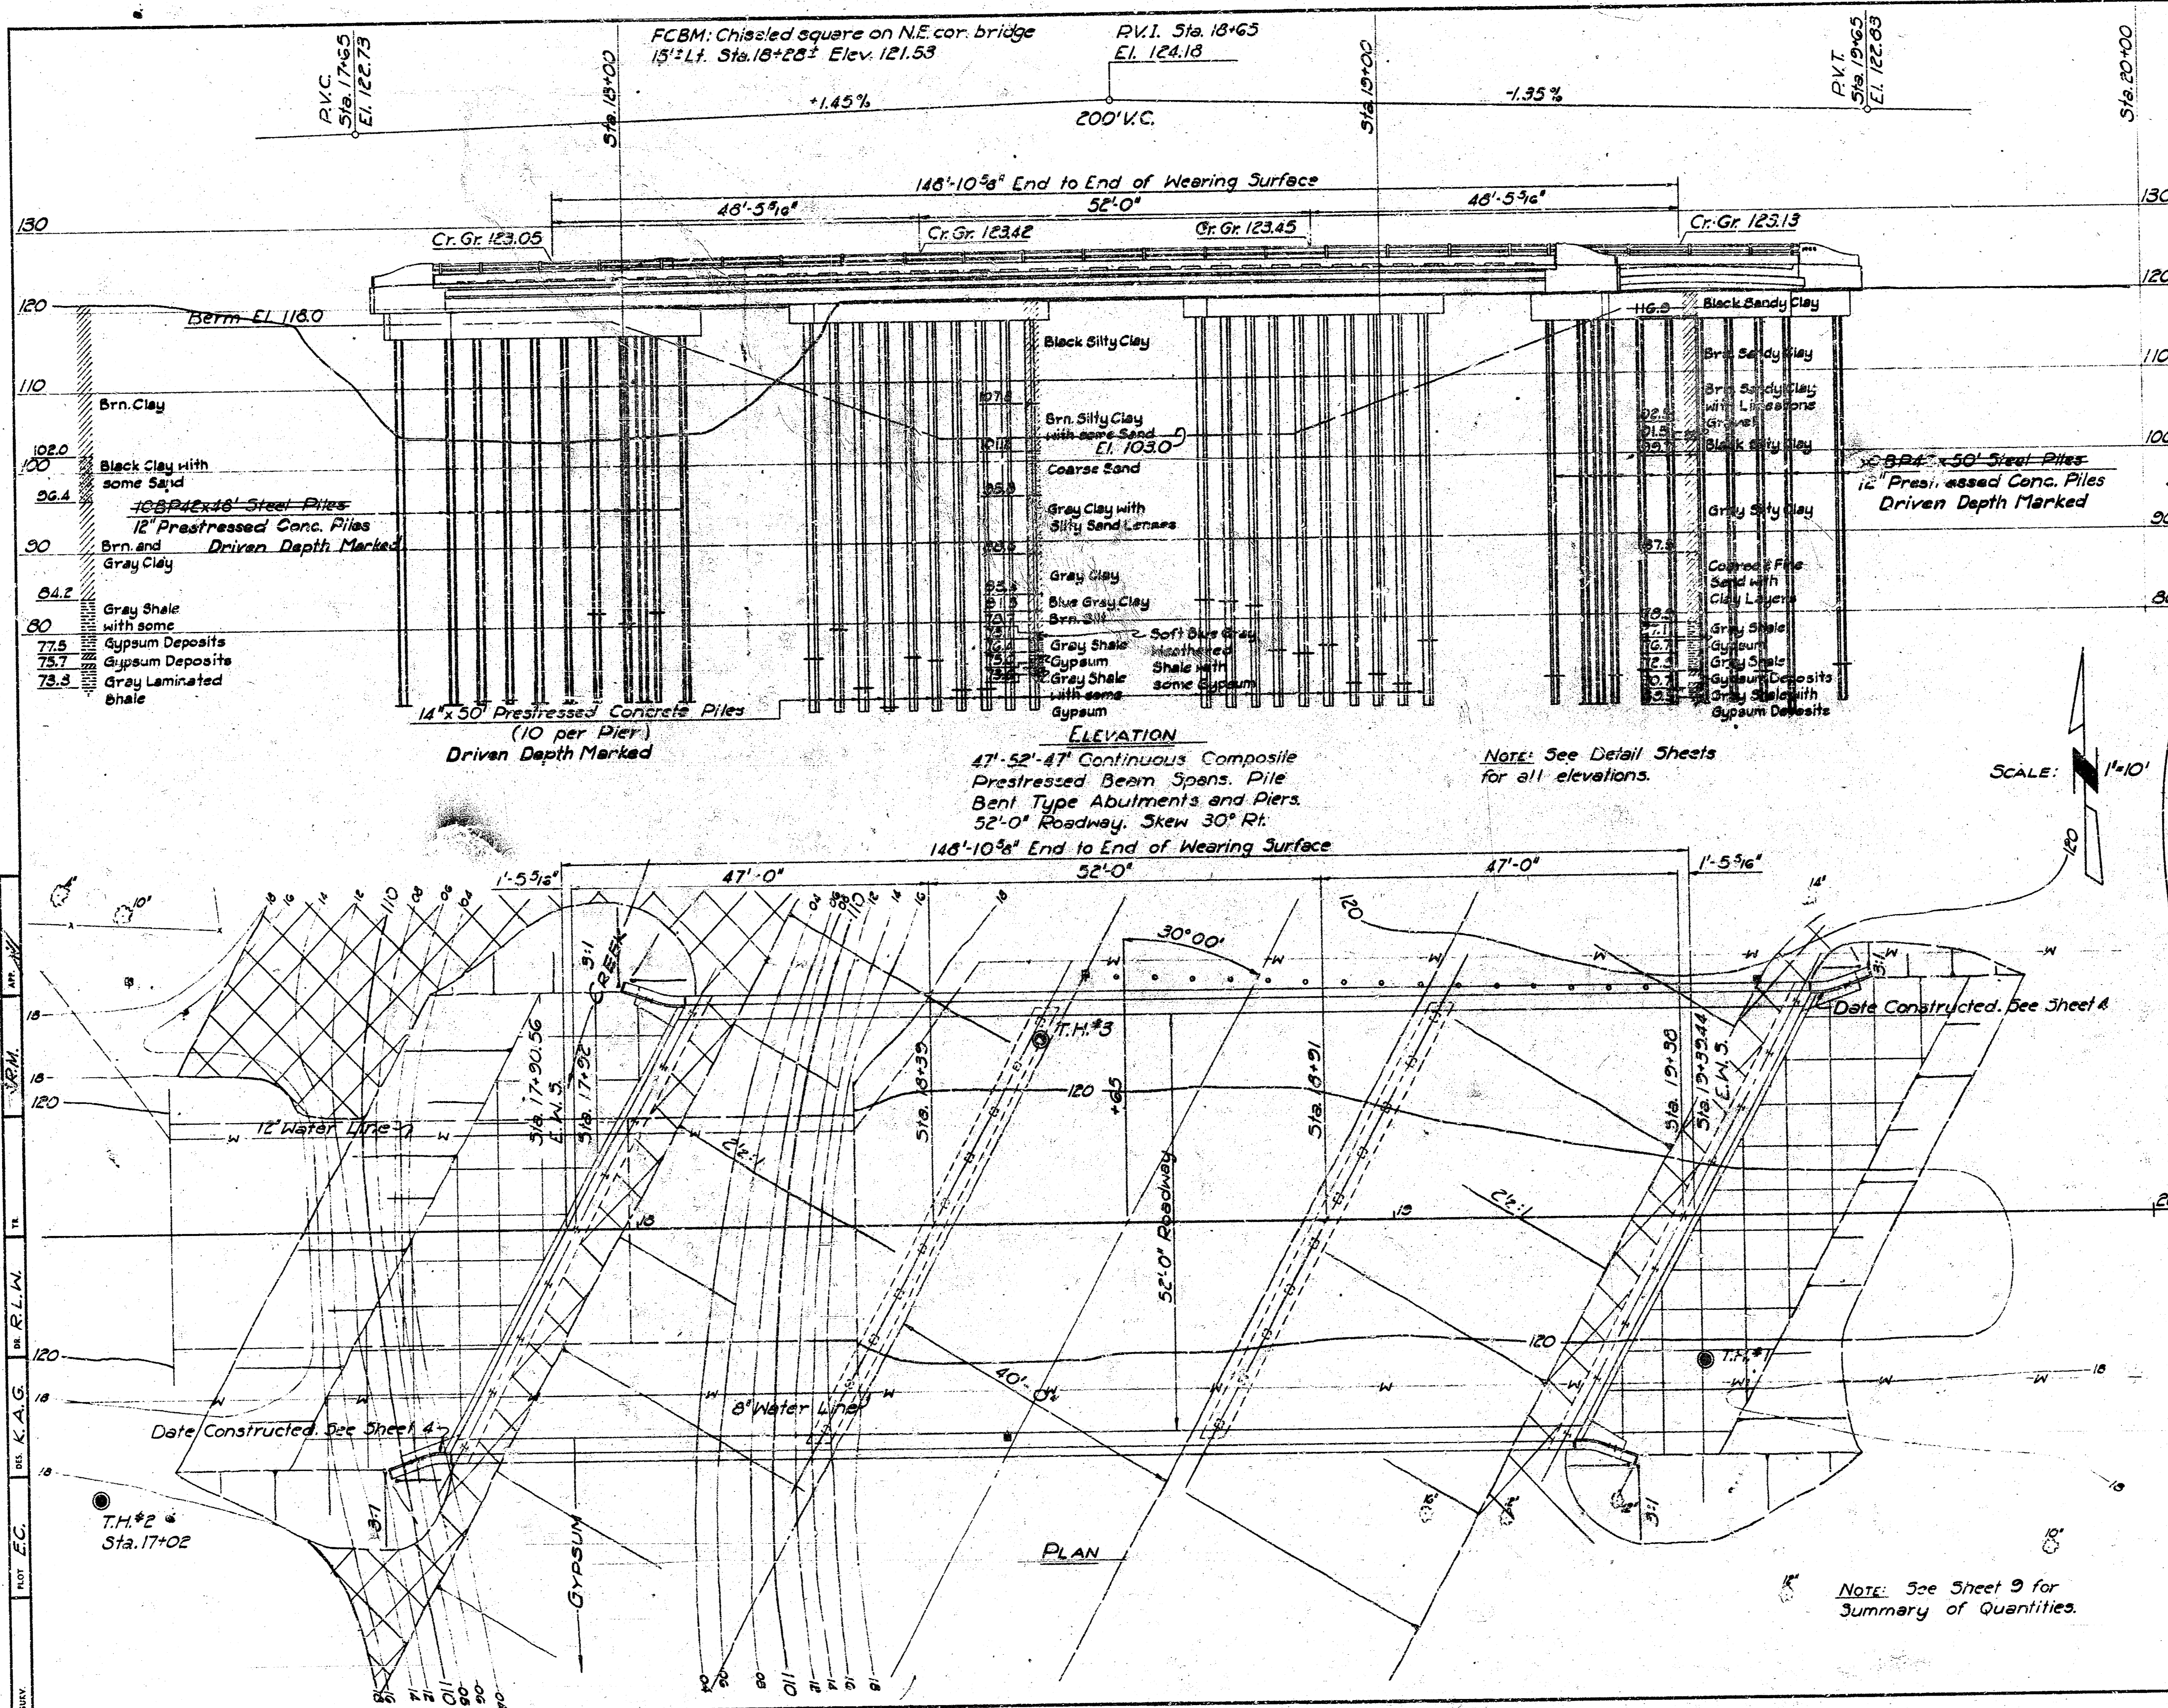

PUB. ROAD DIV. NO.	STATE	PROJECT NO.	FISCAL YEAR	SHEET NO.	TOTAL SHEETS
5	KANSAS	C15-47	1965	3	9

GENERAL NOTES

EXISTING STRUCTURE: The Contractor shall remove the existing structure.

COMPACTED EMBANKMENTS: The Contractor shall construct the embankments and the berms at the abutments as shown on this sheet and the Contour Map prior to construction of the bridge.

BRIDGE EXCAVATION: All bridge excavation shall be Class III. See Sheet 9 for limits of pay excavation.

SOUNDINGS: Sounding information shown on this sheet is as obtained from borings made in the field and represents the best information available to the City of Wichita.

PILES: Piles shall be 14" prestressed concrete in piers and 10" steel piles in abutments, or alternate, as described and detailed on Sheet 9. Piles shall be driven to the penetration shown unless in the opinion of the Engineer such penetration cannot be secured without injury to the pile. All piles shall be driven to a minimum computed bearing value of 35 tons per pile in abutments, 45 tons per pile in piers.

PILE DRIVING: All piles shall be driven with a steam or diesel hammer, if a diesel hammer is used, sufficient hammer data shall be provided to permit rating by the Engineer before driving starts.

CONCRETE: Class AA(E) concrete shall be used in abutments and piers, except for prestressed piles. Class AA(E) concrete shall be used in the superstructure, including coles and diaphragms, except for prestressed beams. Bevel all exposed edges with a 3/4" triangular roofing and fillet all corners 3/4" unless otherwise noted.

REINFORCING STEEL: All dimensions relative to reinforcing steel placement are to centerline of bars unless otherwise noted. All dimensions shown in bending diagrams are out to out of bars.

WATER LINES: Concrete inserts for pipe hangers are to be furnished by the owner of water lines (McCannell 17", Casana 8", City's proposed 12" for installation by the Bridge Contractor.

DESIGN:
 Design Loading: M20-S16-44 A.A.S.H.O. Specifications (1961 Ed.)
 Unit Stresses: $f_c = 1,600$ p.s.i. Class AAA
 $f_c = 1,200$ p.s.i. Class A
 $f_s = 20,000$ p.s.i. (Rein.)
 $f_c = 3,000$ p.s.i. Class AAA
 $f_c = 3,000$ p.s.i. Class A
 45 tons per pile in piers
 35 tons per pile in abutments

QUANTITIES: All quantities shown on these plans shall be used as final pay quantities except that measurement and payment for piling shall be in accordance with the specifications.

SPECIAL REQUIREMENTS: It is the intention of these plans and specifications that construction of the bridge shall be in accordance with applicable standard specifications and requirements of the Kansas State Highway Commission and that materials shall conform to these specifications unless otherwise expressly noted.





Note: (446)
 Casana laid new line South of bridge. McCannell's line to be taken over by City Water Dept. See sheet 7.

SCALE: 1"=10'


1	WLB-4-66	Rev. As Built
CITY OF WICHITA, KANSAS B. E. SMITH, CITY ENGINEER		
PAWNEE AVENUE BRIDGE OVER BY: SUM CREEK		
CONSTRUCTION LAYOUT		
R. S. DELAMATER CONSULTING ENGINEER WICHITA, KANSAS	DATE August, 1965 SCALE 1"=10'	DWG. NO. 79-M-3

abc Elmer T. Talis El Elmer R. Richard Talis

PUB. ROAD DIST. NO.	STATE	PROJECT NO.	FISCAL YEAR	SHEET NO.	TOTAL SHEETS
5	KANSAS	C15-47	1965	5	9

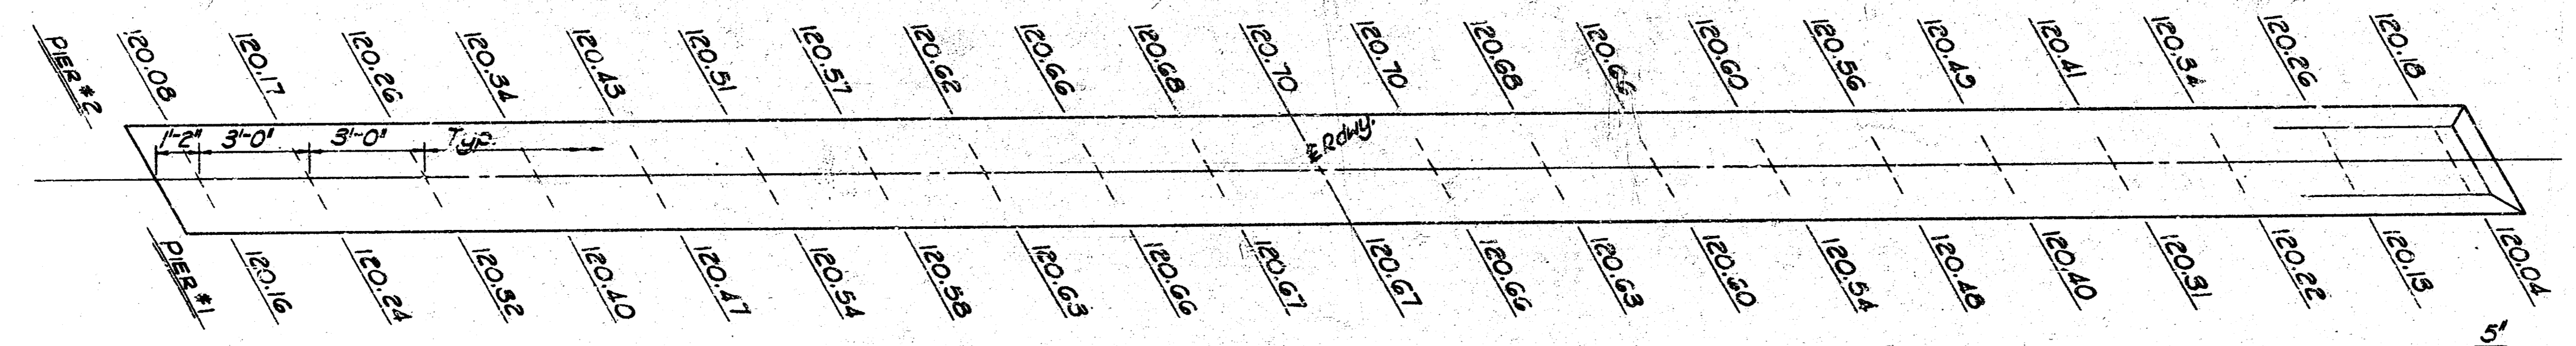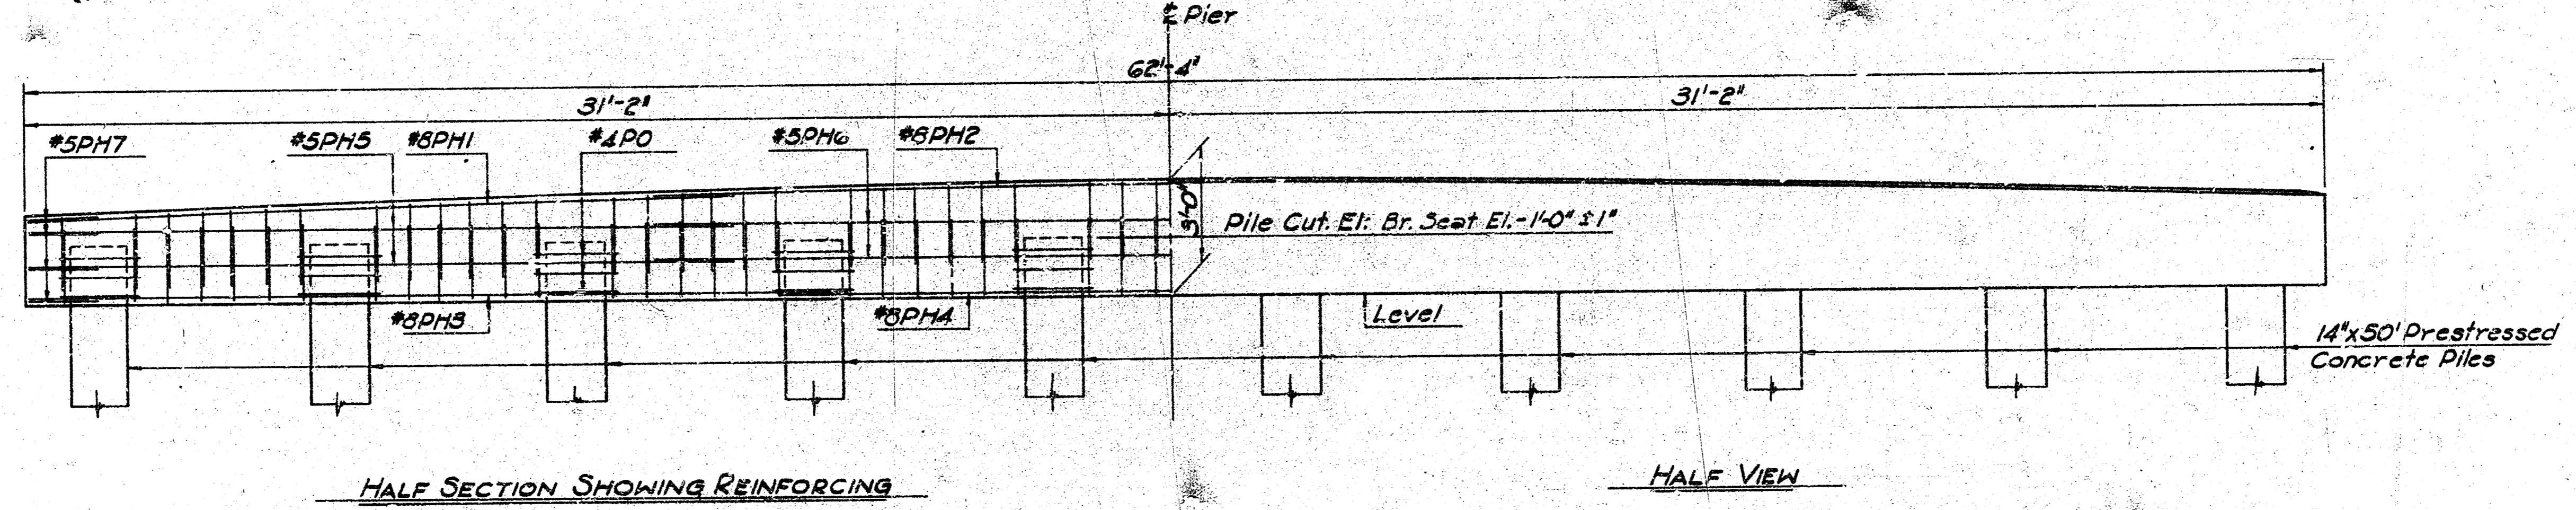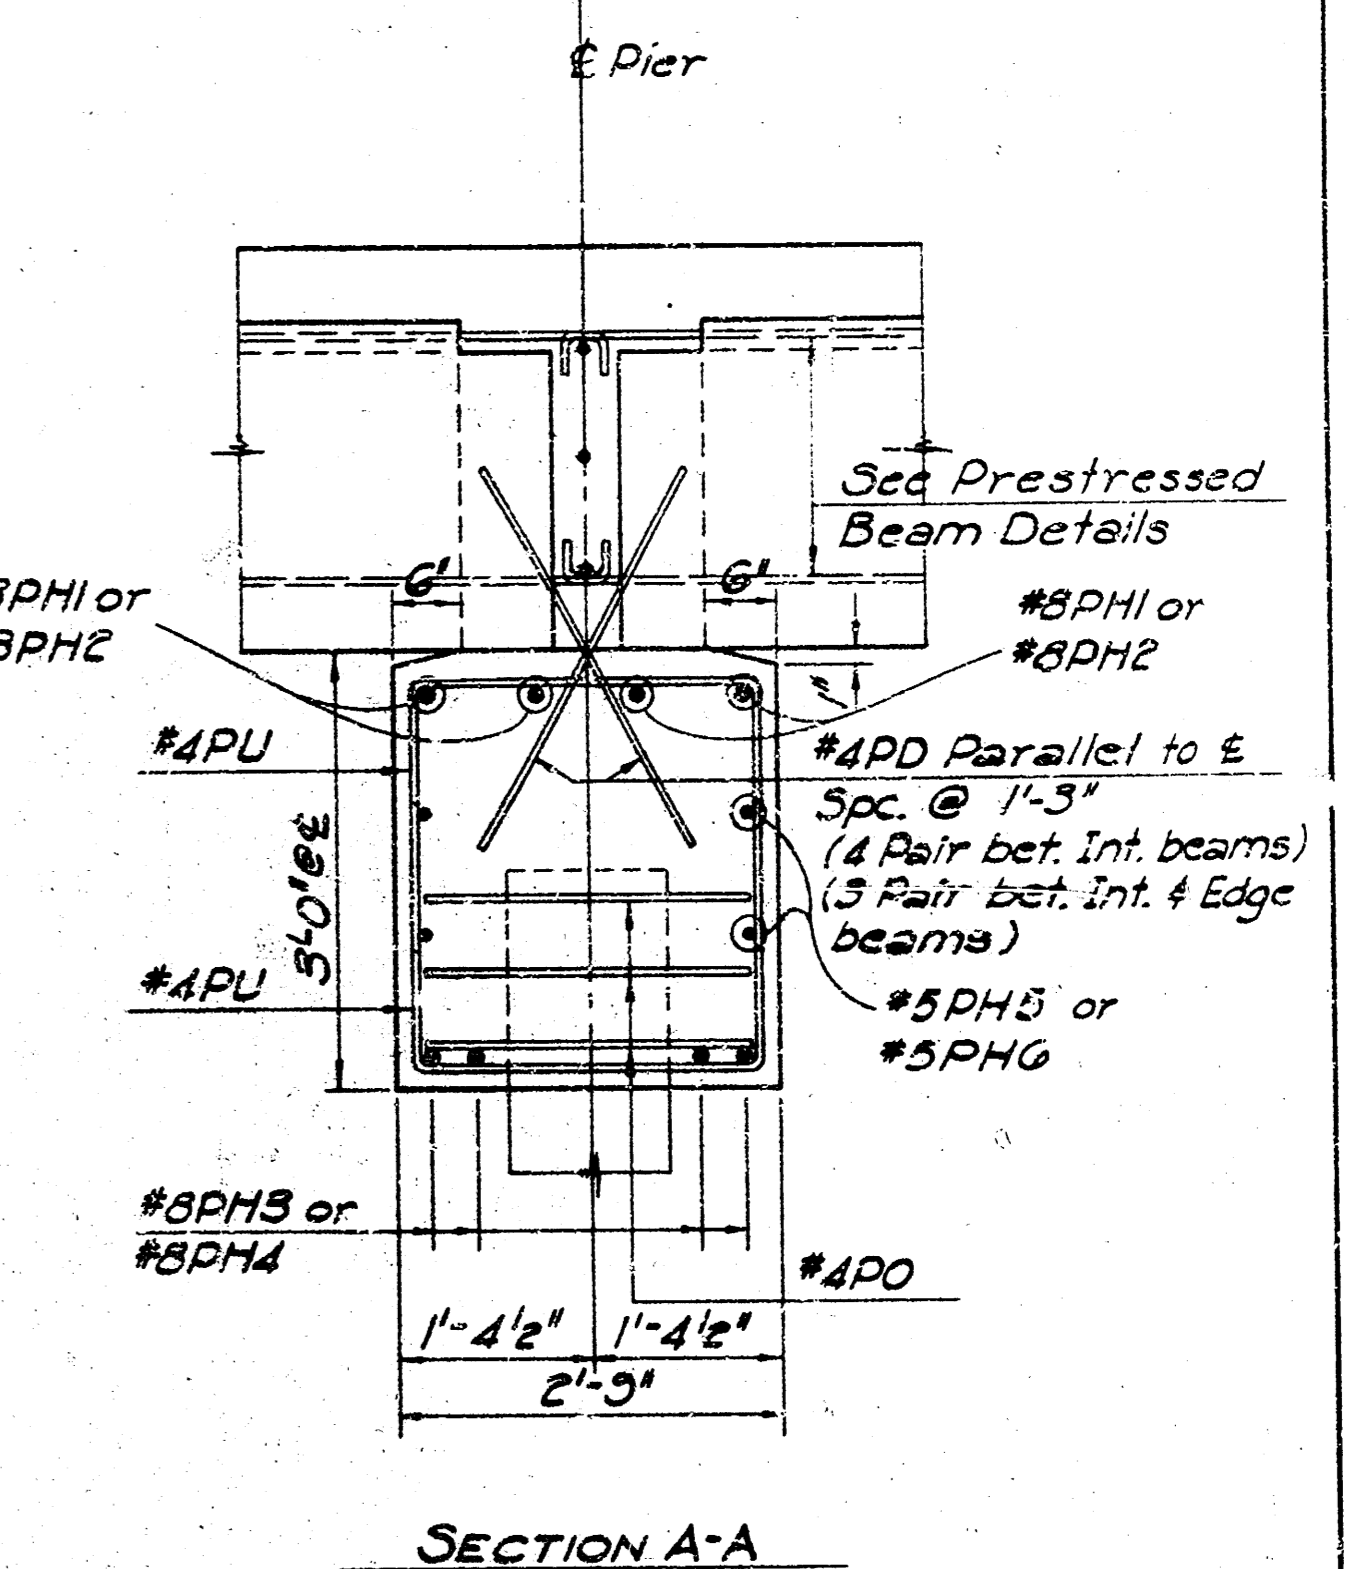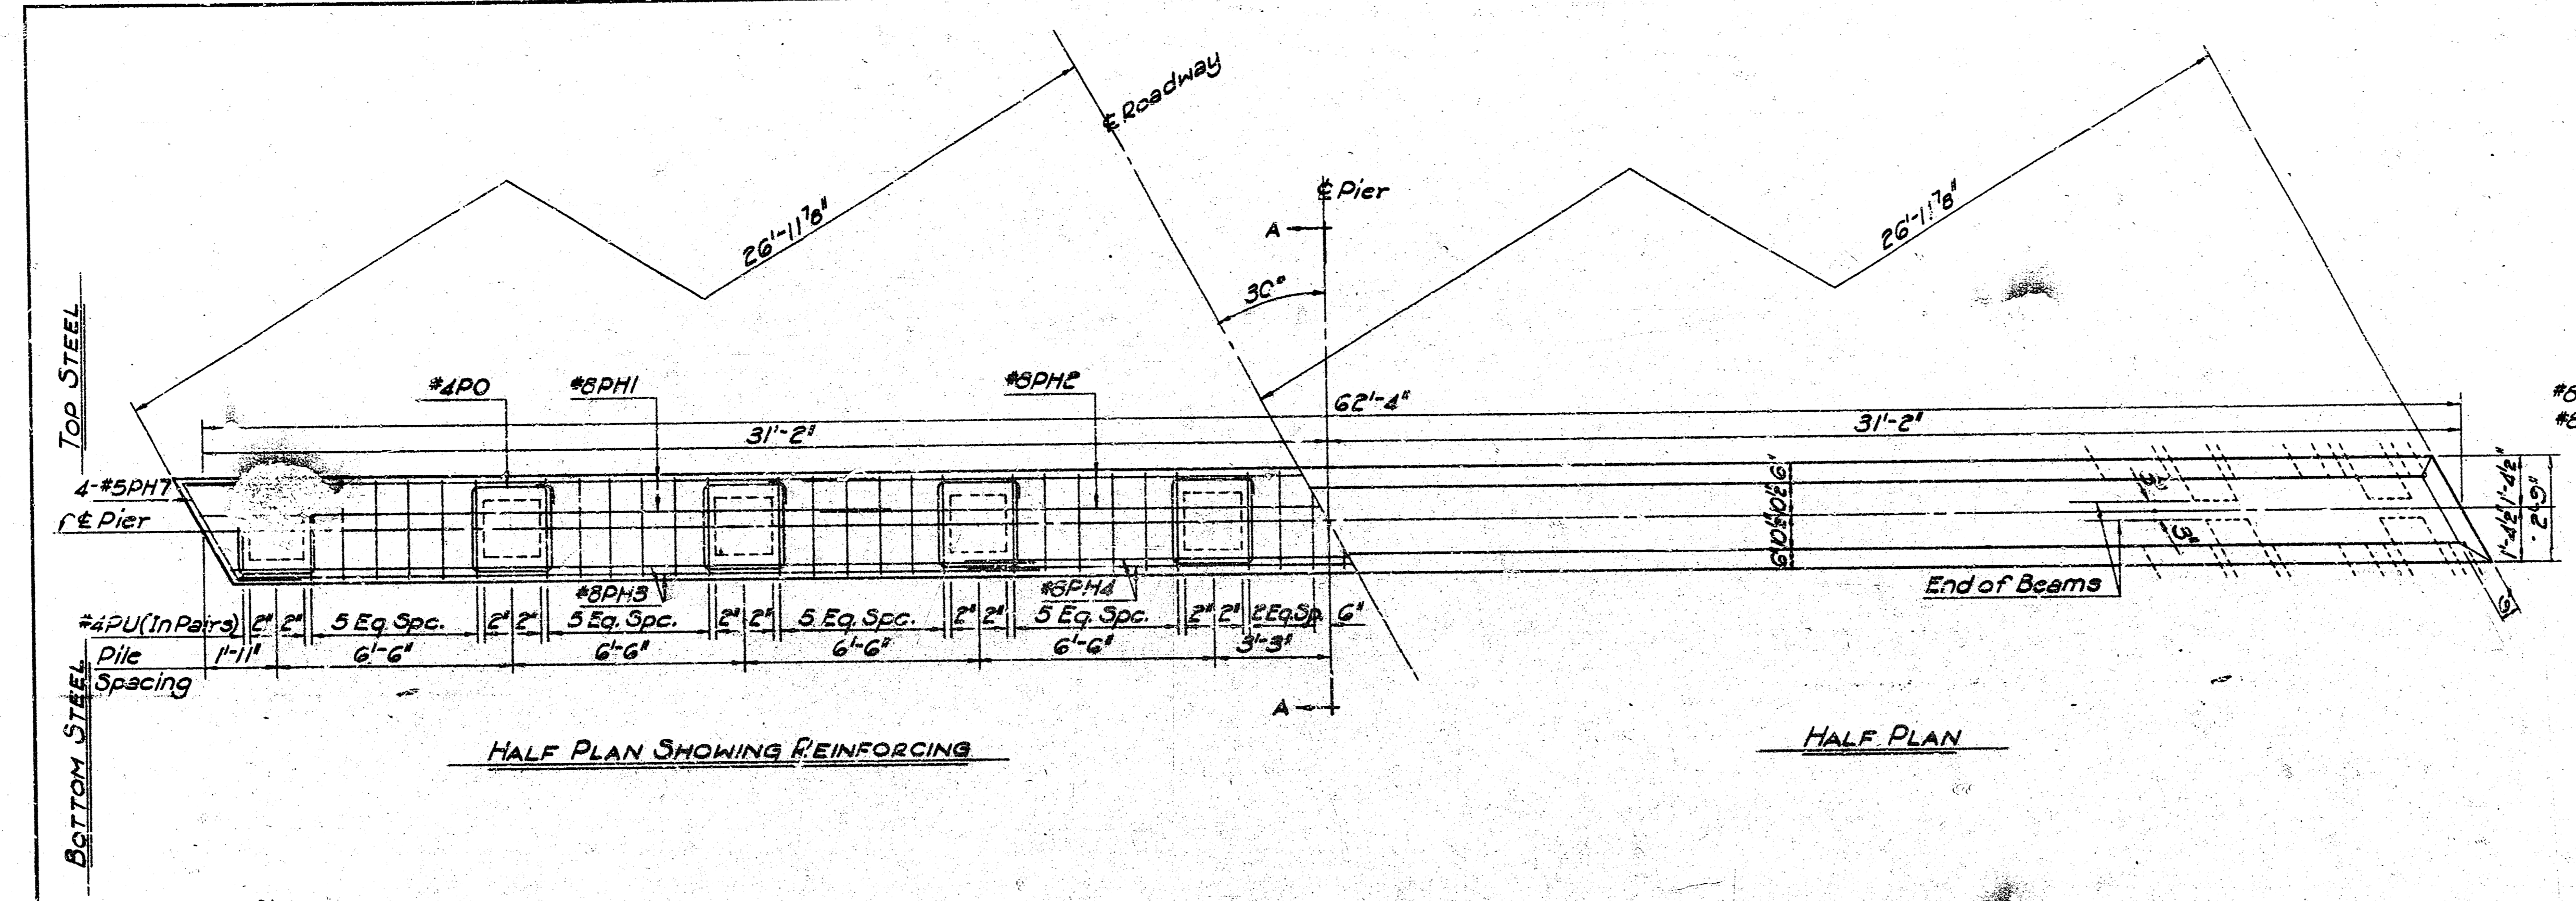

PIER BRIDGE SEAT ELEVATIONS
(Subject to adjustment to compensate for beam camber)

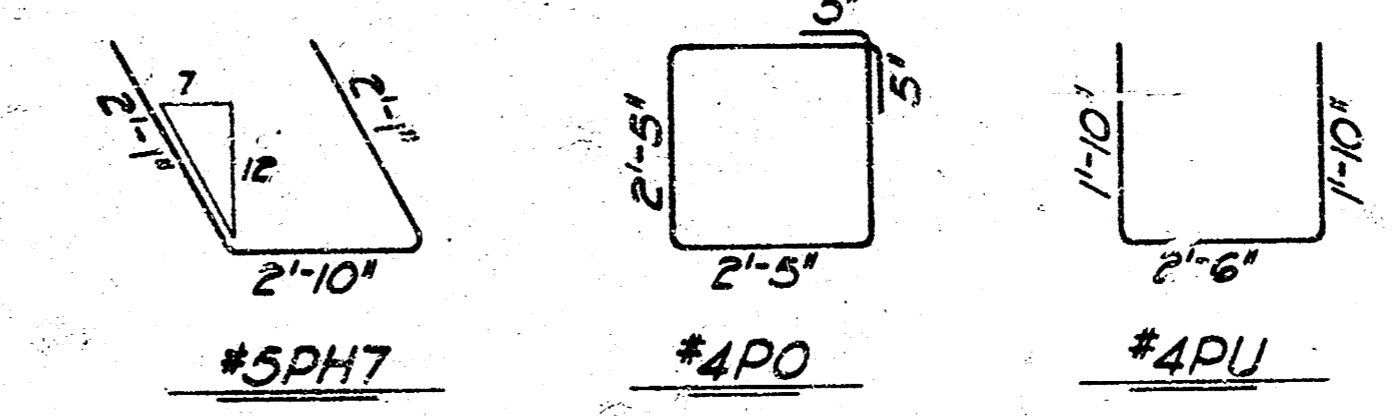

BAR LIST AND SUMMARY OF QUANTITIES (ONE PIER)

Mark	PD	PH1	PH2	PH3	PH4	PH5	PH6	PH7	PO	PU
No. Req'd	76	8	4	8	4	8	4	8	30	112
Size	#4	#8	#8	#8	#8	#8	#8	#8	#4	#4
Length	3'-0"	13'-0"	28'-0"	22'-3"	21'-6"	13'-0"	25'-0"	7'-0"	10'-6"	6'-2"
Shape									□	L

Class A(AE) Conc. 17.5 Cu.Yds.
Reinforcing Steel 2,570 Lbs.


NOTE:
Use Class A(AE) Concrete thruout.

See Sheet 3 for General Notes.


CITY OF WICHITA, KANSAS
B. E. SMITH, CITY ENGINEER
PAWNEE AVENUE BRIDGE OVER GYPSUM CREEK
PIER DETAILS
R. S. DELAMATER
CONSULTING ENGINEER
WICHITA, KANSAS
DATE August, 1965
SCALE
DWG. NO. 79-M-5

DATE: _____
 DES. KAG OR E.C.
 CHECKED R.M.
 APPROVED: _____

PUB. ROAD DIV. NO.	STATE	PROJECT NO.	FISCAL YEAR	SHEET NO.	TOTAL SHEETS
5	KANSAS	C15-47	1965	6	9

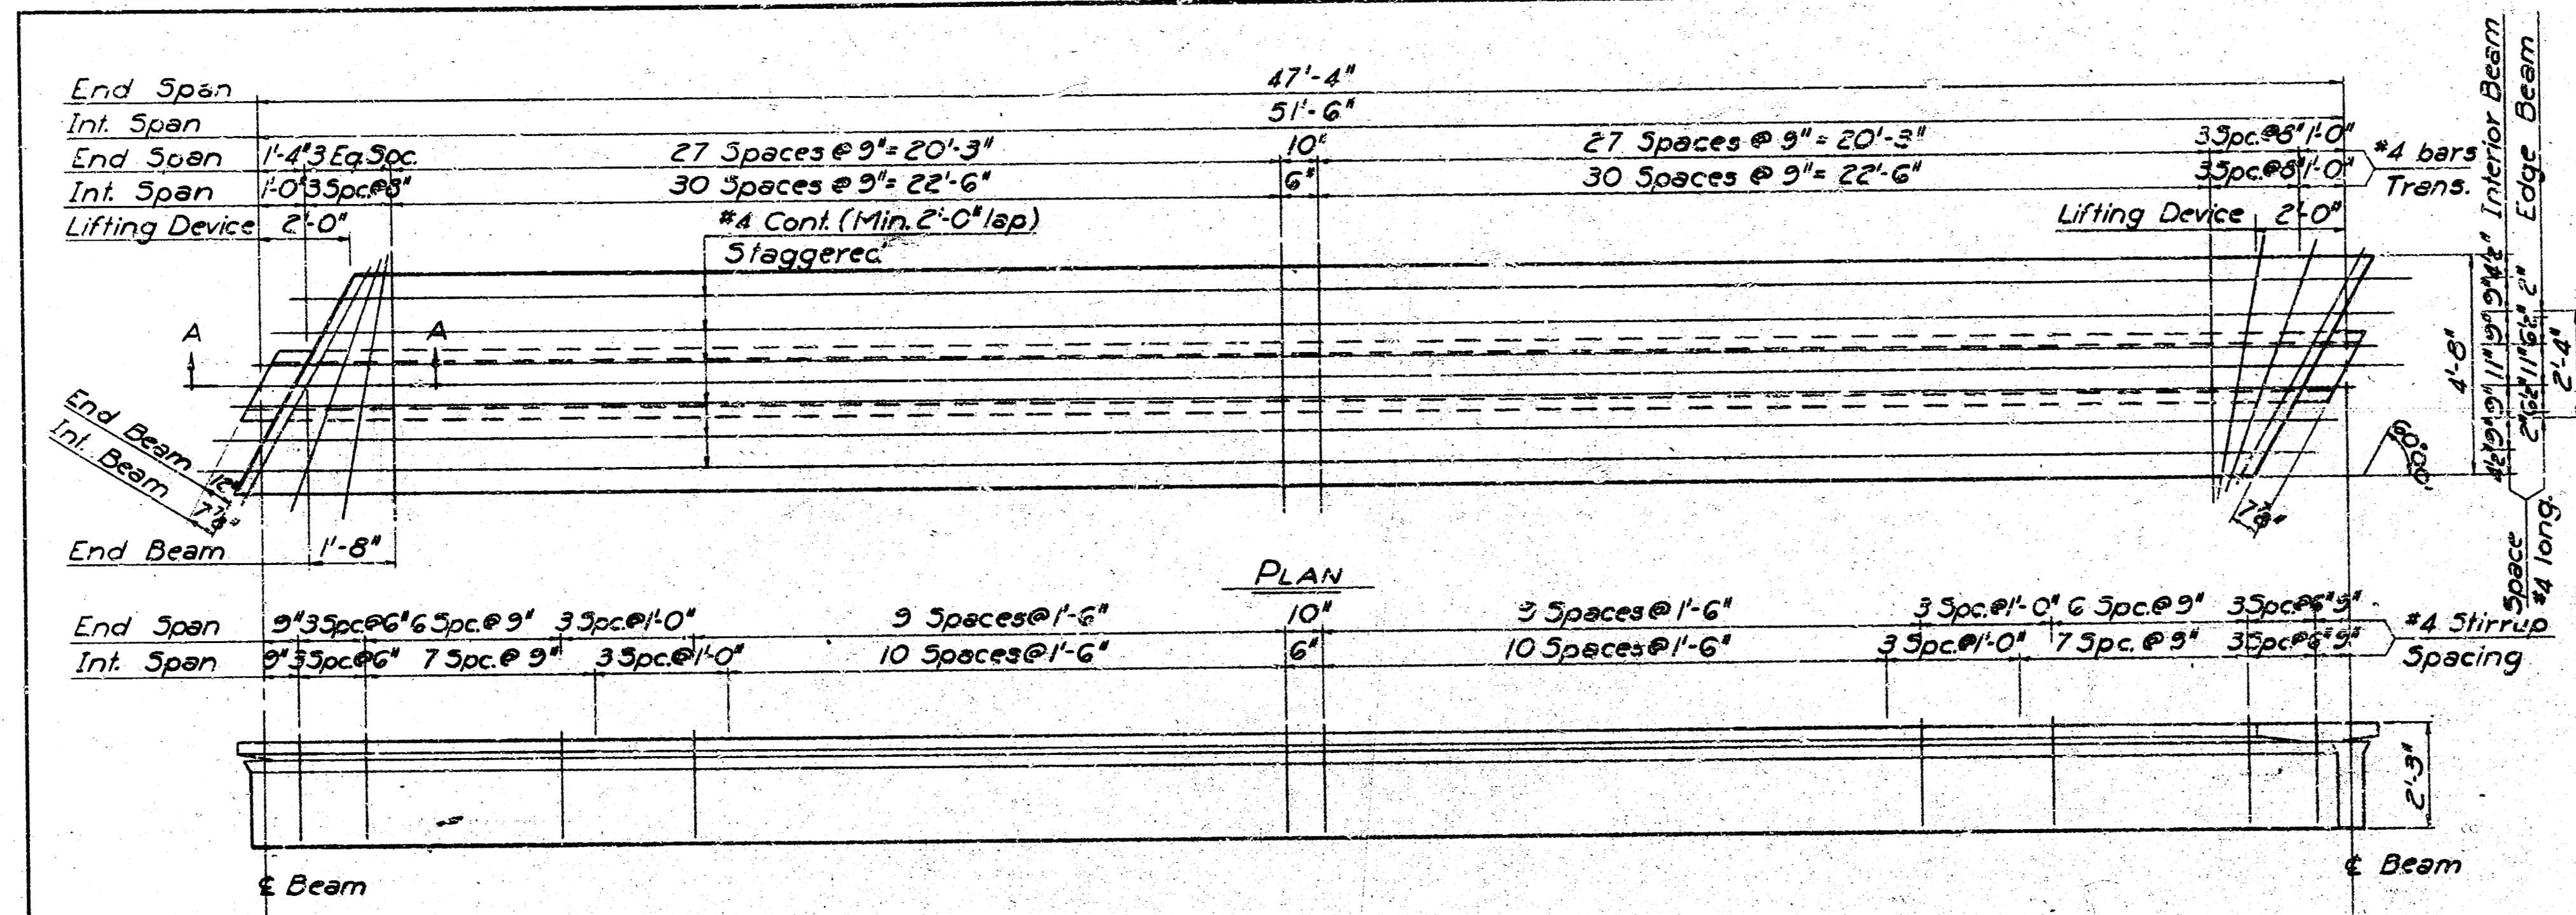

ELEVATION
(Similar for Interior and Edge Beams)

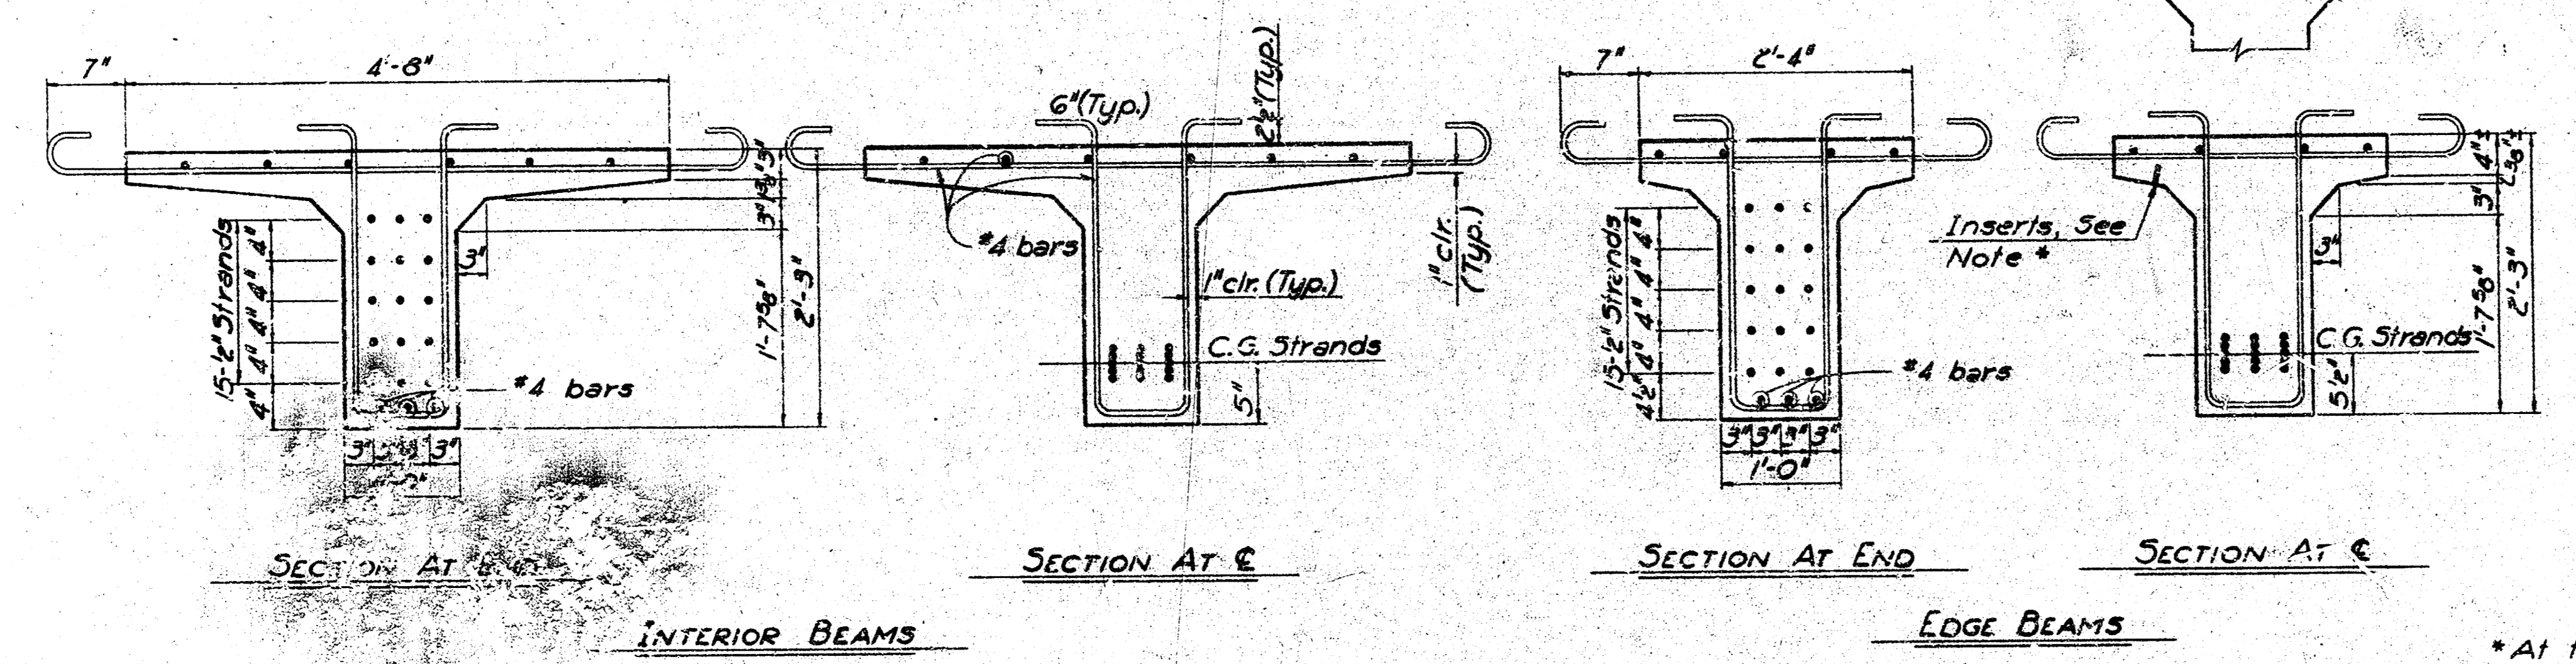


* At the Contractor's option: inserts to support forms for edge of slab.

GENERAL NOTES


DESIGN:
Loading: H20-S16-44 A.A.S.H.O. Specifications (1961 Ed.)
Concrete: $f'_c = 4,000$ p.s.i. (at 28 days)
 $f_{ci} = 4,650$ p.s.i. (Min. release strength)
Prestressing steel: 1/2" nominal diameter 7-wire high tensile type stress relieved strands having an ultimate strength of 41,300 lbs per strand.
Reinforcing Steel: $f_s = 20,000$ p.s.i.

STEEL PLACEMENT: All dimensions shown relative to placement of reinforcing steel are to centerline of bars unless otherwise noted. All dimensions shown in the bending diagrams are out to out of bars.

HANDLING AND ERECTION: Each beam shall be equipped with lifting devices of sufficient strength to insure safe and proper handling of the beams. Details of lifting devices shall be submitted for approval by the engineer before fabrication for placing procedure and erection loads.

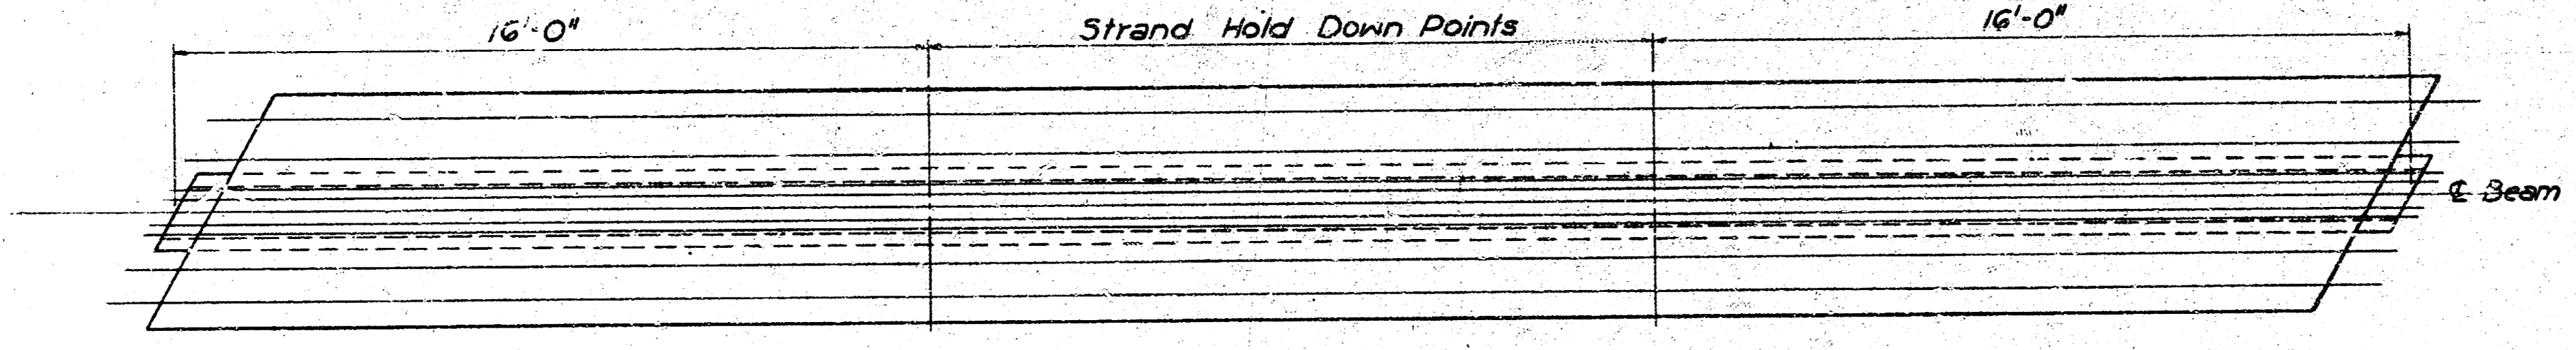

PLAN
Interior Beam
(Edge Beam similar)

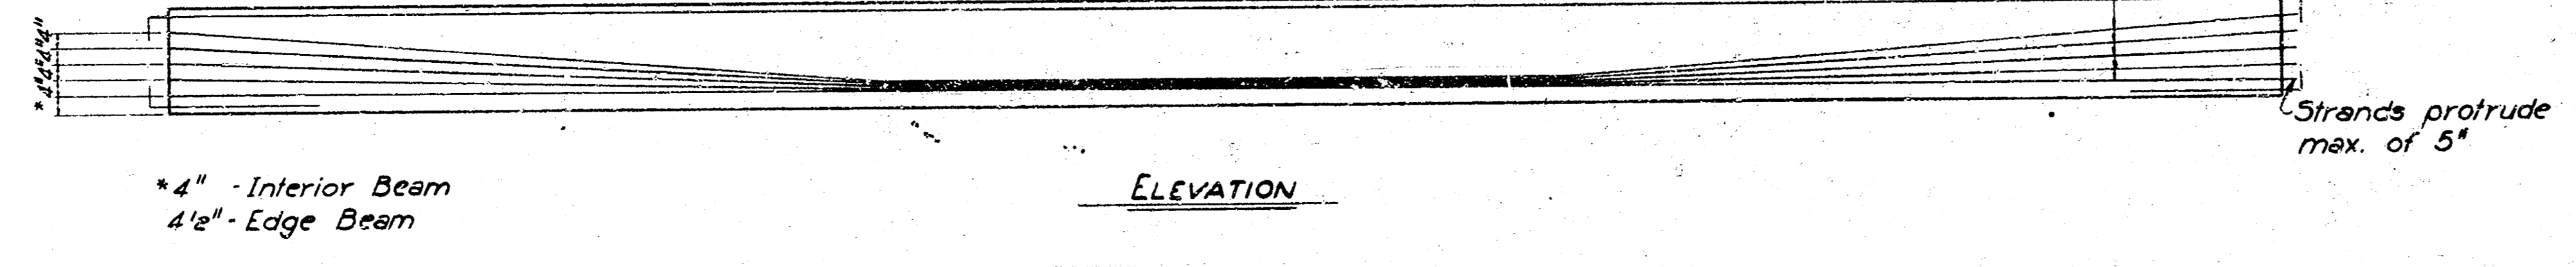














CITY OF WICHITA, KANSAS
B. E. SMITH, CITY ENGINEER
PAWNEE AVENUE BRIDGE OVER
GYPSUM CREEK
PRESTRESSED BEAM DETAILS

R. S. DELAMATER
CONSULTING ENGINEER
WICHITA, KANSAS

DATE August, 1965
SCALE
DRAWING NO. 79-N-6

PUB. ROAD DIV. NO.	STATE	PROJECT NO.	FISCAL YEAR	SHEET NO.	TOTAL SHEETS
5	KANSAS	C15-47	1965	7	9



NOTE:
Class AAA(AE) concrete shall be used thruout.
See Sheet 3 for General Notes.

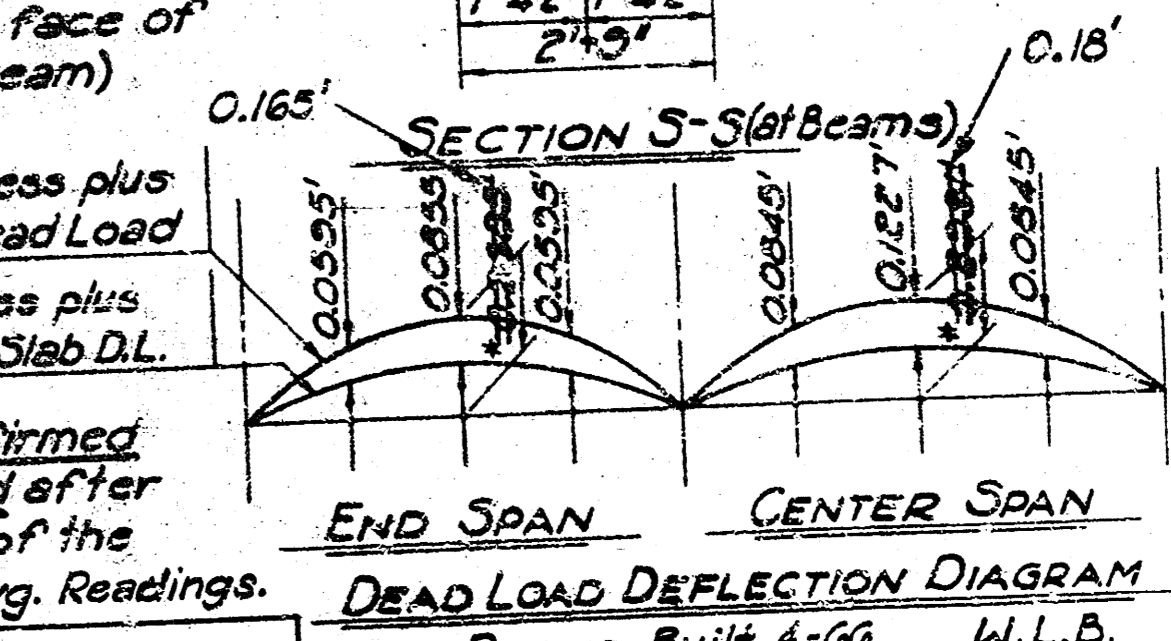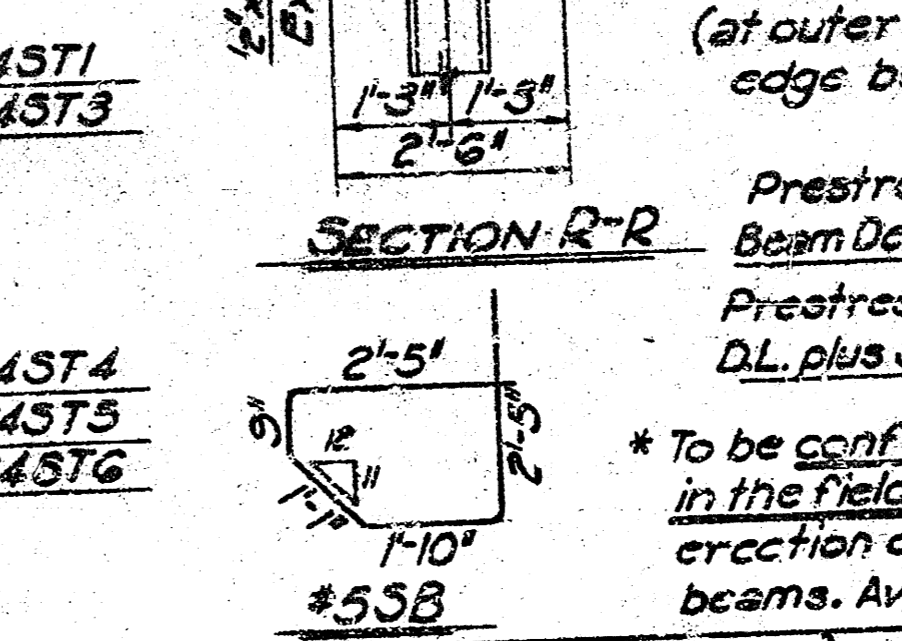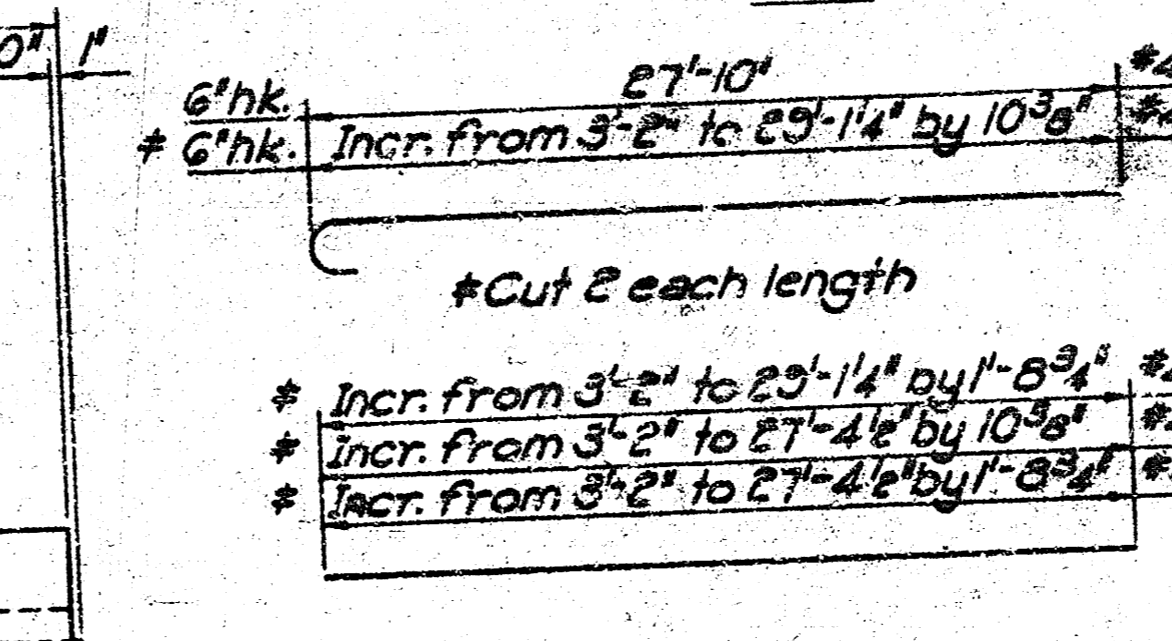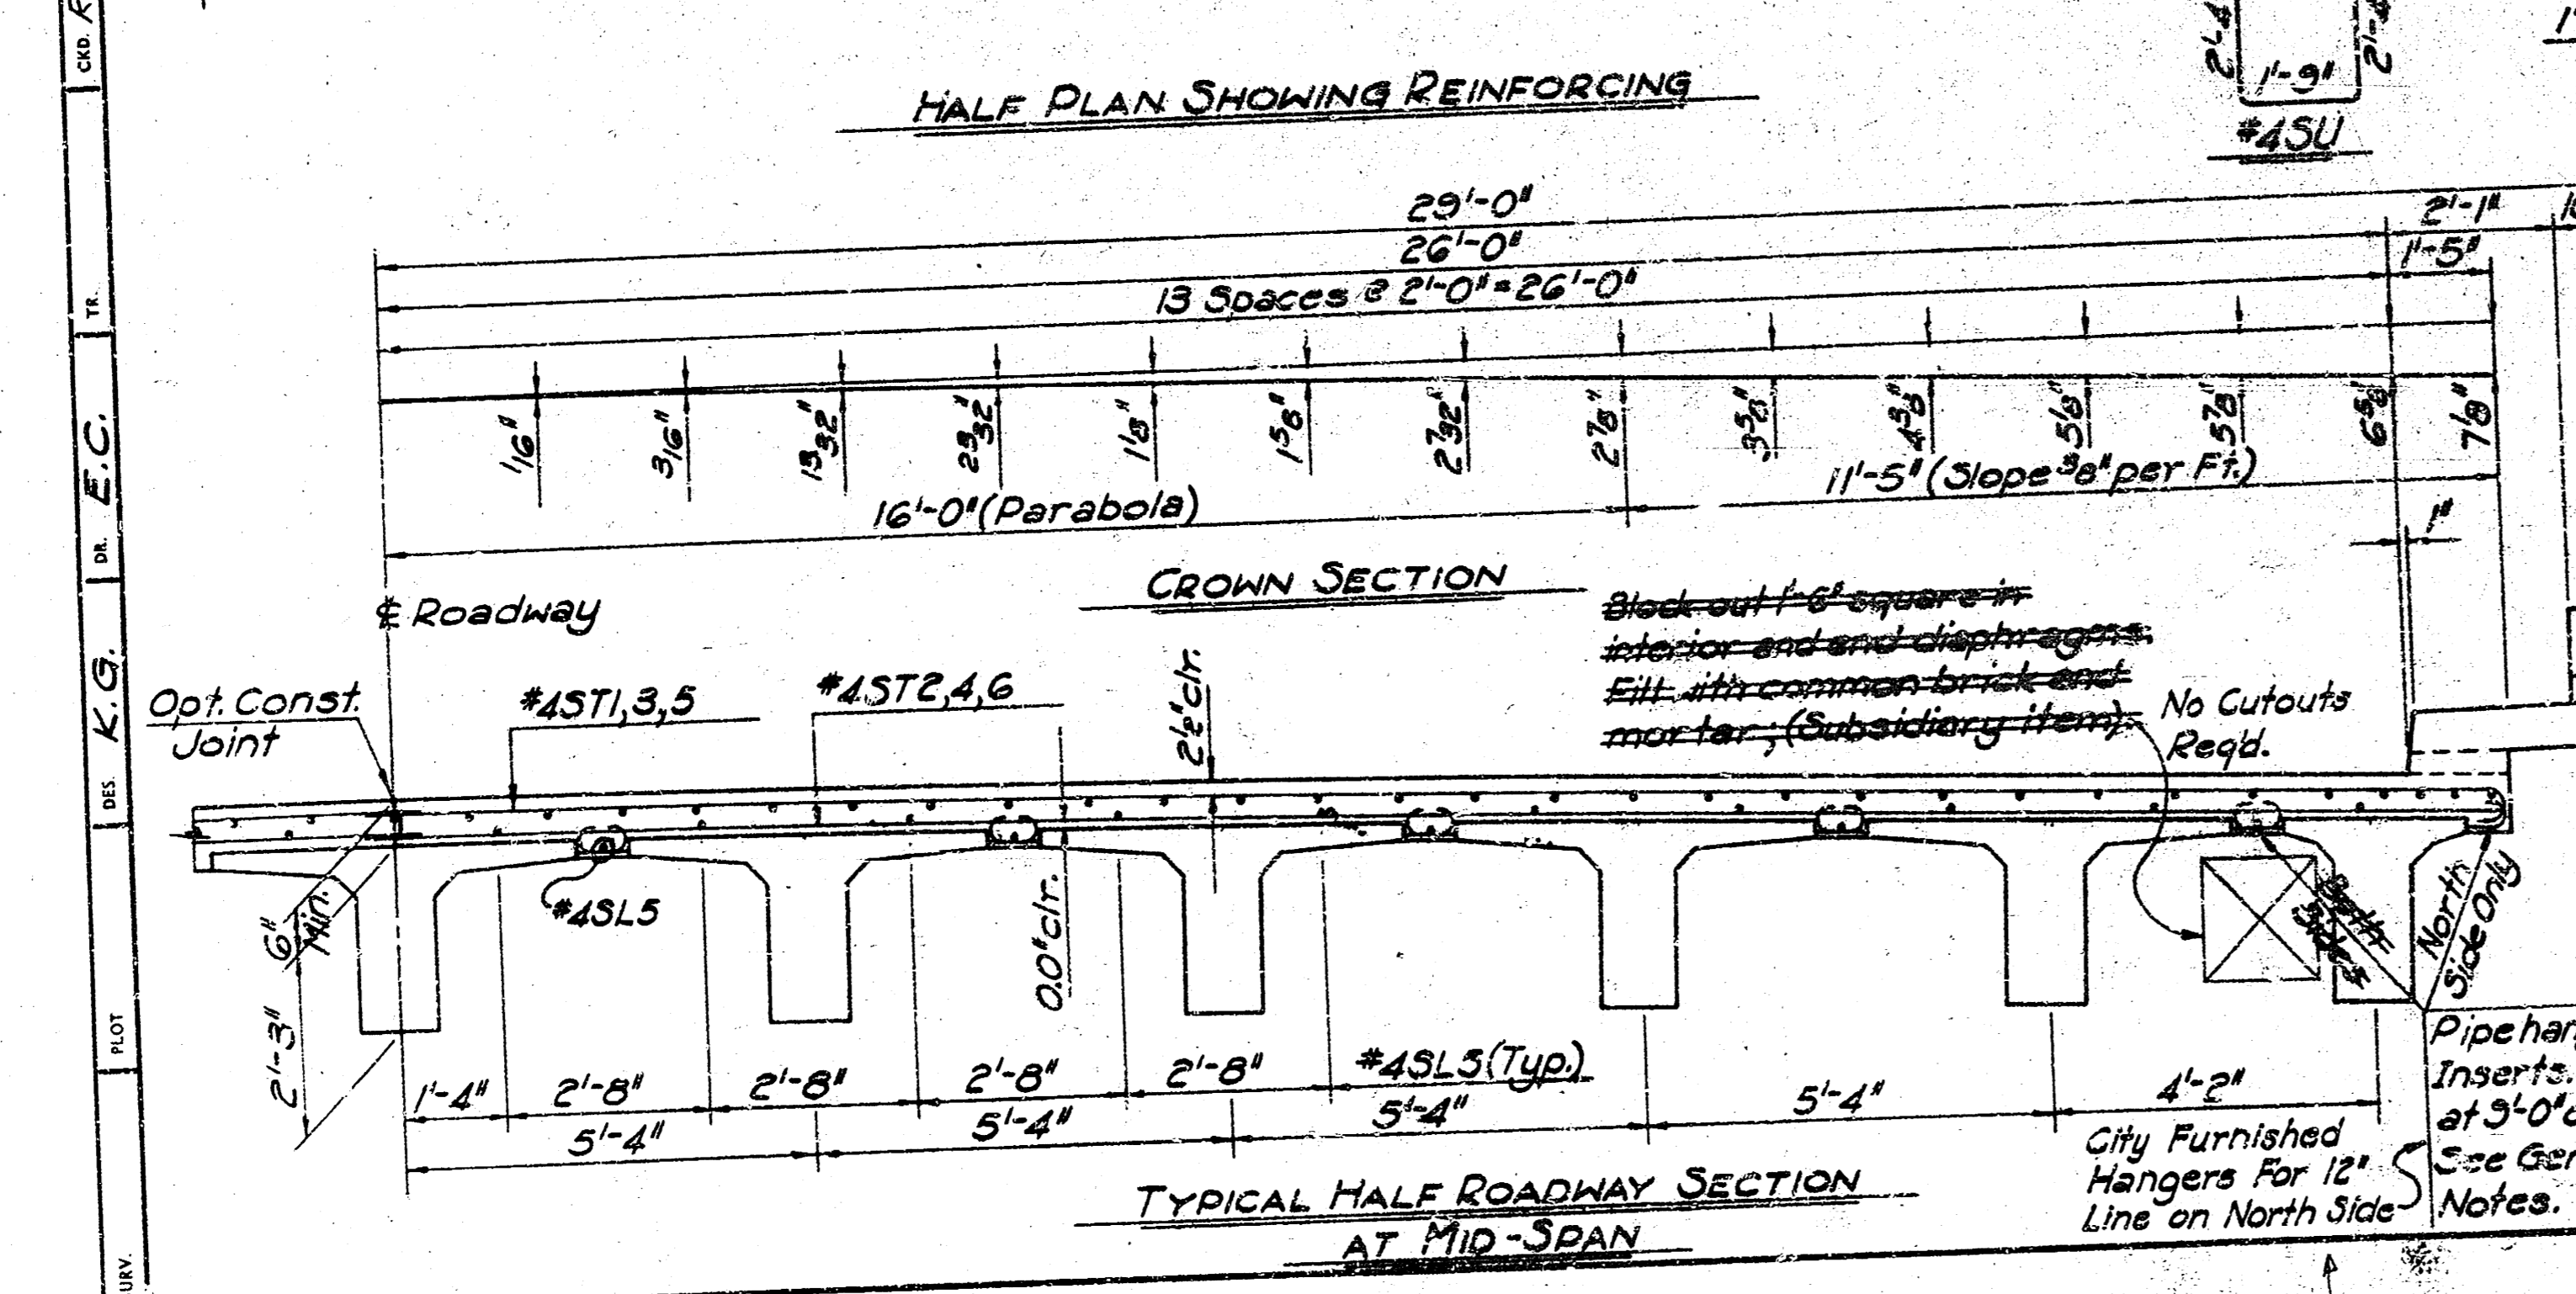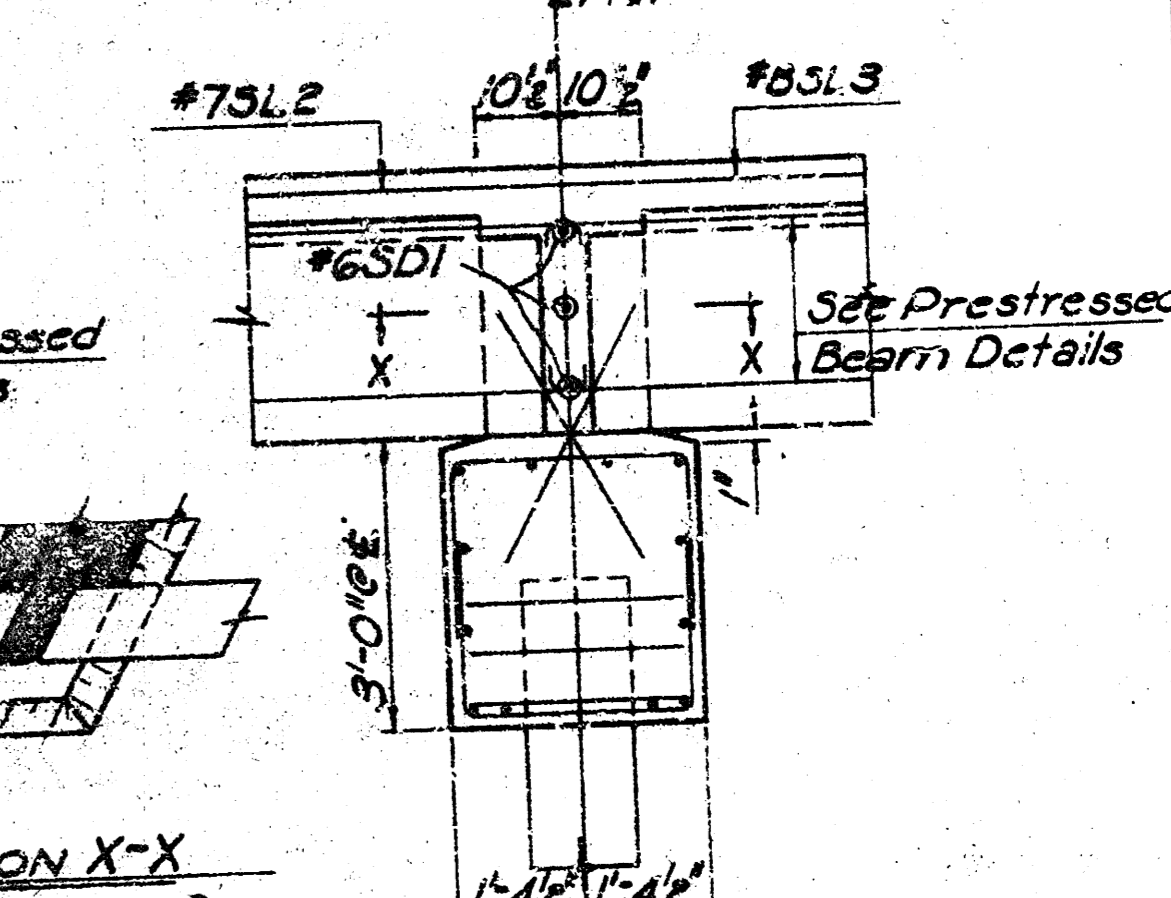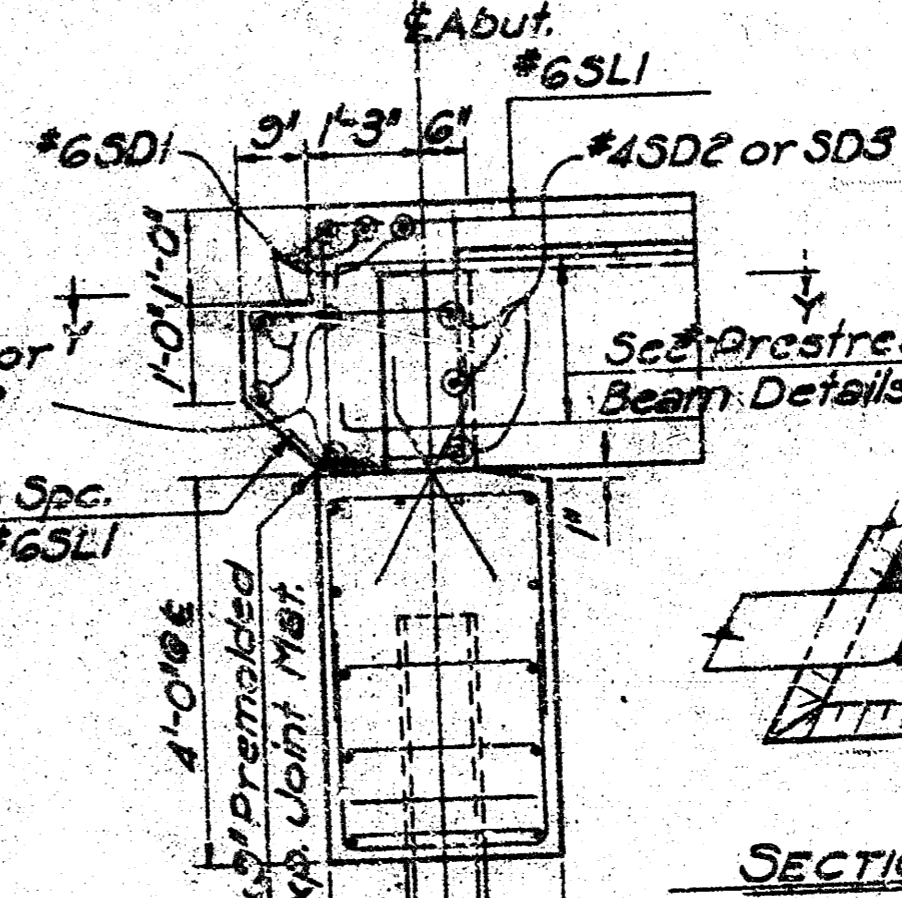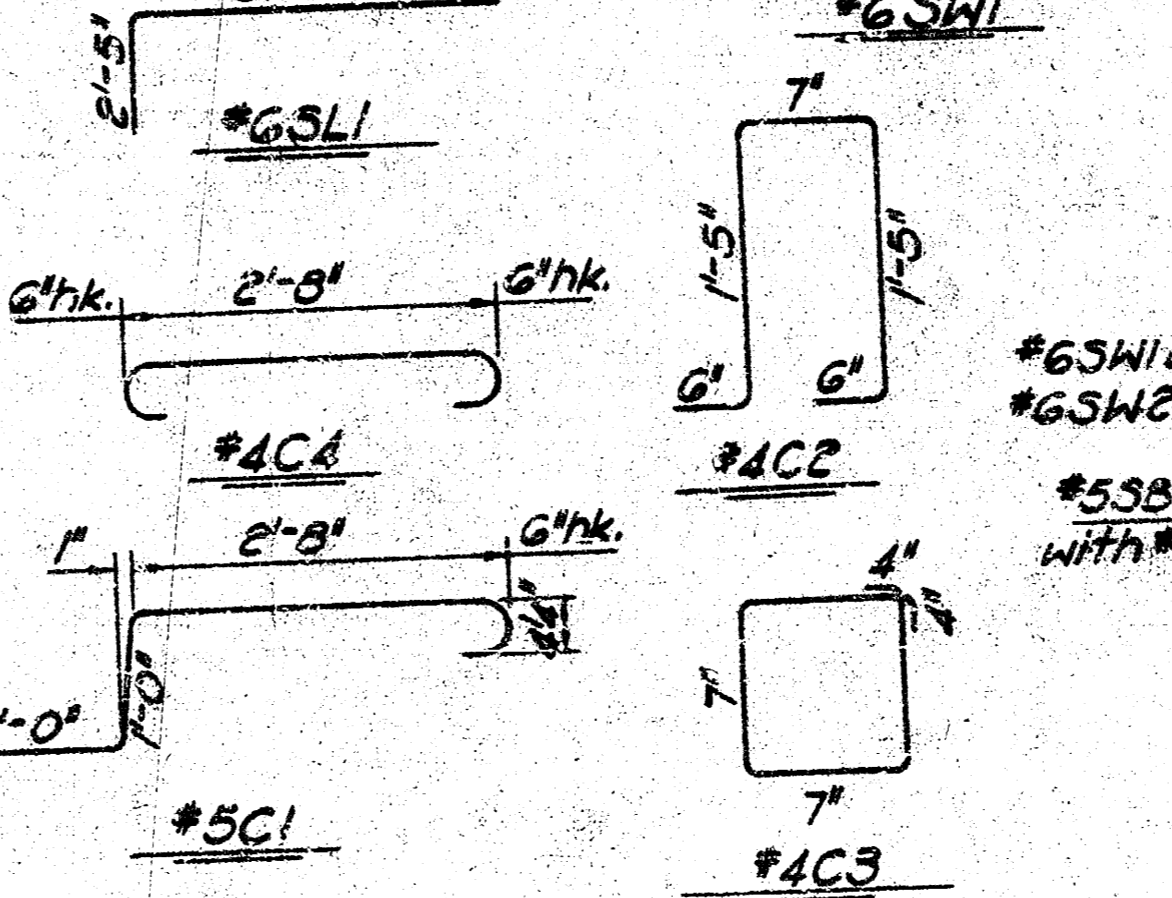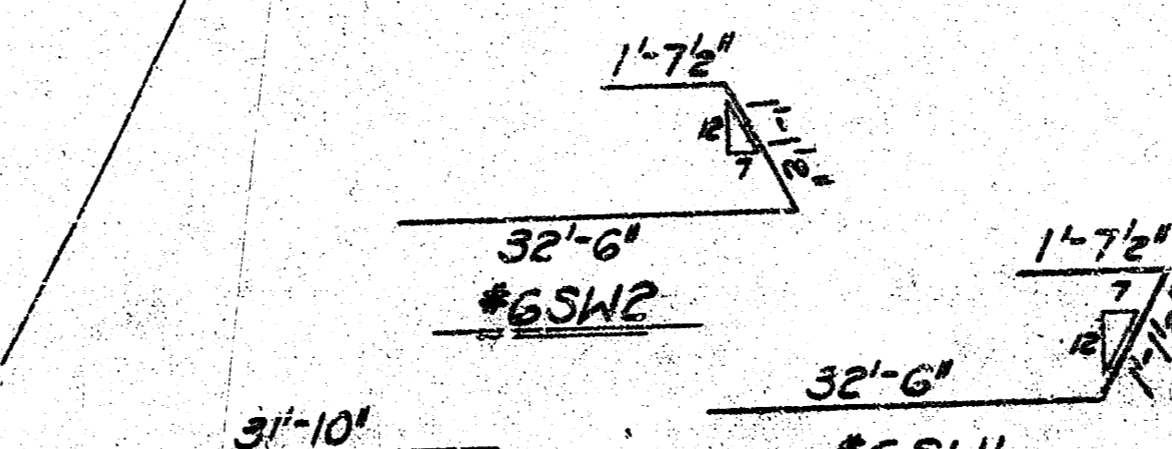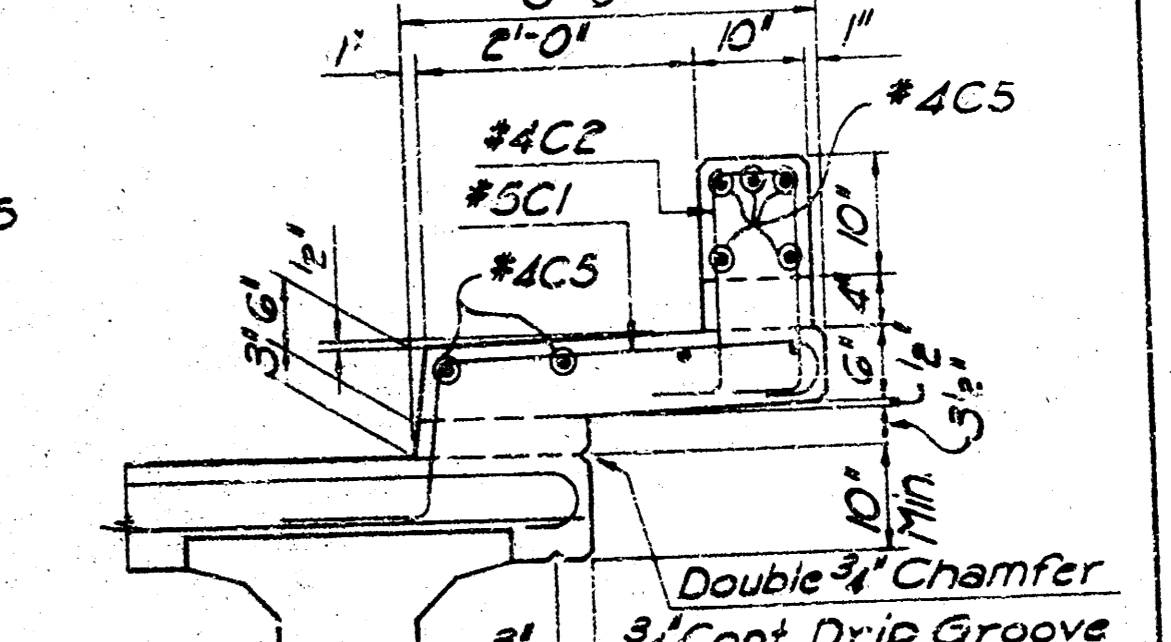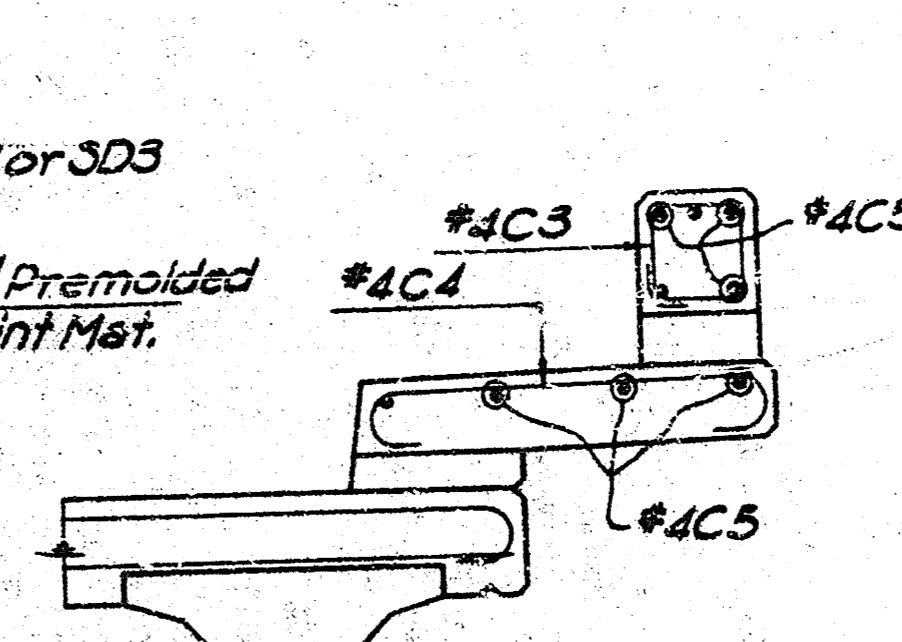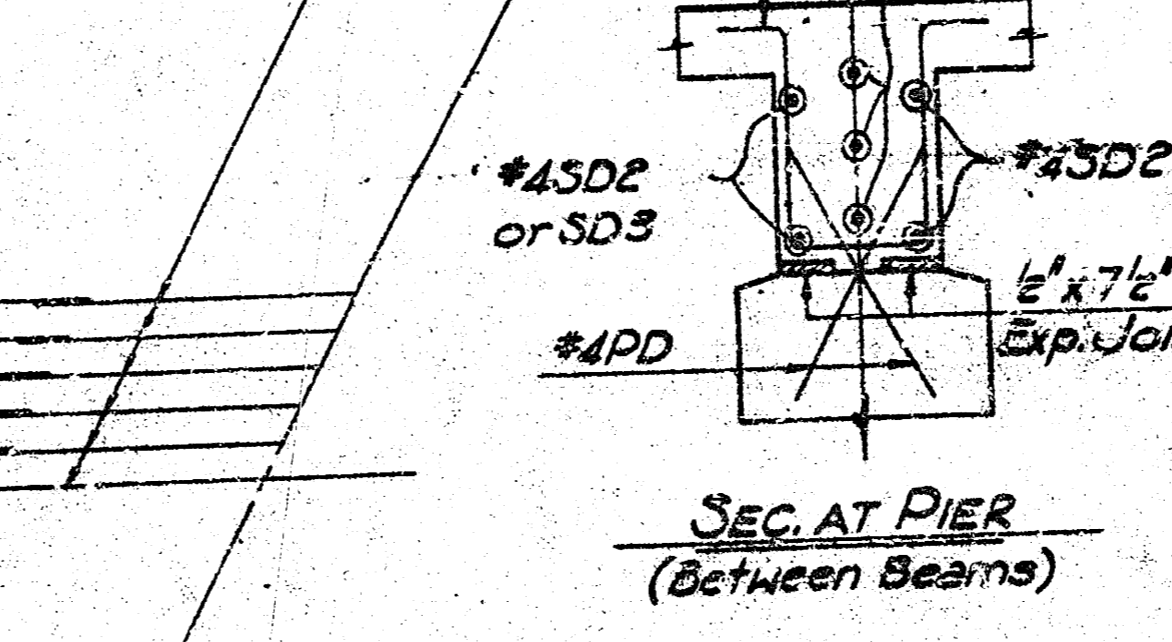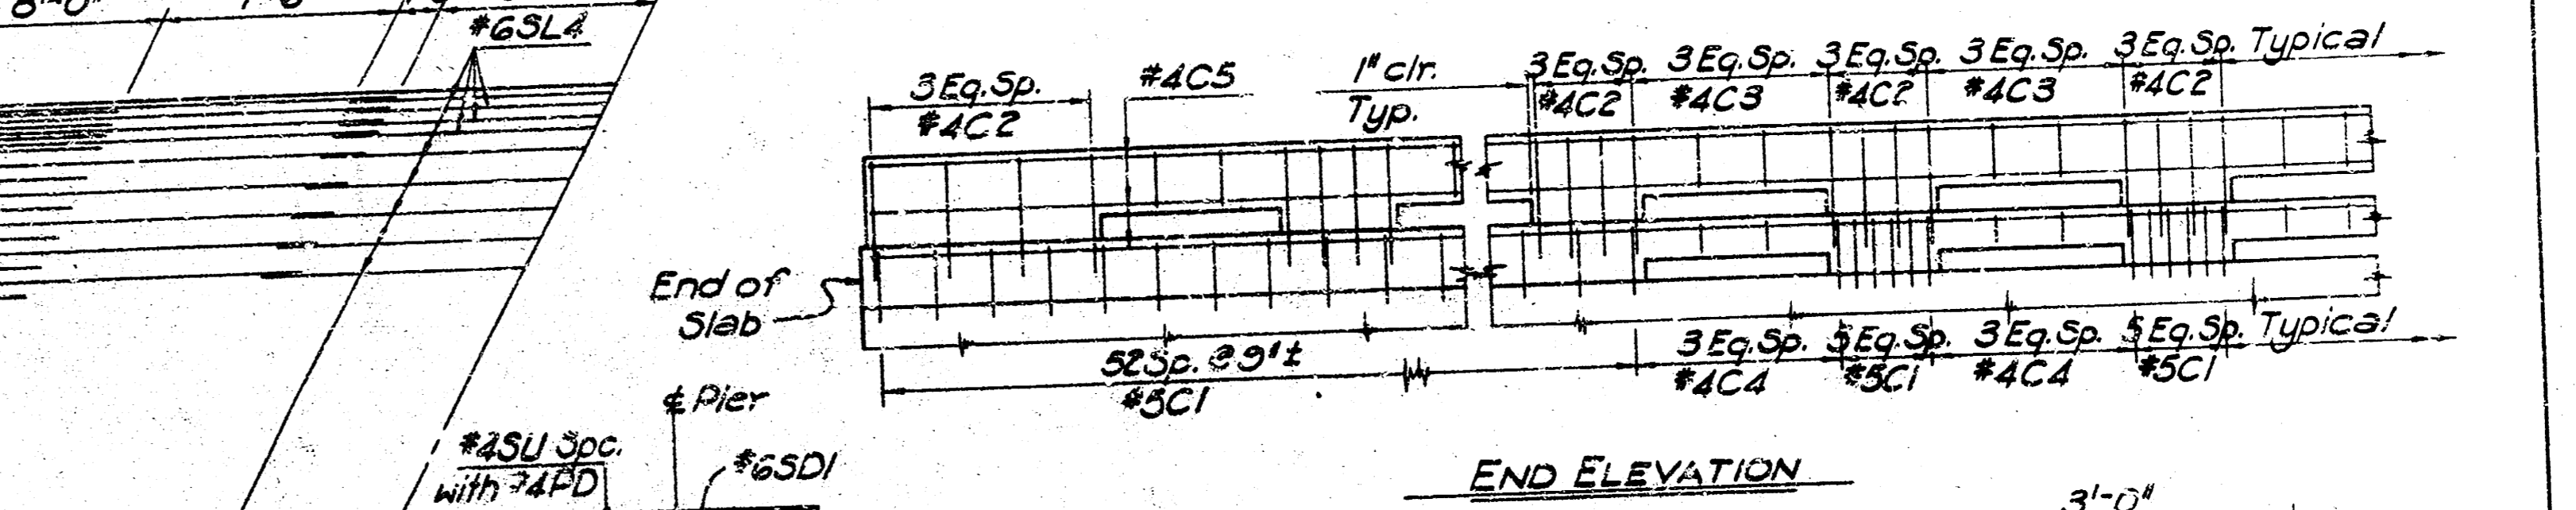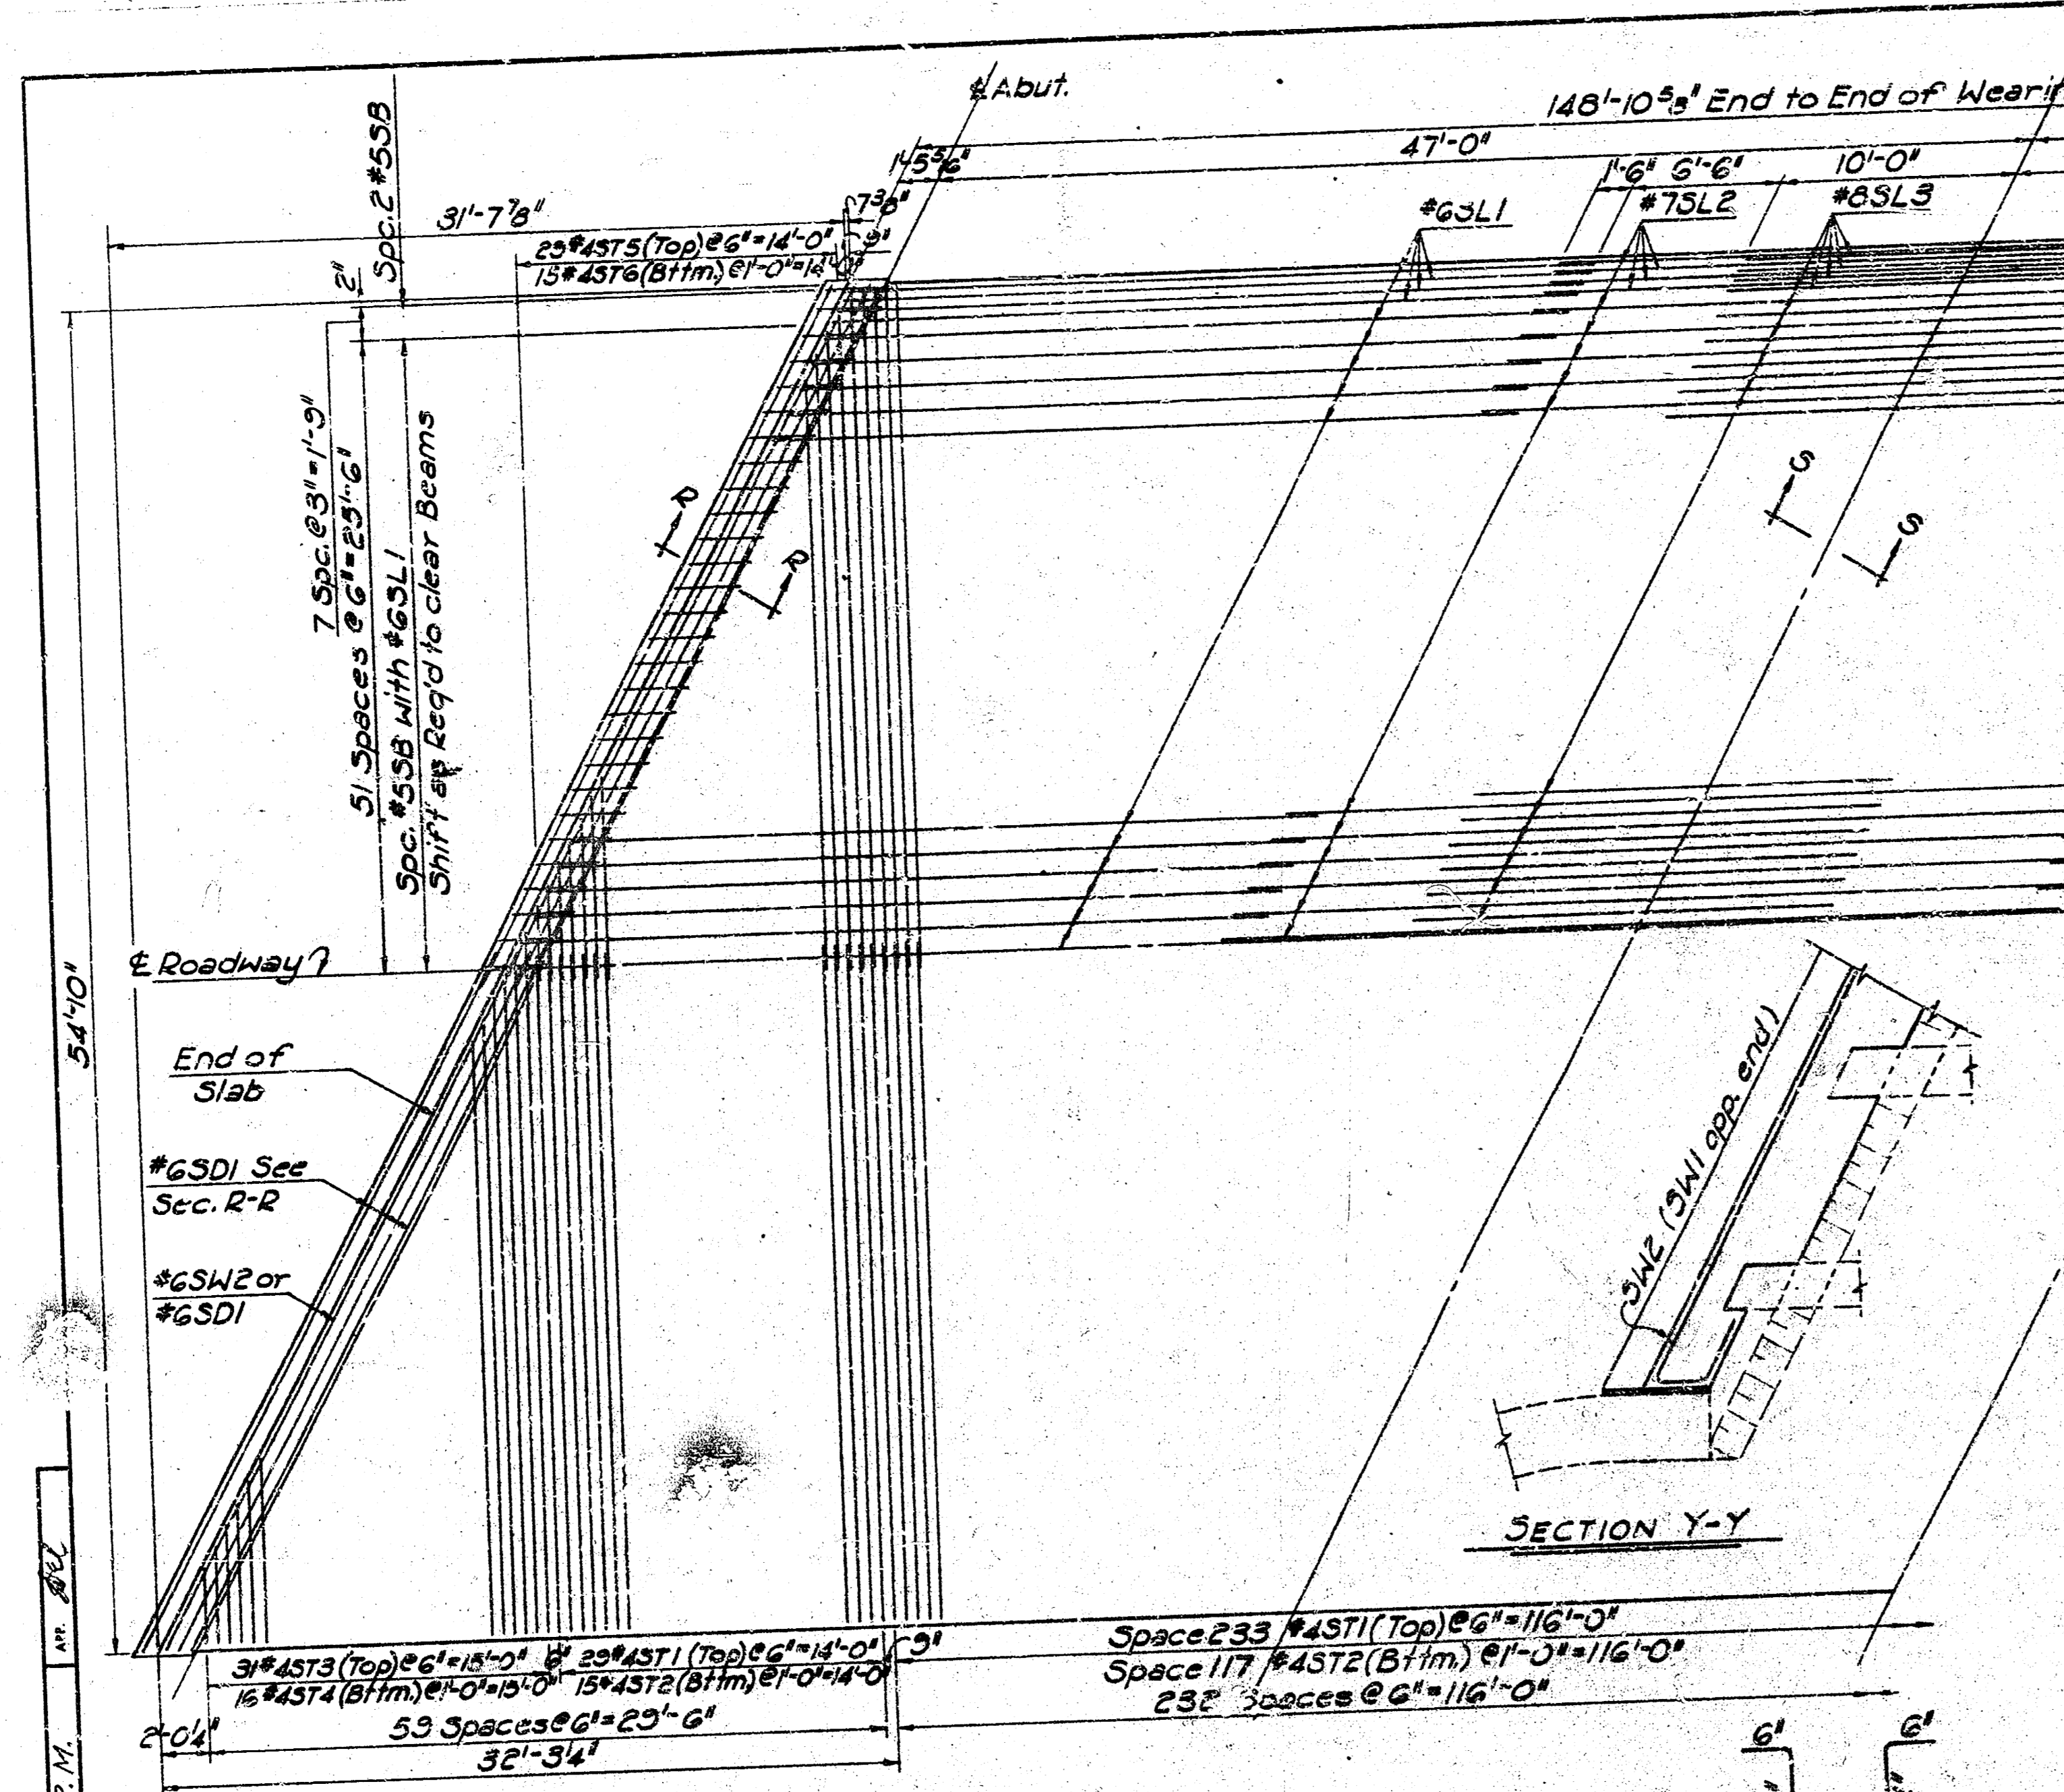

Mark	C1	C2	C3	C4	C5	SD1	SD2	SD3	SL1	SL2	SL3	SL4	SL5	SK1	SK2
No. Reqd.	416	296	144	72	108	32	112	28	116	116	59	180	4	4	4
Size	#3	#4	#4	#4	#4	#6	#4	#4	#6	#7	#8	#4	#4	#6	#6
Length	3'-2"	4'-5"	7'-0"	3'-0"	23'-0"	32'-0"	4'-0"	3'-0"	34'-3"	35'-0"	18'-0"	21'-0"	28'-6"	35'-5"	35'-3"
Shape	U	U	U	U	U	U	U	U	U	U	U	U	U	U	U
Mark	SU	ST1	ST2	ST3	ST4	ST5	ST6	ST8							
No. Reqd.	76	524	264	62	32	30	110								
Size	#4	#4	#4	#4	#4	#4	#4								
Length	7'-5"	28'-2"	27'-10"												
Shape	U														

Rev. as Built 4-66 W.L.B.
CITY OF WICHITA, KANSAS
B. E. SMITH, CITY ENGINEER
PAWNEE AVENUE BRIDGE OVER
GYPSUM CREEK
SUPERSTRUCTURE DETAILS
R. S. DELAMATER
CONSULTING ENGINEER
WICHITA, KANSAS
DATE August, 1965
SCALE
78-M-7

PUR. ROAD NO.	STATE	PROJECT NO.	FISCAL YEAR	SHEET NO.	TOTAL SHEETS
5	KANSAS	C15-47	1955	8	9

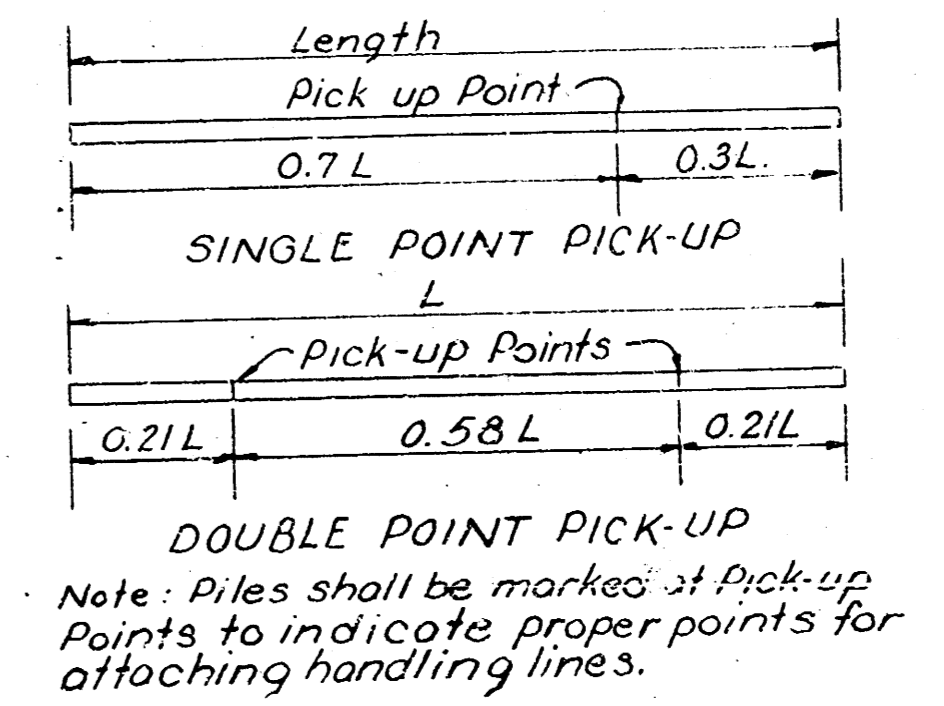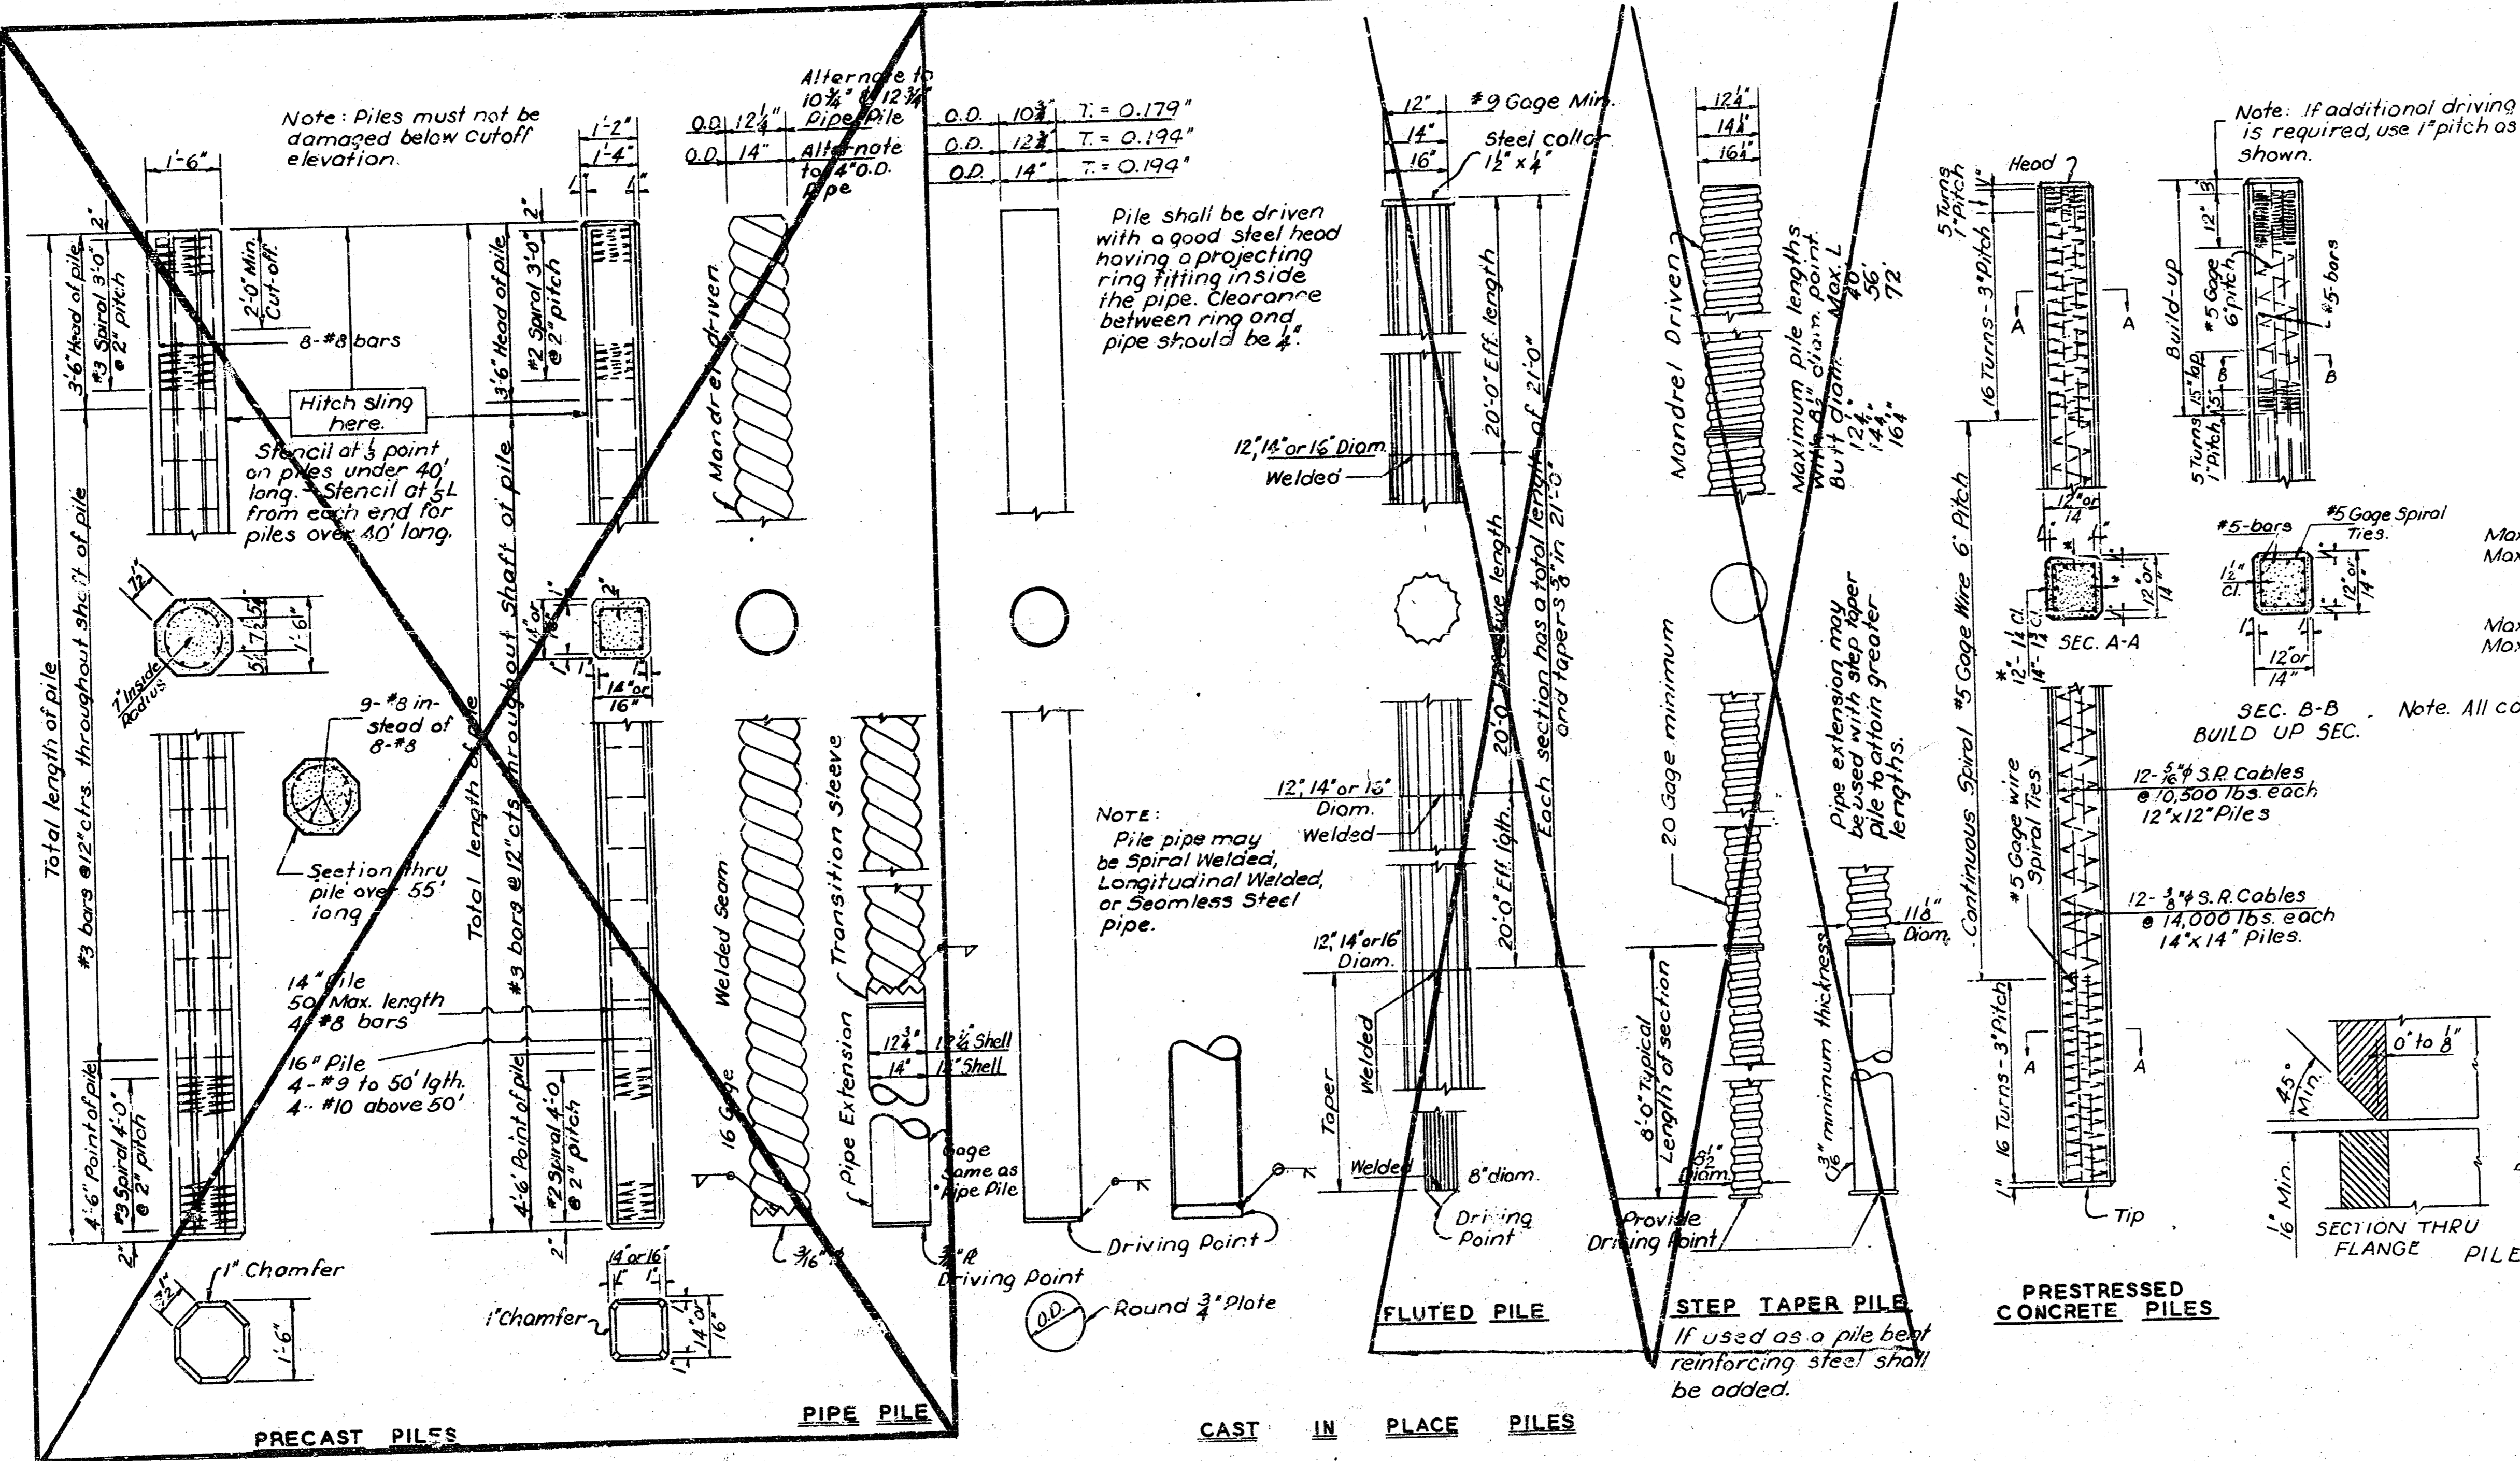

12" x 12" Piles
 Max. length - 50' Single Point Pick-up.
 Max. length - 75' Double Point Pick-up.

14" x 14" Piles
 Max. length - 60' Single Point Pick-up.
 Max. length - 85' Double Point Pick-up.

PILE		EQUIVALENT CONCRETE PILES	
STEEL PILE	PRECAST PILE	PIPE	FLUTED SHELL
108P47	10 3/4"	12"	12"
128P47	12 3/4"	14"	14"
148P47	14 3/4"	16"	16"

PIPE		EQUIVALENT CONCRETE PILES	
PIPE	PRECAST PILE	PIPE	FLUTED SHELL
10 3/4"	14"	12 1/2"	12 1/2"
12 3/4"	16"	14 1/2"	14 1/2"
14 3/4"	18"	16 1/2"	16 1/2"

12. Splices
 Splice details for cast-in-place or prestressed concrete piles shall be made in accordance with the manufacturers' recommendations, subject to the approval of the Engineer. Splice details for steel piles shall be in accordance with the details shown on this sheet.

13. Driving Formula
 Piles shall be driven to the minimum bearing value as specified on the Construction Layout as determined by the driving formula stipulated in the Specifications.

14. Mill Test Reports
 Notarized mill test reports, in triplicate, shall be furnished by the contractor for all steel pile and cast-in-place pile shells.

15. Payment
 Payment for all piles will be made as set forth in the specifications.

General Notes

1. Specifications
 Standard Specifications for State Road and Bridge Construction as currently used by State Highway Commission of Kansas.

2. Choice of Piles
 Where Piles are specified, the contractor may elect to use either the steel pile specified on the footing plans or the equivalent precast concrete, cast-in-place concrete or prestressed concrete pile shown in the table on this sheet. Where Concrete Piles are specified the Contractor may elect to use either the size and type concrete pile specified on the footing plans or the equivalent precast concrete, cast-in-place concrete or prestressed concrete pile shown in the table on this sheet. Other types of concrete piles not shown here are subject to the approval of the Engineer. Prestressed concrete piles, Helical corrugated pipe shell or Step taper piles shall not be used for abutments without expansion joints on bridges more than 120 ft. long.

3. Concrete
 All concrete for Precast and Cast-in-place shall be Class 'A' fc' = 3000 p.s.i. Concrete for Prestressed piles shall be Class AAA fc' = 4000 p.s.i.

4. Reinforcing Bars
 Reinforcing Bars shall be new billet steel of intermediate grade, without exception. Hoops and spirals may be either plain or deformed bars.

5. Precast Piles
 Precast piles shall conform to the requirements of Sub-Section G1-7.

6. Cast-in-Place Shells
 A. Pile shells shall have a minimum thickness as follows:
 1. Piles driven without mandrel - Use gages or thicknesses shown above, except Fluted pile use No. 9 gage minimum.
 2. Piles driven with mandrel shell shall be of sufficient strength and thickness to withstand driving without injury and to resist harmful distortion and/or buckling due to soil pressure after being driven and the mandrel removed.
 B. The contractor shall maintain on the job at all times prior to and during the filling of the shells, a light suitable for their inspection.
 C. Improperly driven, broken or otherwise defective shells shall be removed and replaced or otherwise corrected to the satisfaction of the Engineer by removal and replacement, or the driving of an additional pile at no extra cost.

7. Steel Piles
 Steel pile material shall meet the requirements of ASTM A7.

8. Pile Points
 All Cast-in-place piles except mandrel driven piles shall be equipped with a steel driving point of minimum thickness. Driving points shall be mill welded to the pile. Steel piles shall have a square cut end only. No driving point is required.

9. Welding
 All field welding shall meet the requirements of Article G1-6 specifications.

10. Paint
 Shall comply with the Kansas Standard Specifications, 1960 Edition.

11. Test Piles
 Test piles shall be driven where called for on the Bridge plans. All test piles shall be located so that they will become part of the Bridge pile system.



NO.	DATE	REVISIONS	BY	APP'D.
4	4-8-62	Add Longitudinal Welded Pipe pile	J.C.L.	T.W.O.
3	12-2-61	Revise Choice of Pile note, etc.	J.C.L.	T.W.O.
2	9-27-61	Revise Pipe Pile General Note	J.C.L.	T.W.O.
1	1-24-61	Remove hole in Prestressed Conc. Pile	J.C.L.	T.W.O.

STATE HIGHWAY COMMISSION OF KANSAS

STANDARD PILE DETAILS

STD. NO. 102

SHEET NO. OF SCALE APP'D. DESIGNED BY QUANTITIES TRACKED DESIGN CR. DETAIL CR. QUAN. TA. TRACE CR.

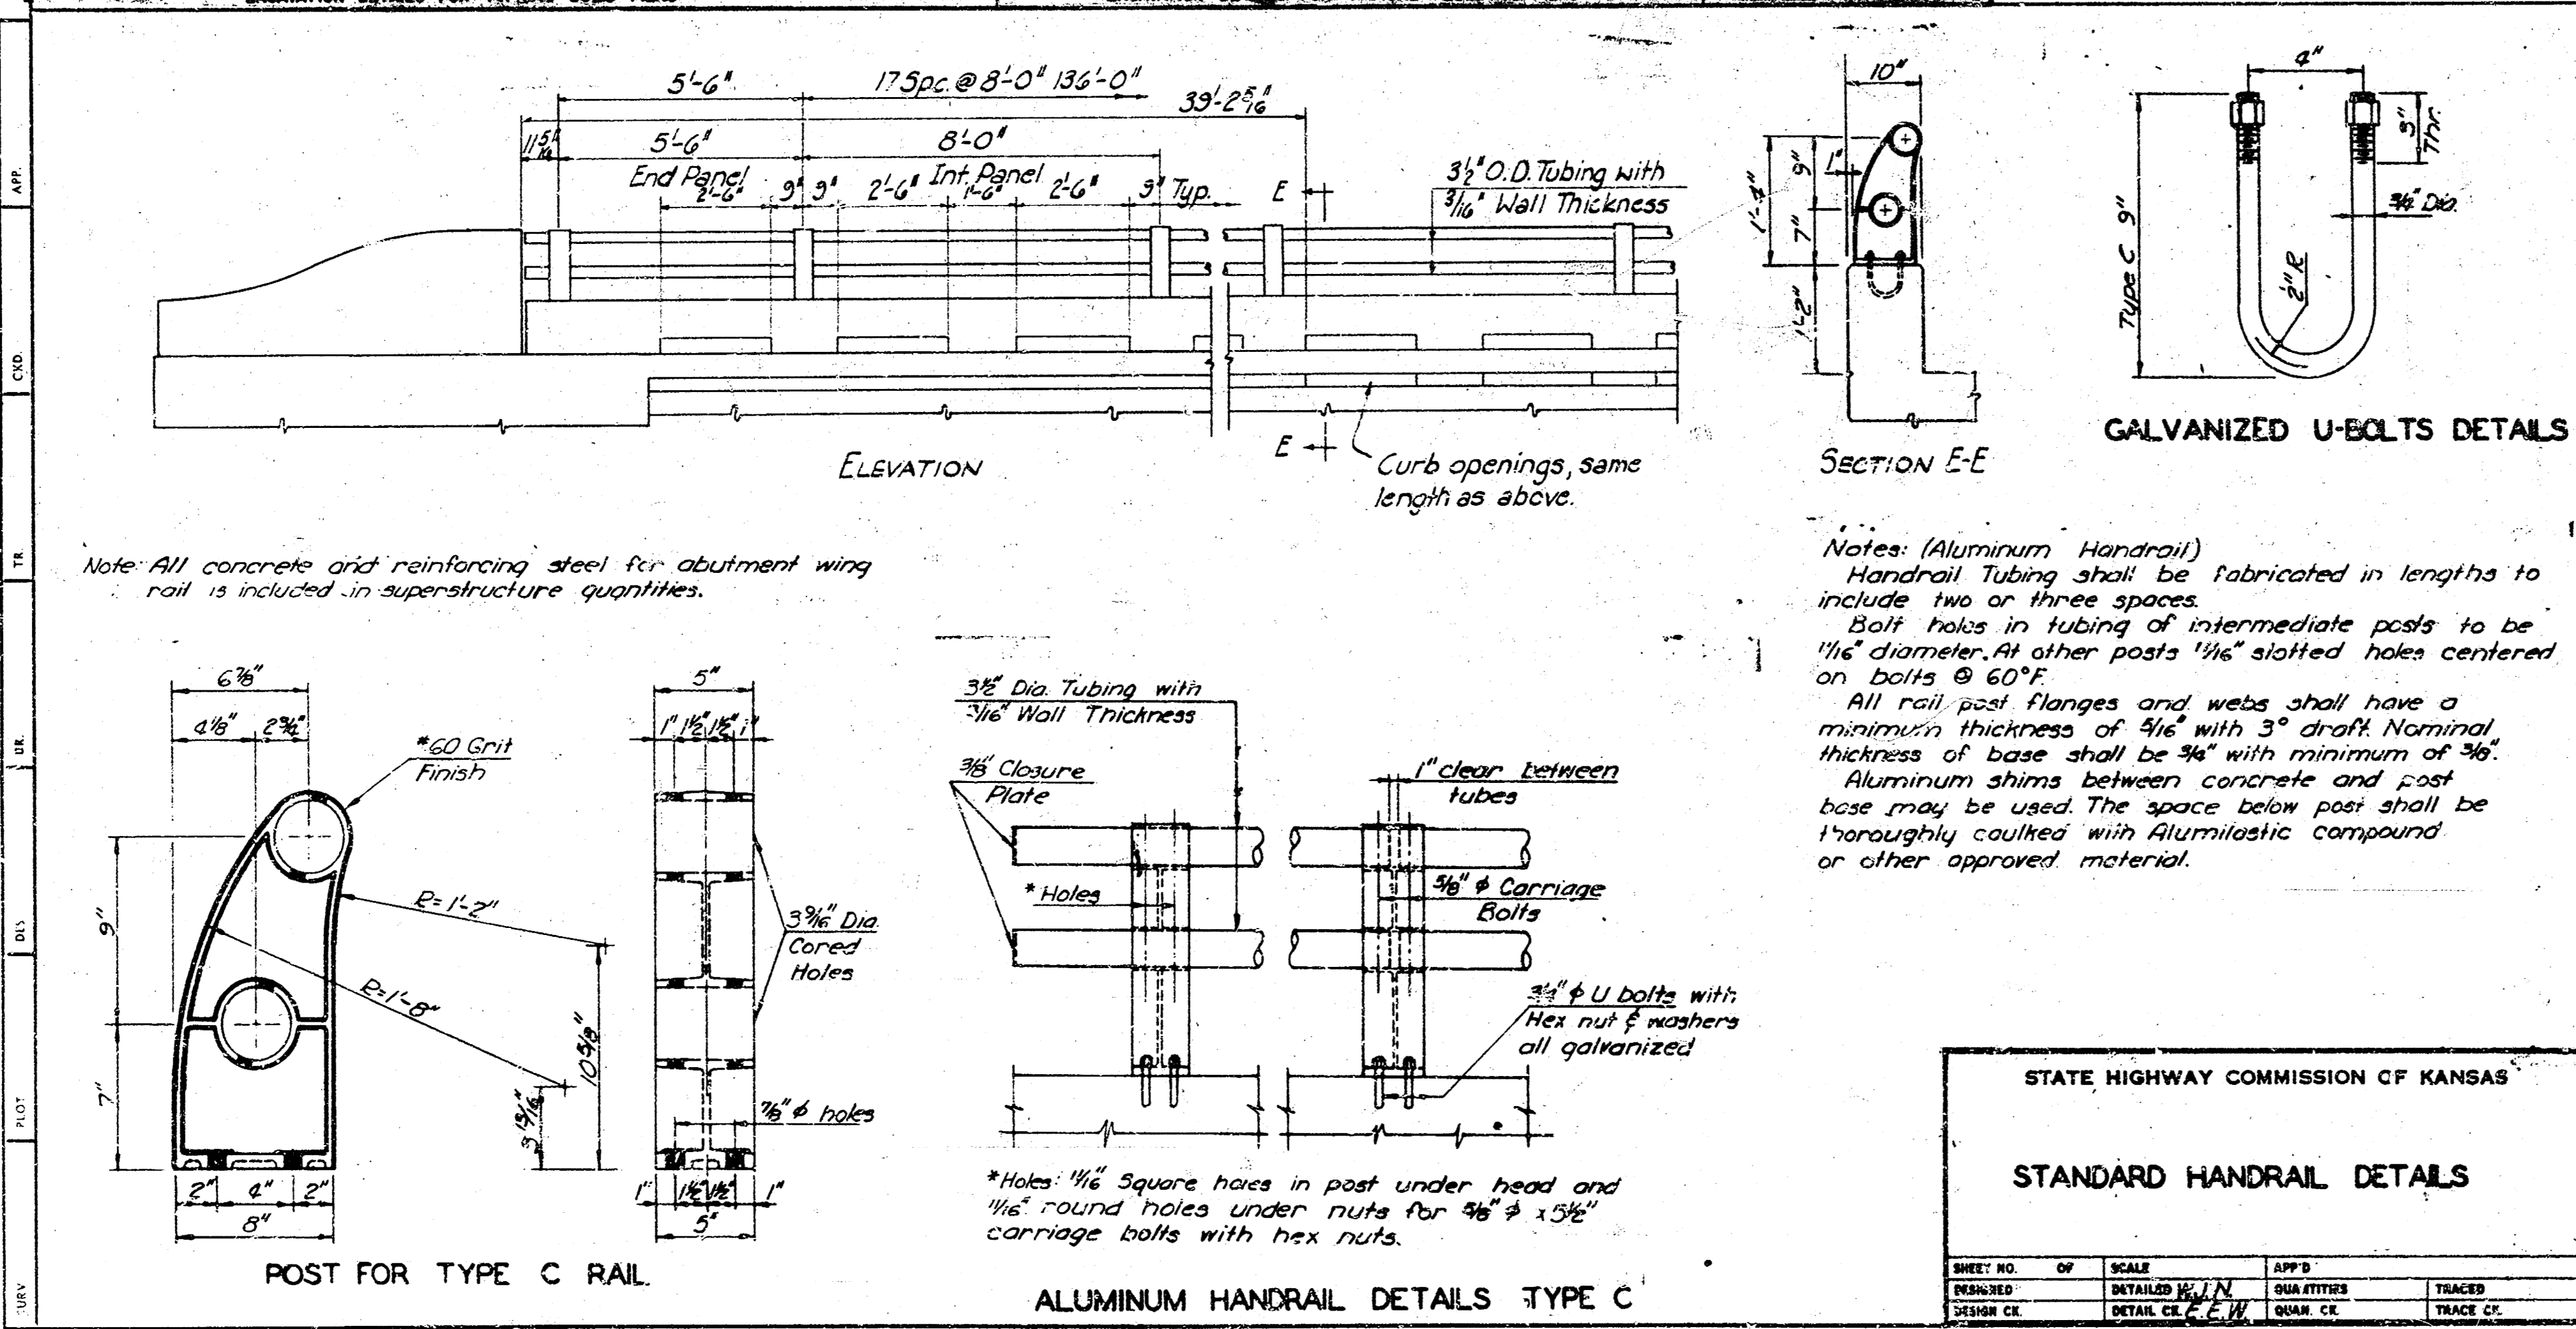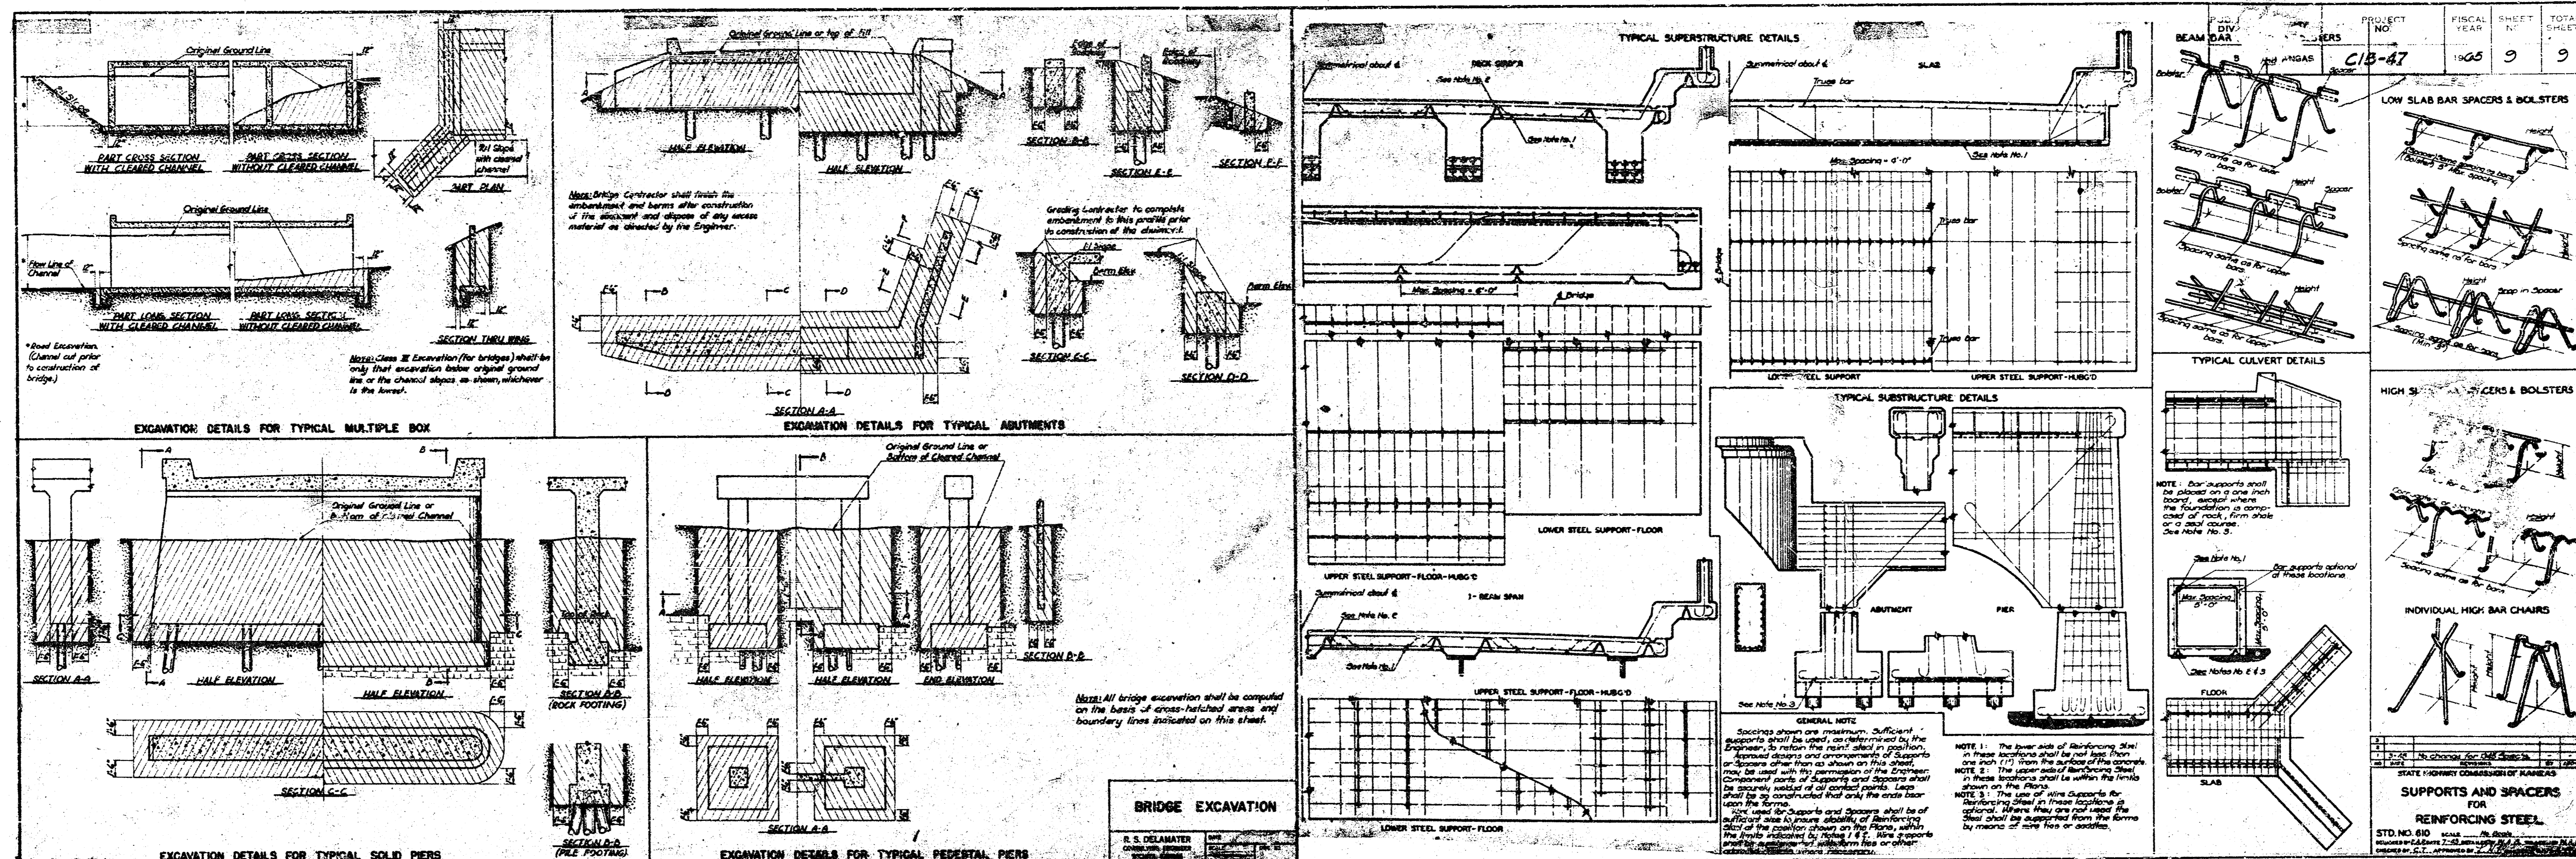

SUMMARY OF BRIDGE QUANTITIES

Item	Abut. #1	Pier #1	Pier #2	Abut. #2	Superst.	Total	Unit
Excavation, Class III	57				57	114	Cu. Yds.
Class AAA (AE) Conc.					248.7	248.7	Cu. Yds.
Class A (AE) Conc.	33.9	17.8	17.8	33.9		103.4	Cu. Yds.
Reinforcing Steel	4,550	2,570	2,570	4,550	50,950	65,190	Lbs.
Prestress'd Conc. Beams					33	33	Each
Aluminum Handrail					294.0	294.0	Lin. Ft.
Steel Piles 10"	550				528	1,078	Lin. Ft.
Prestress'd Conc. Piles 14"		500	500			1,000	Lin. Ft.

SUMMARY OF GRADING QUANTITIES

Item	Quan.	Unit
Common Excavation	18,900	Cu. Yds.
Compacted Embankment	10,200	Cu. Yds.
Removal of Exist. Structure	L.S.	L.S.

STATE HIGHWAY COMMISSION OF KANSAS

STANDARD HANDRAIL DETAILS

Sheet No. 1 of 1
 Project: Pawnee Avenue Bridge Over Sypsum Creek
 Design: R. S. Delamater
 Date: August, 1965

CITY OF WICHITA, KANSAS
 B. F. SMITH, CITY ENGINEER

PAWNEE AVENUE BRIDGE OVER
 SYPSUM CREEK
 BAR SUPPORTS, BR. EXC., HANDRAIL

SUMMARY OF QUANTITIES

R. S. DELAMATER
 CONSULTING ENGINEER
 WICHITA, KANSAS

DATE August, 1965
 SCALE 1/8" = 1'-0"

79-M-9