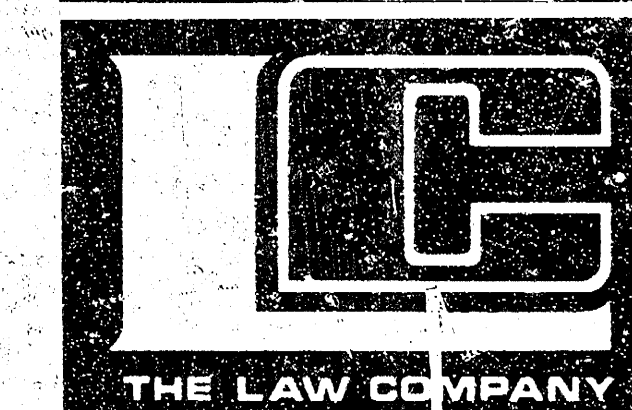



- NOTE:
1. SALES TAXES AND INSTALLATION TO CONFORM TO
11-11-11 NICHITA STANDARDS AND SPECIFICATIONS.
2. CONTRACTOR TO REMOVE AND REPLACE CONCRETE
RIPRAP AS NECESSARY.
3. CONTRACTOR TO NOTIFY RAILROAD CO. AND COUNTY
ENGINEER, 48 HOURS PRIOR TO THE CROSSING
OF RAILROAD OR COUNTY ROAD.
4. CONTRACTOR TO HAVE MANAGEMENTS WITH COUNTY
FOR TEMPORARY STOP-AND-CLIPPING ROAD. CONTRACTOR
TO REPAIR PAVEMENT PER DETAIL SHOWN
BEFORE AND TO THE SATISFACTION OF THE COUNTY
ENGINEER.
5. MANHOLE RING AND COVERS SHALL BE CITY OF NICHITA
STANDARD.
6. MANHOLE STEPS ARE NOT REQUIRED.
7. CONTRACTOR SHALL NOT OPEN OUT INVERT OF 12"
SEWER AT STA. 0+00 UNTIL APPROVED BY CITY.

[illegible]

FOR CONSTRUCTION: JAN 14 1972

[illegible]

CALVIN KINGDON BERGER | P.A. | 312 S. MARKET
WICHITA, KANS. 67202
PHONE 316/285-5554
ARCHITECTS & ENGINEERS

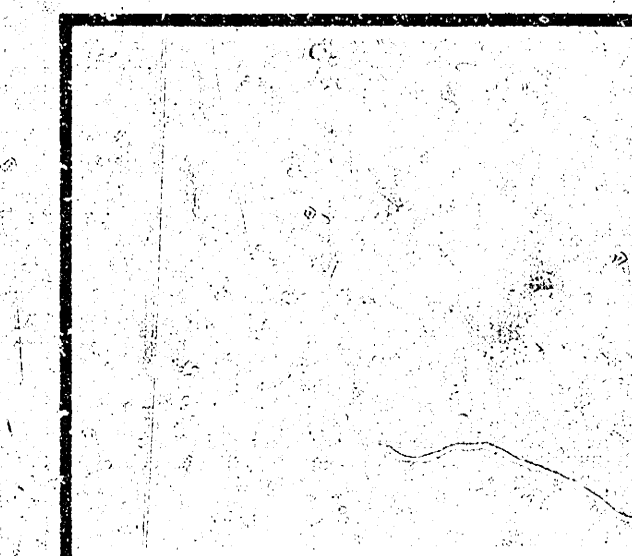

DRAWN		CHECKED	
R. DUTTON		RDF	

RELATED DRAWINGS	
SHELL	
DETAILS	
STRUCTURE	
MECHANICAL	
ELECTRICAL	
OTHER	

3A OF 28 SHEETS

MANUFACTURING FACILITIES
FOR
DE BOER BUILDING
SYSTEMS CORP. INC.
WICHITA, KANSAS
PROJECT NUMBER 103

KEY PL. 2

TENANT SANITARY SEWER PLAN SHEET TITLE	
TENANT NUMBER	SHEET NUMBER SU 2 OF _____ SHEETS

AS BUILT 3-1-72
BANKED 3-3-72
© I-45 BY W.D.U.

TENANT:	
SHEET TITLE	
TENANT NUMBER	SHEET NUMBER 1 OF _____ SHEETS