


TWENTY-FIFTH STREET BRIDGE

OVER THE
LITTLE ARKANSAS RIVER
= NORTH WICHITA THRUWAY =
WICHITA, KANSAS

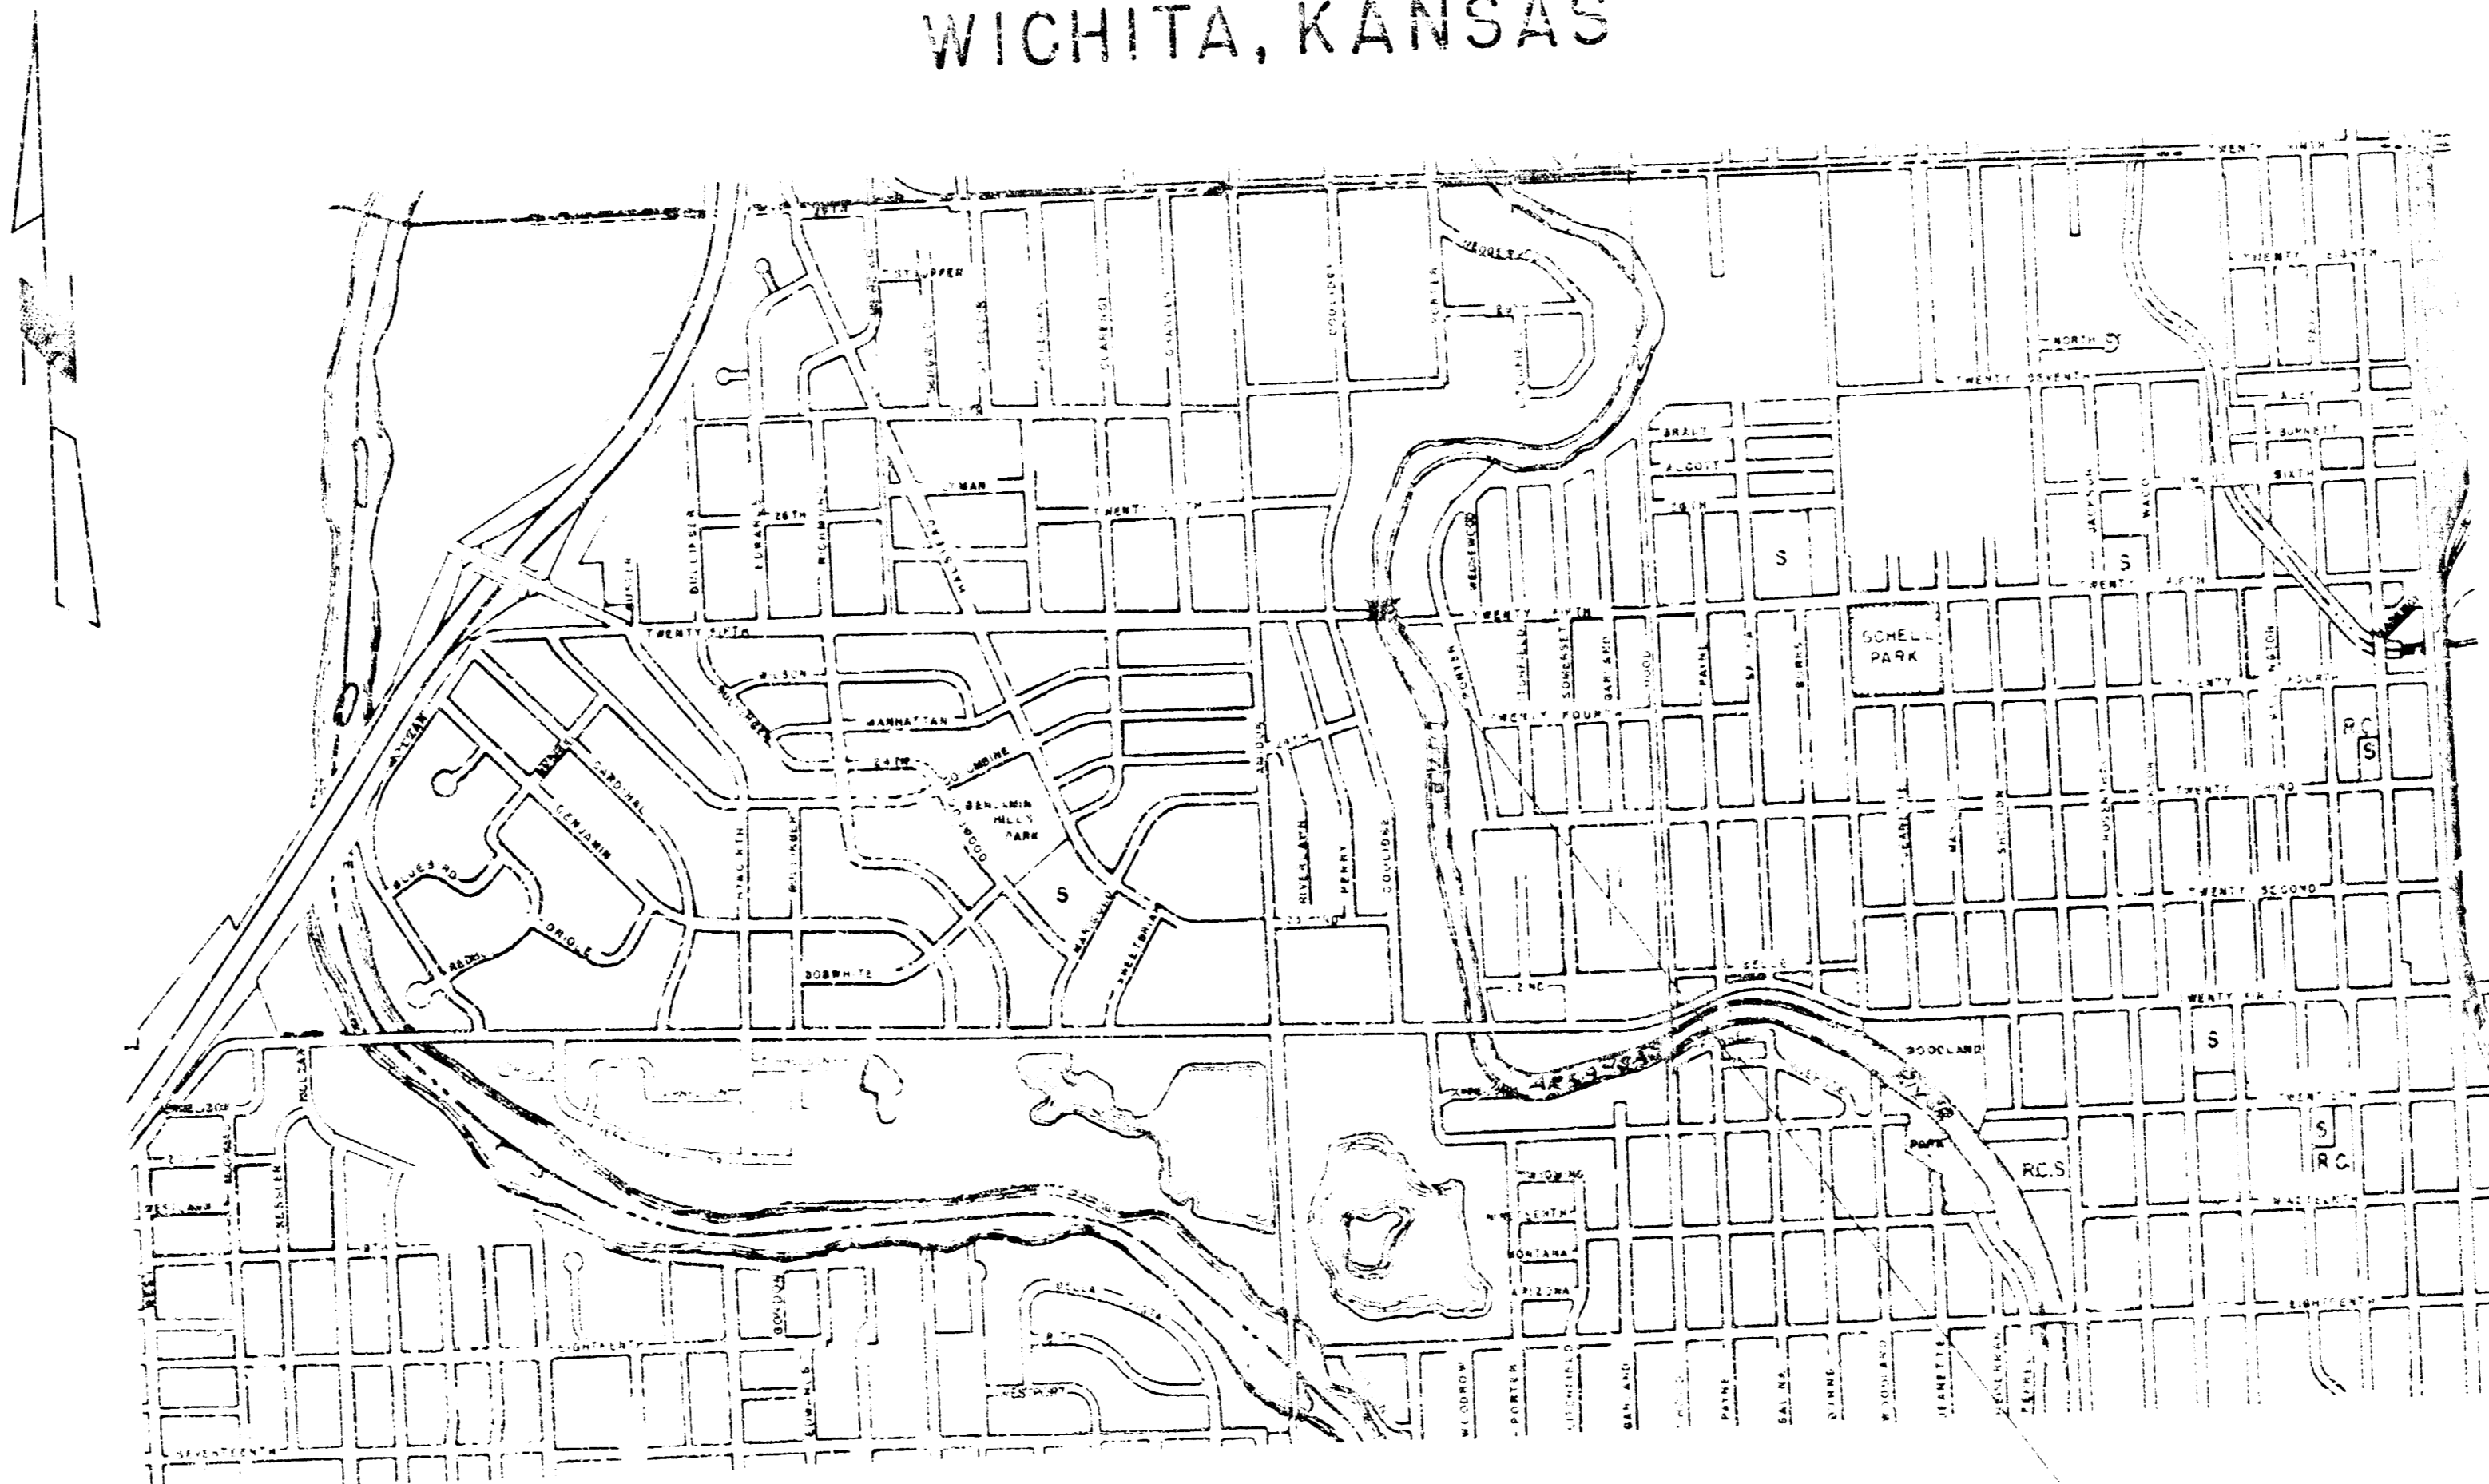

INDEX OF SHEETS


Sheet No. 1.	Title Sheet
" 2.	Contour Map
" 3.	Construction Layout
" 4.	Abutment Details
" 5.	Pier Details
" 6.	Superstructure Details
" 7.	Dock Section & Sidewalk Details
" 8.	Retaining Details
" 9.	Bar List
" 10.	Standard Pier Details
" 11.	Spur Supports, Bridge Excavation, Notes & Summary of Quantities


DEPARTMENT OF PUBLIC WORKS
CITY OF WICHITA
B. E. SMITH, CITY ENGINEER
PROJECT C16-37

PROJECT LOCATION

PLANS PREPARED BY
R. S. DELAMATER, CONSULTING ENGINEER
WICHITA, KANSAS
APRIL, 1957

Revised As Built, January, 1968

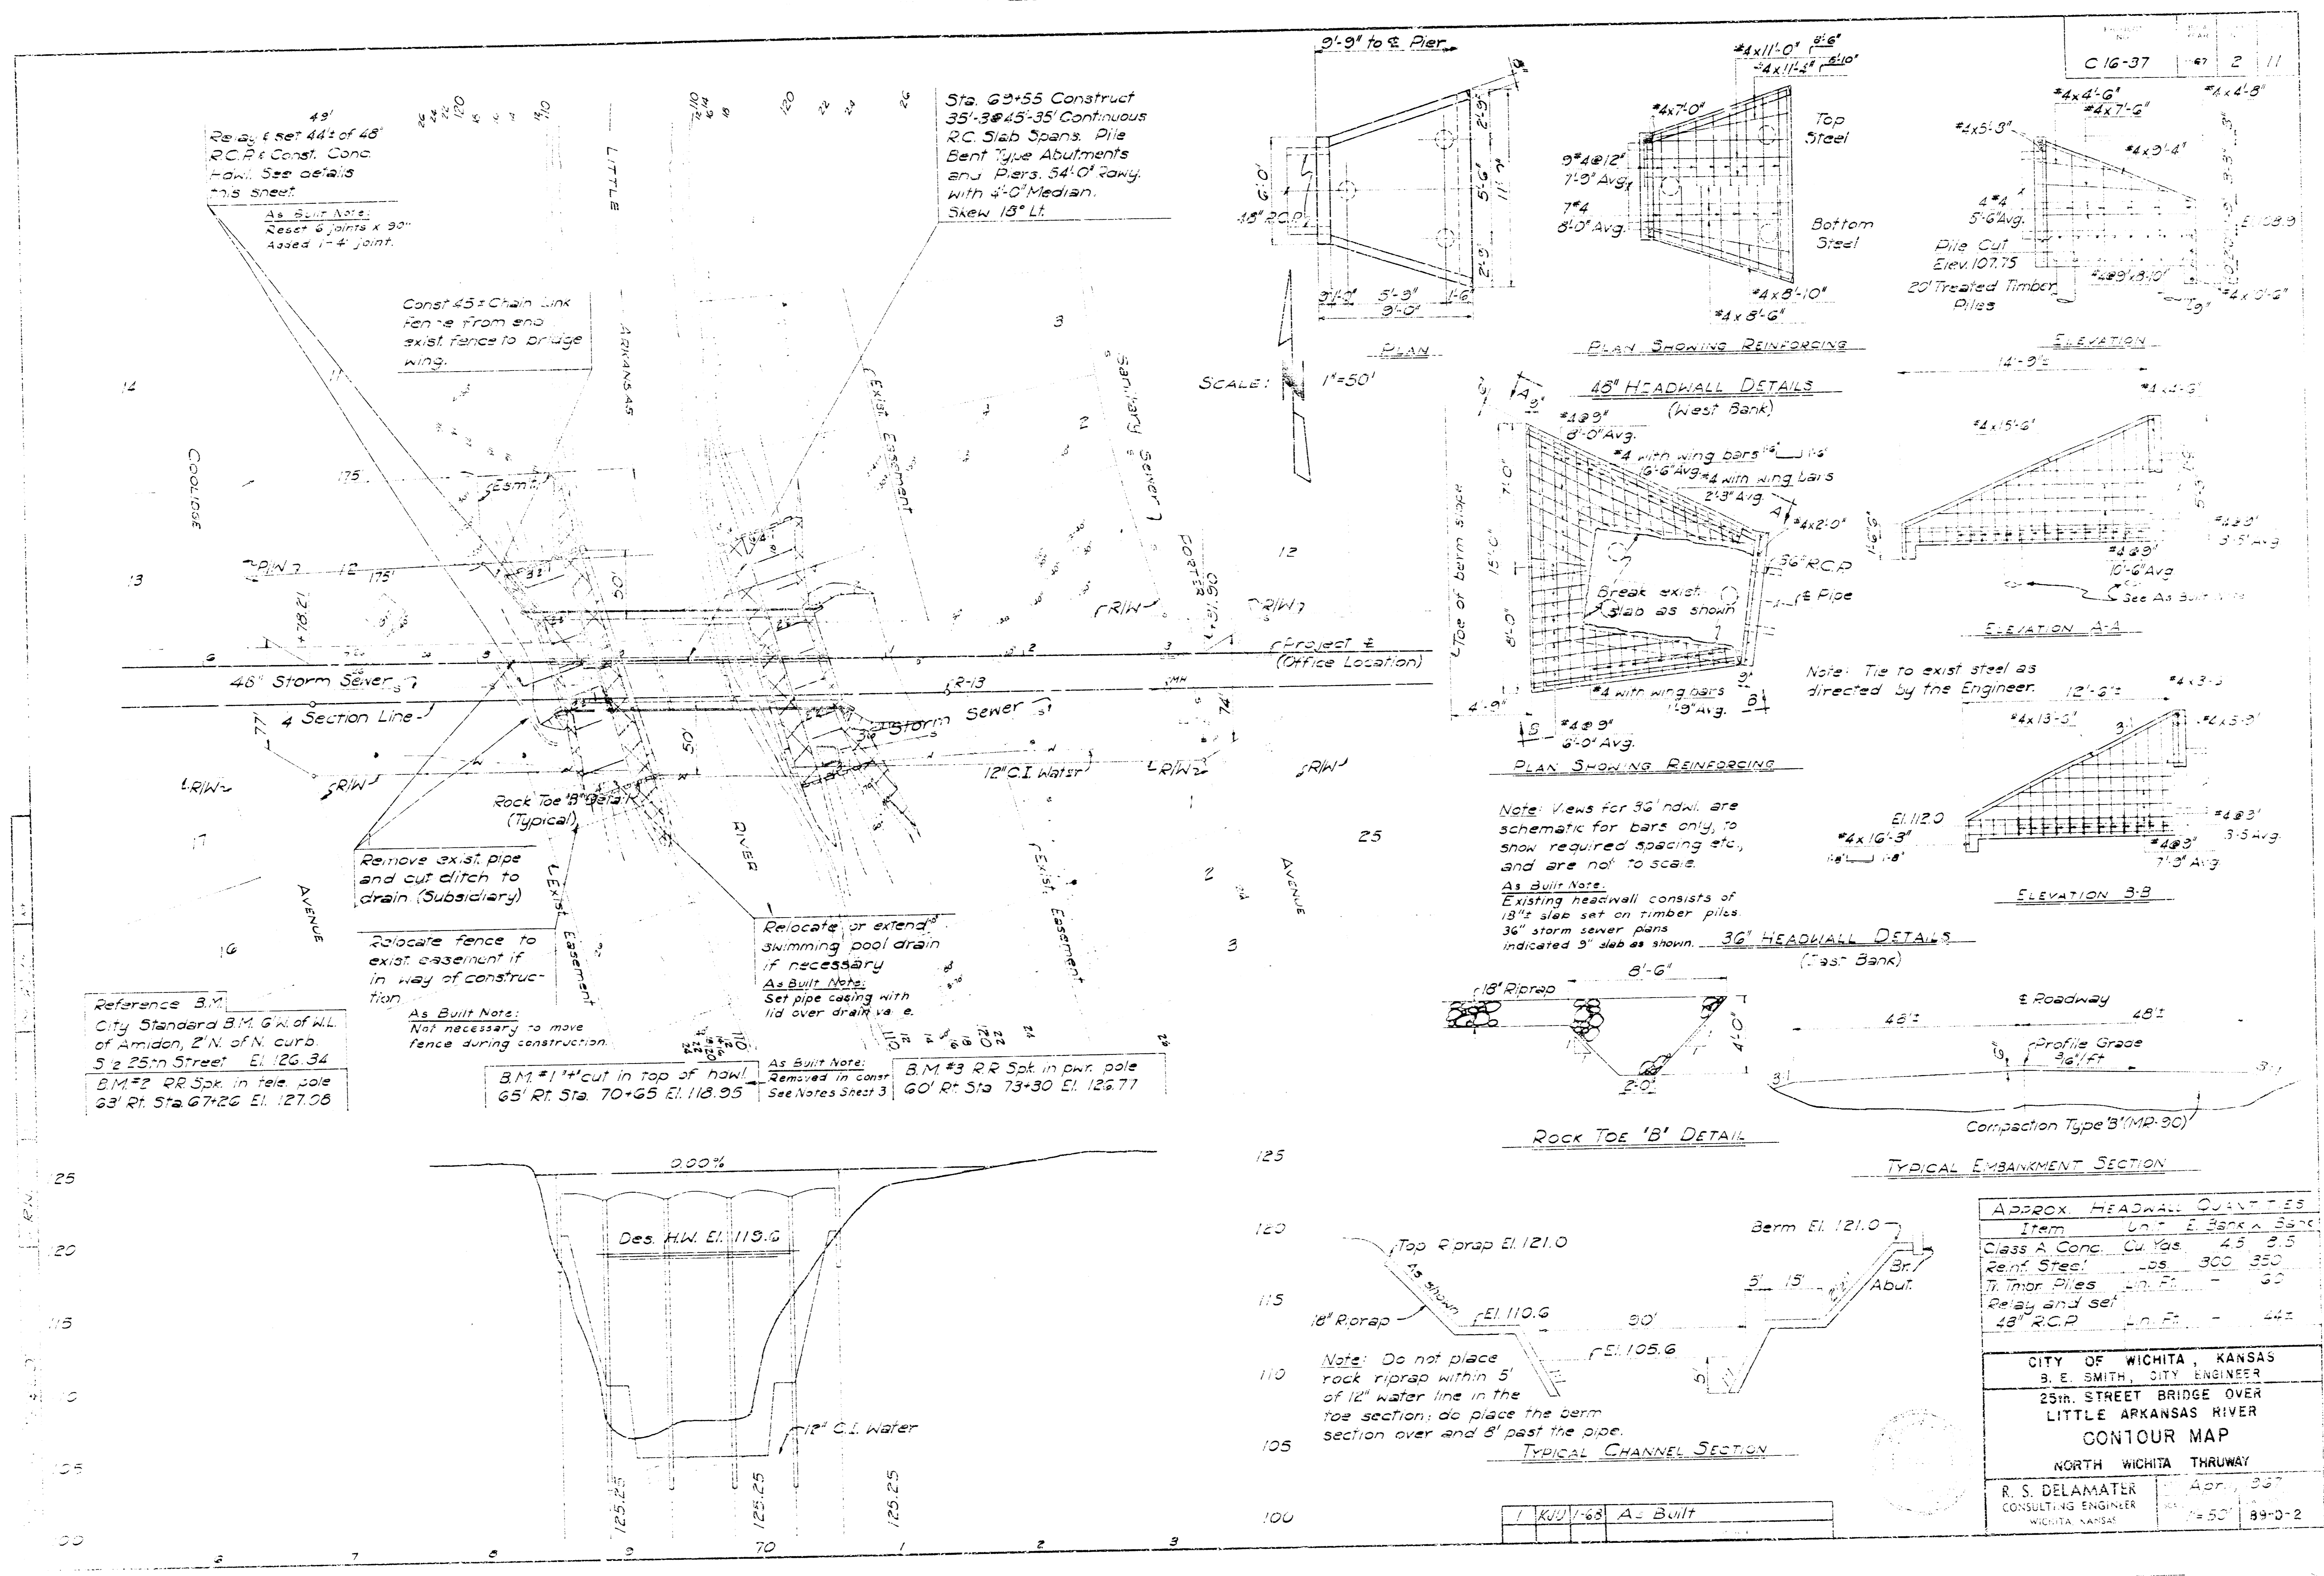


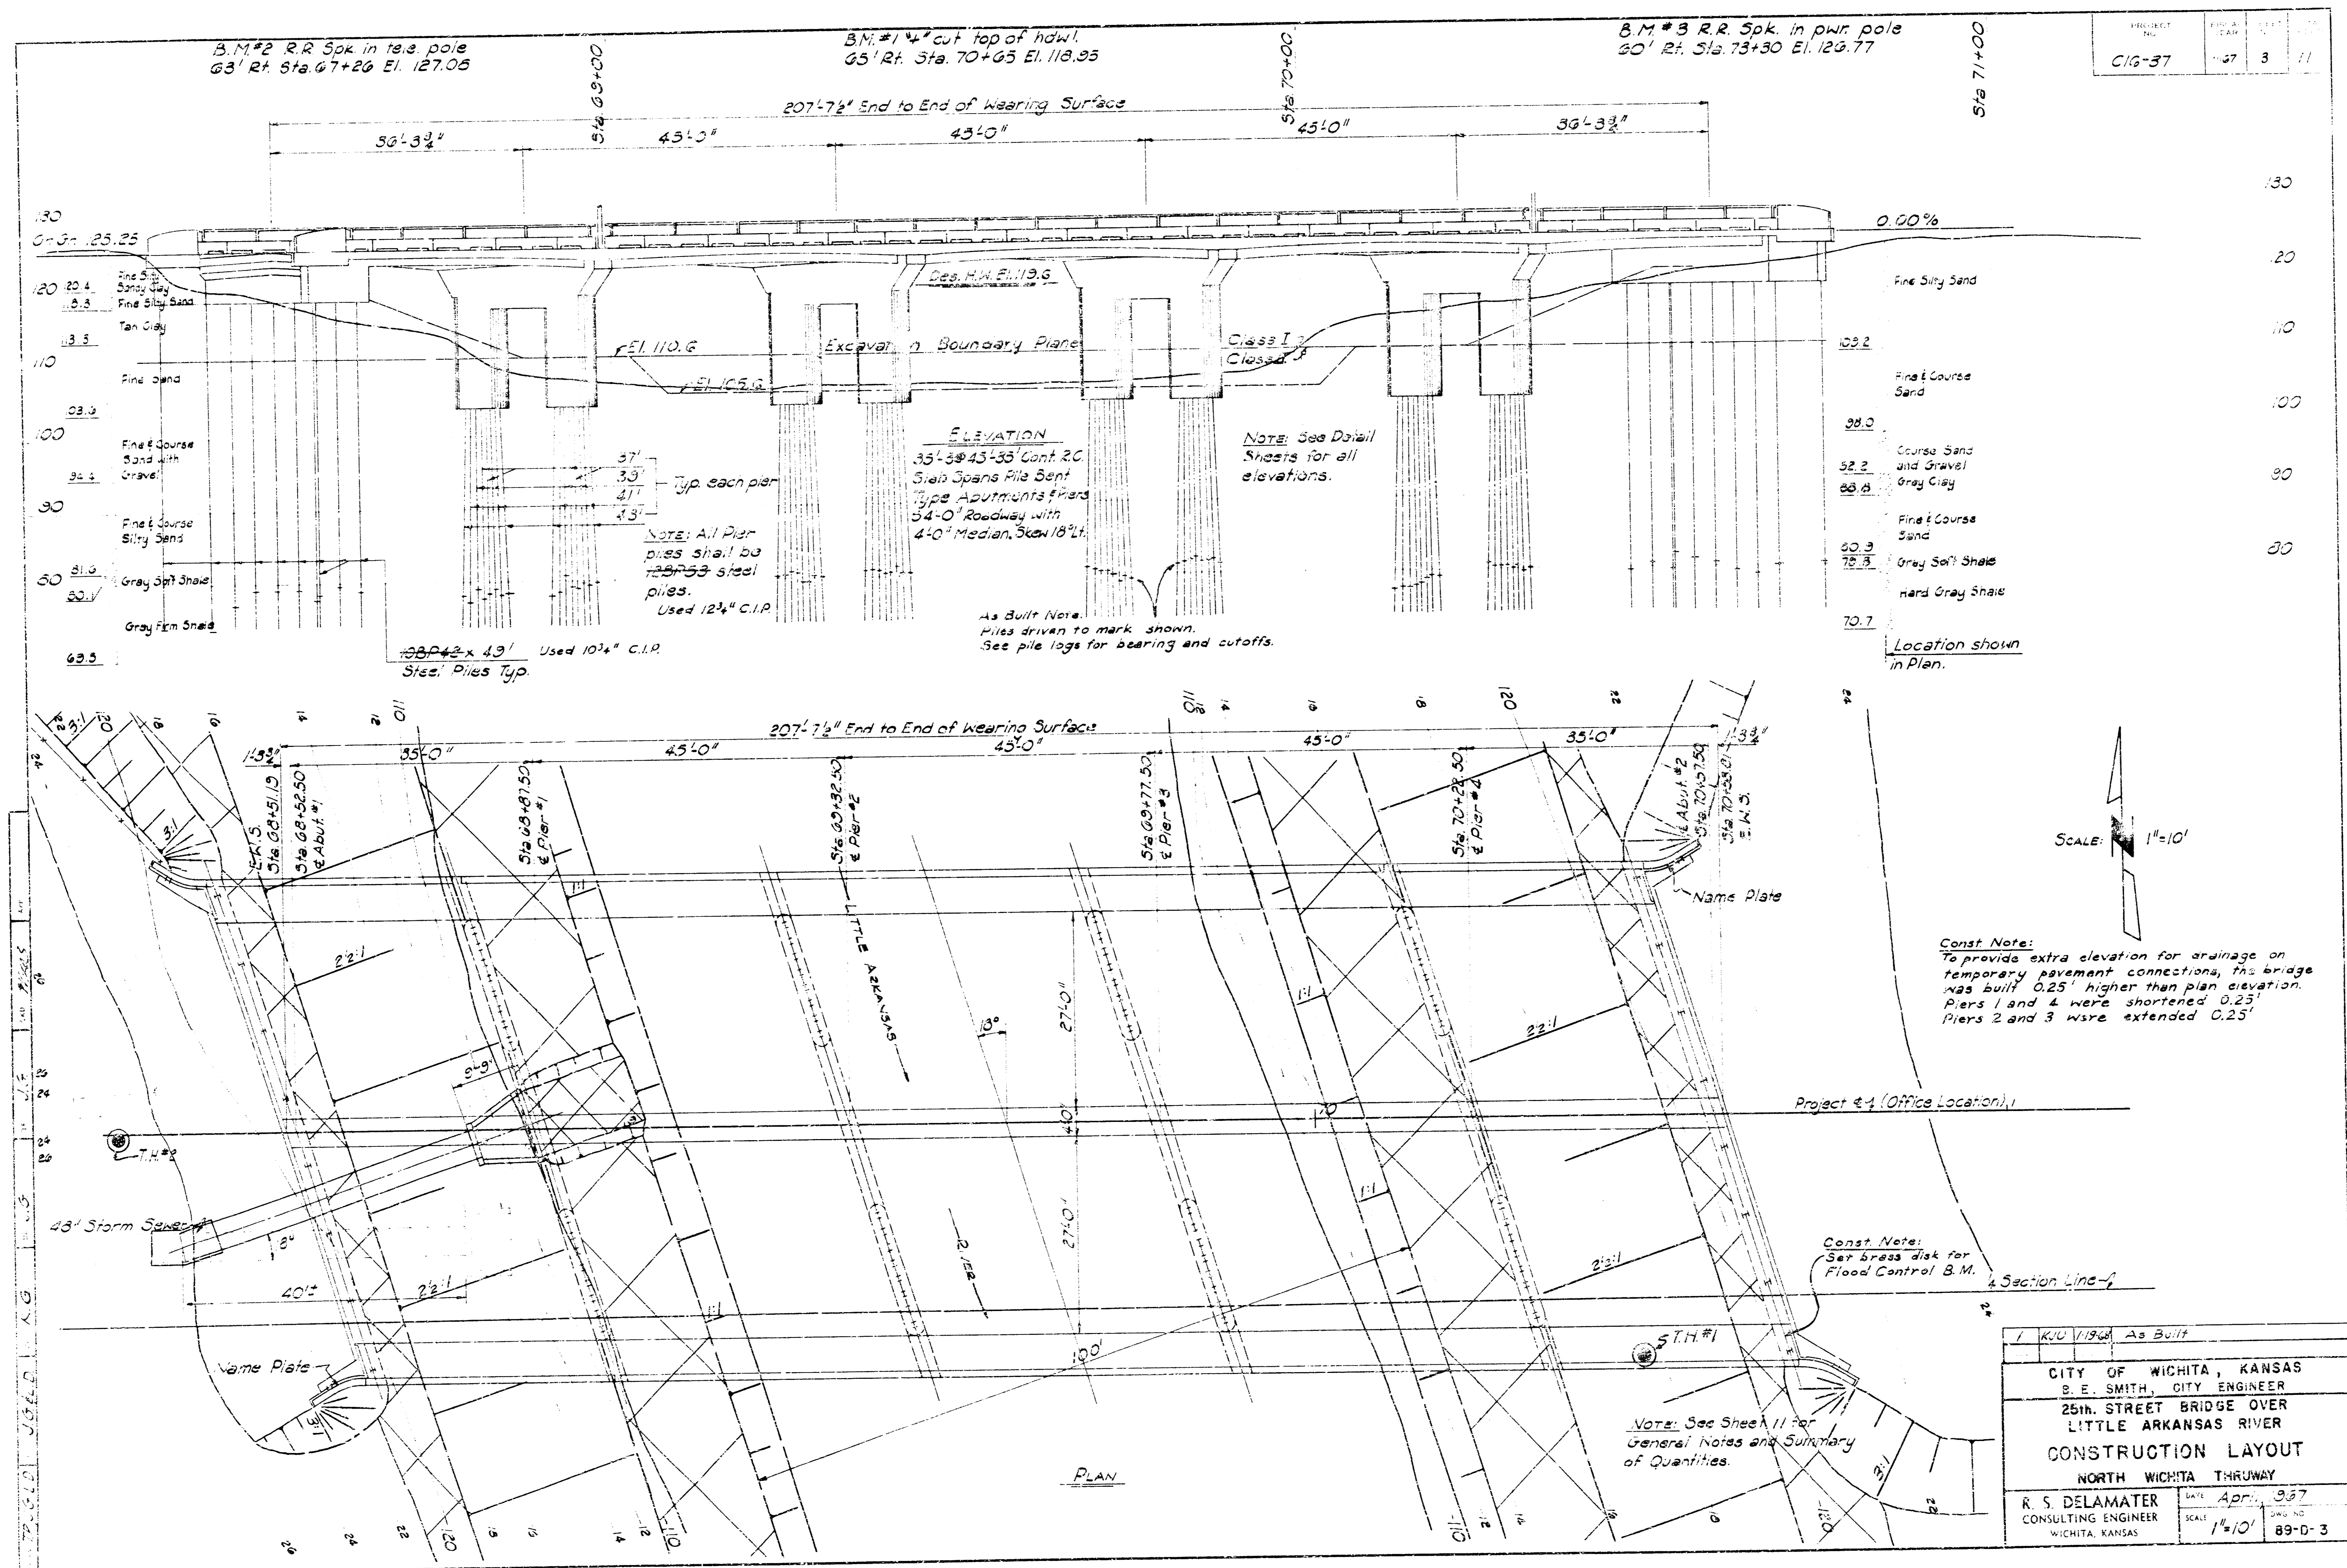

PROJECT No.	DATE	BY	CHKD.
C16-37	37	3	11

1 K10 1/1964 As Built	
CITY OF WICHITA, KANSAS	
B. E. SMITH, CITY ENGINEER	
25th STREET BRIDGE OVER	
LITTLE ARKANSAS RIVER	
CONSTRUCTION LAYOUT	
NORTH WICHITA THRUWAY	
R. S. DELAMATER	DATE: Apr. 37
CONSULTING ENGINEER	SCALE: 1"=10'
WICHITA, KANSAS	DWG. NO. 89-0-3

PROJECT NO.	FISCAL YEAR	SHEET NO.	TOTAL SHEETS
C/G-37	1967	4	11

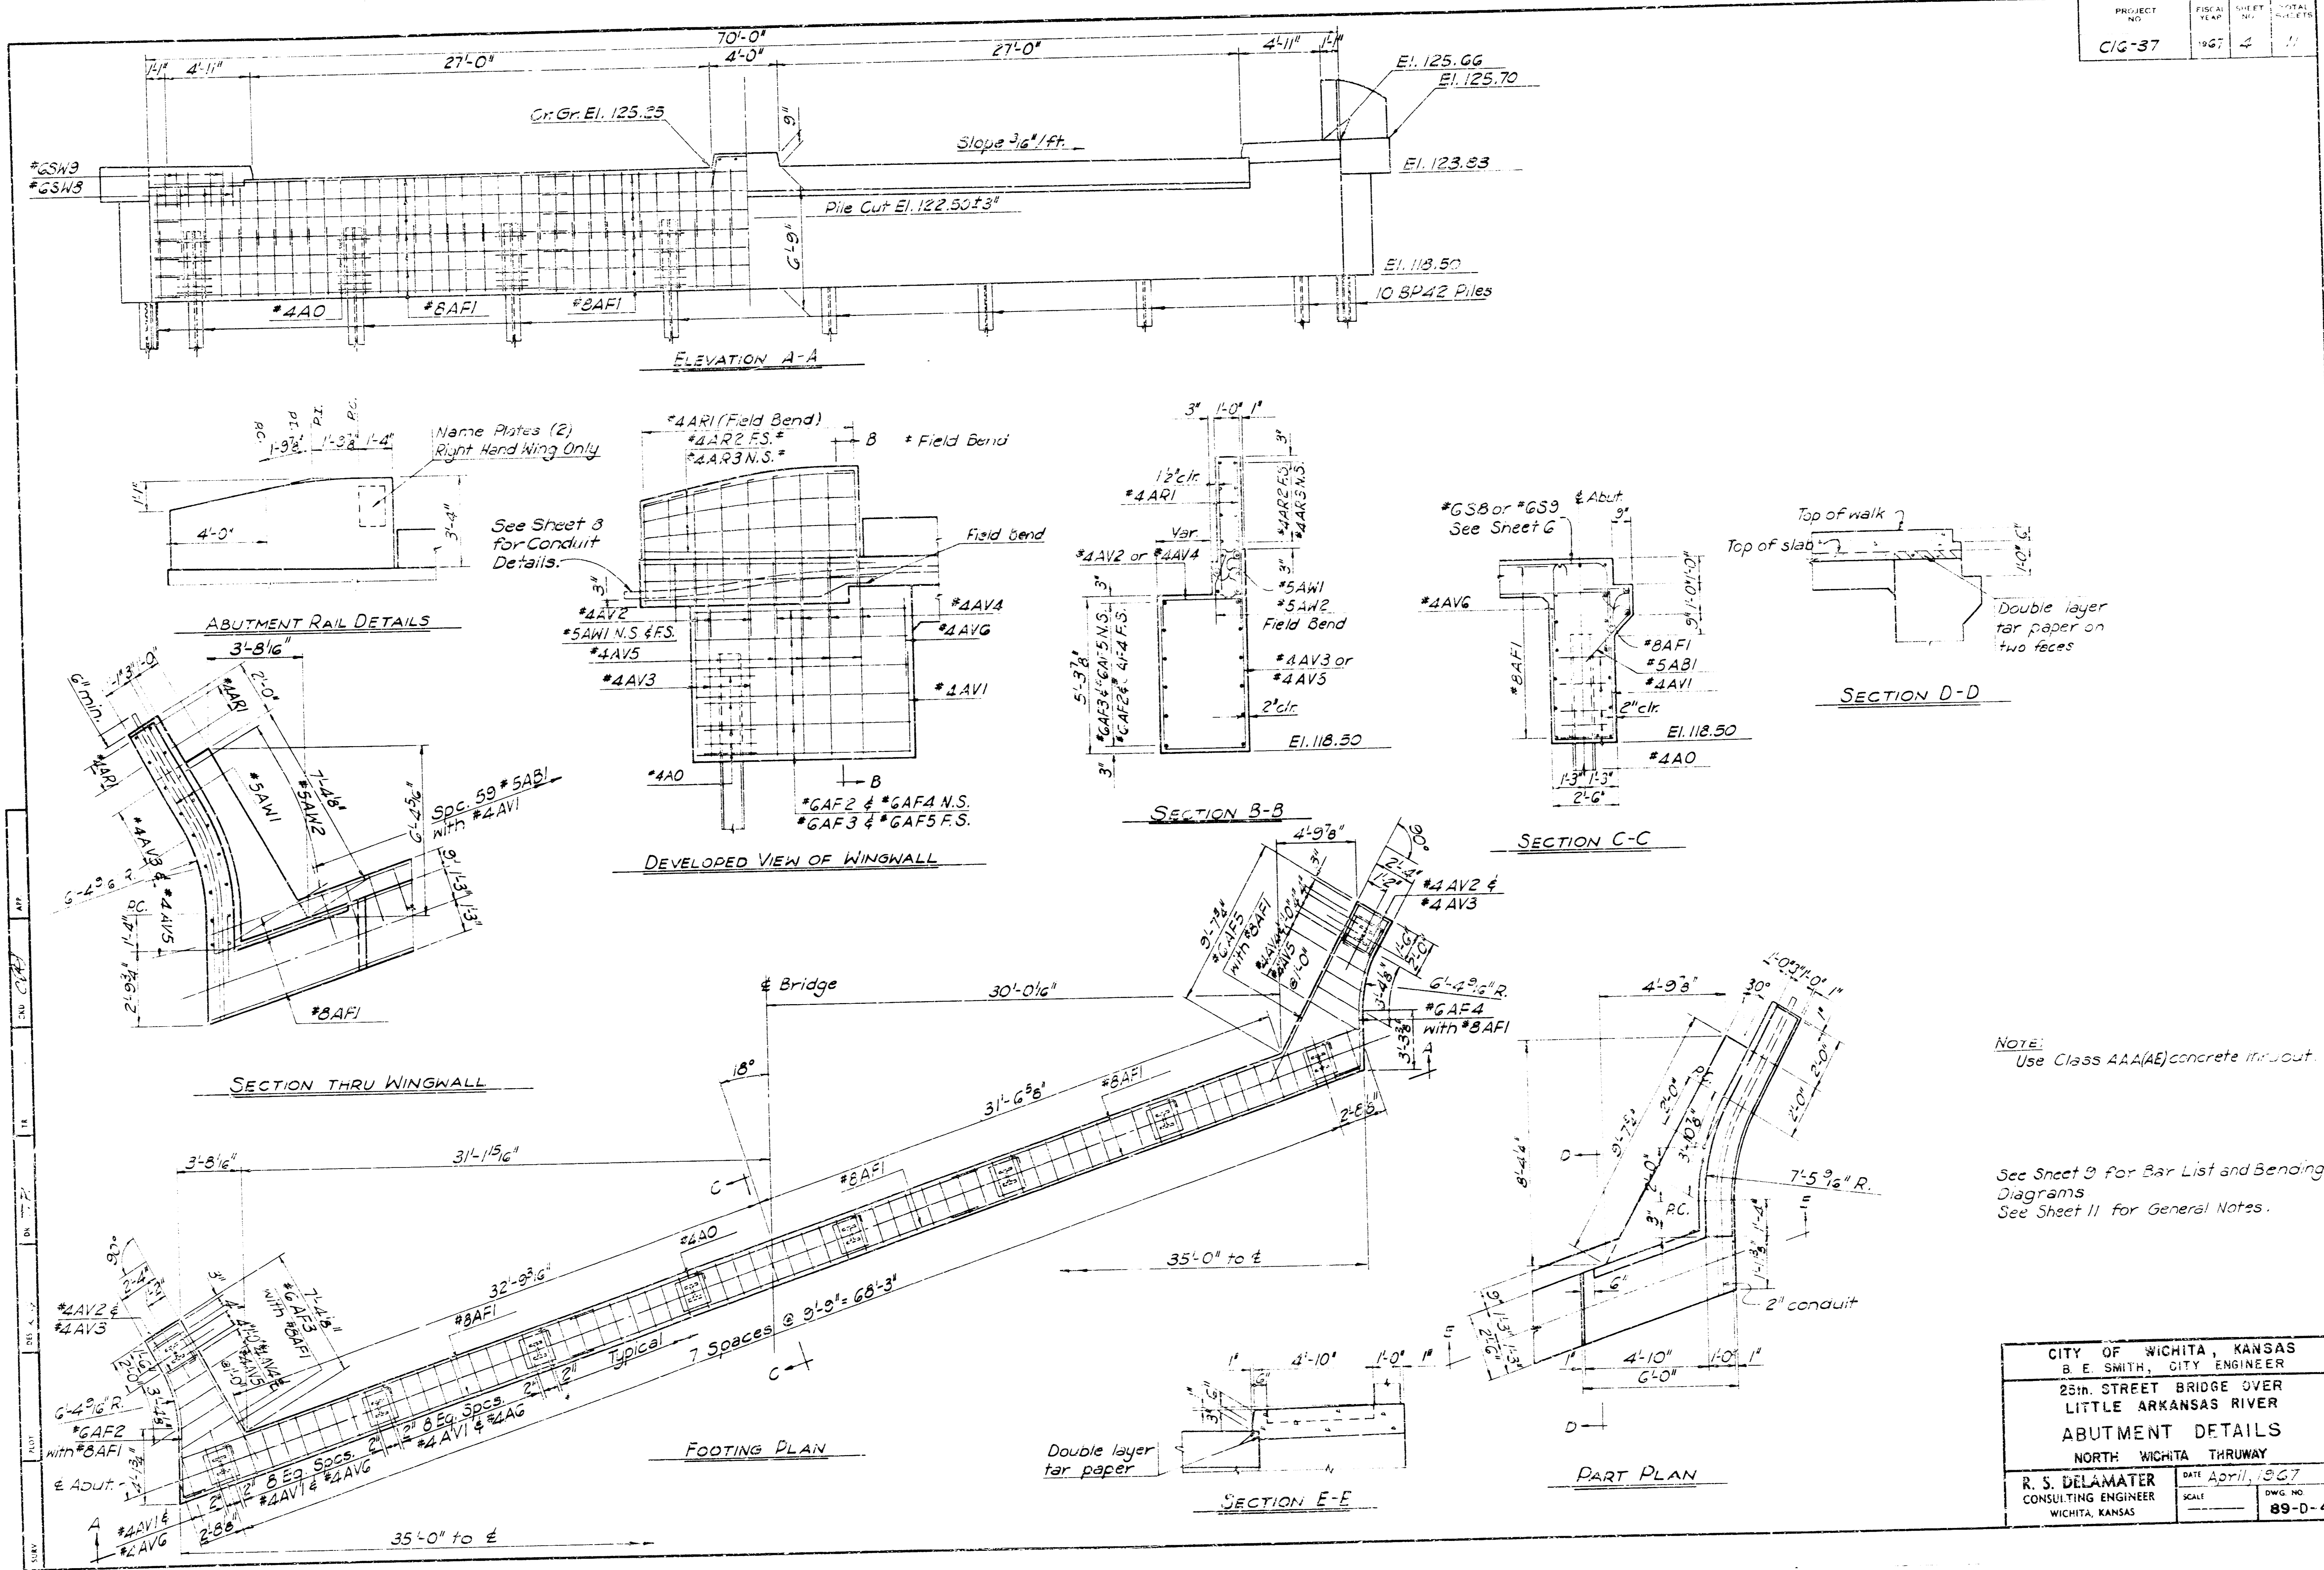


NOTE:
 Use Class AAA(AE) concrete throughout.

See Sheet 3 for Bar List and Bending Diagrams
 See Sheet 11 for General Notes.

CITY OF WICHITA, KANSAS B. E. SMITH, CITY ENGINEER	
25th STREET BRIDGE OVER LITTLE ARKANSAS RIVER	
ABUTMENT DETAILS	
NORTH WICHITA THRUWAY	
R. S. DELAMATER CONSULTING ENGINEER WICHITA, KANSAS	DATE April, 1967 SCALE _____ DWG. NO. 89-D-4

PROJECT NO.	ESCAL. YEAR	SHEET NO.	TOTAL SHEETS
CIG-37	1927	5	11

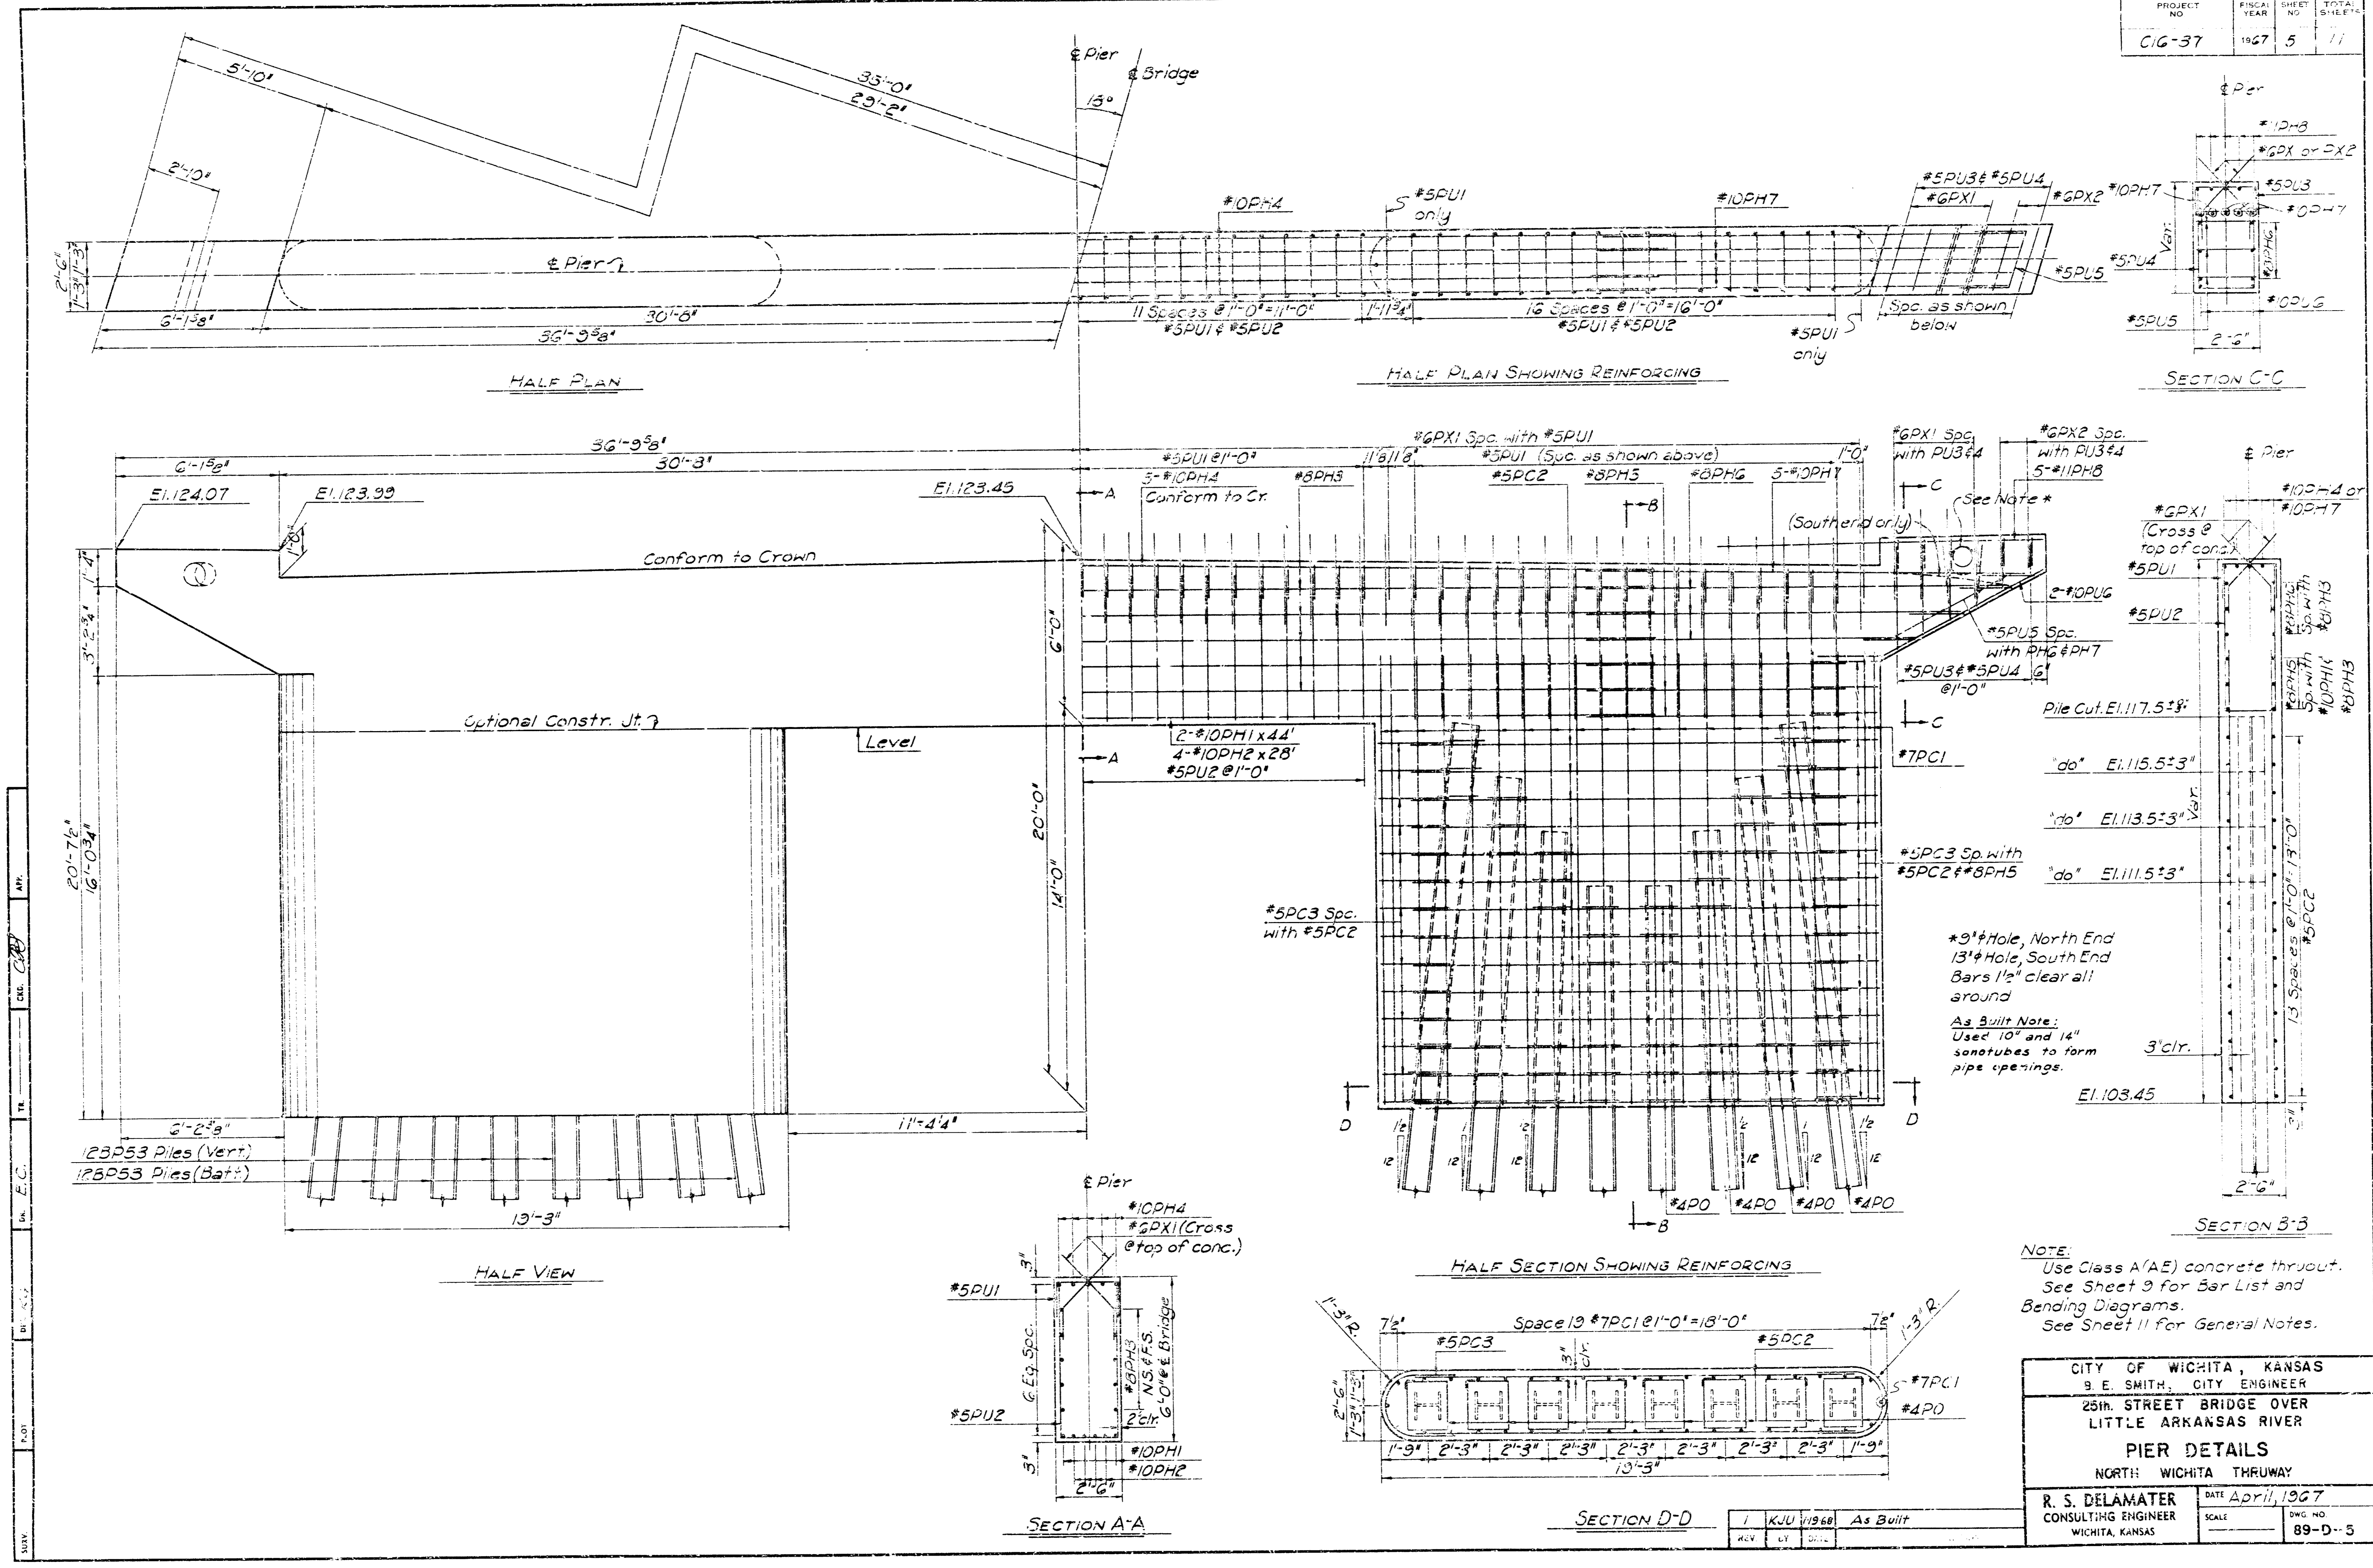


NOTE:
 Use Class A(AE) concrete thru-out.
 See Sheet 3 for Bar List and Bending Diagrams.
 See Sheet 11 for General Notes.

CITY OF WICHITA, KANSAS
 B. E. SMITH, CITY ENGINEER
 25th STREET BRIDGE OVER
 LITTLE ARKANSAS RIVER
PIER DETAILS
 NORTH WICHITA THRUWAY
 R. S. DELAMATER
 CONSULTING ENGINEER
 WICHITA, KANSAS
 DATE April, 1927
 SCALE _____
 DWG. NO. 89-D-5

1	KLU	1927	As Built
---	-----	------	----------







PROJECT NO.	FISCAL YEAR	SHEET NO.	TOTAL SHEETS
CIG-37	1927	6	11

NOTE:
See Sheet 7 for Deck Section,
Sidewalk and Curb Details.

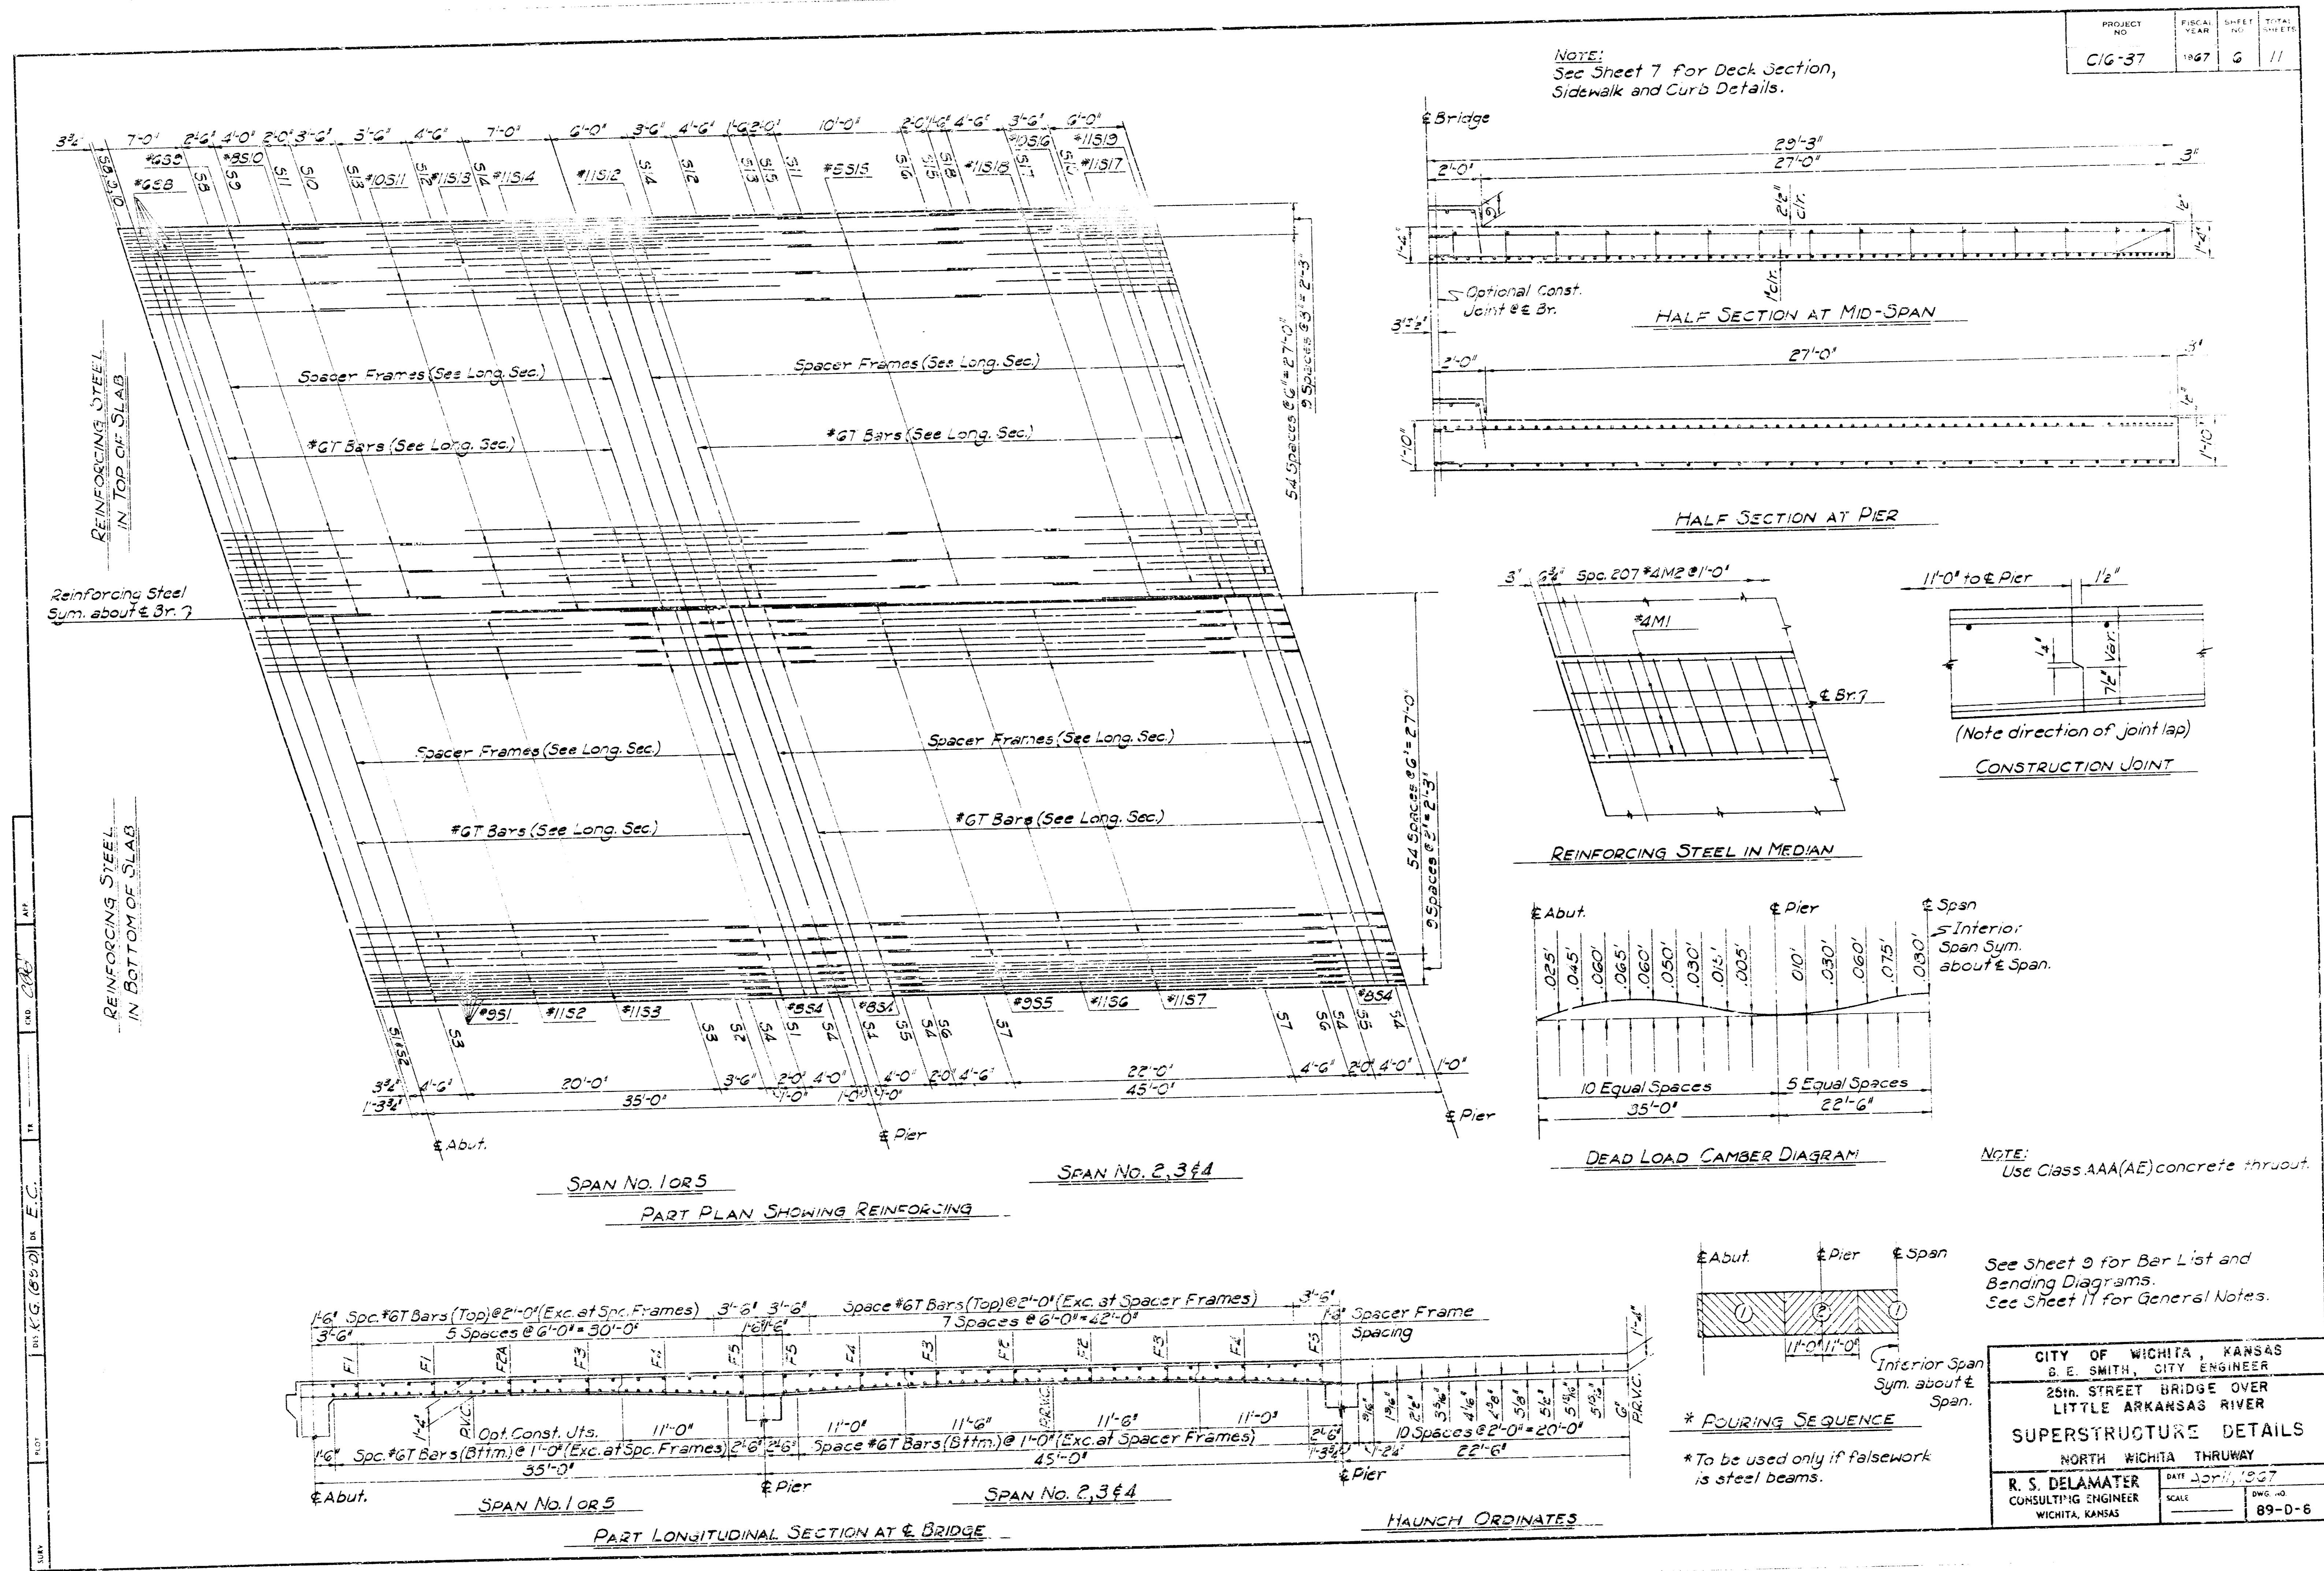

CITY OF WICHITA, KANSAS B. E. SMITH, CITY ENGINEER 2516 STREET BRIDGE OVER LITTLE ARKANSAS RIVER	
SUPERSTRUCTURE DETAILS	
NORTH WICHITA THRUWAY	
R. S. DELAMATER CONSULTING ENGINEER WICHITA, KANSAS	DATE: Jan 11, 1927 SCALE: _____ DWG. NO. 89-D-6

PROJECT NO.	DATE	SHEET NO.	TOTAL SHEETS
C-6-37	1927	7	

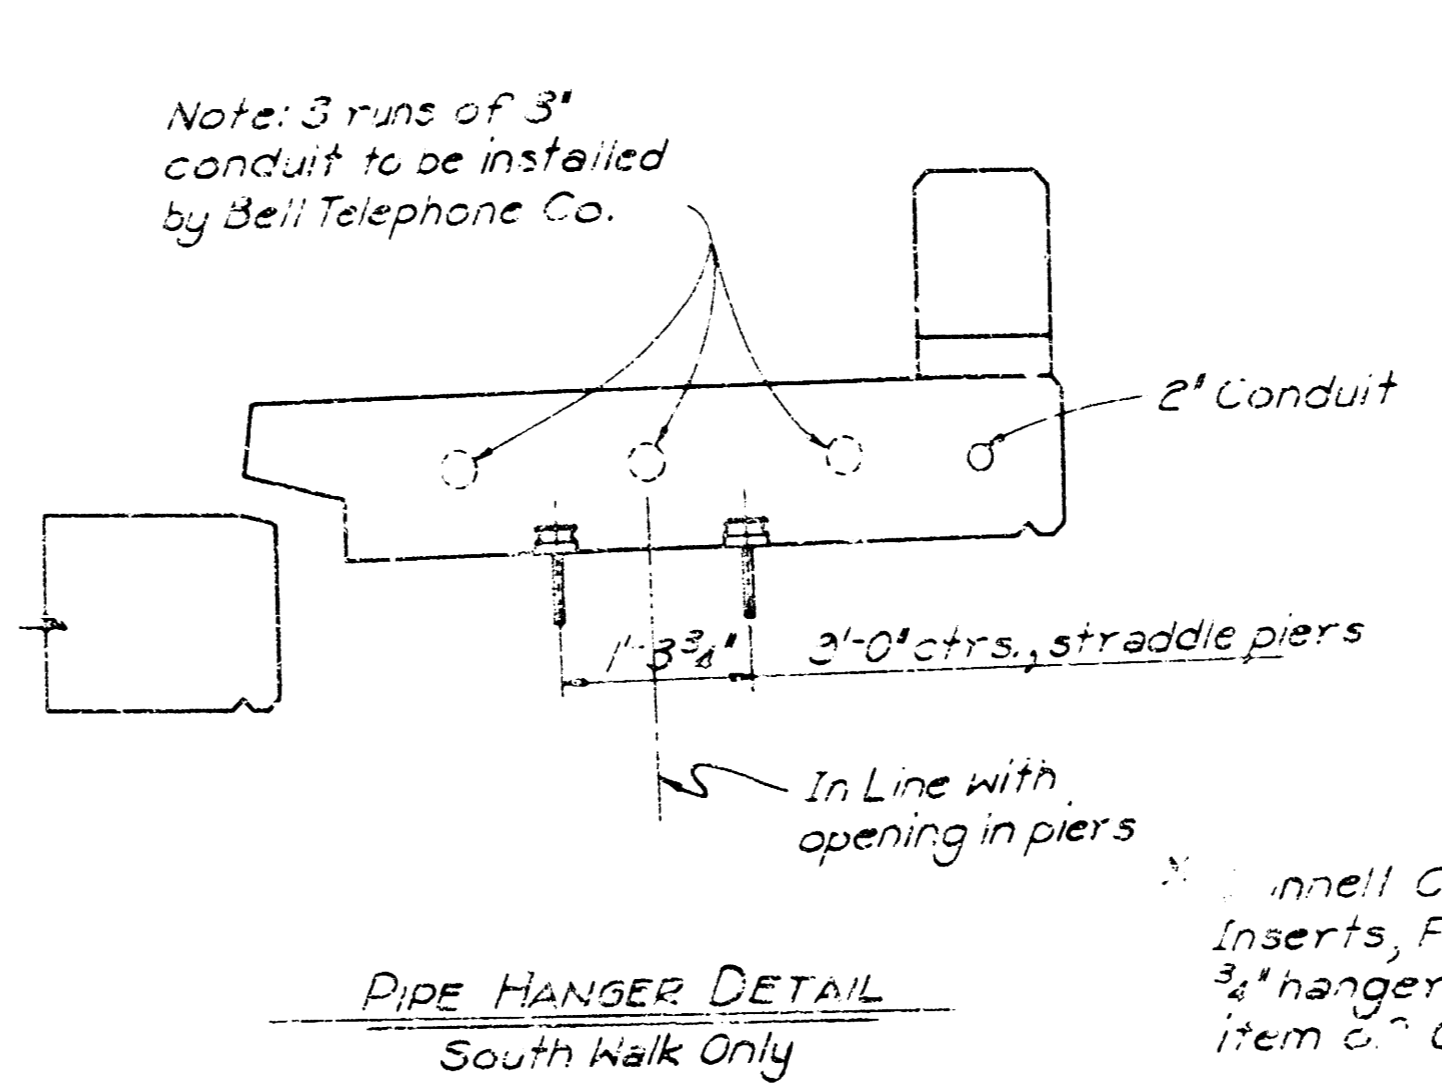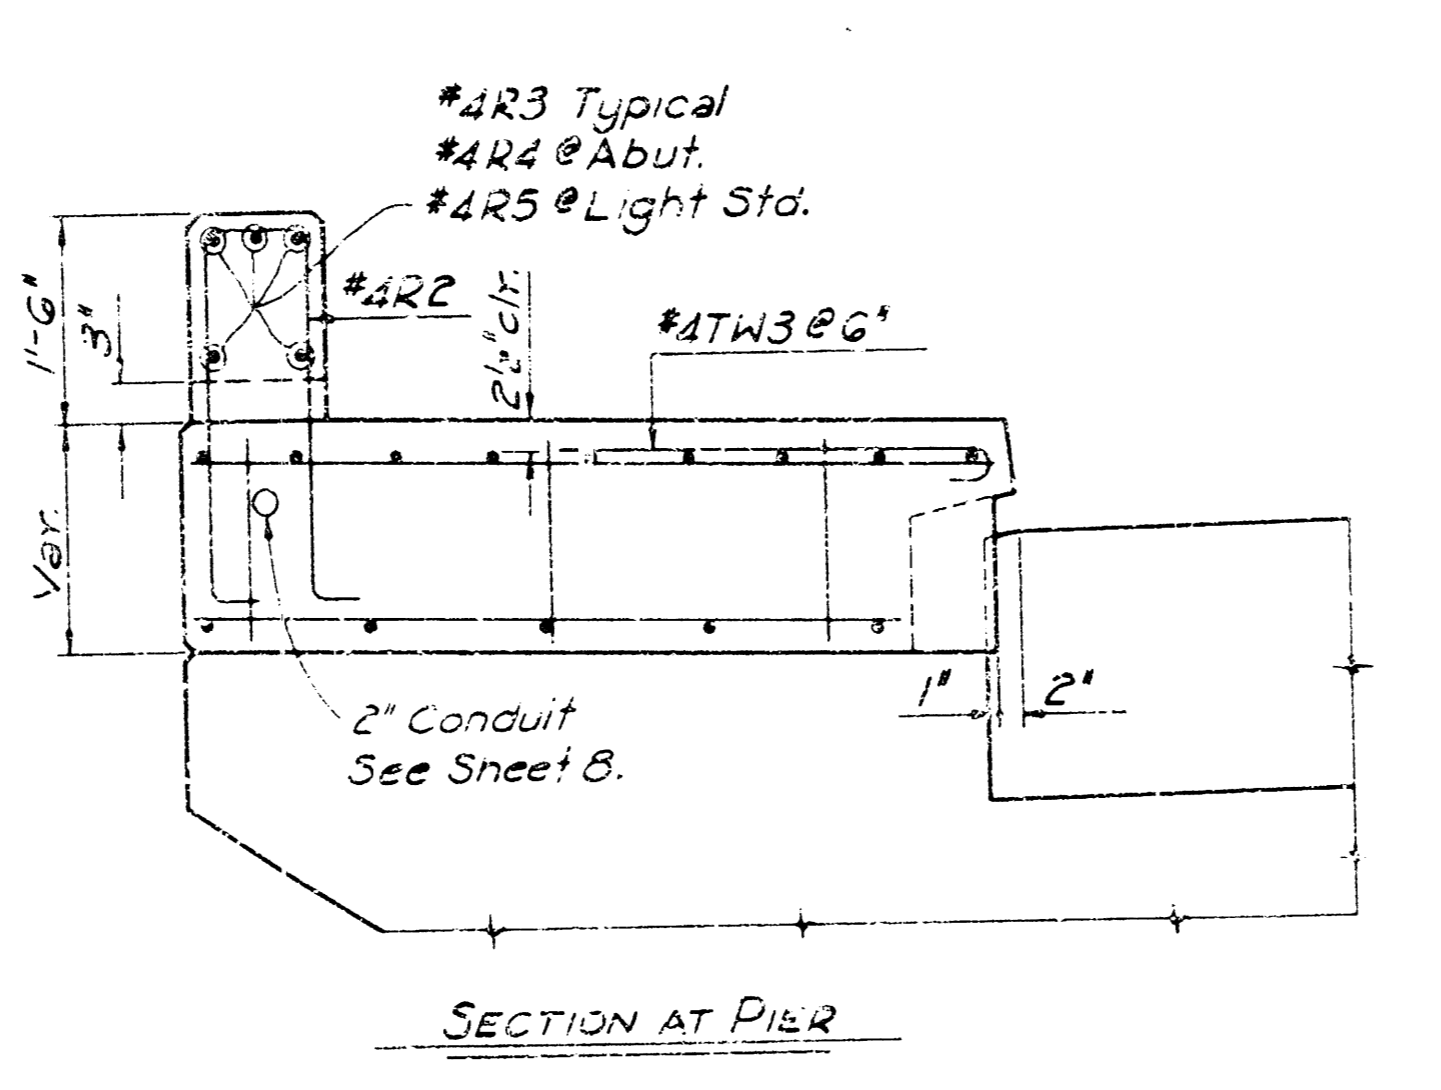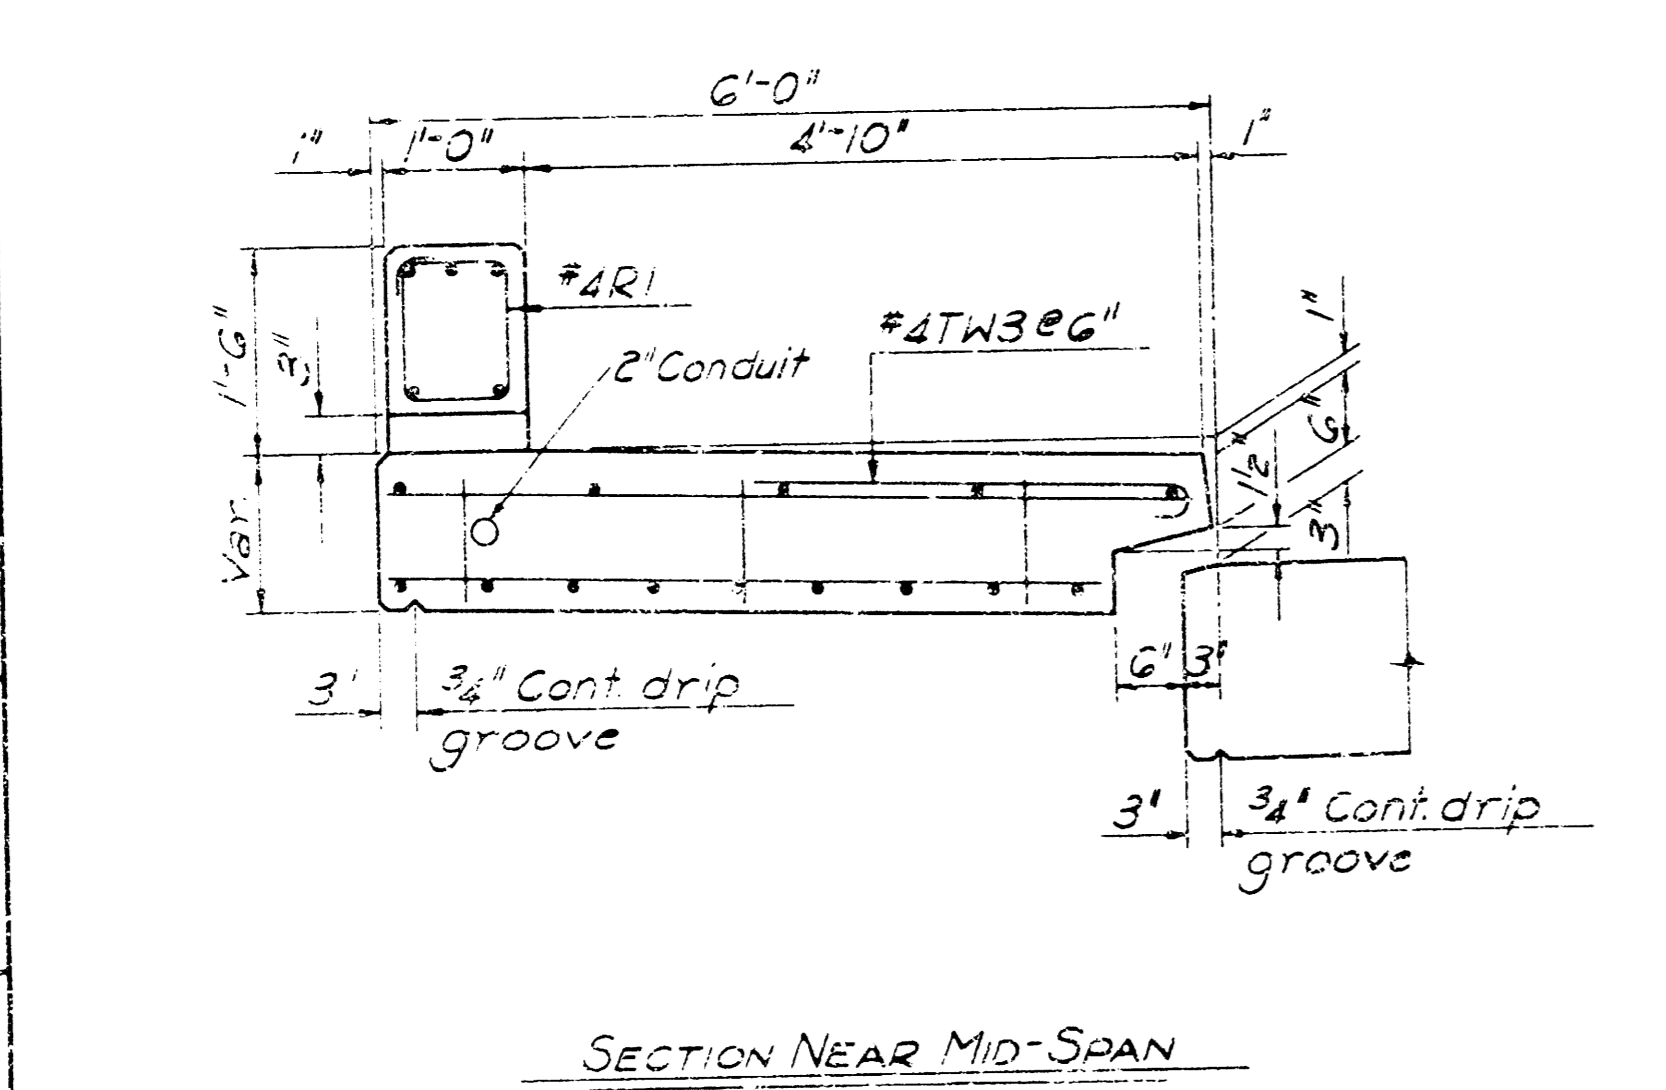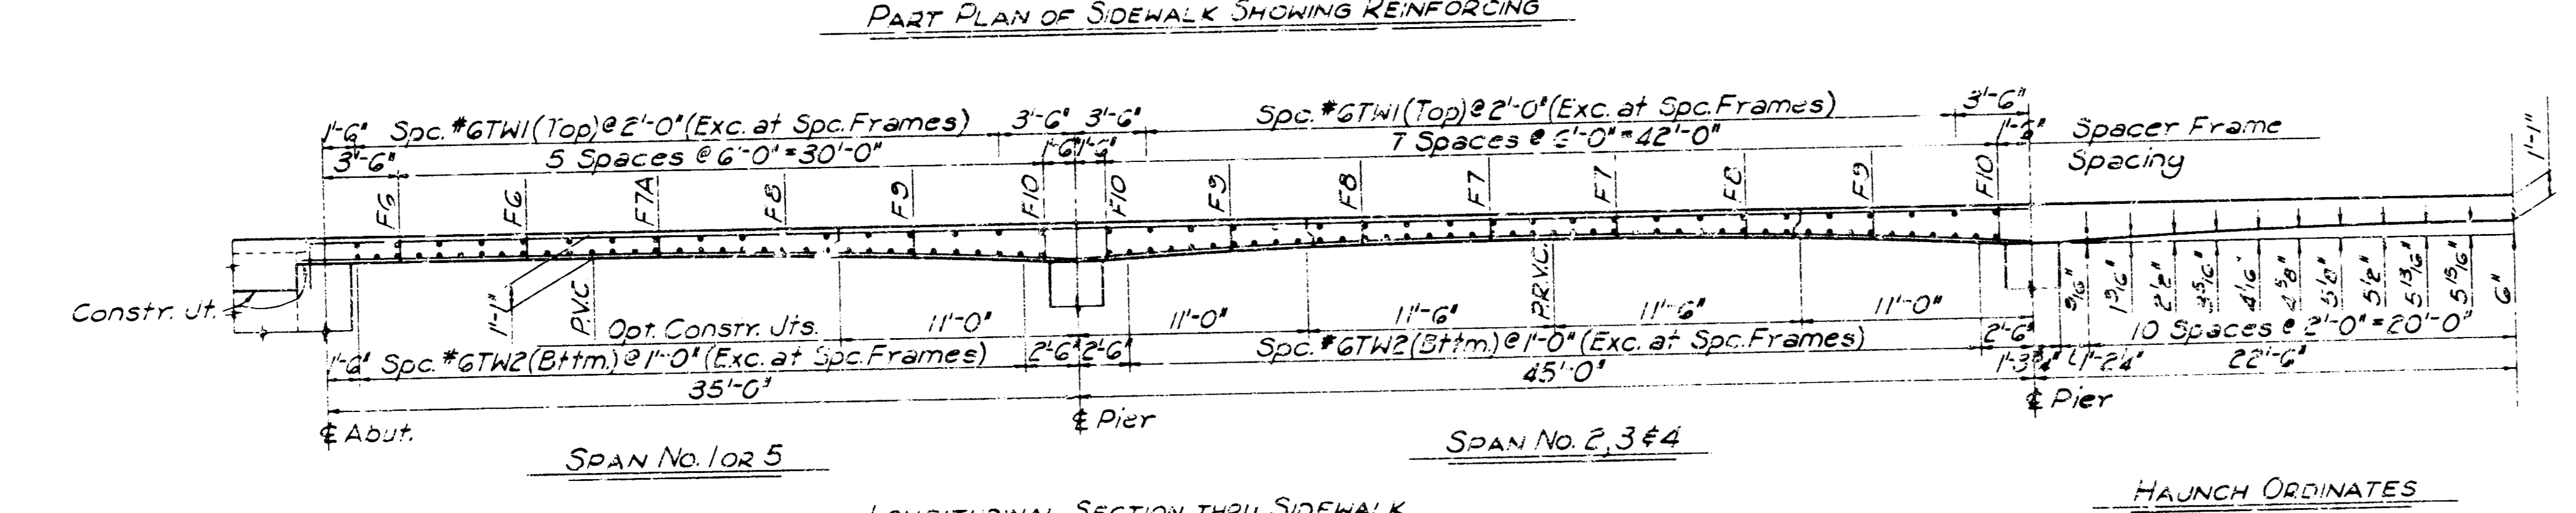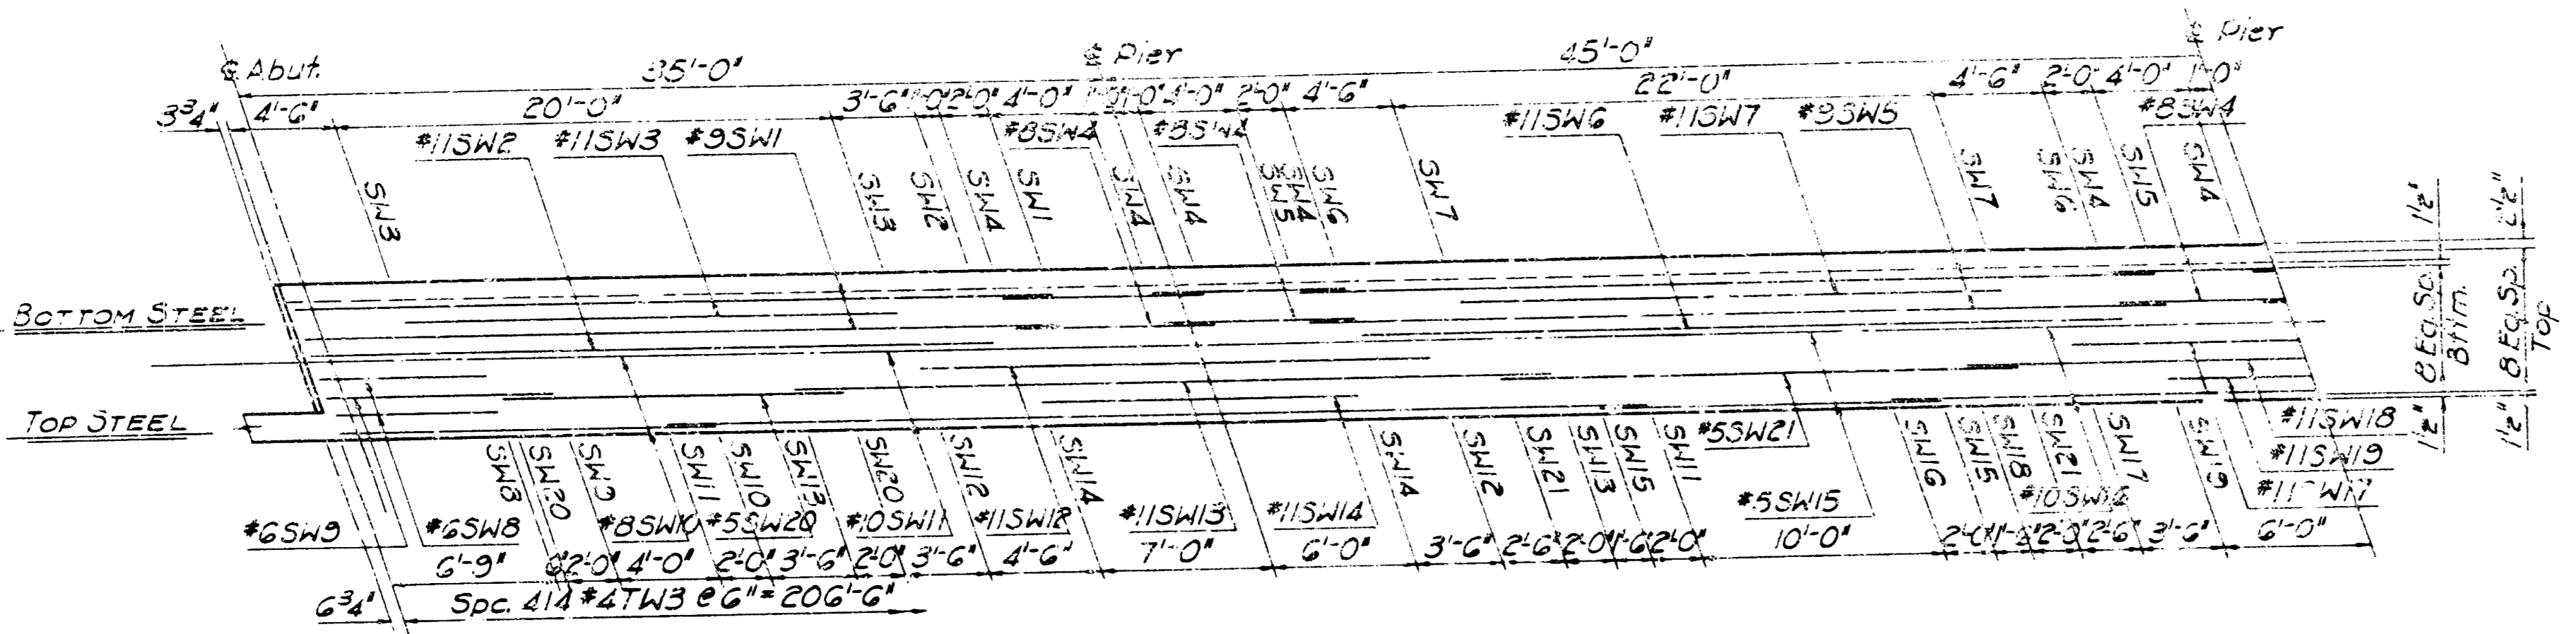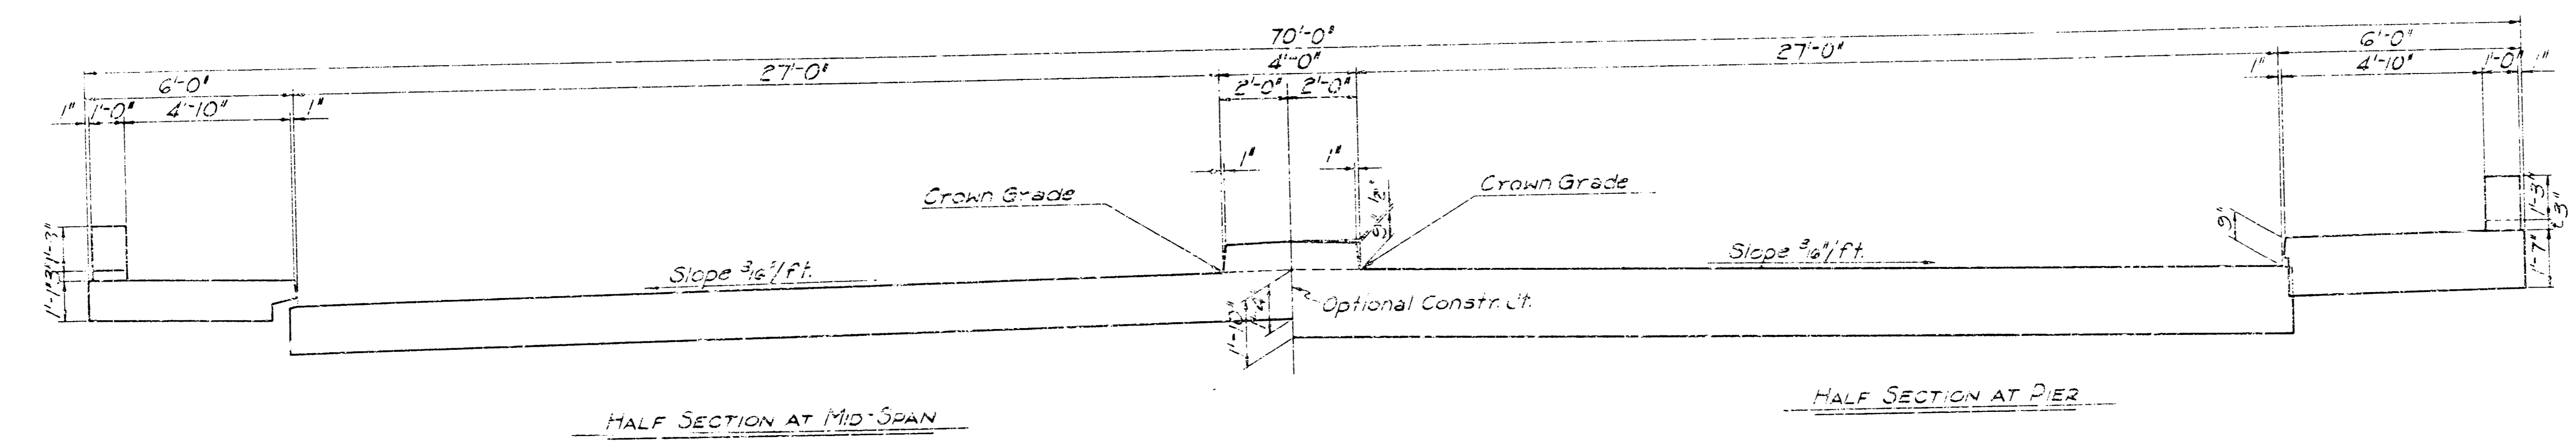


NOTE:
See Sheet 9 for Bar L and S
Bending Diagrams.
See Sheet 11 for General Notes.
See Sheet 6 for Dead Load
Member Diagram.


* Const. Note:
Bolt washers from
original fittings were
given to Water Dept.
office for safe keeping.

KCU 11248 As Built	
CITY OF WICHITA, KANSAS B. E. SMITH, CITY ENGINEER	
25th STREET BRIDGE OVER LITTLE ARKANSAS RIVER DECK SECTION & WALK DETAILS NORTH WICHITA THRUWAY	
R. S. DELAMATER CONSULTING ENGINEER WICHITA, KANSAS	DATE: 10/11/27 SCALE: _____ DRAWING NO.: 89-0-7



Use Innell CB Universal Concrete
Inserts, Fig. 202 or equal, for
3/4" hanger rods. Subsidiary to
item 2" Class AAA(A2) Concrete.

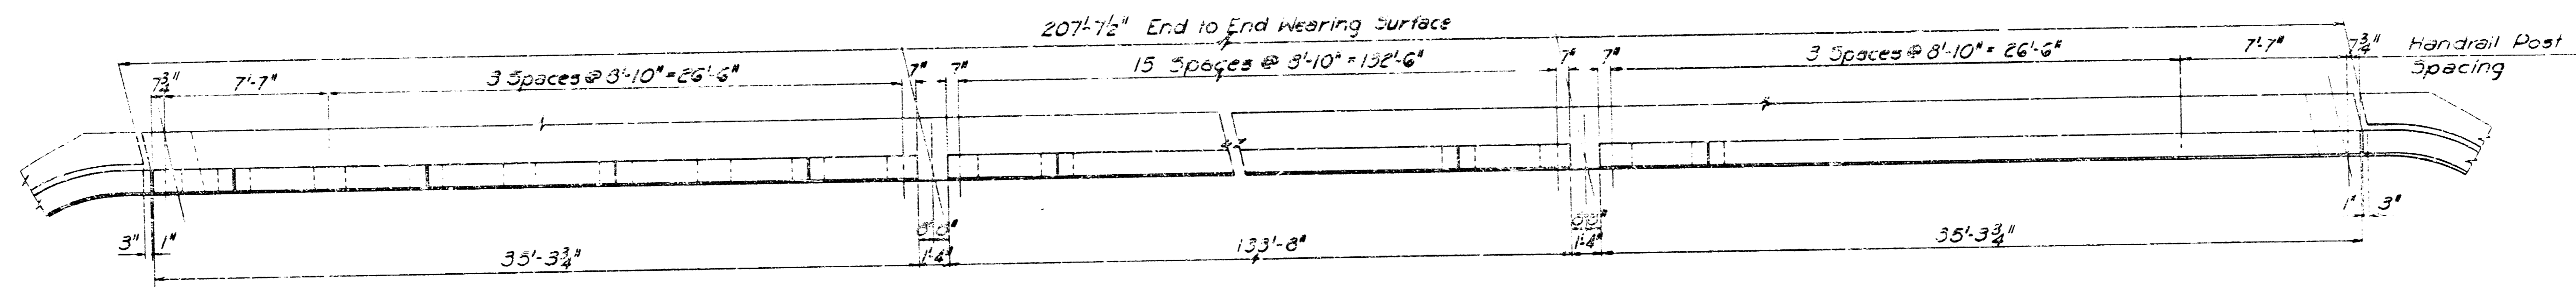


HANDRAIL PARAPET WALL PLAN

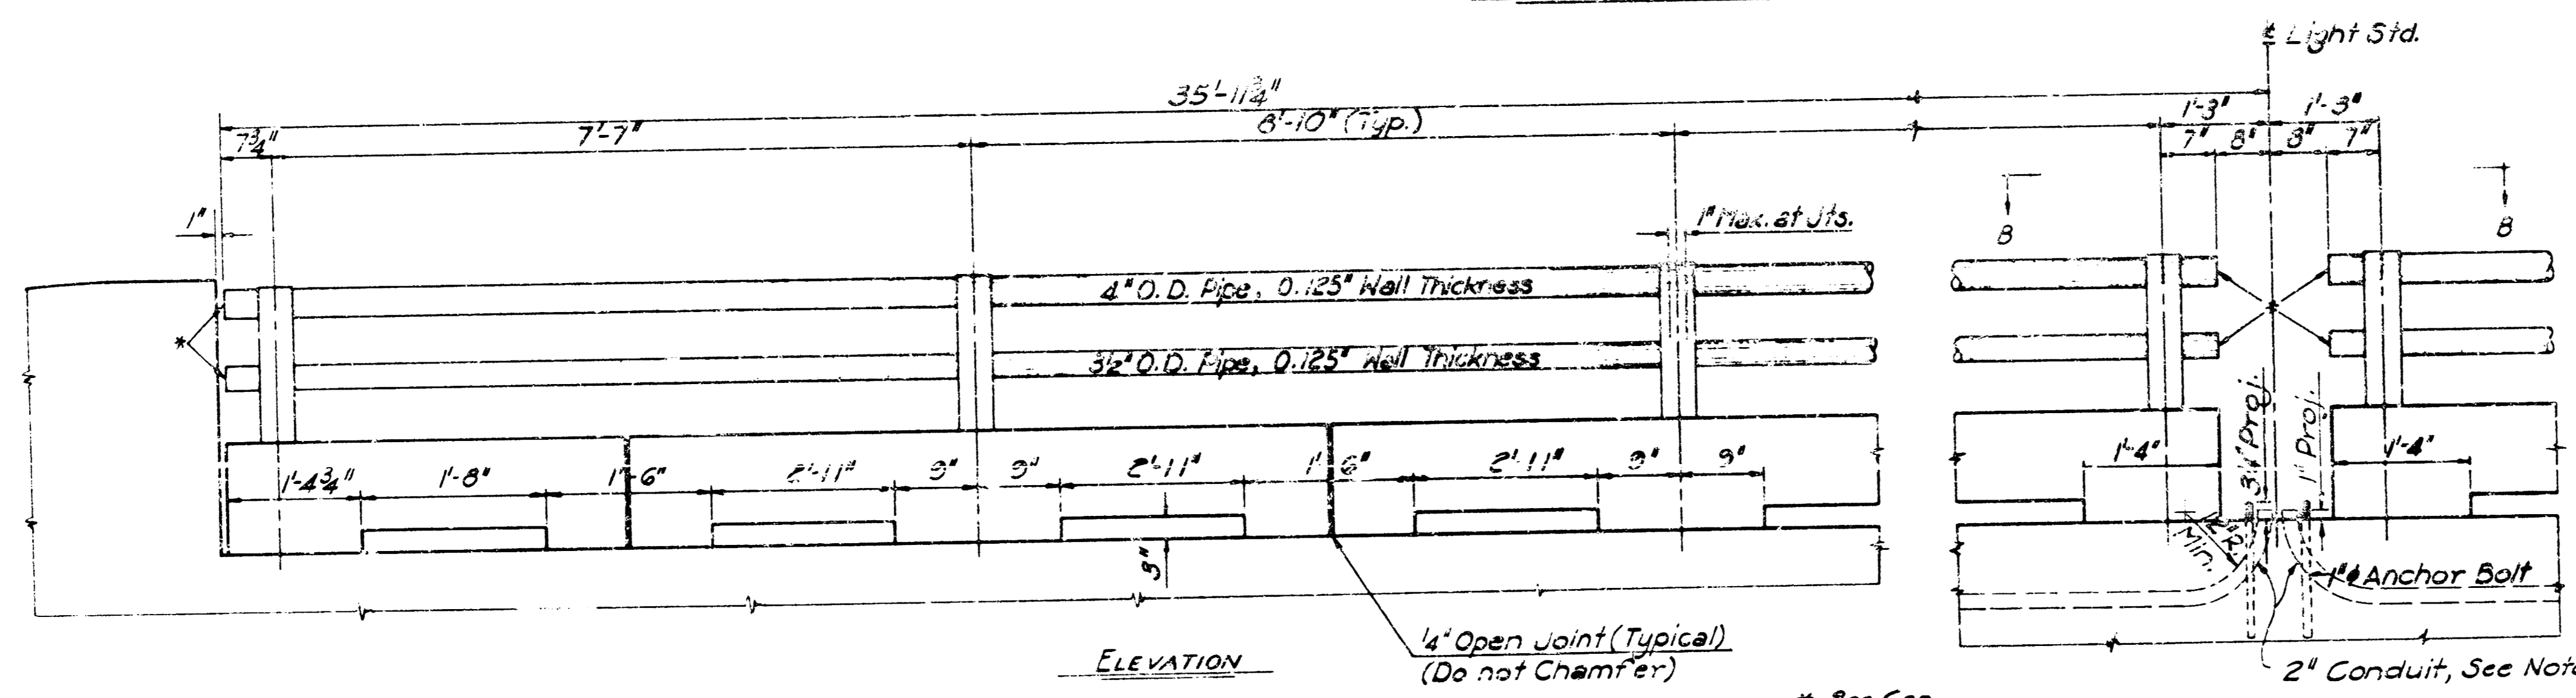


ELEVATION

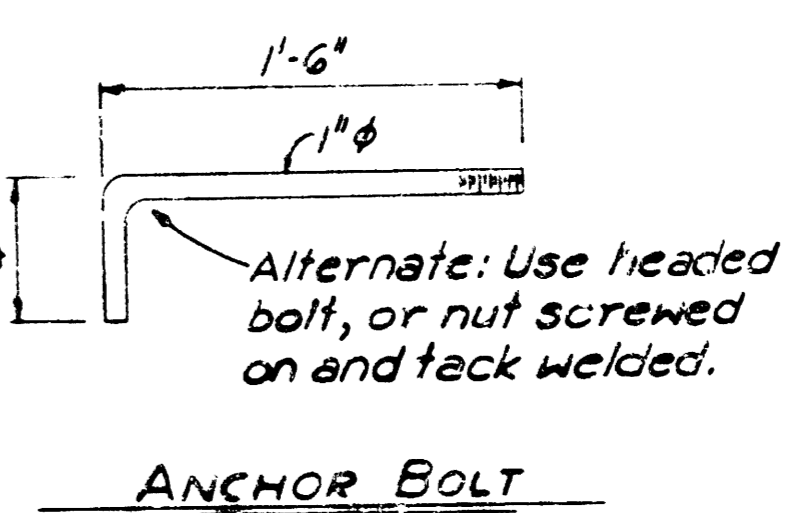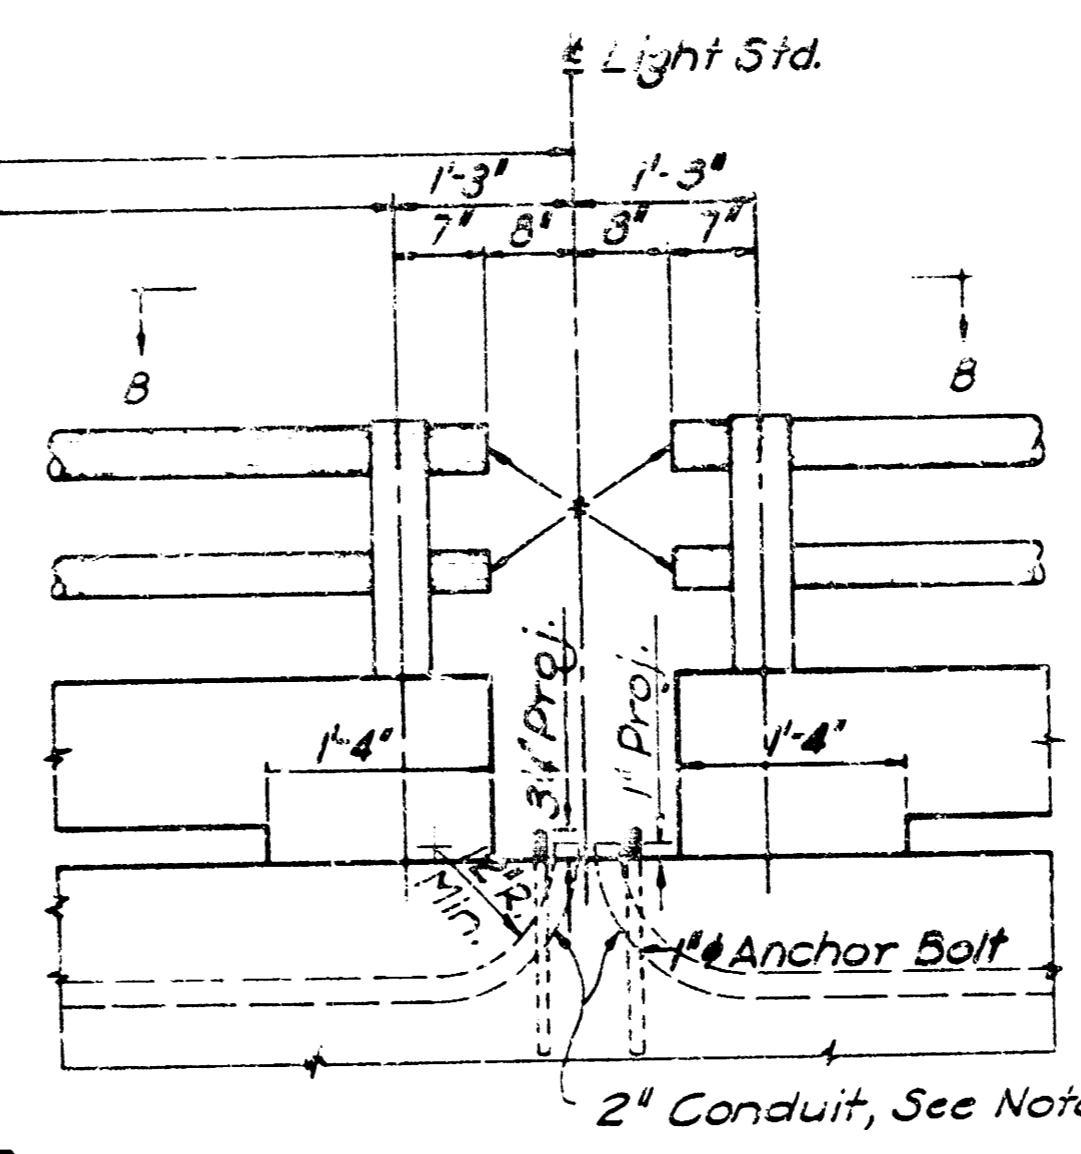

ANCHOR BOLT

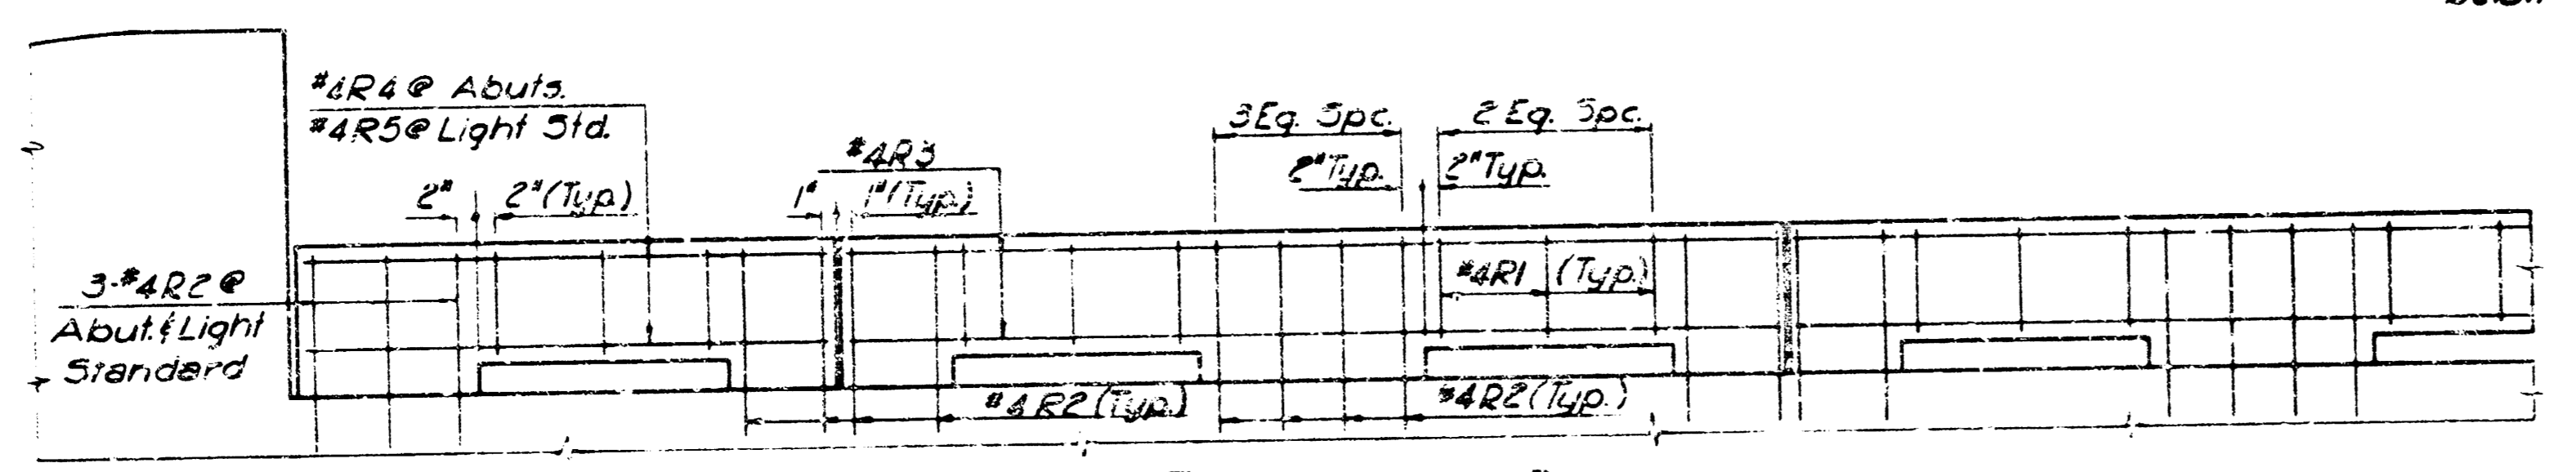

PART ELEVATION SHOWING REINFORCING

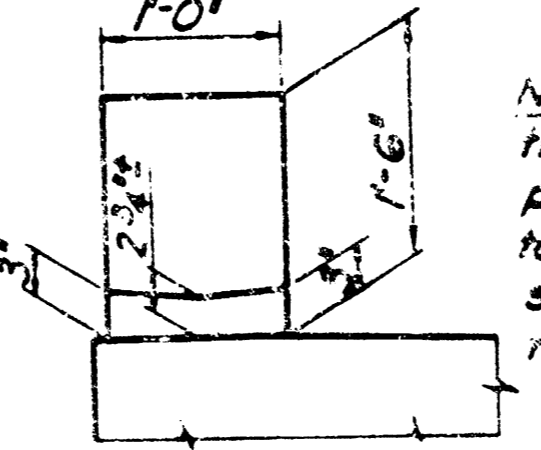


OPTIONAL CURB SECTION


NOTE: At the option of the Contractor, the parapet slot may be constructed to the dimensions shown, or similarly, to expedite form removal.

NOTE: The top surface of the parapet wall shall be given a troweled finish, with special care given to provide smooth contact surfaces under handrail posts. Rail sections shall be of such length as to span at least two full handrail panels. This handrail is intended to be identical, except for panel lengths, to that previously used on the Amicon Bridge for the City of Wichita. Bevel exposed edges of parapet slots 1/2\"/>


See Sheet 11 for General Notes. See Sheet 9 for Bar List and Bending Diagrams. 2\"/>

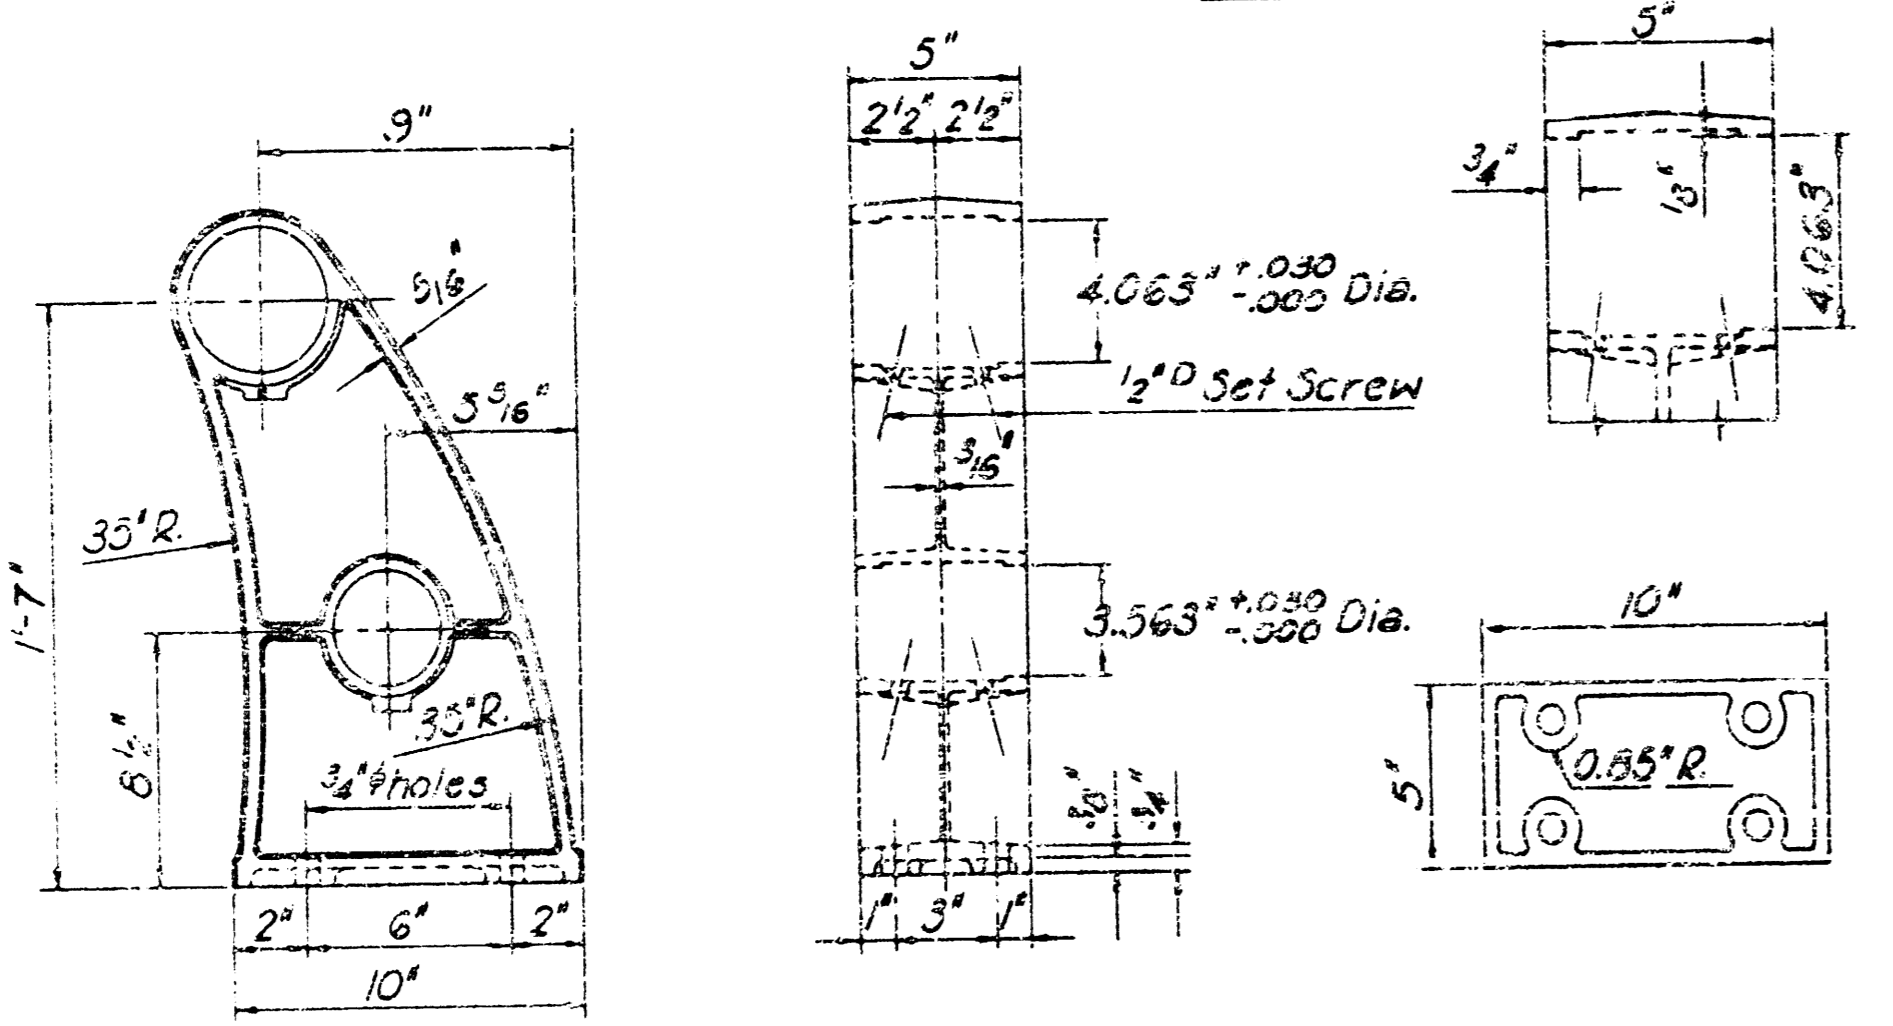

HANDRAIL POST DETAILS

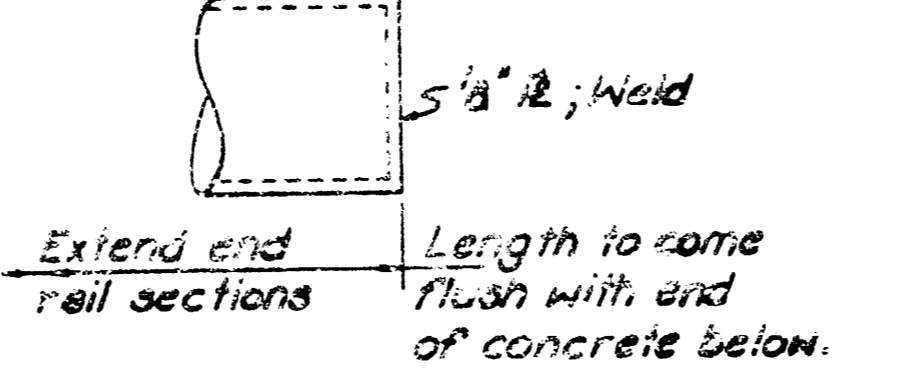


RAIL CAP DETAIL

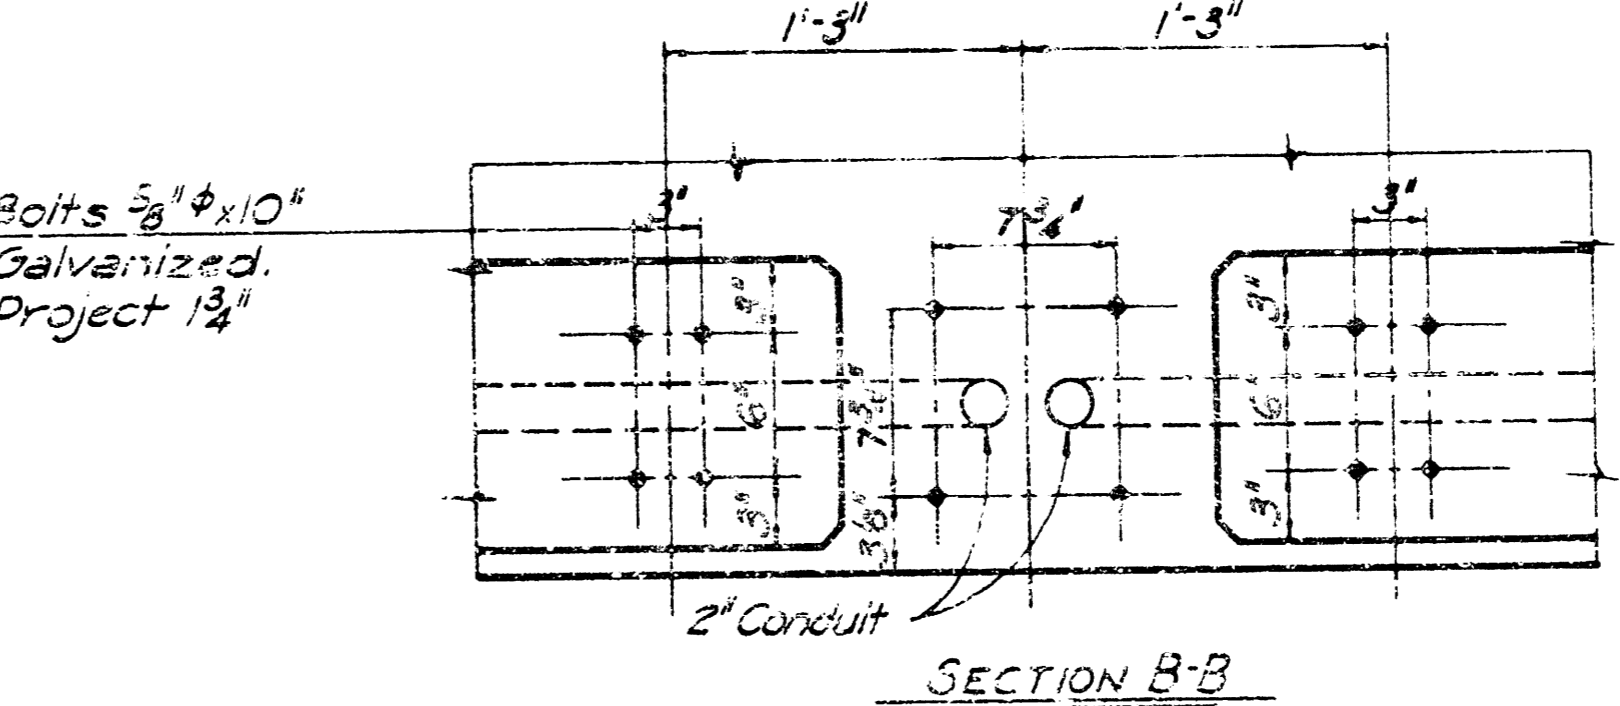

SECTION B-B


CITY OF WICHITA, KANSAS	
B. E. SMITH, CITY ENGINEER	
25th STREET BRIDGE OVER LITTLE ARKANSAS RIVER	
HANDRAIL DETAILS	
NORTH WICHITA THRUWAY	
R. S. DELAMATER	DATE April, 1967
CONSULTING ENGINEER	SCALE
WICHITA, KANSAS	DWG. NO. 89-D-8

SUPERSTRUCTURE					
Straight Bars			Bent Bars		
Mark	No.	Size Length	Mark	No.	Size Length
S1	126	#9 31'-0"	F1	3	* *
S2	60	#11 24'-0"	F2	12	* *
S3	64	#11 20'-0"	F2A	4	* *
S4	504	#8 8'-0"	F3	16	* *
S5	139	#9 53'-0"	F4	16	* *
S6	90	#11 31'-0"	F5	16	* *
S7	96	#11 22'-0"	F6	8	* *
S8	64	#8 18'-0"	F7	12	* *
S9	64	#10 40'-0"	F7A	4	* *
S10	64	#11 21'-0"	F8	16	* *
S11	64	#11 31'-0"	F9	16	* *
S12	60	#11 13'-0"	F10	16	* *
S13	96	#8 12'-0"			
S14	64	#10 35'-0"	S8	124	#6 3'-0"
S15	64	#11 19'-0"	S9	62	#6 11'-6"
S16	62	#11 28'-0"			
S17	60	#11 12'-0"			
M1	32	#4 27'-0"	M2	209	#4 6'-8"
T	446	#6 31'-4"			
TW1	128	#6 6'-0"	TW2	828	#4 3'-6"
TW2	318	#6 5'-3"			
R3	200	#4 8'-8"	R1	276	#4 3'-6"
R4	20	#4 3'-7"	R2	380	#4 5'-9"
Q5	40	#4 4'-10"			
SW1	20	#9 31'-0"			
SW2	8	#11 28'-0"			
SW3	8	#11 20'-0"			
SW4	80	#8 8'-0"			
SW5	30	#9 35'-0"			
SW6	12	#11 31'-0"			
SW7	12	#11 22'-0"			
SW8	12	#8 15'-3"			
SW9	12	#10 40'-0"			
SW10	8	#11 21'-0"			
SW11	8	#11 31'-0"			
SW12	8	#11 13'-0"			
SW13	18	#5 14'-0"			
SW14	12	#10 35'-0"			
SW15	8	#11 19'-0"			
SW16	8	#11 28'-0"			
SW17	8	#11 12'-0"			
SW18	8	#5 13'-6"			
SW19	8	#5 21'-0"			
SW20	15	#5 21'-0"			






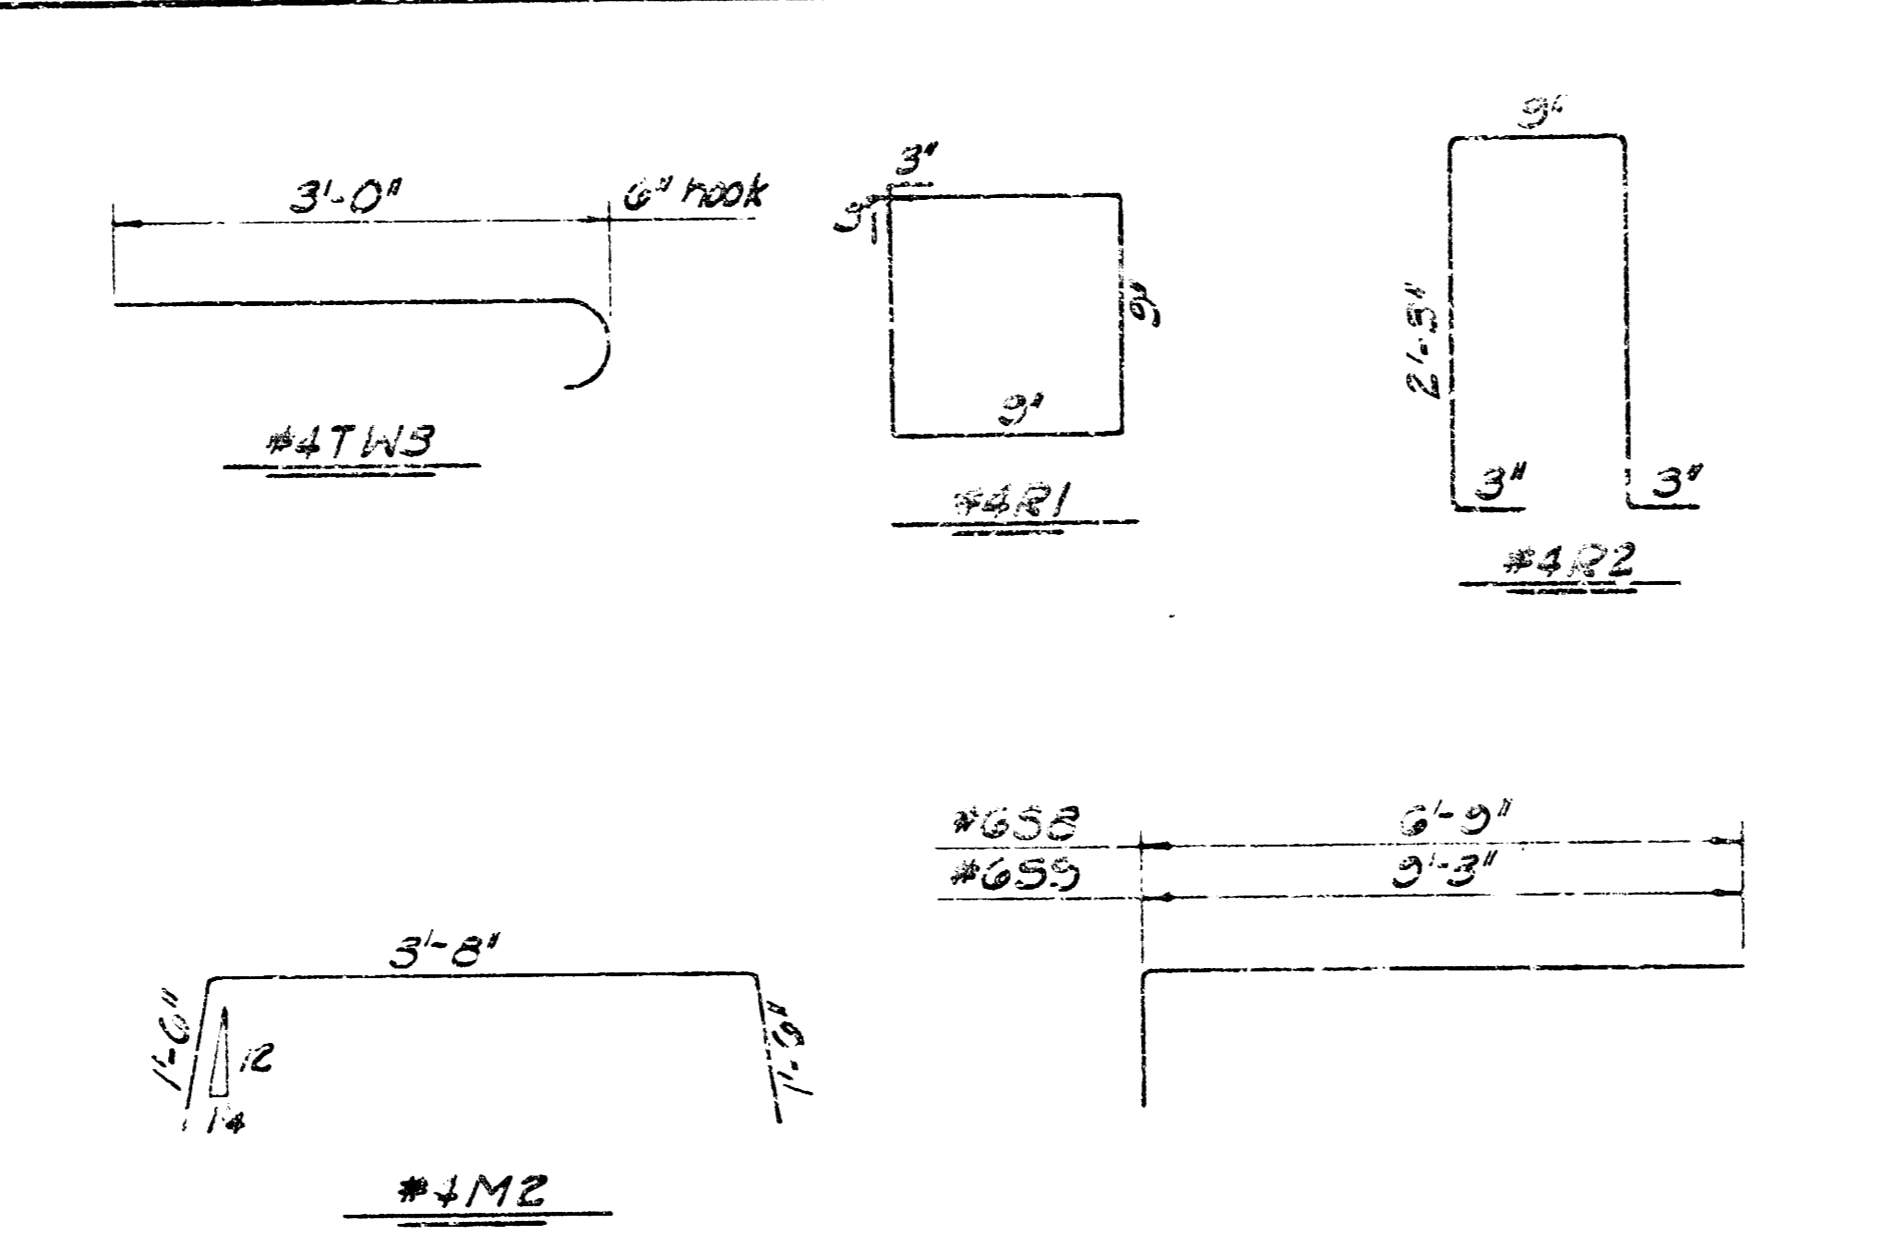


ONE ABUTMENT (2 THUS)					
Straight Bars			Bent Bars		
MARK	No.	Size Length	MARK	No.	Size Length
AF1	57	#8 23'-5"	AB1	59	#5 3'-5"
AF2	6	#6 9'-0"	AF2	6	#6 10'-7"
AF3	6	#6 11'-3"	AF4	6	#6 9'-9"
AV1	36	#4 3'-0"	AV1	67	#4 12'-3"
AV2	8	#4 8'-10"	AV2	6	#4 4'-0"
AV3	5	#4 8'-4"	AV3	6	#4 13'-10"
AV4	12	#5 10'-6"	AV4	3	#4 *
AV5	14	#5 3'-5"	AV5	67	#4 3'-6"
			AO	50	#4 8'-8"
			SW3	8	#6 9'-9"
			SW3	4	#6 12'-3"

ONE PIER (4 THUS)					
MARK	No.	Size Length	MARK	No.	Size Length
PC1	80	#7 16'-6"			
PC2	36	#5 10'-0"	PC3	62	#5 6'-2"
DH1	2	#10 44'-0"	DU	36	#4 7'-2"
DH2	4	#10 23'-0"	DU1	61	#5 5'-2"
DH3	10	#8 44'-0"	DU2	57	#5 12'-6"
DH4	5	#10 44'-0"	DU3	12	#5 4'-3"
DH5	12	#8 10'-0"	DU4	8	#5 *
DH6	12	#8 *	DU5	8	#5 6'-2"
DH7	10	#10 12'-9"	DU6	4	#10 9'-6"
DH8	10	#11 12'-0"			
PX2	8	#6 3'-9"	PX1	138	#6 4'-6"

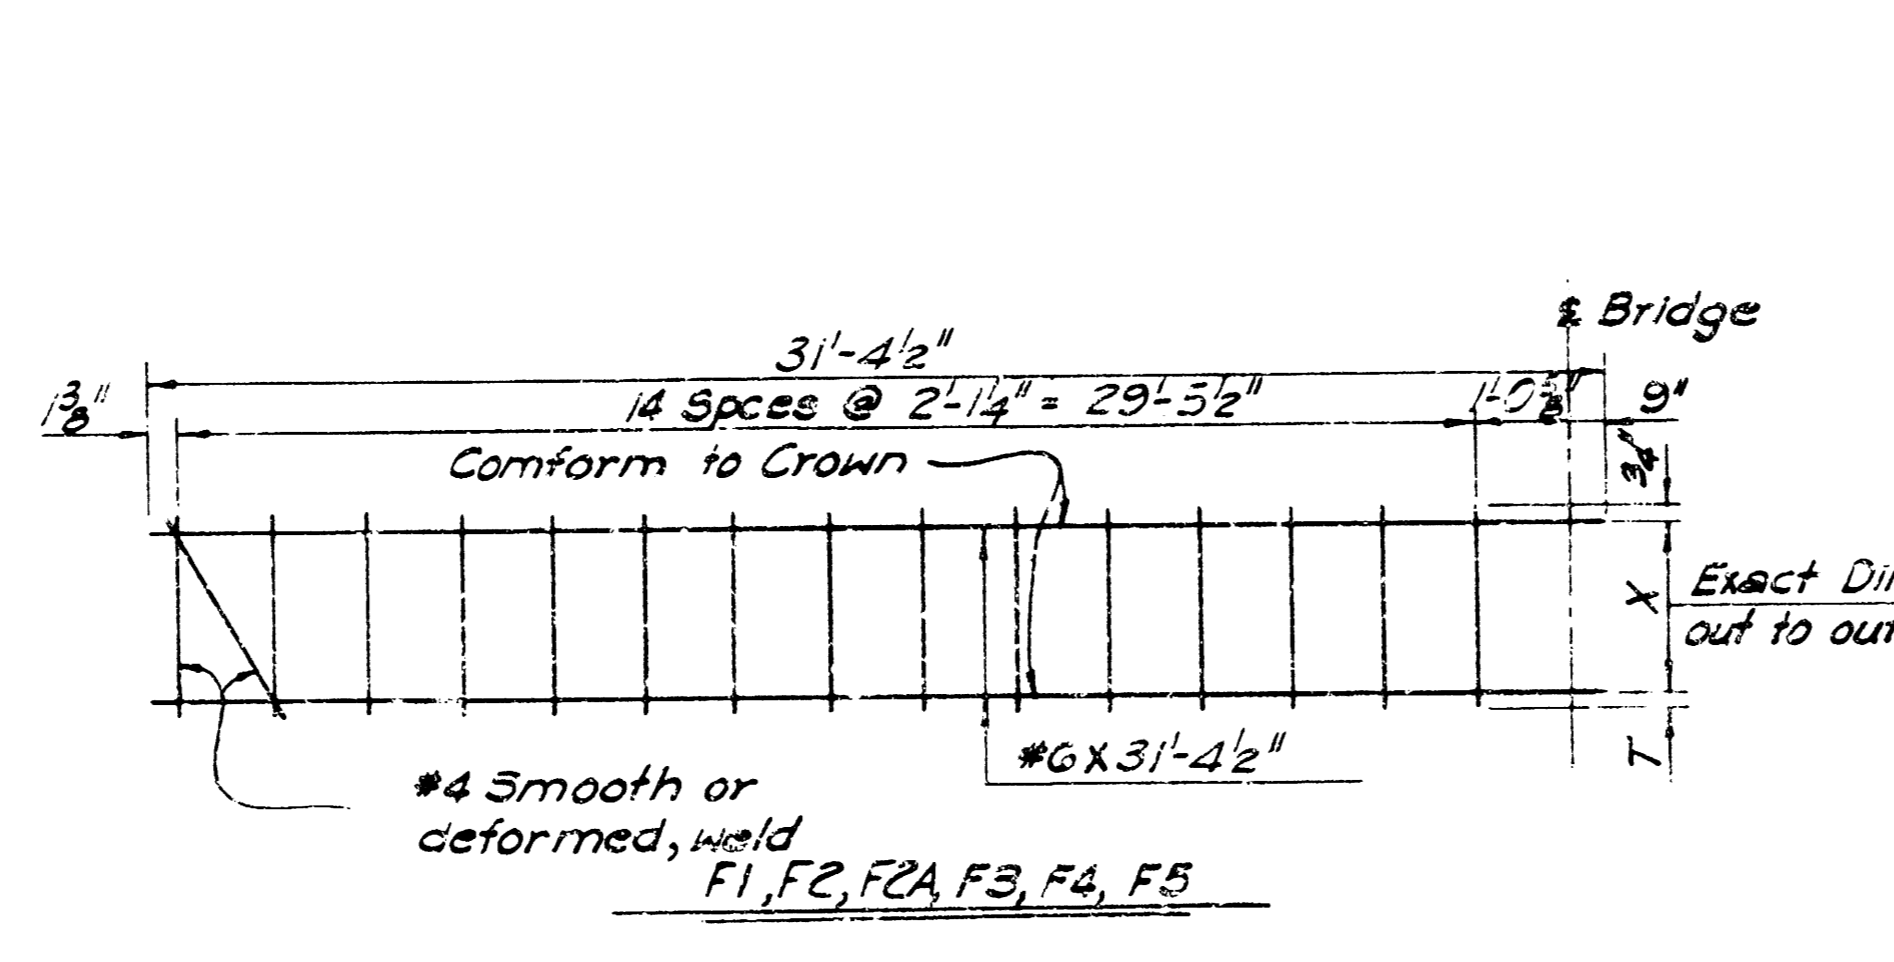

BAR	X	T
F1	10 1/8"	2 1/8"
F2	10 3/8"	2 1/8"
F2A	3 1/8"	2 1/8"
F3	10 1/8"	2 1/8"
F4	11 1/8"	2 1/8"
F5	11 3/8"	2"
F6	7 3/8"	2 1/8"
F7	7 1/8"	2 1/8"
F7A	4 3/8"	2 1/8"
F8	7 3/8"	2 1/8"
F9	10 1/8"	2 1/8"
F10	11-0"	2"

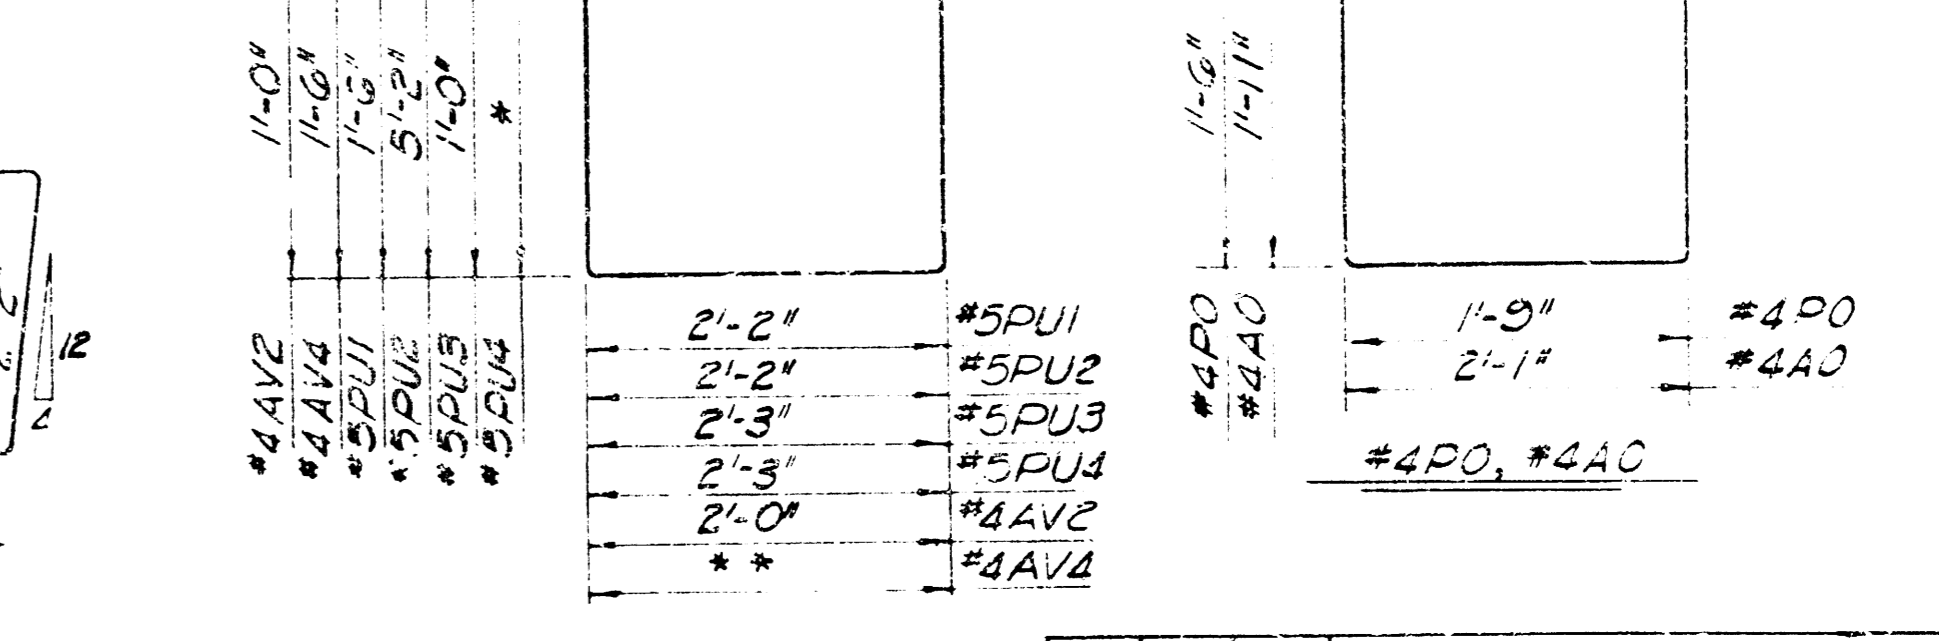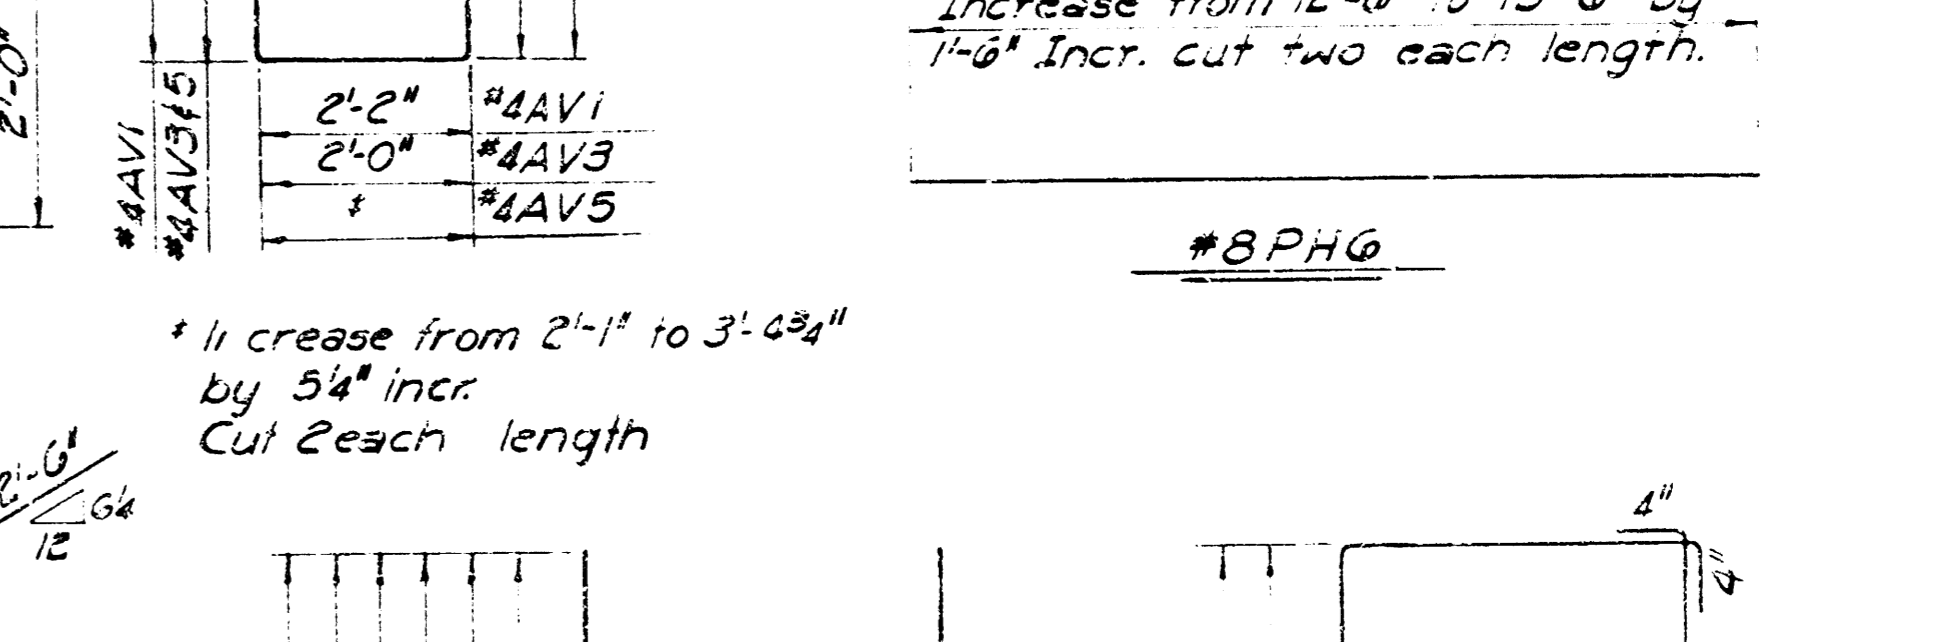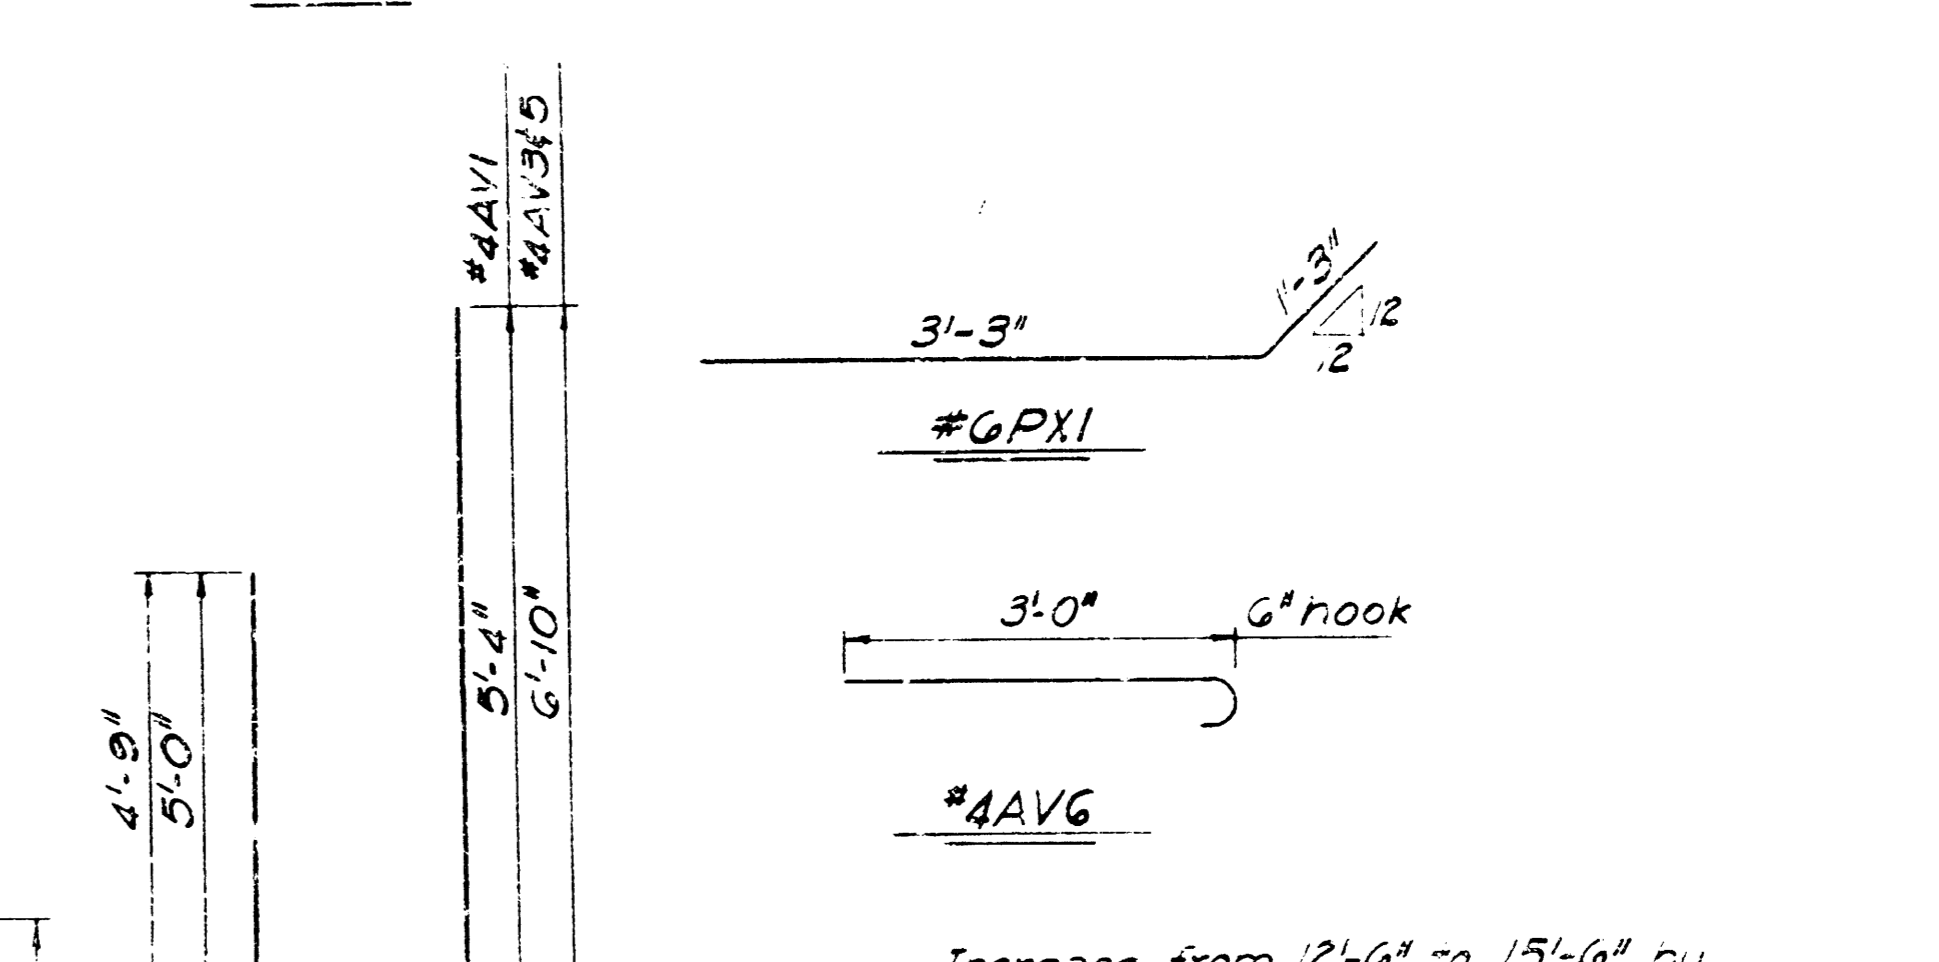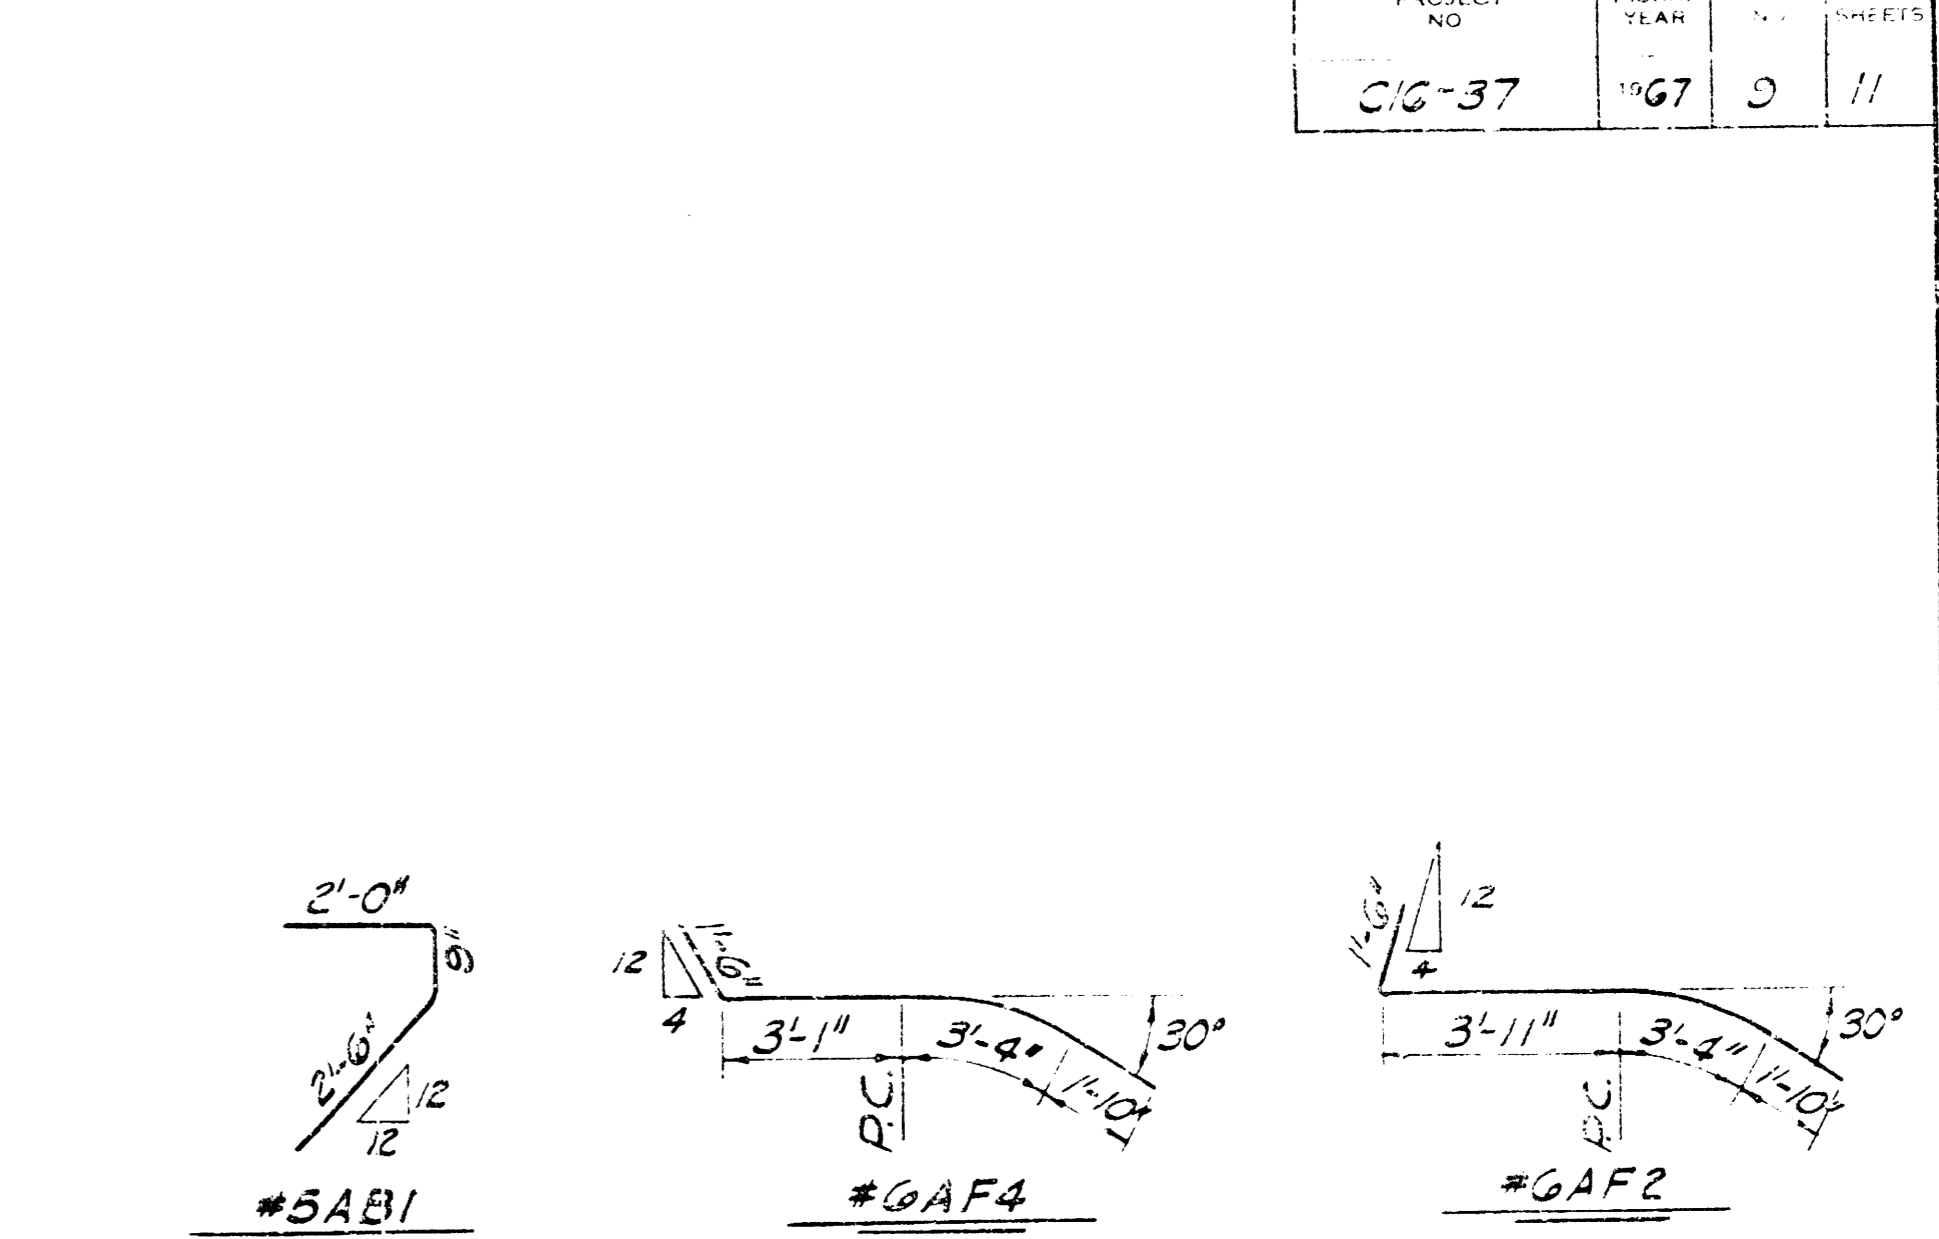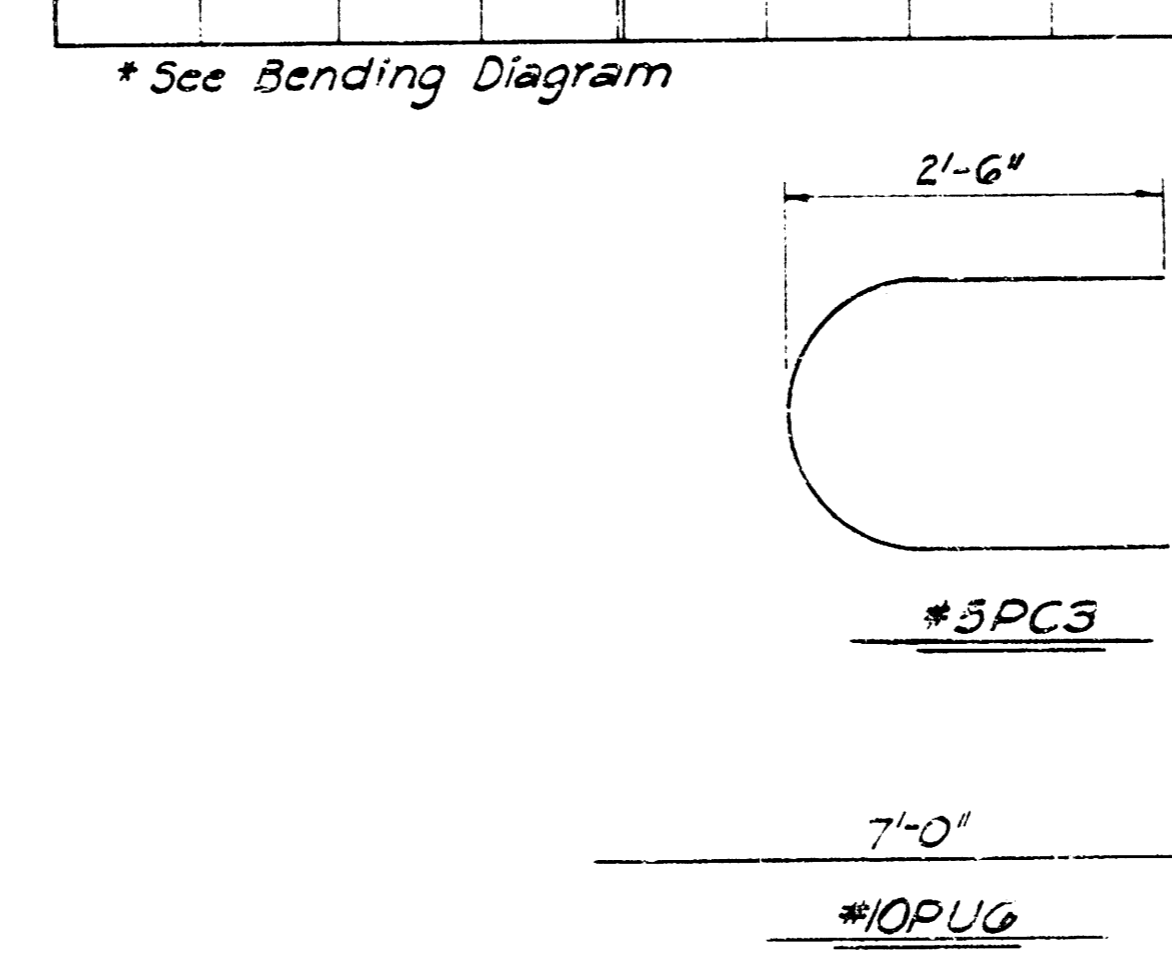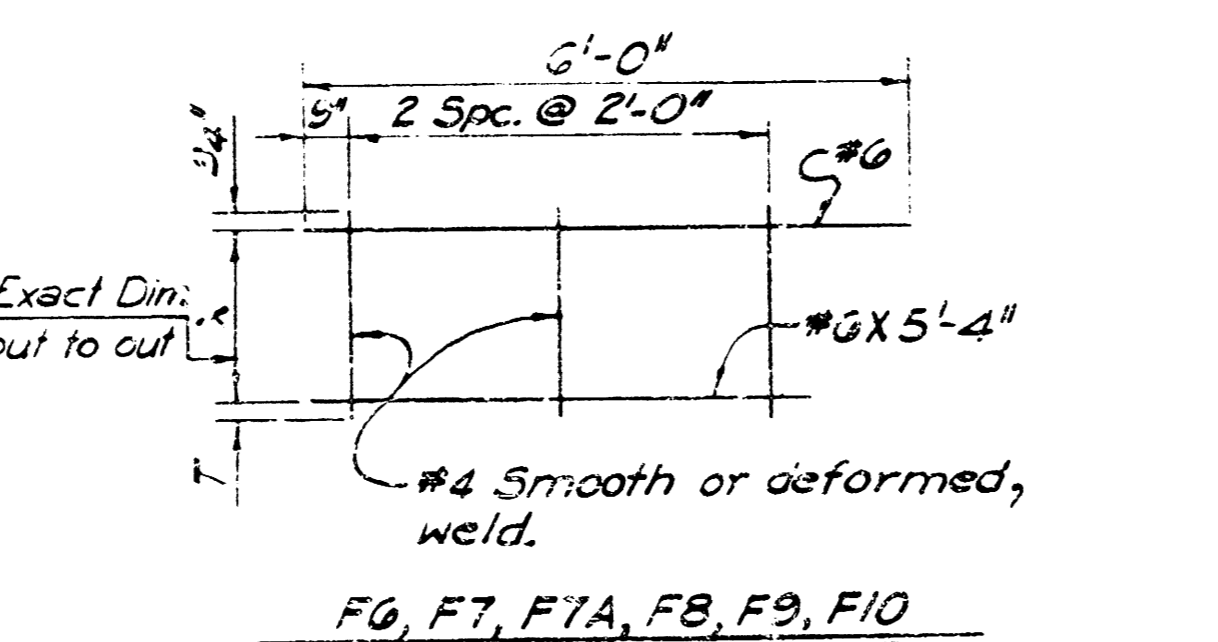

PROJECT NO. C/G-37
 FILED YEAR 1967
 SHEET NO. 3
 TOTAL SHEETS 11

1. KCU 1/2" As Built

CITY OF WICHITA, KANSAS
 B. E. SMITH, CITY ENGINEER

25th STREET BRIDGE OVER
 LITTLE ARKANSAS RIVER


BAR LIST

NORTH WICHITA THRUWAY

R. S. DELAMATER
 CONSULTING ENGINEER
 WICHITA, KANSAS

DATE April, 1967
 SCALE
 DWG. NO. 69-D-9

** Increase from 2'-1" to 3'-4 1/2" by 5/8" increment cut two each length.
 ** Increase from 1'-1/2" to 3'-10" by 6/8" inc. cut two each length.

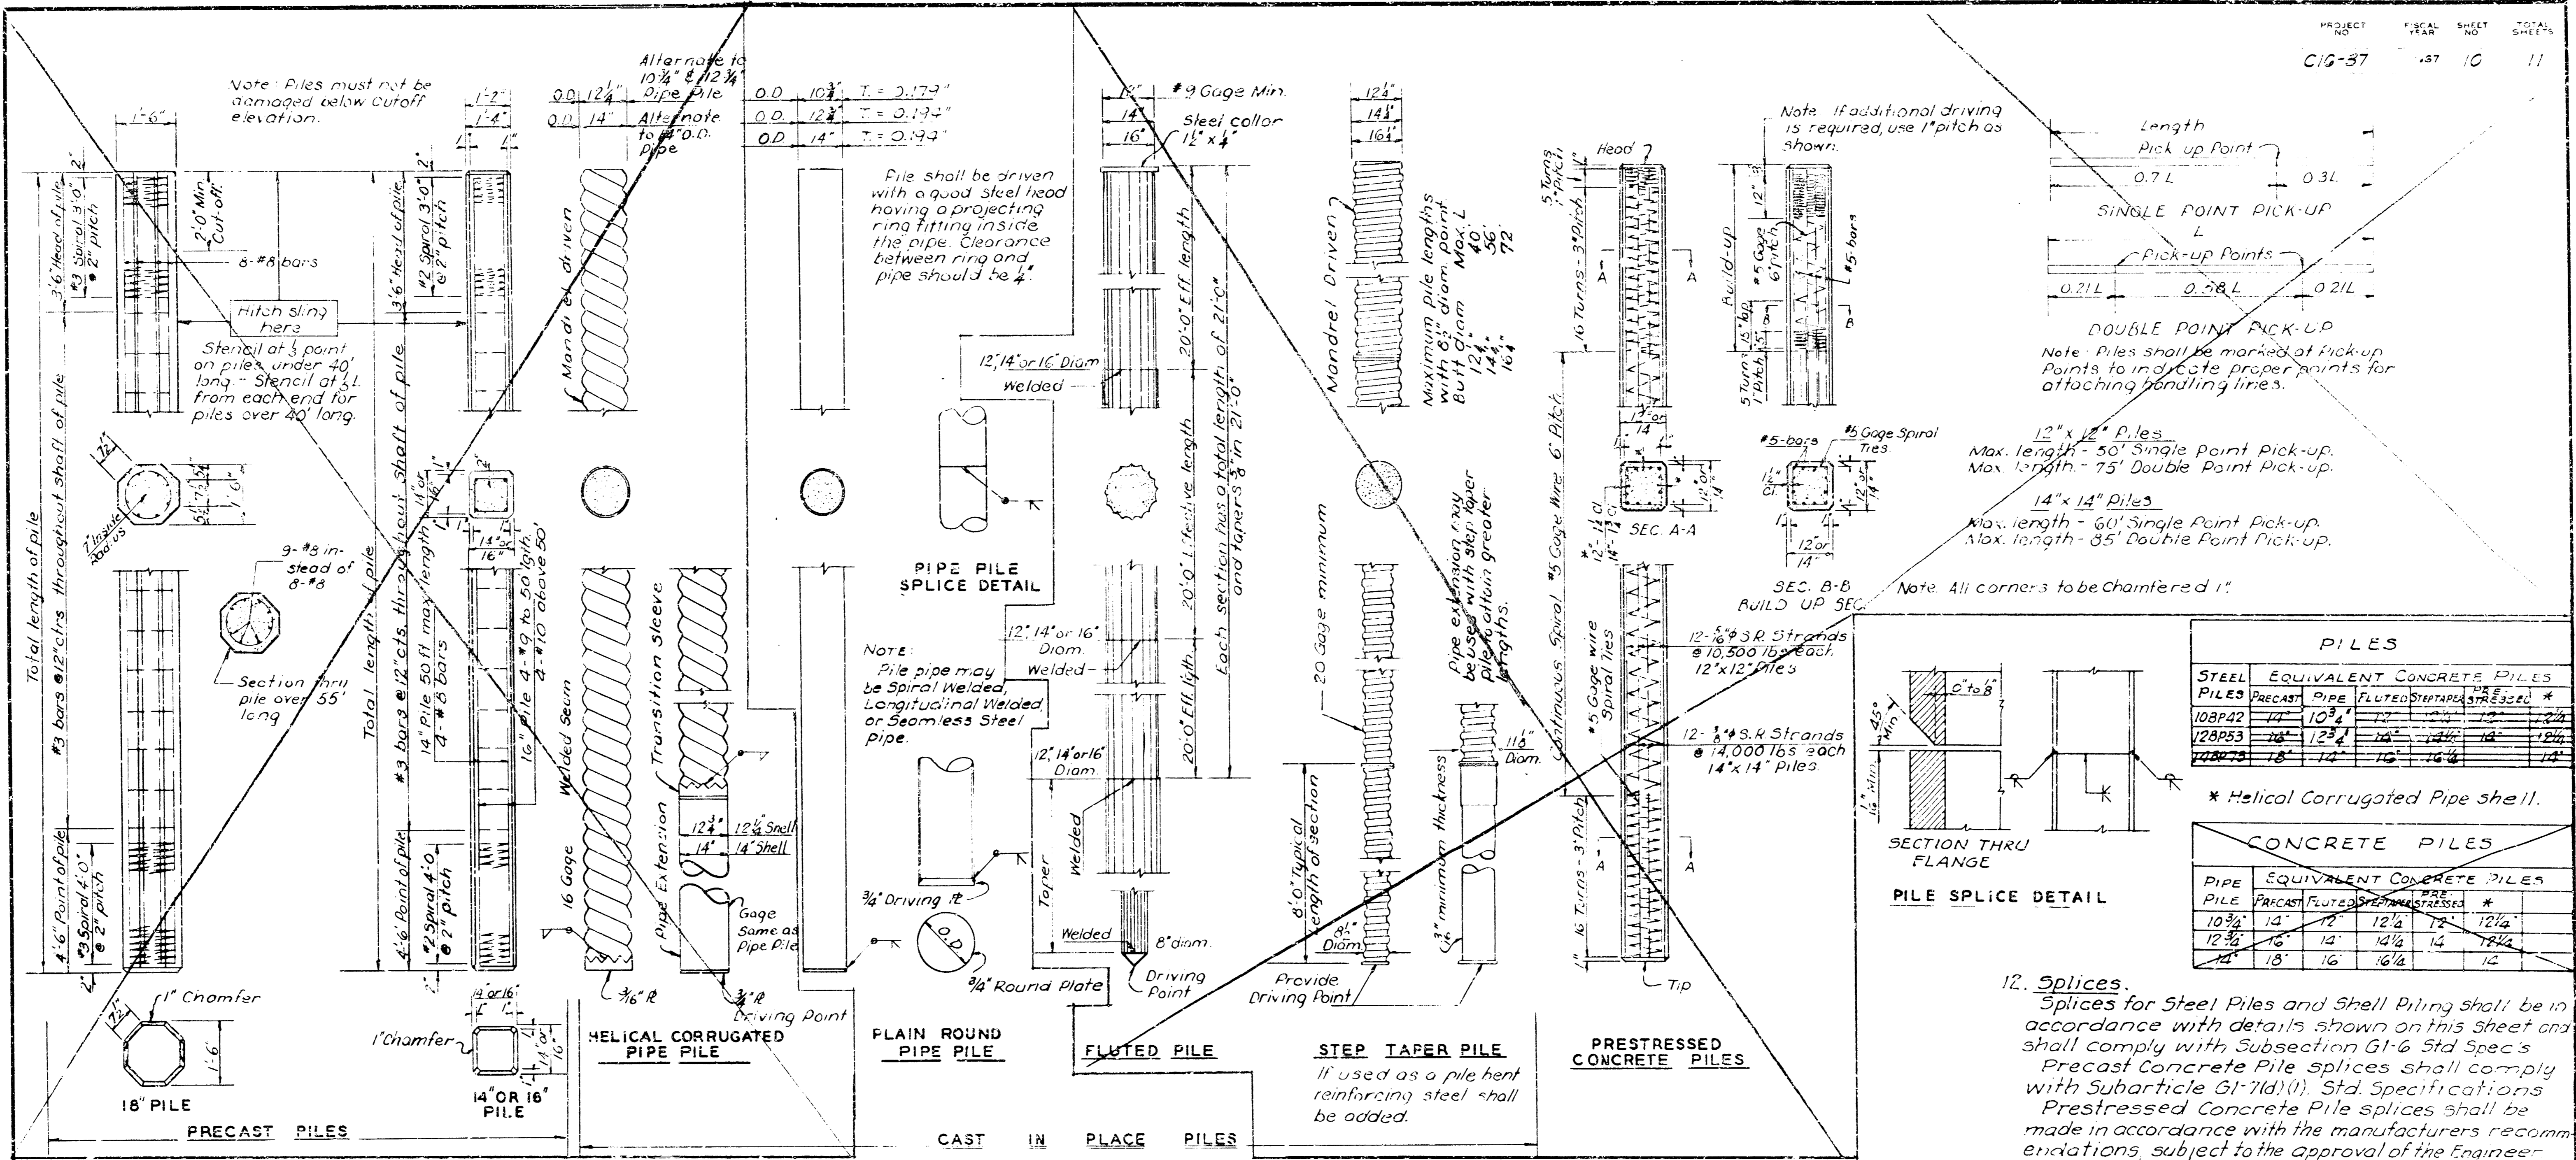

PILES				
STEEL PILES	EQUIVALENT PRECAST CONCRETE PILES	FLUTED SHELLS	HELIICAL CORRUGATED PIPE SHELL	PRESTRESSED CONCRETE PILES
108R42	10	12	12	12
128R53	12	14	14	14
148R64	14	16	16	16

CONCRETE PILES				
PIPE PILE	EQUIVALENT PRECAST CONCRETE PILES	FLUTED SHELLS	HELIICAL CORRUGATED PIPE SHELL	PRESTRESSED CONCRETE PILES
10 1/2"	12	12	12	12
12 1/2"	14	14	14	14
14 1/2"	16	16	16	16

SECTION THRU FLANGE

PILE SPLICE DETAIL

PIPE SPLICE DETAIL

FLUTED PILE

STEP TAPER PILE
 If used as a pile bent reinforcing steel shall be added.


PRESTRESSED CONCRETE PILES

NO.	DATE	REVISION	BY	CHECKED	APPROVED
5	8-28-64	REVISE ENTIRE GEN. NOTE	J.C.C.	E.E.R.	
6	8-28-64	ADD SECTION 13 AND HELICAL PIPE SHELL	J.C.C.	E.E.R.	
7	8-28-64	REVISE PRECAST CONCRETE PILE TABLE	J.C.C.	E.E.R.	
8	8-28-64	REVISE PRECAST CONCRETE PILE TABLE	J.C.C.	E.E.R.	
9	8-28-64	REMOVE NOTE IN PRESTRESSED CONCRETE PILES	J.C.C.	E.E.R.	

STATE HIGHWAY COMMISSION OF KANSAS


STANDARD PILE DETAILS

STD. NO 102

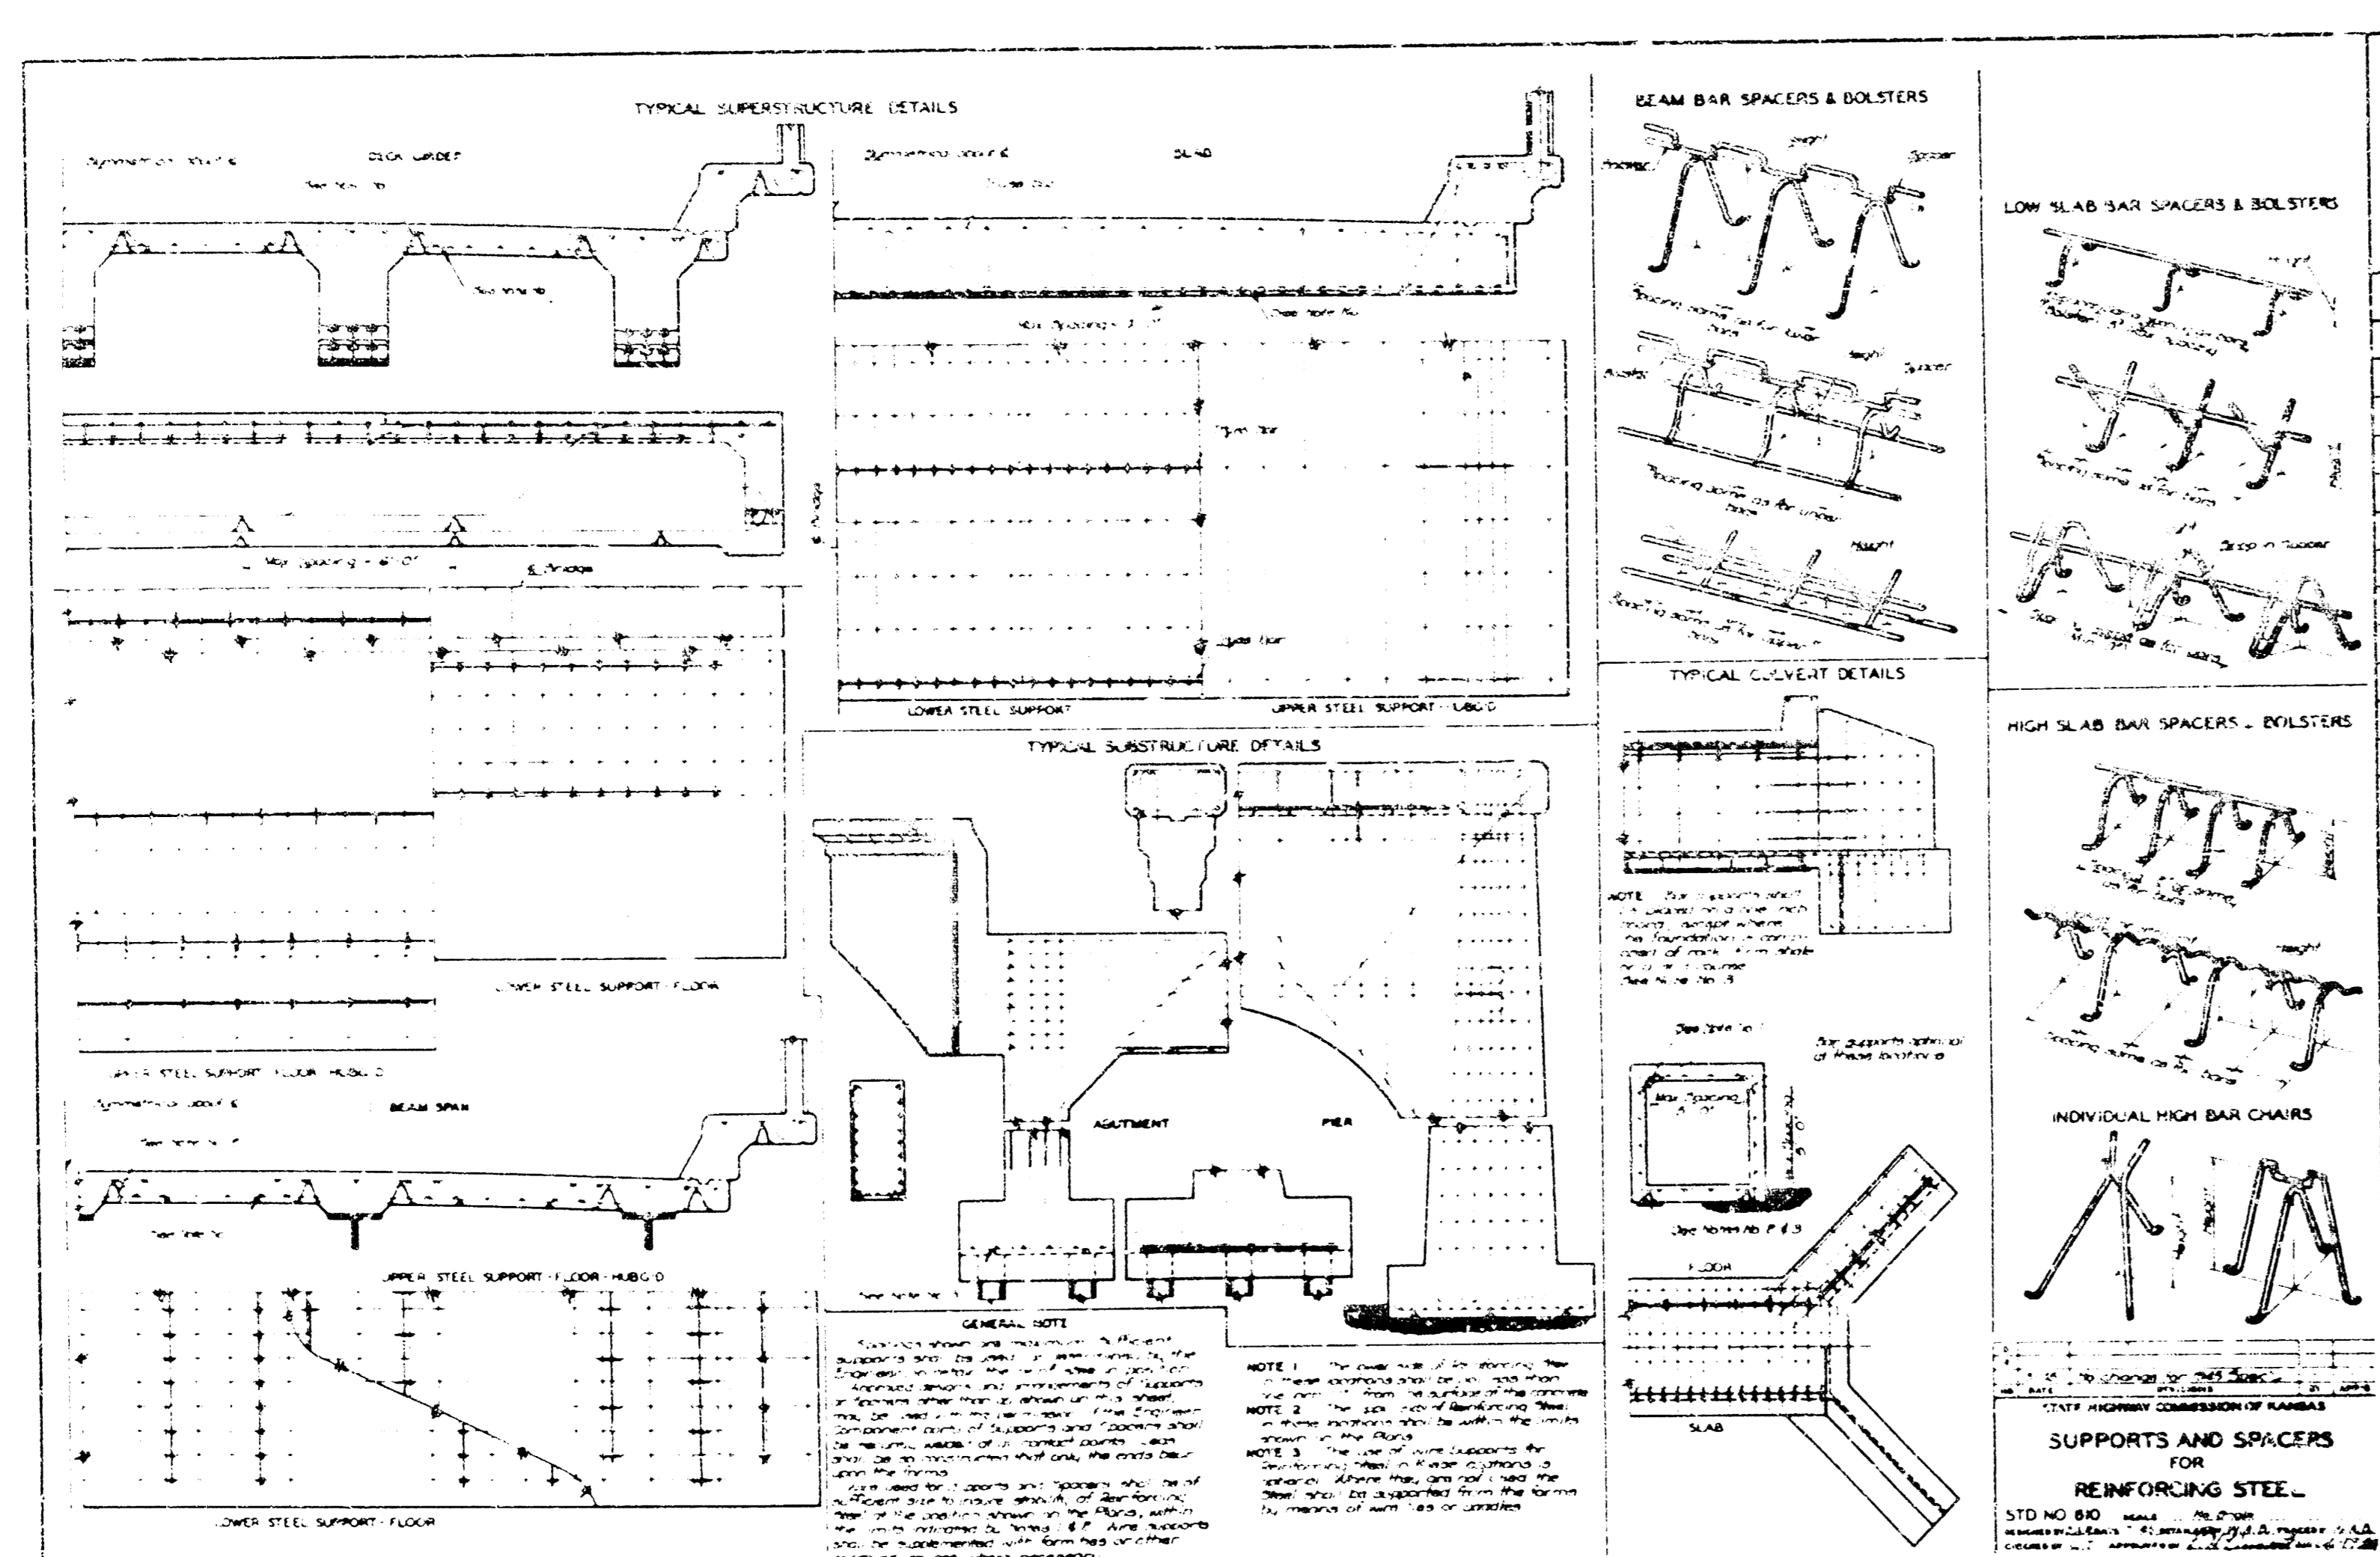

SUMMARY OF BRIDGE QUANTITIES										SUMMARY OF GRADING QUANTITIES		
Item	Abut. #1	Abut. #2	Span #1	Span #2	Span #3	Span #4	Subtotal	Total	Unit	Item	Quantity	Unit
Excavation Class I	30	2				2	60	24	Cu Yds	Str. Saw Reinforcement	15	Lbs
Excavation Class II		21	61	61	61			242	Cu Yds	Man. Reinforcement	15	Lbs
Class AAA(AE) Conc.	80.6						80.6	61.0	Cu Yds	Compacted Sand	50	Cu Yds
Class A(AE) Conc.		24.5	34.5	34.5	34.5			388.0	Cu Yds	Rebar	2,305	Lbs
Reinforcing Steel	6,340	2,030	2,030	2,030	2,030	6,380	25,770	276,550	Lbs	Chain Link Fence	15	Lbs
Aluminum Channel								401.85	Lbs			
Steel Piles 12"	450							450	Lbs			
Steel Piles 18"		640	640	640	640			2,560	Lbs			
Electrical Installation								1.5	Linear Feet			
										Grand Sum		

Const. Note:
 * See pile logs for lengths in place and cut off.
 * Give plan quantity for superstructure steel.

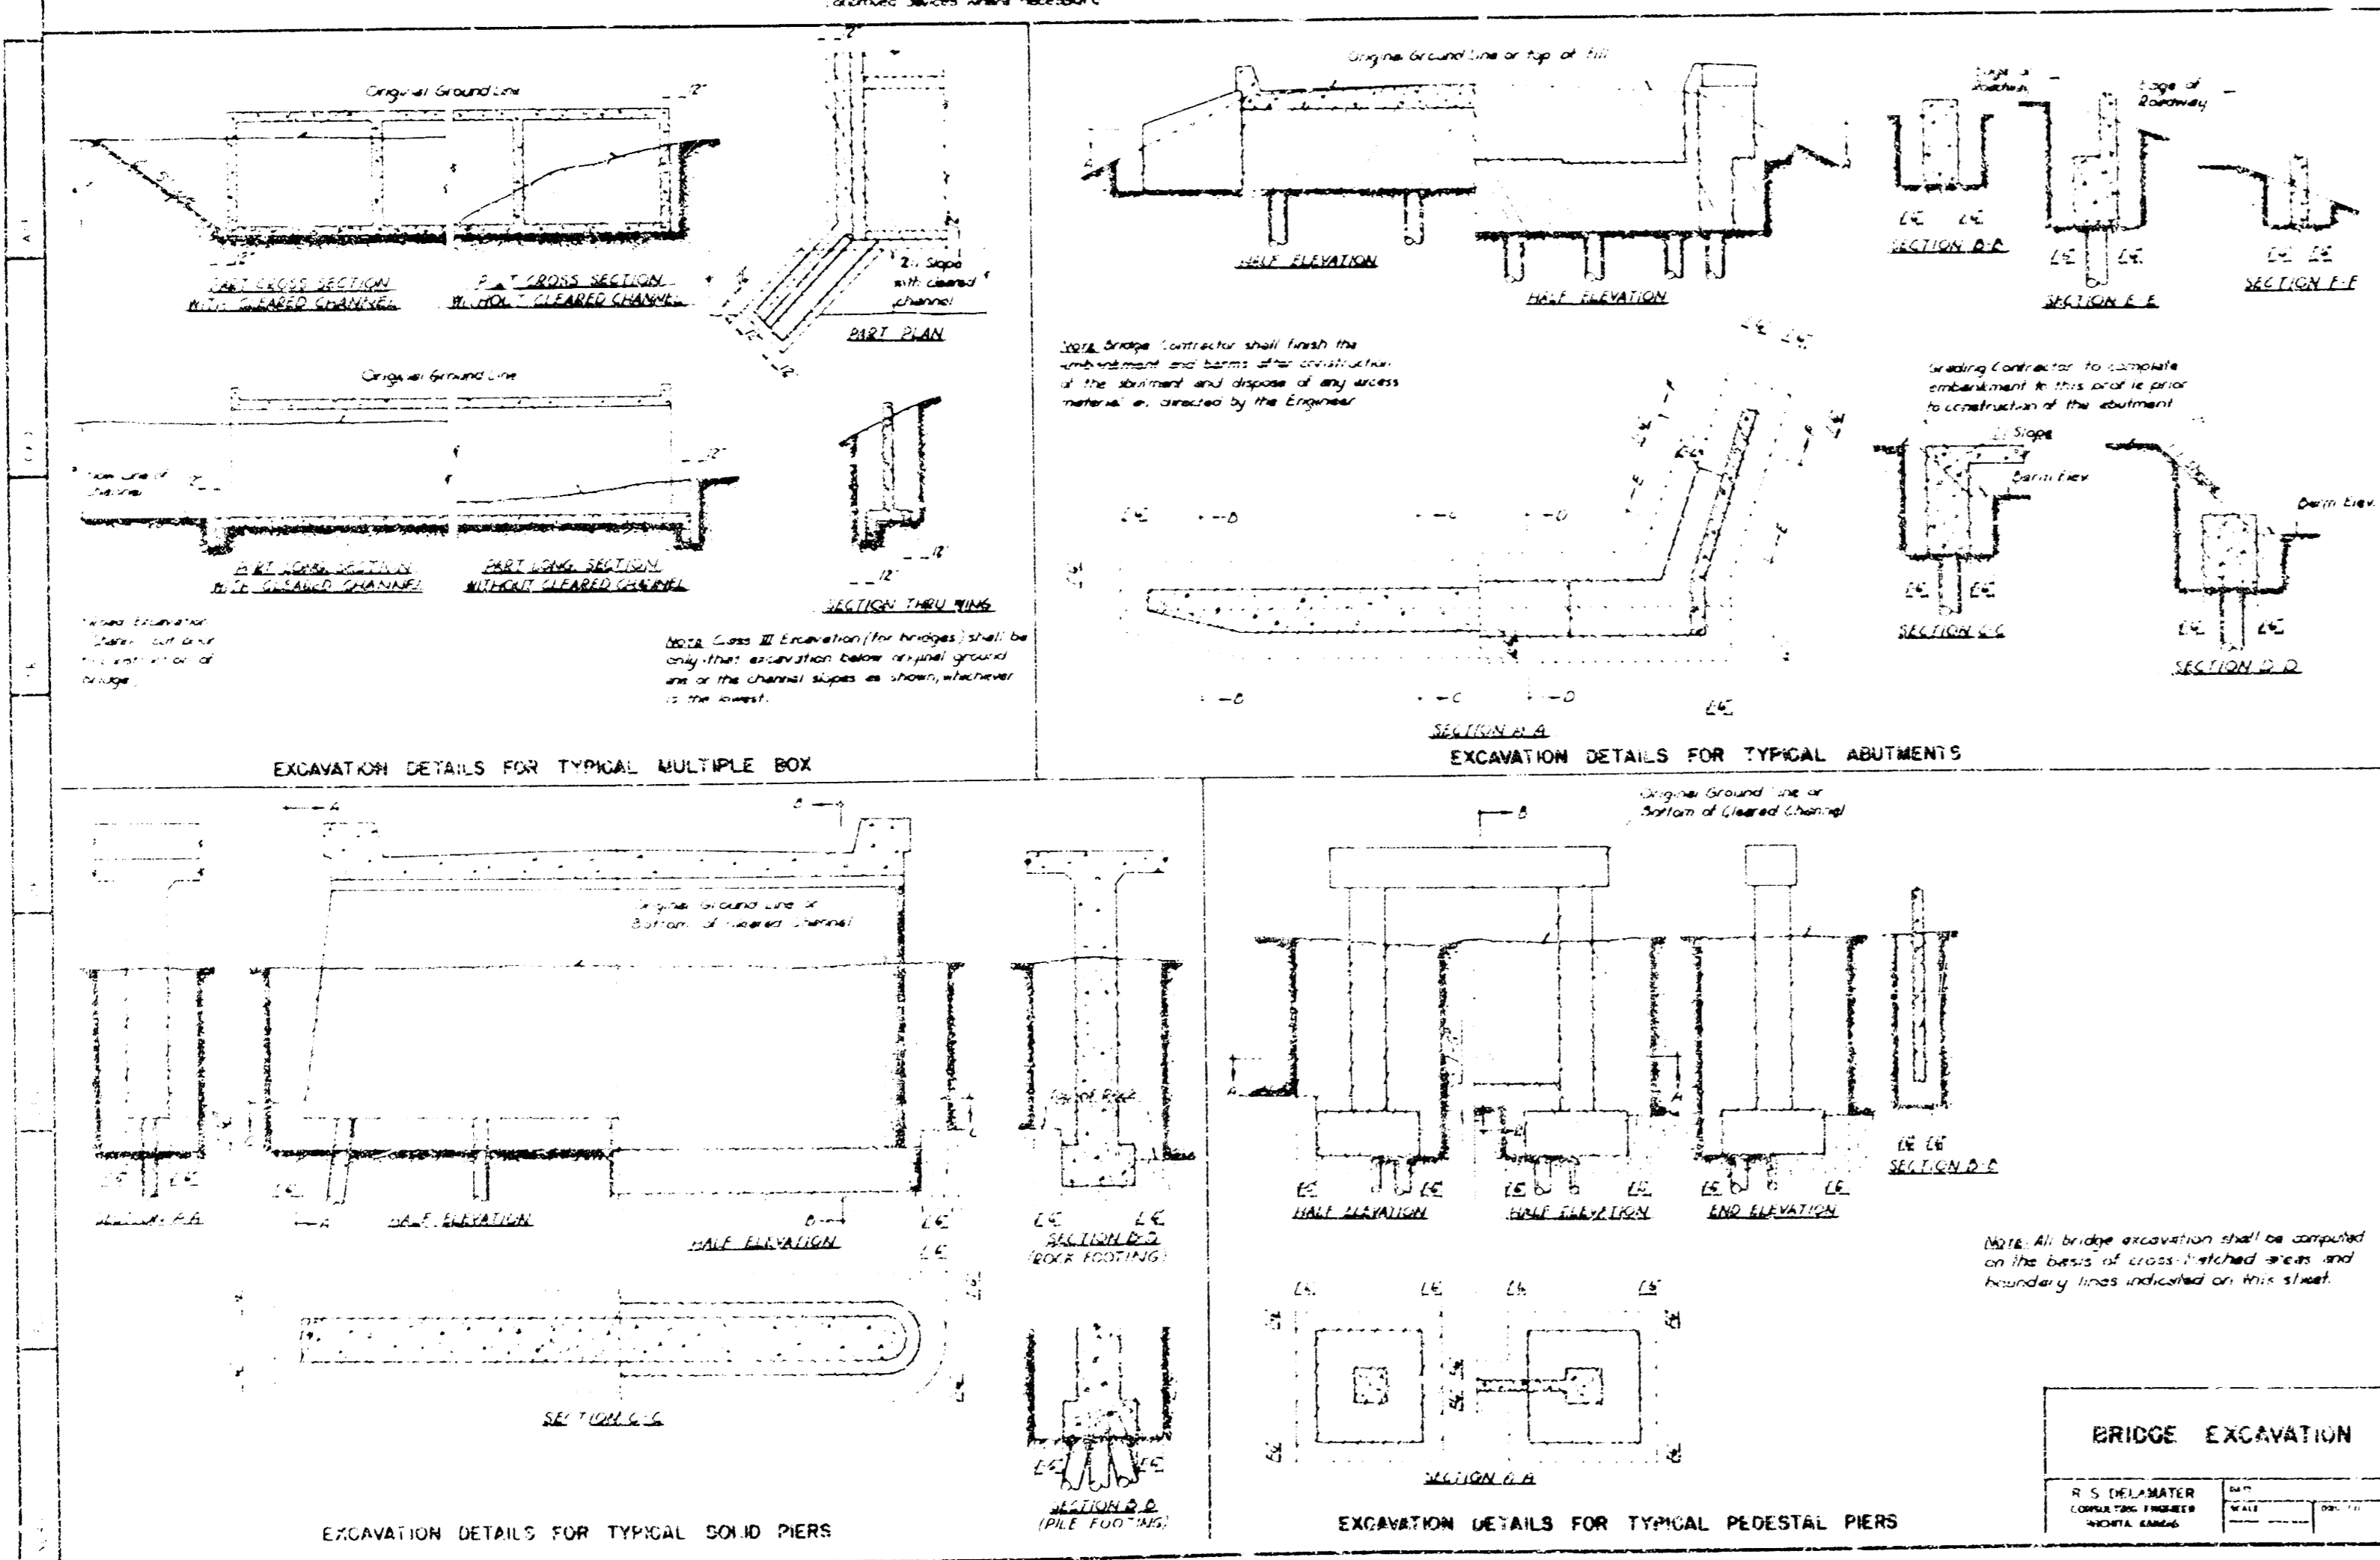

GENERAL NOTE: There will be no direct payment for Common Excavation, or borrow, as such. Payment will be for material in place, as indicated on the construction layout.

EXCAVATION: The contractor shall construct the embankments and grade the berms at the abutments as shown on Construction Layout and Section Map prior to construction of the bridge.

EXCAVATION: Elevation 110.60 constitutes the Excavation Boundary Plane for estimating quantities for Class I and Class II Bridge Excavation; Class I above and Class II below; see diagrams on this sheet for limits of pay excavation.

SOUNDINGS: Sounding information shown on Sheet 3 is as obtained from borings made in the field and represents the best information available to the City of Wichita.

PILES: All piles shall be driven to the penetration shown unless in the opinion of the Engineer such penetration cannot be secured without injury to the pile. All piles shall be driven to a minimum computed bearing value of 43 tons per pile in abutments, 36 tons per pile in abutments.

PILE DRIVING: All piles shall be driven with a steam or diesel hammer; if a diesel hammer is used, sufficient hammer data shall be provided to permit rating by the Engineer before driving starts.

FALSEWORK AND FORMING: Falsework under superstructure, including each sidewalk slab, shall be left in place in any span until the concrete in that span and the sidewalk cover constructed latest shall have attained its design strength; but in no case shall the falsework be removed before 14 days after placing concrete. Formwork walls under handrails shall preferably, but not necessarily, be placed after falsework supporting the work has been removed. Jumper shall be provided in the amounts shown on the Load-Load Diagram.

CONCRETE: Class AAA(AE) Concrete shall be used in abutments and superstructure, including walks; Class A(AE) in Piers. Bevel all exposed edges with a 3/4" triangular mousing and fillet all corners 3/4" unless otherwise noted.

REINFORCING STEEL: All dimensions shown relative to reinforcing steel placement are in centerline of bars unless otherwise noted. All dimensions shown in bending diagrams are out of bars.

DECK TREATMENT: Bridge deck shall be cured with Linseed Oil emulsion, in accordance with the Specifications.

DESIGN:
 Design Loading: H20-S16-44 with 10' spacing
 Unit Stresses: $f_c = 4,000$ p.s.i. Class AAA
 $f_c = 3,000$ p.s.i. Class A
 $f_s = 20,000$ p.s.i. (steel)
 $f_t = 4,000$ p.s.i. Class AAA
 $f_t = 3,000$ p.s.i. Class A
 Pile Loading: 43 tons per pile in abutment
 36 tons per pile in abutment

CITY OF WICHITA, KANSAS
 R. E. SMITH, CITY ENGINEER
22nd STREET BRIDGE OVER LITTLE ARKANSAS RIVER
B.S., B.E., NOTES & QUANTITIES
 NORTH WICHITA THRUWAY
 R. S. DELAMATER CONSULTING ENGINEER
 WICHITA, KANSAS
 DATE: 12-1-57
 SCALE: 1" = 10'-0"
 SHEET NO: B9-D-11